



GAIL FARBER, Director

COUNTY OF LOS ANGELES

DEPARTMENT OF PUBLIC WORKS

"To Enrich Lives Through Effective and Caring Service"

900 SOUTH FREMONT AVENUE
ALHAMBRA, CALIFORNIA 91803-1331
Telephone: (626) 458-5100
<http://dpw.lacounty.gov>

ADDRESS ALL CORRESPONDENCE TO:
P.O. BOX 1460
ALHAMBRA, CALIFORNIA 91802-1460

August 31, 2009

IN REPLY PLEASE
REFER TO FILE: **AS-0**

REQUEST FOR PROPOSALS – ADDENDUM 1 LANDSCAPE MAINTENANCE SERVICES - WEST AREA (2009-PA026)

Thank you for attending the Proposers' Conference for Landscape Maintenance Services - West Area (2009-PA026) on August 31, 2009. The following revisions have been made to the Request for Proposals (RFP). (Please note that **bold** text has been added and ~~strikethrough~~ has been deleted from the RFP.)

1. Please note that Exhibit E, West Area Maps, has been revised. **Proposers must use the enclosed Exhibit E.1, when submitting proposals.**
2. **Please use the following attached forms when submitting proposals:**

**Form PW-16
Form PW-17
Form LW-8**

**Statement of Equipment
Proposer's Insurance Compliance Affirmation
Staffing Plan and Cost Methodology**


3. Exhibit A, Scope of Work, Section B.6, on page A.2, has been modified as follows:
 6. ~~Los Angeles River~~ **Bell Creek** at Owensmouth Avenue
 - a. Total Area: 6,300 square feet
 - b. Planting Area: 2,450 square feet

August 31, 2009
Page 2

If you have any questions concerning the above information, please contact Mr. Edwin Manoukian at (626) 458-4057, Monday through Thursday, 7 a.m. to 5 p.m.

Very truly yours,

GAIL FARBER
Director of Public Works

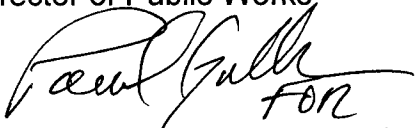A handwritten signature in black ink, appearing to read "Paul Gull" followed by "for" in a smaller, cursive script.

GHAYANE ZAKARIAN, Chief
Administrative Services Division

EM
P:\aspub\CONTRACT\Edwin\Landscape West Area\2009\RFP\Addendum 1.doc

Enc.

TELEPHONE:

STATE BELOW THE INFORMATION FOR ALL EQUIPMENT AVAILABLE

[illegible]

LANDSCAPE MAINTENANCE SERVICES - WEST AREA (2009-PA026)

PROPOSER'S INSURANCE COMPLIANCE AFFIRMATION

Proposer's Name

Address

- ☐ If awarded the contract: Proposer will comply with the insurance coverage provisions set forth in Exhibit B, Section 5, Indemnification and Insurance Requirements of this Request for Proposals, and Proposer will procure, maintain, and provide the County with proof of insurance coverage in the coverage amounts and types specified in Exhibit B, Section 5 throughout the entire term of the proposed contract, without interruption or break in coverage.
- ☐ If you check this box, your proposal will be determined nonresponsive and your proposal will be disqualified. Proposer will not comply with the insurance coverage provisions set forth in Exhibit B, Section 5, Indemnification and Insurance Requirements of this Request for Proposals, and Proposer will not procure, maintain, and provide the County with proof of insurance coverage in the coverage amounts and types specified in Exhibit B, Section 5 throughout the entire term of the proposed contract, without interruption or break in coverage.

Proposer's Printed Name


Proposer's Signature


Date


POSITION/TITLE * (LIST EACH EMPLOYEE SEPARATELY)	HOURS PER DAY							HOURS PER WEEK	ANNUAL HOURS	HOURLY WAGE RATE**	ANNUAL COST
	SUN	MON	TUE	WED	THU	FRI	SAT				

[illegible]


- This cost methodology is to show, in detail, how the Proposer arrived at the proposed contract price. This methodology is to reflect employee classifications to be used (e.g., landscape maintenance laborer, working supervisor, etc.); hours to be worked daily, weekly, and annually by each classification; hourly and annual wages to be paid to each classification; estimated annual payroll taxes; estimated annual allowances for vacation, sick, holiday, health and welfare, and pension. Proposer's costs for insurance, supplies, equipment, overhead, and any other miscellaneous costs are to be shown as requested. These costs, plus the gross labor costs and projected profit, must match the total to the Proposer's annual price as quoted in Form PW-2, Schedule of Prices. When there is a discrepancy between the price quoted in Form PW-2, Schedule of Prices, and this cost methodology, Form LW-8, the correctly calculated price indicated in Form PW-2, Schedule of Prices, shall prevail. The above information was compiled from records that are available to me at this time and I declare under penalty of perjury that the information is true and accurate within the requirements of the proposal.

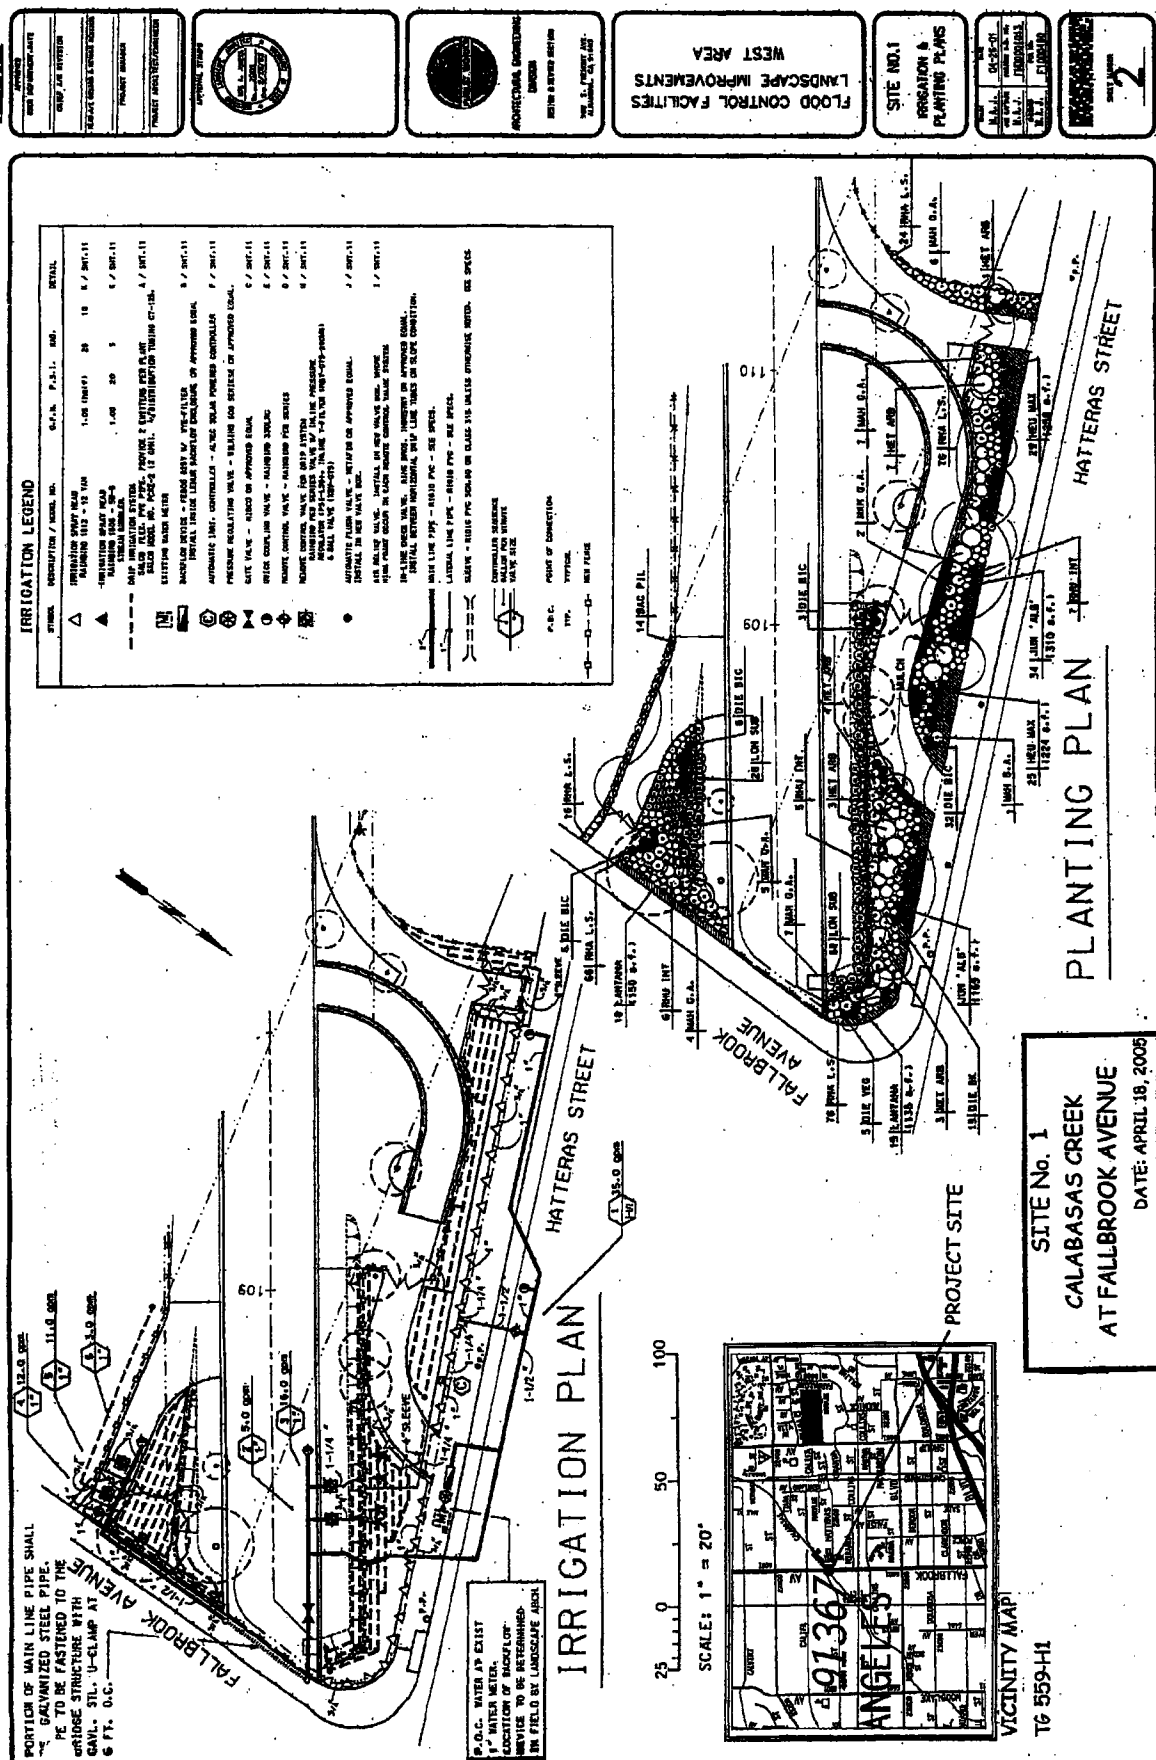

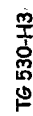

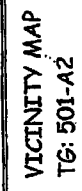


1. CONTRACTOR SHALL PRUNE ALL EXISTING TREES AND LARGE SHRUBS, INCLUDING PALM TREES, WITHIN THE PROJECT AREA AS DIRECTED BY THE LANDSCAPE ARCHITECT.
2. ALL PLANTING AREAS SHALL RECEIVE MIN. 3" OF MULCH.

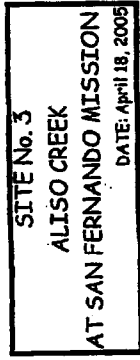

100
50
0
25
SCALE: 1" = 20'

SEE SHT. L-3 FOR IRRIGATION LEGEND

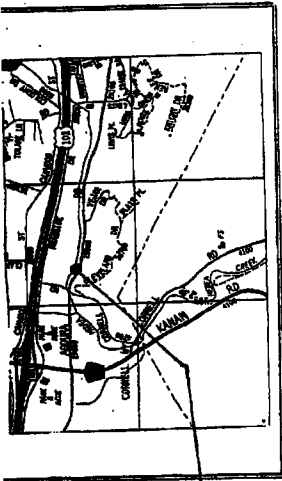

PROJECT SITE

VICINITY MAP
TG: 558-B6


PLANTING LEGEND			
TREE	SYMBOL	ABBREY.	BOTANICAL NAME "COMMON NAME"
		CER OCC	Cercis occidentalis WESTERN RED BUD
		ABBREY.	BOTANICAL NAME "COMMON NAME"
		HET ARB	Hesperomela arborea TOTO
		PLA RAC	Palaua rosea CALIFORNIA STICKLE
SHRUBS/GROUND COVER			
		BAC PIL	Baccharis pilularis TWIN PEAKS COTONE
		CEA 640	Ceanothus glaucus YANKEE POINT CANTON
		MAN RUS	Mammillaria rigida DEER GRASS
		RIB VIS	Ribes viburnifolium EVERGREEN CURRANT
		SAL DEE	Salvia densa DEE'S BLUE SALVIA
		SAL TER	Salvia teretica TERRACE SALVIA
		ZAU CAL	Zauschneria californica CALIFORNIA FUCHSIA
		HEI MAX	Hesperomela maxima ISLAND ALUM ROOT
		AREA 'B' (105)	AREA 'B' (105)
		AREA 'B' (11)	AREA 'B' (11)
		AREA 'B' (21)	AREA 'B' (21)
		AREA 'B' (15)	AREA 'B' (15)
		AREA 'B' (54)	AREA 'B' (54)
		AREA 'B' (17)	AREA 'B' (17)
		AREA 'A' (34)	AREA 'A' (34)
		AREA 'A' (66)	AREA 'A' (66)


NOTE:
THIS PLAN WAS PREPARED BASED ON OLD PLANS
FROM L.V.V.V.D. D.M. AND FIELD MEASUREMENT.
EXACT LOCATIONS OF UTILITIES AND EXISTING SITE
FEATURES ARE APPROXIMATE.


PLANTING NOTES:

1. PROVIDE 3" DEEP LAYER OF 1" TO 2" GRIND WOOD BY-PRODUCT OR SHREDDED BARK MULCH TO ALL PLANTING AREAS. COLOR OF MULCH SHALL BE DARK.
2. KEEP 5' RADII CLEARANCE ALL AROUND THE EXISTING OAK TREES AND 5' RADII AROUND THE EXISTING FIRE HYDRANT.


SITE No. 5
CHESBORO CREEK
AGOURA HILLS
DATE: April 18, 2005

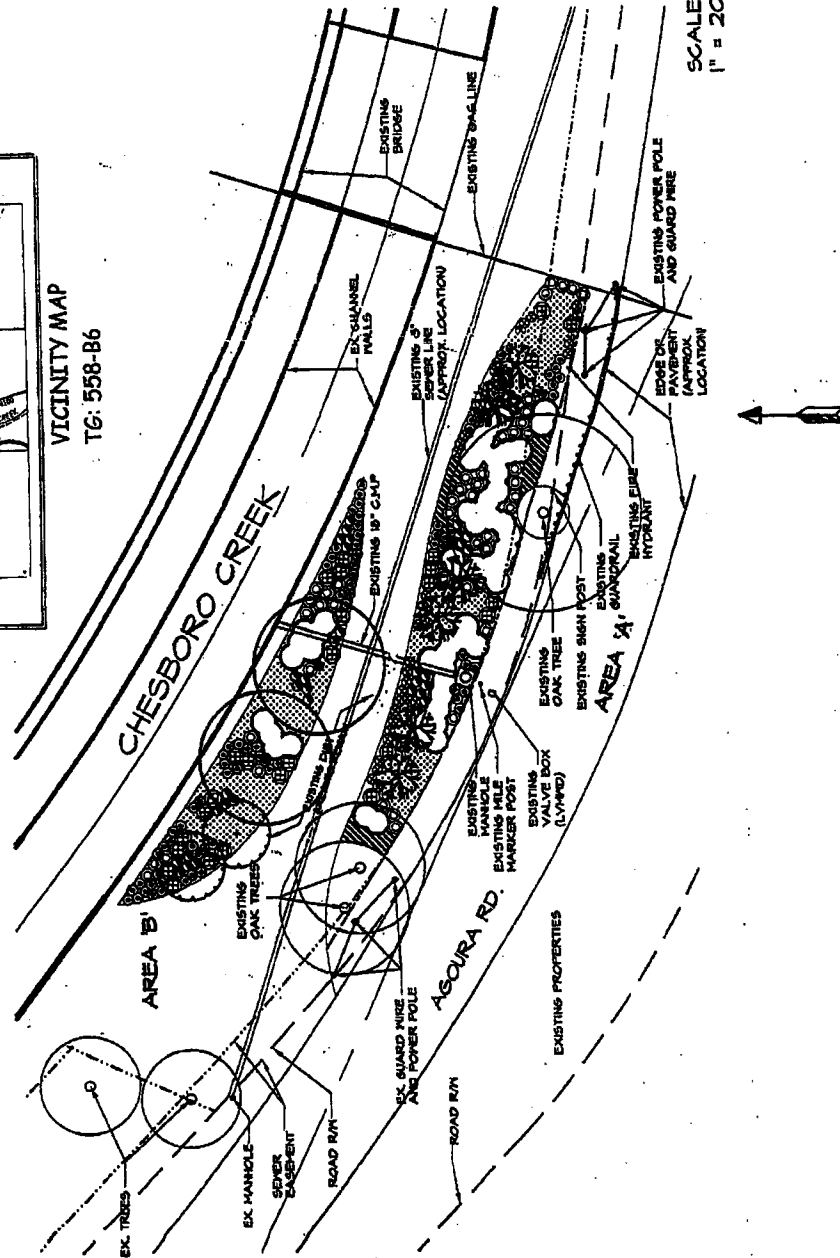


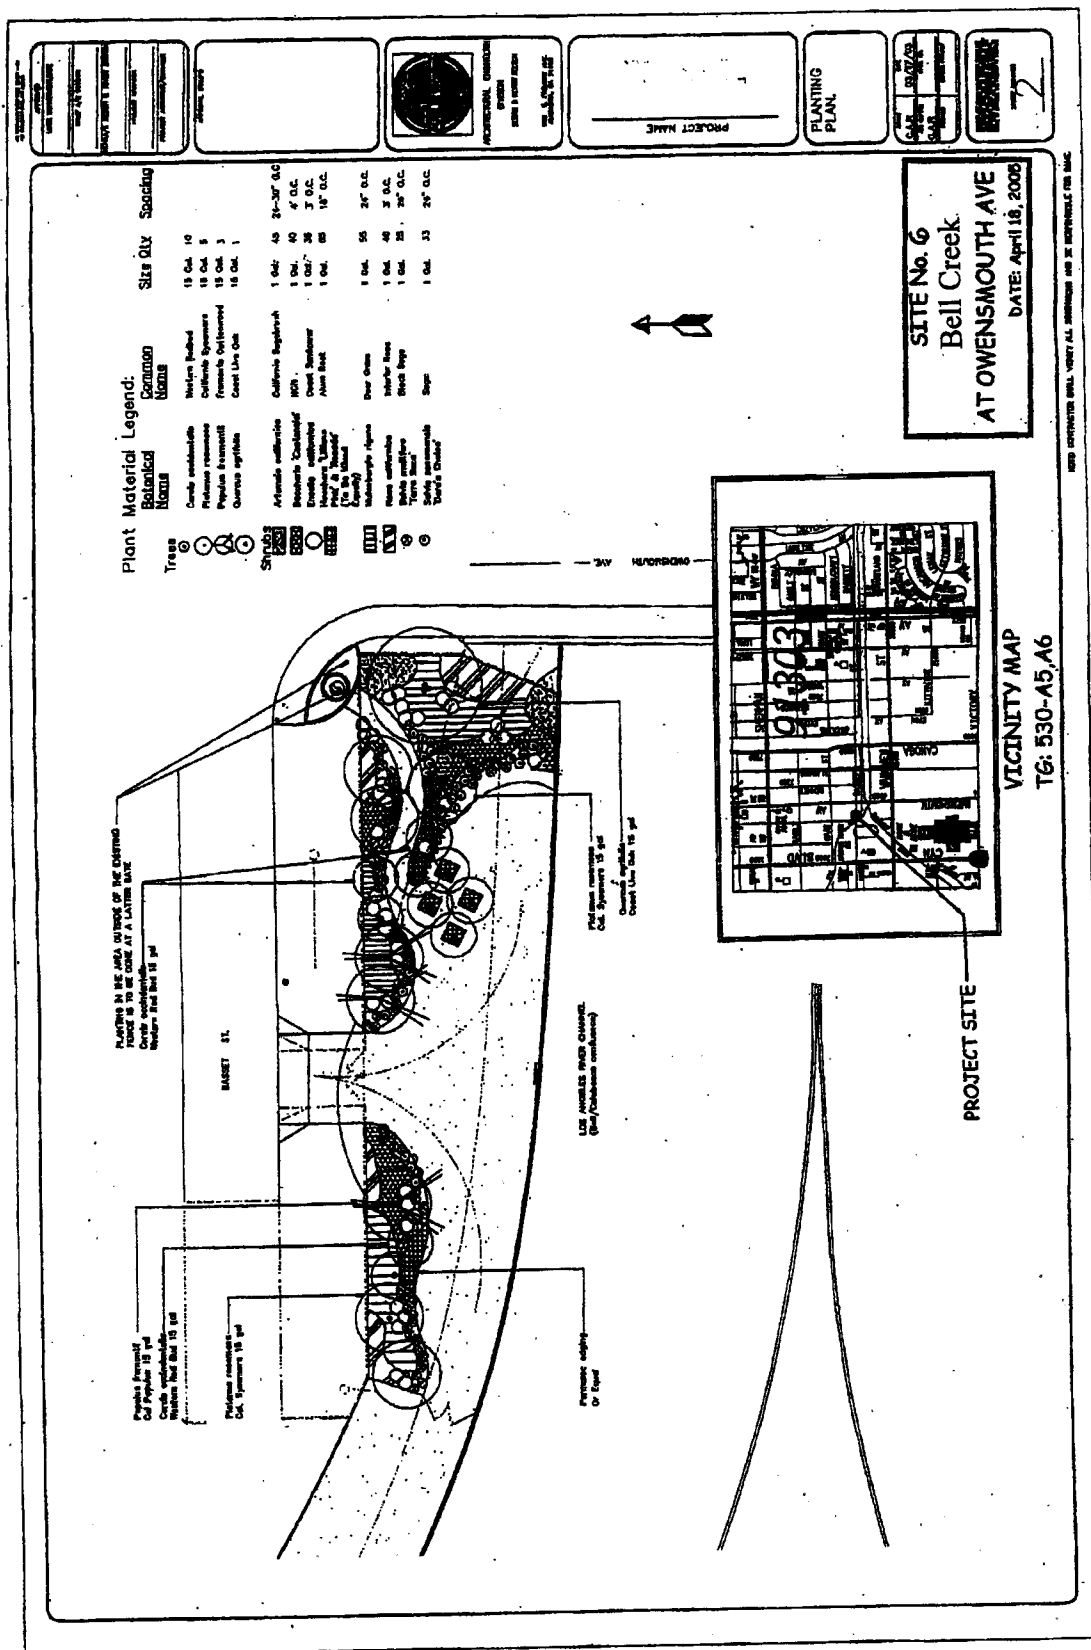


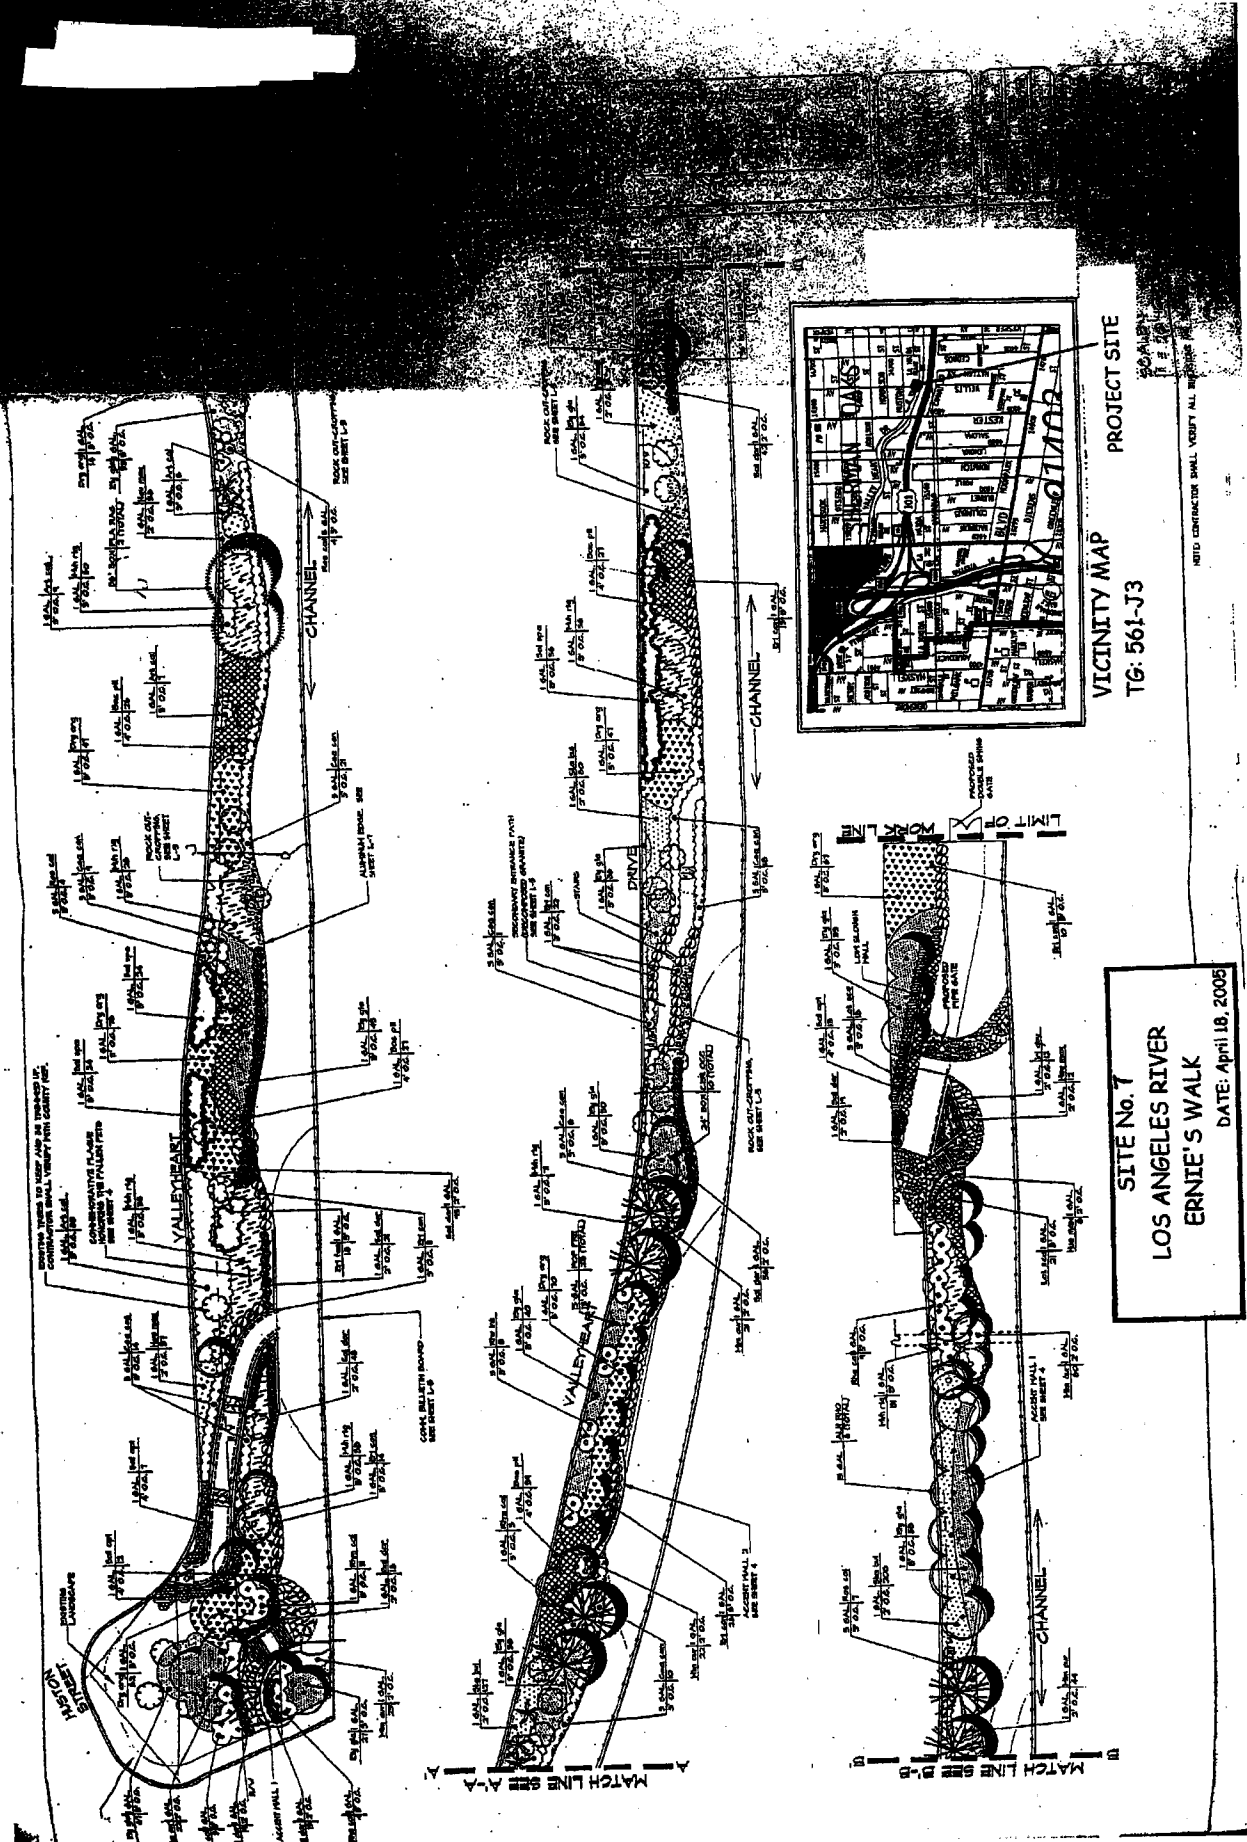



SITE No. 7
LOS ANGELES RIVER
ERNIE'S WALK
 DATE: April 18, 2005

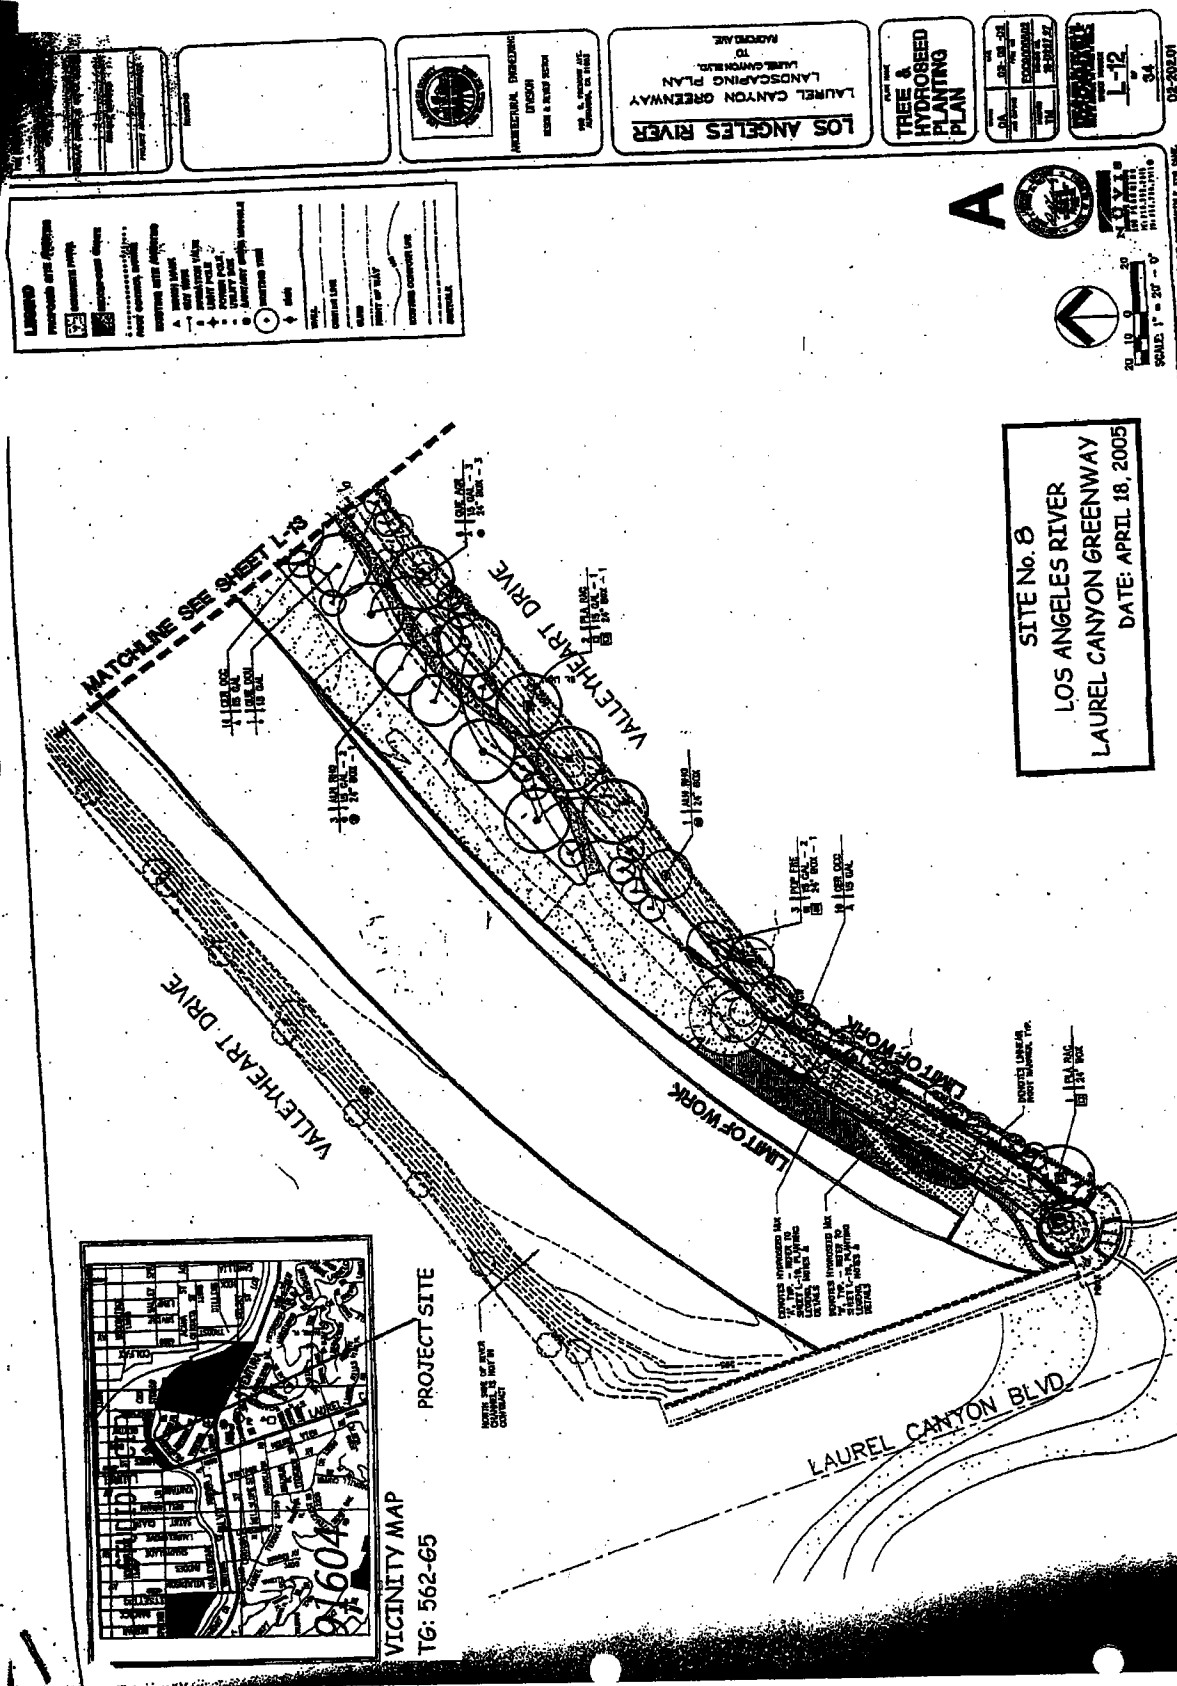


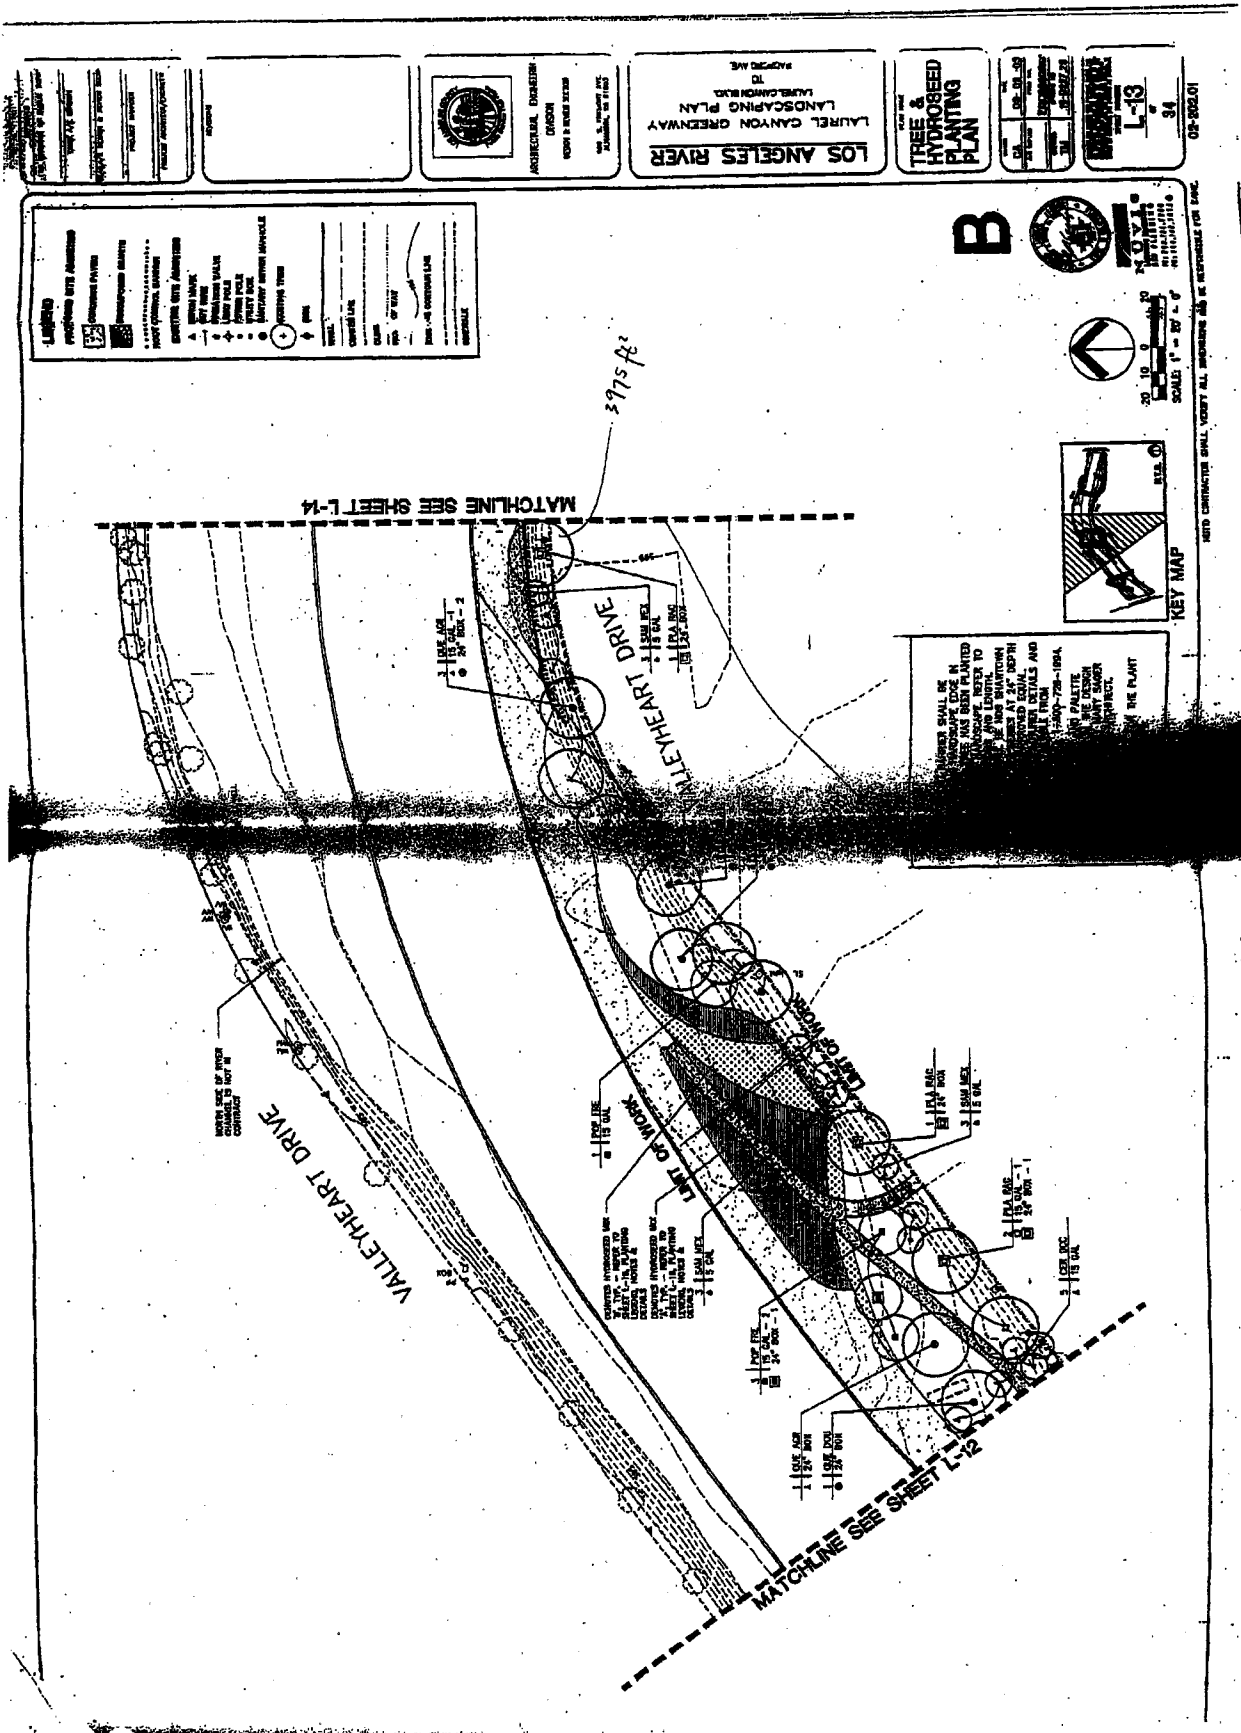


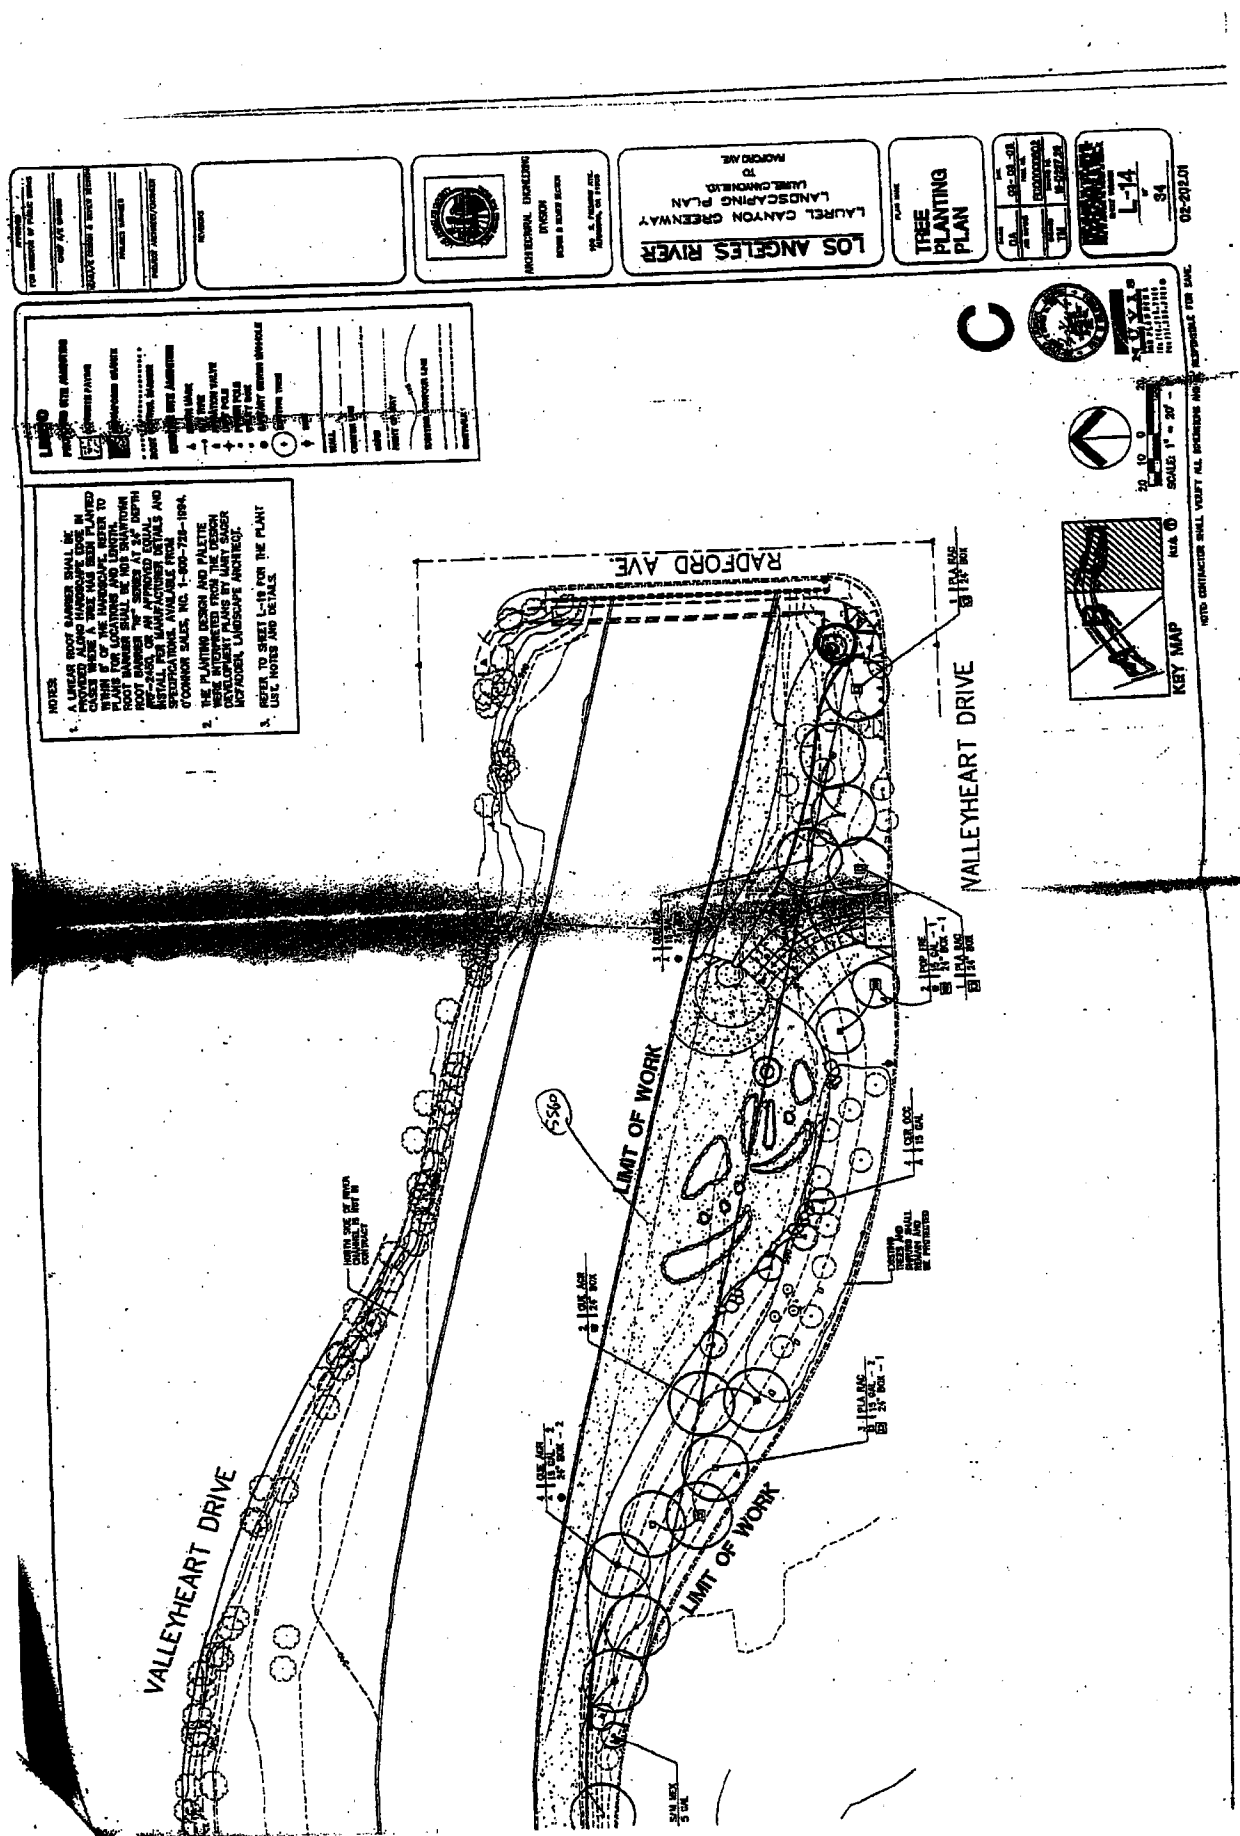

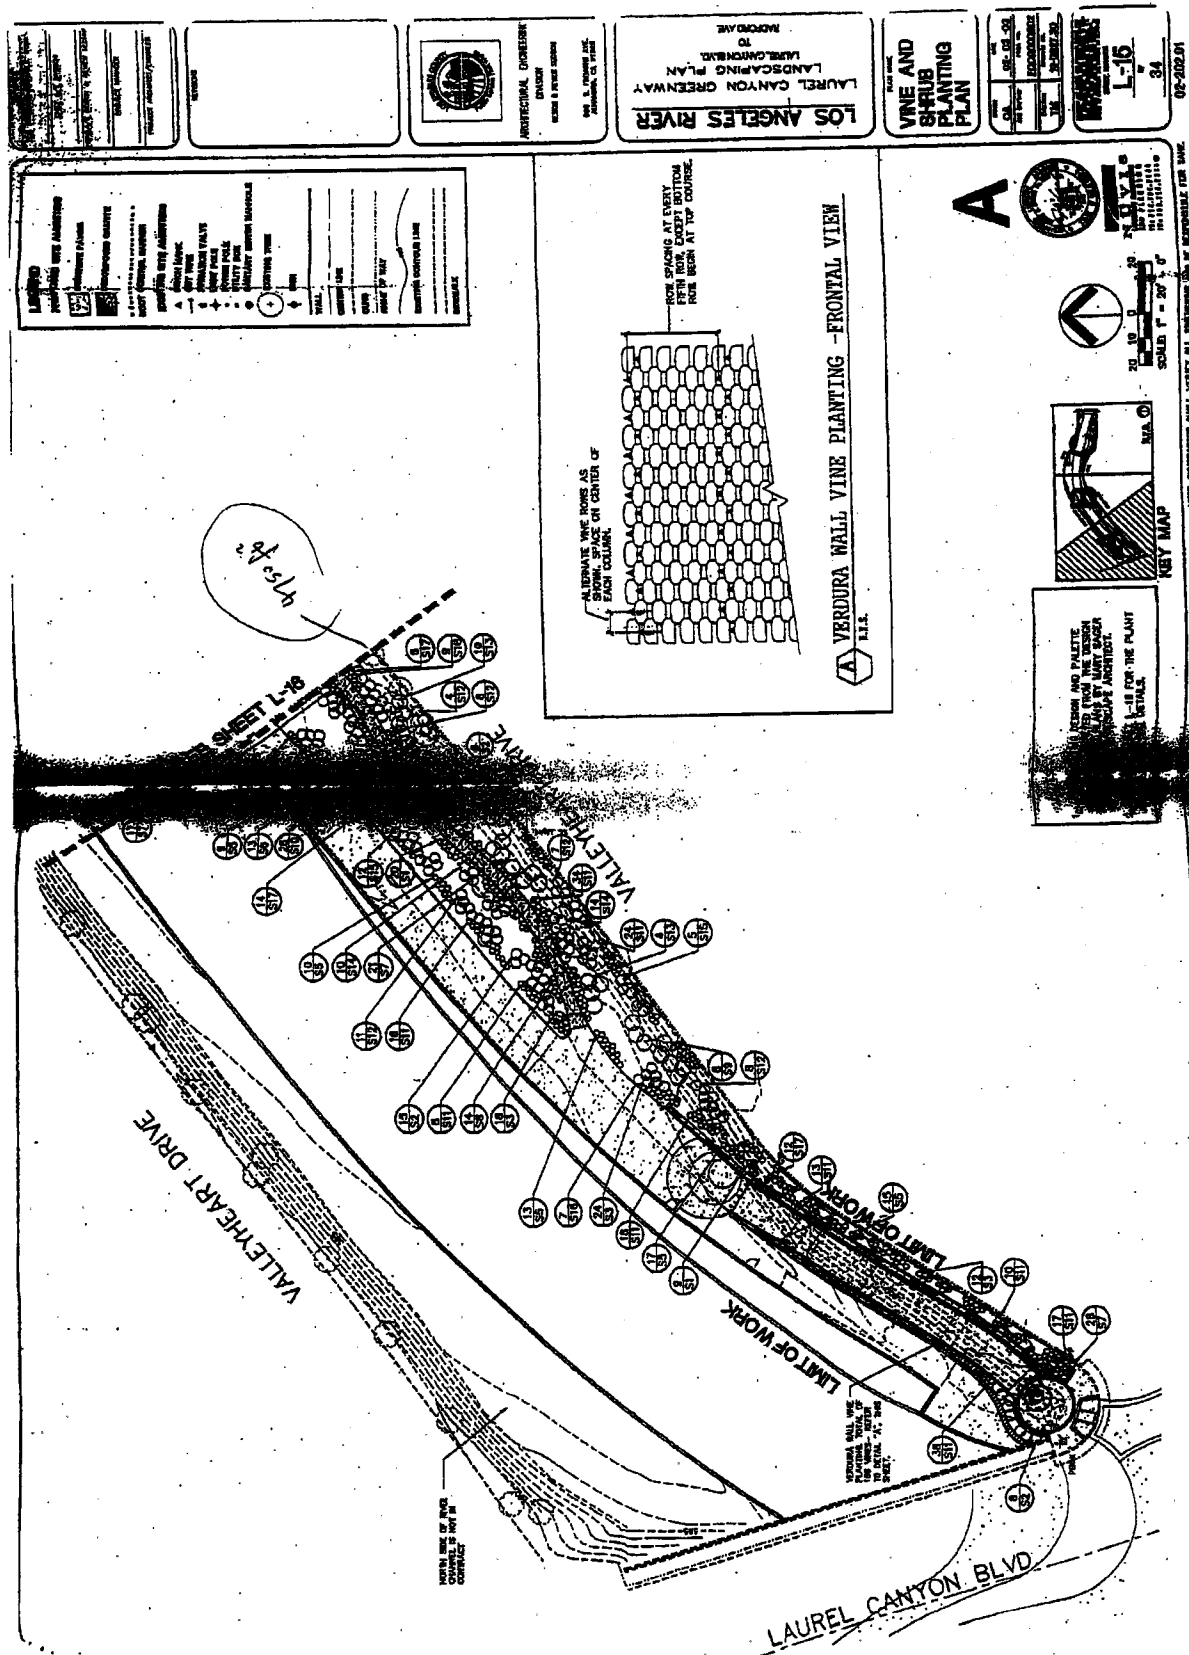


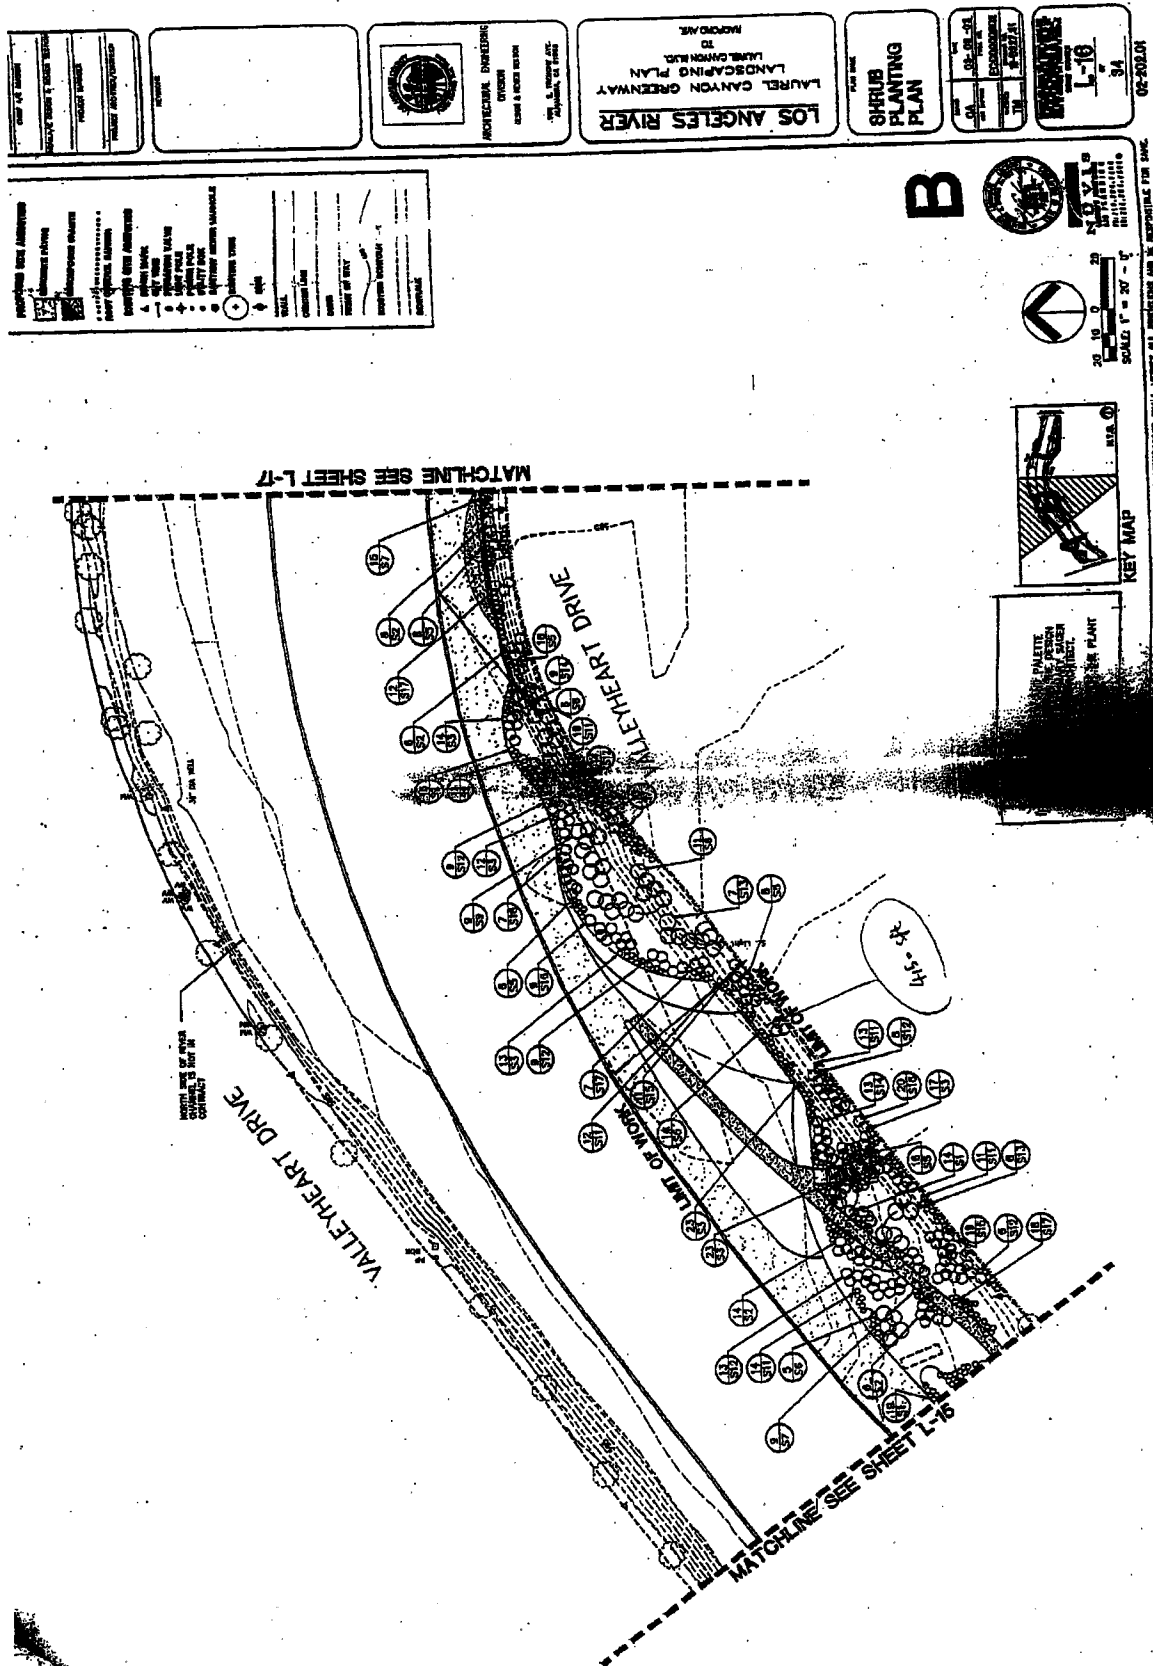


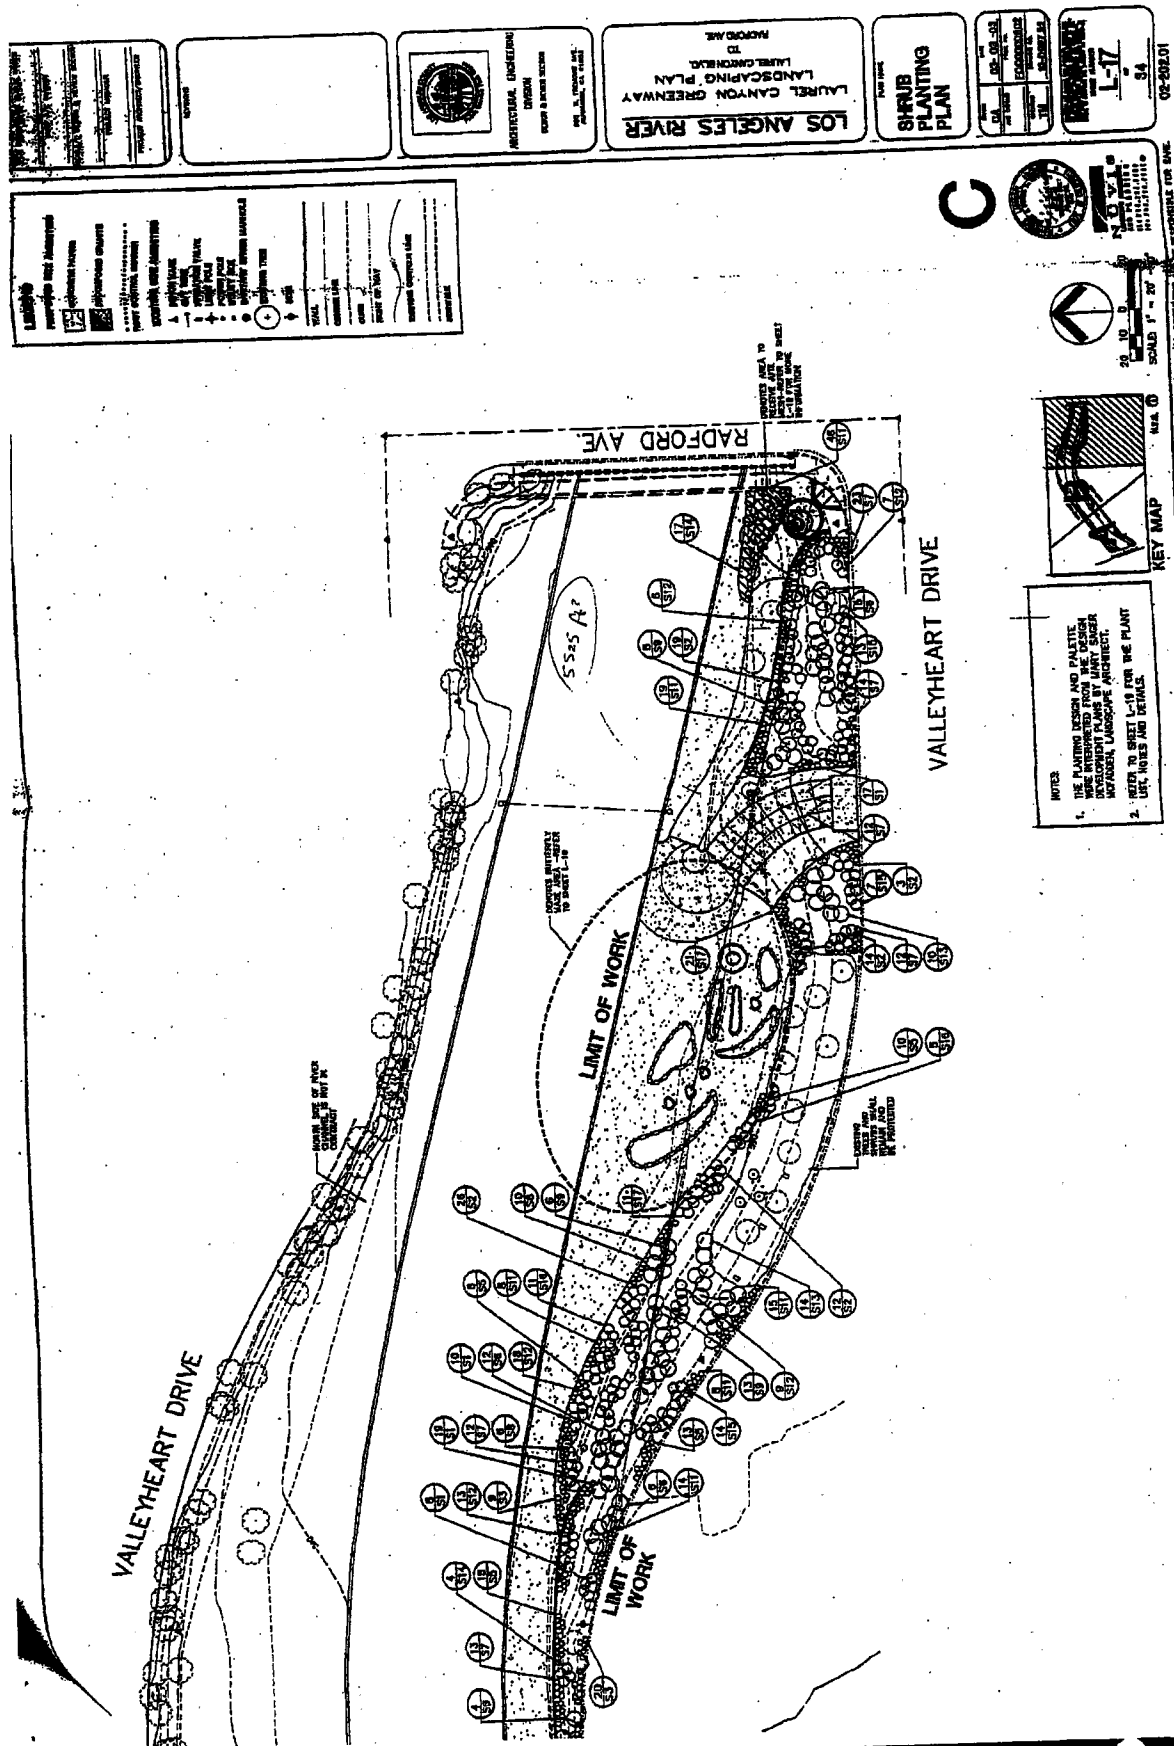


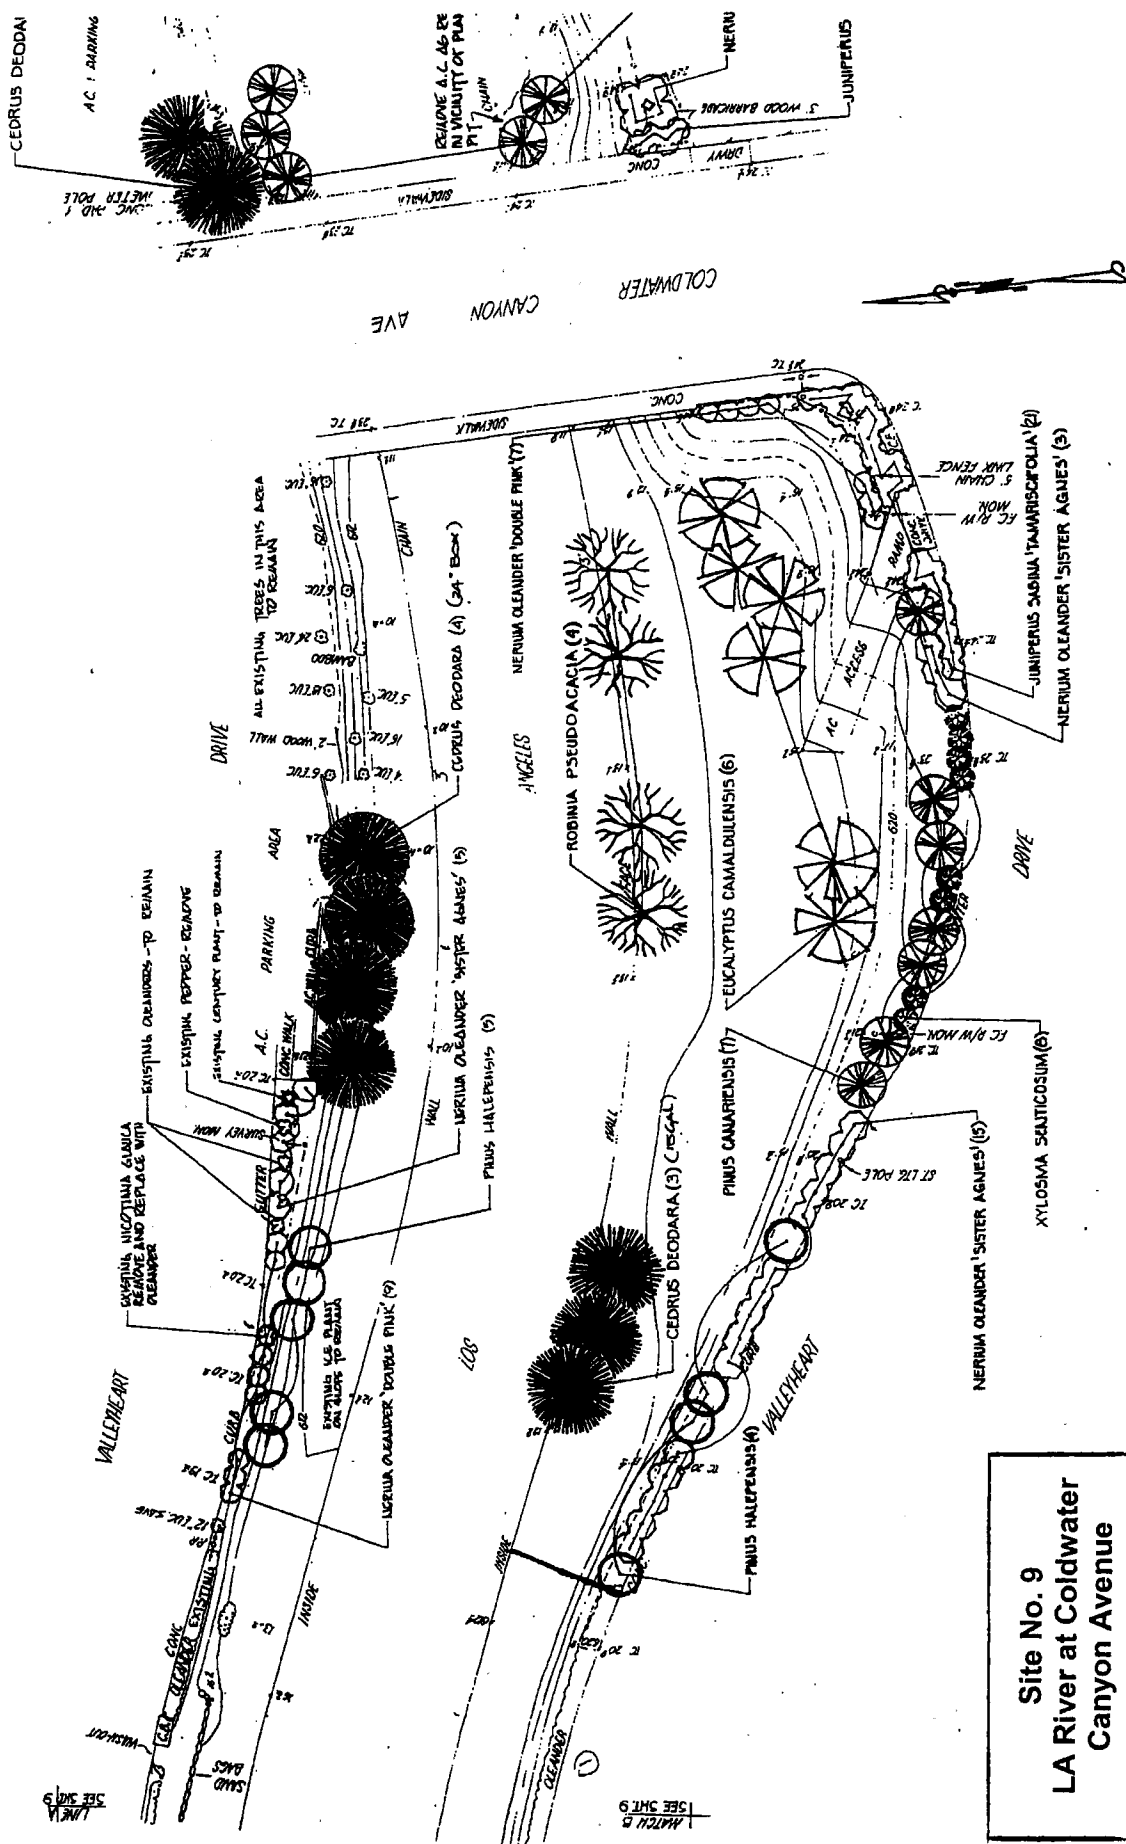


Site No. 9
LA River at Coldwater
Canyon Avenue

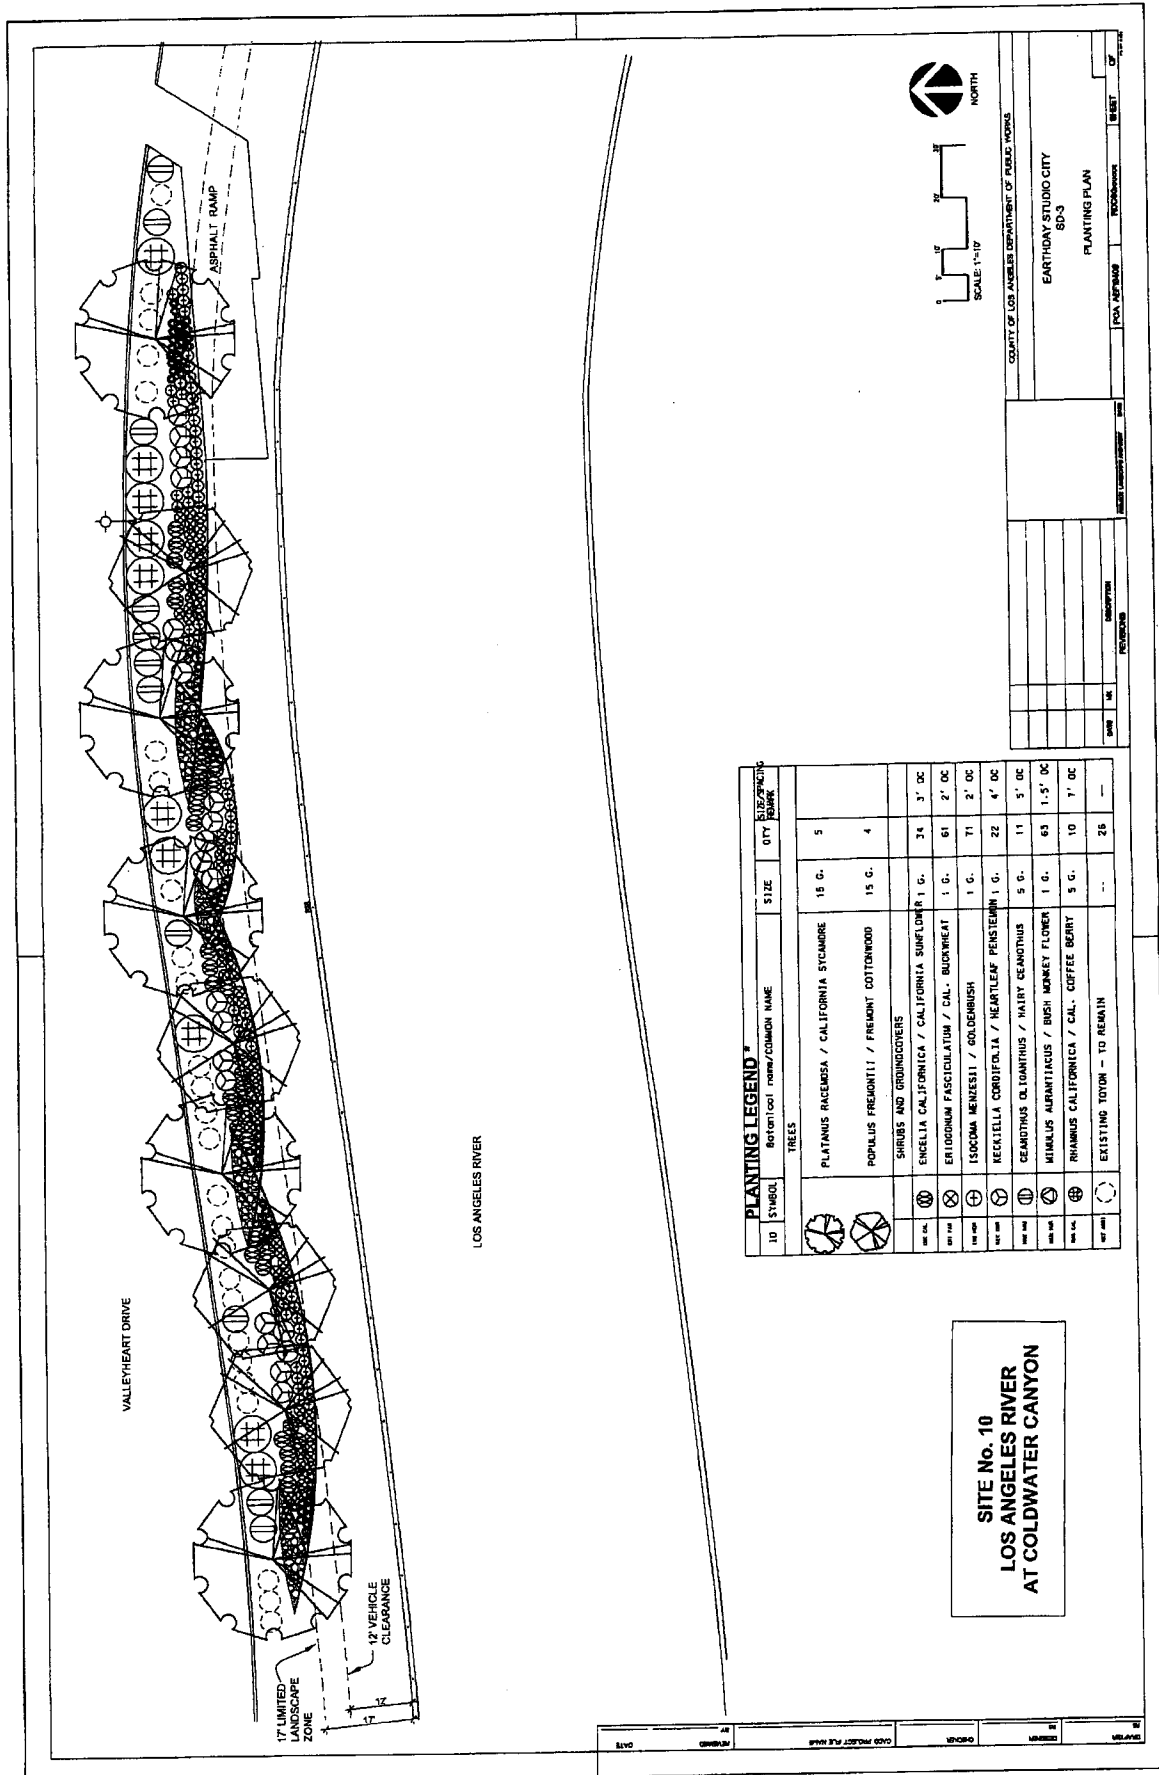

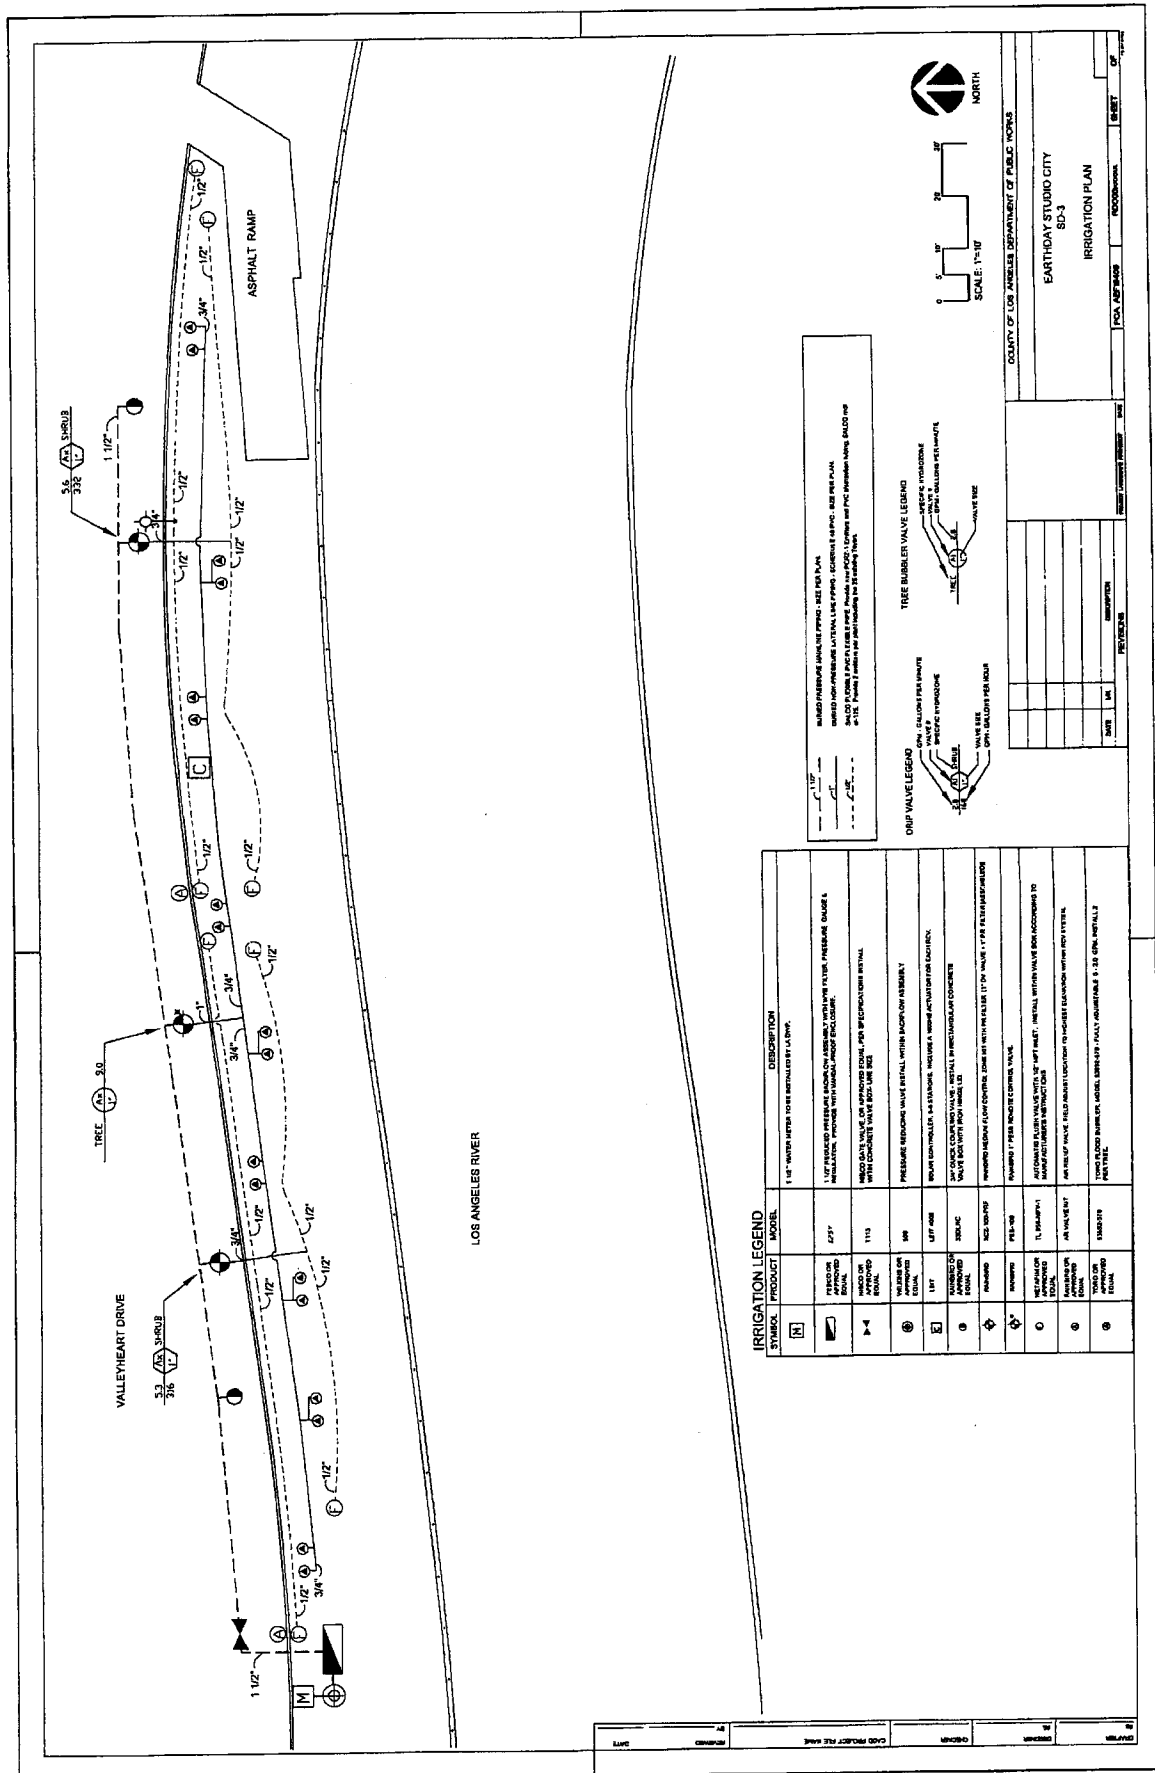

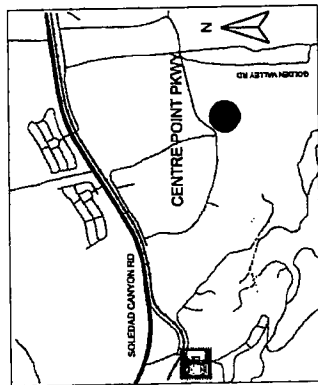

**SITE No. 11
SANTA CLARITA YARD**

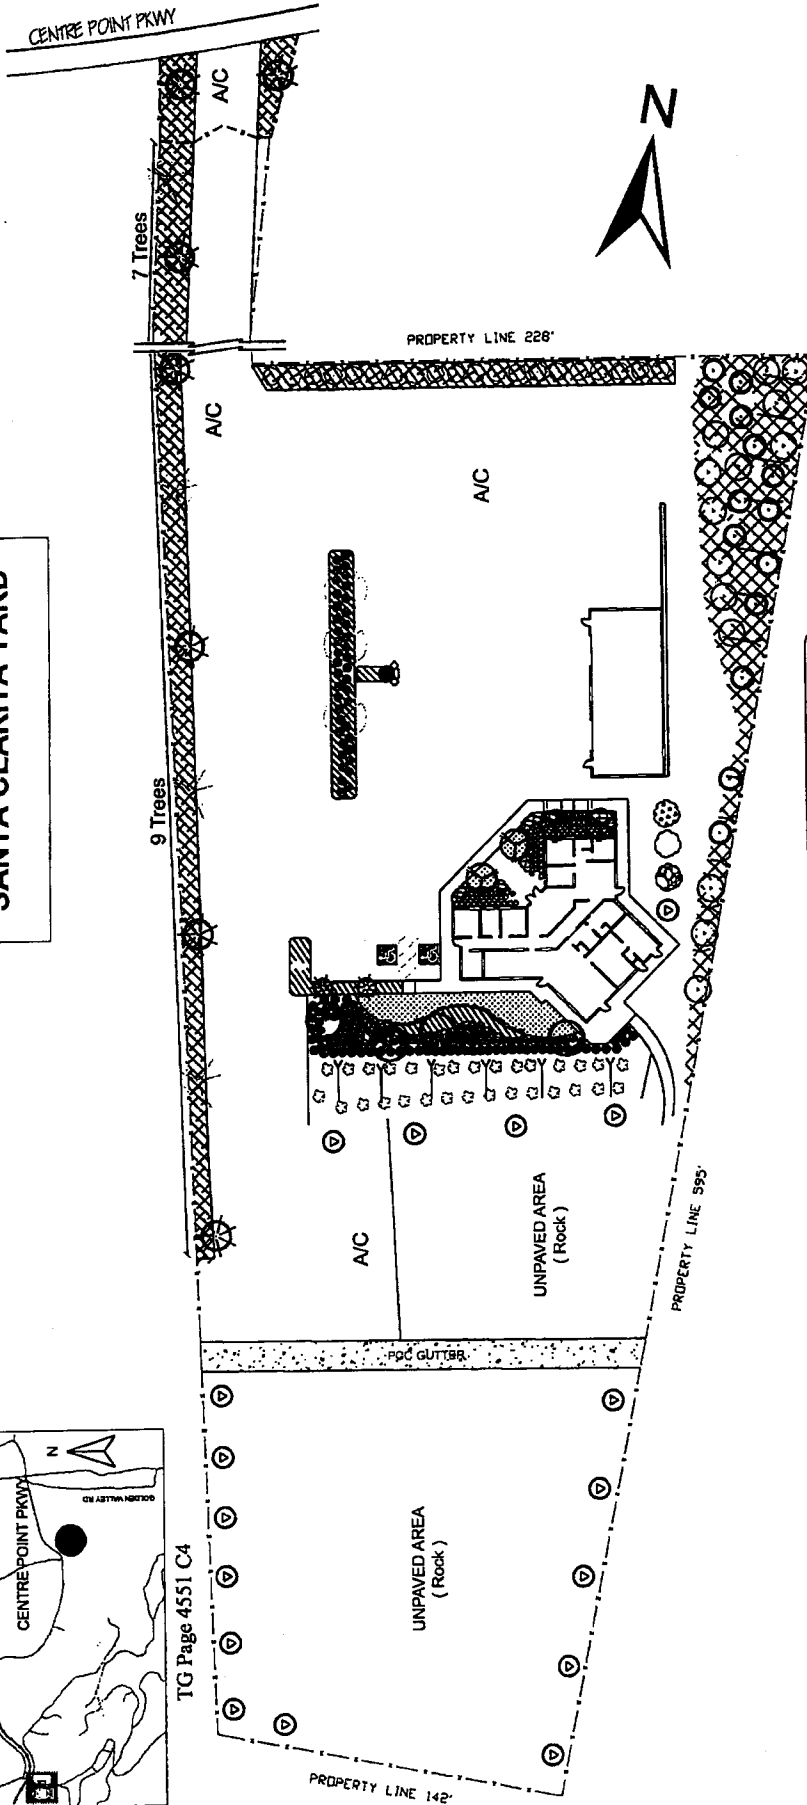

LEGEND	
	Revert to Native Hydressed w/ide (Covered)
	Gazania @ 18" OC - front flats (Covered)
	Lombard @ 24" OC - from flats (Covered)
	Tall Fescue (Covered)
	5g - Pinus eiderica - Afghan Pine - #14
	15g - Euclalyptus sideroxylen - Red Ironbark - #4
	15g - Fraxinus Raywood - Raywood Ash - #8
	24" Box Robinia Ambigua Purple Robe - Locust - #4
	5g - Quercus agrifolia - Oak - #14
	15g - Salinus molis - California Pepper - # 8@90°
	15g - Platanus racemosa - #3
	Apricot - #1
	Apple - #1
	Lemon - #1
	Modesto Ash - # 17
	Acacia - #30
	1g - Pittosporum l. 'Wheeler's Dwarf' - Dwarf Pittosporum
	5g - Abelia g. 'Ed Goucher' - Glossy Abelia
	5g - Dodonaea v. 'Purpurea' - Hop Bush
	5g - Ligustrum japonica - Ligustrum
	1g - Rhipidolepis indica 'Clara' - White Indian Hawthorne
	1g - Hamamelis 'Stella de Oro' - Daylily
	1g - Pittosporum l. 'Veriegata' - Variegated Pittosporum
	Dononaea - # 20

PREPARED	LOS ANGELES COUNTY DEPARTMENT OF PUBLIC WORKS
DATE	10/06/2004
SCALE	
A.S.	SANTA CLARA YARD 21190 Centre Point Parkway Landscaping Plan