



Parcels 1 & 2 as shown in Black quitclaimed by City of L.A. - E-6-18, OR 13380-212
 Parcels 1 & 2 as shown in Red dedicated to City of L.A. - E-6-19, OR 13410-131
 Parcels 1 & 2 as shown in Green quitclaimed to City of L.A. - E-6-20, OR 16013-51, Part 3

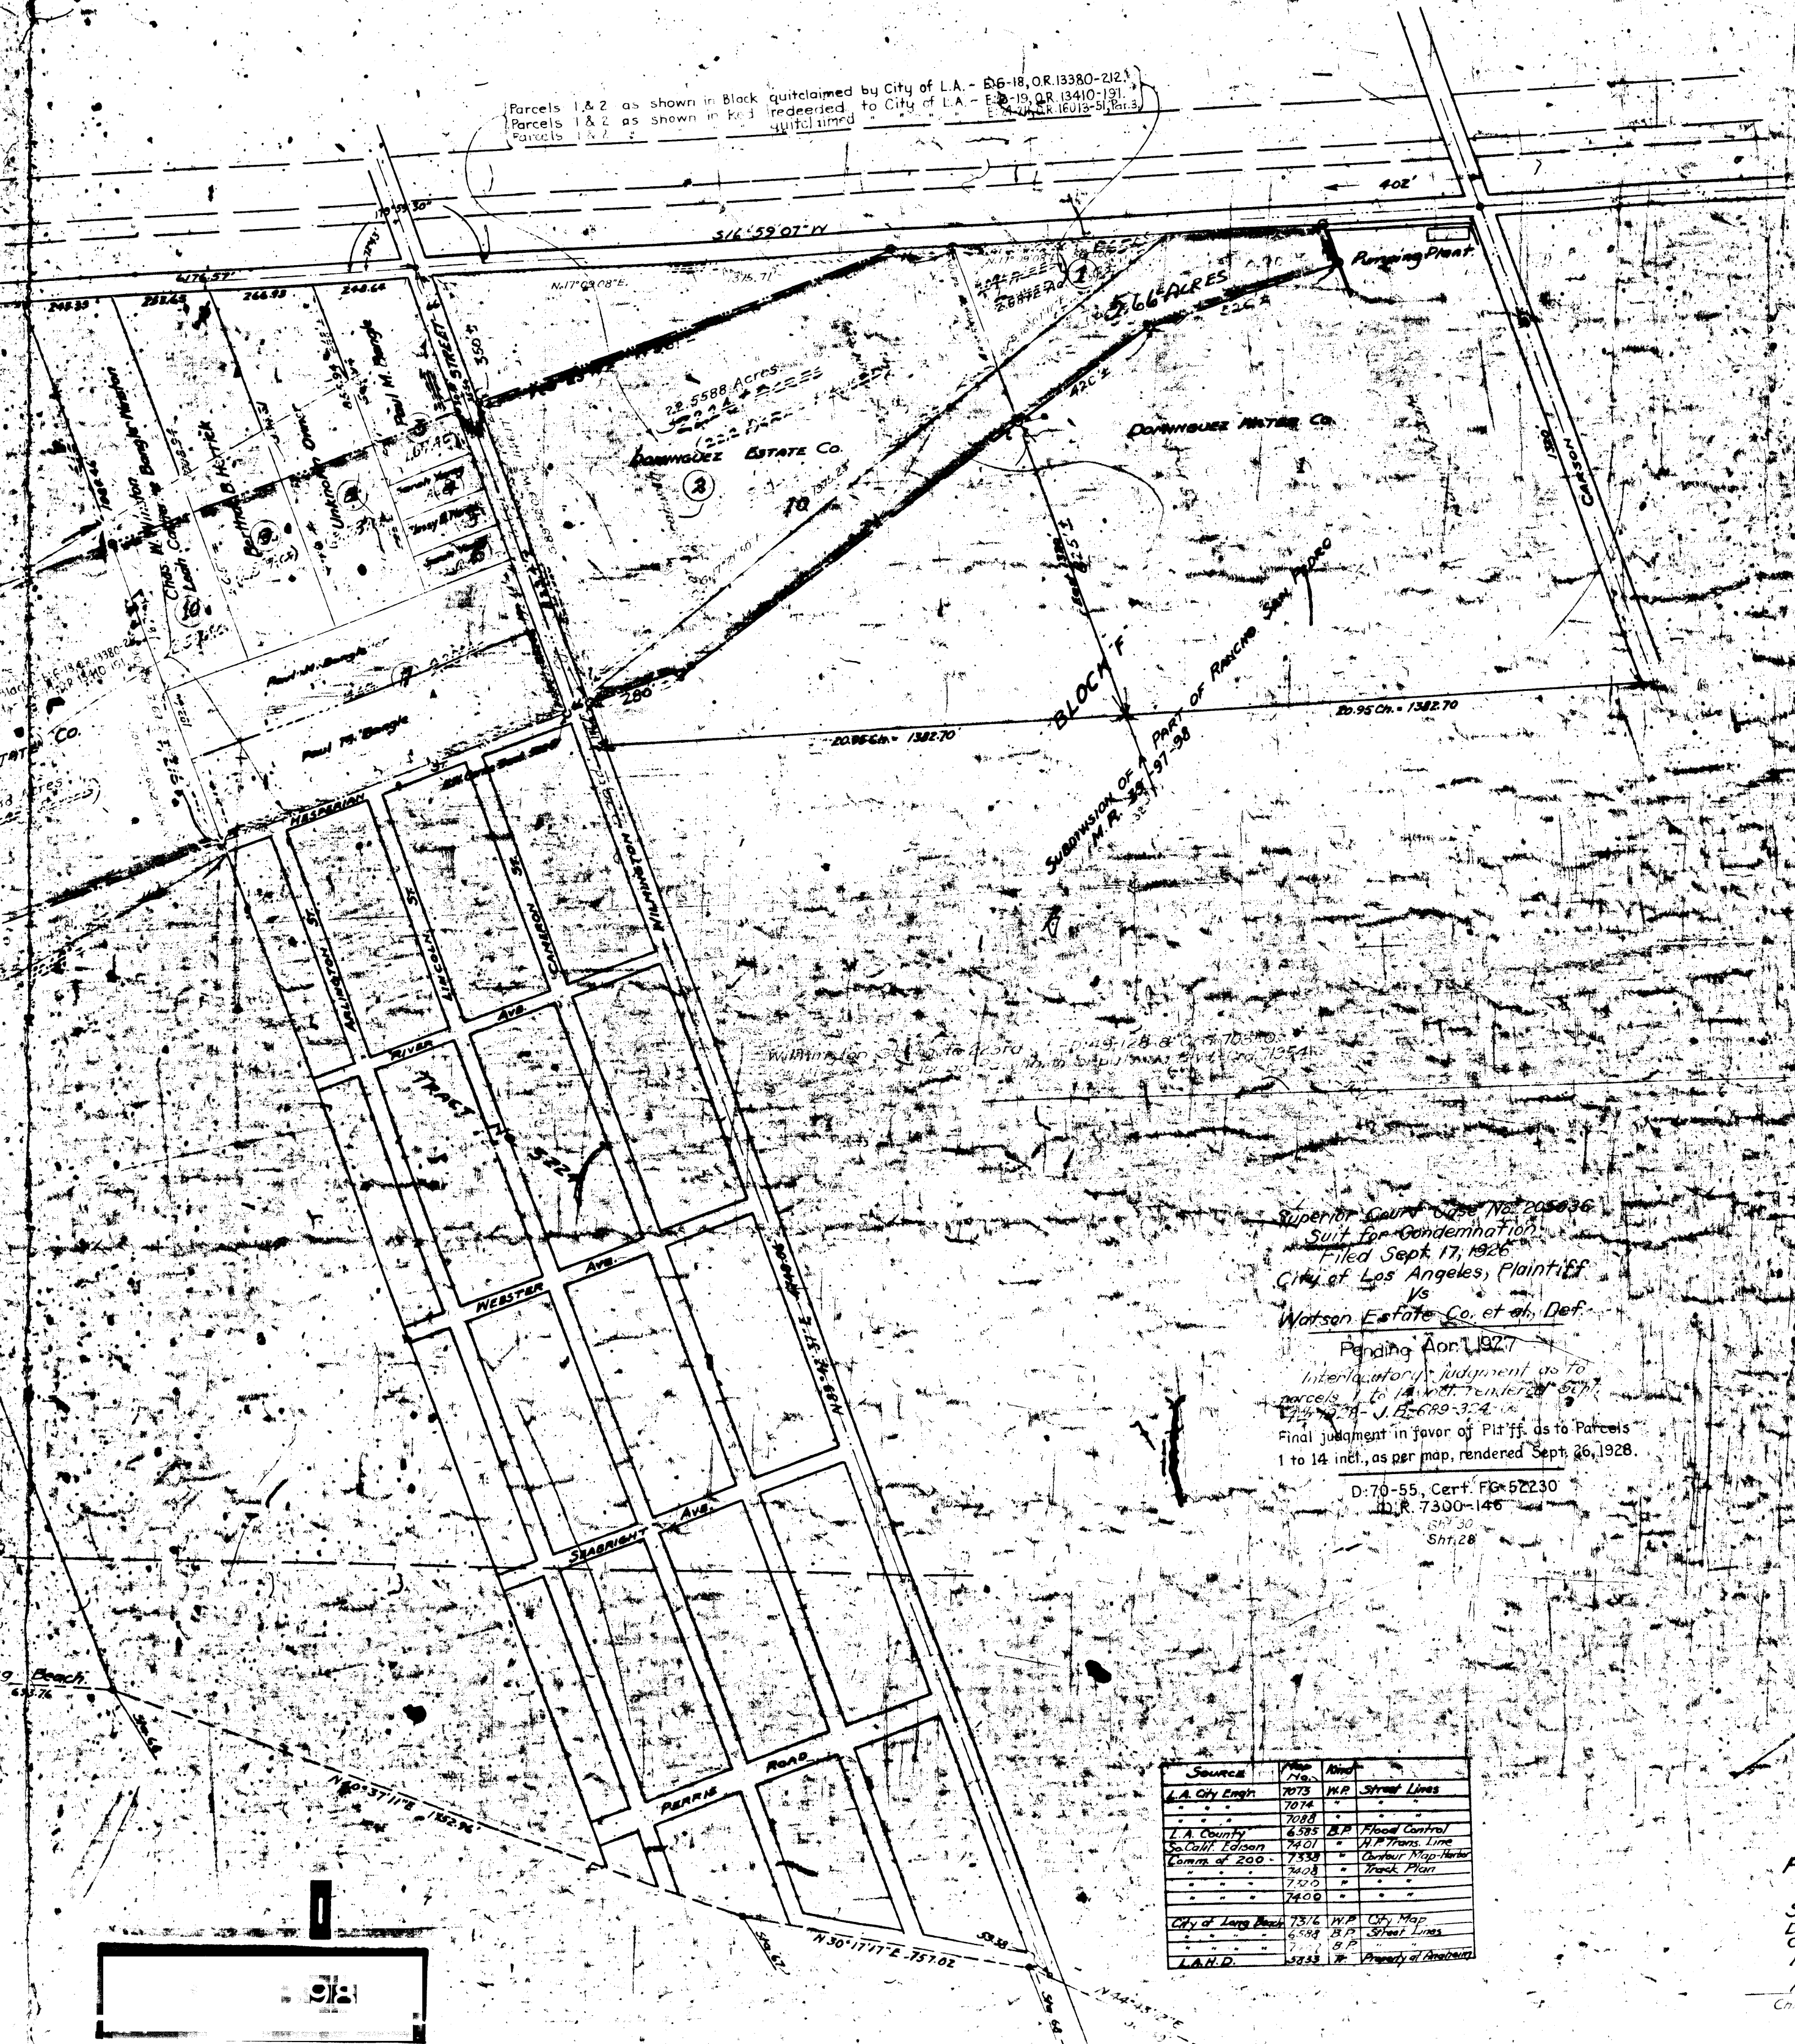



Superior Court Case No. 20536
 Suit for Condemnation
 Filed Sept. 17, 1926
 City of Los Angeles, Plaintiff
 vs
 Watson Estate Co., et al., Def.
 Pending April 1927
 Interlocutory Judgment as to
 parcels 1 to 14 with remainder 8th
 July 24 - J. L. 689-3-4
 Final judgment in favor of Pl. ff. as to parcels
 1 to 14 incl., as per map, rendered Sept. 26, 1928.
 D-70-55, Cert. Fk-52230
 L.R. 7300-146
 Sht. 20
 Sht. 28


Source	Map No.	Kind
L.A. City Engr.	7073	H.P. Street Lines
"	7074	"
"	7088	"
A. County	6885	H.P. Flood Control
San Joaquin	7401	H.P. Trans. Line
Comm. of 200	7338	Survey Map-Harbor
"	7408	Trunk Plan
"	7409	"
"	7400	"
City of Long Beach	7516	H.P. City Map
"	6884	H.P. Street Lines
"	817	"
L.A.D.	5433	H.P. Property of Harbor

City of Los Angeles
 HARBOR DEPARTMENT
 Office of the Harbor Engineer
PROPOSED R. R. YARDS
VICINITY OF WATSON
 Scale 1"=200'
 Drawn-F.B.W.
 Checked-C.R.W.
 Insp. a.m.
 10-20-1925
 R.P. Hayes
 Asst. Harbor Eng.
 Harbor Eng.

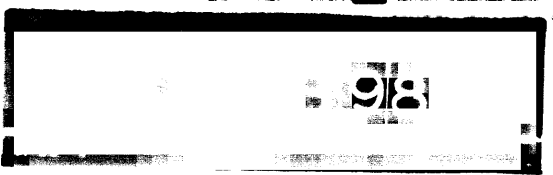

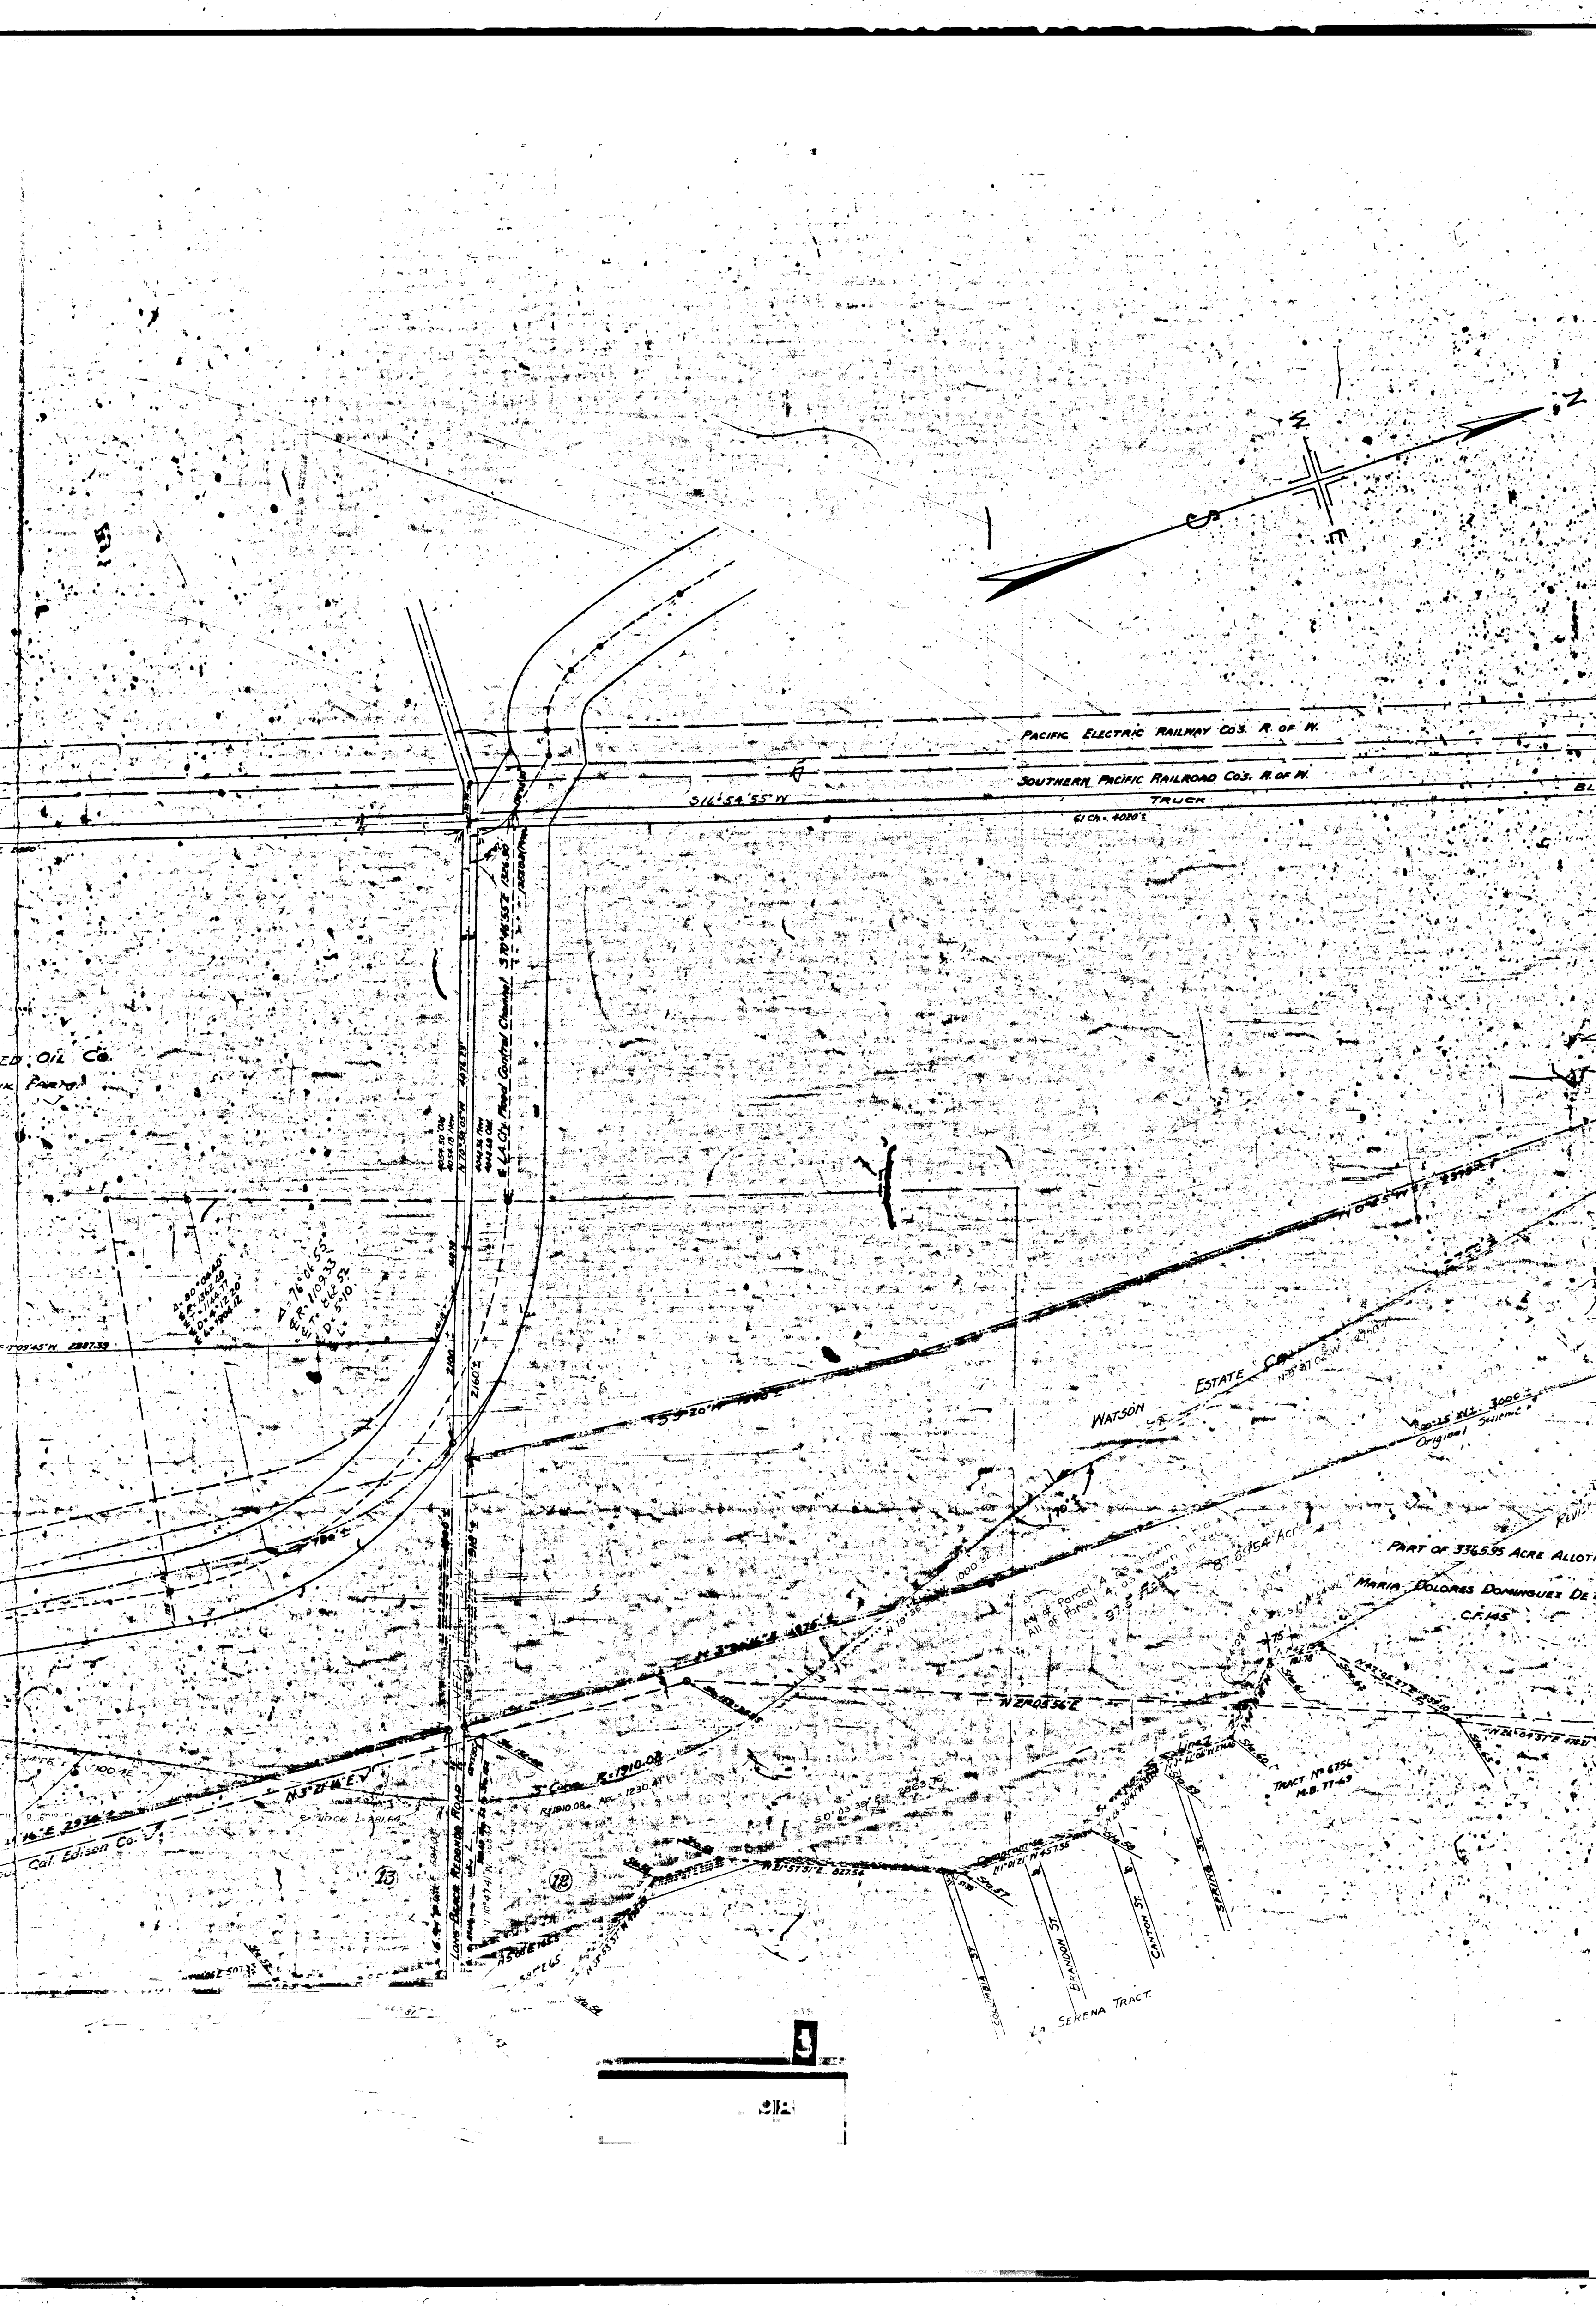

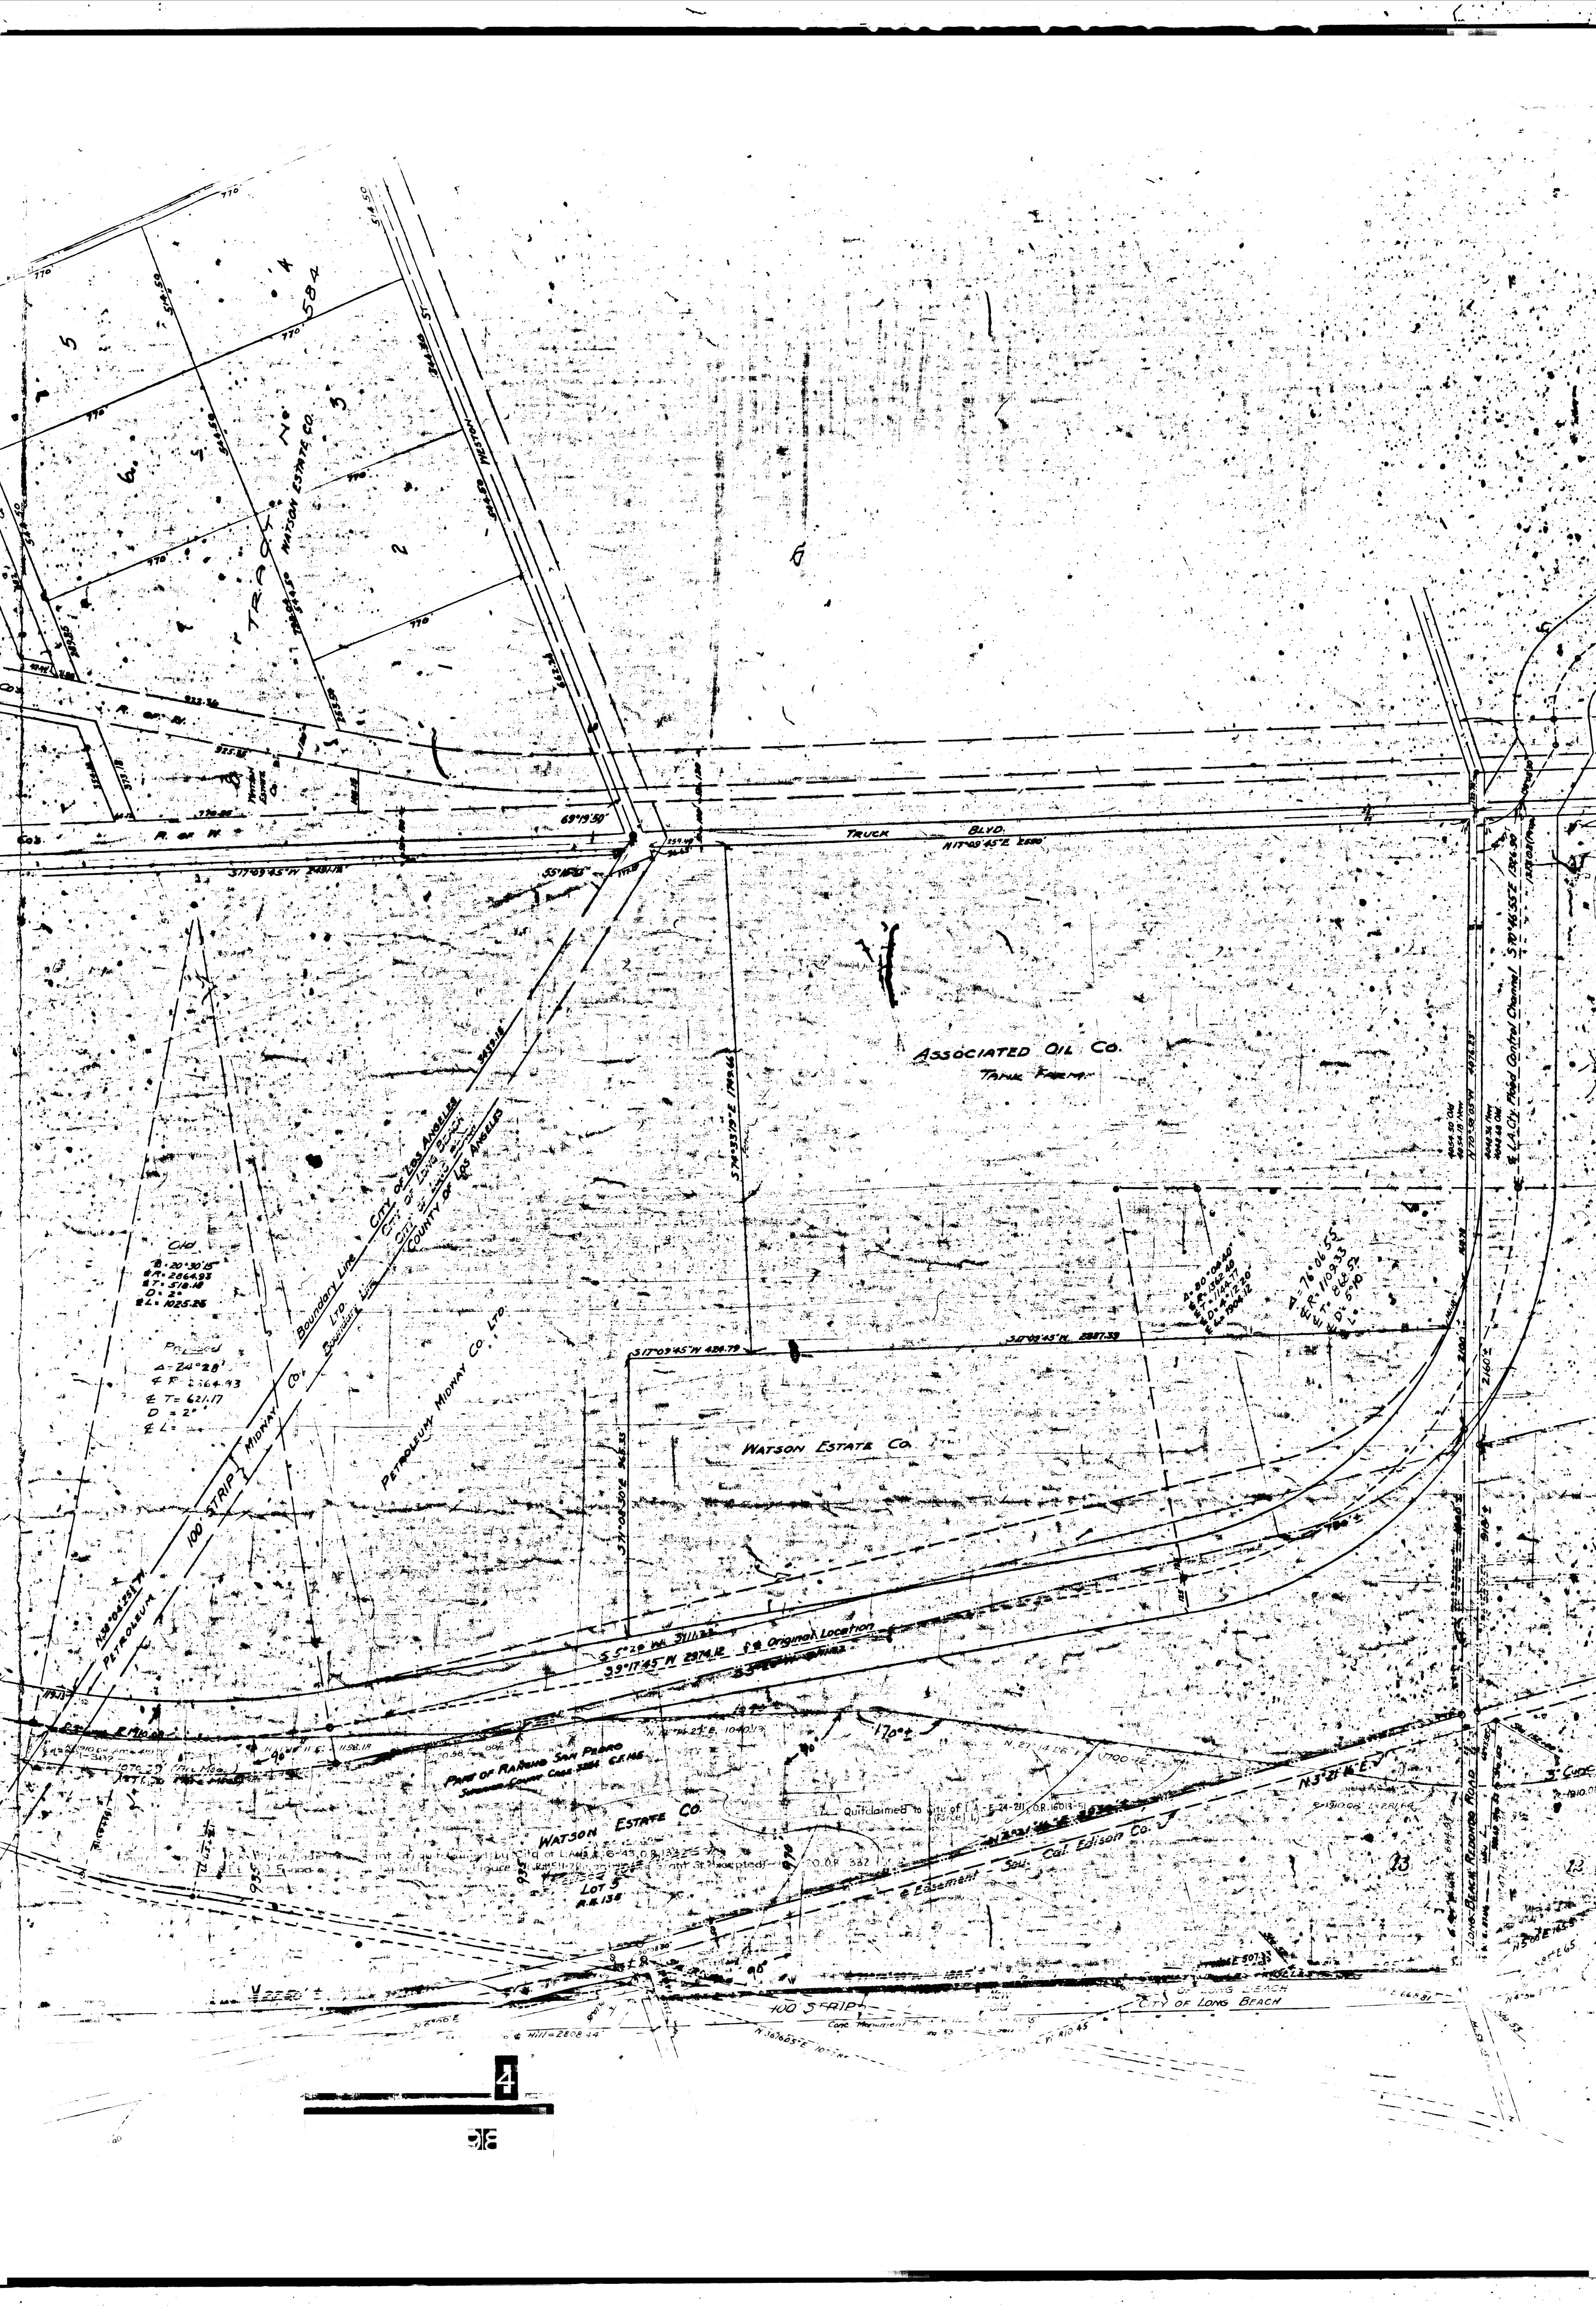

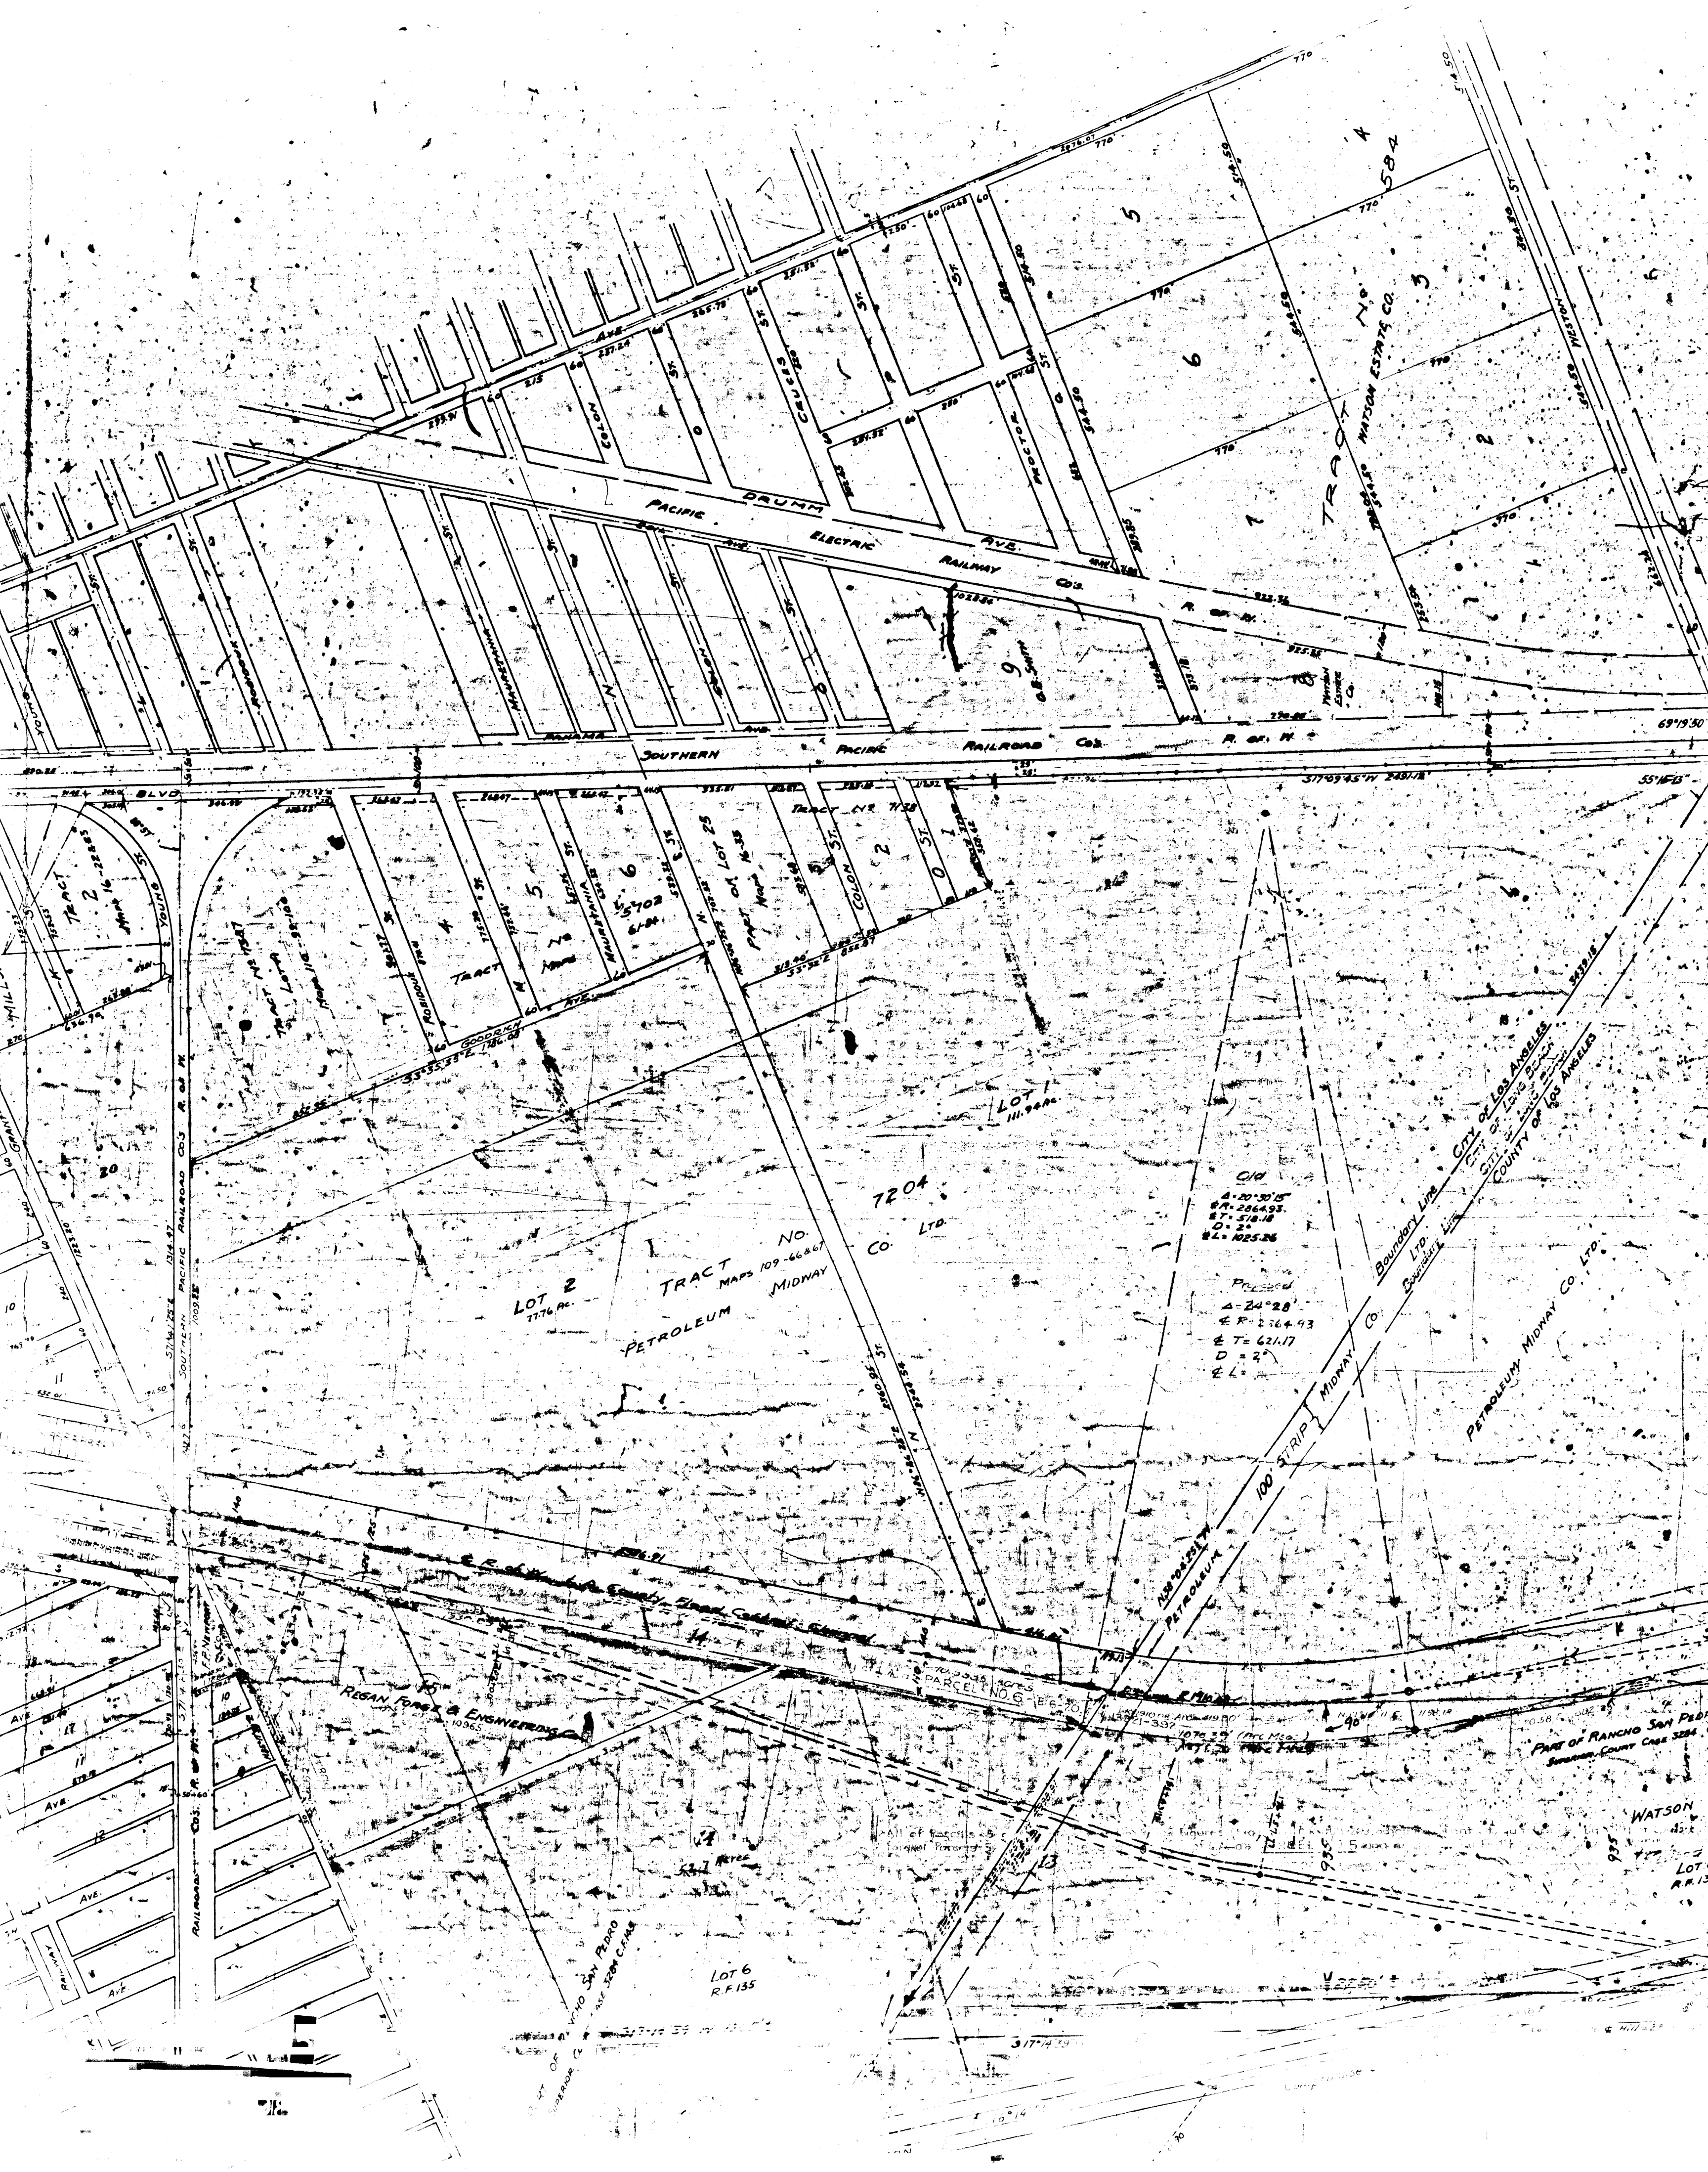

TRACT NO.
109-46 & 67
PETROLEUM
MIDWAY
CO. LTD.

LOT 2
7776 AC.

LOT 1
111,940 AC.

LOT 6
R.F. 135

PROPOSED
A = 24° 28'
B = 2364.93
C = 621.17
D = 2'
E = 1025.26

REGAN PARK & ENGINEERING

PART OF RANCHO SAN PEDRO
SUNSHINE COUNTY CASE 3284

WATSON
LOT
R.F. 13

