

Willow St. changed to 102nd St. D:49-229
 Myers Pl. " " 13th St. " "
 Palm St. " " 104th St. " "

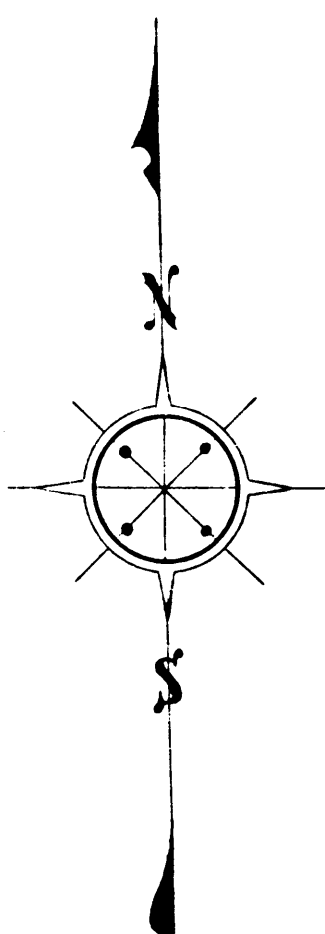


EXHIBIT "A"

ACQUISITION AND IMPROVEMENT DISTRICT NO 56 OF THE COUNTY OF LOS ANGELES FOR THE OPENING EXTENDING AND IMPROVEMENT OF AND WORK UPON **MYERS PLACE**

MAP SHOWING PROPERTY TO BE ACQUIRED IN ACCORDANCE WITH THE PROVISIONS
 OF THE "ACQUISITION AND IMPROVEMENT ACT OF 1925" APPROVED MAY, 23, 1925.
 SCALE 1"=50' JUNE, 1927.

J. E. ROCKHOLD - COUNTY SURVEYOR

LEGEND

LAND SOUGHT TO BE ACQUIRED SHOWN IN RED
 NUMBERS IN CIRCLES INDICATE PARCELS SOUGHT TO BE CONDEMNED
 THE PARCELS ARE DESCRIBED IN PARAGRAPH VII OF THE COMPLAINT
 PORTION COLORED RED SHOWS LOCATION, GENERAL ROUTE AND
 TERMINI OF PUBLIC ROAD TO BE CONDEMNED

*Negative of this map filed
 in Blue Print Dept. as
 Negative No. 191*

*Superior Court Case No. 240687
 Suit for Condemnation
 Filed Dec. 16th 1927
 County of Los Angeles, Plaintiff
 Vs
 Angelus Security Corp. et al, Def.*

A&I DISTRICT NO. 56.		
Drawn By	C.M.R.	June, 1927.
Traced By	C.M.R.	June, 1927.
Checked By	R.B.H.	June, 1927.

C.F. 1529-