

Superior Court Case No. 582988
 Suit for Condemnation
 Filed Feb. 14, 1951
 County of Los Angeles, Plaintiff,
 vs.
 Carl W. Faucett, et al, Defendants.
~~FOR CURRENT STATUS~~
~~SEE INDIVIDUAL PARCELS~~
 Final Judgment in favor of Pltff.
 as to Par. 15-7 rendered Dec. 3, 1952
 E: 124-176, O.R. 40491-386.
 Case dismissed as to Parcels
 15-1 to 15-6, January 13, 1955.
 SEE C.F. 2444 (S.C.C. 597943)
 FOR LATER CONDEMNATION.

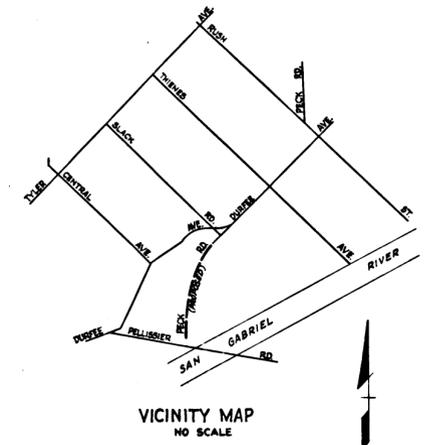


EXHIBIT "A"
 MAP SHOWING PROPERTY TO BE ACQUIRED
 FOR THE OPENING
 OF
PECK ROAD
 C.E.ARNOLD COUNTY SURVEYOR
 DECEMBER 1950

LEGEND
 NUMBERS IN CIRCLES REPRESENT PARCELS SOUGHT TO BE ACQUIRED
 PORTIONS COLORED RED SHOW EASEMENTS SOUGHT TO BE ACQUIRED
 FOR HIGHWAY PURPOSES.

AREAS OF PARCELS SOUGHT TO BE ACQUIRED SHOWN
 THUS: 0000 - AREA OF PARCEL IN SQUARE FEET
 00000 - AREA OF HOLDING IN SQUARE FEET OR ACRES

DRAWN BY	DATE	CHECKED BY	DATE	CALCULATED BY	DATE	CHECKED BY	DATE
RECEI-1150	11-50	FORD-BREEDEN	12-50	RECEI	11-50	BREEDEN	11-50

REFERENCES: ALIGNMENT: C.S.B-2249


TOPOGRAPHY: F.B. 1465-52-56, 176 APPRAISER'S FIELD NOTES

J.N. R-012 INDEX MAP 37 (B-2) ASSESSOR BOOK 810 & 862

PECK ROAD ONE SHEET

C.F. 2337 -

INDEX 37

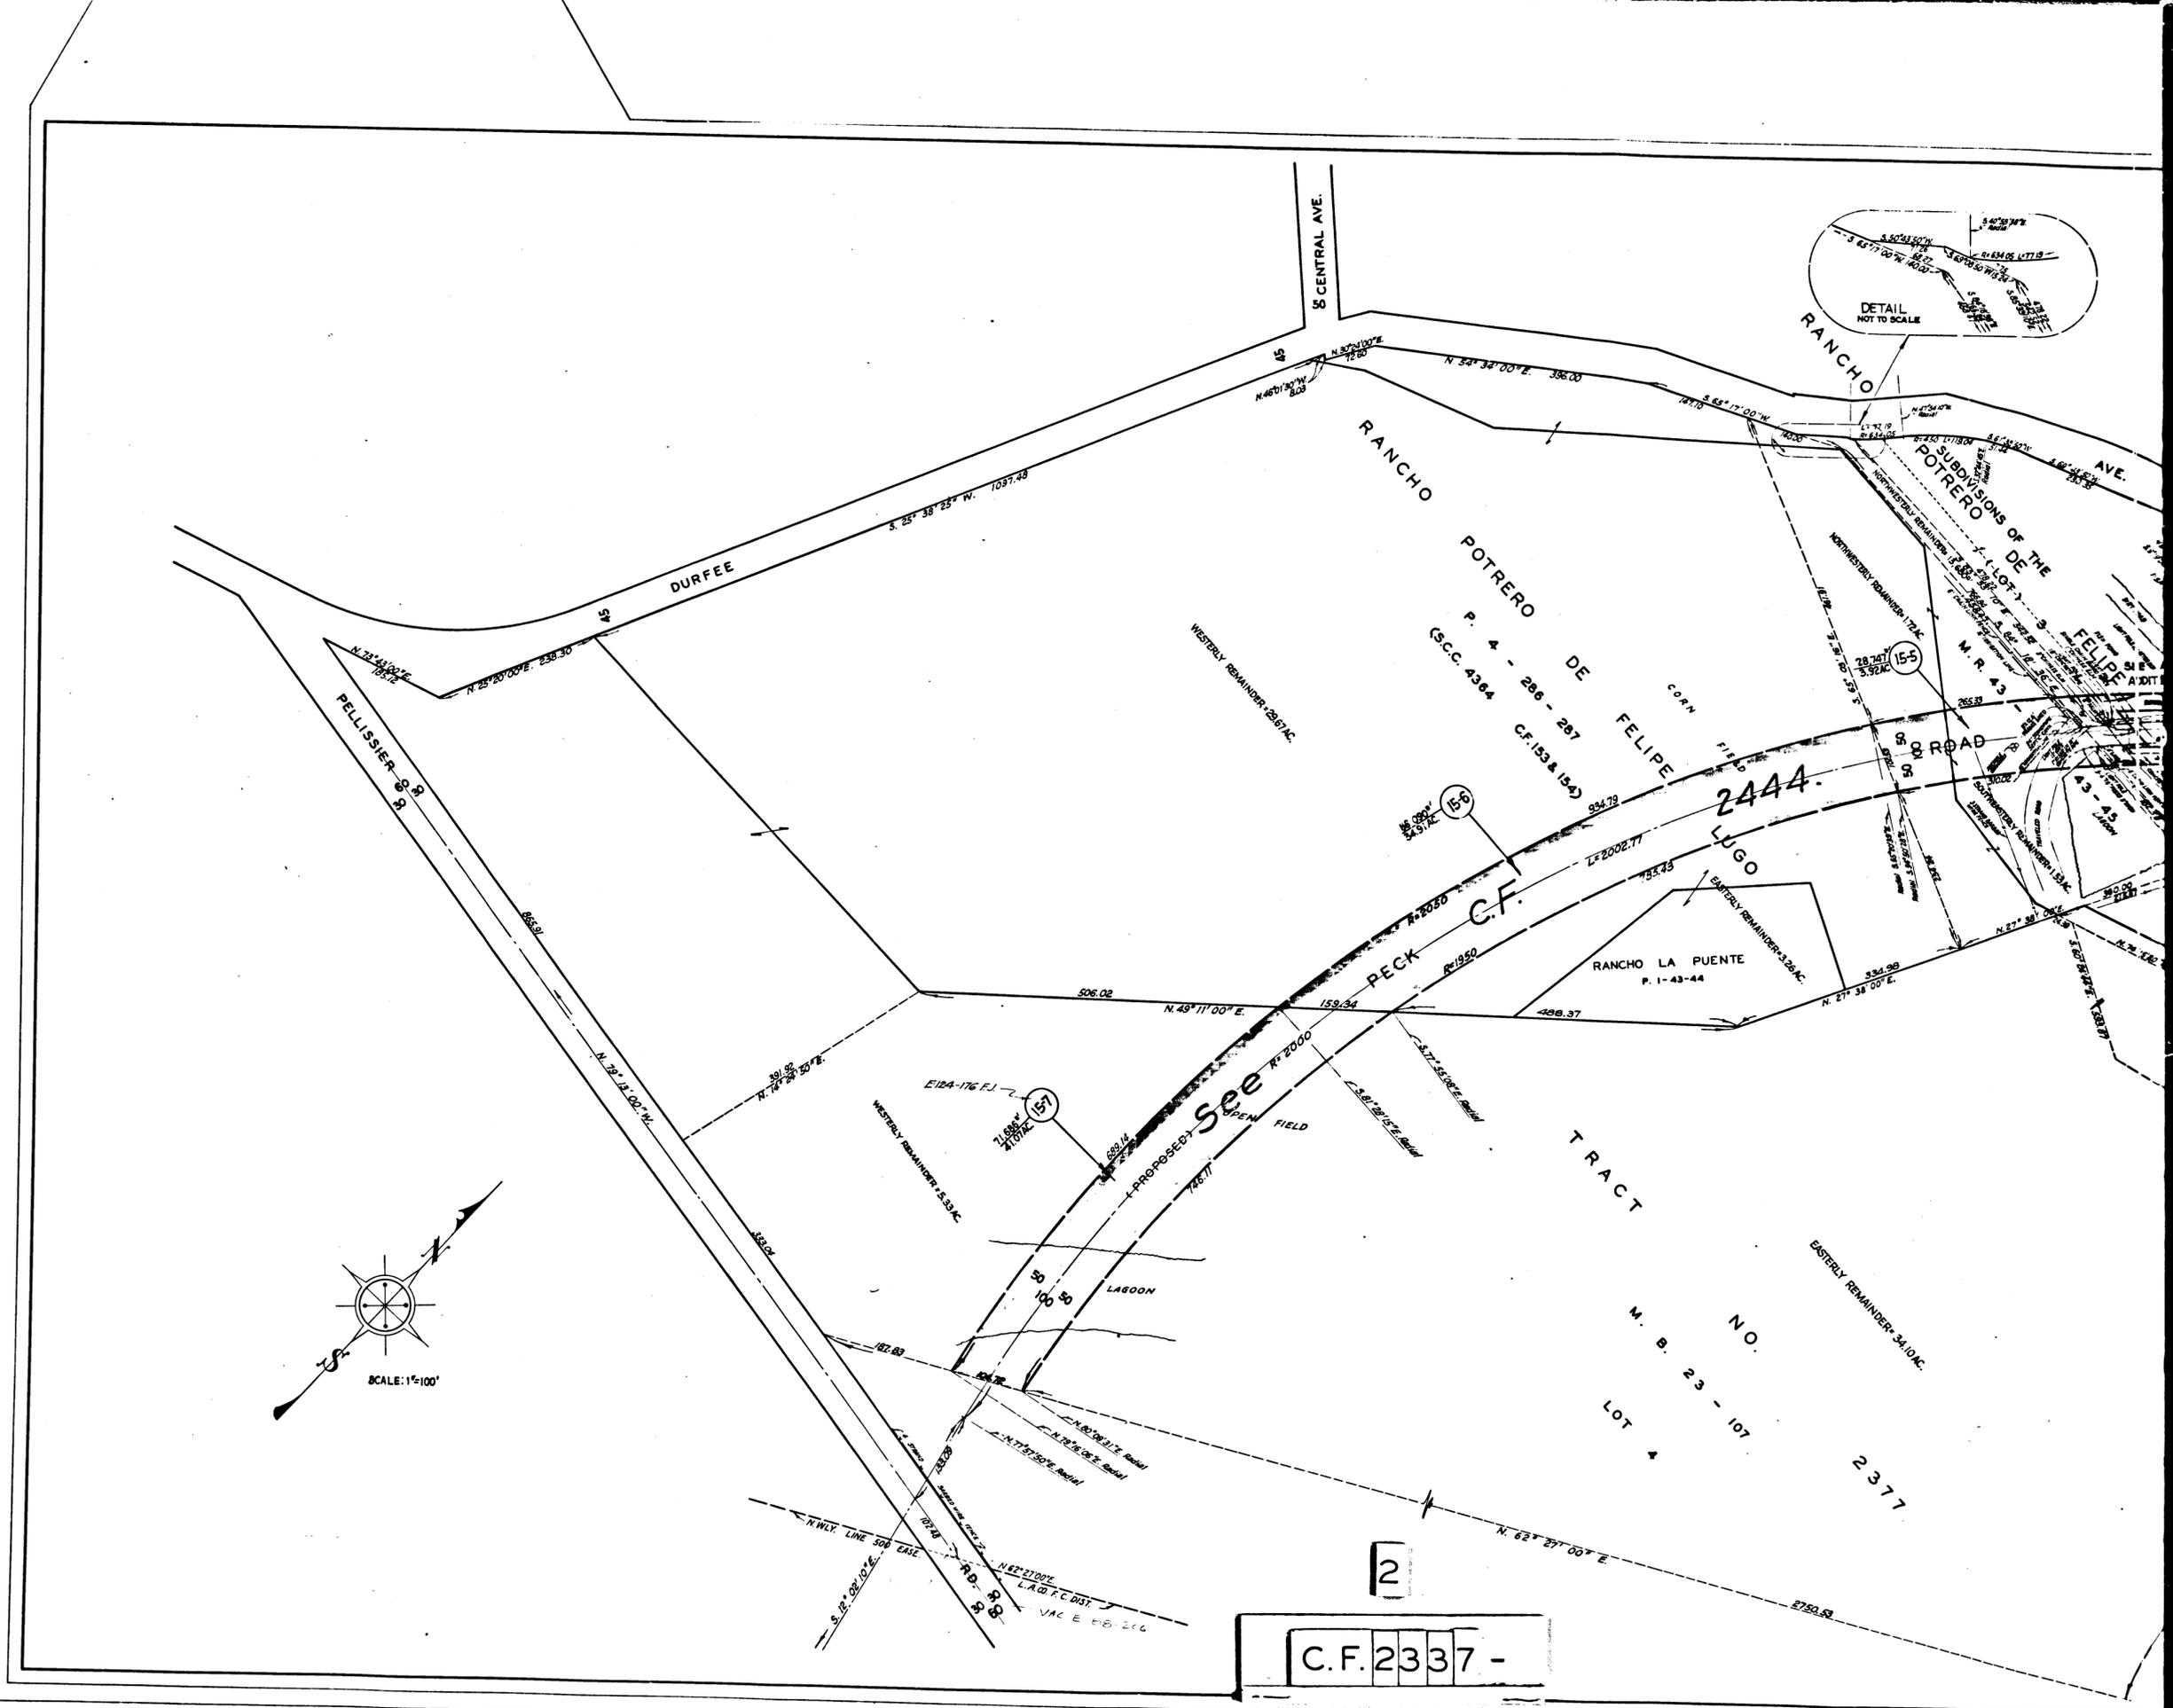

2

C.F. 2337 -