



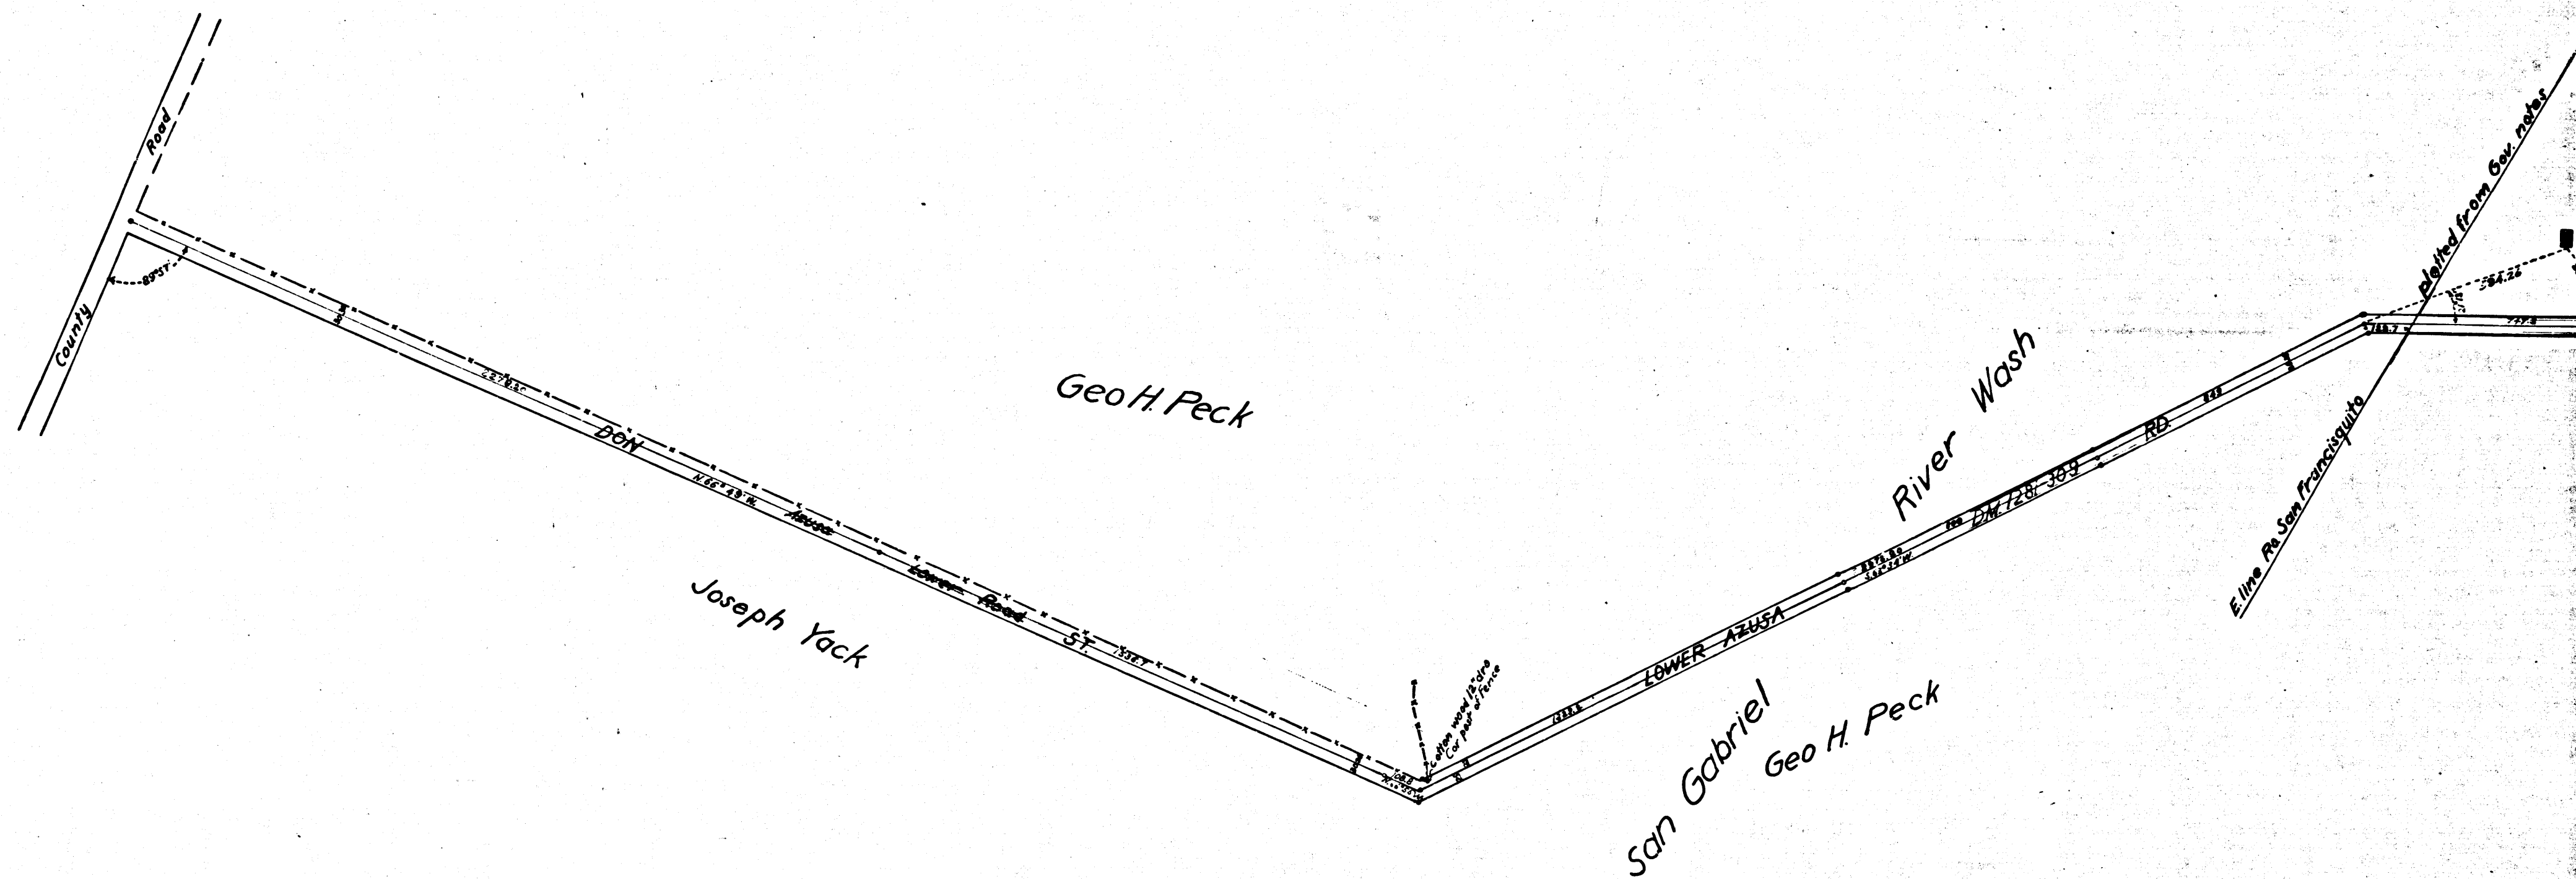

C	S	1	0	3	1
A	1	O	F	A	4

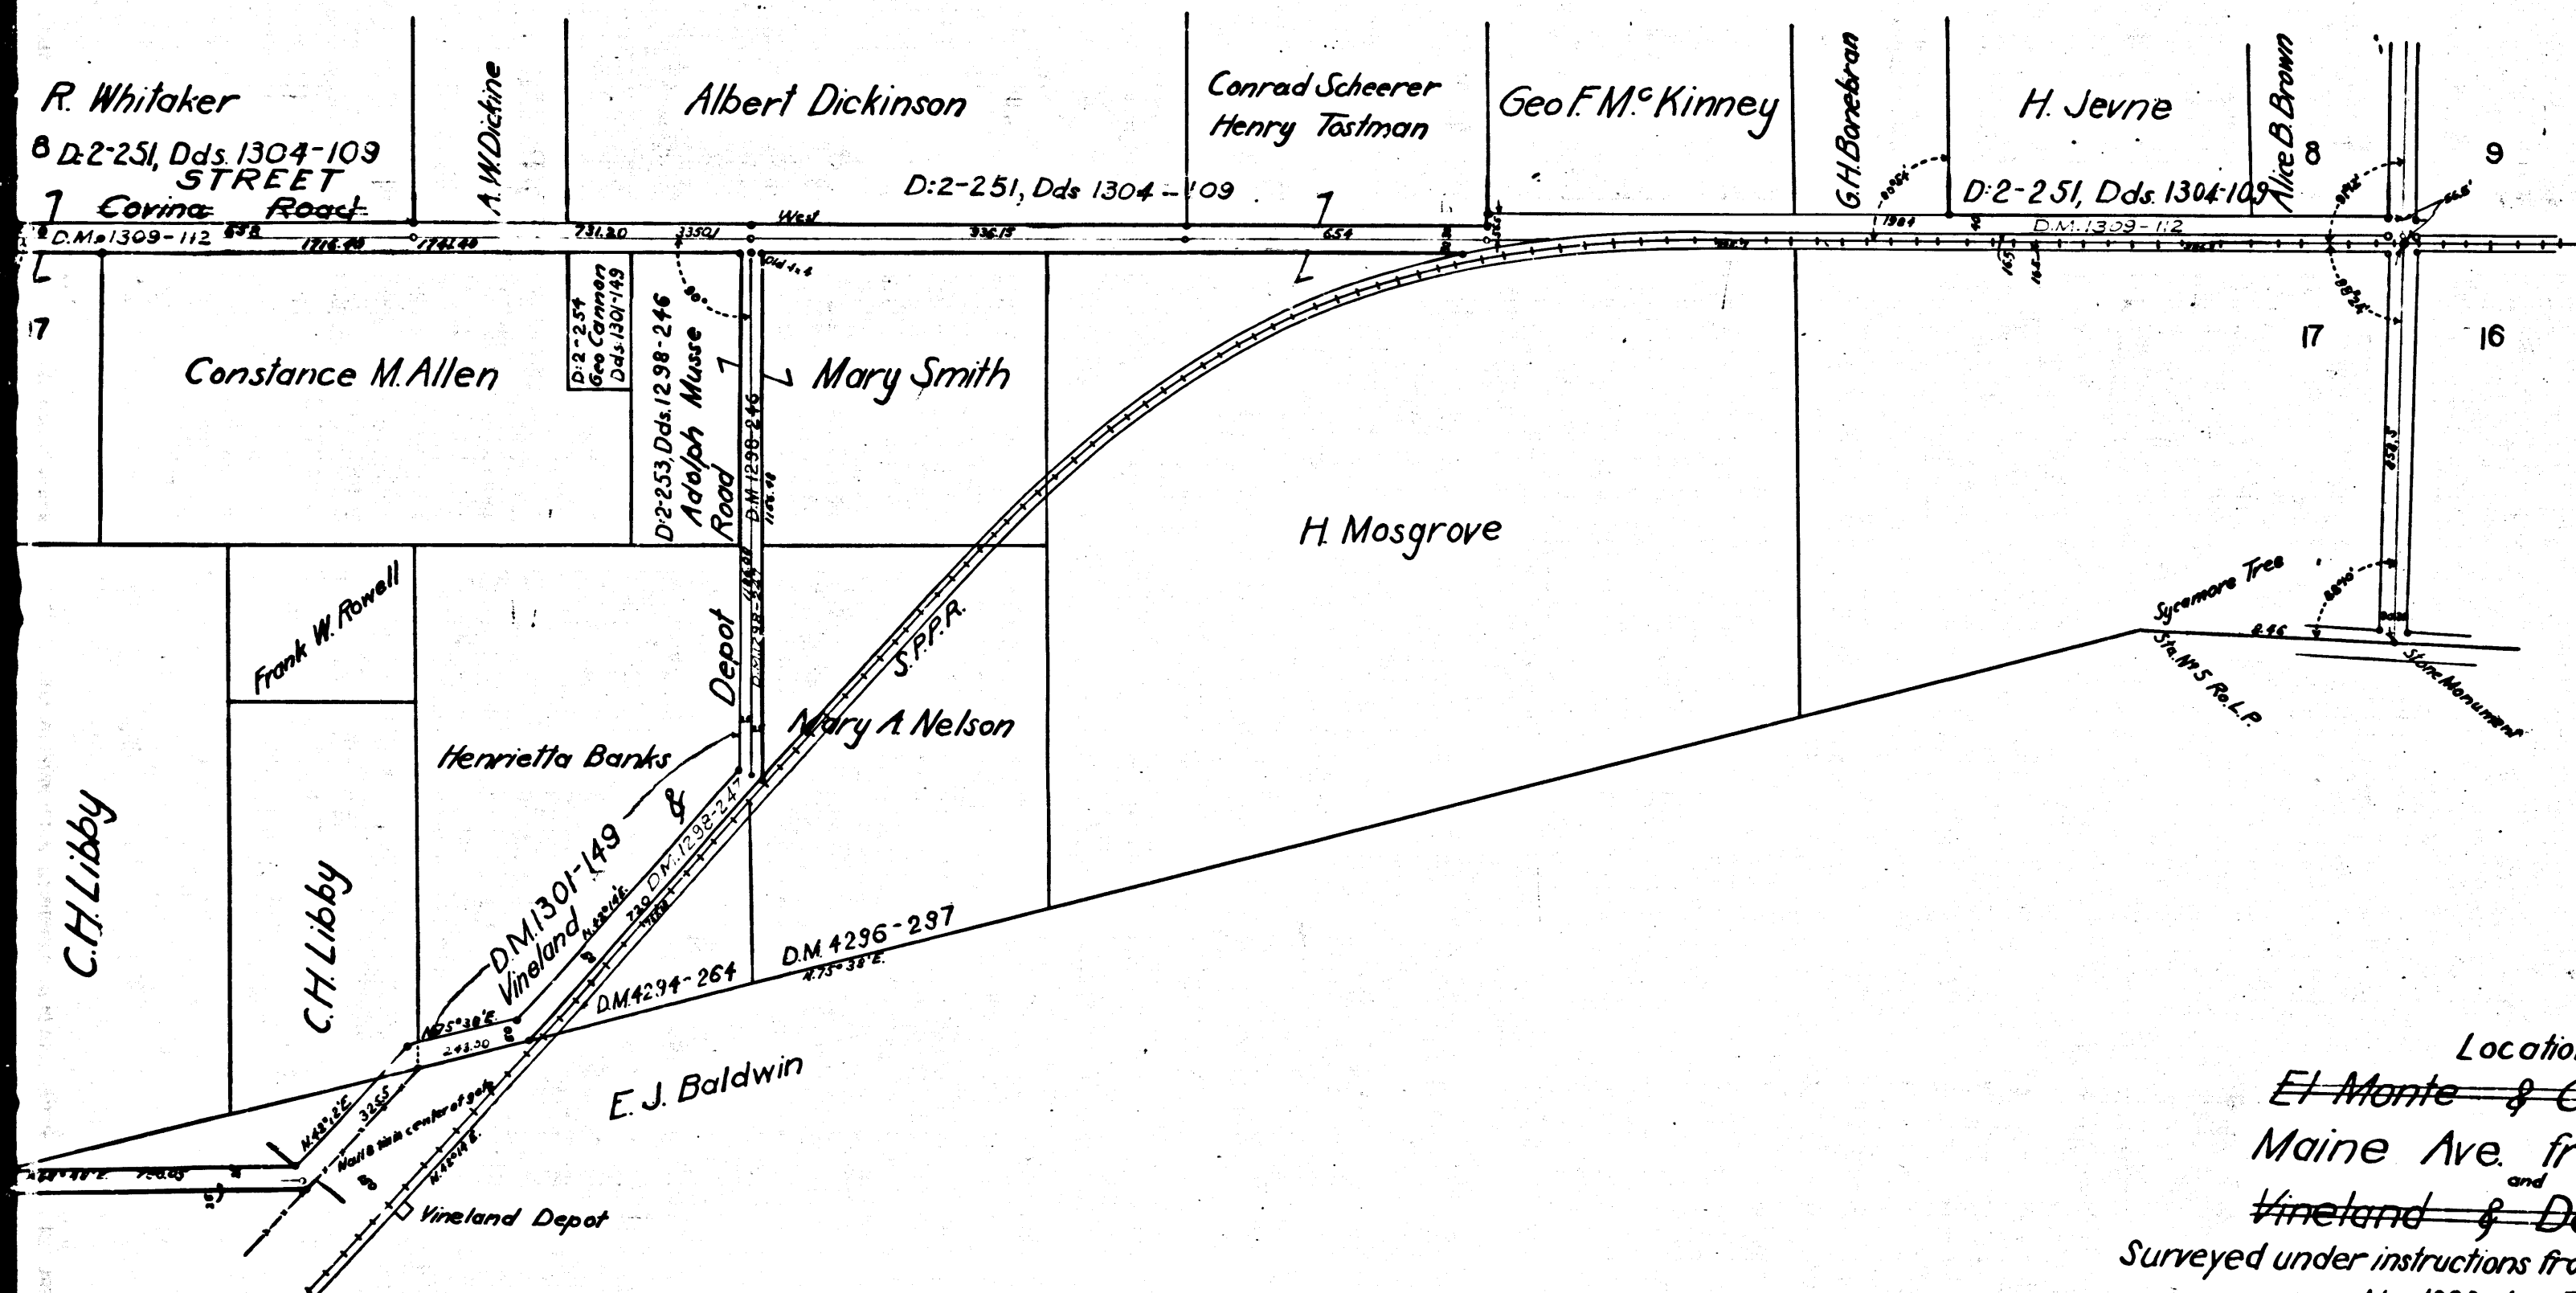

Location of
~~El Monte & Corina Road~~ LOWER AZUSA RD.
 Maine Ave. from Vineland
 and
~~Vineland & Depot Road~~ { Alderson Ave
 Railroad " D:13-4
 Surveyed under instructions from Hon. Board of Supervisors
 Nov 1898 by E.T. Wright Co. Sur.

Scale 1" = 300'
 F.B 20-14 21 to 24

COUNTY SURVEYORS MAP NO. 1031

RETRACED FROM THE CLOTH MOUNTED EGG-SHELL ORIGINAL
 MAP WHICH BEEN FILED AT PACOIMA VAULT.

RETRACED BY TOM KARDOS

FEB. 18, '57

CHECK BY R.J. Black
 Index 46

CS	1031
A4	OF A4