

LOT 22.

LOT 23.

LOT 24.

LOT 25

LOT 29.

S. P. R. R.
Old Santa Monica Branch.

PART LOT!
MR22-20

MAP OF ST.
~~HIGUERA ROAD~~
~~OR VALLEY ROAD~~
IN RANCHO RINCON DE LOS BUEYES.

July 1911.

AND
RODEO RD
Ivor B. Noble

L.B. 38-49
Scale 1" = 100'.

County Surveyor.

Skeggs
Rothenburg.

707

LOT 8.

LOT 9.

LOT 10.

LOT 12

SUB OF THE SOUTHERN PORTION OF THE
RANCHO RINCON DE LOS BUEYES

MR 53-25.

LOT 5.

LOT 6.

LOT//

107 14.

C S T 7 7 5 5

A1 OF A2

LOT 23.

LOT 24.

LOT 25.

LOT 29.

S.P.R.R.
Old Santa Monica Branch.

MAP OF ST.
HIGUERA ROAD
OR VALLEY ROAD
IN RANCHO RINCON DE LOS BUEYES.

July 1911.

RODEO RD.
Ivory B. Noble.

L.B. 38-49.
Scale 1"=100'.

County Surveyor.

Stegge
Rosenburg
Koch
Wattles

LM 22

LOT 9.

LOT 10.

LOT 12.


SUB OF THE SOUTHERN PORTION OF THE
RANCHO RINCON DE LOS BUEYES

MR 53-25.

LOT 11.

HIGUERA

ROAD ST.

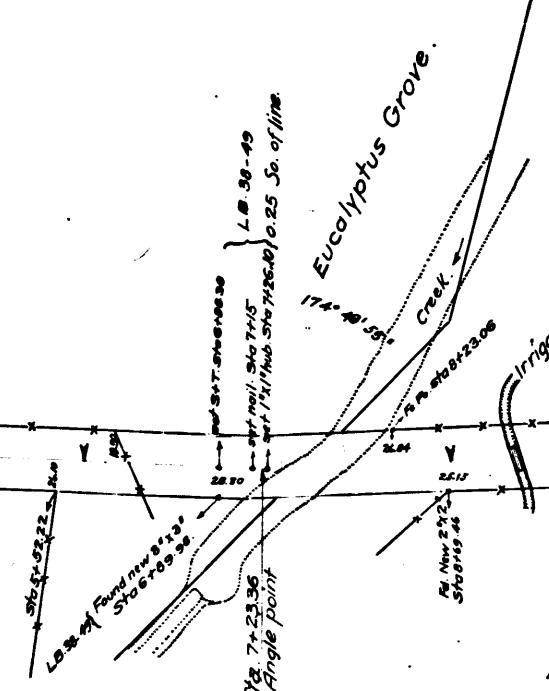

LOT 14.

MOYNIERS TRACT

MB 5-115.

LOT 1

CS 7755

A2 OF A2

RANCHO CINEGA OR PASO DE LA TIJERA.

RANCHO CINEGA OR PASO DE LA TIJERA.