


SCALE 1"=50'

MAP OF ~~BLVD ROAD~~
LAUREL CANYON
THROUGH
BUNGALOW LAND AND TRACT No 1042
SHOWING
LINE OF EASTERLY SIDE OF CONCRETE RETAINING WALL
CONSTRUCTED IN 1915

IVORY B NOBLE COUNTY SURVEYOR
Scale, 1 in. = 50 Ft. October 30, 1915

FB. 48-50-55
Field work by Hamilton.
Office work by Marsh.
Checked by Alvarren.

NOTE.- Courses on this map are based on bearings of E of

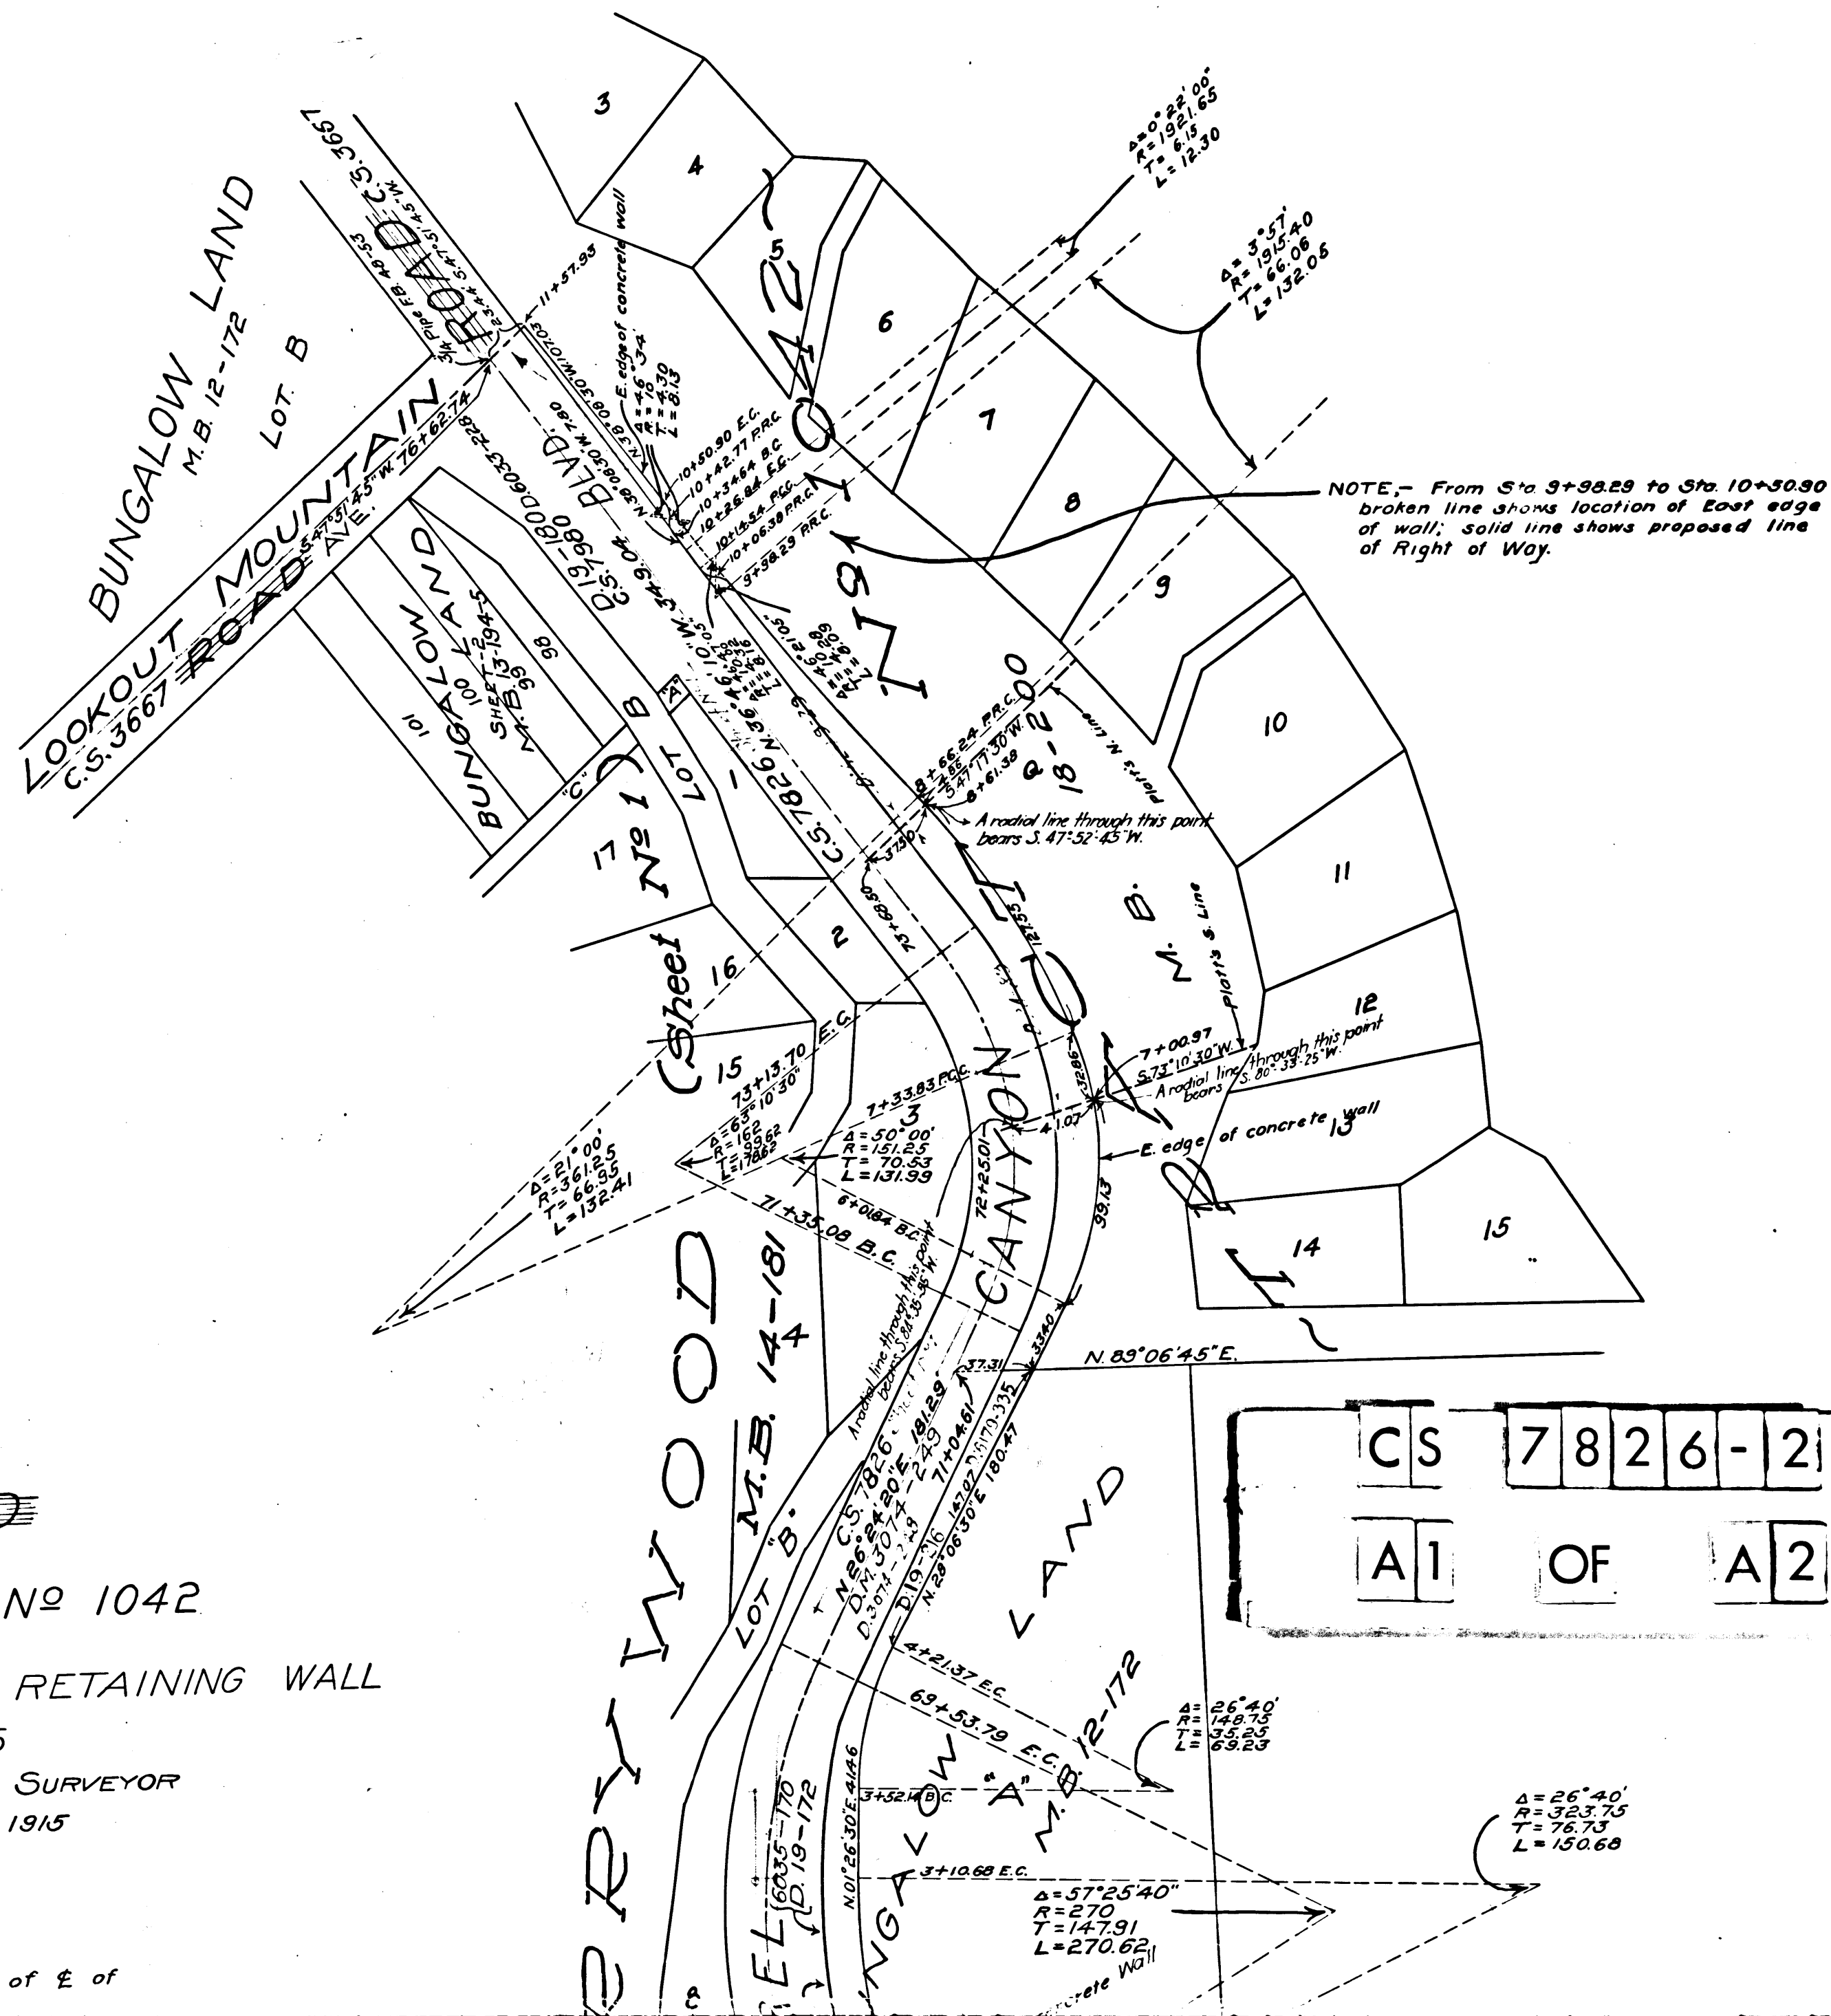

MAP OF
LAUREL CANYON ~~BLVD~~ ROAD
THROUGH
BUNGALOW LAND AND TRACT N^o 1042
SHOWING
LINE OF EASTERLY SIDE OF CONCRETE RETAINING WALL
CONSTRUCTED IN 1915

IVORY B NOBLE COUNTY SURVEYOR

Scale, 1 in. = 50 Ft.

October 30, 1915

F.B. 48-50-55

Field work by Hamilton.

Office work by Marsh.


Checked by *Alvarren*.

NOTE, - Courses on this map are based on bearings of $\frac{1}{2}$ of
Laurel Canyon Road as per C.S. Map N^o 7826

NOTE, - Original Survey of Laurel Canyon Road
made by County Surveyor per C.S. Map N^o 7826
Survey for concrete wall made by County
Road Dept. per F.B. 48-50-55
Map made by County Surveyor.

Laurel Canyon Rd. chg. to Laurel Canyon Blvd. - Ord. 72046.

I.M. 22

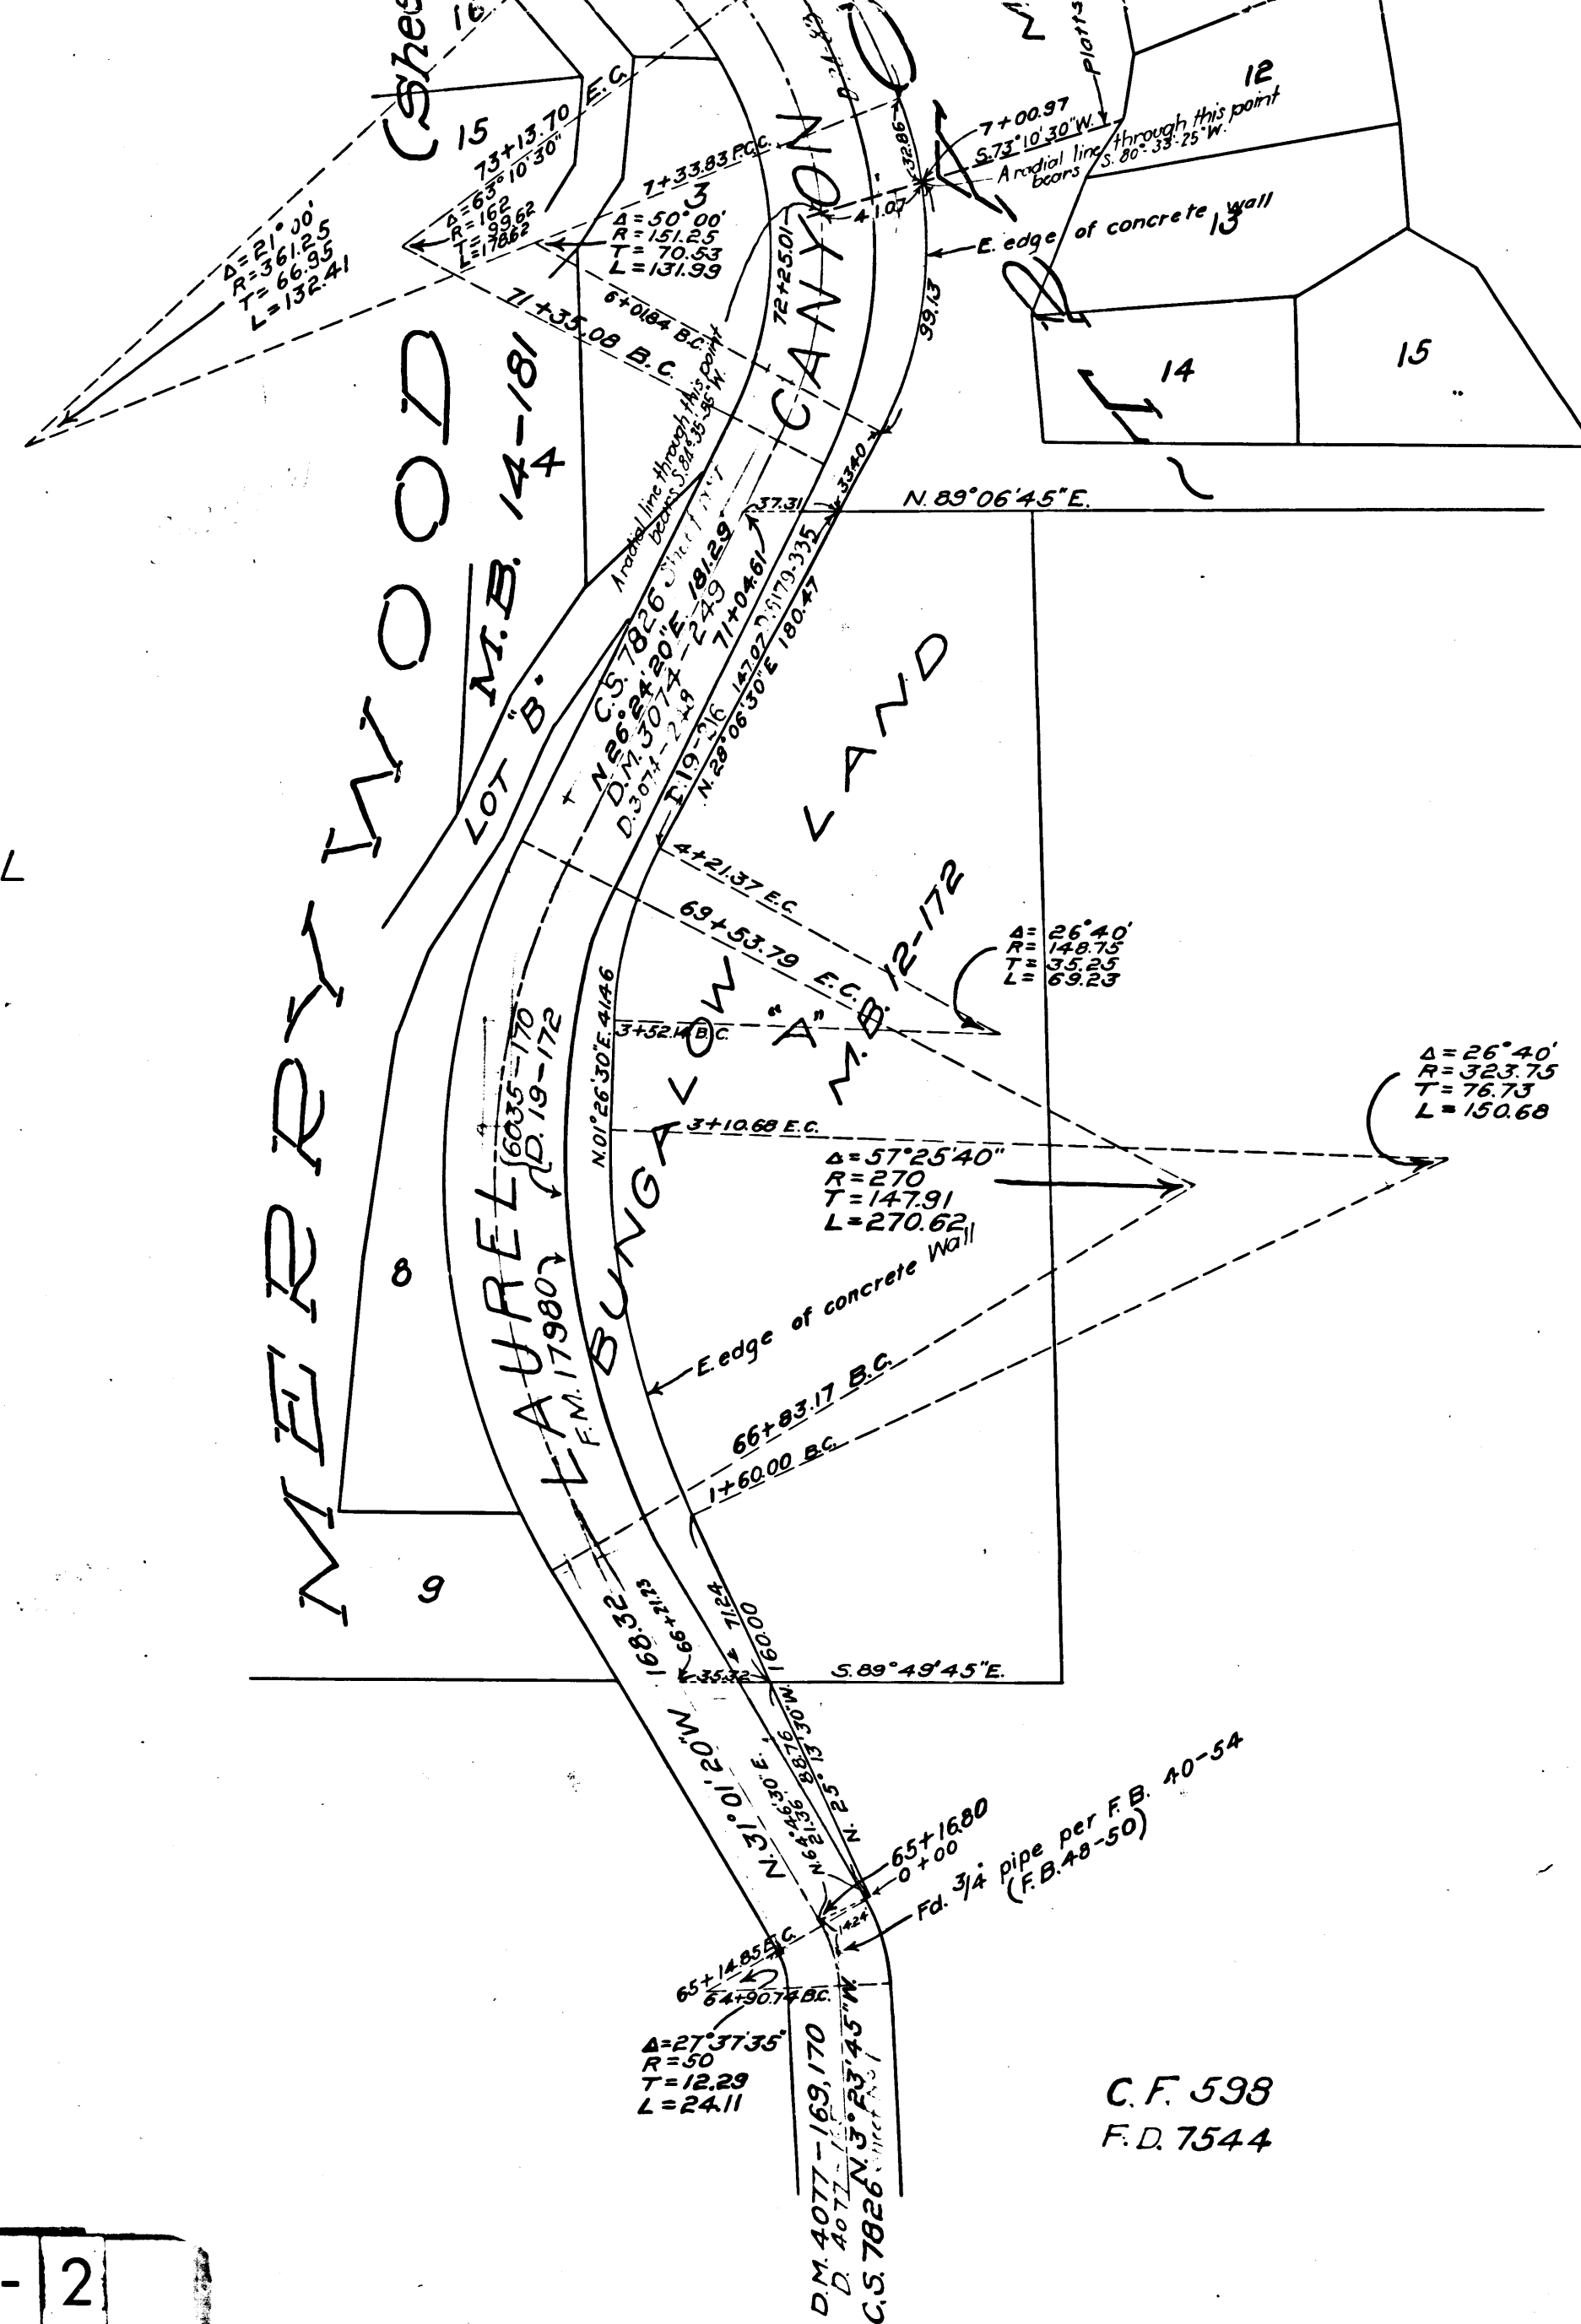

NE $\frac{1}{4}$, SW $\frac{1}{4}$, OF SEC. 5, T. 1 S., R. 14 W.

CS 7826-2
A2 OF A2

C.F. 598
F.D. 7544