


For vacation of por. of Lots "A", 1 to 7 incl. and a por. of Lot 11 Blk. 52 lying Wly of the above line shown in red, see D:26-196 C.R. 1574-190 R.B. 24-77.
 Laurel Canyon Rd. chg. to Laurel Canyon Blvd. - Ord. 72046.

C	S	7	8	2	6	-	3
A	1	OF	A	2			

Scale: 1"=60'

Plotted by G.M. Morgan 7/10/22
Checked by J.K. Skinner 7/11/22

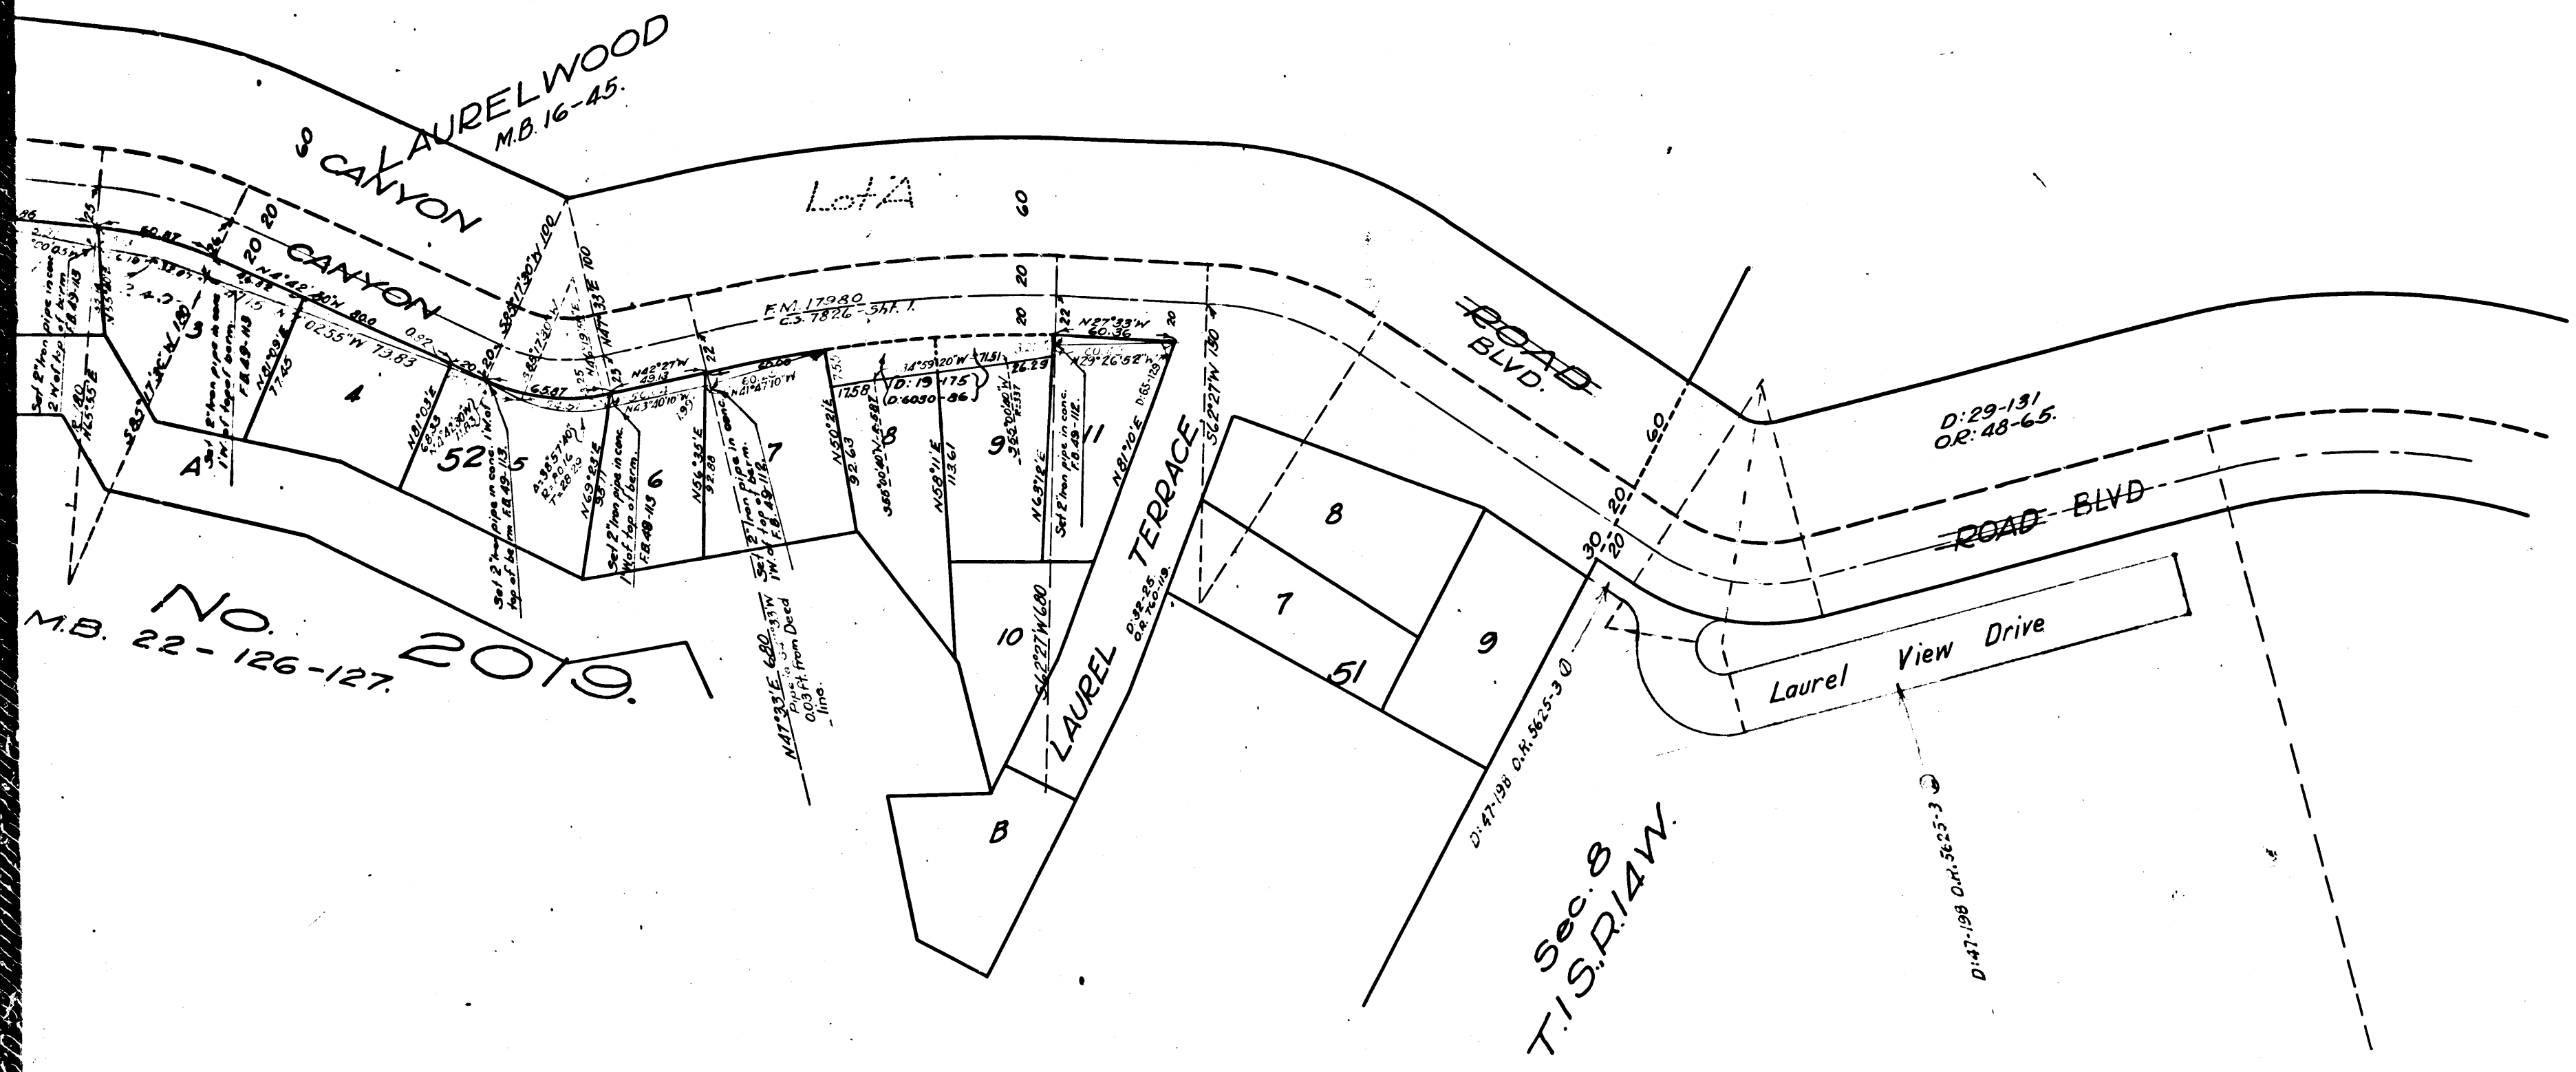

No. 2019
M.B. 22-126-127

Sec. 8
T. 1 S. R. 14 W.

of por. of Lots A, 1 to 7 incl. and a por. of Lot 11 Blk. 52 lying Wly of the above line
see D: 25-196 C.R. 1574-190 R.B. 24-77.
yon Rd. chg. to Laurel Canyon Blvd. - Ord. 72046.

C	S	7	8	2	6	-	3
A	2	OF	A	2			