

RAN

30
29
31
32
T.1S. R.16W.

PACIFIC

OCEAN

CREEK

TOPANGA

FOR NEW ALIGNMENT SEE FM 11510

CS	7915	
A1	OF	A5

MAP OF
TOPANCA CAÑON ROAD
BLVD.
FROM PACIFIC OCEAN TO GARAPATA CAÑON

Sept. 1913

Ivory Noble


County Surveyor

Scale: 1 in. = 200 ft.
(Scale maps - 1 in. = 100 ft.)
FB 49-2637
FB 50-2412

Bearings established by Solar Observation on tangent to curve (B.C. = 74° 42' 55"); (Course S 88° 43' 10" W)
For profile see ~~FB 49-2637~~ discarded
For cross sections see ~~FB 49-2637~~ discarded

FIELD WORK
OFFICE WORK
CHECKED BY
NEG. 562
INDEX 58 & 89
Shops
Black Moyer
Topanga Canyon Rd changed to Topanga Canyon Blvd D-48-202

SEC. 19
T. 15. R. 16 W
SEC. 30

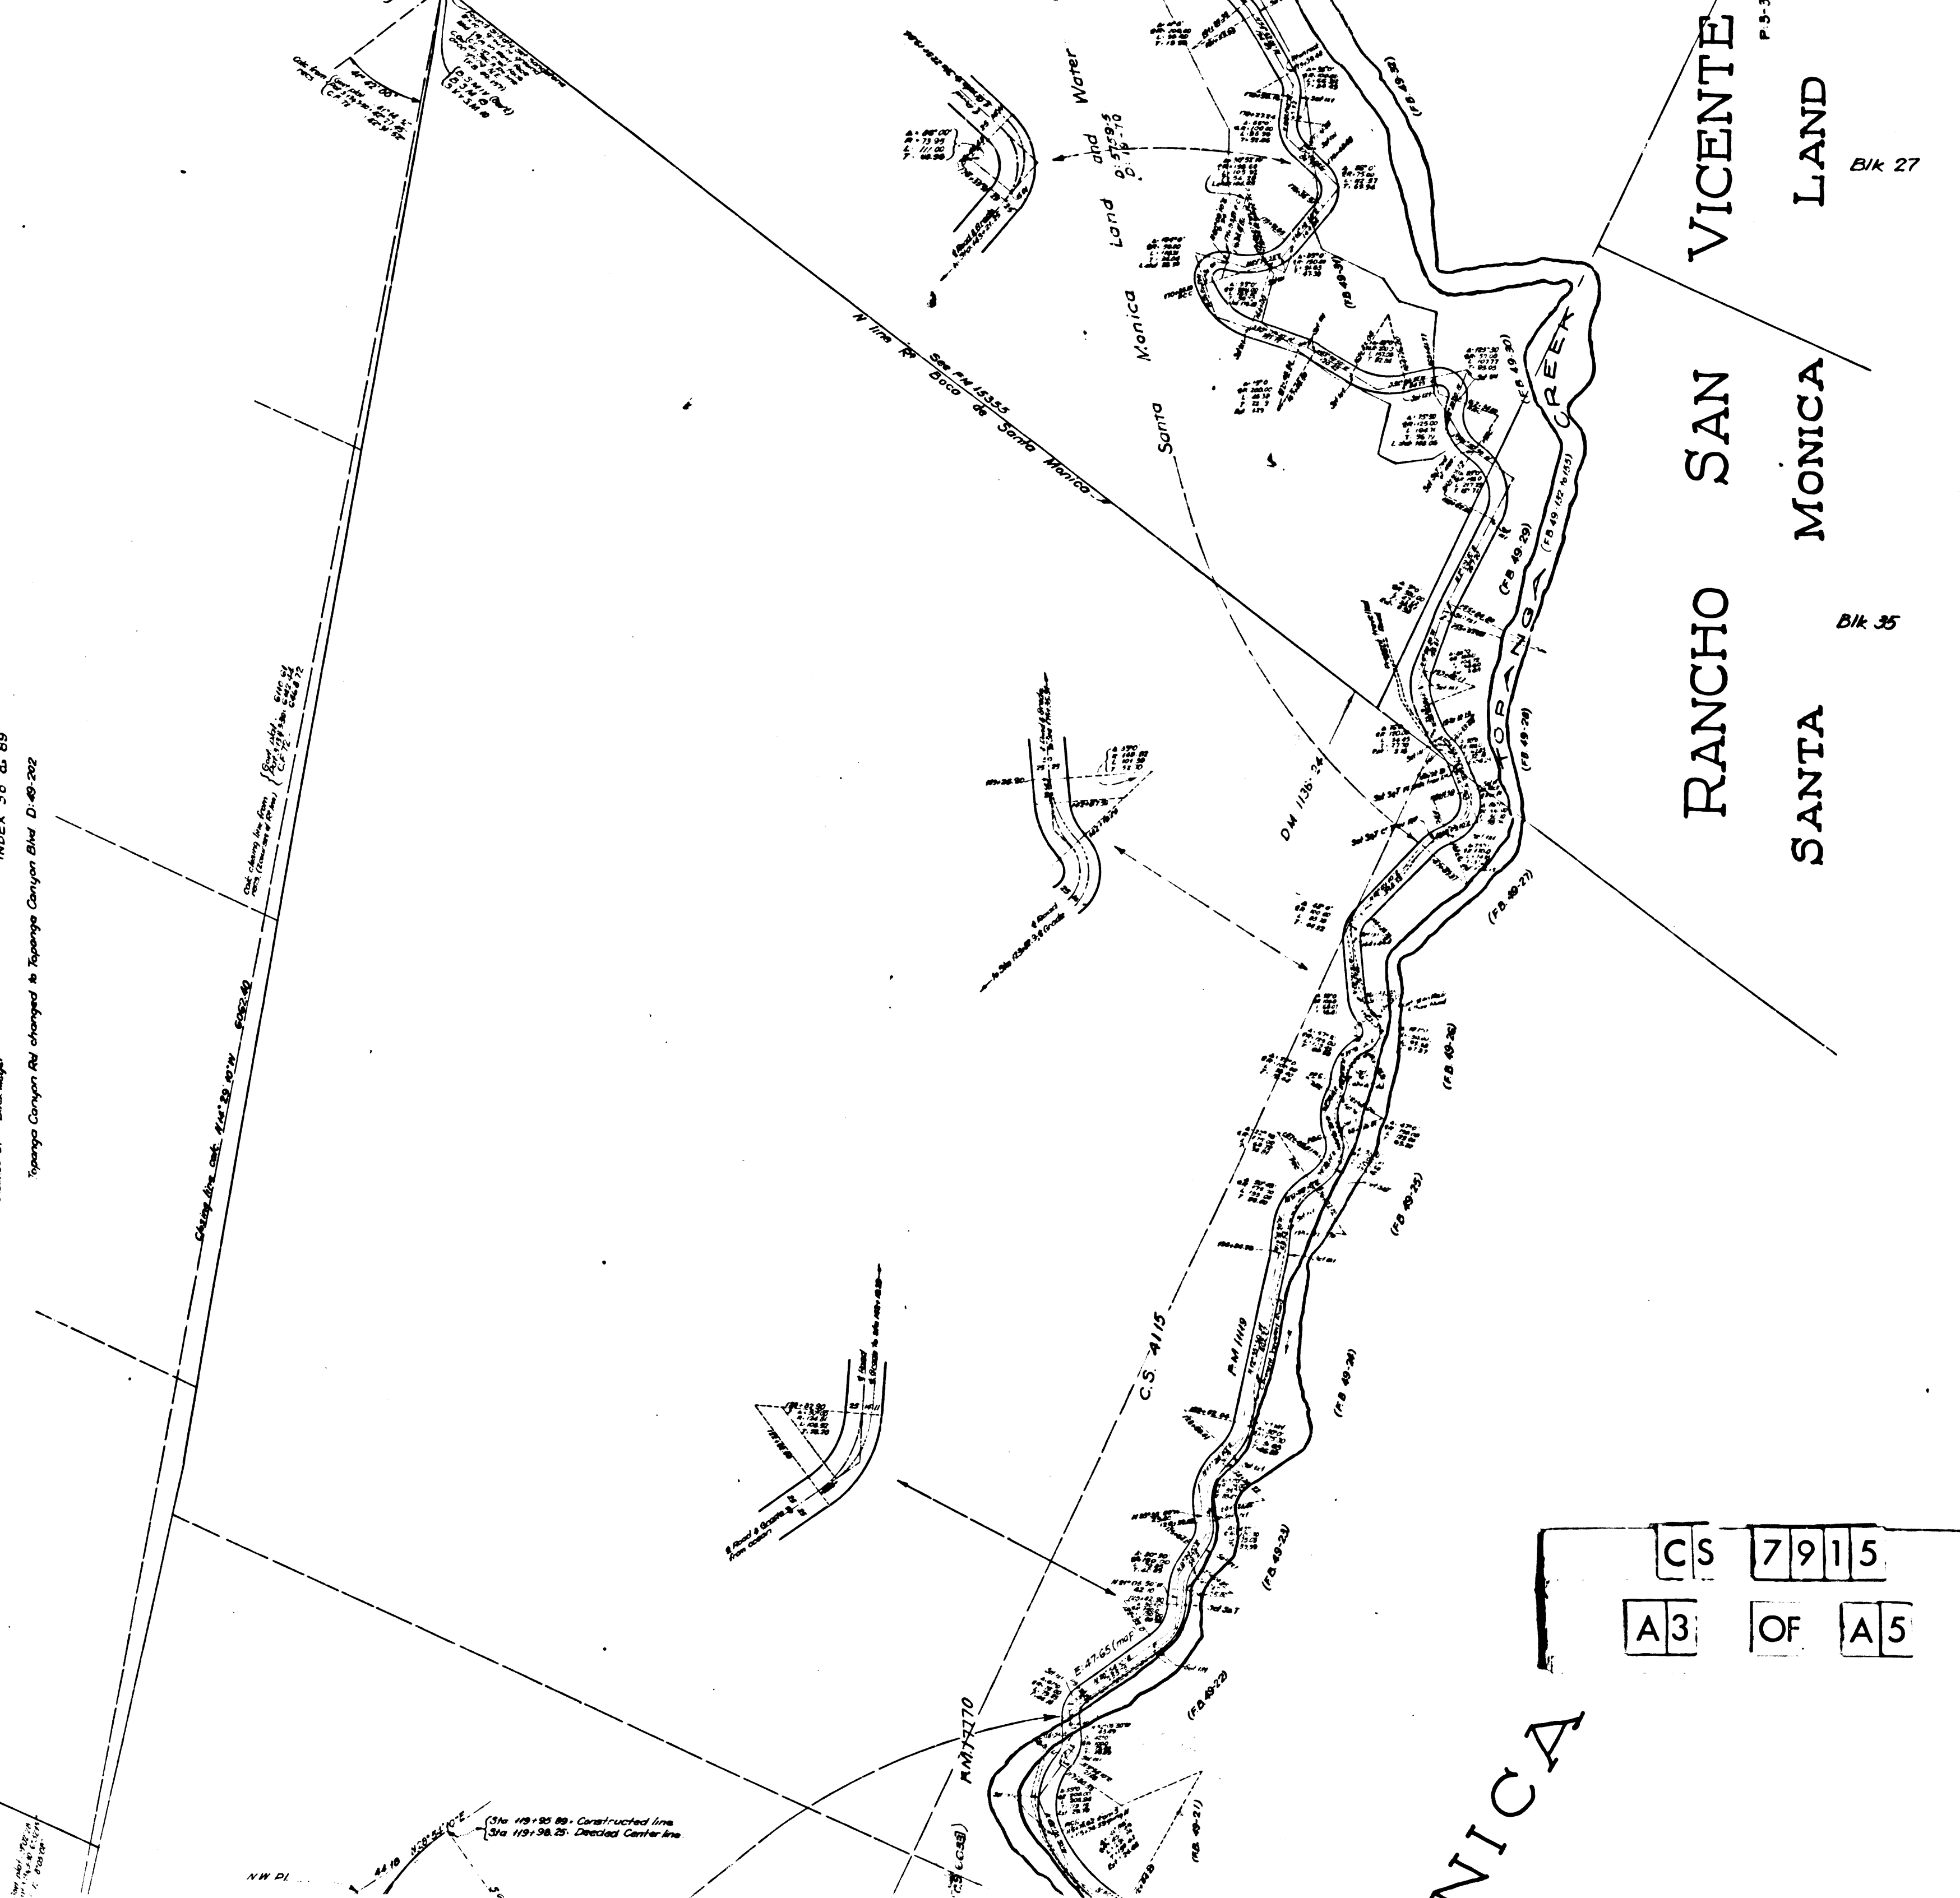

CS 7915
A3 OF A5


VICENTE
RANCHO SAN
SANTA MONICA
LAND

Blk 35

Blk 27

NICA

CHANGE OF LINE - From Sta 24+59.54 to Sta 233+11.00
Surveyed - June, 1915 See F.B. 30-58.63
Scale 1"=100'

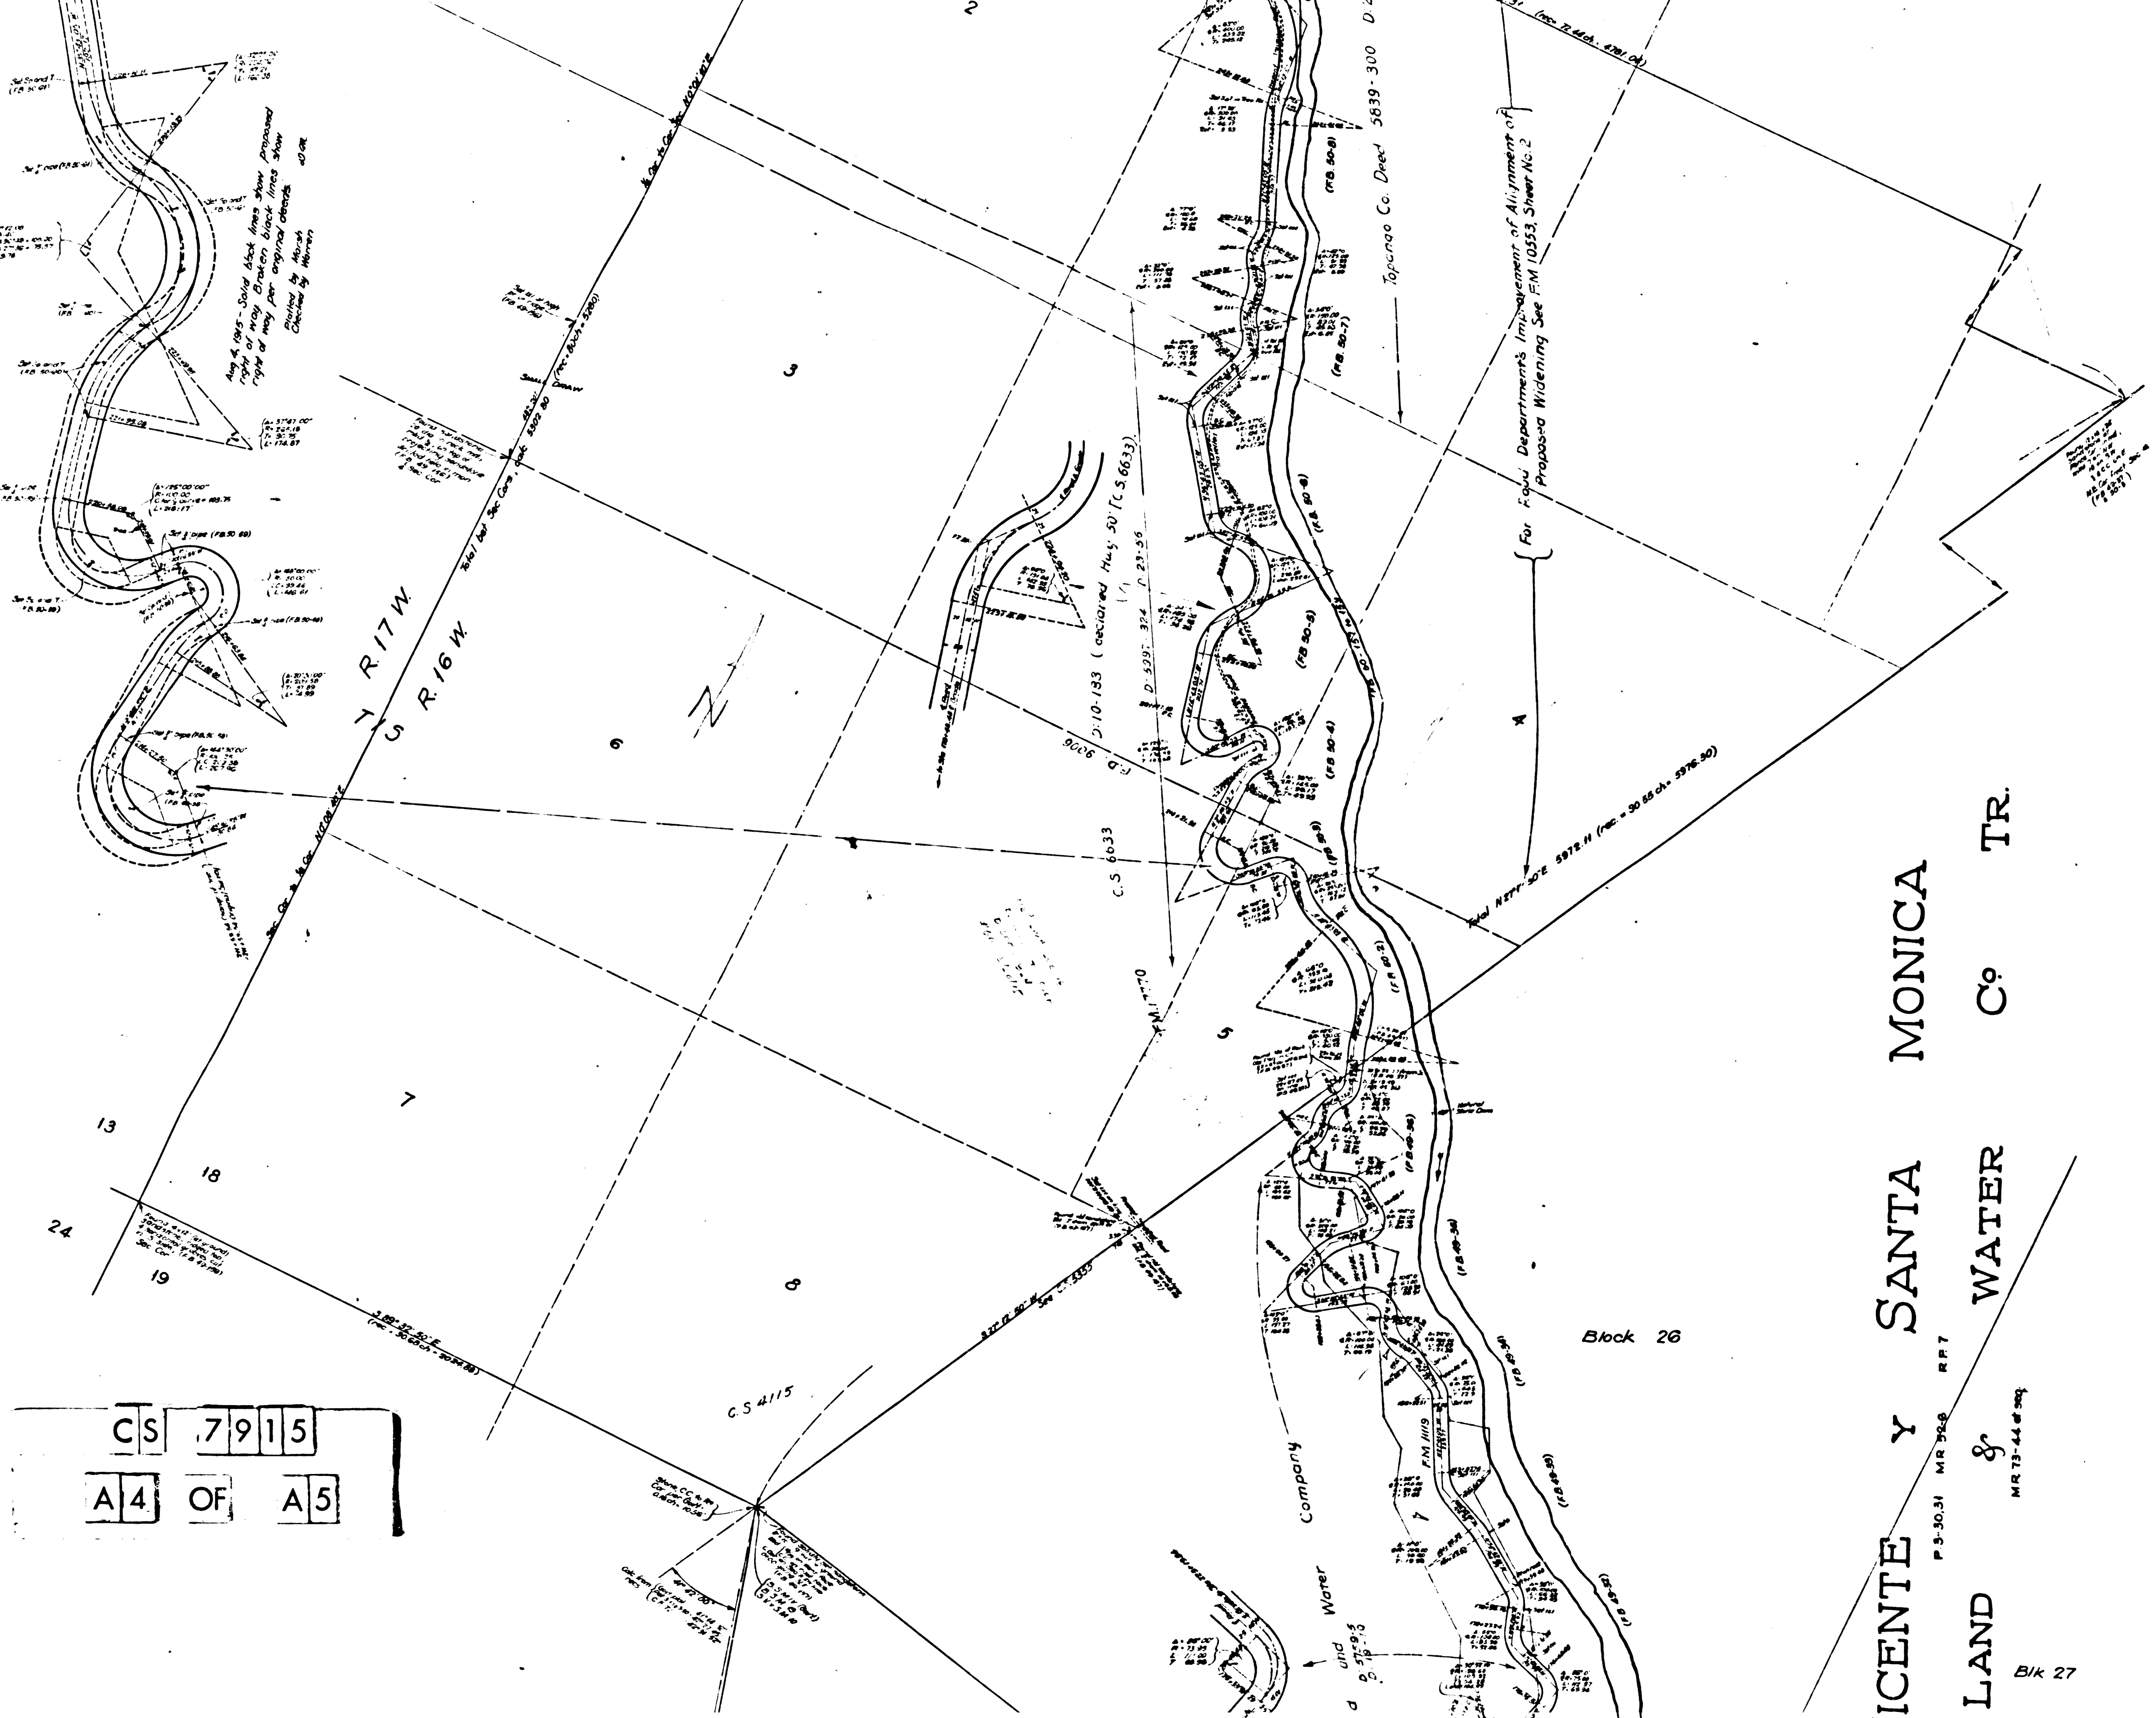

CS 7915
A4 OF A5

ICENTE Y SANTA MONICA
LAND & WATER CO. TR.

P. 3-30.31 MR 3528 RPT
MR 73-44 of 300

Blk 27

