


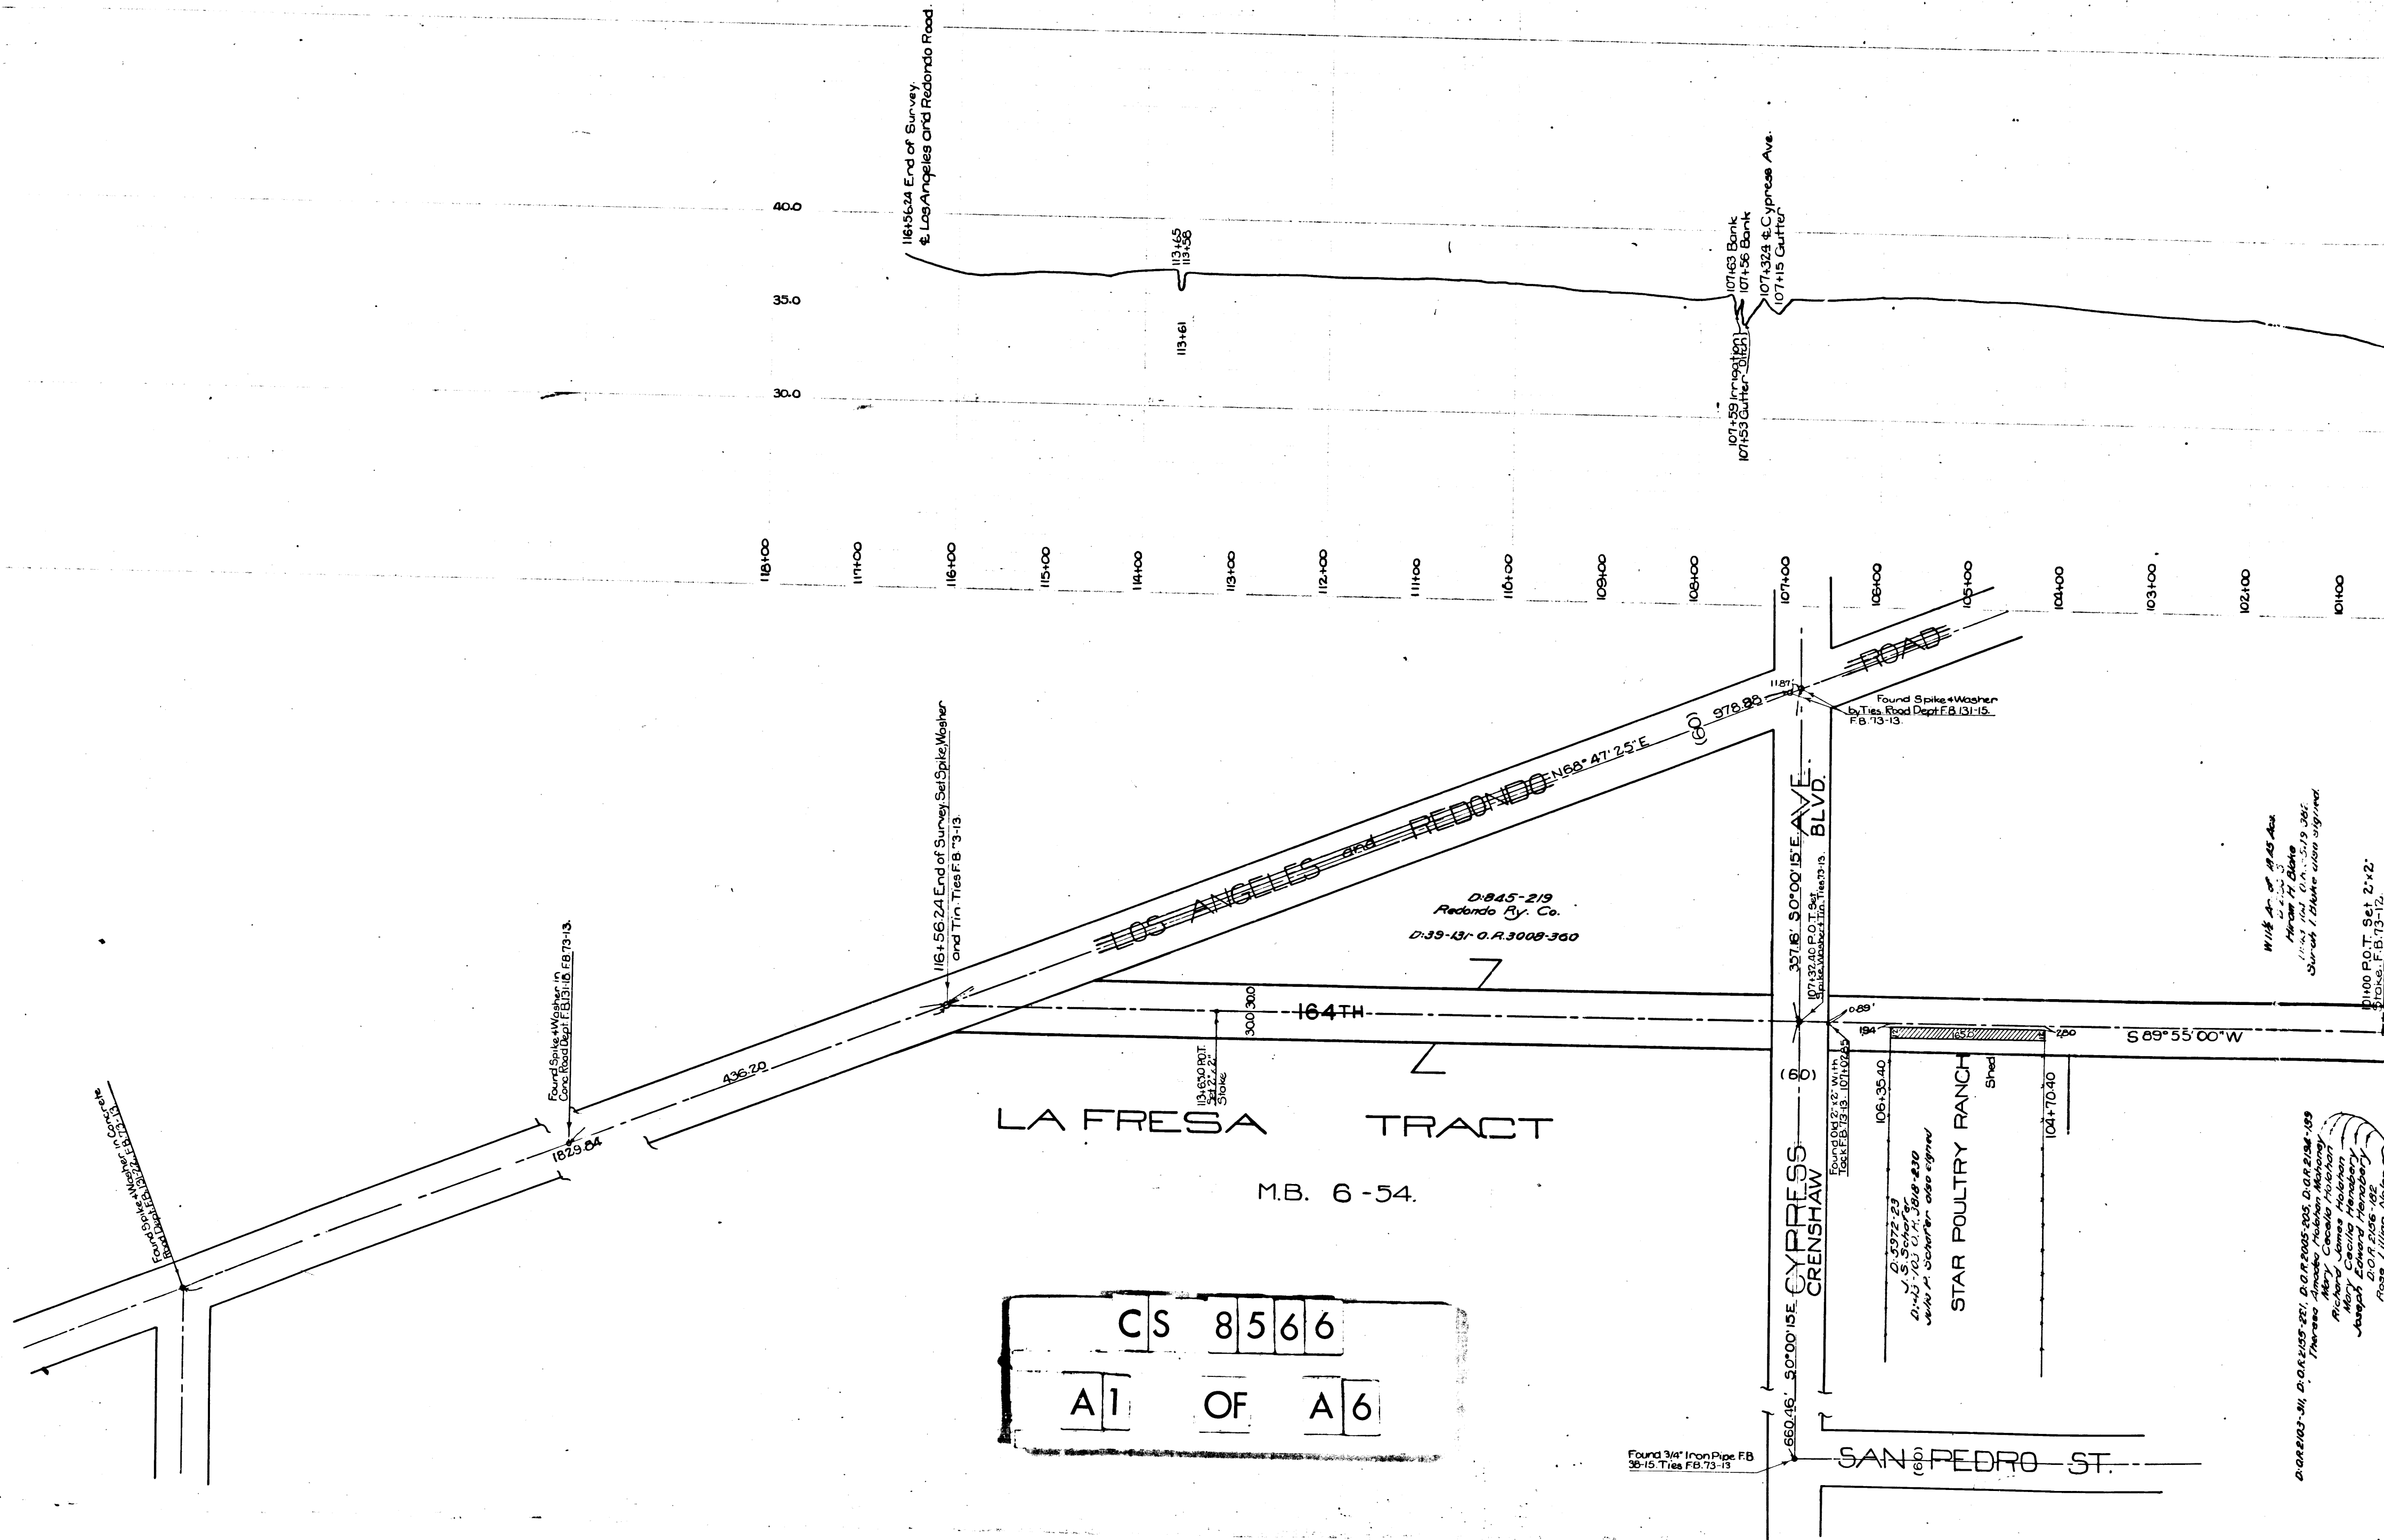

CS 8566
A1 OF A6

0.002102-31, D.O.R. 2105-221, D.O.R. 2005-205, D.O.R. 2104-109
Theresa M. Mendenhall, Secretary
Richard James Hendrick
Mary Cecilia Hendrick
Joseph Edward Hendrick
Res. 0.0112106-102
Res. 0.0112106-102
With an of 19.45 Ac.
Hiram H. Blake
1941 Vol. 1, p. 519, 361
Survey of Blake also signed
D.H.00 P.O.T. Set 21x2
Stake, F.B. 73-12

ORO ST.

D.O.R. 2103-34, D.O.R. 2155-121, D.O.R. 2005-203, D.O.R. 2104-103
Theresa Amador, Helen Anthony,
Mary Cecelia Hendrick,
Joseph Edward Hendrick,
D.O.R. 2106-102,
D.O.R. 2107-107,
Joseph E. Hendrick also signed,
D.O.R. 2107-200, D.O.R. 2107-201,
Joseph Edward Hendrick, signed as Guaranty.

W 1/4 Sec 21, 18.45 Acs
D.O.R. 2107-200,
Helen H. Bohn,
D.O.R. 2107-201, D.O.R. 2107-202,
Sarah I. Bohn also signed.

D.O.R. 2107-201, Set 2x2;
Spike, F.B. 73-12.

E. 6.95 Acs. of N. 18.45 Acs.
D.O.R. 2107-203,
Agnes Auschinsky, Maud
Hendrick,
Guaranty, T. & S. Co., Inc.,
D.O.R. 2107-203, D.O.R. 2107-204,
H.V. Shinn and G. A. Holtz also signed.

Set 1/2x2; Spike,
F.B. 73-12.

N. 14.65 Acs. of S. 30 Acs.
D.O.R. 2107-362,
Anna Oshersky,
T. & S. Co., Inc.,
D.O.R. 2107-362,
Maurice W. Morris,
D.O.R. 2107-362, D.O.R. 2107-363,
mean.

Set 1/2x2; Spike,
F.B. 73-12.

McDONALD

AVE N 89° 55' 00" E

M.R. 15-21,22

CS 8566
A2 OF A6

1971.42, to Los Angeles & Redondo Road
Found Spike & Washer by Ties Road Dept. F.B. 73-12, F.B. 73-12.

ARLINGTON ST. AVE.
N 0° 05' 00" W
Set 1/2x2; Spike,
F.B. 73-12.

TRACT

81+25 Bank
81+22 Gutter
81+07 & Arlington St.
80+92 Gutter

89+89 Irrigation Ditch.

94+15

104+00 103+00 102+00 101+00 100+00 99+00 98+00 97+00 96+00 95+00 94+00 93+00 92+00 91+00 90+00 89+00 88+00 87+00 86+00 85+00 84+00 83+00 82+00 81+00 80+00 79+00 78+00 77+00 76+00

TRACT

L. A. City School Dist.
D: 43-259 O. R. 4825 - 299

E:22-165,OR,4551-184

66+00 Intersection Illinois St.

62+32 E Pennsylvania St.

54+90 Gutter
54+55 Gutter
54+72.5 E. Western Ave
54+50 Bank.

MESCOYES ADD

~~MARKET~~ -  - ST.

Found Spike + Washer by
Ties Road Dept. FB 109-91 FB 73-9.

GARDENA

~~GLADSTONE~~

BLVD

5958

65-16.

M.R. 19-4

MANHATTAN
NEW YORK


SAN PEDRO ST.

TRACT No. 54+32.48 Found 2/24/81
Iron Pipe 2 1/2" dia. F.H. 73-S
State F.R. 73-9

M.B.




C	S	8	5	6	6
---	---	---	---	---	---


A 3 OF A 6

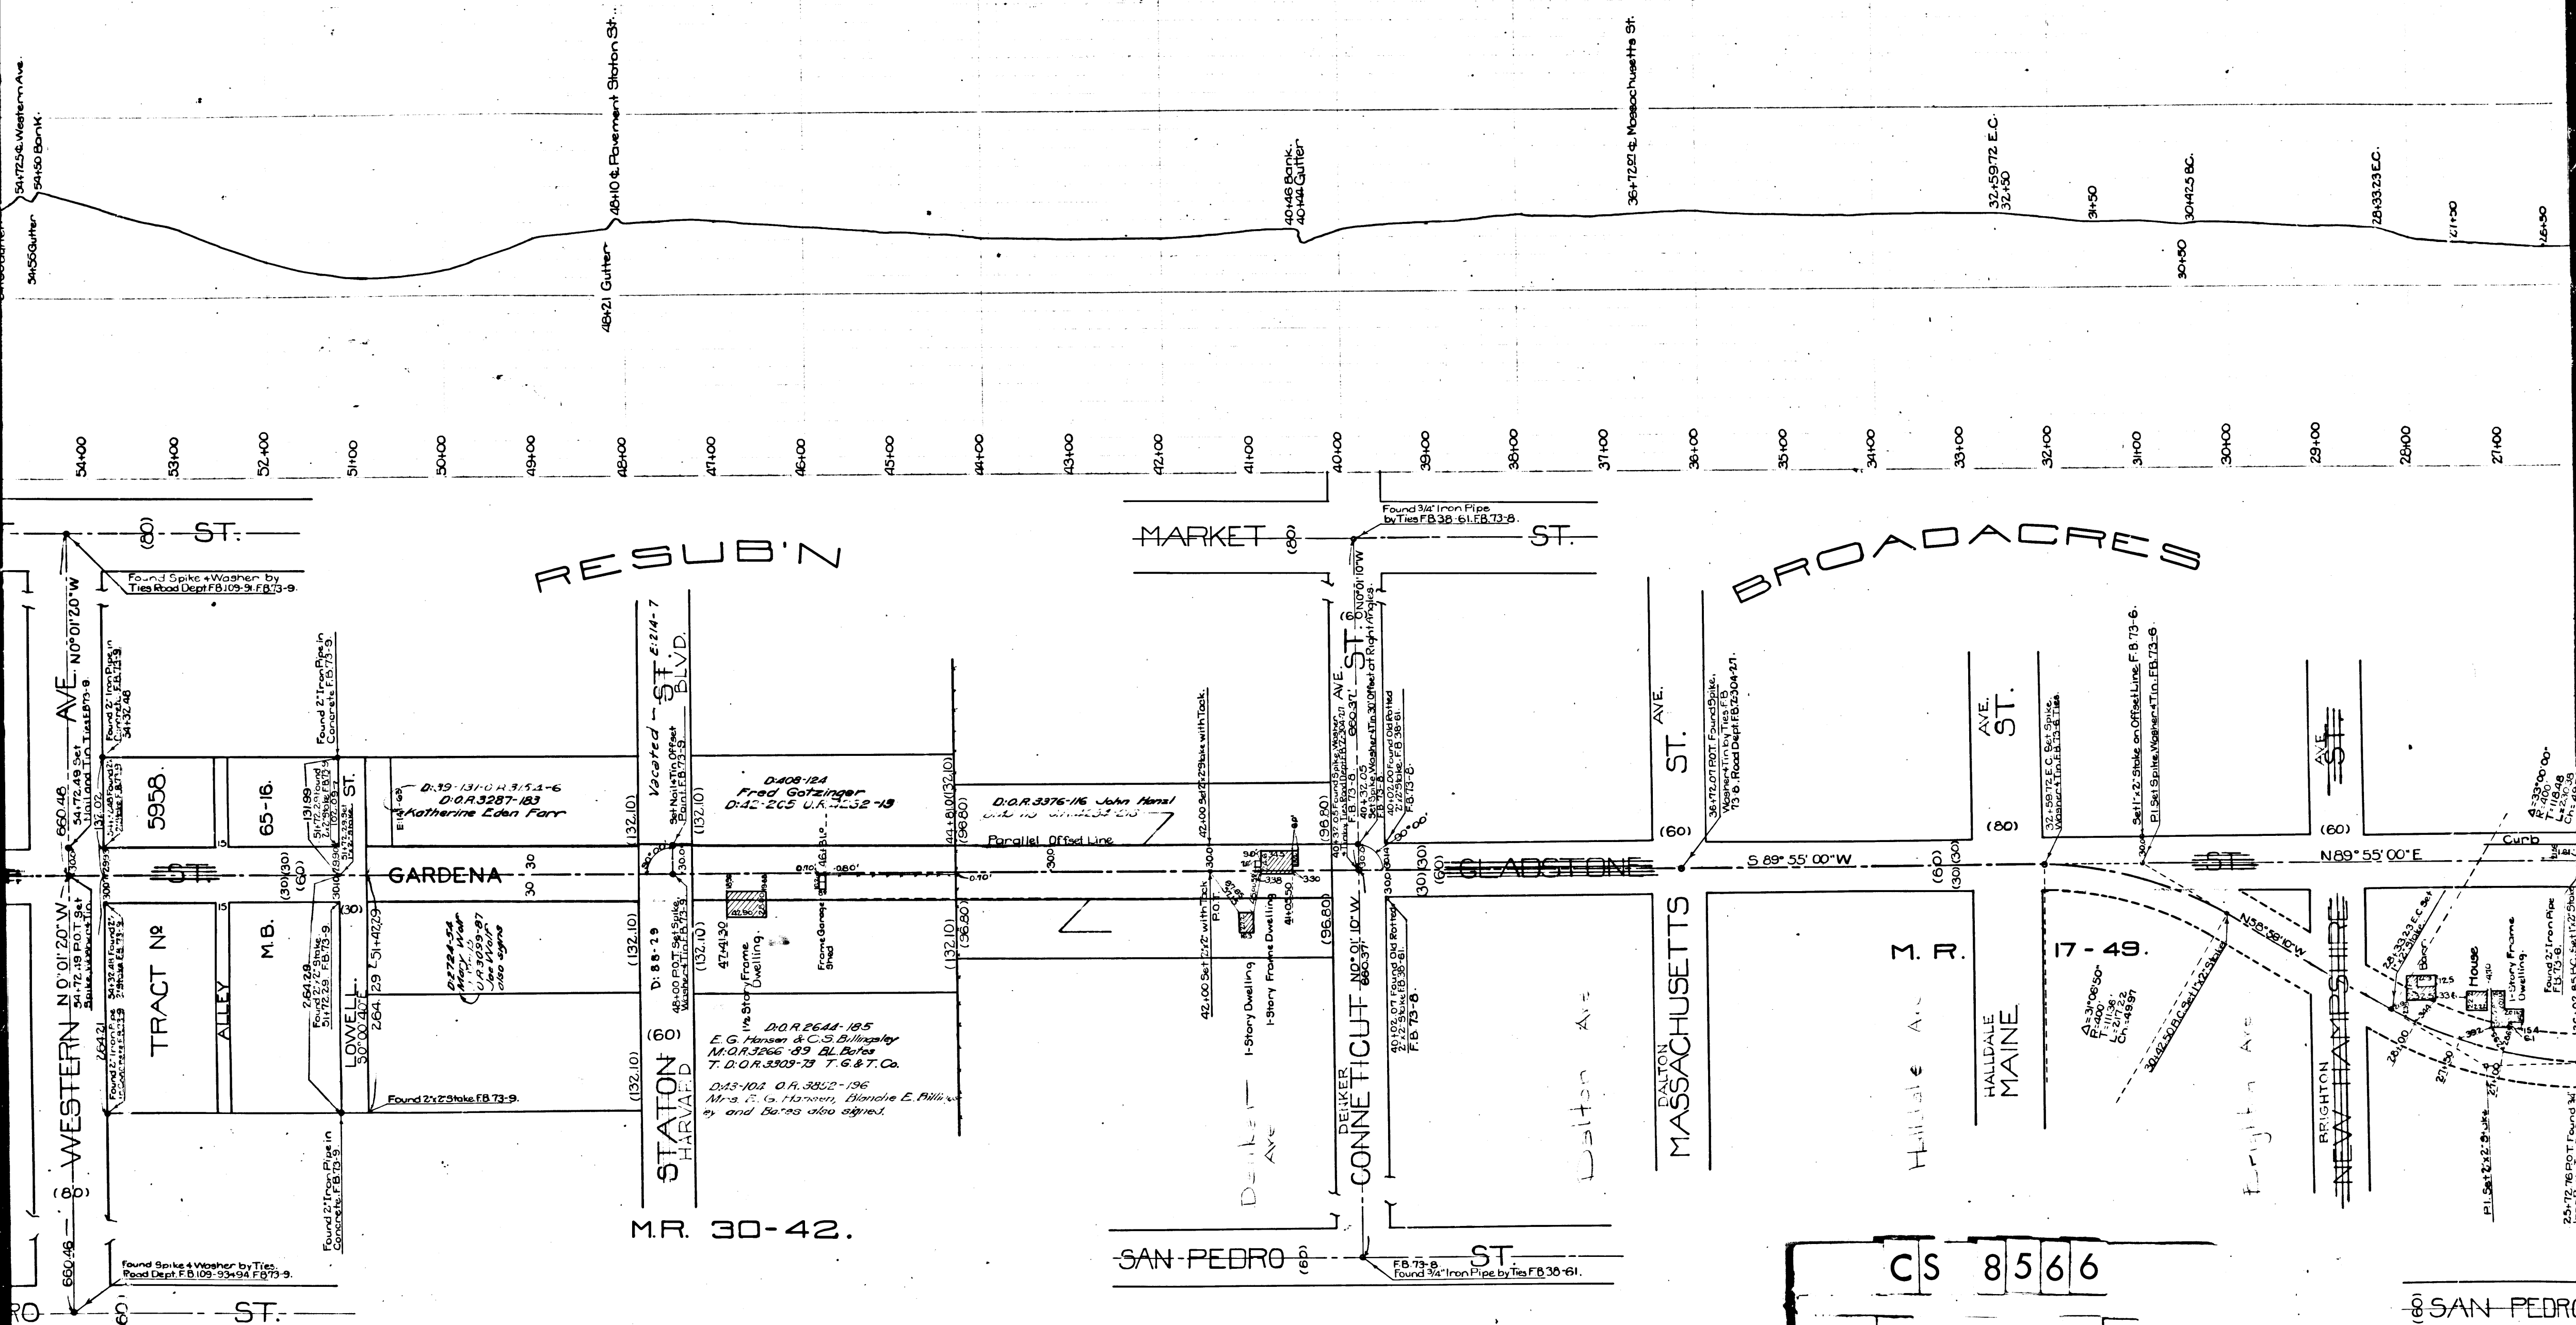


C	S	8	5	6	6
A	4	OF	A	6	

~~8~~ SAN PEDRO

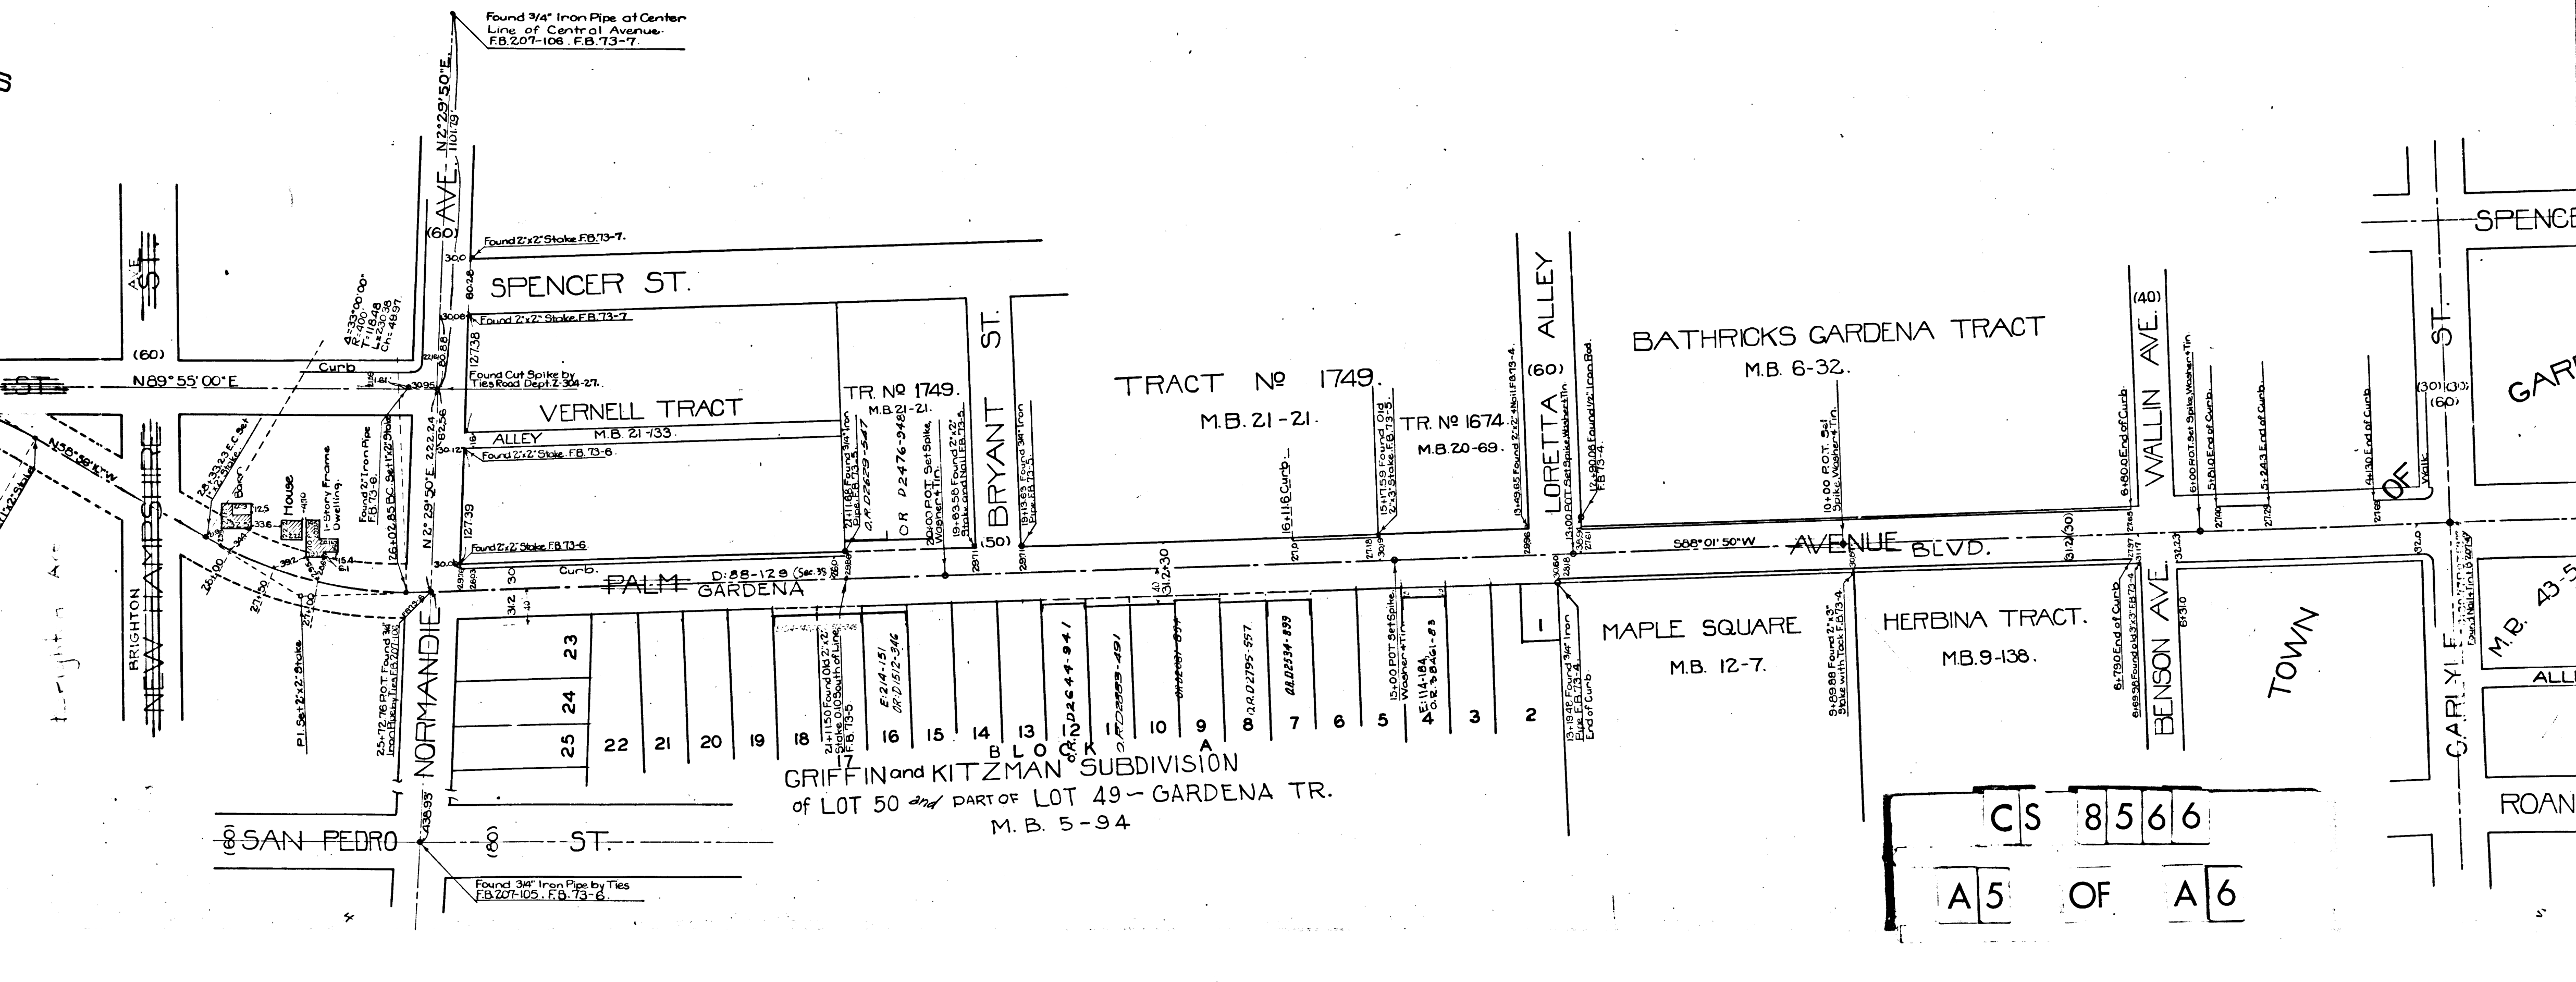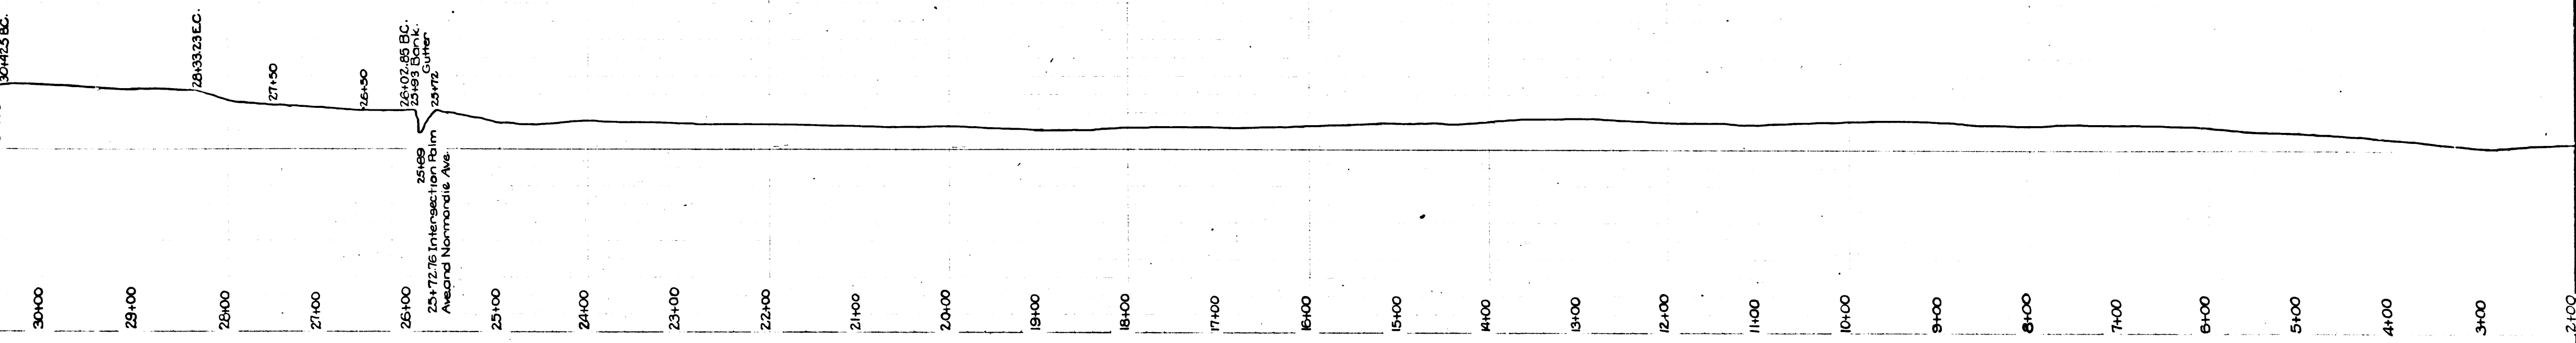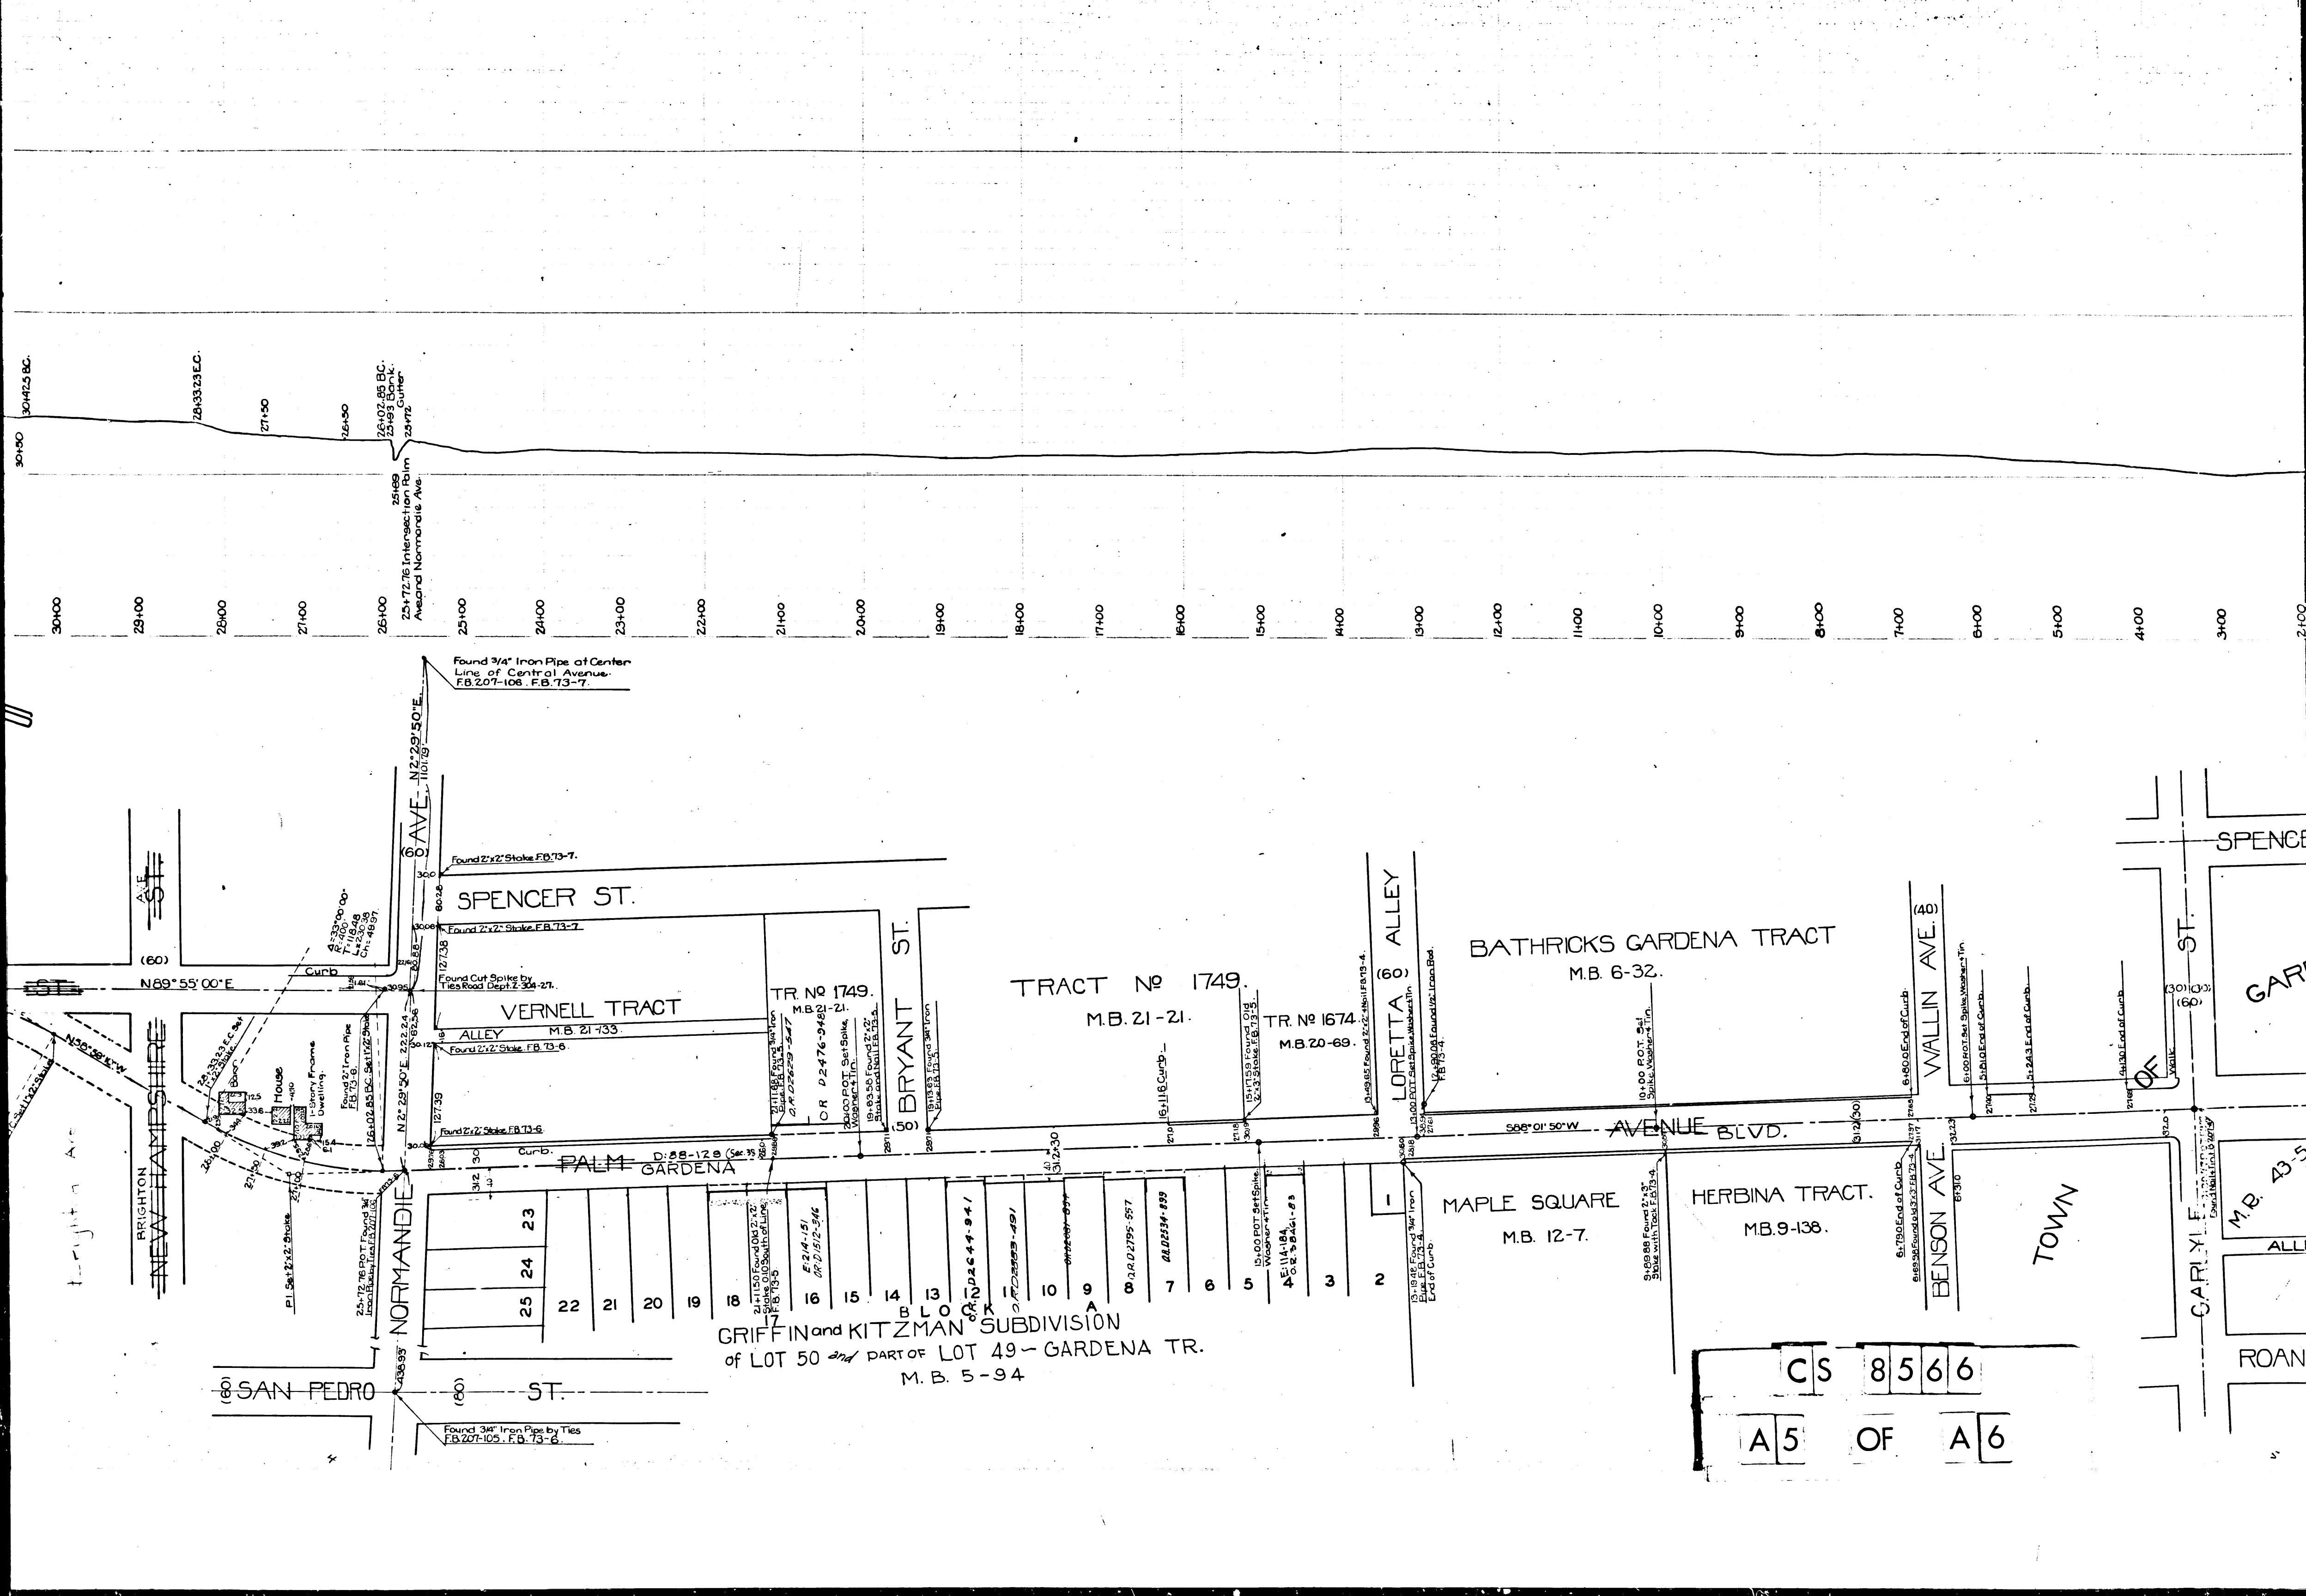

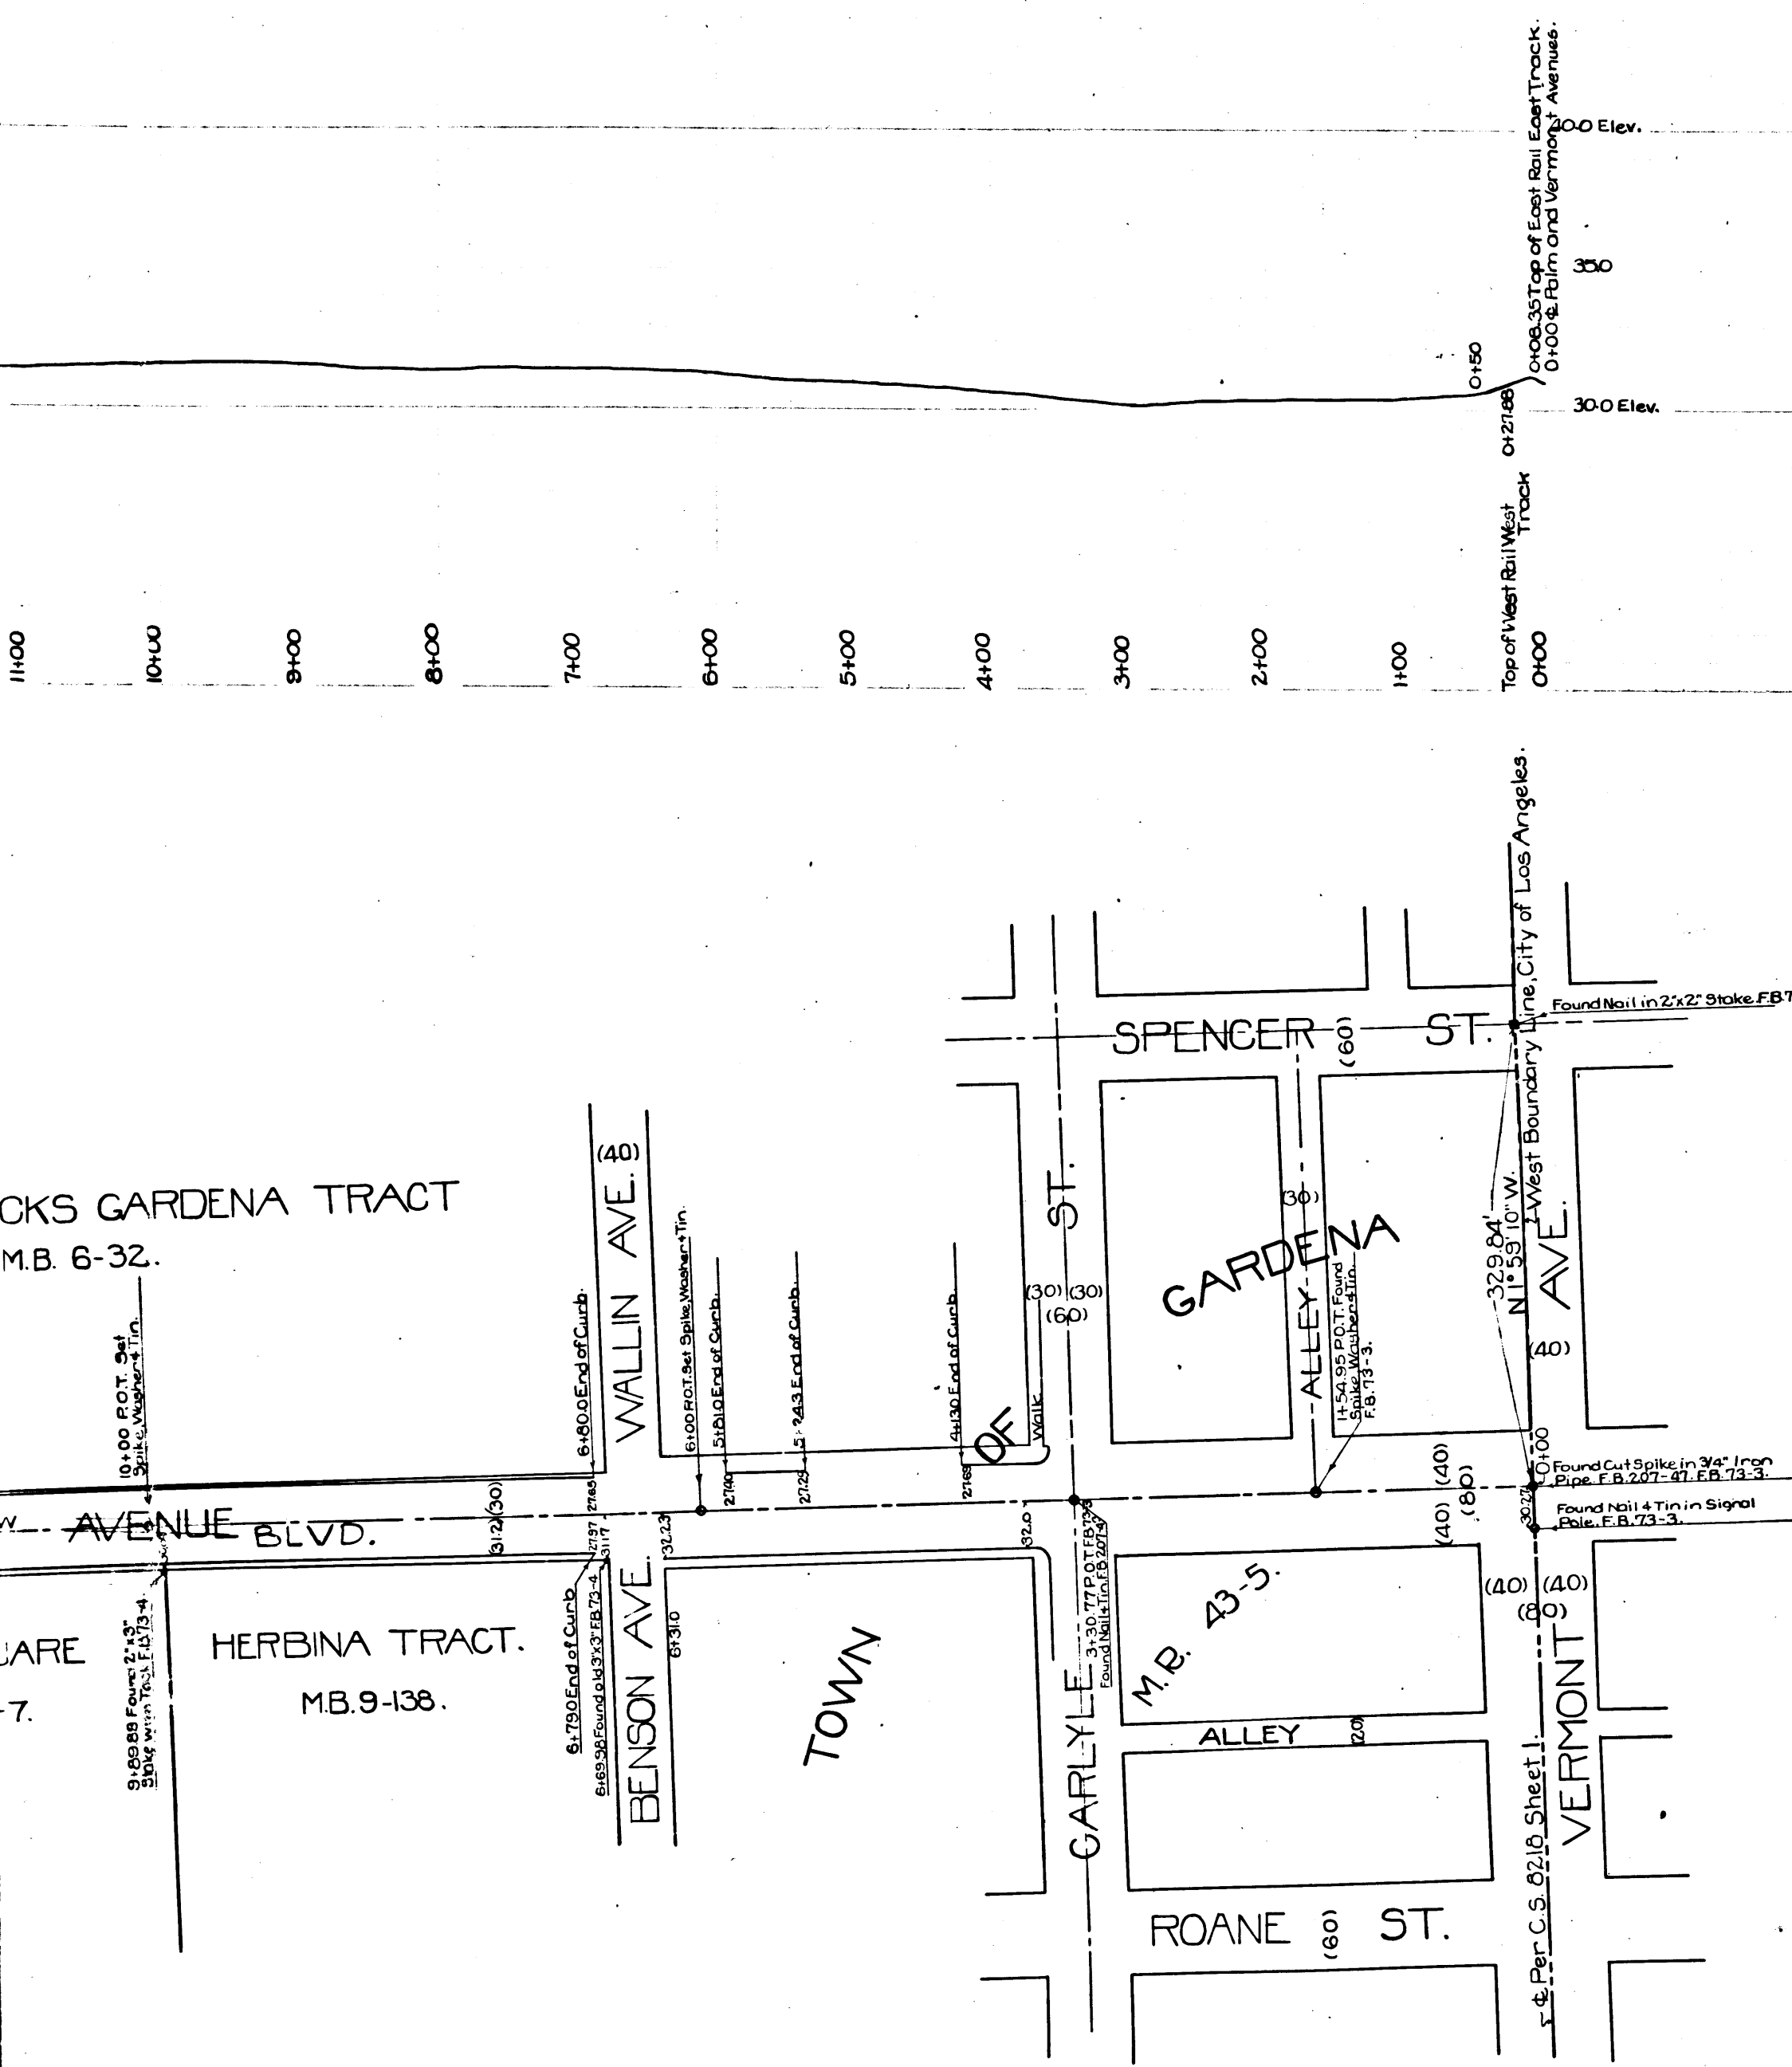

Scale 1"=80' Horiz.
4" Vert.

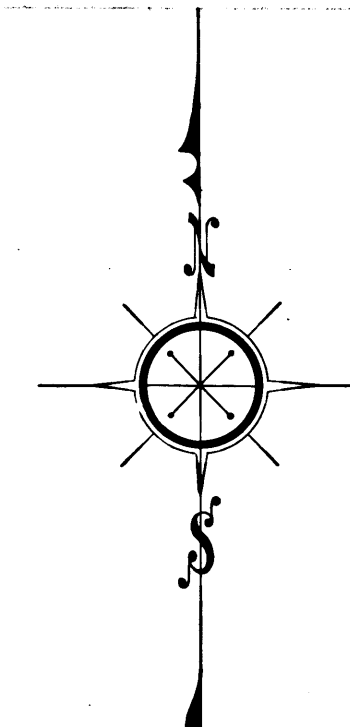

CS 8566
A6 OF A6

GARDENA BLVD. MAP OF 164TH ST.
AND PALM AVENUE
FROM REDONDO BEACH BLVD.
VERMONT AVENUE TO LOS ANGELES
REDONDO ROAD

COUNTY SURVEYORS MAP NO 8566
SCALE: 1-INCH = 80 FEET

J.E. Rockhold County Surveyor
Surveyed April & May 1923.

Surveyed Under Instructions Of the Board Of Supervisors
Per order Dated February 5th 1923. Bearings Based On
The Bearing Of Vermont Avenue Per C.S. Map No. 8218-Sheet No. 1

F.B. 73, 3 to 13.
L.B. 116, 26 to 36.
Field Work by A.E. Dunn.
Office Work by L.G. Bell.
Checked by F.M. Coon.
Traced by L.G. Bell.

Palm Ave. changed to 164th St. D: 88-27 Res. 543. (Torrance)
Gardena Blvd. - D: 88-123 Res. 17 (Gardena) Sec. 39
Los Angeles & Redondo Rd. changed to Redondo Beach Blvd. - D: 49-214

Sh. 25
Sh. 26