



SUSANA C.F.118 DOMINGUEZ

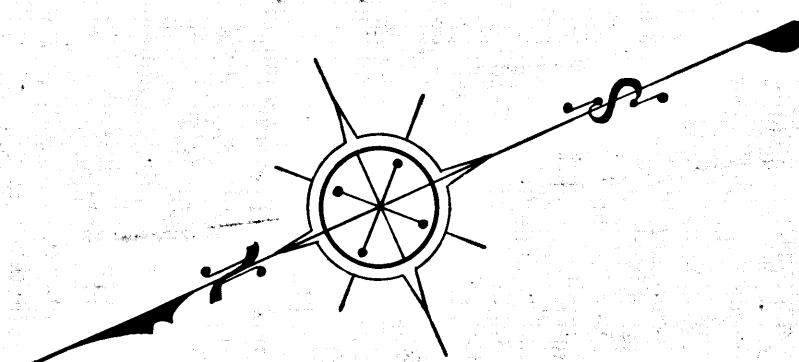

DOMINGUEZ COLONY
M.R. 32-97

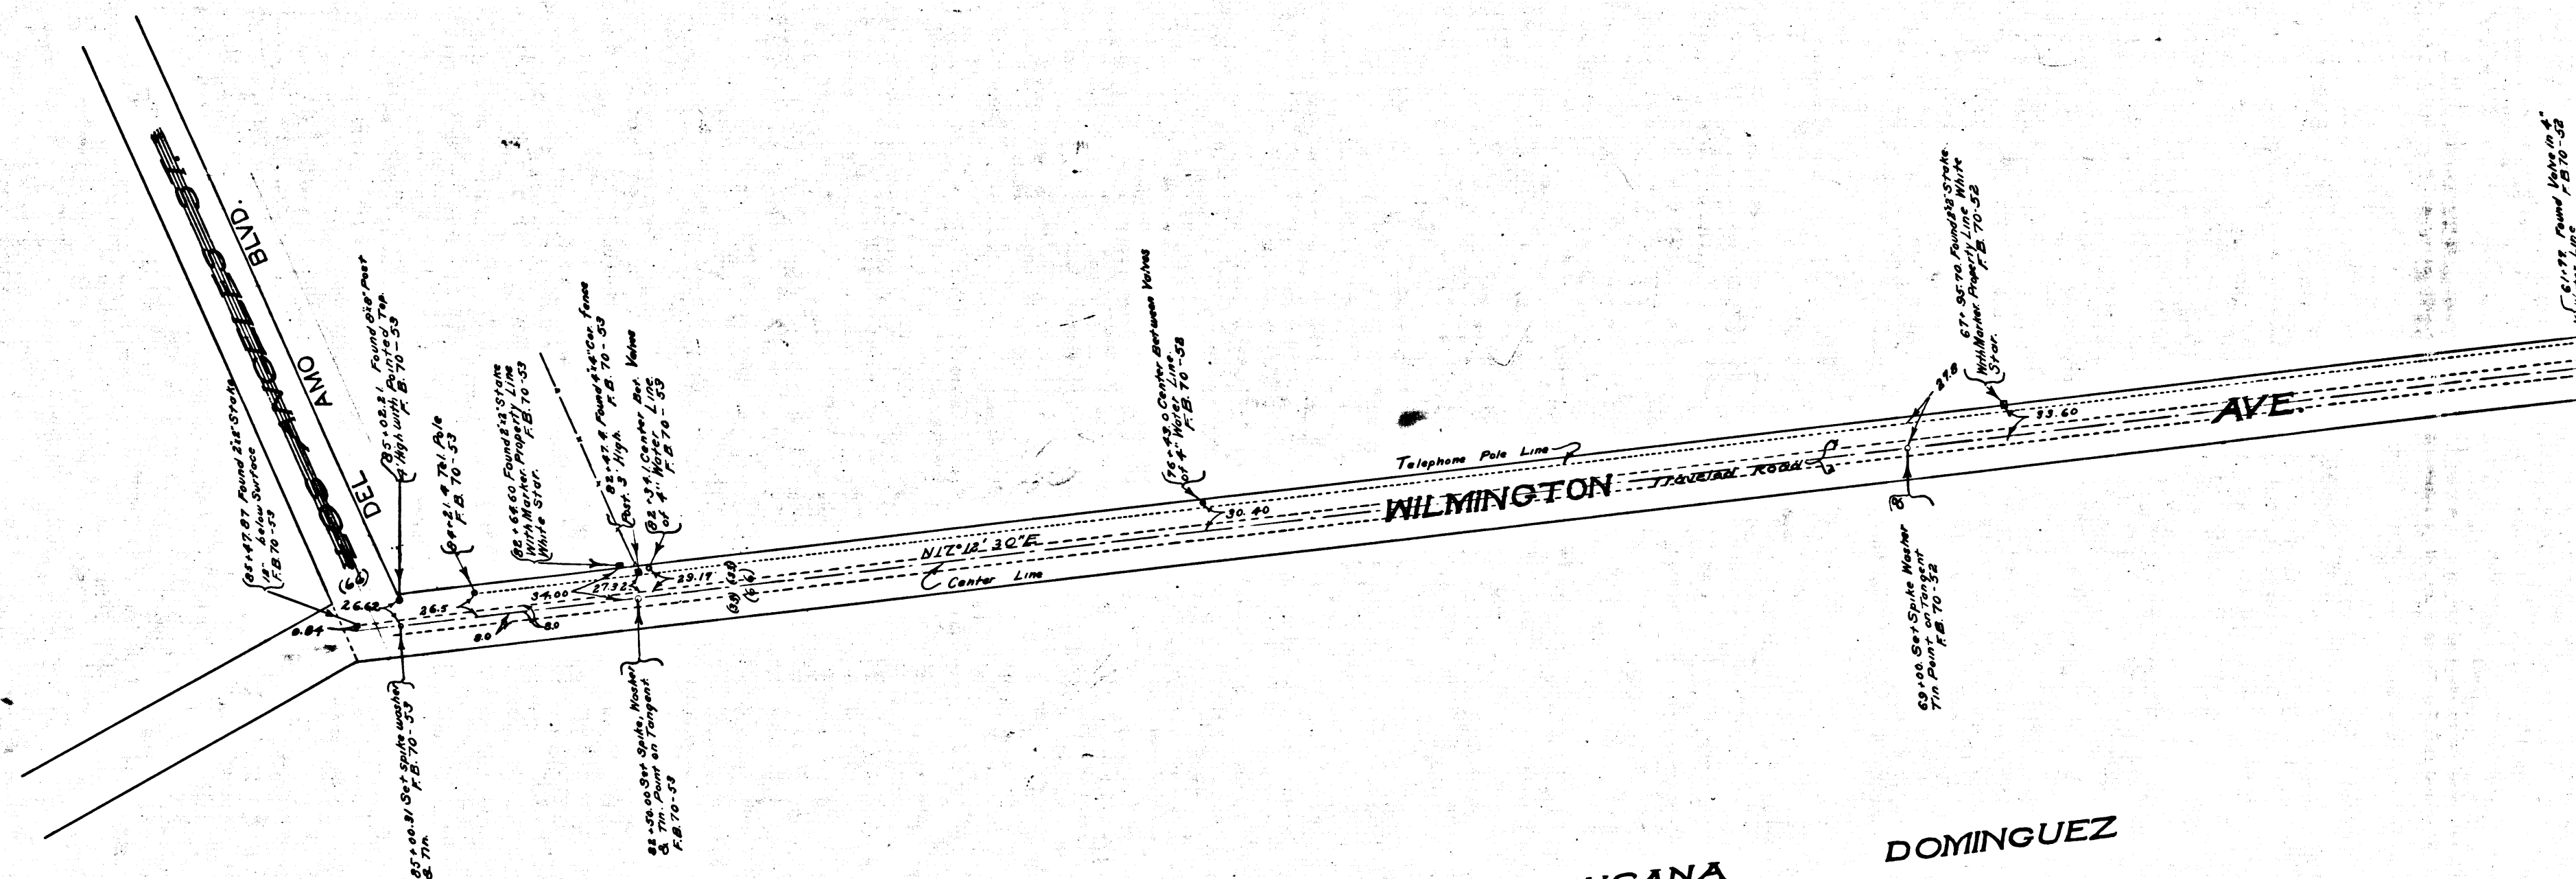


SUSANA DOMINGUEZ
C.F.118

CS	8701	
A1	OF	A6


DOMINGUEZ COLONY
M.R. 32-97-98

ONY

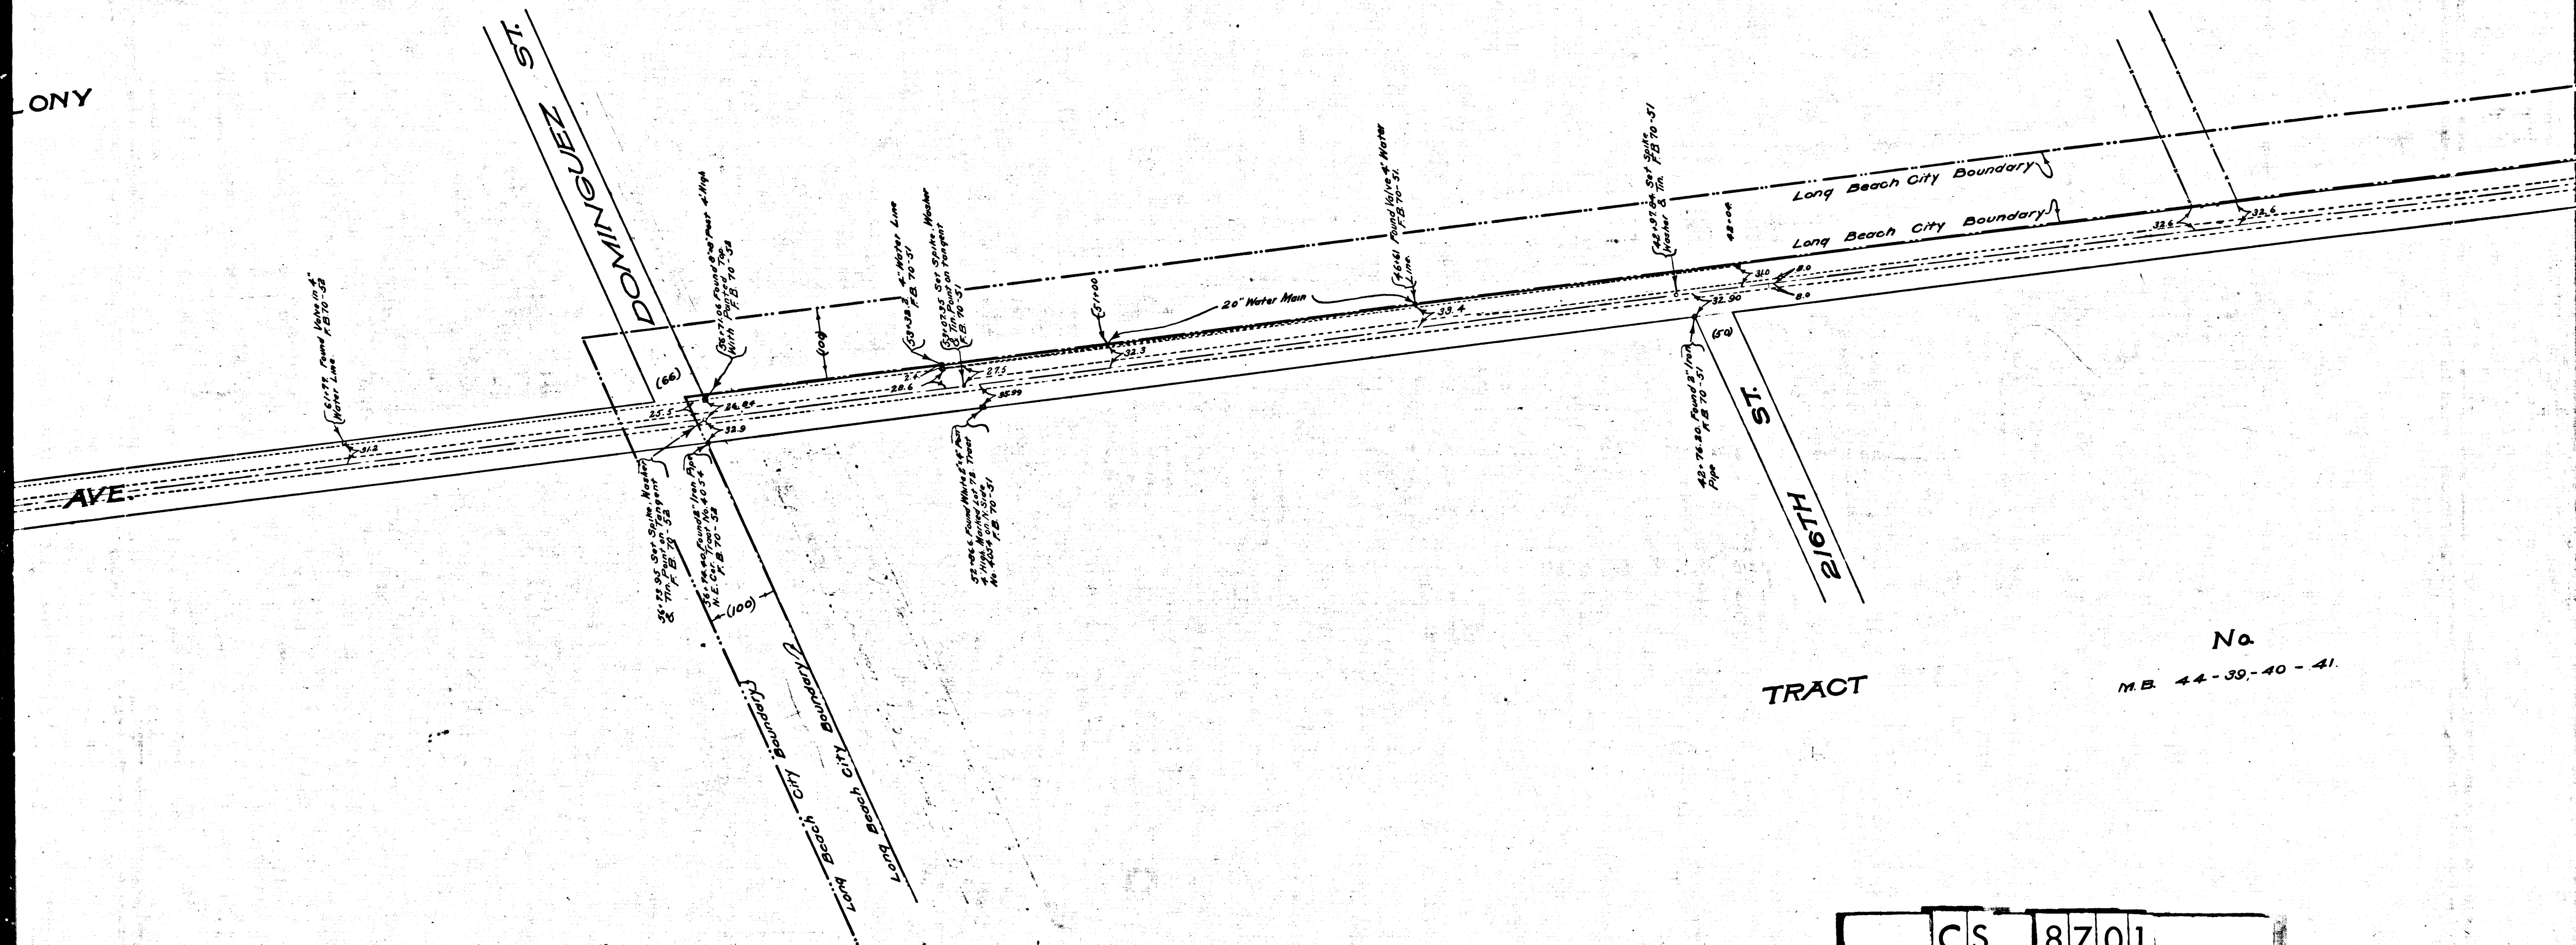

TRACT No.
M.B. 44-39-40-41

CS	8701
A2	OF A6

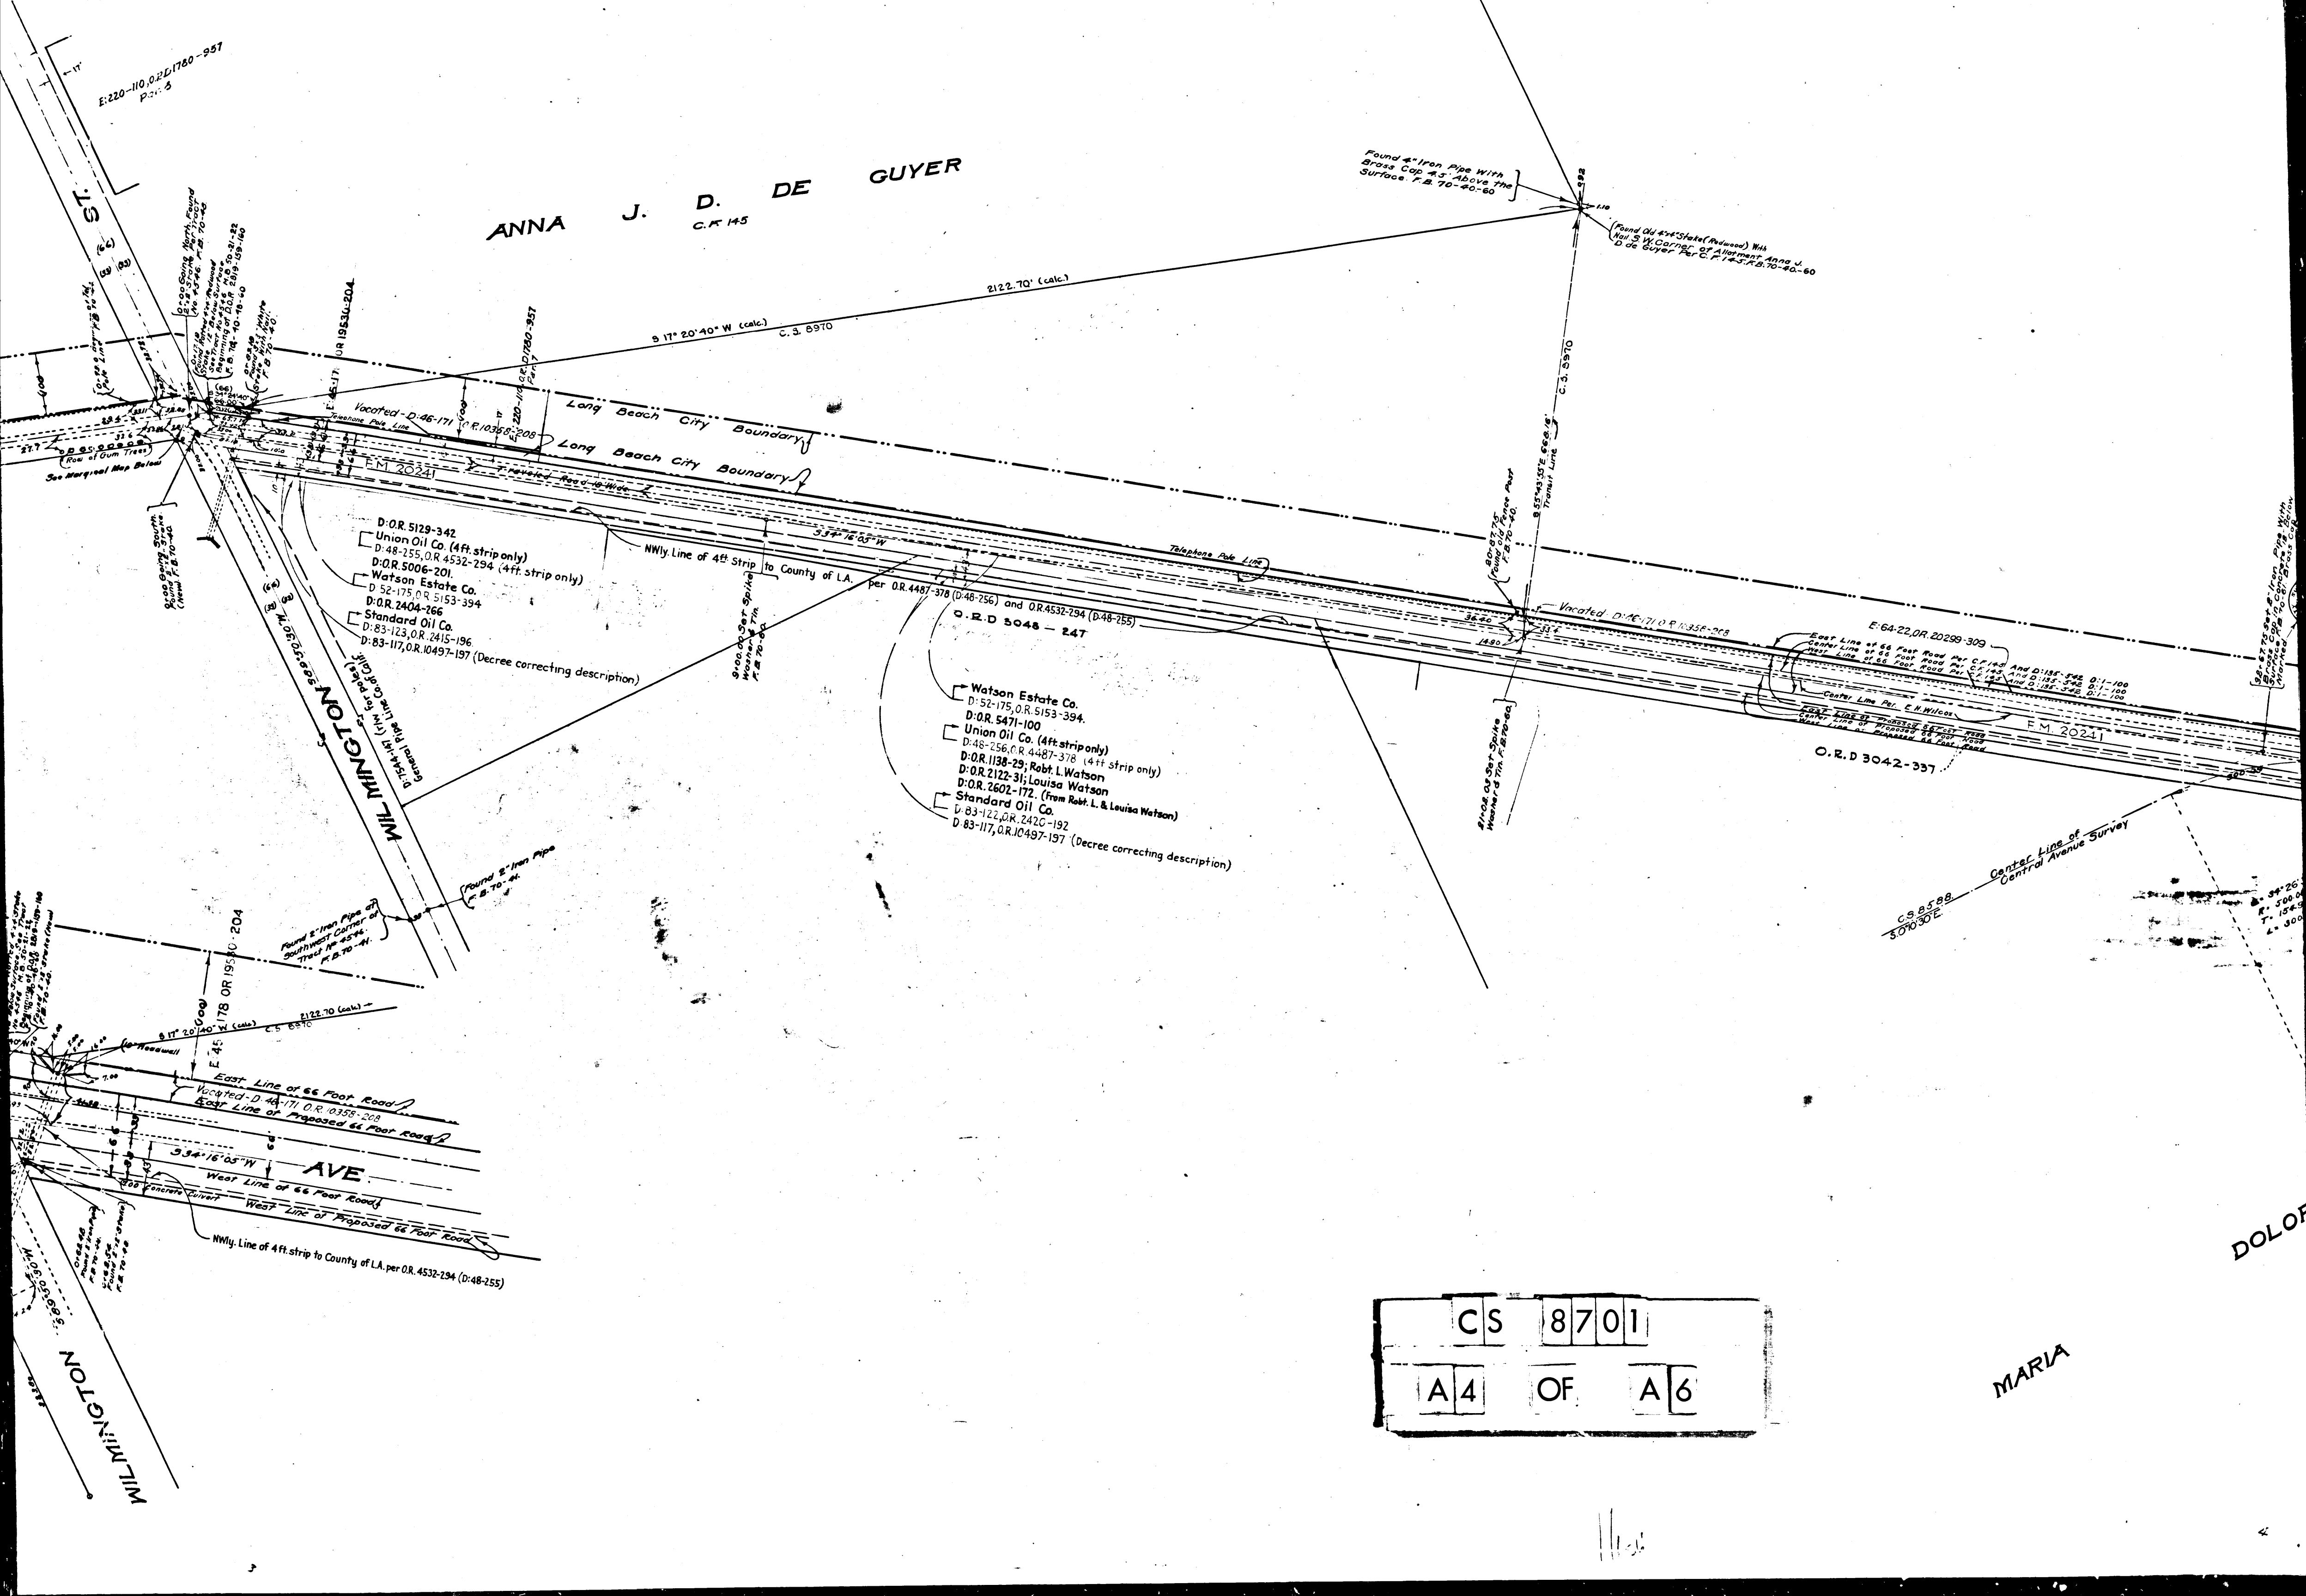

ANNA J. D. DE GUYER
C.F. 145

Found 4" Iron Pipe With
Brass Cap 4.5' Above the
Surface F.B. 70-40-60

Found Old 4" Stake (Redwood) With
Nail S.W. Corner of Allotment Anna J.
De Guyer, Per C.F. 145 F.B. 70-40-60

D.O.R. 5129-342
Union Oil Co. (4ft. strip only)
D. 48-255, O.R. 4532-294 (4ft. strip only)
D.O.R. 5006-201
Watson Estate Co.
D. 52-175, O.R. 5153-394
D.O.R. 2404-266
Standard Oil Co.
D. 83-123, O.R. 2415-196
D. 83-117, O.R. 10497-197 (Decree correcting description)

Watson Estate Co.
D. 52-175, O.R. 5153-394
D.O.R. 5471-100
Union Oil Co. (4ft. strip only)
D. 48-256, O.R. 4487-378 (4ft. strip only)
D.O.R. 1138-29; Robt. L. Watson
D.O.R. 2122-31; Louisa Watson
D.O.R. 2602-172. (From Robt. L. & Louisa Watson)
Standard Oil Co.
D. 83-122, O.R. 2420-192
D. 83-117, O.R. 10497-197 (Decree correcting description)


E. 64-22, O.R. 20299-309
Center Line of 66 Foot Road Per C.F. 145 and D. 185-592 O. 1-100
East Line of 66 Foot Road Per C.F. 145 and D. 185-592 O. 1-100
West Line of 66 Foot Road Per C.F. 145 and D. 185-592 O. 1-100
Center Line Per E.H. Wilson
Center Line of Proposed 66 Foot Road
Center Line of Proposed 66 Foot Road
O.R.D. 3042-337

Center Line of
Central Avenue Survey
C.S. 8588
S. 0° 10' 30" E

CS	8701
A4	OF A6

MARIA

DOLOP

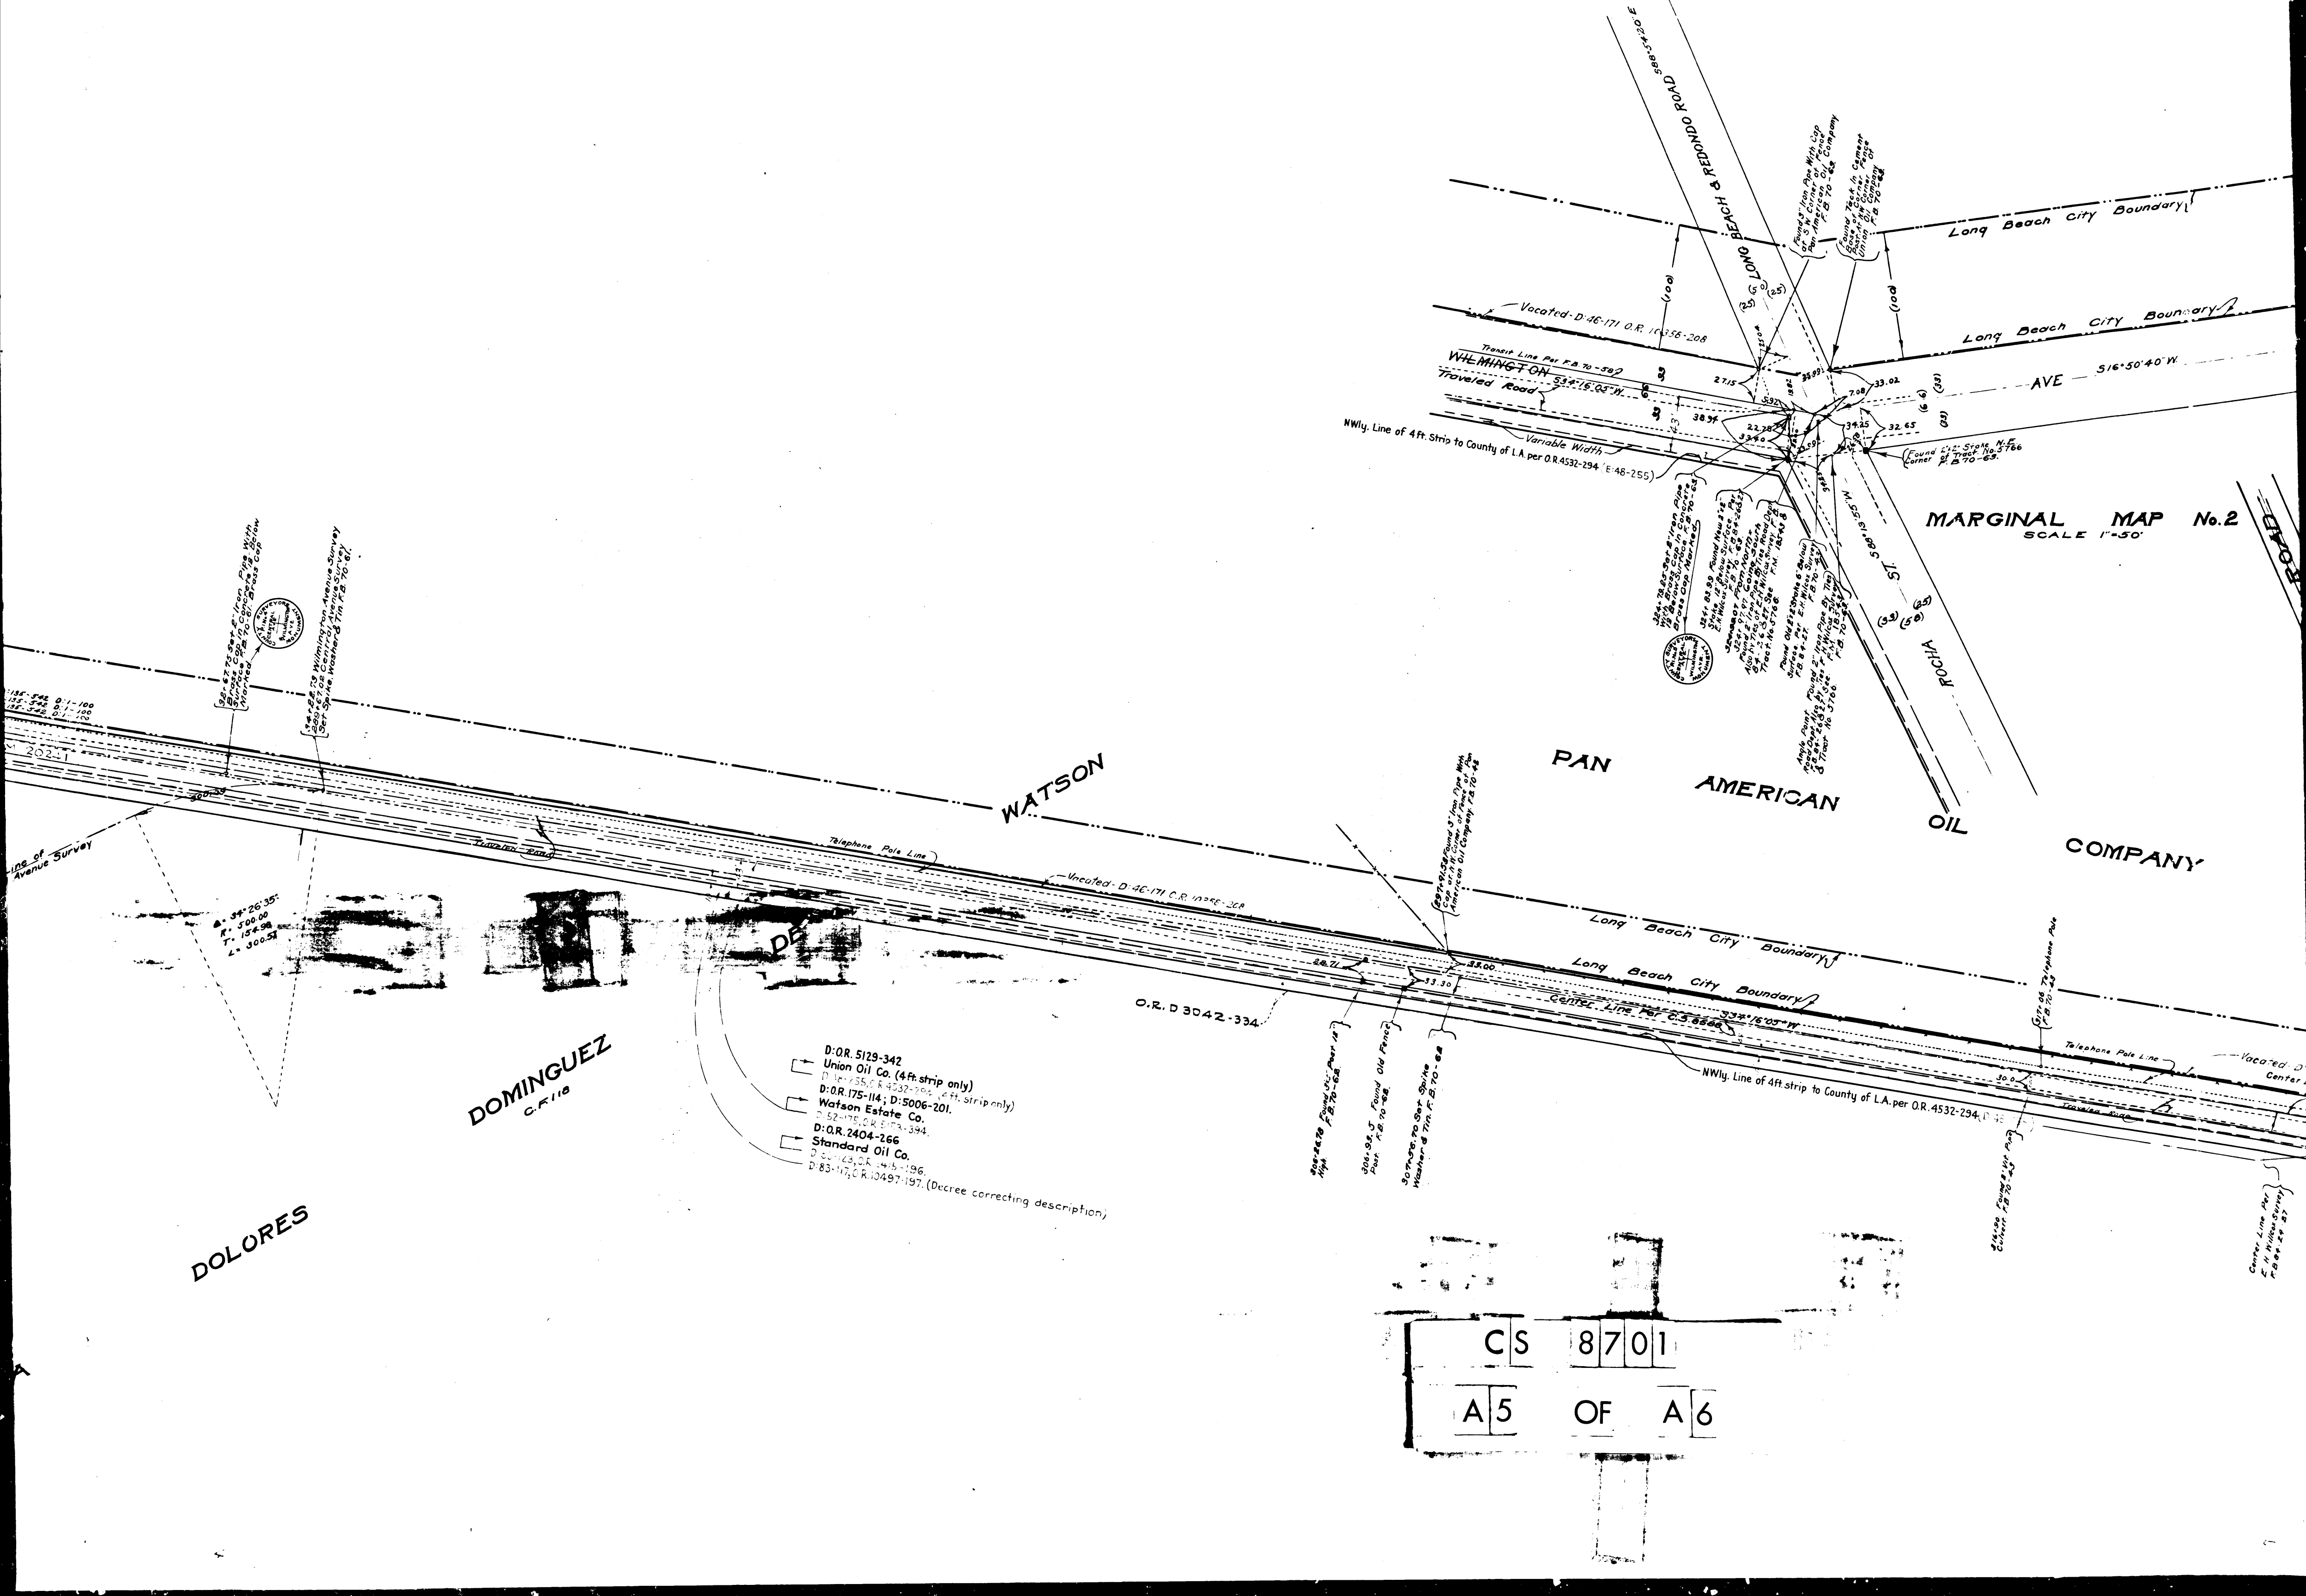

MARGINAL MAP No. 2
SCALE 1"=50'

CS 8701
A5 OF A6

- D:O.R. 5129-342
Union Oil Co. (4 ft. strip only)
D:O.R. 175-114; D:5006-201.
Watson Estate Co.
D:52-175, O.R. 5173-394.
D:O.R. 2404-266
Standard Oil Co.
D:O.R. 175, O.R. 145-196.
D:83-117, O.R. 10497-197. (Decree correcting description)

DOMINGUEZ
C.F. 118

DOLORES

WATSON

PAN
AMERICAN
OIL
COMPANY

Long Beach City Boundary

Long Beach City Boundary

AVE - S16°50'40"W

ANCHOR

Long Beach City Boundary

Long Beach City Boundary

NWly. Line of 4 ft. strip to County of L.A. per O.R. 4532-294, 1:45

Center Line Per
E. H. Wilson Survey
P.B. 10-27

Center Line Per
E. H. Wilson Survey
P.B. 10-27

Long Beach City Boundary



Long Beach City Boundary

AVE 516°50'40"W

7-5105 N.E.
7-5106 N.E.
7-5107 N.E.
7-5200 N.E.

MARGINAL MAP No.2
SCALE 1"=50'

COMPANY

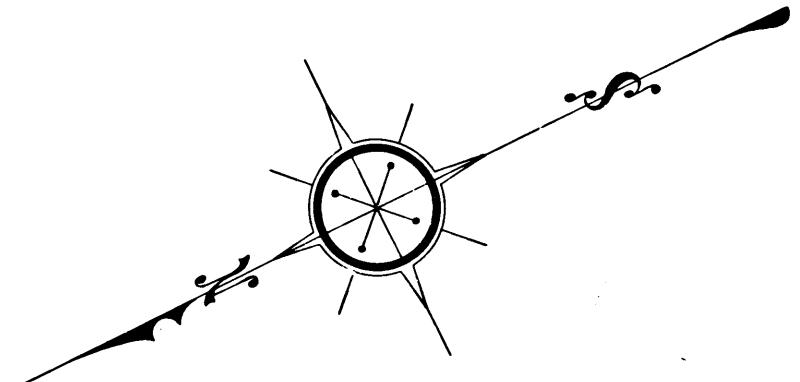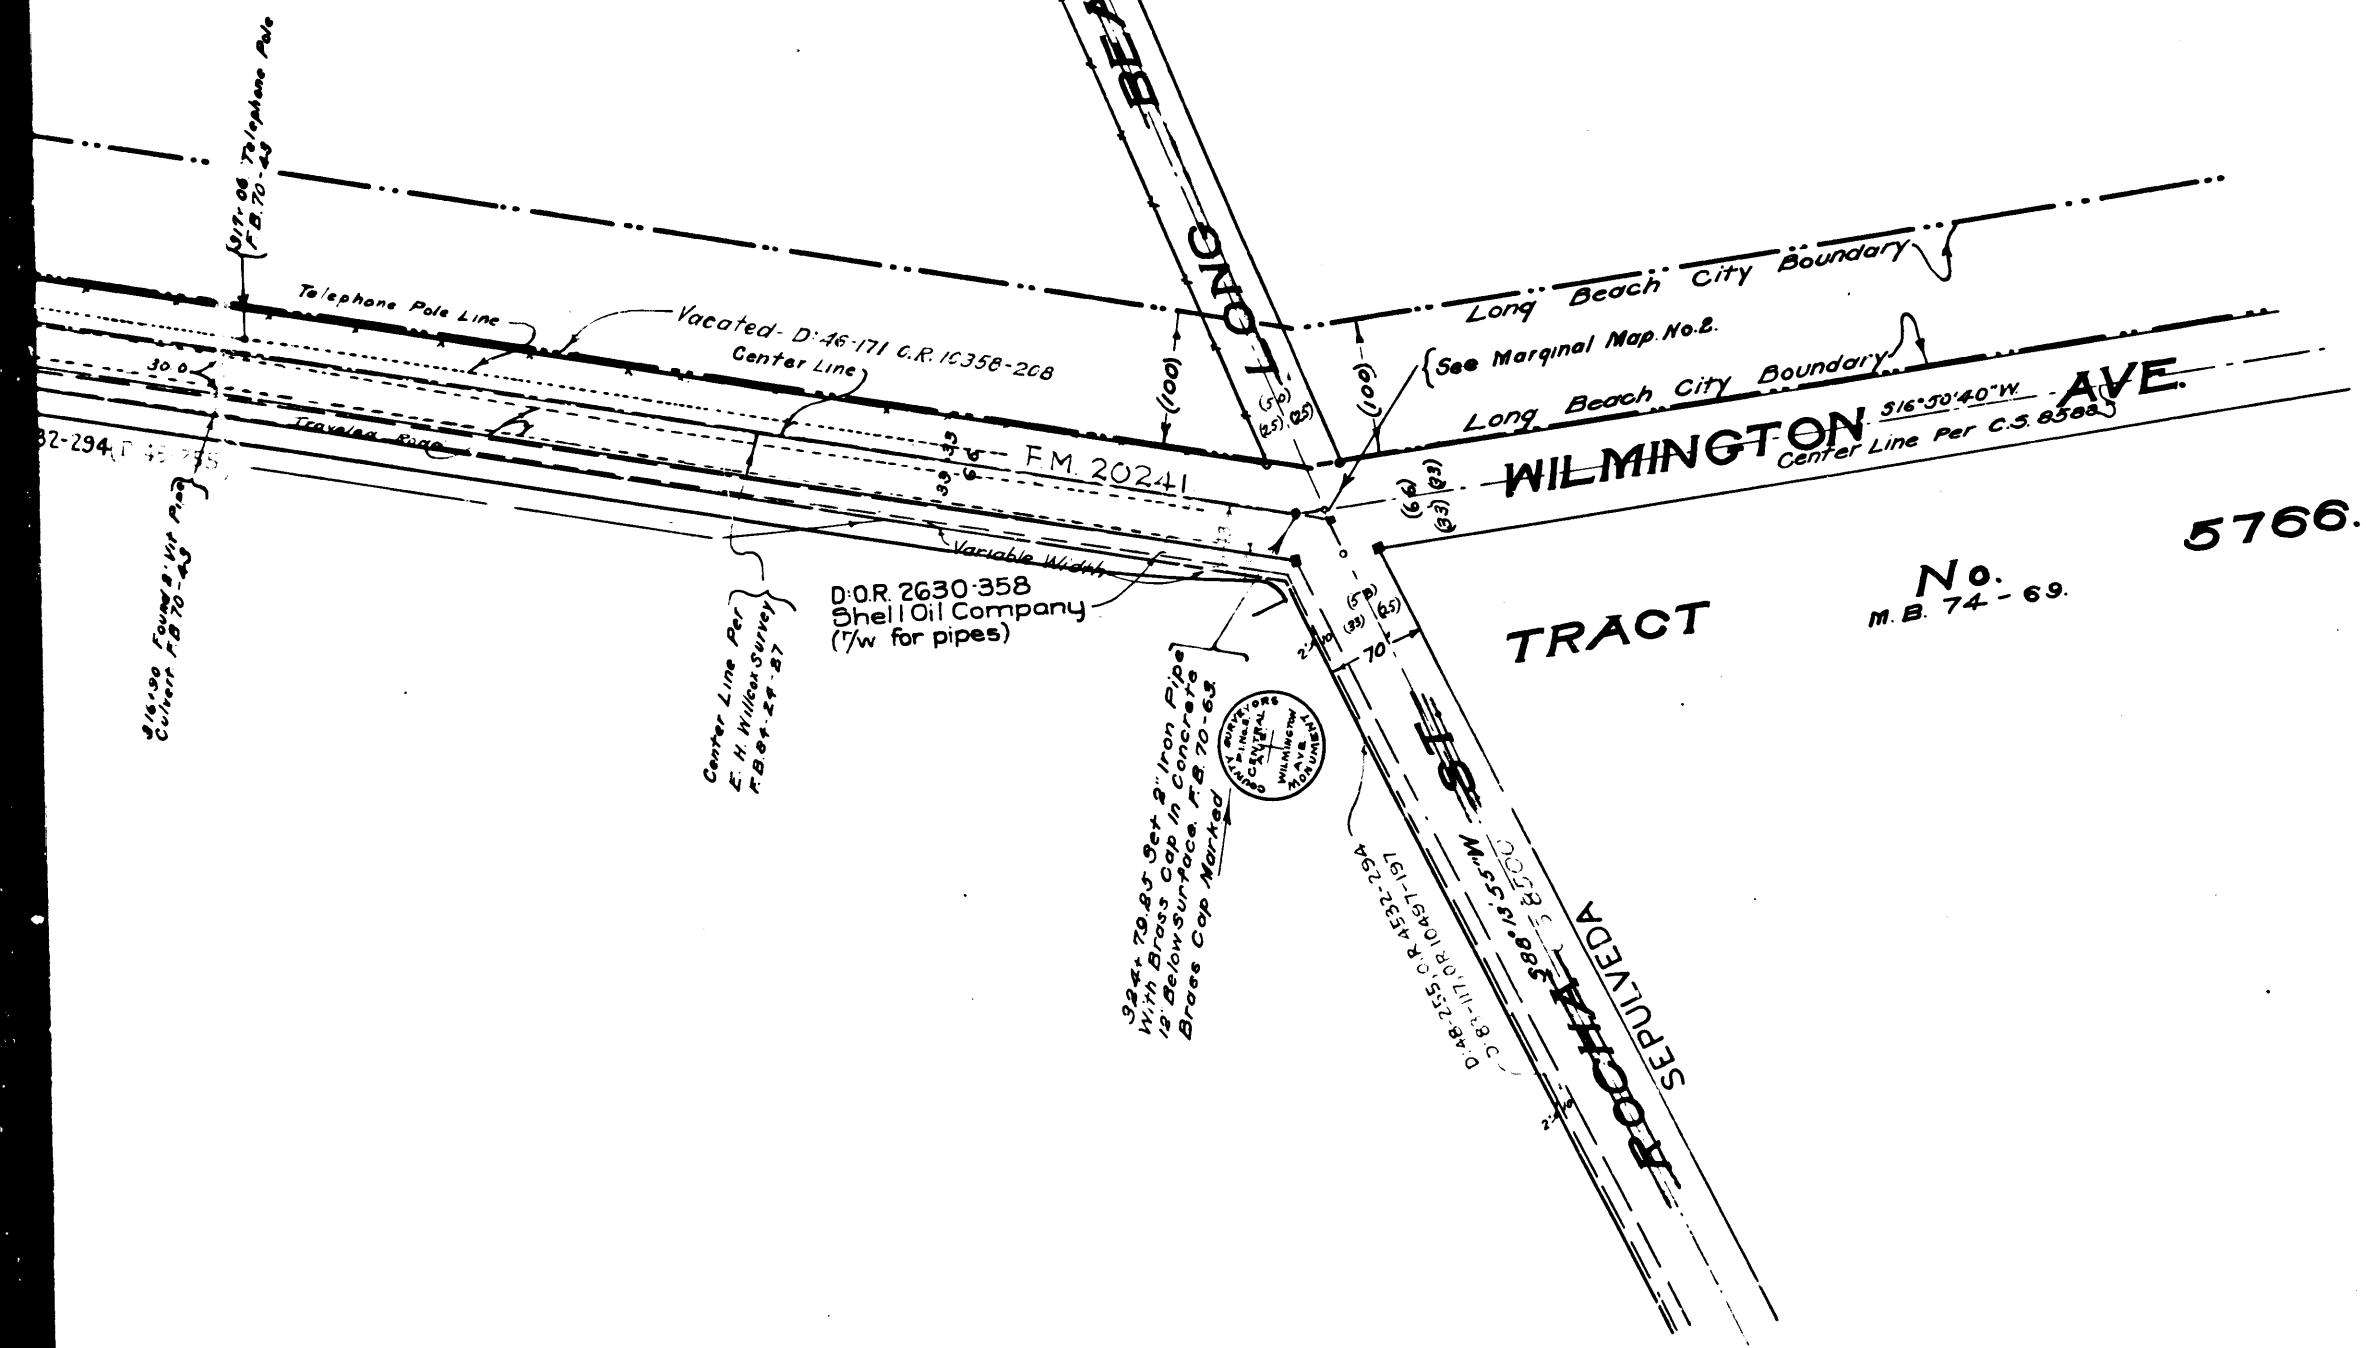

MAP OF WILMINGTON AVENUE

DEL AMO FROM BLVD.
~~LOS ANGELES STREET~~
SEPULVEDA TO BLVD.
~~LONG BEACH REDONDO ROAD~~

COUNTY SURVEYOR'S MAP No. 8701
SCALE: 1-INCH=100 FEET

J.E. ROCKHOLD COUNTY SURVEYOR
SURVEYED AUGUST TO OCTOBER 1933.

Surveyed Under Instructions Of The Board Of
Supervisors For Order Dated May 8, 1933.
Bearings Based On The Bearing Of The Center
Line Of Central Avenue As Shown On C.S. 8588.

F.B. 70-19 to 69
Field Work By A.E. Dunn
Office Work By E.J. Brook
Checked By R.R. Taylor

Sht. 30
26
28

Los Angeles St. changed to Del Amo St. D. 49-33 R.B. 40-122

CS	8701
A6	OF A6

M.R. 32 - 97 - 98.

No.
M.B. 50-21-22.

4546

4054

C	S	8	7	0	1
---	---	---	---	---	---

A 3 OF A 6

MARGINAL MAP
SCALE 1" = 50'

WILMINGTON