

**POMONA CITY
GANESHA PARK LINE
TRACK MAP**

From Holt Ave. to Junction with Covina-Pomona Line, also Covina-Pomona Line from Garey Ave. West to S.P.R.R.


SCALE 1" = 100'

March 22, 1910

| GANESHA PARK WEST TRACK (S. Bound) | | | | | GANESHA PARK EAST TRACK (N. Bound) | | | | | | | | |
|------------------------------------|------|---------|-------|---------|------------------------------------|------|------------|------|---------|-------|---------|-----------|------|
| Date | Lead | Lin Ft. | Sta. | To Sta. | Rel. Sec. | Ties | Date | Lead | Lin Ft. | Sta. | To Sta. | Rel. Sec. | Ties |
| June 22, 09 | 3044 | 29+00 | 42+00 | 20+00 | 66-87 | W.M. | Nov 29, 09 | 298 | 11+00 | 17+00 | 20+00 | 66-87 | W.M. |
| Nov 20 | 585 | 19+00 | 25+00 | | | | Dec 1, 09 | 820 | 7+00 | 13+00 | | | |
| 82 | 865 | 17+00 | 23+00 | | | | 18 | 824 | | | | | |
| 83 | 33 | 17+00 | 17+00 | | | | | | | | | | |
| March 6, 10 | 15 | 25+00 | 25+00 | 15 | SPRR | | | | | | | | |


| COVINA-POMONA W of Garey Ave to S.P.R.R. SOUTH TRACK | | | | | COVINA-POMONA W of Garey Ave to S.P.R.R. NORTH TRACK | | | | | | | | |
|--|------|---------|-------|---------|--|------|-----------|------|---------|------|---------|-----------|------|
| Date | Lead | Lin Ft. | Sta. | To Sta. | Rel. Sec. | Ties | Date | Lead | Lin Ft. | Sta. | To Sta. | Rel. Sec. | Ties |
| Dec 5, 07 | 270 | 0+00 | 2+00 | | | | Dec 2, 07 | 82 | 1+00 | 1+20 | 1+20 | 66-87 | W.M. |
| Nov 26, 09 | 585 | 2+00 | 8+00 | | | | 4, 07 | 131 | 1+20 | 3+00 | | | |
| Dec 16 | 474 | 8+00 | 13+00 | | | | | | | | | | |
| 30 | 850 | 13+00 | 24+00 | | | | | | | | | | |
| Jan 5, 10 | 400 | 18+00 | 24+00 | | | | | | | | | | |
| 5 | 400 | 18+00 | 24+00 | | | | | | | | | | |
| 6, 10 | 483 | 18+00 | 18+00 | | | | | | | | | | |

Notes—Construction Notes & Stationing shown in red.
Stations on preliminary line shown in black.

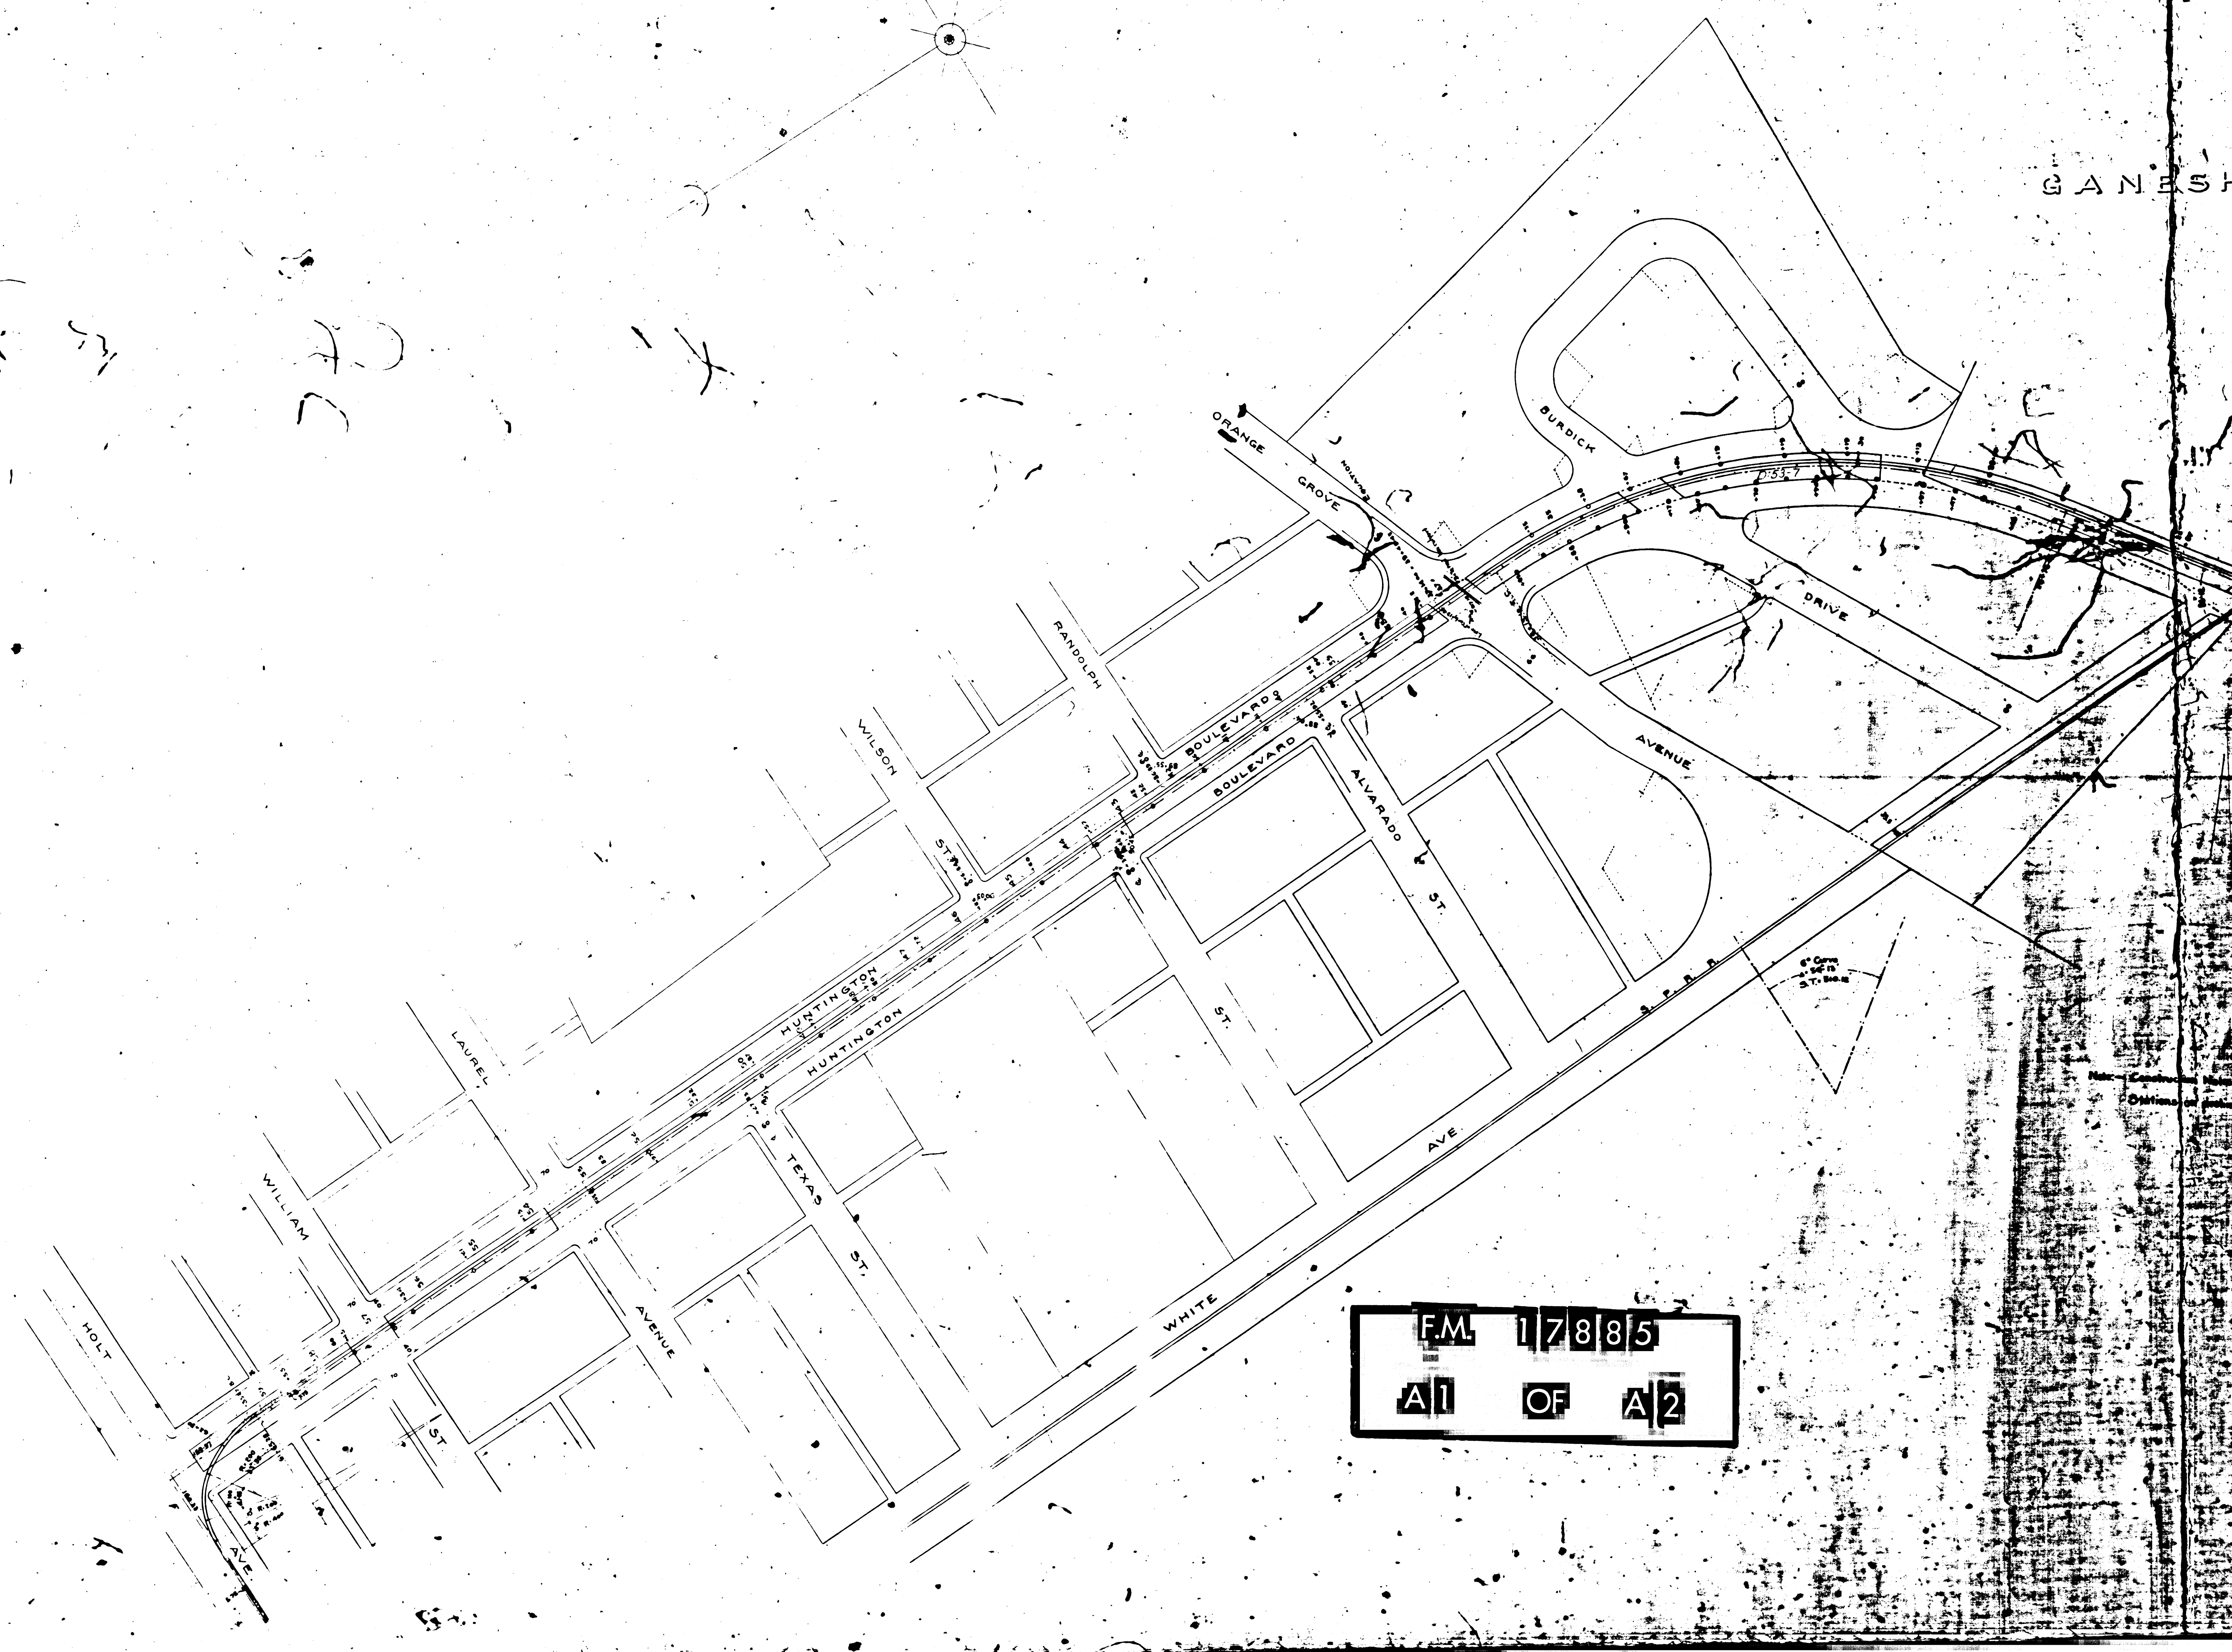

GANESHA

FM 17885
A1 OF A2

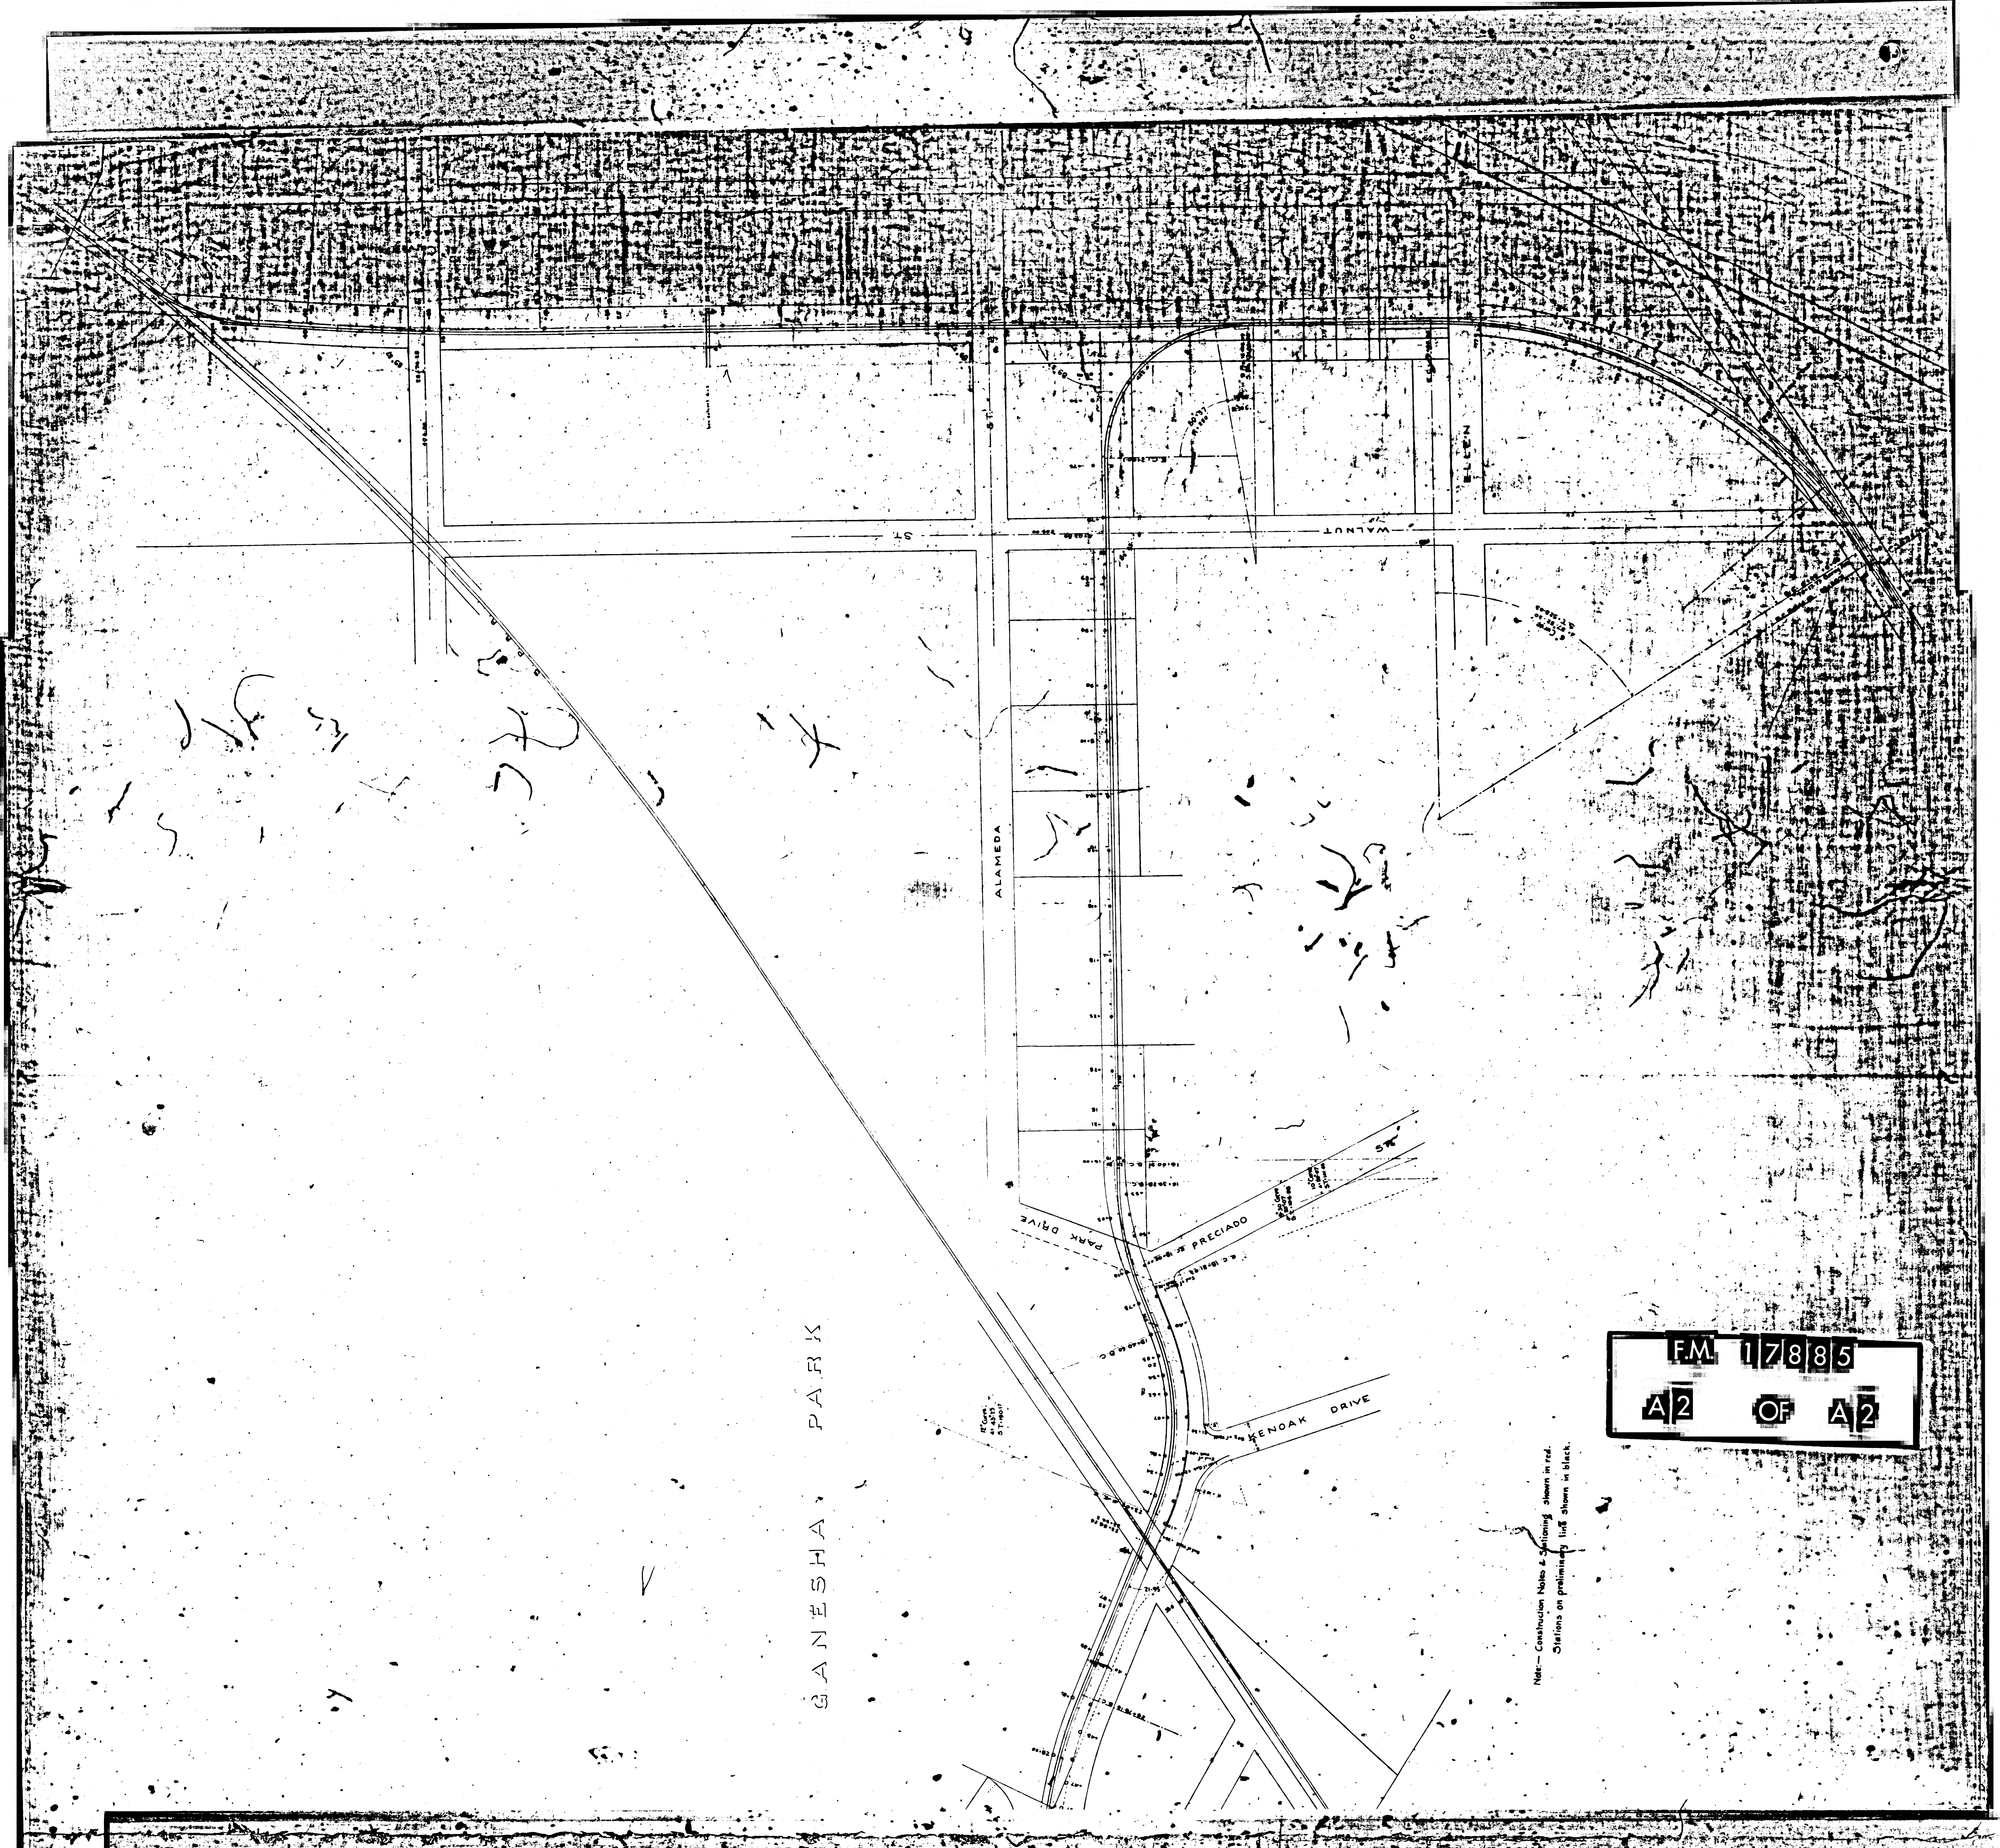

GANESHA PARK

FM 17885
A2 OF A2

Note - Construction Notes & Scaffolding shown in red.
Obstacles on preliminary layout shown in black.