

**SURVEY OF PART OF
HELLMAN TRACT
AND
CALIFORNIA CO-OP COLONY TRACT**

MAY 1911.

N.B. 257-9 SCALE 200'=1"

-25-28

-51

C.B. 40-


RED LINES RECORD OF HELLMAN TR.

IM 32

Note:— This map traced in County
Surveyor's Office May 1, 1916 from
Map borrowed from E.T. Wright

Notes and figures shown in blue
were added by County Surveyor.
Per. to City of Long Beach for St. purp. D: 41-169.

F.M. 118052

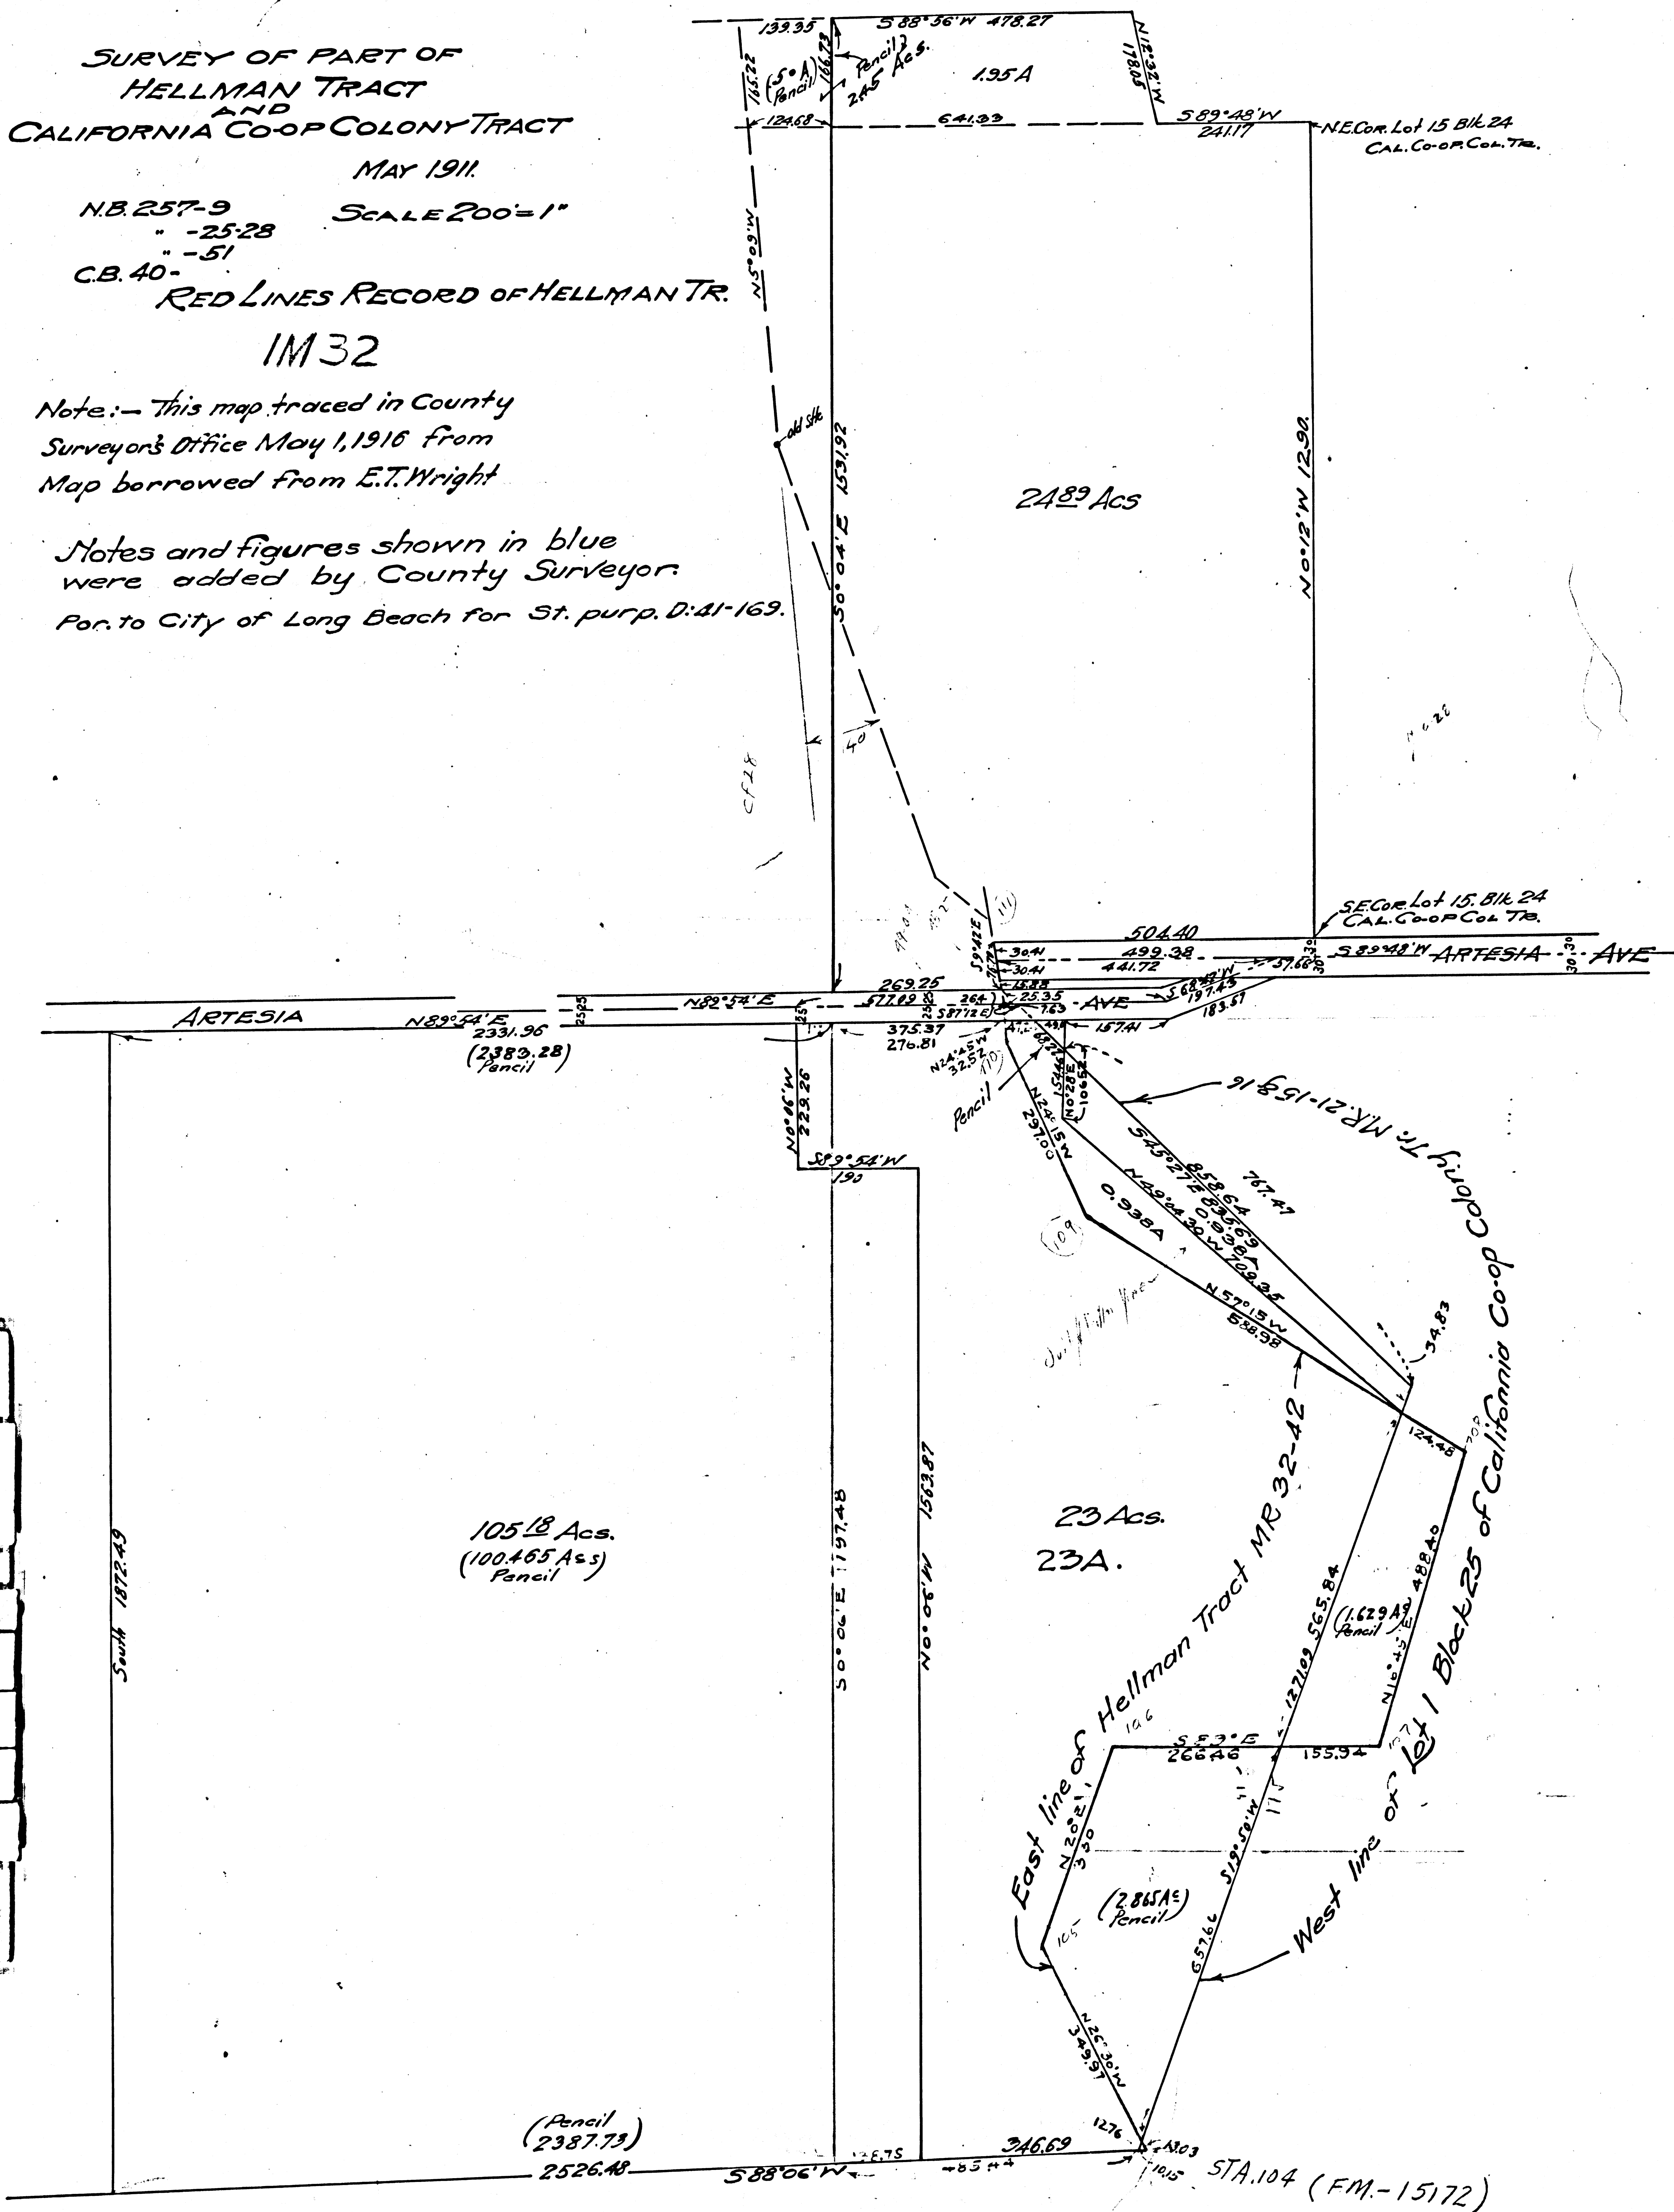

68.05
19.27
167.56