


△ SEE DRAWING AS BUILT
 on Detail Sht. EMMA 119-122-123-125-127-129

△ DRAWING AS BUILT
 on Detail Sht. EMMA 119-122-123-125-127

| | |
|--------------------------------------|-----------------|
| CONSTRUCTION PLAN | |
| MOUNT EMMA RD. PHASE I | Proj. No. 016 I |
| Angeles Forest Hwy. to Cheseboro Rd. | Sht. 2 of 19 |

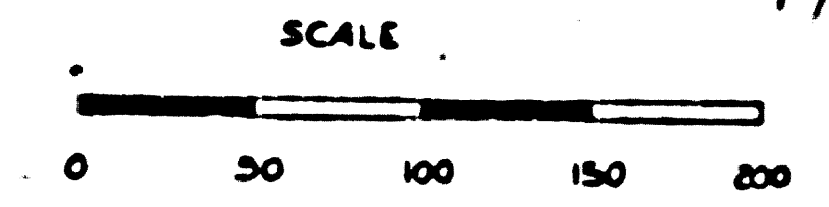

FM 21837-1 (A1 OF A2)

LOS ANGELES COUNTY ROAD DEPT.
 TOPOGRAPHIC MAP
MT EMMA ROAD
 FROM
 ANGELES FOREST HIGHWAY
 TO
 3 MILES NORTHEAST
 PREPARED BY: [Name] & ASSOCIATES
 3145 70th St., Los Angeles, Calif. 90044
 DATE: 1961
 SCALE: 1" = 400'
 SHEET: 2 OF 19

