


CONSTRUCTION PLAN
MOUNT EMMA RD. PHASE I
Angeles Forest Hwy. to Cheseboro Rd.
 Proj. No. 016 I
 Sht. 3 of 19

▲ - SIDE DRAIN - AS BUILT
 For Detail See R.D.F.B. 2725-129; R.D.F.B. 2726-27-29-231-233-235
 ▽ - DRAIN PIPE - AS BUILT
 For Detail See R.D.F.B. 2725-129; R.D.F.B. 2726-27-231-233-235

Note: align. per: R.D.F.B. 2725, 2824, 2926, 2927.

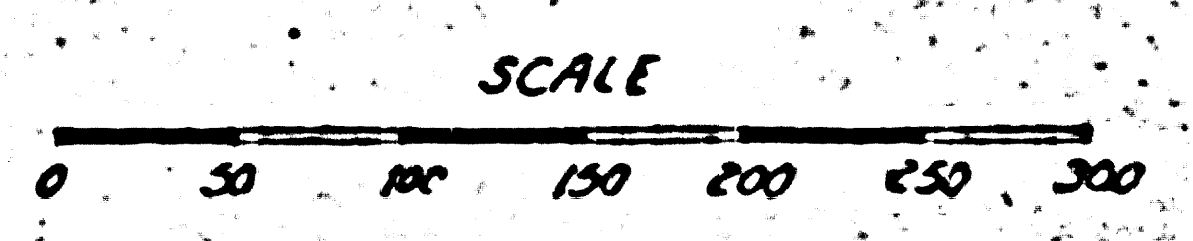


U3618
 Phase I
AS BUILT
 Date: 12/21/19
 LOS ANGELES COUNTY ROAD
 TOPOGRAPHIC MAP
 MT. EMMA ROAD
 ANGELES FOREST HIGHWAY
 3 MILES APPROXIMATE

FM 21837-2 (A1 OF A2)

MOUNT EMMA ROAD PHASE I
 AS BUILT
 SHEET 3 OF 19

19226
19227
19228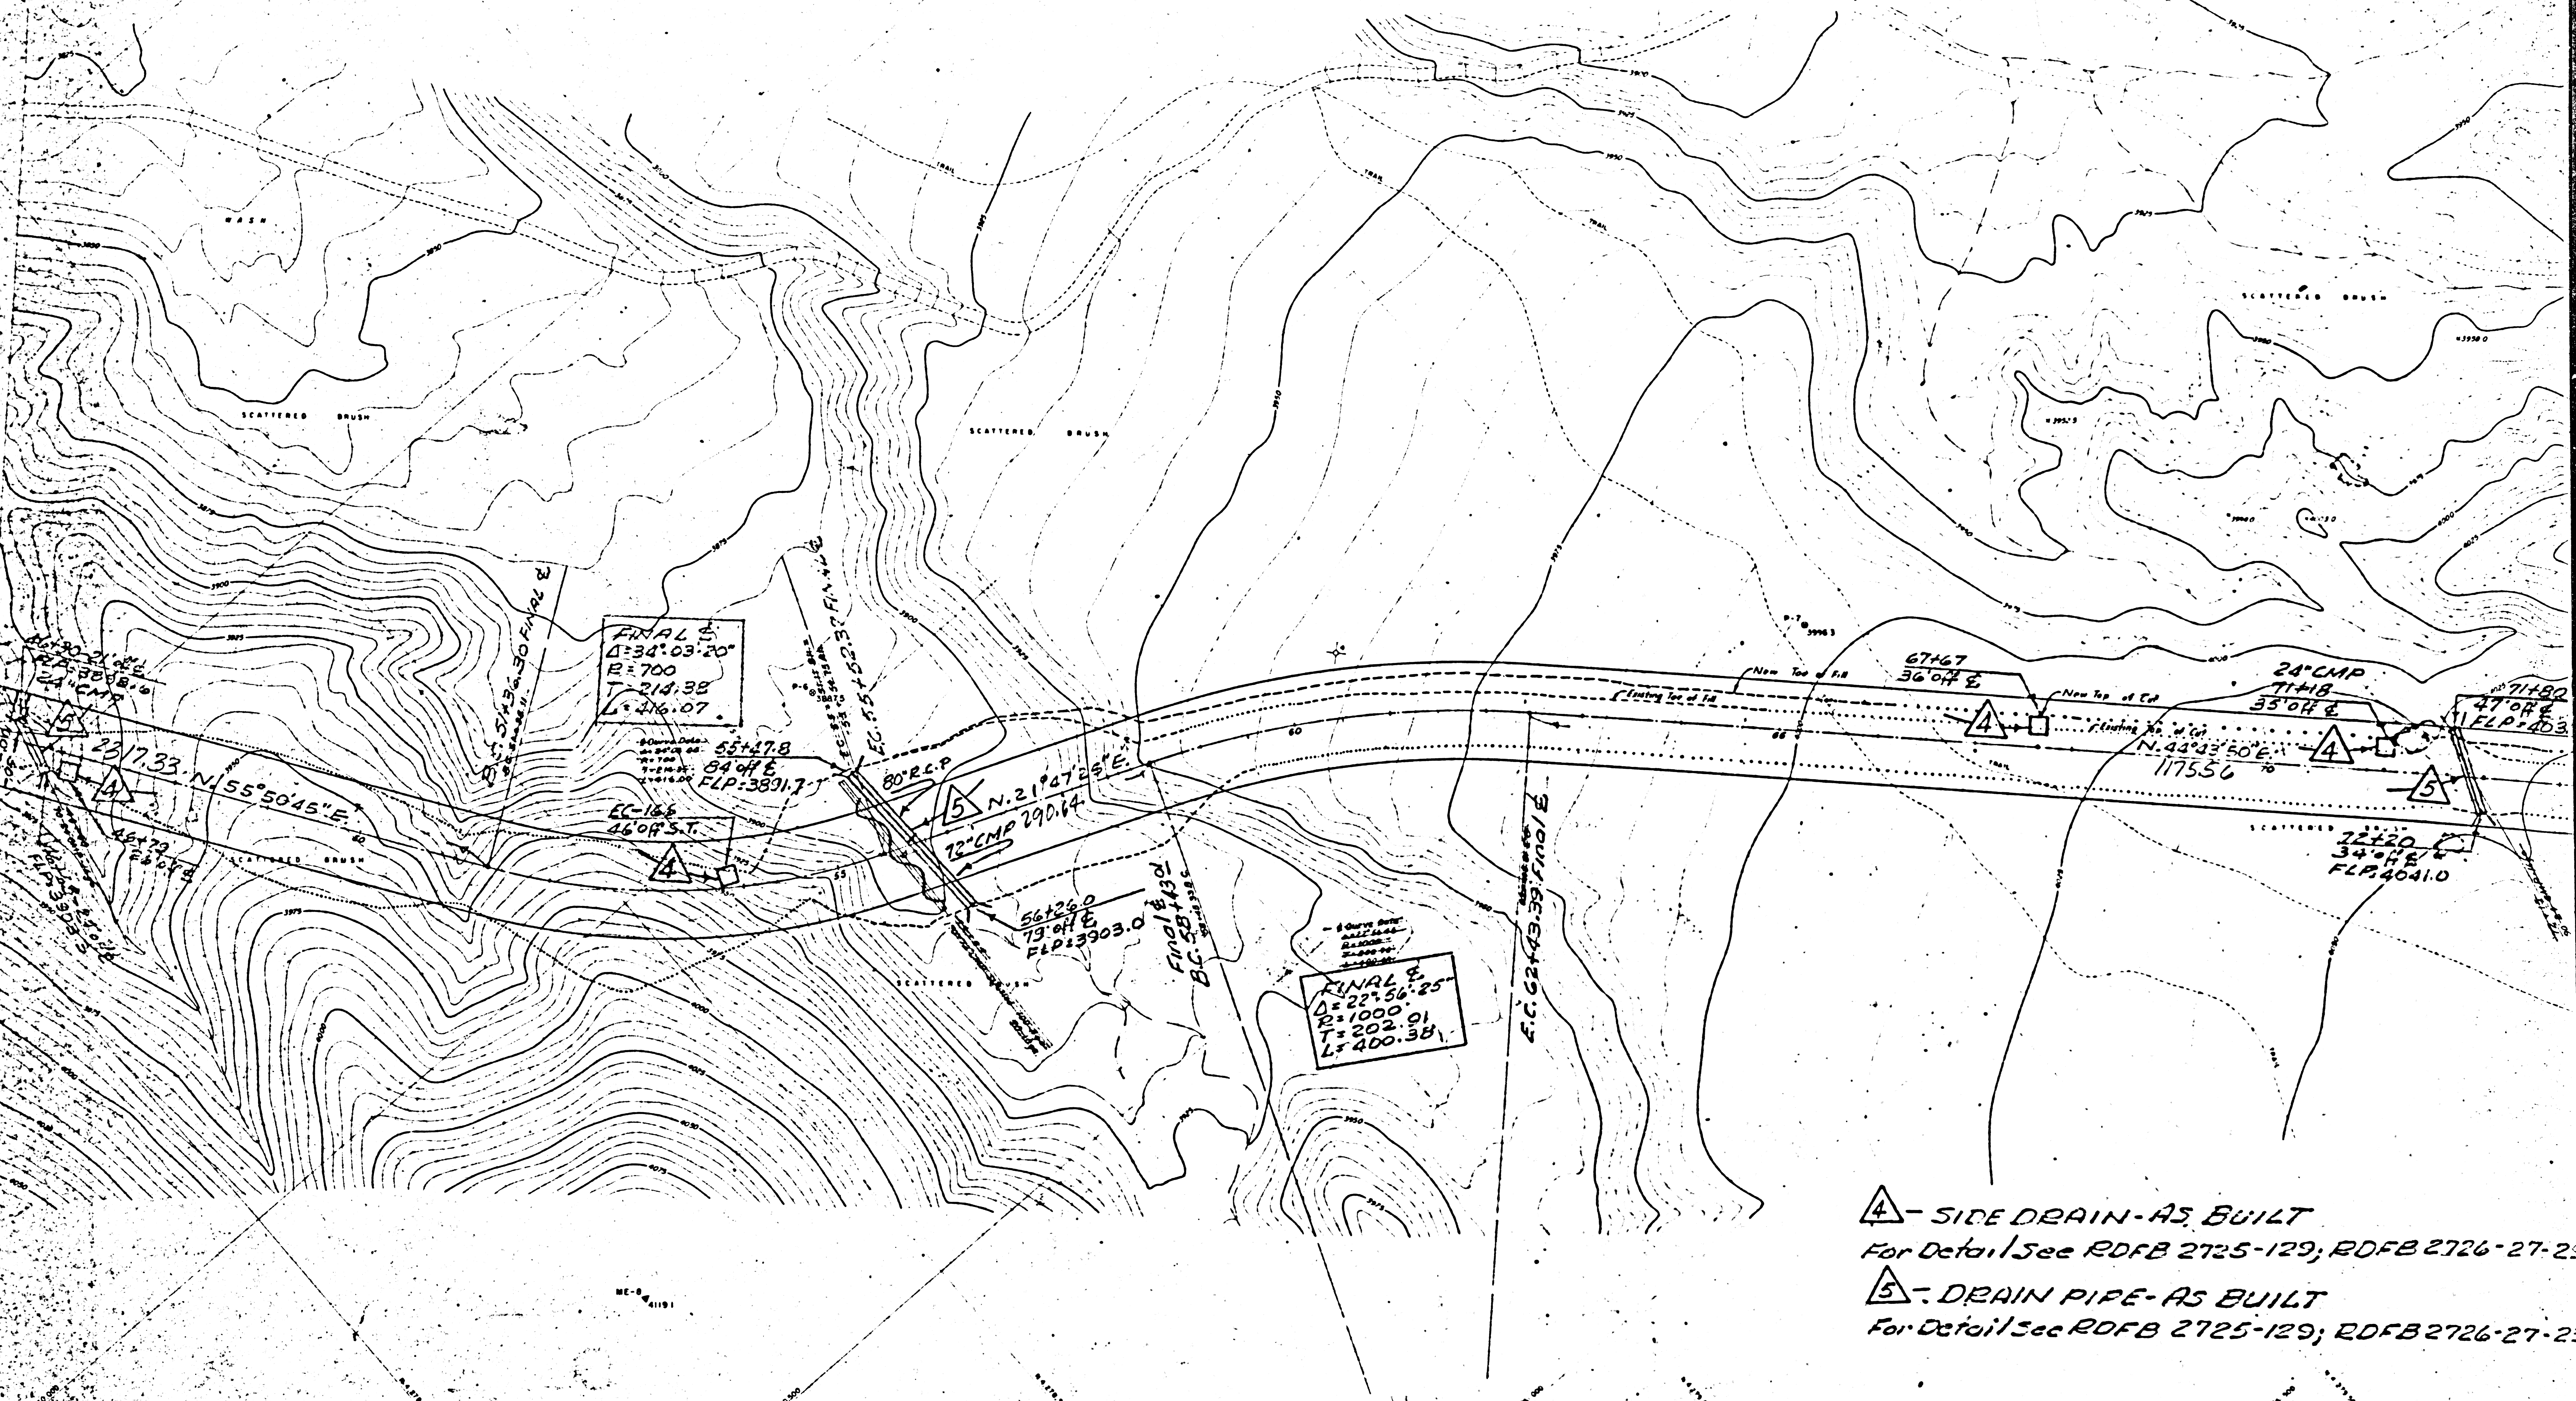
△ - SIDE DRAIN - AS BUILT
For Detail see RDFB 2725-129; RDFB 2726-27-2.

△ - DRAIN PIPE - AS BUILT
For Detail see RDFB 2725-129; RDFB 2726-27-2.

FM 21837-2 (A 2 OF A2)