



△ - SIDE DRAIN - AS BUILT  
For Detail See RCFB 2826-243-244-246

▽ - DRAIN PIPE - AS BUILT  
For Detail See RCFB 2826-243-244-246

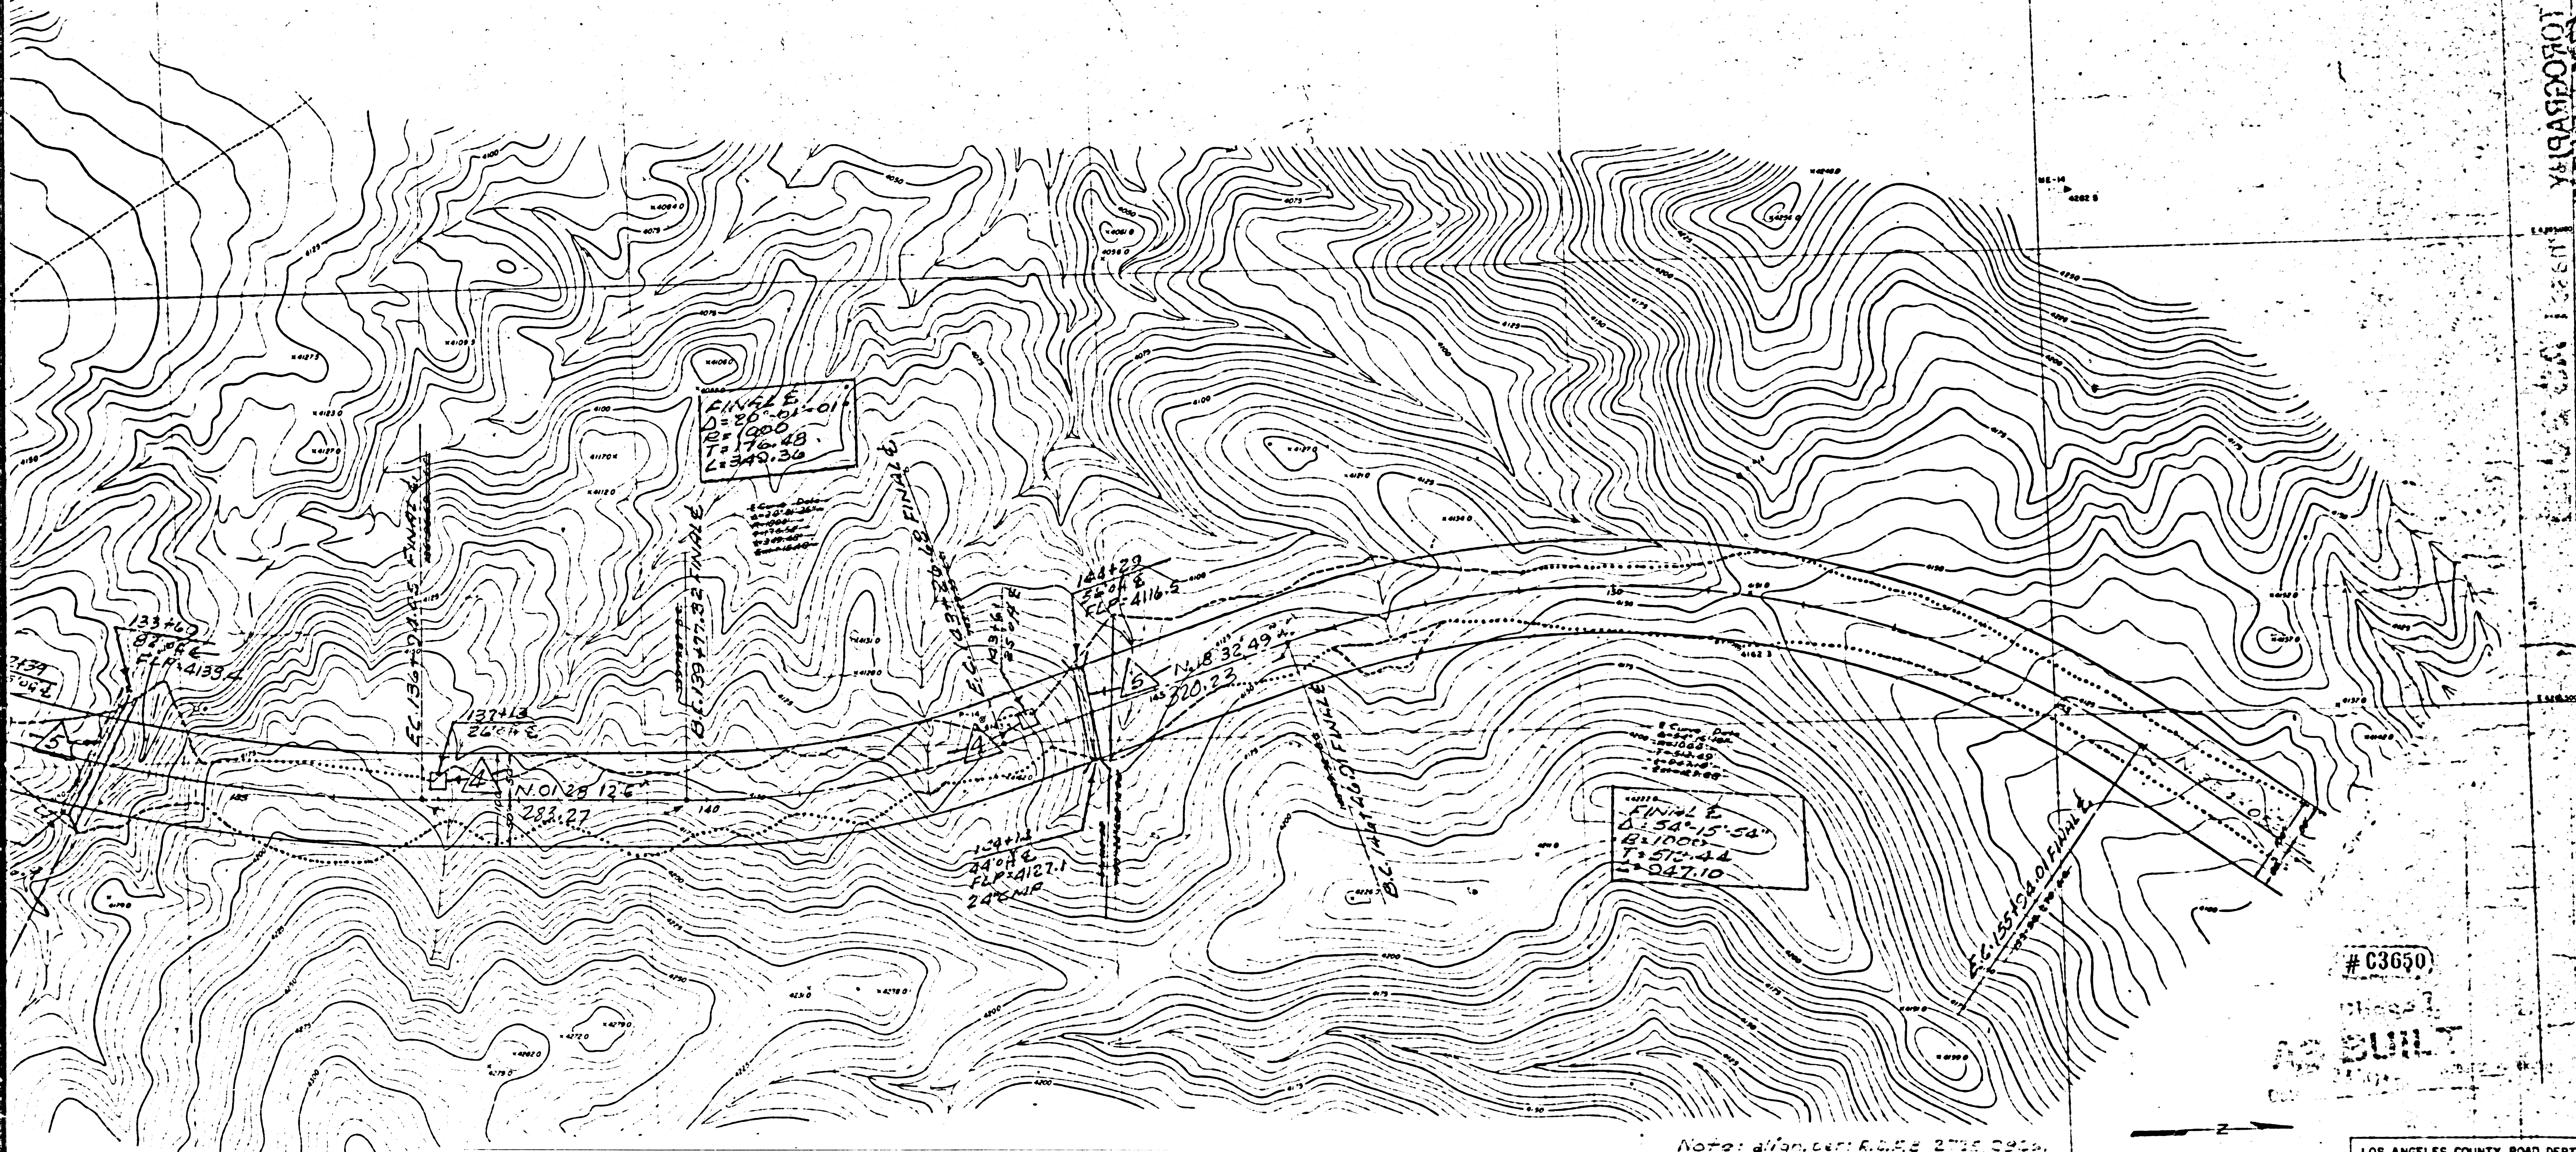

Note: all angles per R.C.S.B. 2755, 2926, 3026, 3126

**CONSTRUCTION PLAN**  
MOUNT EMMA RD. PHASE I  
Angeles Forest Hwy. to Cheseboro Rd.  
Proj. No. 016 I  
Sht. 5 of 19

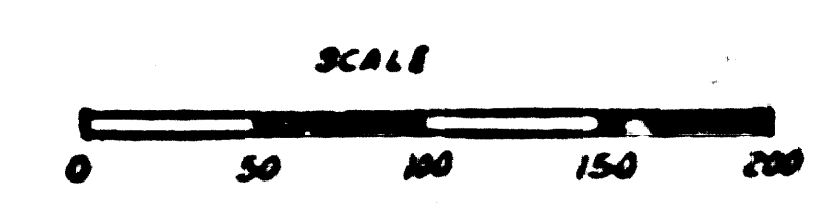


# C3650  
LOS ANGELES COUNTY ROAD DEPT.  
TOPOGRAPHIC MAP  
MT. EMMA ROAD  
FROM  
ANGELES FOREST HIGHWAY  
TO  
5 MILES NORTHEAST  
PREPARED BY: [Name] & ASSOCIATES  
DATE: [Date]  
SCALE 1"=100'  
SHEET 5 OF 19 SHEETS

FM 21837-4 (A1 OF A2)

△ - SIDE DRAIN - AS BUILT  
For Detail See RDFB 2826-243-244-246

△ - DRAIN PIPE - AS BUILT  
For Detail See RDFB 2826-243-244-246

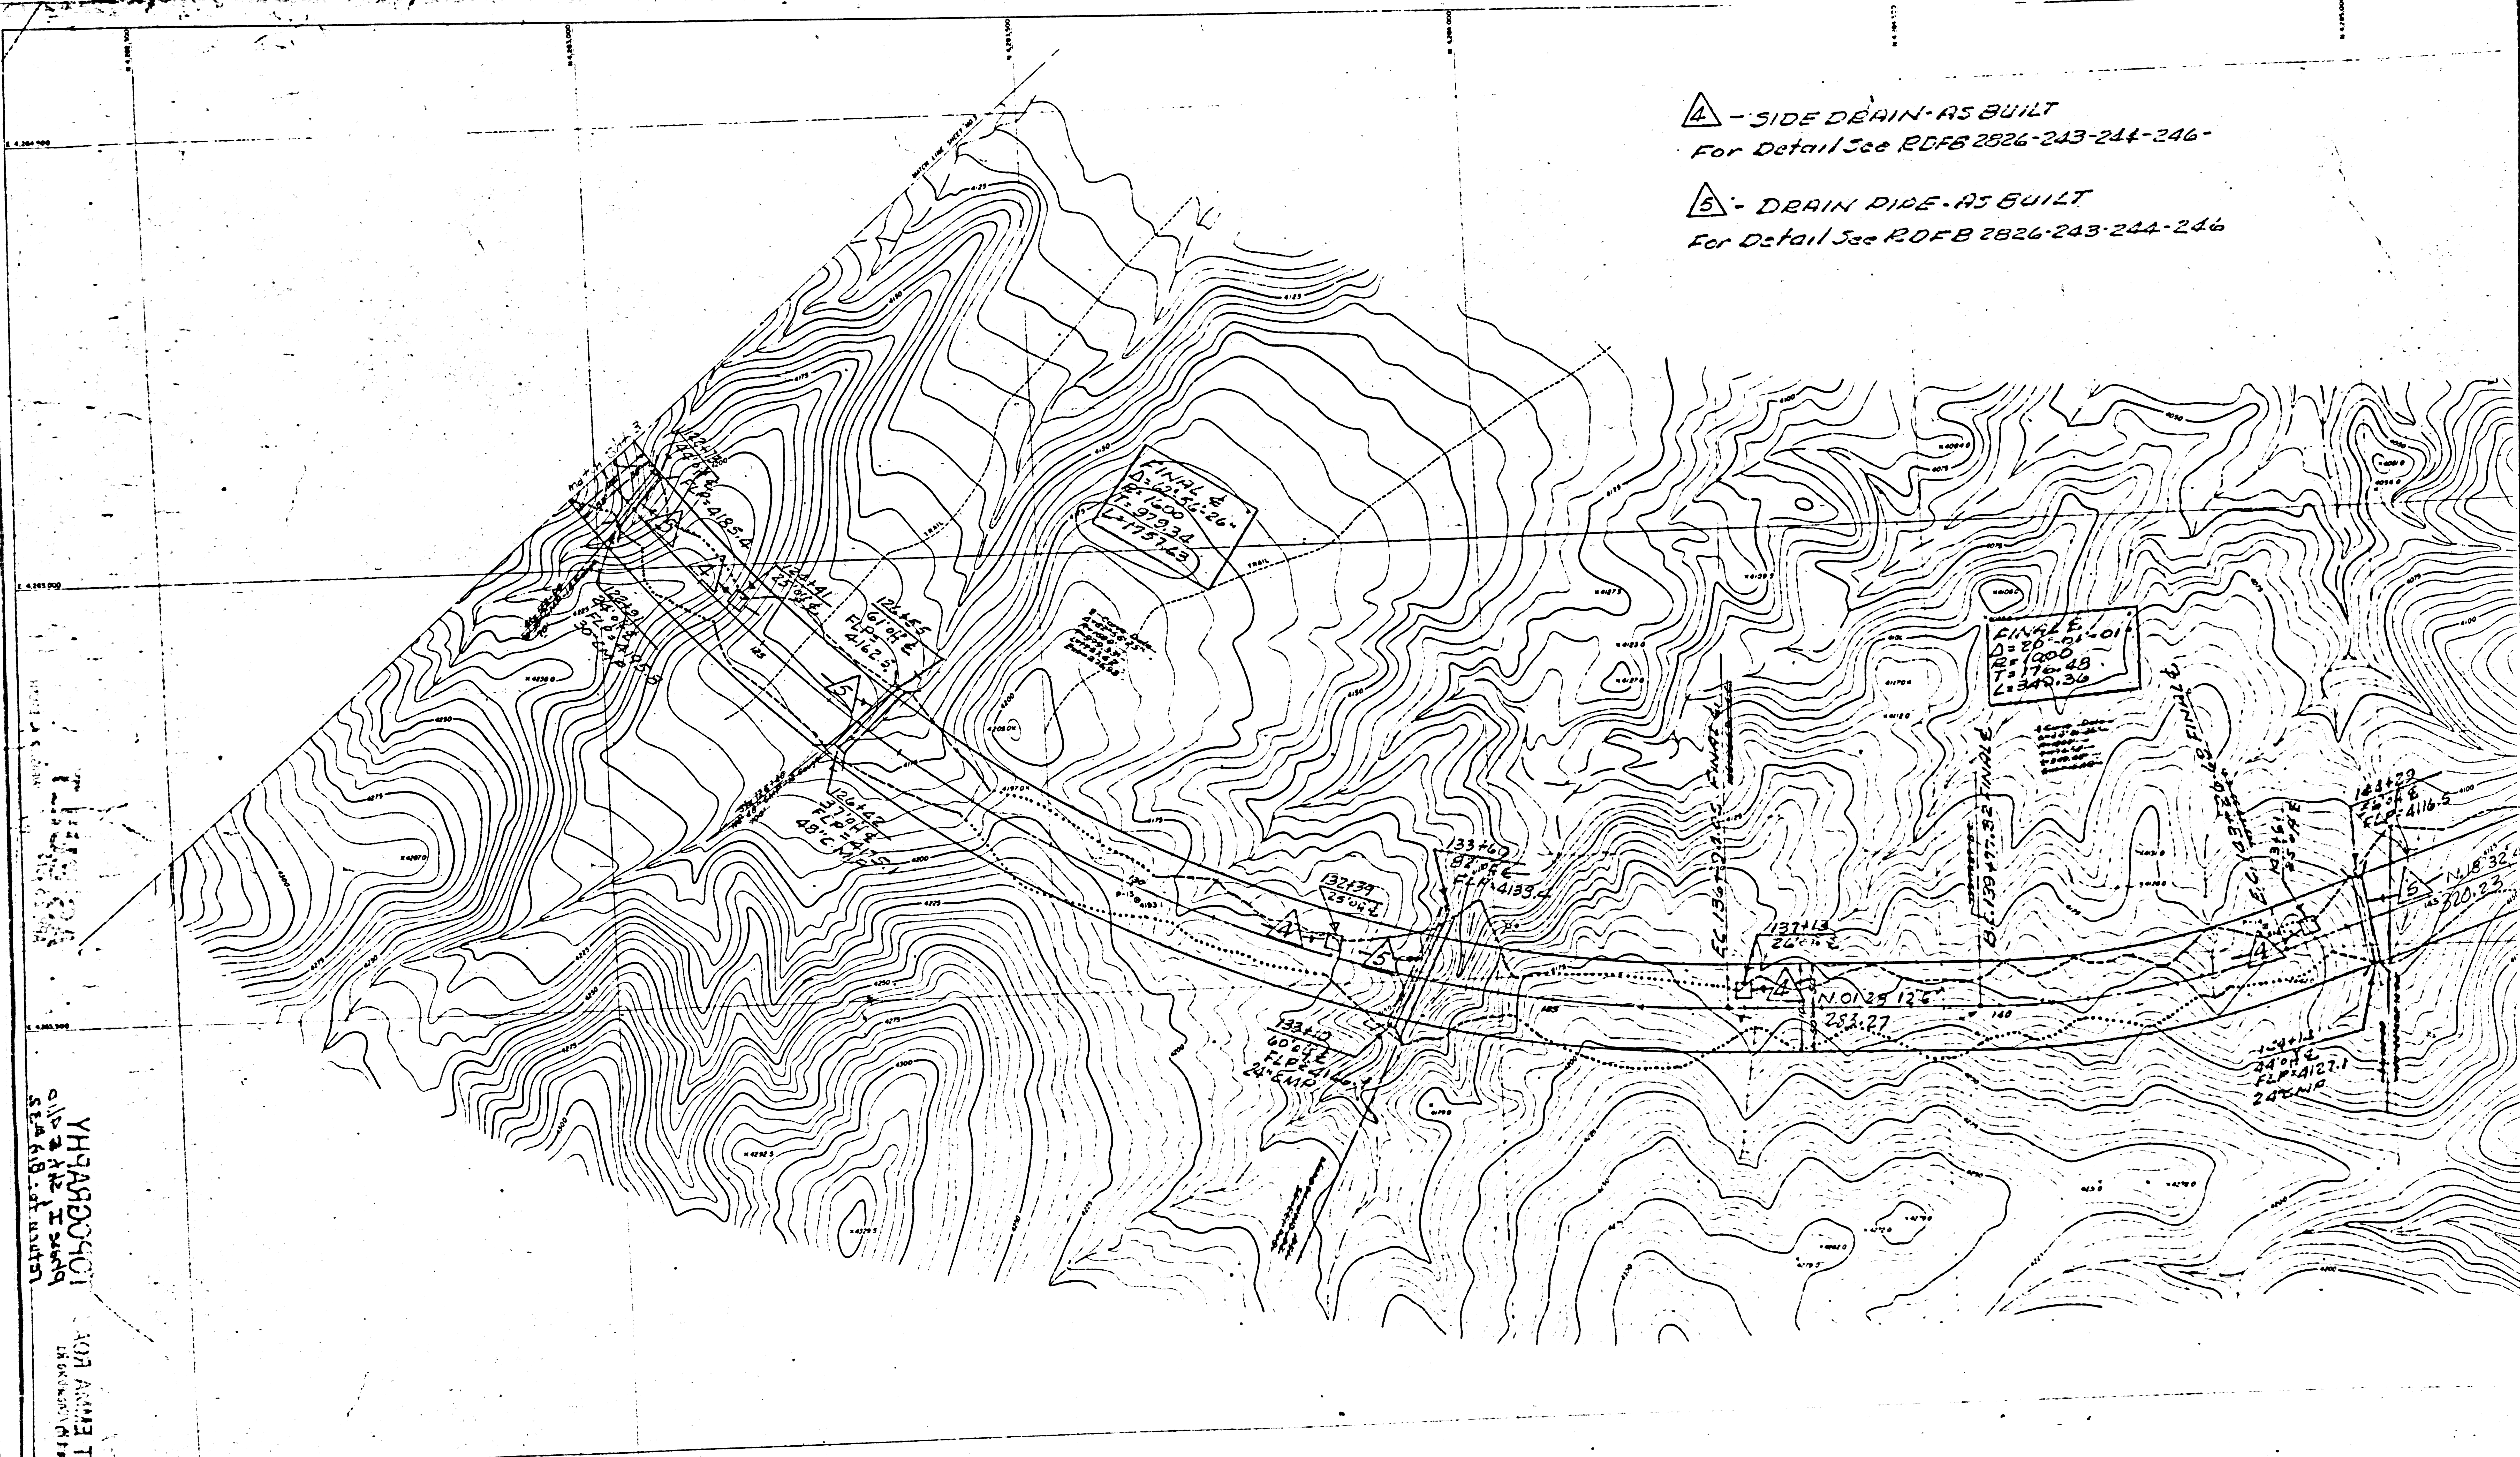

YH9A90901  
012 2 12 I 2009  
SIA 618 01 100781

NOV 11 1954  
ENGINEERING  
CORPORATION

FM 21837-4 (A2 OF A2)