
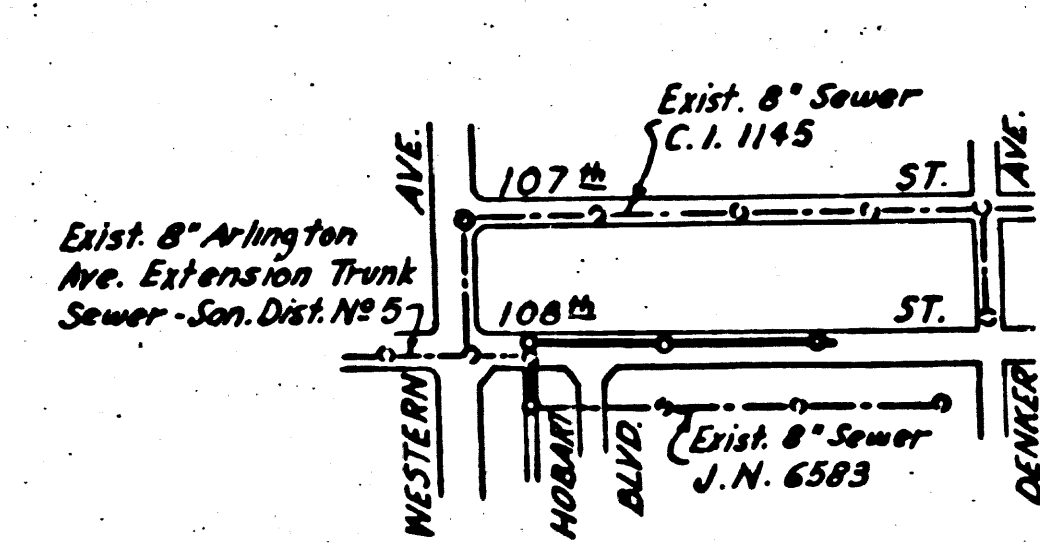
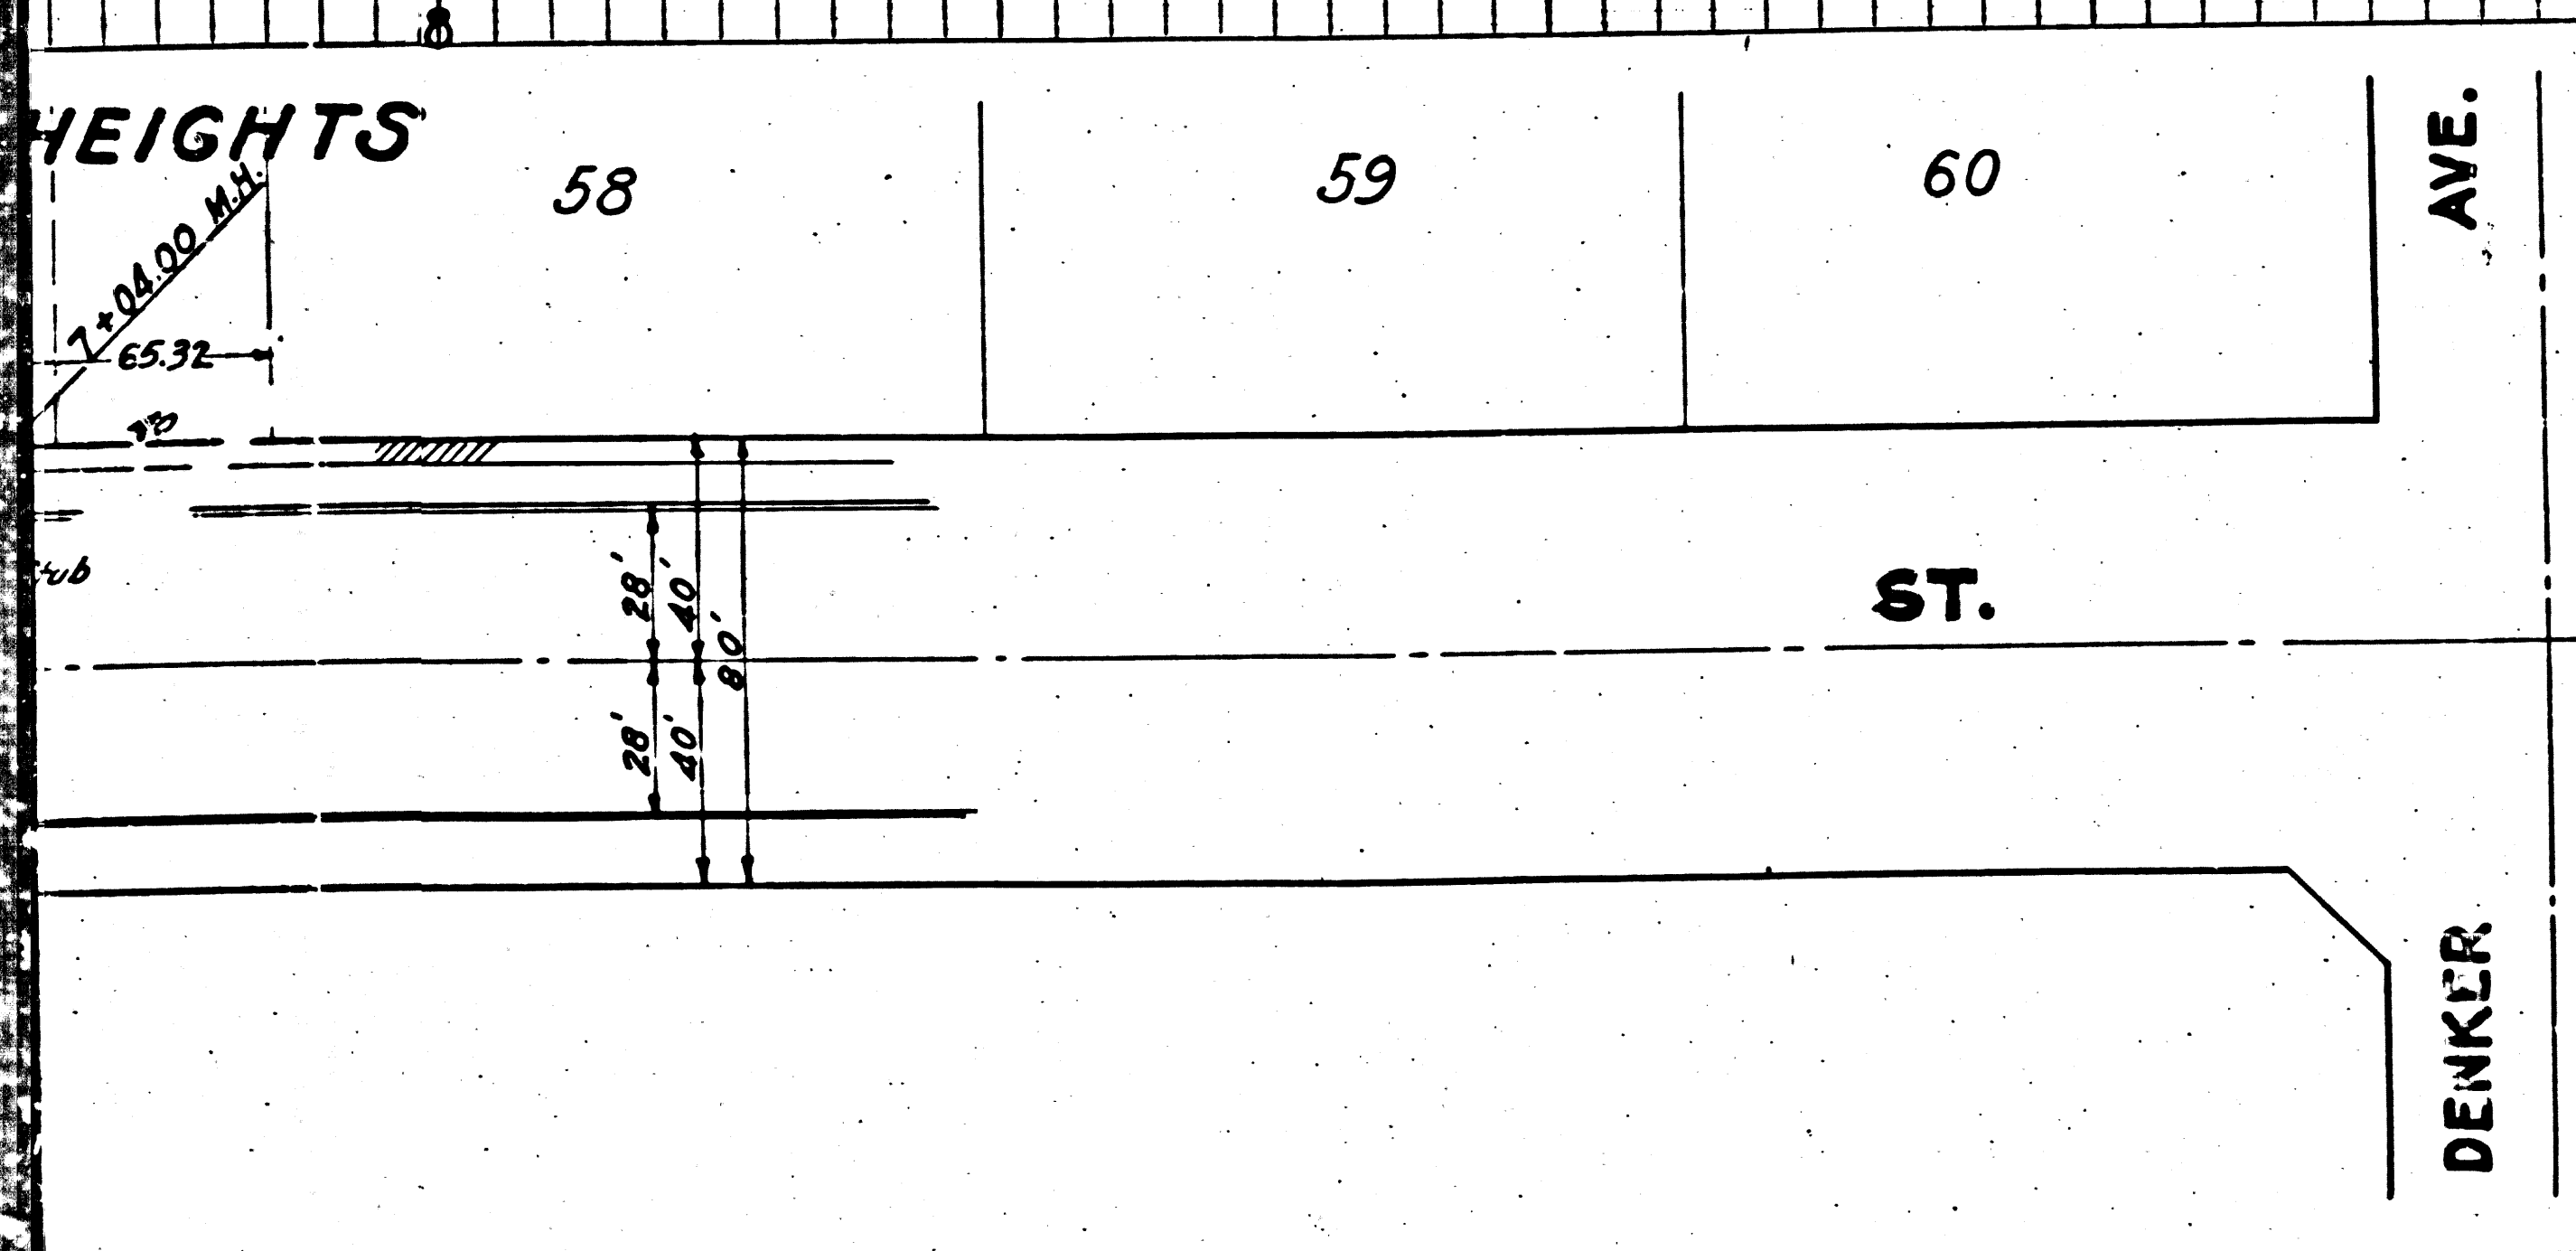


SERVED BY SEWER IN EASEMENT AT REAR

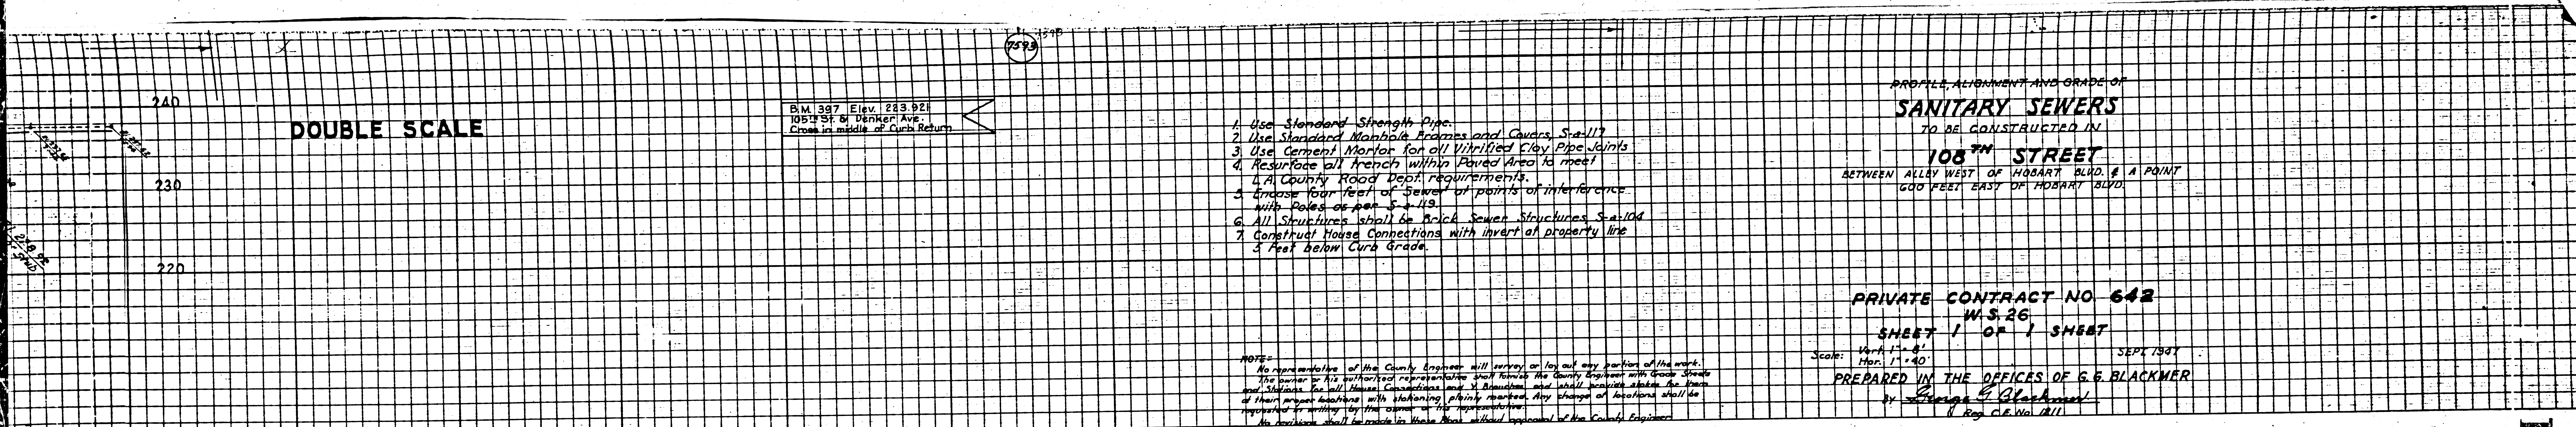

**P.C. N8642
INDEX MAP
Scale: 1"=600'**

Final C.R.P. 2/19/48

FOR LEGEND
See Plan No. S-a-64

NOTE:
Grades to which this improvement is to be constructed are shown on Plans and Profile. Grade points for top of curb, center line of street, or center line of alley are shown by circles on Profile. At all points between designated points the grade shall be established as to conform to a straight line shown between said designated points. Elevation are in feet above U.S.C.S. Datum or Mean Sea Level. This drawing and the data hereon are hereby made a part of the specifications. Work shall be constructed according to specifications on file in the office of the County Engineer and shall be prosecuted only in the presence of the County Engineer. Bid and mark can be started, the Contractor must obtain a permit to excavate in County streets from the L.A. County Road Dept., 104 Hall of Records and make a deposit with the County Engineer, 700 Fashion League Building, sufficient to cover the cost of Construction Inspection and Record Plans.

EXPIRES NOV 28 1947

COUNTY OF LOS ANGELES, CALIFORNIA

REVISED Nov. 18 1947 *Alfred J. Jones* APPROVED *Alfred J. Jones*
Reg. C.E. 6222 *Alfred J. Jones* *Alfred J. Jones*
Jury Engineer
REVISION CHECKED Nov. 18 1947 *J. B. McNamee* APPROVED *Carl L. Jones*
Office of County Engineer, Reg. C.E. No. 6322 *Carl L. Jones*
Chief Engineer of County
Sanitation District No. 3
CHECKED *William H. Kelle* 1947
Office of County Engineer, Reg. C.E. No. 5843

BC 675