

LOMITA

B.M. Elev. 44.603 per 374536
 1.87' S. of S. end of Lot 171 W.
 3.66' Normandy Ave., on N. side of
 220th St.

(1) USE STANDARD MANHOLE FRAME AND COVER 3'-0" HT.
 (2) USE STANDARD STRENGTH PIPE (EXCEPT AS NOTED)
 (3) USE CEMENT MORTAR FOR ALL VITRIFIED CLAY PIPE JOINTS.
 (4) RESURFACE ALL TRENCH WITHIN PAVED AREA TO MEET LOS ANGELES COUNTY ROAD DEPT. OR CALIFORNIA STATE HIGHWAY REQUIREMENTS IN ACCORDANCE WITH PERMITS.
 (5) CONTINUE UNDER CONNECTIONS WITH INVERT AT PROPERTY LINE.
 (6) ENCASE FOUR FEET OF SEWER AT POINTS OF INTERFERENCE WITH POLES AS PER S.O. 119.
 (7) ALL STRUCTURES SHALL BE BRICK SEWER STRUCTURES 5'-0" DIA.
 (8) CONSTRUCT TOPS OF ALL STRUCTURES IN SIGHT OF WAY 6" ABOVE FINISHED GRADE.
 (9) STOPPERS TO BE INSTALLED WITH JOINT COMPOUND BY MANUFACTURER AT THIS PLANT PER SPEC'S. SEC. 35, 40.
 (10) CONC. PAVEMENT TO BE CUT NOT LESS THAN 2" IN DEPTH WITH CONC. SAW PER SPEC'S. SEC. 65.
 INSTALL WIRE TAPS PER SPEC'S. SEC. 45.



NOTE: REPRESENTATIVE OF THE COUNTY ENGINEER WILL SURVEY OR LAY OUT ANY PORTION OF THE WORK. THE OWNER OR HIS AUTHORIZED REPRESENTATIVE SHALL FURNISH THE CORRECT RECORDS AND BEARING RECORDS AND STATIONS OF ALL HOUSE CONNECTIONS AND Y BRANCHES AND SHALL PROVIDE STAKES FOR THEM AT THEIR OWNERS' EXPENSE WITH STATIONING PLAINLY MARKED. ANY STAKES OR MARKERS WHICH ARE NOT CORRECTLY IDENTIFIED BY THE OWNER OR HIS REPRESENTATIVE OR WHICH ARE NOT MAINTAINED THROUGHOUT THE WORK SHALL BE REPLACED AT THE OWNERS' EXPENSE. REVISIONS SHALL BE MADE IN THESE PLANS WITHOUT APPROVAL OF THE COUNTY ENGINEER.

**PROFILE ALIGNMENT AND GRADE OF
 SANITARY SEWERS
 TO BE CONSTRUCTED IN
 220th ST.
 BETWEEN MEYLER ST. AND 476 FT. EAST OF MEYLER ST.
 MEYLER ST.
 BETWEEN 220th ST. AND 140 FT. SOUTH OF 220th ST.**

**PRIVATE CONTRACT NO. 2061
 W.S. 28
 SHEET 1 OF 1 SHEET**

MARCH 1952

**PREPARED IN THE OFFICES OF
 CALDWELL & MASON ENGRS.**

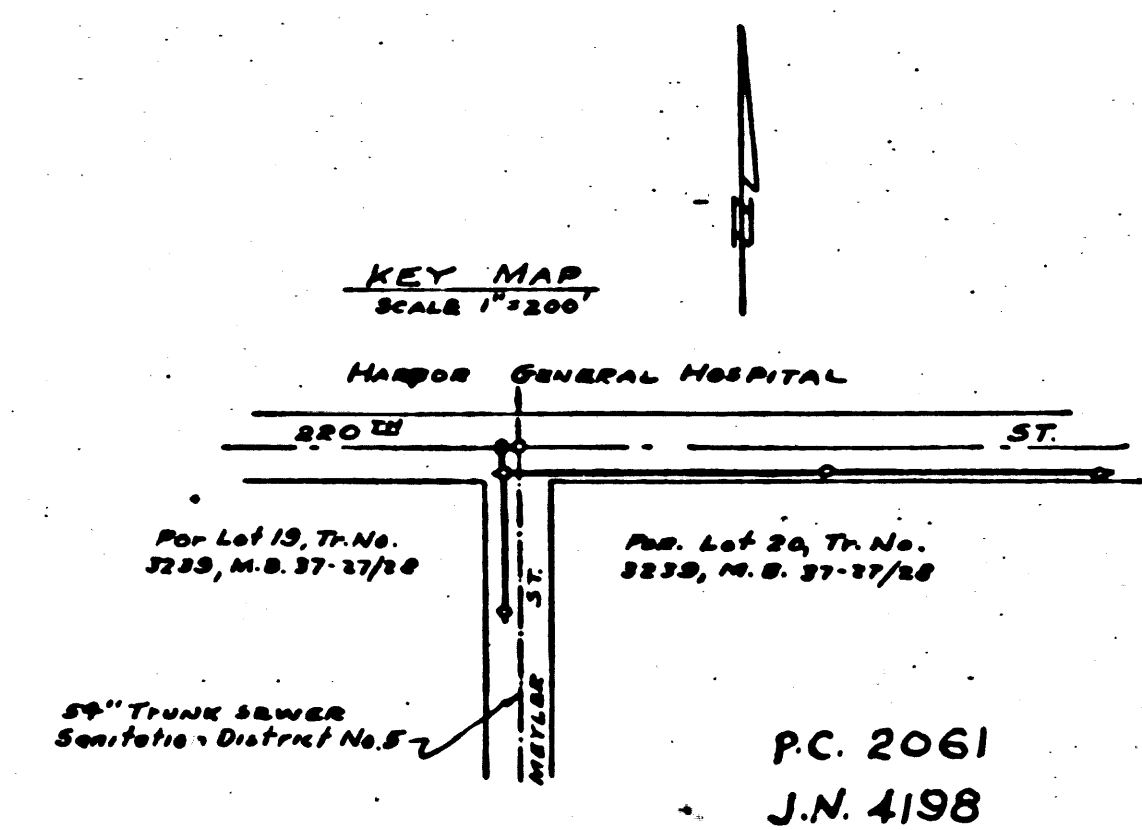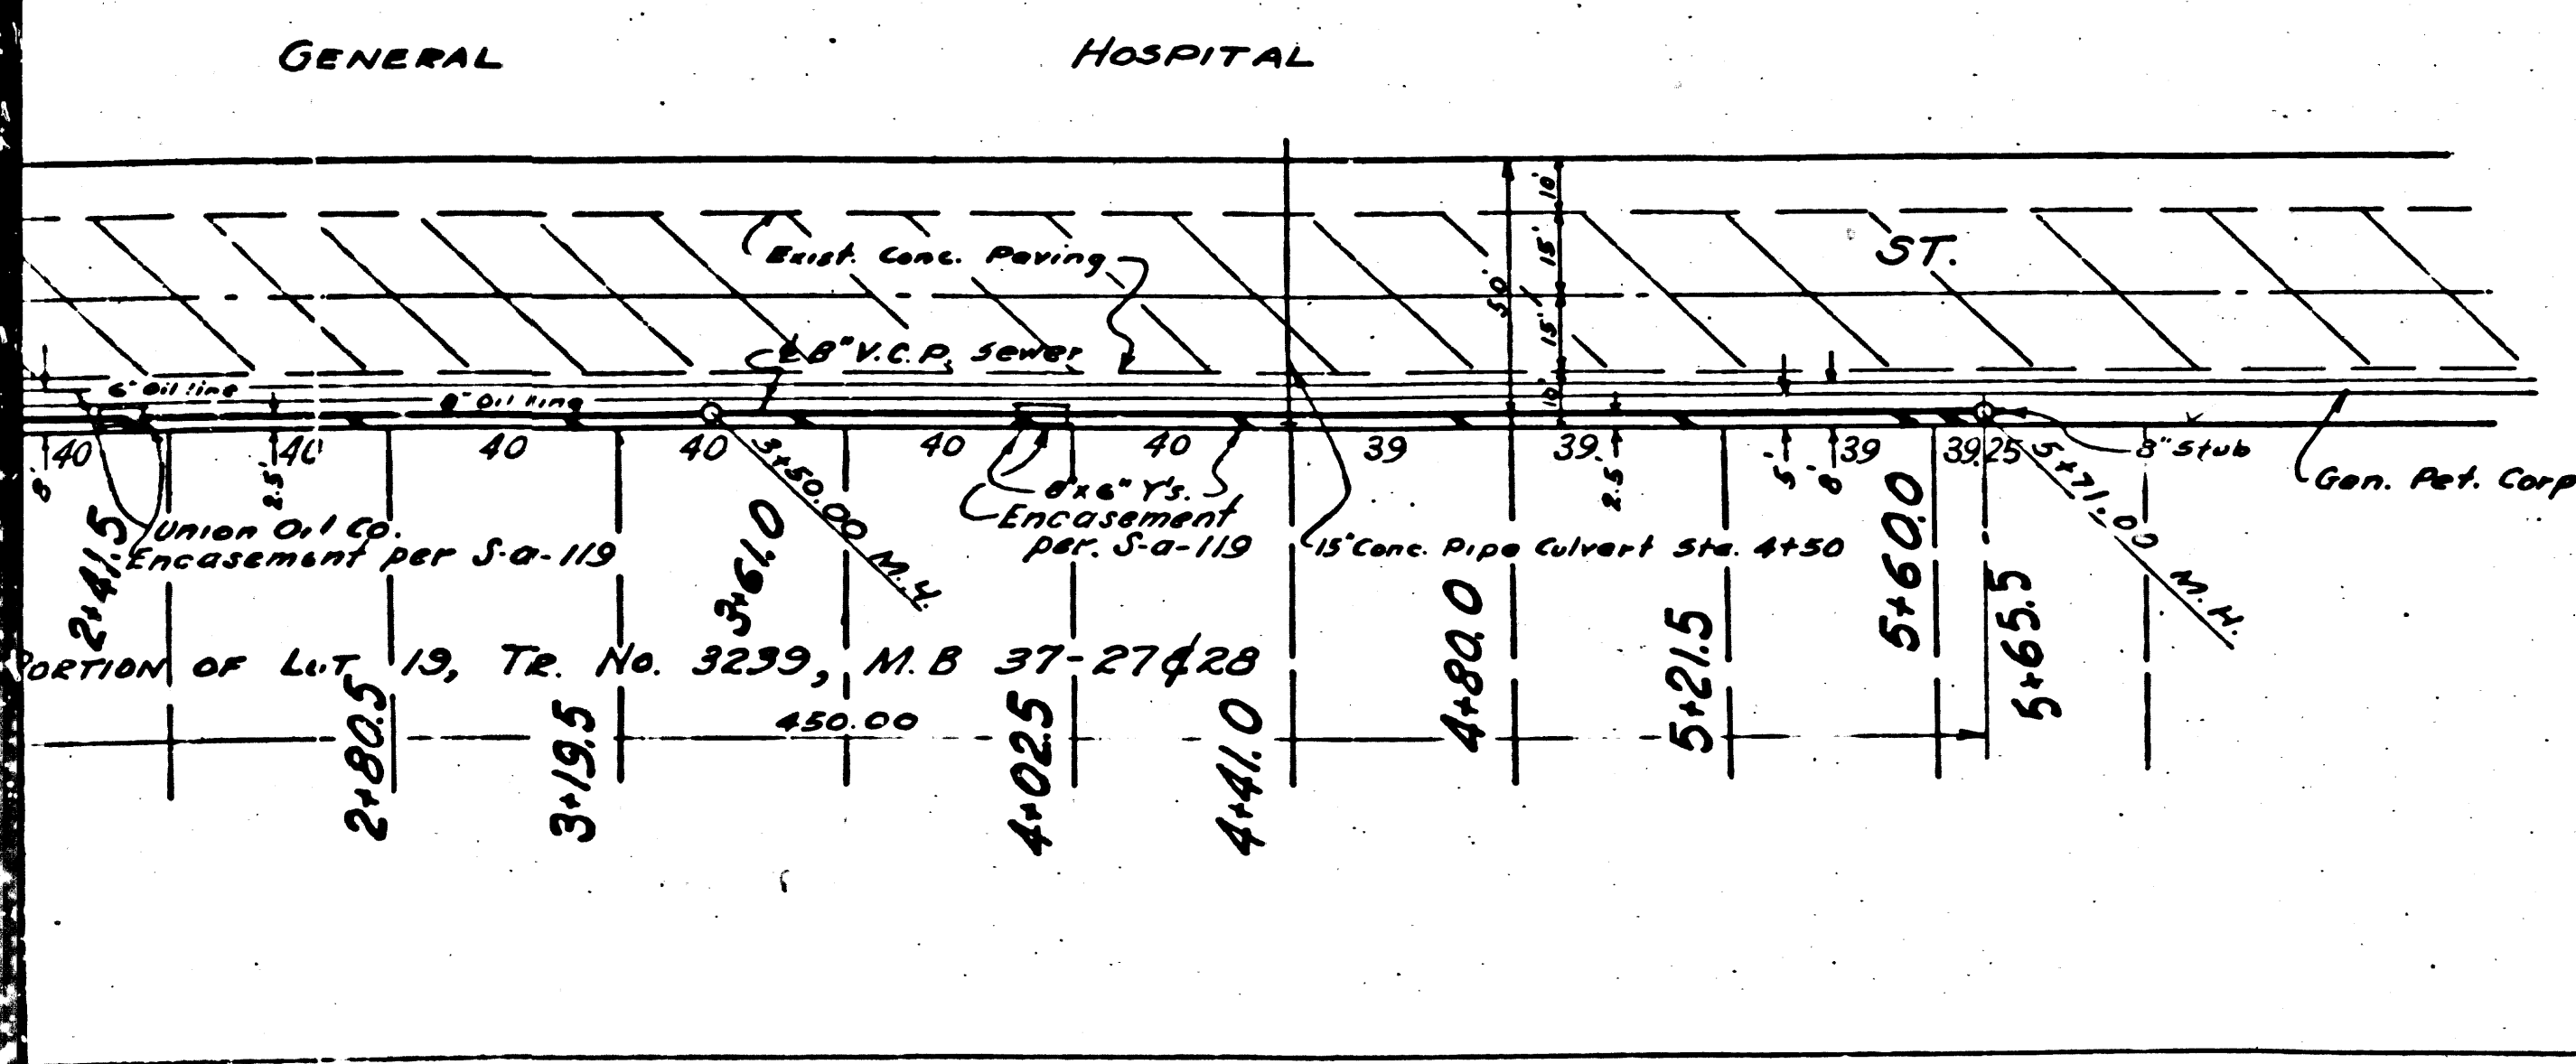

into any existing structure
 final acceptance of this work,
 Sanitation District should be notified
 in order that required inspection may be made.

before breaking into any
 and before final acceptance of this work,
 County Sanitation District should be notified
 in order that required inspection may be made.

PC. 2061
 J.N. 4198

BY: C. Keith Mason
 REG. C.E. No. 7677

FOR LEGEND
 SEE PLAN NO. S-4-64

NOTE:
 GRADES TO WHICH THIS IMPROVEMENT IS TO BE CONSTRUCTED ARE SHOWN ON PLANS AND PROFILE GRADE POINTS FOR TOP OF CURB, CENTER LINE OF STREET OR CENTER LINE OF ALLEY ARE SHOWN BY CIRCLES ON PROFILES. AT ALL POINTS BETWEEN DESIGNATED POINTS THE GRADE SHALL BE ESTABLISHED SO AS TO CONFORM TO A STRAIGHT LINE DRAWN BETWEEN SAID DESIGNATED POINTS. ELEVATIONS ARE IN FEET ABOVE U.S.C. & G.S. DATUM OR MEAN SEA LEVEL. THIS ENGINEER AND THE DATA HEREON ARE NOT A PART OF THE SPECIFICATIONS. WORK SHALL BE CONSTRUCTED ACCORDING TO SPECIFICATIONS ON FILE IN THE OFFICE OF THE COUNTY ENGINEER AND SHALL BE PROSECUTED ONLY IN THE PRESENCE OF THE COUNTY ENGINEER. BEFORE WORK CAN BE STARTED, THE CONTRACTOR MUST OBTAIN A PERMIT TO EXCAVATE IN COUNTY STREETS FROM THE L.A. COUNTY ROAD DEPT., JOB NO. SECOND STREET, AND MAKE A DEPOSIT WITH THE COUNTY ENGINEER, 828 L.A. COUNTY ENGINEERING BLDG., SUFFICIENT TO COVER THE COST OF CONSTRUCTION INSPECTION AND RECORD PLANS. IF WORK IS TO BE DONE IN A STATE HIGHWAY, A PERMIT MUST BE OBTAINED FROM THE STATE OF CALIFORNIA, DIVISION OF HIGHWAYS, 100 S BRIDGE ST. AFTER MAKING THE DEPOSIT WITH THE COUNTY ENGINEER. APPROVAL OF THE PLAN BY THE COUNTY OF LOS ANGELES DOES NOT CONSTITUTE A REPRESENTATION AS TO THE ACCURACY OF THE LOCATION OF, OR THE EXISTENCE OR NON-EXISTENCE OF ANY UNDERGROUND UTILITY PIPE OR STRUCTURE WITHIN THE LIMITS OF THIS PROJECT (THIS NOTE APPLIES TO ALL SHEETS).

COUNTY OF LOS ANGELES, CALIFORNIA
 WILLIAM J. EDWARDS COUNTY ENGINEER
 APPROVED BY A. M. Rawlin CHIEF DEPUTY
 APPROVED BY Richard E. Kuhn 3-19-1952
 OFFICE OF COUNTY ENGINEER REG. C.E. No. 7660

MAR 28 1952
 COUNTY OF LOS ANGELES
 SANITATION DISTRICT NO. 8

NO. 5501 VAN NORD BLDG. 2ND FL. 211 - 550 1/2 ST. & MEYLER ST.

