


R 3105

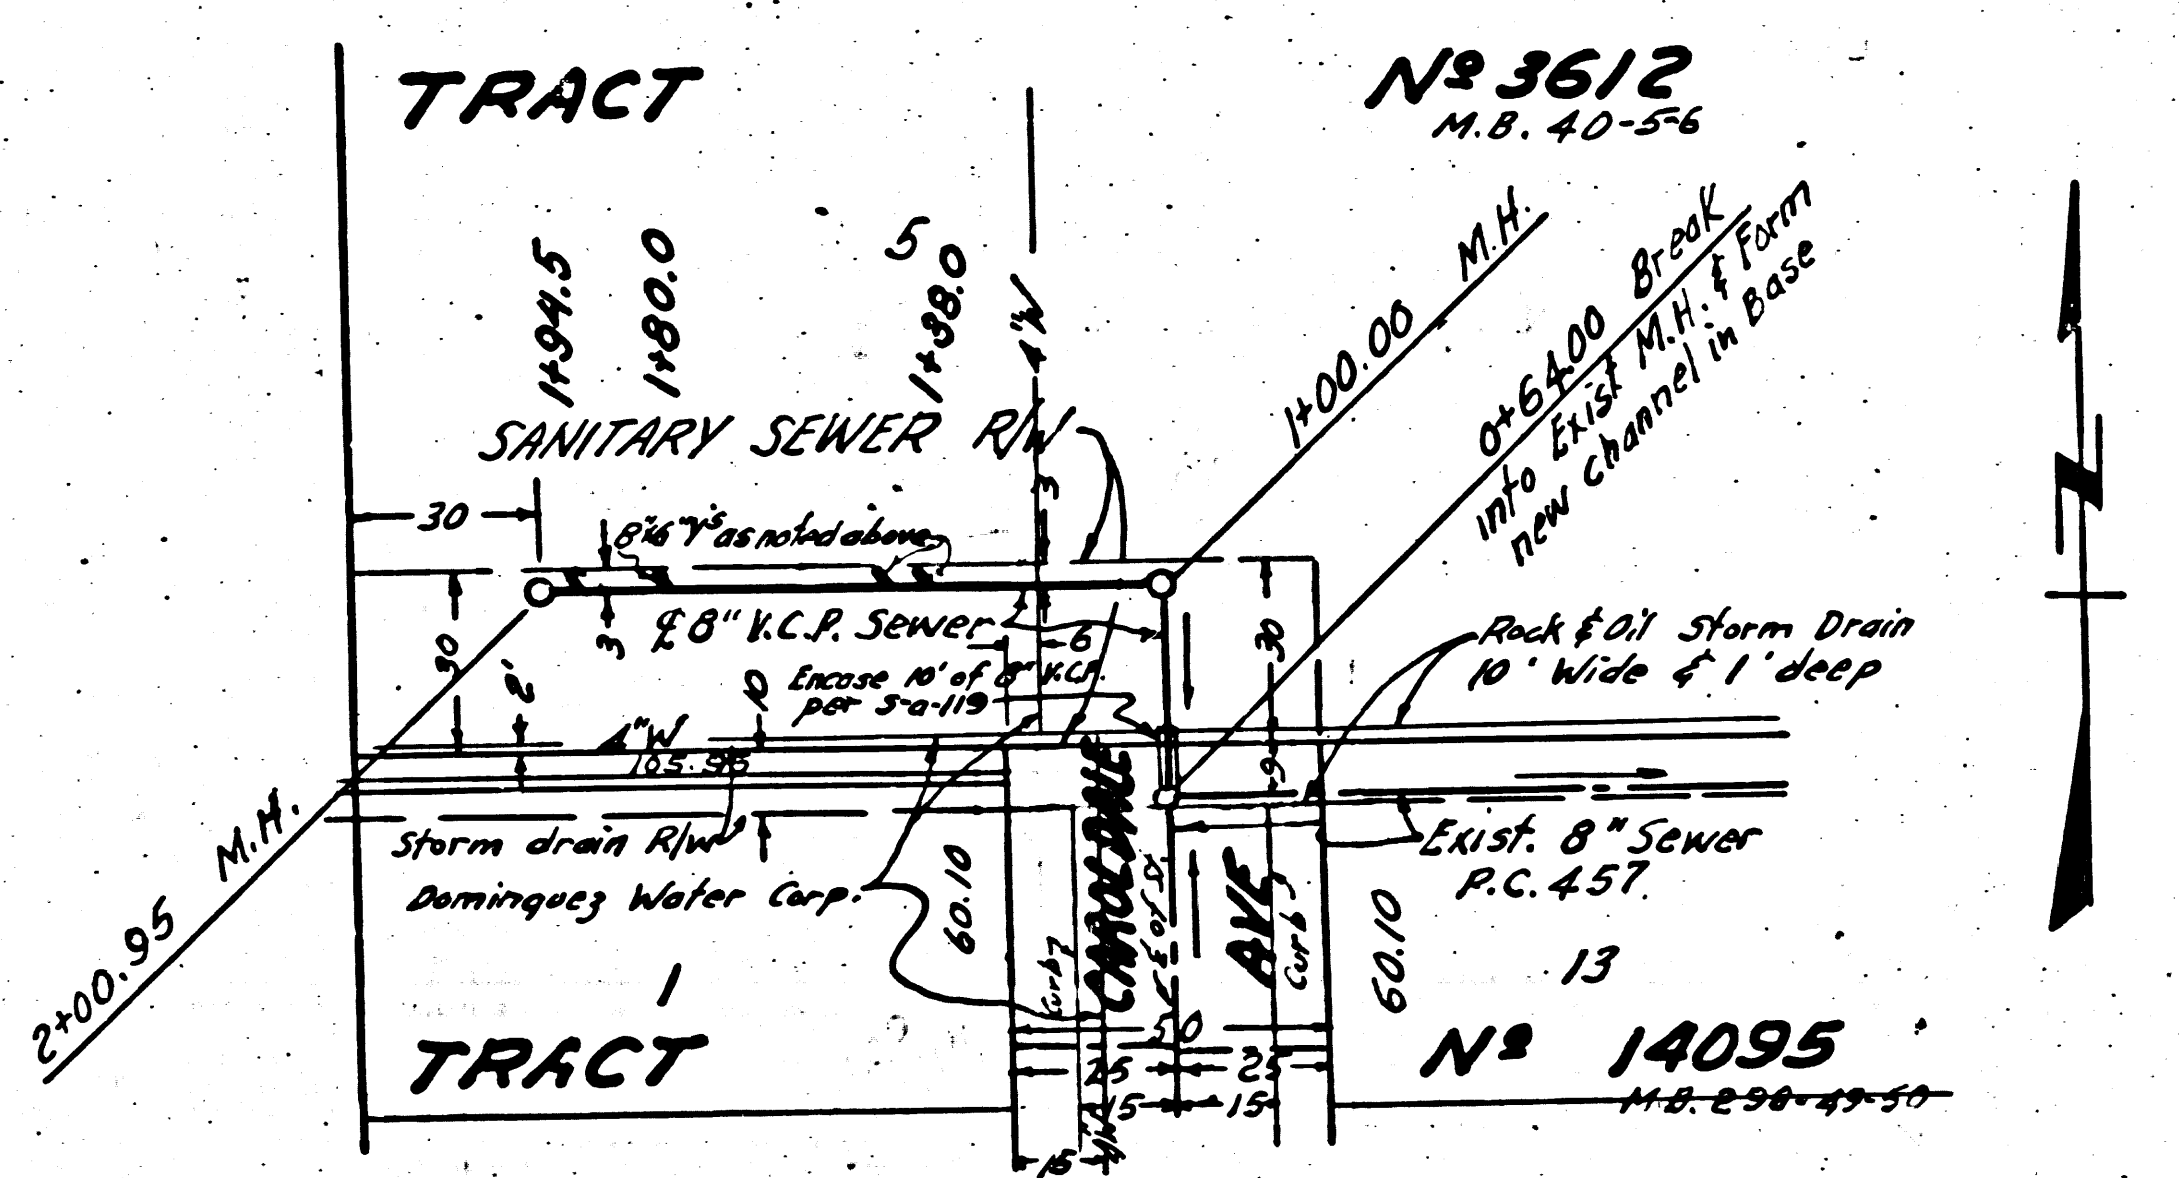

Trim Line


LOMITA BLDG. DIST. NO 7L

NOTE:
 Provide stakes on the property lines or property lines produced at right angles to the sewer line at the center line of each manhole.
 No representative of the County Engineer will survey or layout any portion of the work.
 The owner or his authorized representative shall furnish the County Engineer with grade sheets and stations for all house laterals and Y branches and shall provide stakes for them at their proper locations with stationing plainly marked. Any change in location shall be requested in writing by the owner or his representative.
 No revisions shall be made in these plans without the approval of the County Engineer.

1. Use standard manhole frames and covers, S-a-117, Except as noted.
2. Use standard strength pipe except as noted.
3. Use cement mortar for all vitrified clay pipe joints.
4. Resurface all trench within paved area to meet L.A. County Road Dept. or California State Highway Dept. requirements in accordance with permit.
5. Encase four feet of sewer at points of interference with poles, S-a-119.
6. ~~Manholes to be constructed with insets at property line~~
7. All structures shall be brick sewer structures, S-a-104, Except as noted.
8. For allowable leakage test, use Formula No. _____ Spec's, Sec. 61.
9. Manhole tops in improved Rights-Of-Way to be constructed to final grade.

B.M. 51503 El. 37.070 spk
 in walk 40' N E Carson St.
 ± 50' N E Monica AVE.

SHEET	PAGE
1	1

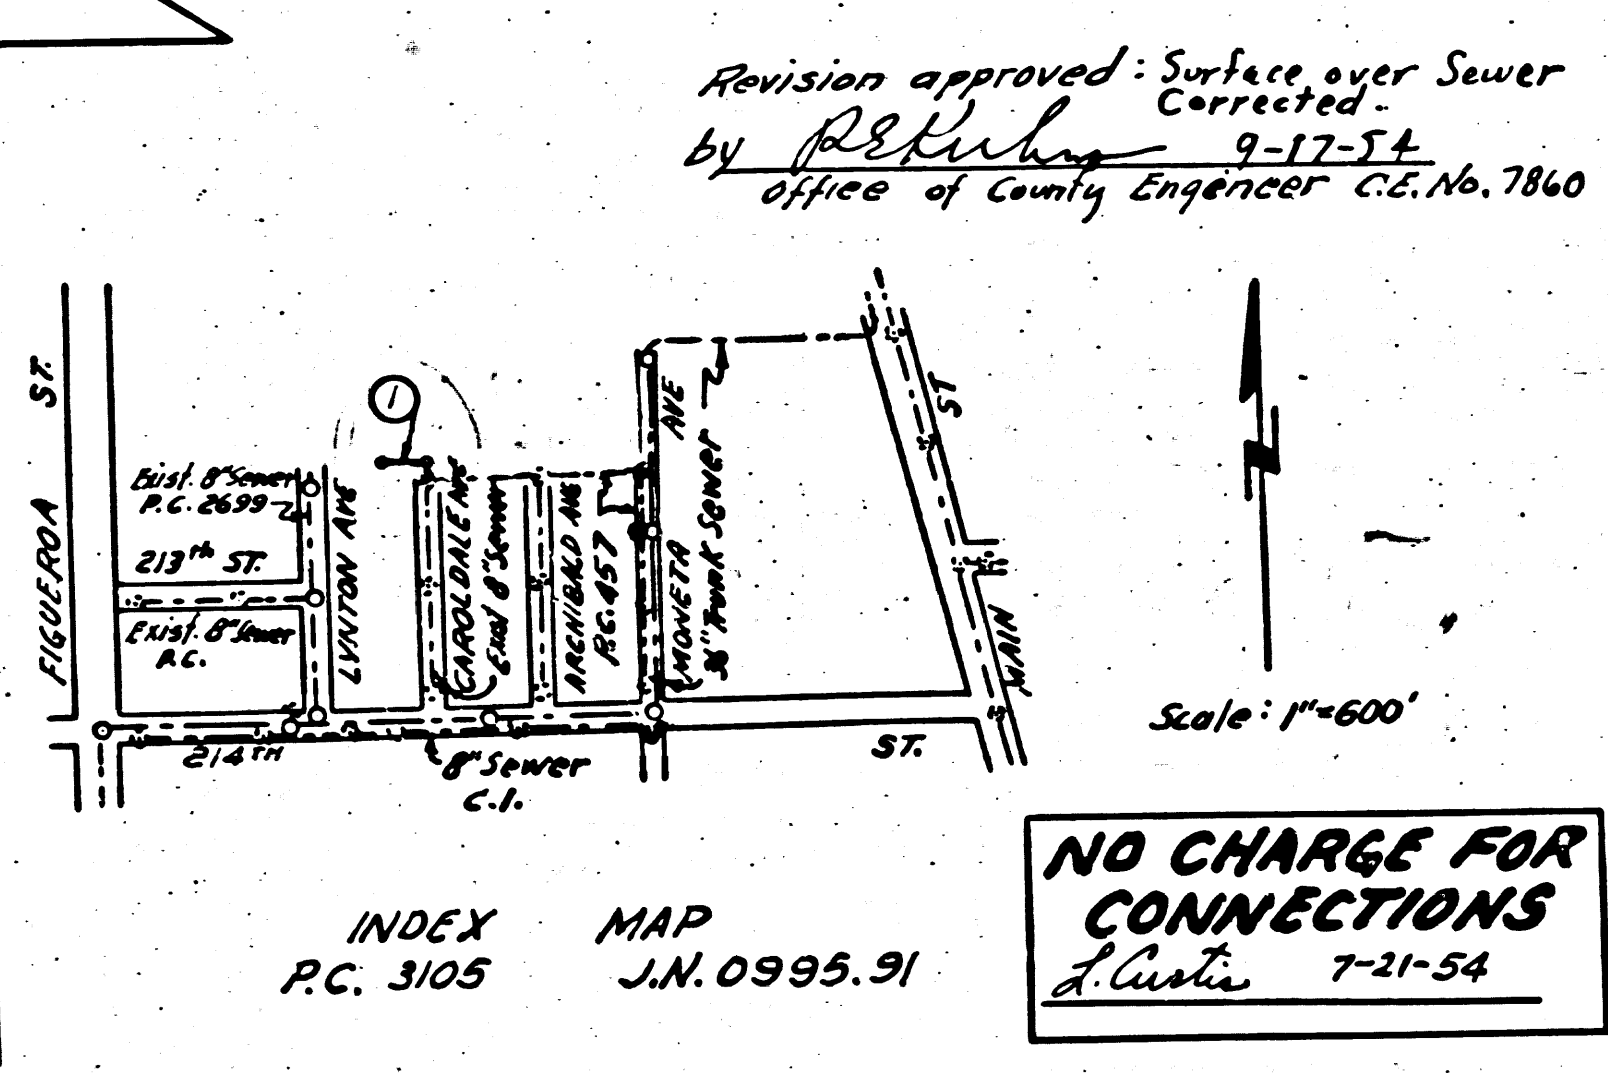

Trim Line

PROFILE, ALIGNMENT AND GRADE OF
SANITARY SEWERS
 TO BE CONSTRUCTED IN
SANITARY SEWER R/W
 IN LOT 5 TRACT NO 3612

RC. 3105
J.N. 0995.91
 Page 1

(18,988)

PRIVATE CONTRACT NO. **3105**
 W. S. 28
 I SHEET

Scale: VERT. 1\"/>
 JULY 1954
 PREPARED IN THE OFFICES OF
BARCLAY SURVEYING COMPANY
 By *[Signature]* Reg. C. E. No. 1137

FOR LEGEND SEE PLAN NO. S-a-64

NOTE:
 Grades to which this improvement is to be constructed are shown on plans and profiles. Grade points for top of curb, center line of streets, or center line of alleys are shown by circles on profiles. At all points between designated points the grade shall be established so as to conform to a straight line drawn between said designated points.
 Elevations are in feet above U.S.C. & G.S. datum or mean sea level.
 This drawing and the data hereon are hereby made a part of the specifications.
 Work shall be constructed according to specifications on file in the office of the County Engineer and shall be prosecuted only in the presence of the County Engineer.
 Before work can be started, the contractor must obtain a permit to excavate in County streets from the L.A. County Road Dept., 108 W. 2nd St. and make a deposit with the County Engineer, 733 L.A. County Engineering Building, sufficient to cover the cost of construction inspection and record plans.
 Approval of this plan by the County of Los Angeles does not constitute a representation as to the accuracy of the location of or the existence or non-existence of any underground utility, pipe, or structure within the limits of this project. This note applies to all sheets.
 If work is to be done in a State Highway, a permit must be obtained from the State of California, Division of Highways, 120 South Spring Street.

COUNTY OF LOS ANGELES, CALIFORNIA

Approved, William J. Fox, County Engineer
 Approved, A. M. Ravn
 CHIEF ENGINEER SAM DIST. NO. 2
 By *[Signature]* *[Signature]*
 Sanitation Engineer Office Engineer
 Checked by *[Signature]* 9-22-54
 Office of County Engineer C. E. No. 5839

NO CHARGES FOR CONNECTIONS
[Signature] 7-21-54

Checked *[Signature]*
 9-28-54

RC. 3105 SANITARY SEWER R/W

W. S. 28
 B.C. 3102
 182800.01