

BELLFLOWER BLDG. DIST. No. 4

NOTE:
NO REPRESENTATIVE OF THE COUNTY ENGINEER WILL SURVEY OR LAY OUT ANY PORTION OF THE WORK.
THE OWNER OR HIS AUTHORIZED REPRESENTATIVE SHALL FURNISH THE COUNTY ENGINEER WITH GRADE SHEETS AND STATIONS FOR ALL HOUSE LATERALS AND Y BRANCHES AND SHALL PROVIDE STAKES FOR THEM AT THEIR PROPER LOCATIONS WITH STATIONING PLAINLY MARKED. ANY CHANGE OF LOCATION SHALL BE REQUESTED IN WRITING BY THE OWNER OR HIS REPRESENTATIVE.

- NO REVISIONS SHALL BE MADE IN THESE PLANS WITHOUT APPROVAL OF THE COUNTY ENGINEER.
1. USE STANDARD MANHOLE FRAMES AND COVERS, S-a-117, EXCEPT AS NOTED
 2. USE STANDARD STRENGTH PIPE EXCEPT AS NOTED.
 3. USE CEMENT MORTAR FOR ALL VITRIFIED CLAY PIPE JOINTS.
 4. RESURFACE ALL TRENCH WITHIN PAVED AREA TO MEET L. A. COUNTY ROAD DEPT. REQUIREMENTS IN ACCORDANCE WITH PERMIT.
 5. ENCASE FOUR FEET OF SEWER AT POINTS OF INTERFERENCE WITH POLES, S-a-119.
 6. HOUSE LATERALS TO BE CONSTRUCTED WITH INVERT AT PROPERTY LINE 6 FEET BELOW GRADE.
 7. ALL STRUCTURES SHALL BE BRICK SEWER STRUCTURES, S-a-104, EXCEPT AS NOTED.
 8. PROVIDE STAKES ON THE PROPERTY LINES OR PROPERTY LINES PRODUCED, AT RIGHT ANGLES TO THE SEWER LINE AT THE CENTER LINE OF EACH MANHOLE.
 9. FOR ALLOWABLE LEAKAGE TEST USE FORMULA NO. SPECS. I, SEC. 51.


Before breaking into any existing structure and before final acceptance of this work, County Sanitation District should be notified in order that required inspection may be made.

NO CHARGE FOR CONNECTIONS
C. G. Miller - 5-19-55

ENGINEERING SERVICE CORPORATION 1127 W. WASHINGTON BLVD. LOS ANGELES 19, CALIF. PR. 7281					
REVISIONS			TRACED BY _____		
			DES'G'D BY J.E.		
			CK'D BY C.G.		
			SUBMITTED 7/1		
SUB STRUCTURES OK'D					
W. O. NO.	DWG. NO.	DATE	SCALE	L. B.	P. N.
6248-2		5/17/55		779	

BENCH MARK.
1-7 RE 329 Elev. 114.580
Brass 3rd. County Survey Mon.
Set in well 15" below surface
100 S. of E. of Imperial Highway
& 16' E. of W. of Valley View Avenue.
Note: Add 0.03 to E. 114.580 to equal 5V Datum.

PAGES	SHEET
1-5	1

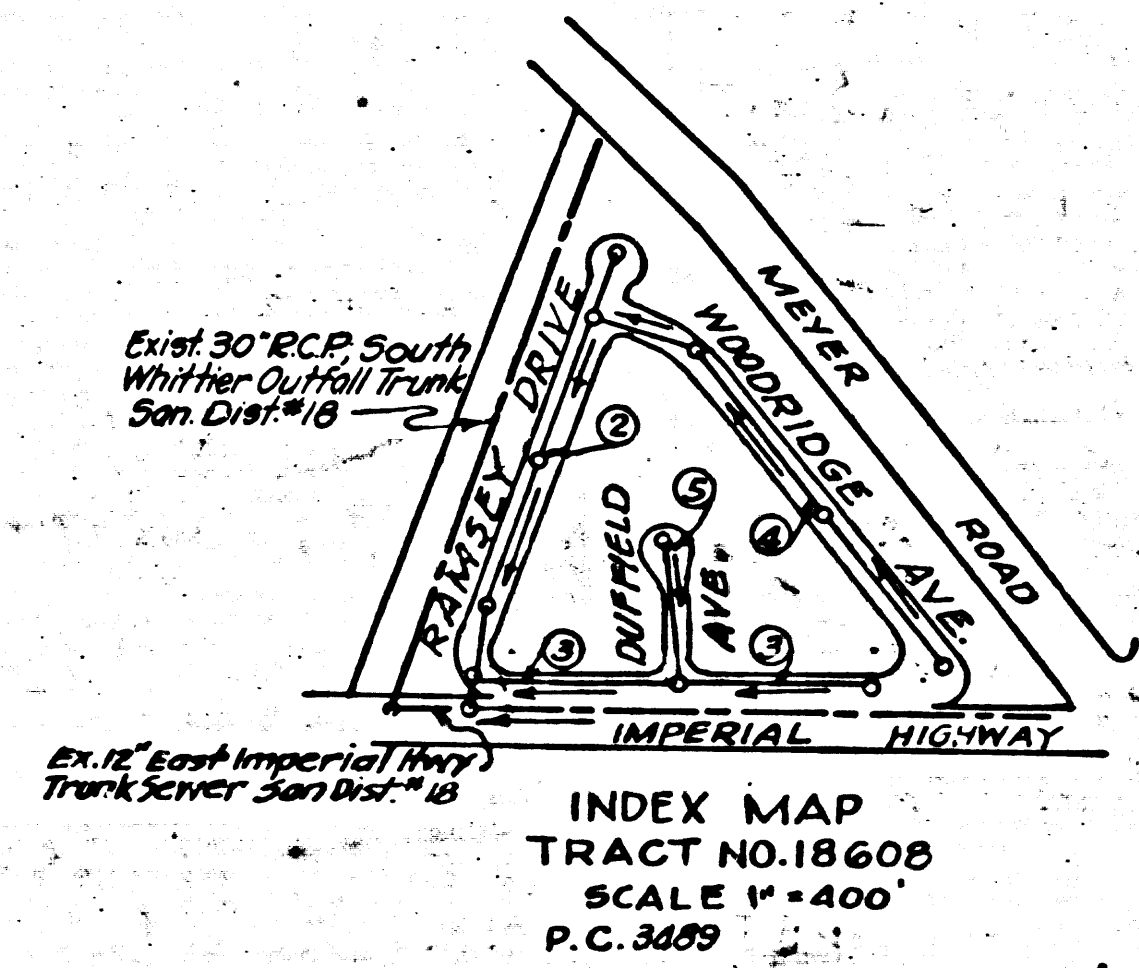

dated 7-25-55 K. H. ...

PROFILE, ALIGNMENT AND GRADE OF **P. C. 3489**
SANITARY SEWERS PAGE 1
TO BE CONSTRUCTED IN

TRACT No 18608
PRIVATE CONTRACT NO. 3489
W. S. 34
SHEET 1 OF 1 SHEETS

SCALE: VERT. 1" = 4'
HOR. 1" = 40'

APRIL 1955

PREPARED IN THE OFFICES OF
ENGINEERING SERVICE CORPORATION
BY E. H. Keenan
REG. C. E. NO. 3692

FOR LEGEND
SEE PLAN NO. S-a-64

NOTE:
GRADES TO WHICH THIS IMPROVEMENT IS TO BE CONSTRUCTED ARE SHOWN ON PLANS AND PROFILES. GRADE POINTS FOR TOP OF CURB, CENTER LINE OF STREETS OR CENTER LINE OF ALLEY ARE SHOWN BY CIRCLES ON PROFILES. AT ALL POINTS BETWEEN DESIGNATED POINTS THE GRADE SHALL BE ESTABLISHED SO AS TO CONFORM TO A STRAIGHT LINE DRAWN BETWEEN SAID DESIGNATED POINTS.
ELEVATIONS ARE IN FEET ABOVE U. S. G. S. DATUM OR MEAN SEA LEVEL.
THIS DRAWING AND THE DATA HEREON ARE HEREBY MADE A PART OF THE SPECIFICATIONS.
WORK SHALL BE CONSTRUCTED ACCORDING TO SPECIFICATIONS ON FILE IN THE OFFICE OF THE COUNTY ENGINEER AND SHALL BE PROSECUTED ONLY IN THE PRESENCE OF THE COUNTY ENGINEER.
BEFORE WORK CAN BE STARTED THE CONTRACTOR MUST OBTAIN A PERMIT TO EXCAVATE IN COUNTY STREETS FROM THE L. A. COUNTY ROAD DEPT. 108 W. 2ND ST. AND MAKE A DEPOSIT WITH THE COUNTY ENGINEER, Rm. 324 253 SO. BROADWAY SUFFICIENT TO COVER THE COST OF CONSTRUCTION INSPECTION AND RECORD PLANS.
APPROVAL OF THIS PLAN BY THE COUNTY OF LOS ANGELES DOES NOT CONSTITUTE A REPRESENTATION AS TO THE ACCURACY OF THE LOCATION OF, OR THE EXISTENCE OR NON-EXISTENCE OF, ANY UNDERGROUND UTILITY, PIPE, OR STRUCTURE WITHIN THE LIMITS OF THIS PROJECT.

COUNTY OF LOS ANGELES, CALIFORNIA
APPROVED, A. M. RAWN
WILLIAM J. FOX
COUNTY ENGINEER
CHIEF ENGINEER OF COUNTY
SANITATION, DISTRICT NO. 18
BY E. H. Keenan OFFICE ENGINEER
CHECKED BY W. H. ... OFFICE ENGINEER
OFFICE OF COUNTY ENGINEER
REG. C. E. NO. 7860

TRACT NO. 18608
SANITARY SEWER
P. C. 3489

20959

Rel.

NO CHARGE FOR CONNECTIONS

OK



Trim Line

OK

PC 3489
PAGE 3


NO CHARGE FOR CONNECTIONS

20,961

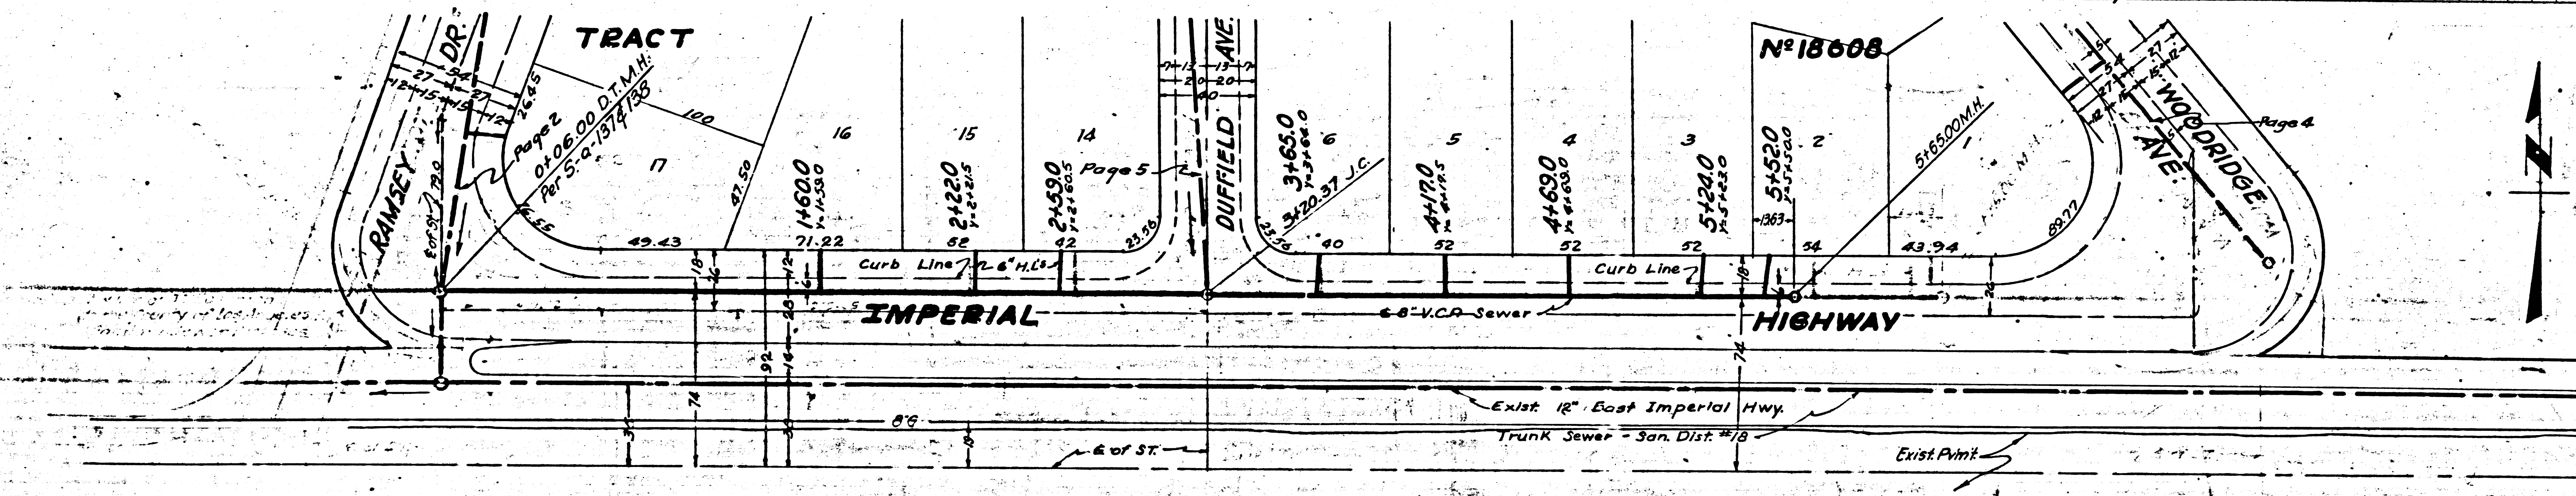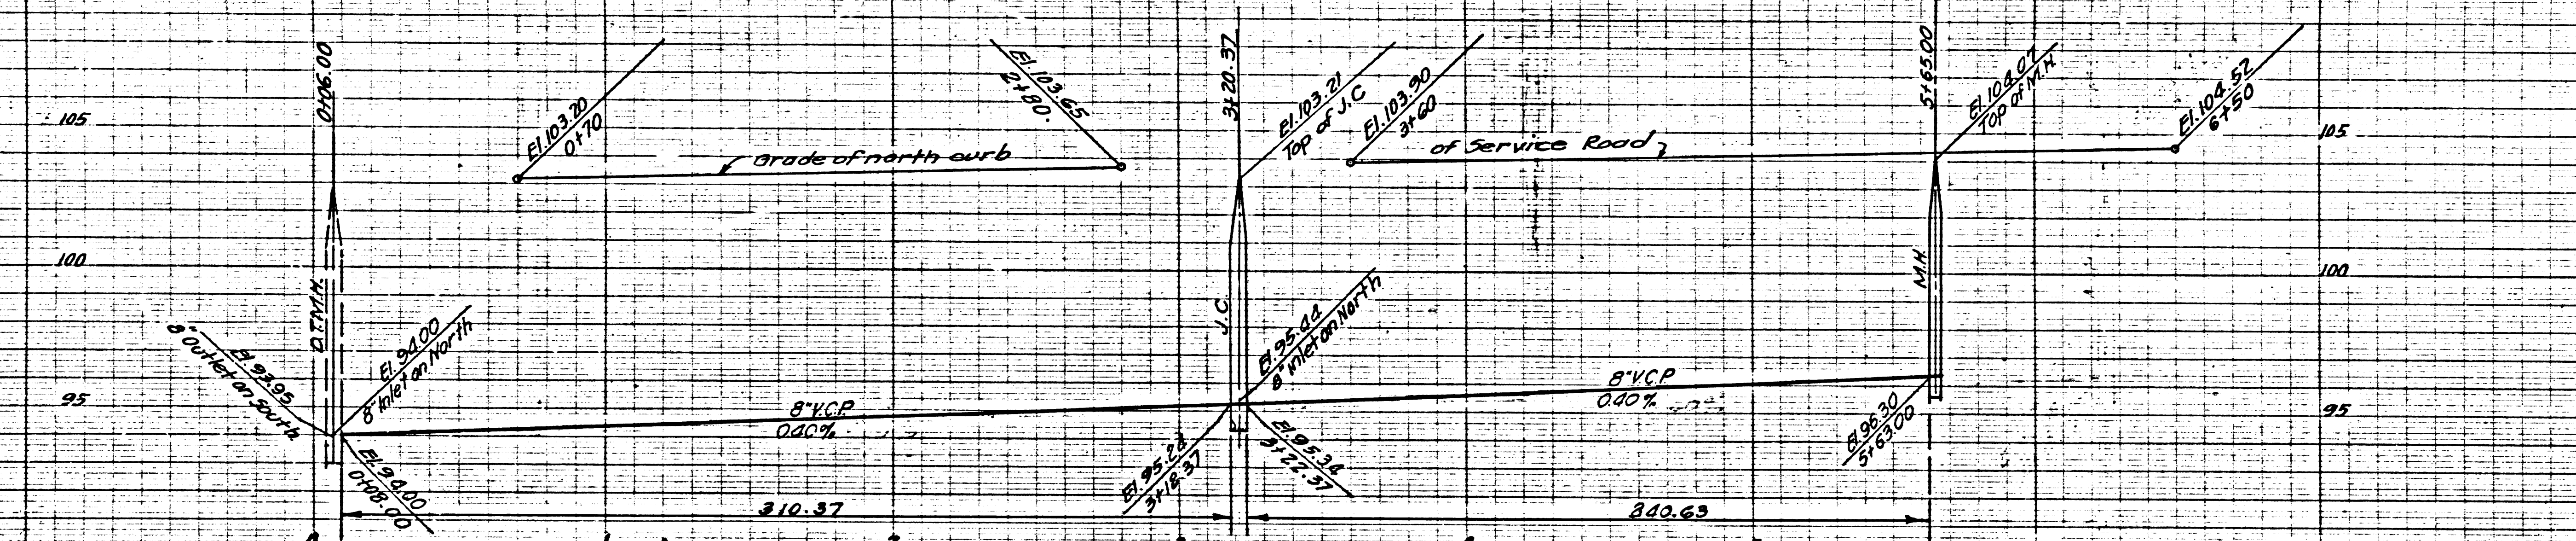


13

OK OK L OK L OK

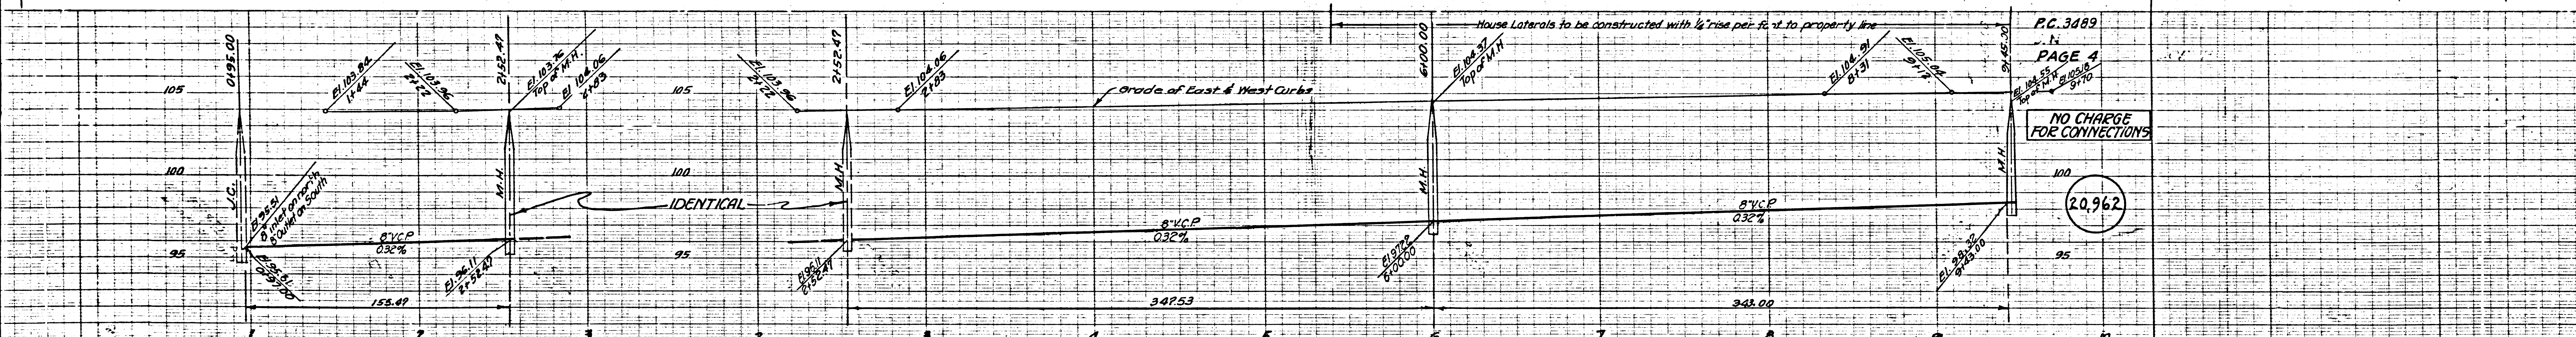

P.C. 3089
 PAGE 4
 NO CHARGE FOR CONNECTIONS
 20,962

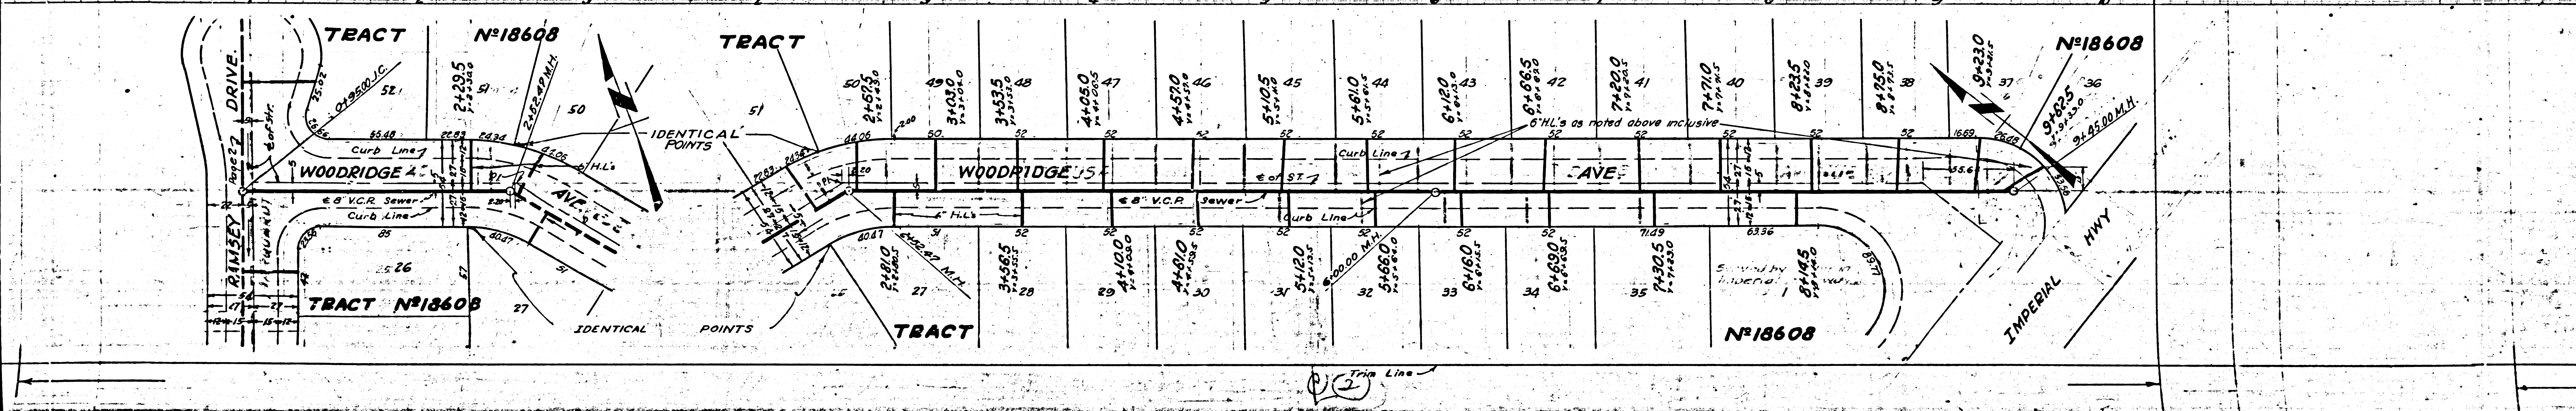

Trim Line

Trim Line 2

NEW YORK

ON MILLERY AVENUE FROM

BRIDGE ST. PROJECT

DATE 12/15/50

BY E. J. WOOD

SCALE 1" = 40'

P.C. 3489

PAGE 5



NO CHARGE FOR CONNECTIONS

20963

80861 N. 97 ST
29
ML
EVA
DWA
DWA
TWH
EVA

QJ1E17UO
AZ1124
J1193MT
T09AUPAHM

82362 MAC

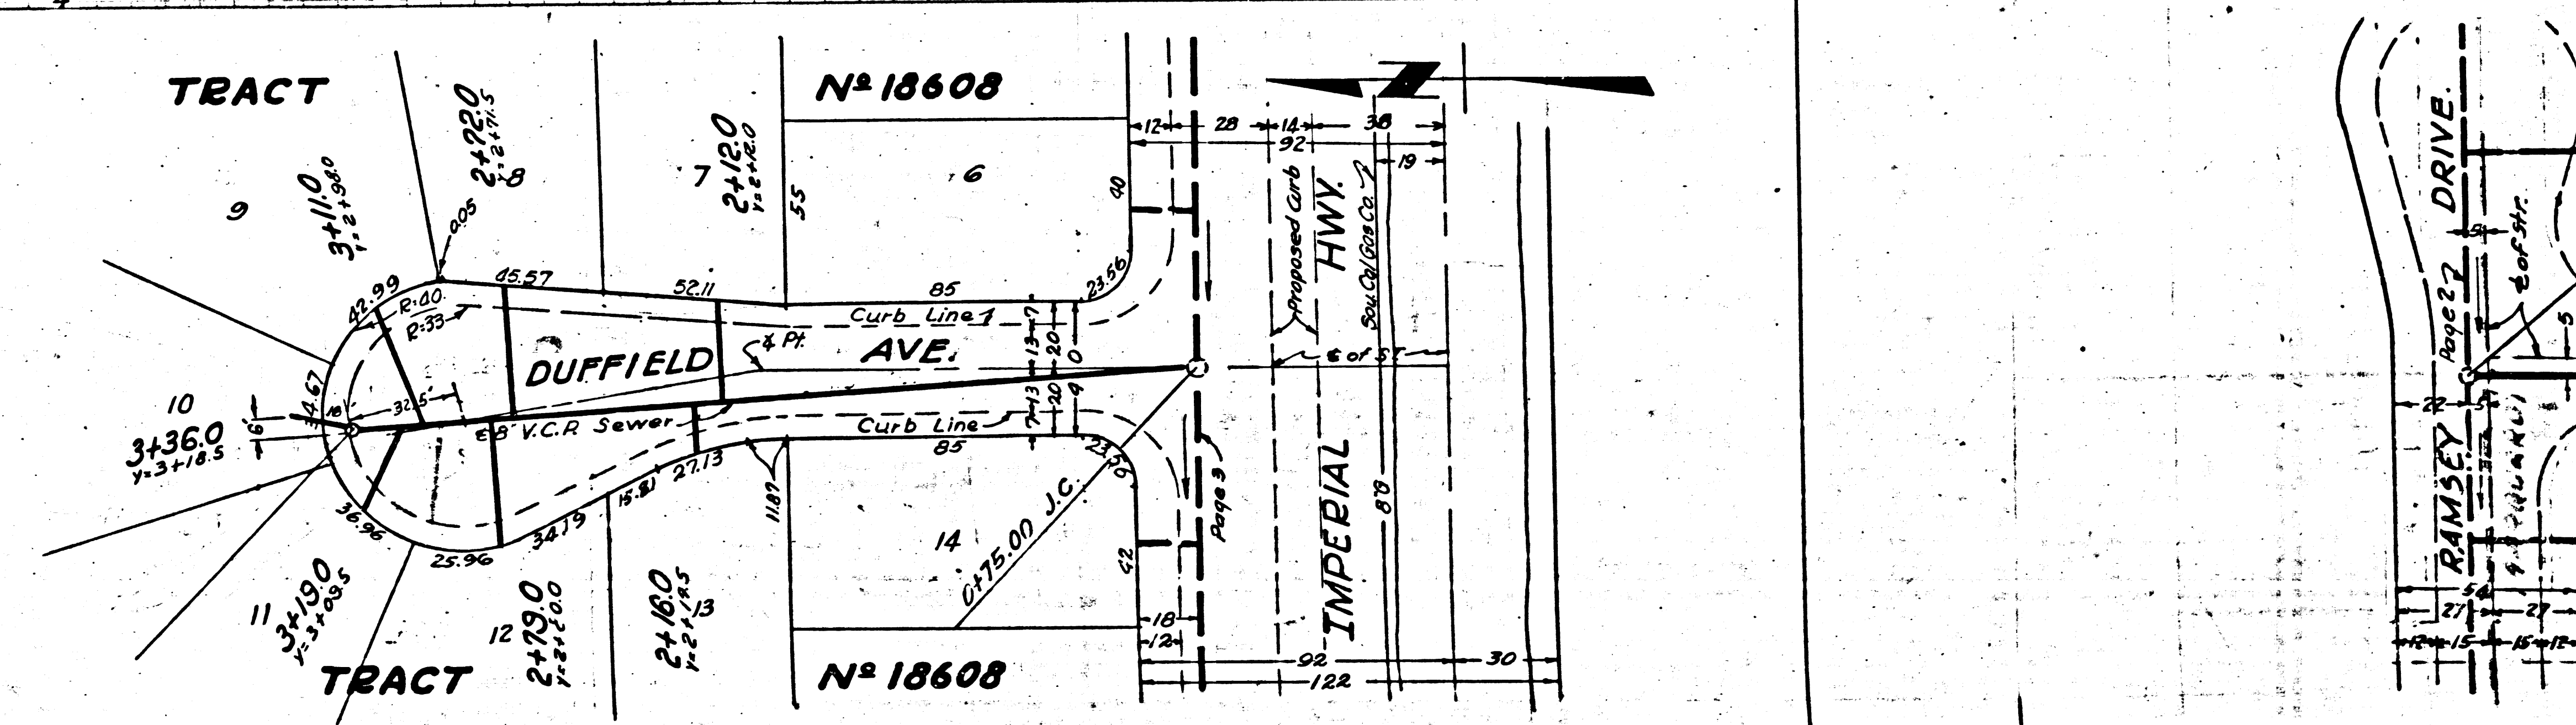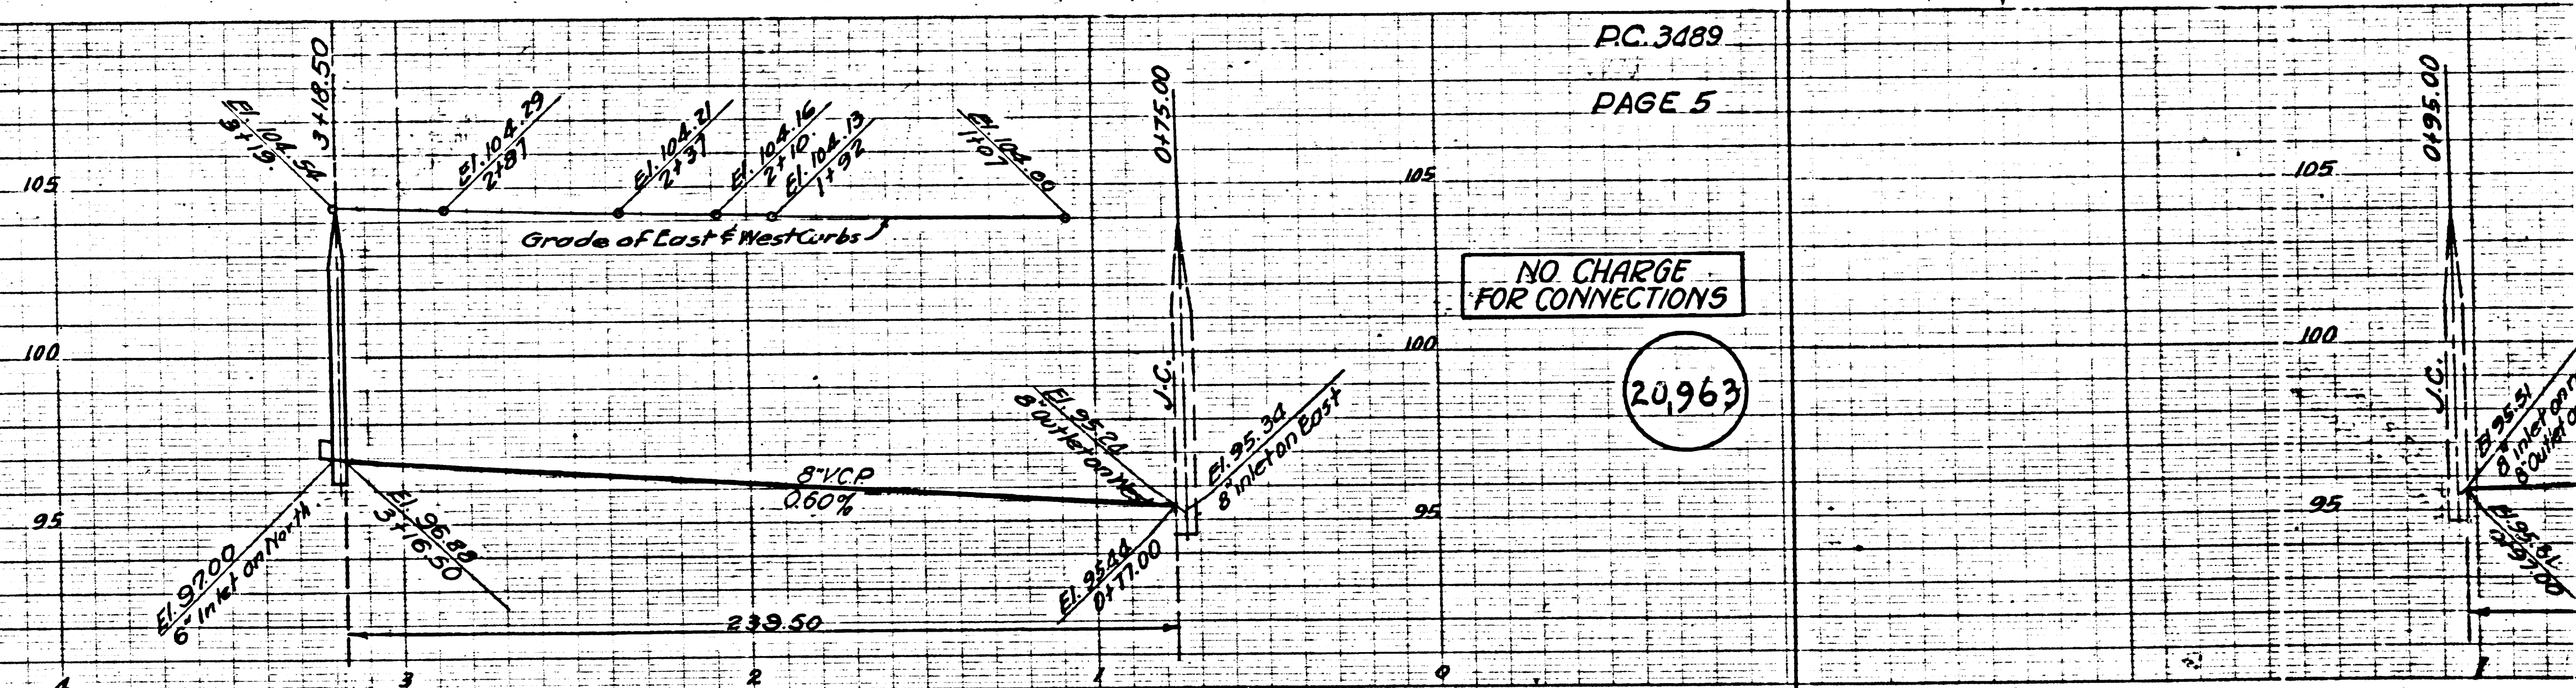

Trim Line 1