

SAN DIMAS BUILDING DISTRICT NO 10

**BERG MARK :**  
 S.E. 495 - LEAD 4 BERG MARK IN  
 S. CORNER OF CURB SIDE SIDE 1 30' S OF E  
 OF SPUR ROAD 242.4 + 30' 18" OF 4" W. CURB  
 ELEVATION 542.161

**NOTE:**  
 Provide stakes on the property lines or property lines produced at right angles to the sewer line at the center line of each manhole.  
 No representative of the County Engineer will survey or layout any portion of the work. The owner or his authorized representative shall furnish the County Engineer with grade sheets and stations for all house laterals and Y branches and shall provide stakes for them at their proper locations with stationing plainly marked. Any change in location shall be requested in writing by the owner or his representative.  
 No revisions shall be made in these plans without the approval of the County Engineer.


1. Use standard manhole frames and covers, S-a-117.
2. Use standard strength pipe except as noted.
3. Use cement mortar for all vitrified clay pipe joints.
4. Resurface all trench within paved area to meet L.A. County Road Dept. or Calif. State Highway Dept. requirements in accordance with permit.
5. Encase four feet of sewer at points of interference with poles, S-a-119.
6. House laterals to be constructed with inverts at property line... 6" feet below curb grade except as noted.
7. All structures shall be brick sewer structures, S-a-104.
8. Manhole tops in unimproved Rights-Of-Way to be 6" above finish grade.
9. For allowable leakage test, use Formula No. 1... Spec's., Sec. 51.

PROFILE, ALIGNMENT AND GRADE OF  
**SANITARY SEWERS**  
 TO BE CONSTRUCTED IN  
**TRACT NO 22120**

PRIVATE CONTRACT NO. 3674  
 W.S. 48  
 SHEET 1 OF 1 SHEET  
 SCALE: VERT. 1" = 4' HORIZ. 1" = 40'  
 SEPTE 1955  
 PREPARED IN THE OFFICE OF  
**TED M. WALSH & ASSOCIATES INC.**  
 BY *Raymond J. Miller* REG. C.E. NO. 2442  
 FOR LEGEND SEE PLAN NO. S-a-64

**NOTE:**  
 Grades to which this improvement is to be constructed are shown on plans and profiles. Grade points for top of curbs, center line of streets, or center line of alleys are shown by circles on profiles. At all points between designated points the grade shall be established so as to conform to a straight line drawn between said designated points.  
 Elevations are in feet above U.S.G.S. datum or mean sea level.  
 This drawing and the data hereon are hereby made a part of the specifications.  
 Work shall be constructed according to specifications on file in the office of the County Engineer and shall be prosecuted only in the presence of the County Engineer.  
 Before work can be started, the contractor must obtain a permit to excavate in County streets from the L.A. County Road Dept., 108 W. 2nd St. and make a deposit with the County Engineer, Room 310, 253 So. Broadway, sufficient to cover the cost of construction inspection and record plans.  
 Approval of this plan by the County of Los Angeles does not constitute a representation as to the accuracy of the location of or the existence or non-existence of any underground utility, pipe, or structure within the limits of this project. This note applies to all sheets.  
 If work is to be done in a State Highway, a permit must be obtained from the State of California, Division of Highways, 120 South Spring Street.

**COUNTY OF LOS ANGELES, CALIFORNIA**  
 Approved, *William J. Fox*, County Engineer  
 Approved, *A. M. Brown*, Chief Clerk  
 REG. C.E. NO. 7260  
 REG. C.E. NO. 1862

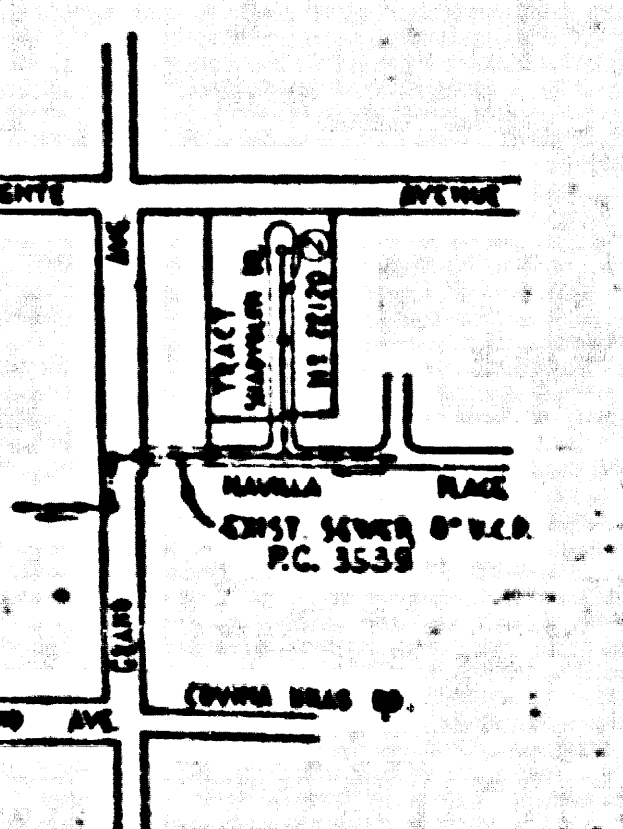

SHEET NO	PAGE NO
1	1-2

**INDEX MAP**  
 SCALE: 1" = 60'  
 P.C. 8674

REVISION: DEAL ESTATE CORRECTED.  
 APPROVED: *Raymond J. Miller*  
 OFFICE OF COUNTY ENGINEER  
 REG. C.E. NO. 7260

**NO CHARGE FOR CONNECTIONS**  
*L. Curtis 10-21-55*

*dated 5-16-56 Miller*


P.C. 8674  
 PAGE 1

(22,655)

(2)

SEWERS IN TRACT NO. 22120

TRIM LINE

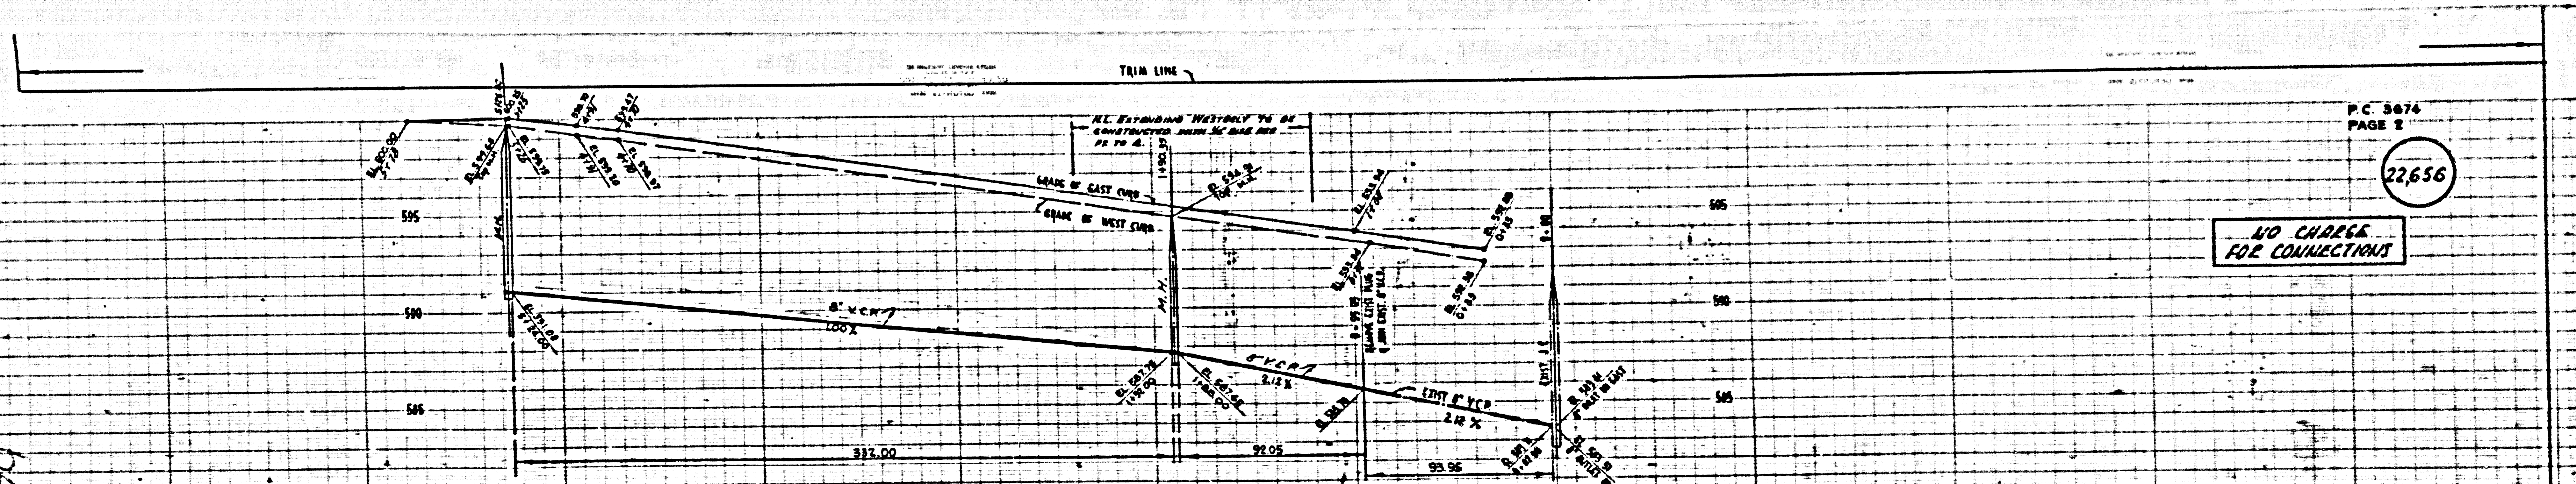


P.C. 3674  
PAGE 2

22,656

NO CHARGE  
FOR CONNECTIONS

P.C. 3674

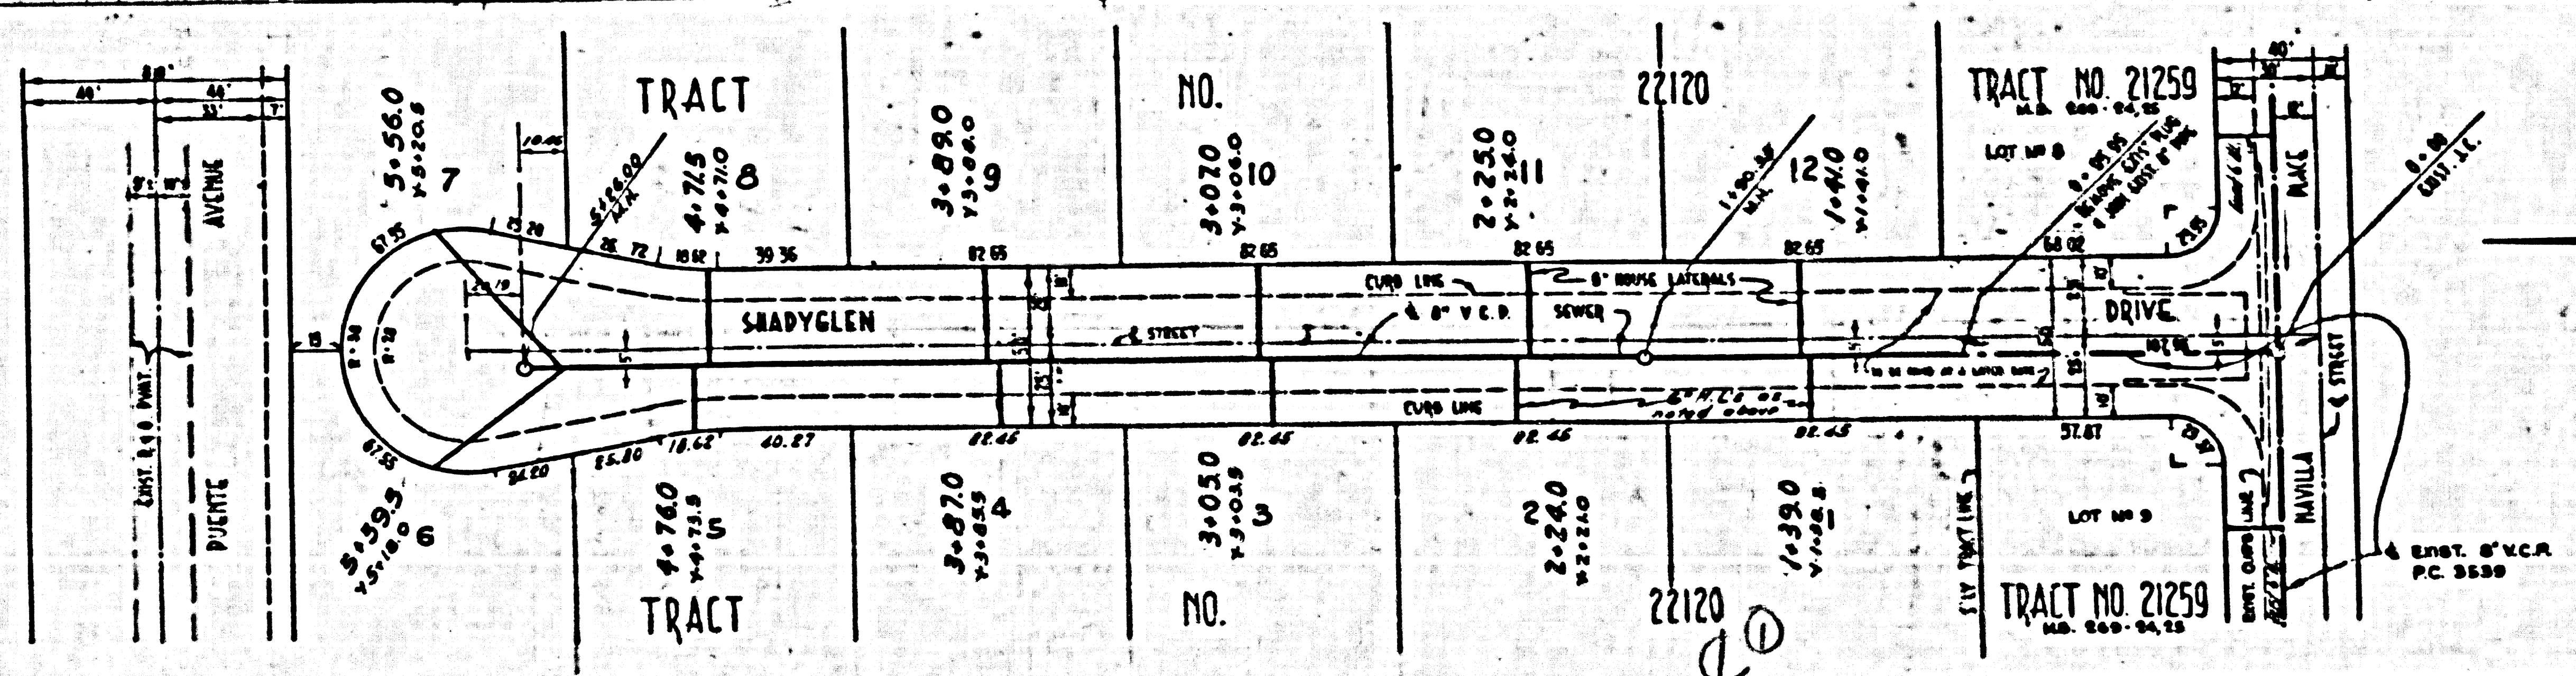

PAGE THIS LINE