


P.C. 3849  
PAGE 2  
SHEET 2

NO CHARGE  
FOR CONNECTIONS


22,658

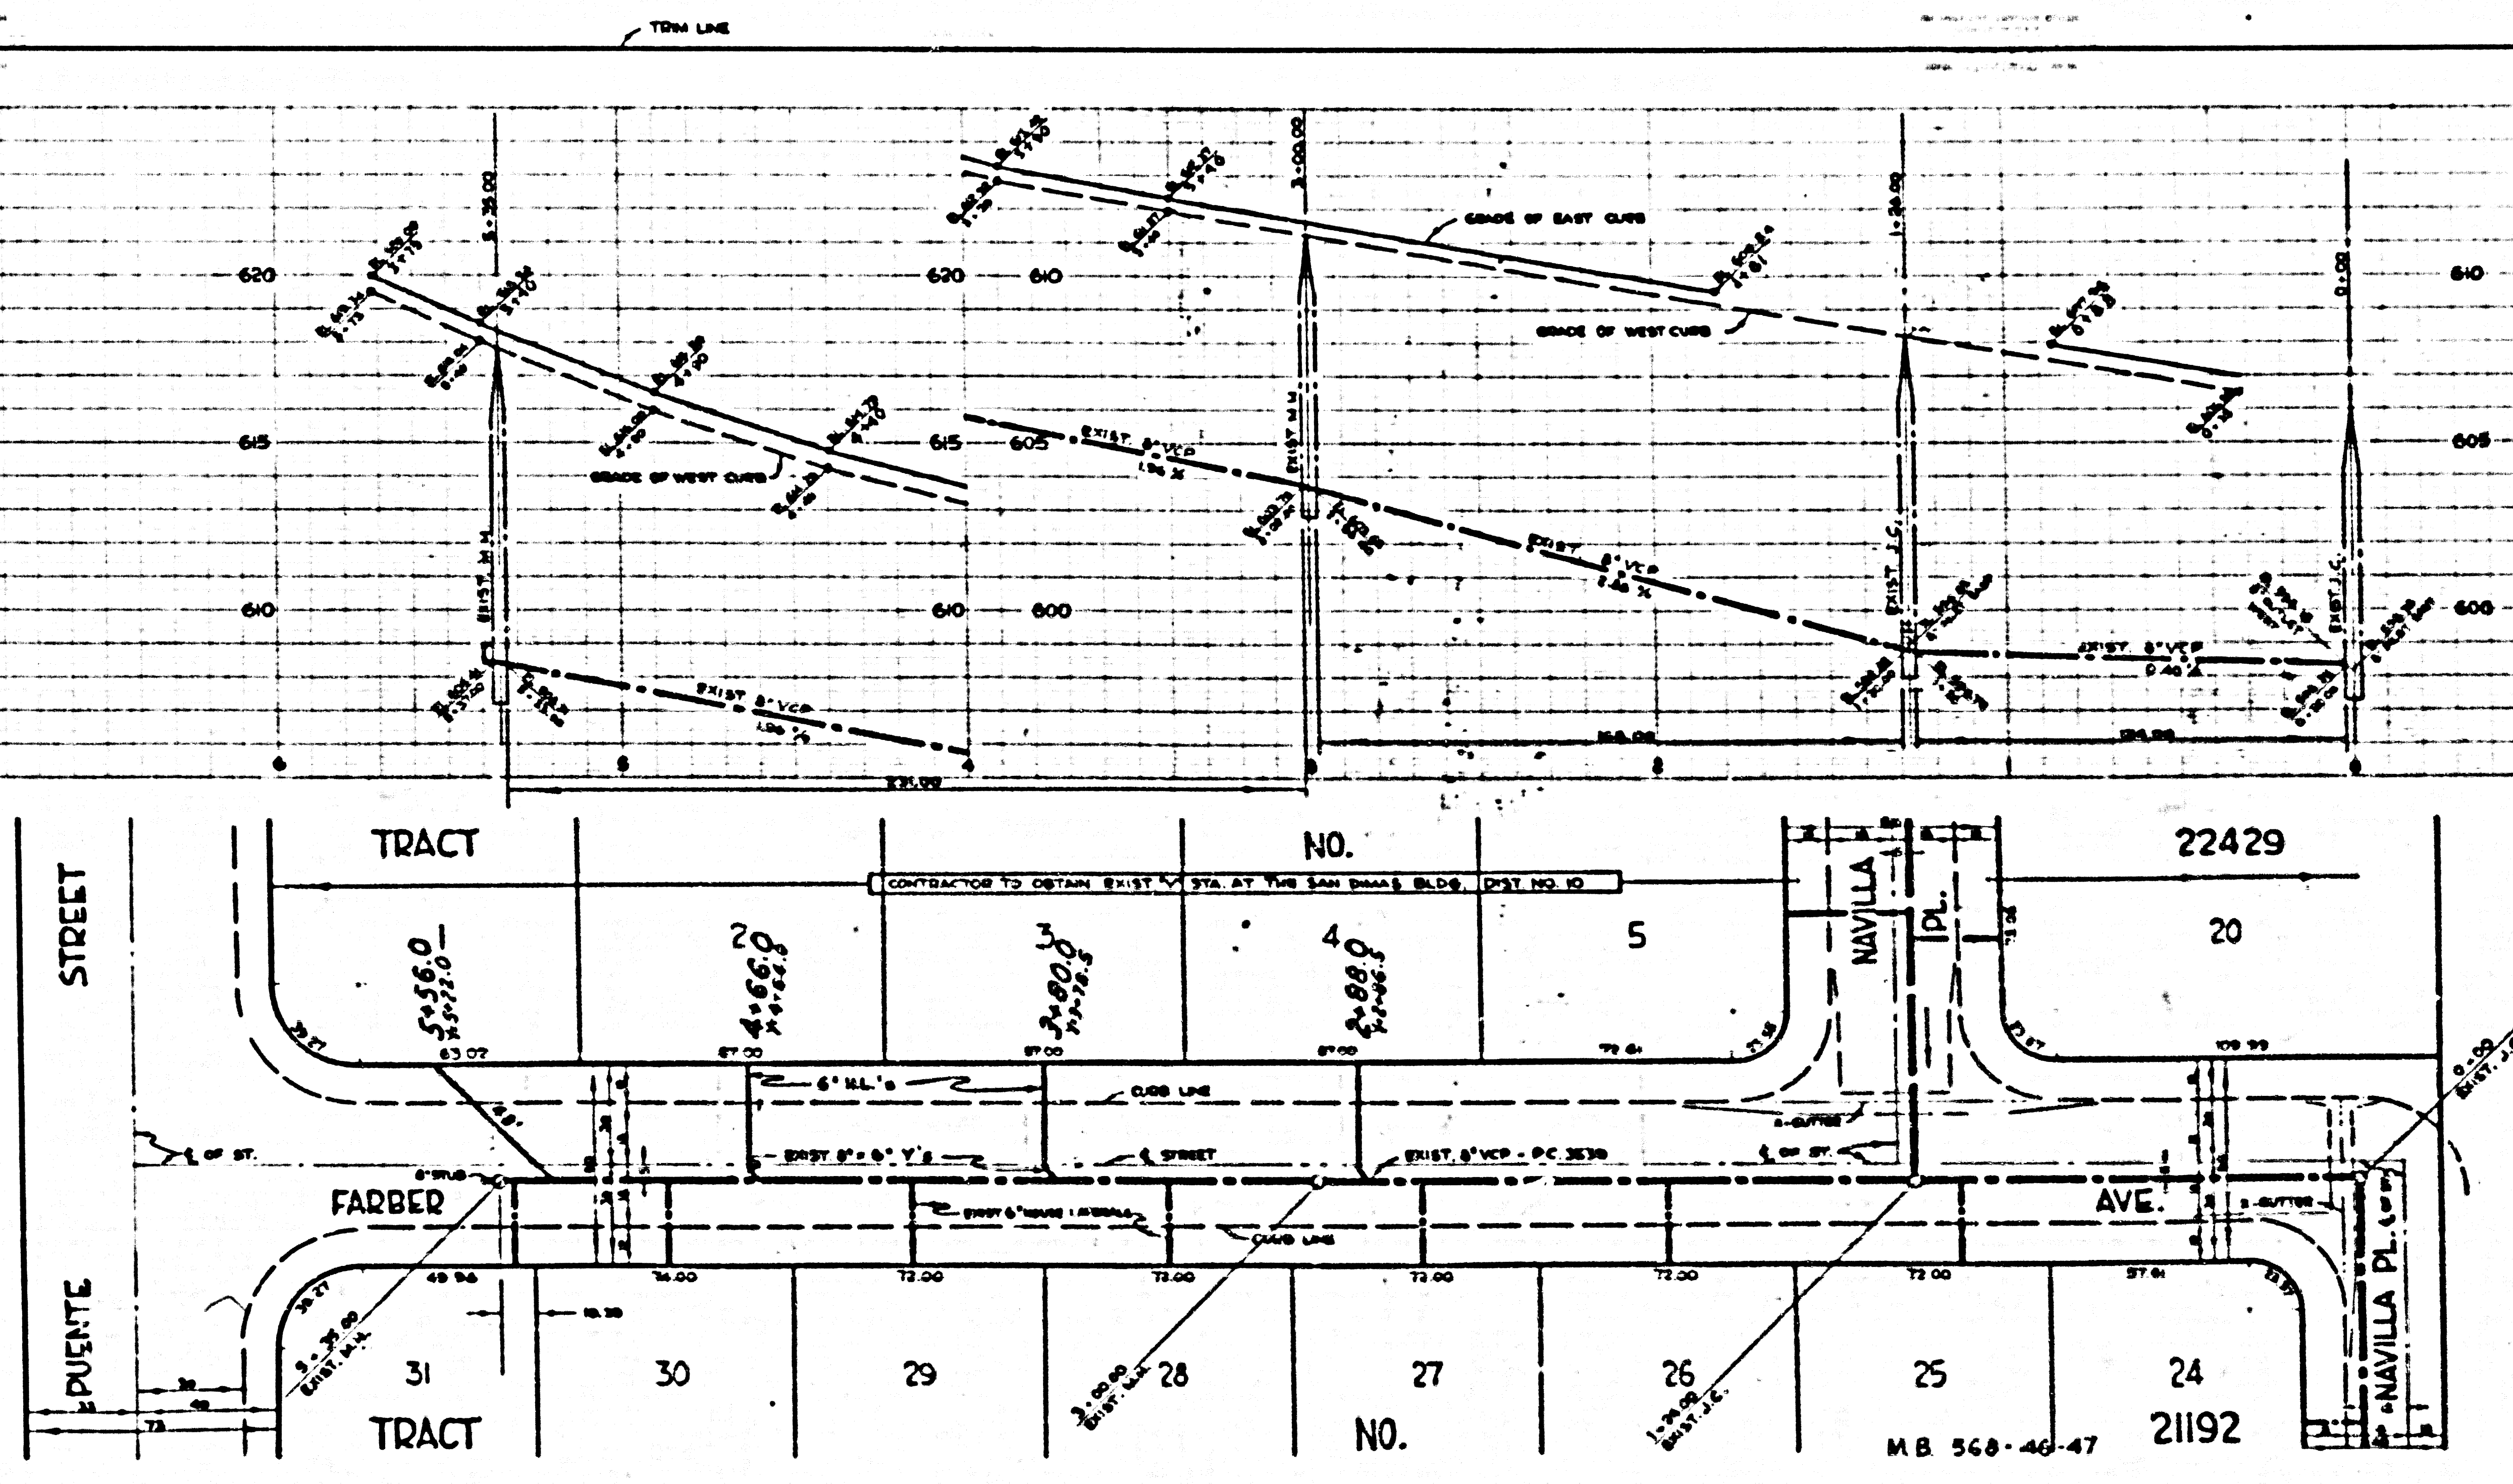

SEWER IN TRACT NO 22429  
P.C. 3849  
PAGE 29

(3)





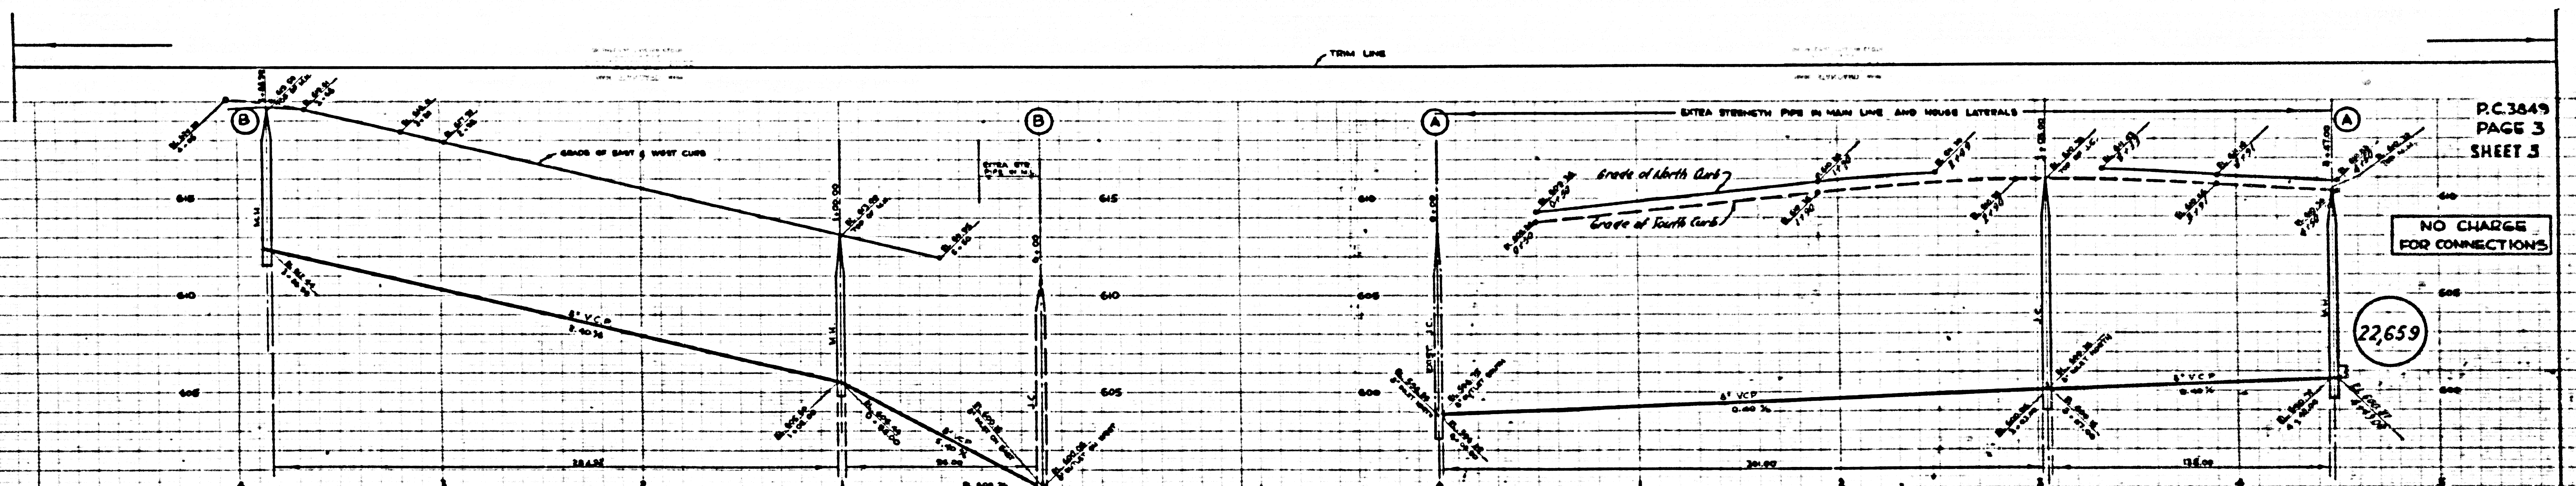

P.C. 3849  
PAGE 3  
SHEET 3

NO CHARGE  
FOR CONNECTIONS

22,659

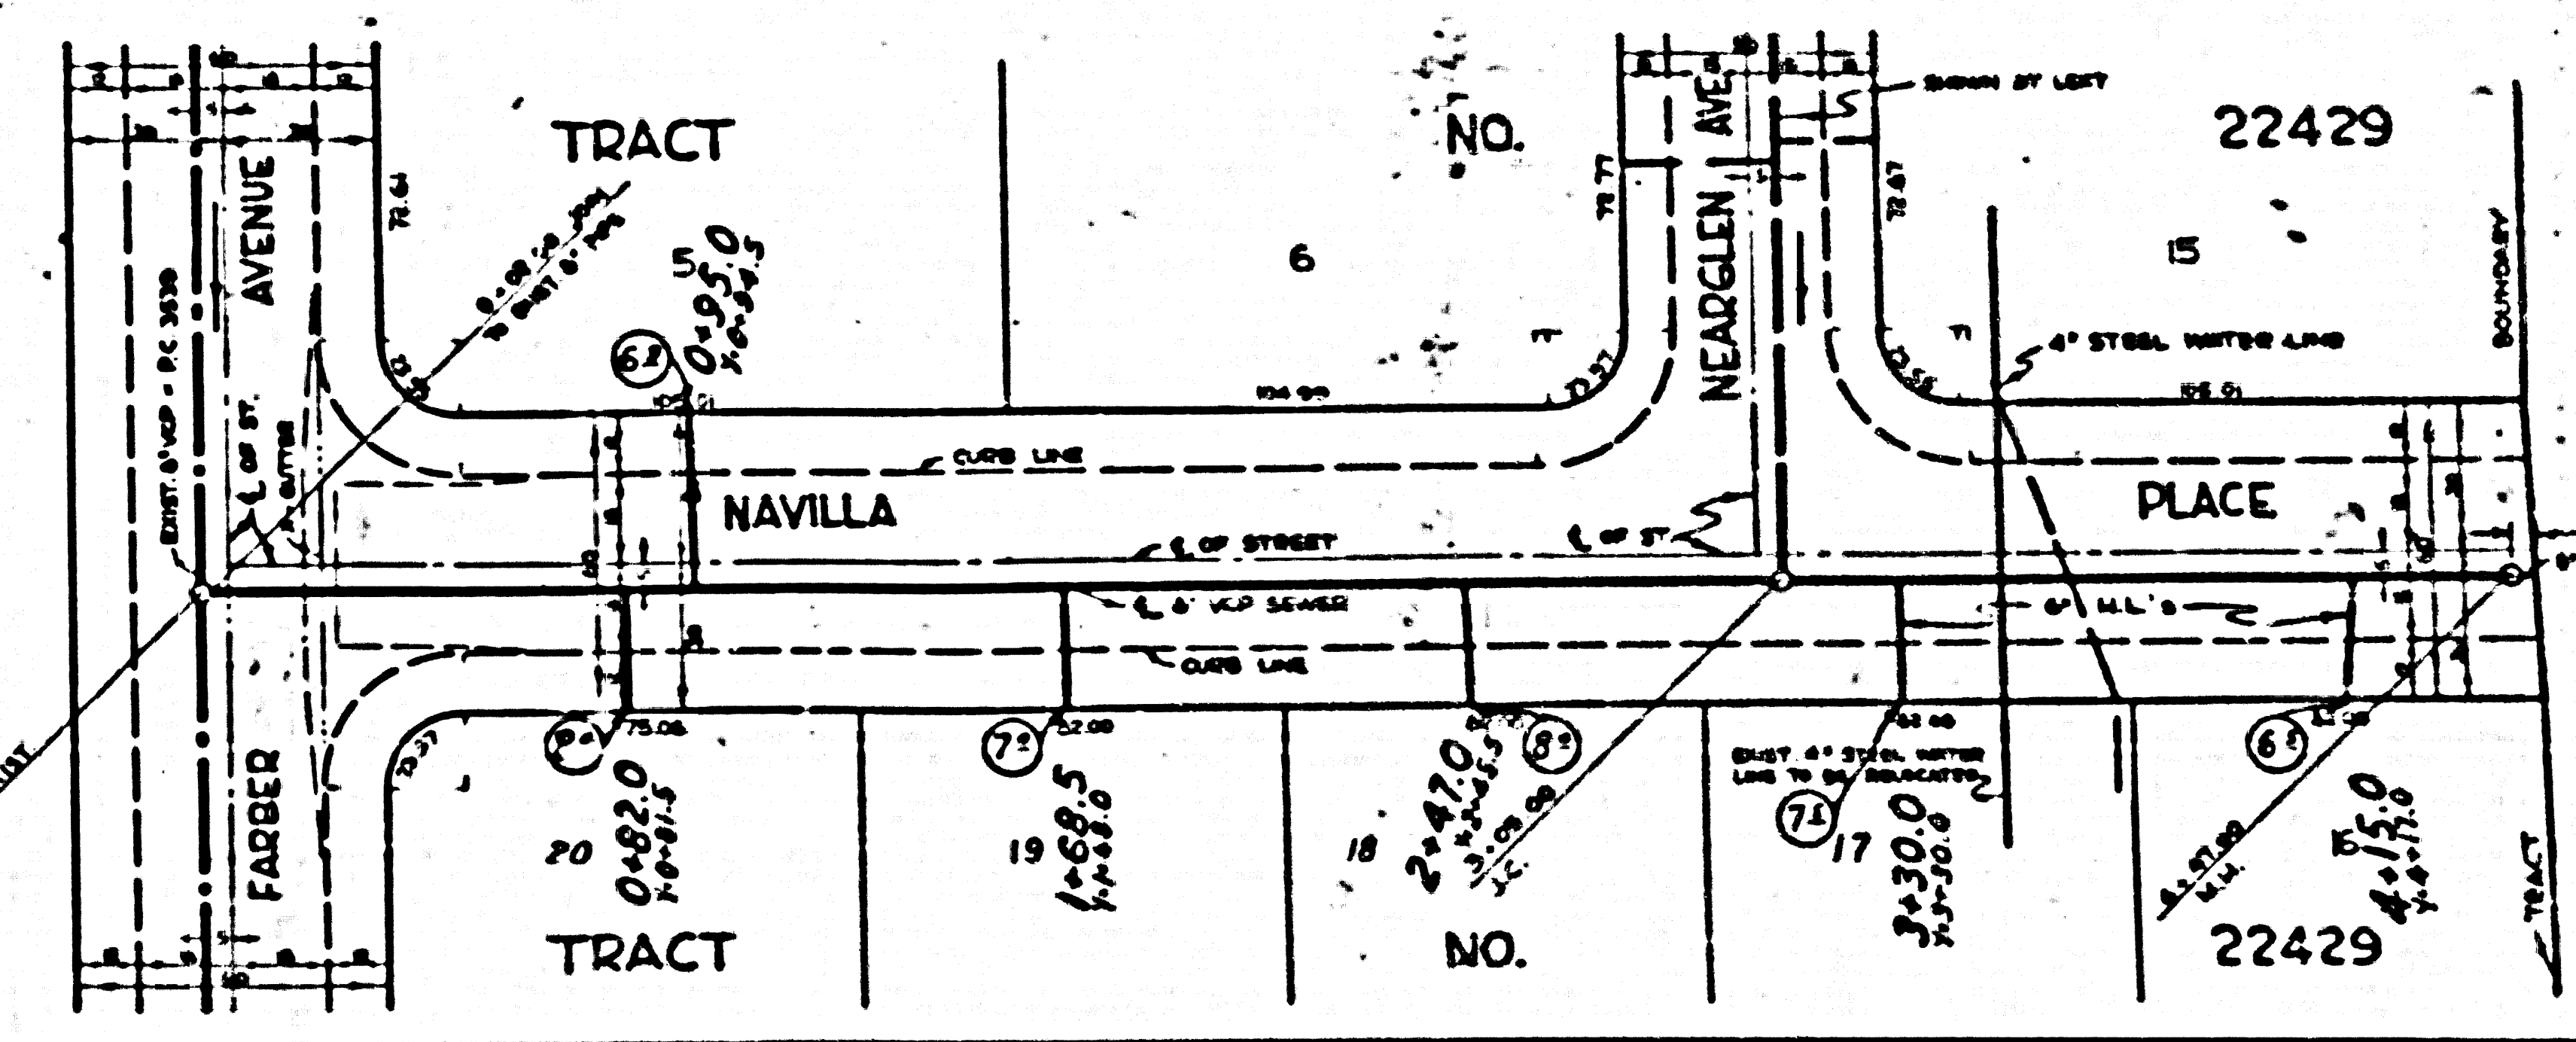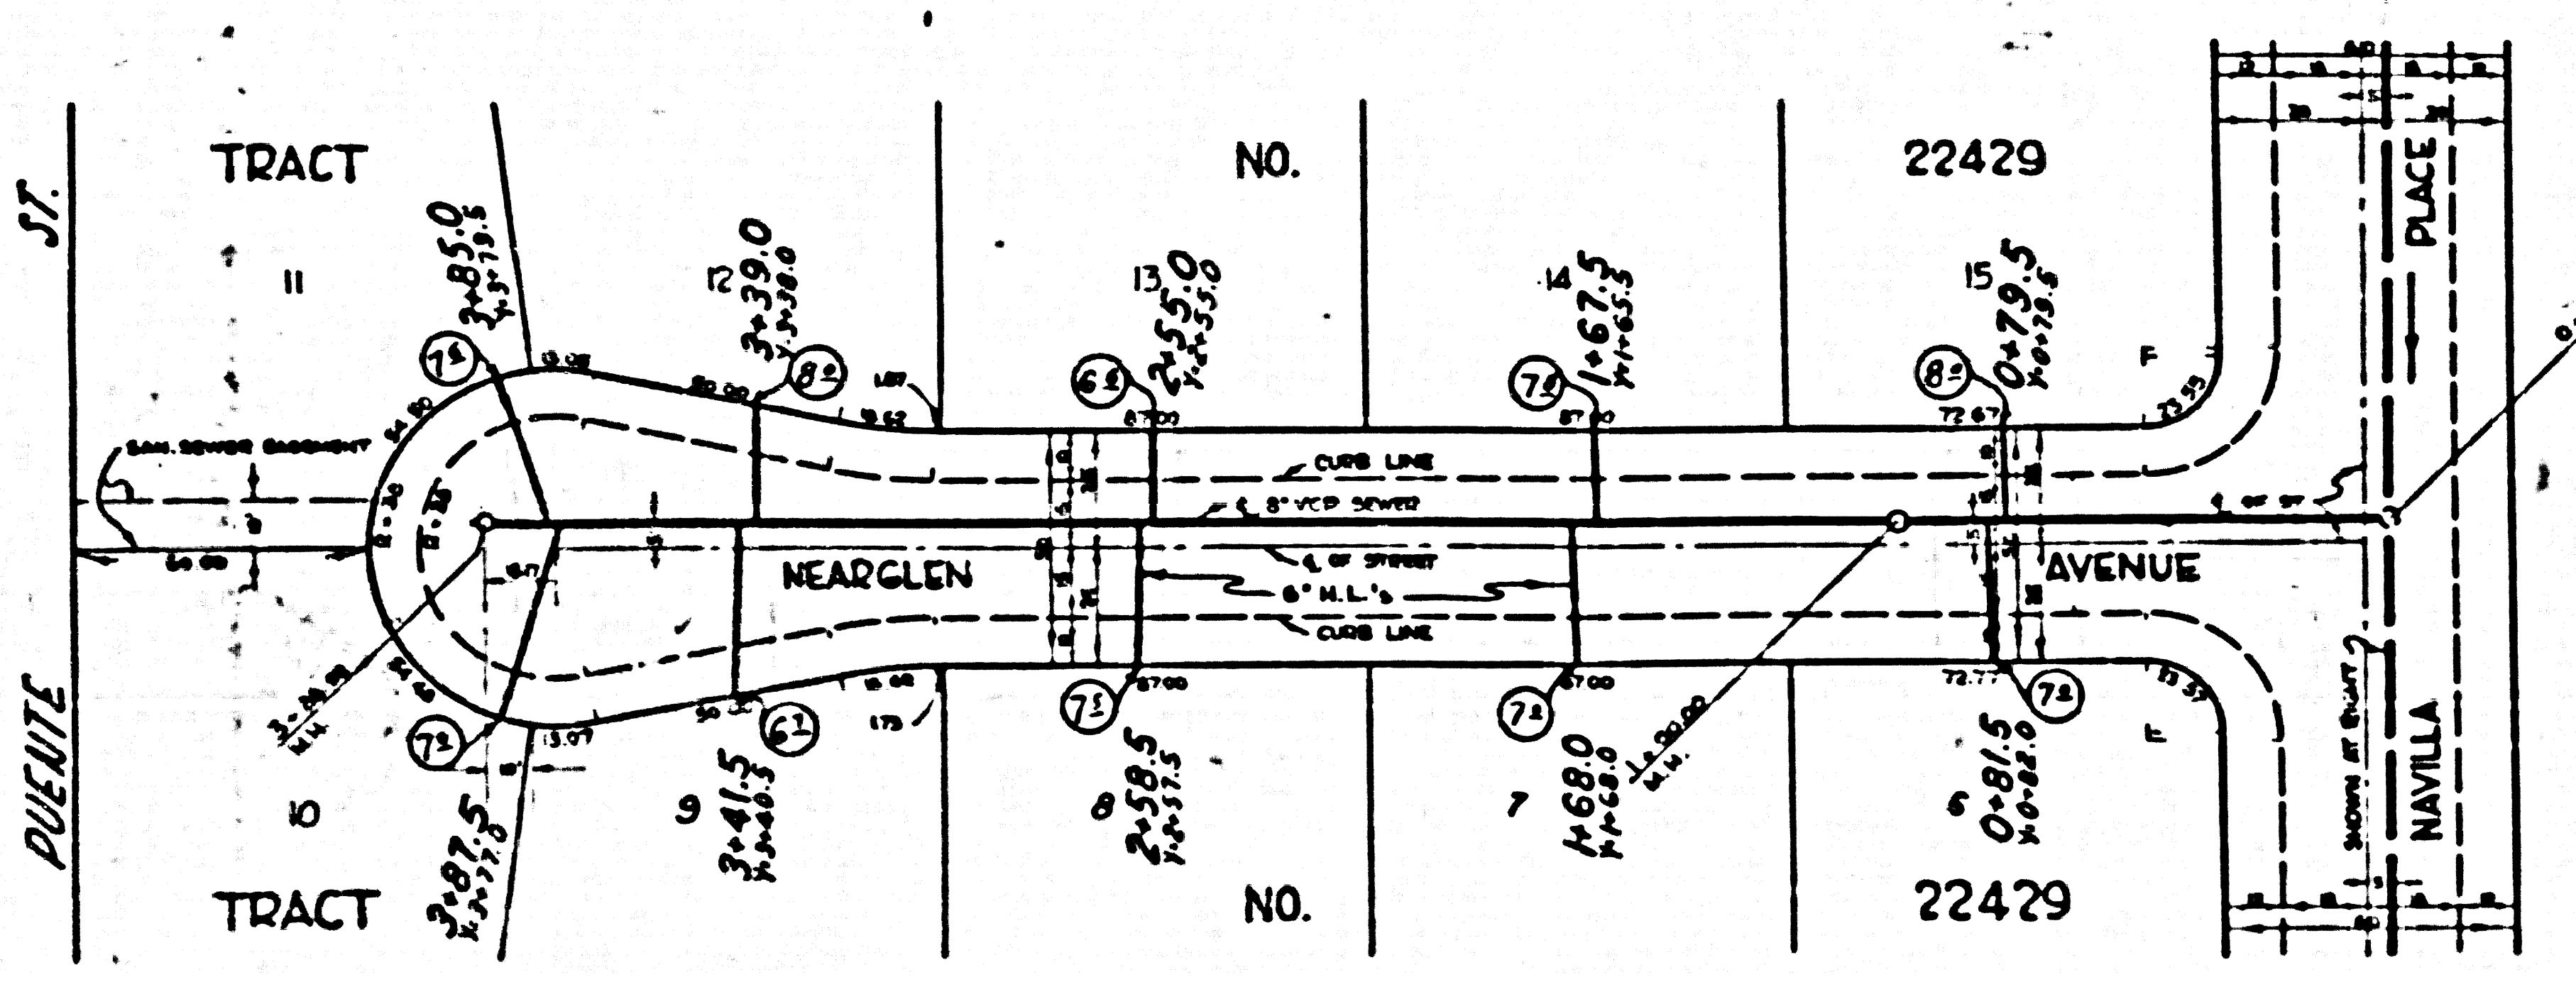

P.C. 3849 SEWERS IN TR. NO. 22429  
V. 28 E. 29




SAN DIMAS BUILDING DISTRICT NO. 10

**BENCH MARK:**  
S.A. 483 - LEAD 6 INCH  
DIAL IN EDGE OF CONC.  
NEAR BOX 120' S OF E. OF  
DOWLAND AVE. 4 1/2 W. OF E.  
OF GRAND AVE. - EL. 562.101

- NOTE:**
- Provide stakes on the property lines or property lines produced at right angles to the sewer line at the center line of each manhole.
- No representative of the County Engineer will survey or layout any portion of the work.
- The owner or his authorized representative shall furnish the County Engineer with grade sheets and stations for all house laterals and Y branches and shall provide stakes for them at their proper locations with stationing plainly marked. Any change in location shall be requested in writing by the owner or his representative.
- No revisions shall be made in these plans without the approval of the County Engineer.
1. Use standard manhole frames and covers, S-a-117.
  2. Use standard strength pipe except as noted.
  3. Use cement mortar for all vitrified clay pipe joints.
  4. Resurface all trench within paved area to meet L.A. County Road Dept. or California State Highway Dept. requirements in accordance with permit.
  5. Excise four feet of sewer at points of interference with poles, S-a-119.
  6. House laterals to be constructed with laterals at property line \_\_\_\_\_ feet below curb grade except as noted.
  7. All structures shall be brick sewer structures, S-a-104.
  8. For allowable leakage test, see Formula No. \_\_\_\_\_, Spec's., Sec. 81.
  9. Manhole tops in unimproved Right-of-Way to be 6" above finish grade.

SHEET NO.	PAGE NO.'S
1	1
2	2
3	3

NO CHARGE  
FOR CONNECTIONS  
*F. Cantor 2-14-56*

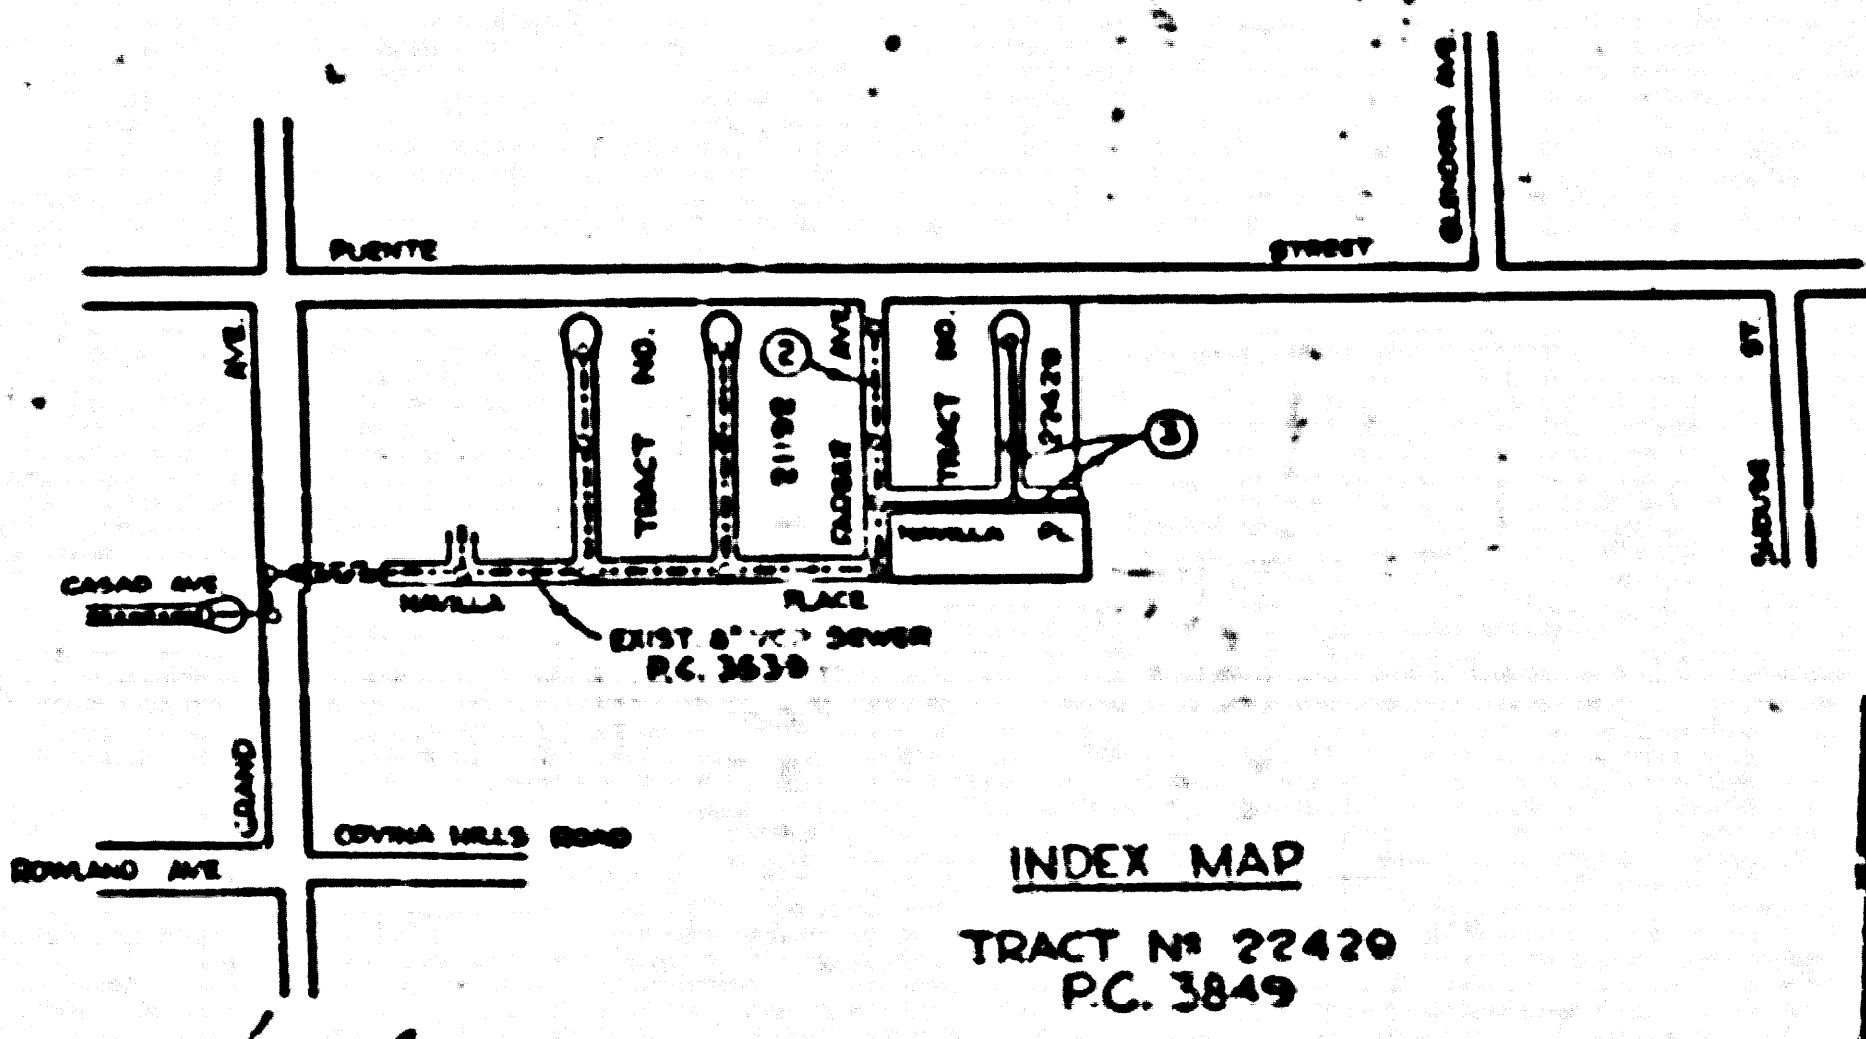

INDEX MAP  
TRACT NO. 22429  
P.C. 3849  
SCALE: 1" = 600'

*Checked 5-14-56 W. L. ...*

P.C. 3849  
PAGE 1  
SHEET 1

22657

(3)

PROFILE, ALIGNMENT AND GRADE OF  
SANITARY SEWERS  
TO BE CONSTRUCTED IN  
TRACT NO. 22429

PRIVATE CONTRACT NO. 3849  
W. S. 48  
1 OF 3 SHEETS  
Scale:  $\frac{1/4" = 10' \text{ HORIZ.}}{1" = 10' \text{ VERT.}}$  NOVEMBER 1955  
PREPARED IN THE OFFICES OF

TED M. WALSH & ASSOCIATES, INC.

*T.M. Walsh*  
C.E. No. 6438  
FOR LEGEND SEE PLAN NO. S-a-44

- NOTE:**
- Grades to which this improvement is to be constructed are shown on plans and profiles. Grade points for top of curb, center line of streets, or center line of alleys are shown by circles on profiles. At all points between designated points the grade shall be established so as to conform to a straight line drawn between said designated points.
- Elevations are in feet above U.S.C. & G.S. Sea level datum of 1929.
- This drawing and the data hereon are hereby made a part of the specifications.
- Work shall be constructed according to specifications on file in the office of the County Engineer and shall be prosecuted only in the presence of the County Engineer.
- Before work can be started, the contractor must obtain a permit to excavate in County streets from the L.A. County Road Dept., 108 W. 2nd St. and make a deposit with the County Engineer, 223 So. Broadway, Room 324, sufficient to cover the cost of construction inspection and record plans.
- Approval of this plan by the County of Los Angeles does not constitute a representation as to the accuracy of the location of or the existence or non-existence of any underground utility, pipe, or structure within the limits of this project. This note applies to all sheets.
- If work is to be done in a State Highway, a permit must be obtained from the State of California, Division of Highways, 129 South Spring Street.

COUNTY OF LOS ANGELES, CALIFORNIA

Approved, John A. Lambie, County Engineer  
*J.A. Lambie*  
San Dimas Engineer

Approved, A. M. Rowe  
CHIEF ENGINEER, SAN DIST. NO. 10  
*A.M. Rowe*  
Office Engineer

Checked by *J.P. Fisher 2-15-56*  
Office of County Engineer, Dep. C. & No. 7260

SEWERS IN TR. NO. 22429  
P.C. 3849  
PAGE 1  
SHEET 1