

BELFLOWER BLDG. DIST. NO. 4

PROFILE ALIGNMENT AND GRADE OF P.C. 3873
 SANITARY SEWERS PAGE 1
 TO BE CONSTRUCTED IN
 TRACT NO. 22213

PRIVATE CONTRACT NO. 3873

W.S. 30

2 SHEETS, 4 PAGES

23,695

SCALE: 1" = 10'


JAN., 1956

PREPARED IN THE OFFICES OF
 ENGINEERING SERVICE CORP.

(4)

BY: *C. B. Debovar*
 REG. C. E. NO. 3692

FOR LEGEND SEE PLAN NO. S-A-64

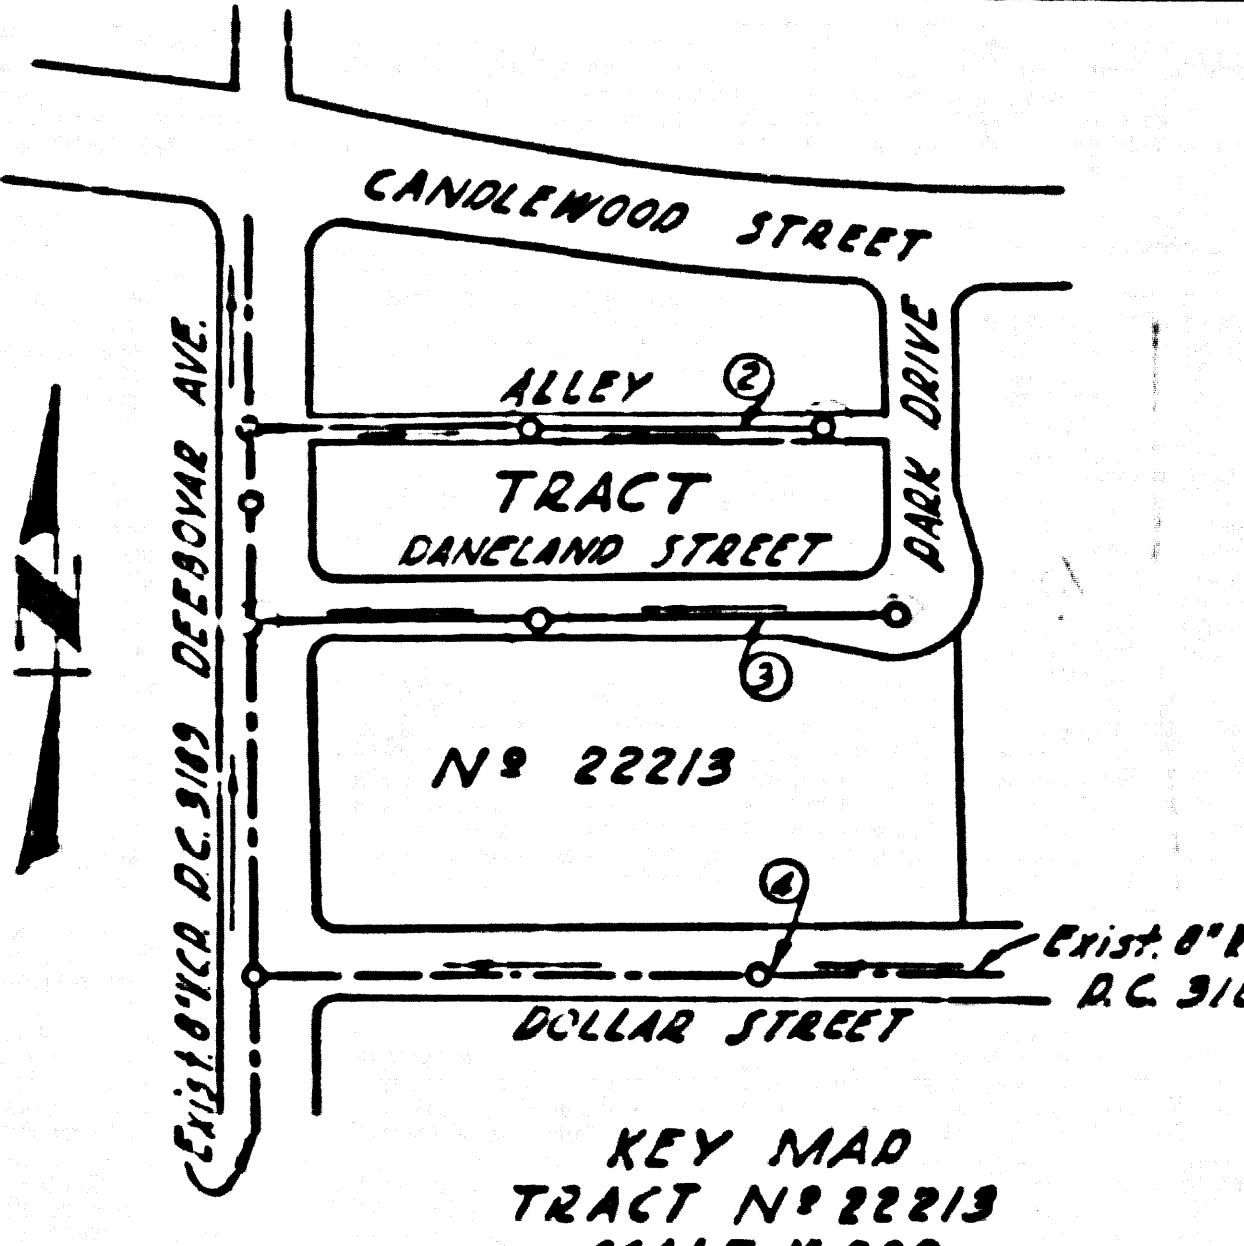

BENCH MARK
 SY 33 Chiseled angle
 Point in headwall at N.E.
 corner of Debovar Blvd.
 and South Street.
 Elev. 53.760

NO CHARGE
 FOR CONNECTIONS
R. S. Kuhn 3-29-56

- NOTES:
- PROVIDE STAKES ON THE PROPERTY LINE OR PROPERTY LINES PRODUCED AT RIGHT ANGLES TO THE SEWER LINE AT THE CENTER LINE OF EACH MANHOLE.
 - NO REPRESENTATIVE OF THE CITY ENGINEER WILL SURVEY OR LAYOUT ANY PORTION OF THE WORK.
 - THE OWNER OR HIS AUTHORIZED REPRESENTATIVE SHALL FURNISH THE CITY ENGINEER WITH GRADE SHEETS AND STATIONING FOR ALL HOUSE LATERALS AND Y BRANCHES AND SHALL PROVIDE STAKES FOR THEM AT THEIR PROPER LOCATIONS WITH STATIONING PLAINLY MARKED. ANY CHANGE IN LOCATION SHALL BE REQUESTED IN WRITING BY THE OWNER OR HIS REPRESENTATIVE.
 - NO REVISIONS SHALL BE MADE IN THESE PLANS WITHOUT THE APPROVAL OF THE CITY ENGINEER.
 - USE STANDARD MANHOLE FRAMES AND COVERS, S.A.-117, EXCEPT AS NOTED.
 - USE STANDARD STRENGTH PIPE EXCEPT AS NOTED.
 - USE CEMENT MORTAR FOR ALL VITRIFIED CLAY PIPE JOINTS.
 - REINFORCE ALL TRENCH WITHIN PAVED AREA TO MEET CITY OF LAKEWOOD SPECIFICATIONS FOR CURB AND SIDEWALKS.
 - ENCASE FOUR FEET OF SEWER AT POINTS OF INTERFERENCE WITH HOLES, S.A.-119.
 - HOUSE LATERALS TO BE CONSTRUCTED WITH INVERTS AT PROPERTY LINE 6" FEET BELOW CURB GRADE OR 6" OF ALLEY EXCEPT AS NOTED.
 - ALL STRUCTURES SHALL BE BRICK SEWER STRUCTURES, 1 S.A.-104, EXCEPT AS NOTED.
 - FOR ALLOWABLE LEAKAGE TEST USE FORMULA NO. 1 SPEC. SEC. II.
 - MANHOLE POPE IN UNIMPROVED RIGHTS-OF-WAY TO BE 4" ABOVE FINISHED GRADE.

NOTE


ENGINEERING SERVICE CORPORATION	
1127 W. WASHINGTON BLVD.	
LOS ANGELES 15, CALIF.	RI 9-7281
REVISIONS	
	TRACED BY <i>R.A.B.</i>
	DESIG. BY <i>cd</i>
	C.K.D. BY <i>cd</i>
	SUBMITTED: <i> </i>
	APPROVED: <i>R. S. Kuhn</i>
SUB STRUCTURES C.K.D.	
NO. 1	REG. C. E. NO. 3692
6837-1	30 JAN 56

NOTE:
 GRADES TO WHICH THIS IMPROVEMENT IS TO BE CONSTRUCTED ARE SHOWN ON PLANS AND PROFILES. GRADE POINTS FOR TOP OF CURB, CENTER LINE OF TRENCH, OR CENTER LINE OF ALLEYS ARE SHOWN BY CIRCLES ON PROFILES. AT ALL POINTS BETWEEN DESIGNATED POINTS THE GRADE SHALL BE ESTABLISHED SO AS TO CONFORM TO A STRAIGHT LINE DRAWN BETWEEN SAID DESIGNATED POINTS.
 ELEVATIONS ARE IN FEET ABOVE U.S.C. & G.S. MEAN SEA LEVEL DATUM OF 1929.
 THIS DRAWING AND THE DATA HEREON ARE HEREBY MADE A PART OF THE SPECIFICATIONS.
 WORK SHALL BE CONSTRUCTED ACCORDING TO SPECIFICATIONS ON FILE IN THE OFFICE OF THE CITY ENGINEER AND SHALL BE PROSECUTED ONLY IN THE PRESENCE OF THE CITY ENGINEER.
 BEFORE WORK CAN BE STARTED, THE CONTRACTOR MUST OBTAIN A PERMIT TO EXCAVATE IN CITY STREETS FROM THE CITY OF LAKEWOOD ROAD DEPT., 128 W. 5TH ST. AND MAKE A DEPOSIT WITH THE CITY ENGINEER, ROOM 324 PAN AMERICAN BUILDING, 333 S.O. HIGHWAY, SUFFICIENT TO COVER THE COST OF CONSTRUCTION INSPECTION AND RECORD PLANS.
 APPROVAL OF THIS PLAN BY THE CITY OF LAKEWOOD DOES NOT CONSTITUTE A REPRESENTATION AS TO THE ACCURACY OF THE LOCATION OF OR THE EXISTENCE OR NON-EXISTENCE OF ANY UNDERGROUND UTILITY PIPE, OR STRUCTURE WITHIN THE LIMITS OF THIS PROJECT. THIS NOTE APPLIES TO ALL PAGES.
 IF WORK IS TO BE DONE IN A STATE HIGHWAY, A PERMIT MUST BE OBTAINED FROM THE STATE OF CALIFORNIA, DIVISION OF HIGHWAYS, 128 SOUTH SPRING STREET.

CITY OF LAKEWOOD, CALIFORNIA
 APPROVED, JOHN A. LAMBE, CITY ENGINEER
 APPROVED, A. M. RAWN, CHIEF ENGINEER
 BY: *A. P. Collins* *A. M. Rawn*
 SANITATION ENGINEER CIVIL ENGINEER
 CHECKED BY: *R. S. Kuhn* 3-29-56
 OFFICE OF CITY OF LAKEWOOD REG. C. E. NO. 7860

Change of Plan Page 2
 M.H. Moved from 6' North
 to 8' South of 2' Alley in
 Debovar Avenue.
 Approved: *R. S. Kuhn* 10-25-56
 Chief of Utility Inspected - Reg. C. E. No. 7860

Sealed 11-28-56 *W. L. ...*

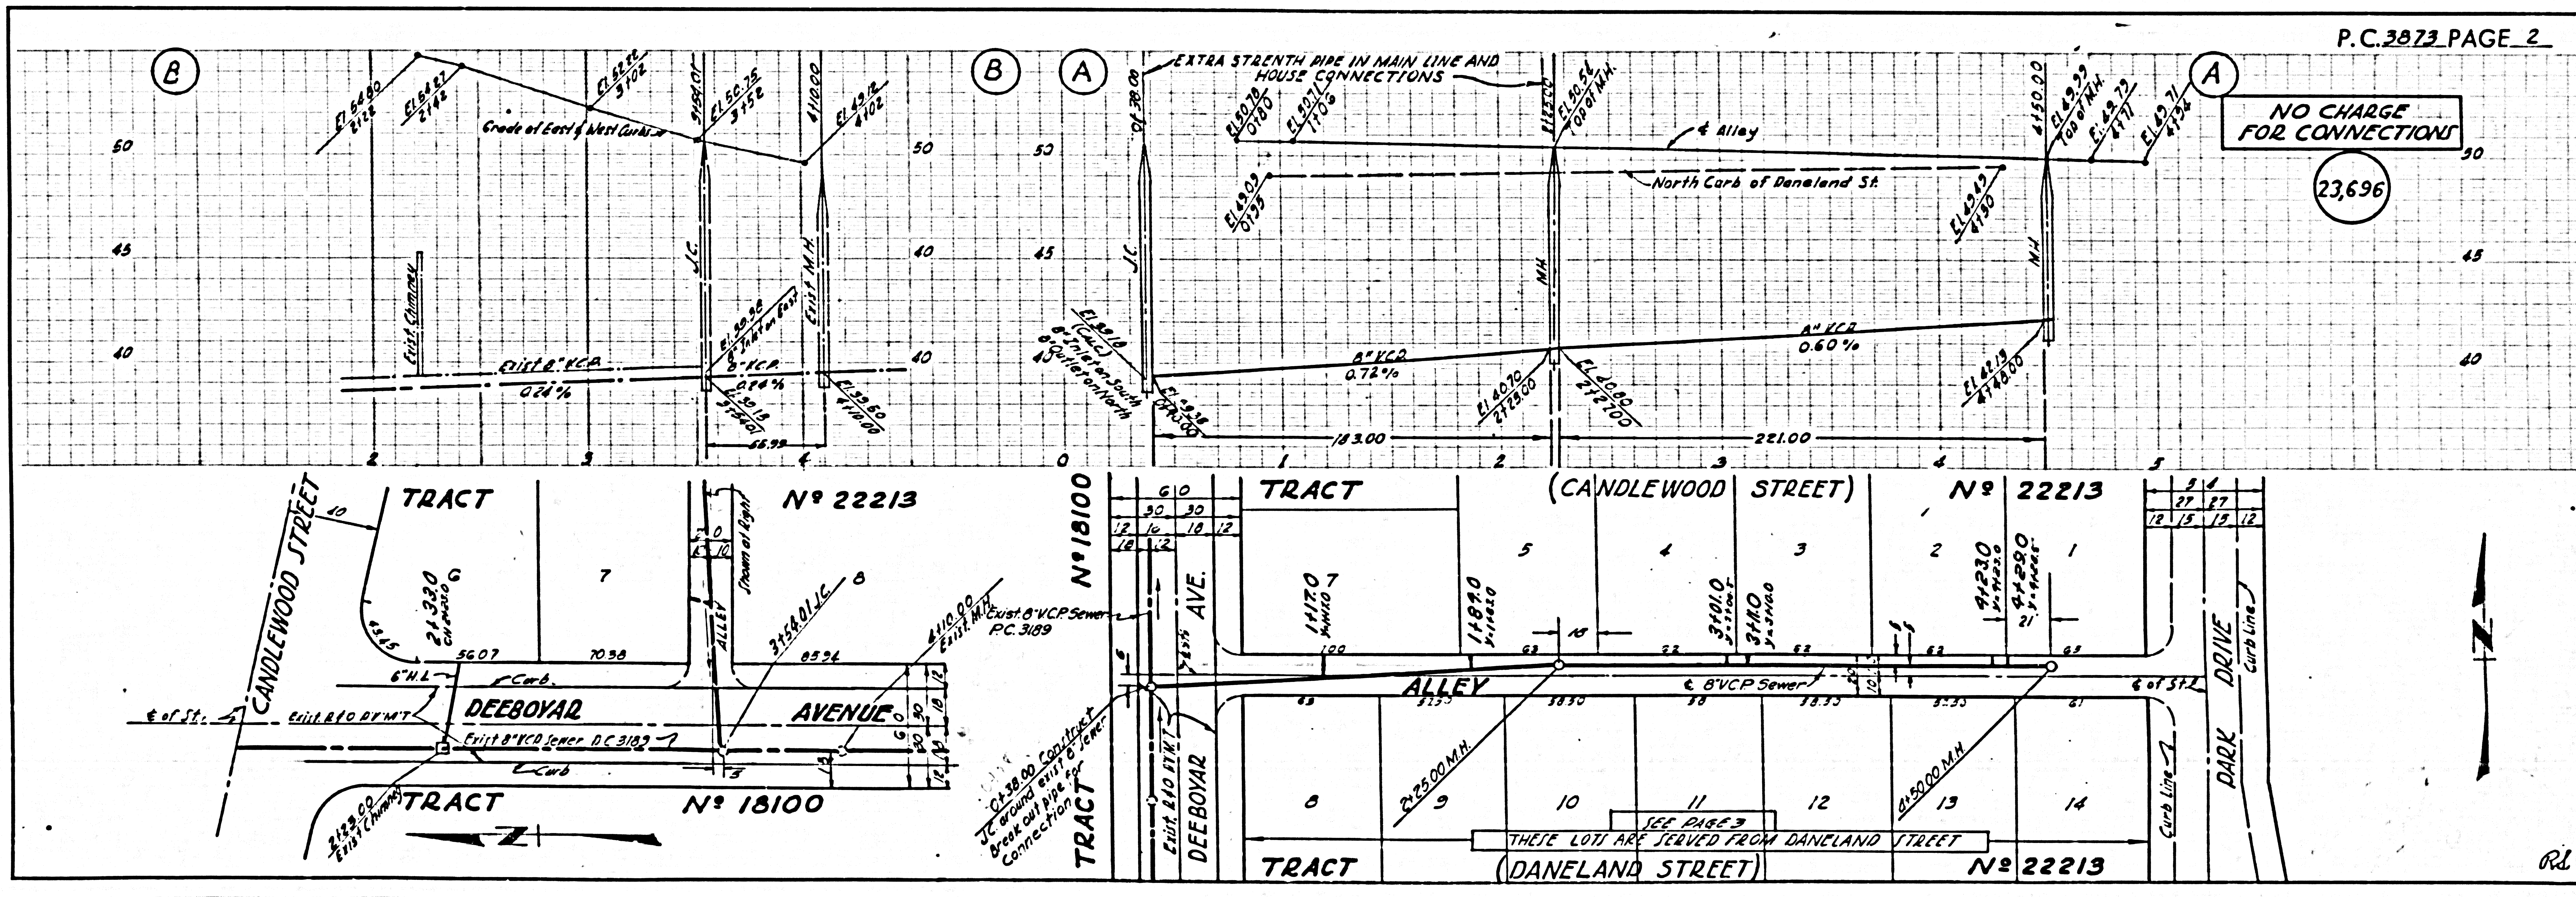

NO CHARGE
 FOR CONNECTIONS
 23,696


NO CHARGE
 FOR CONNECTIONS
 23,696

P.C. 3873

P.C. 3873 PAGE 2

NO CHARGE
 FOR CONNECTIONS


23,697

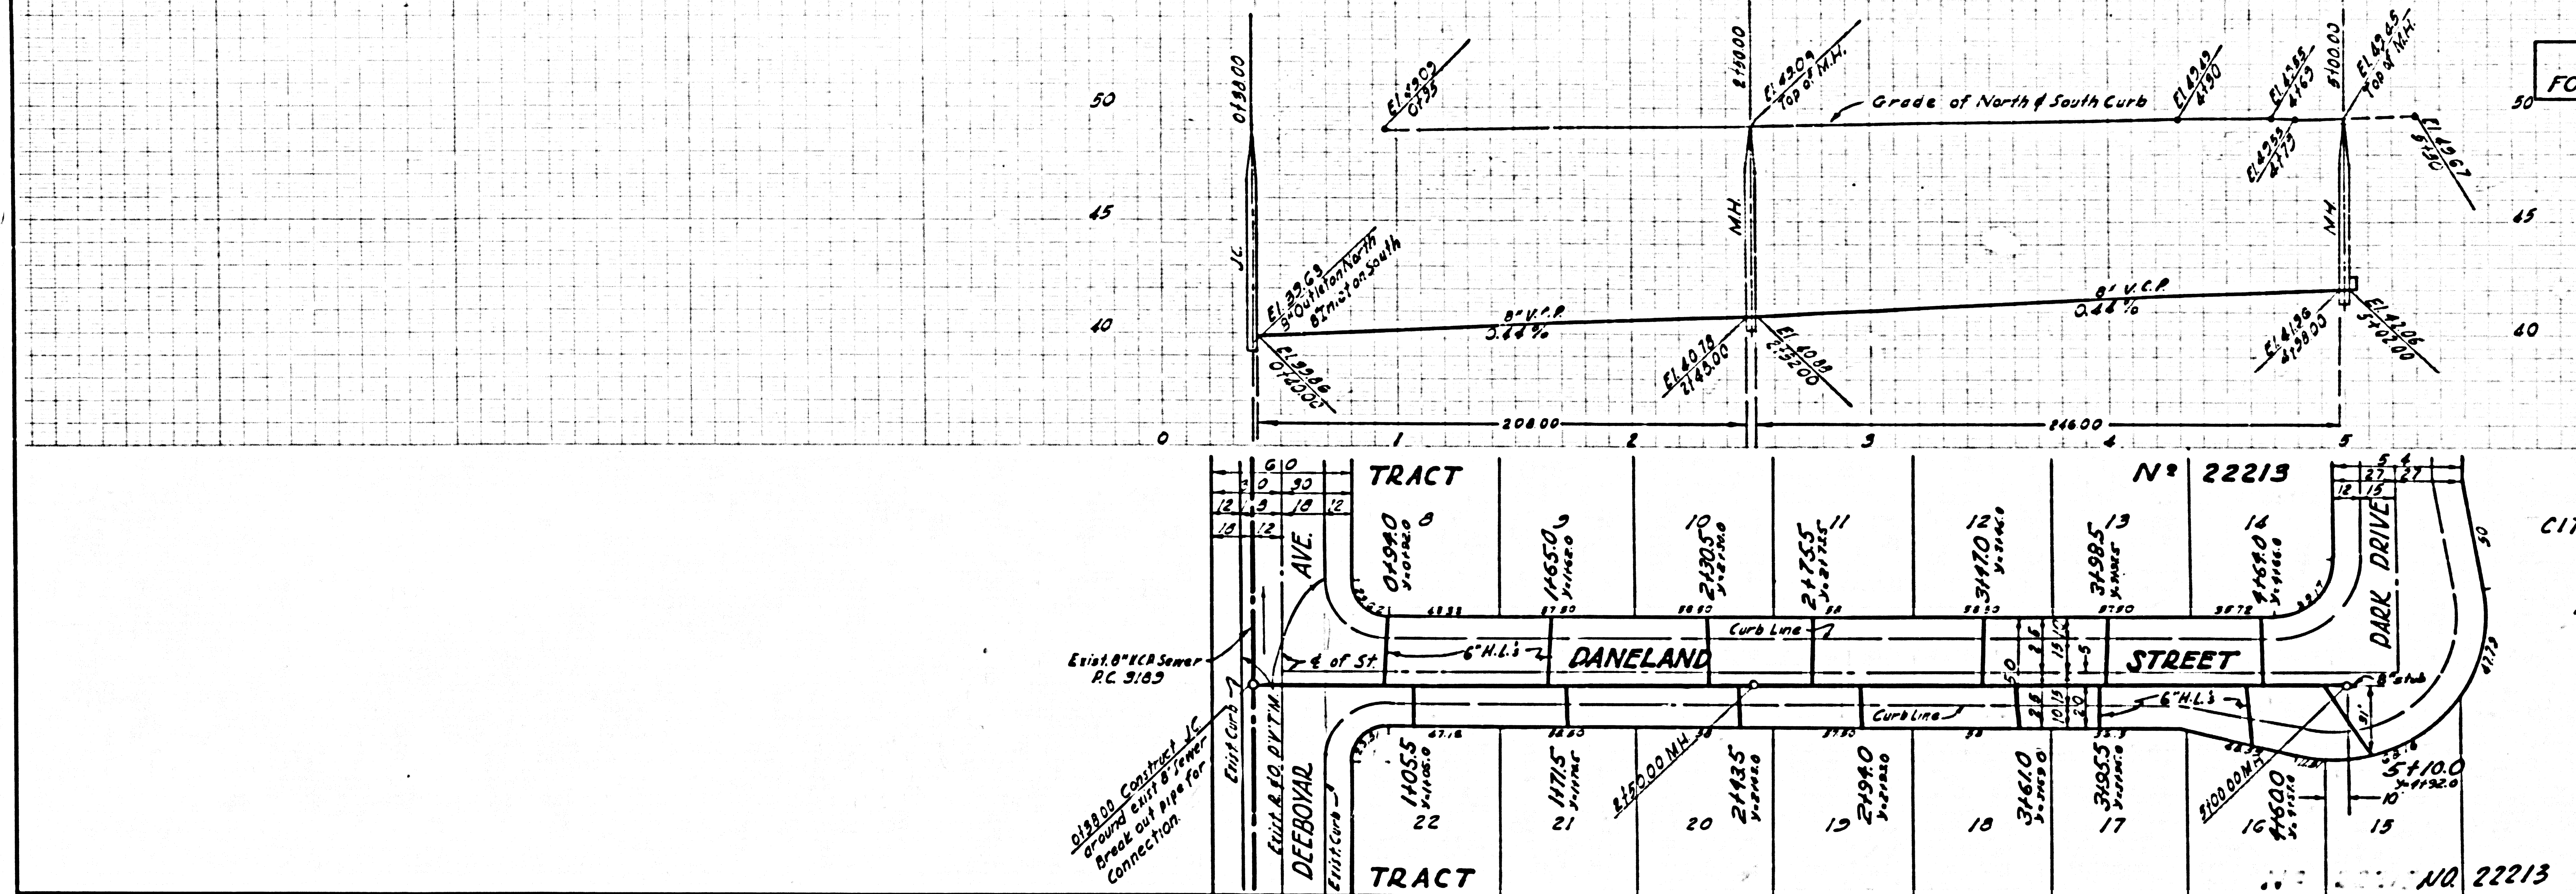

CITY OF LAKEWOOD
 PARK SITE
 31
 NO. 22213
 R.L.

NO CHARGE
 FOR CONNECTIONS

23,698

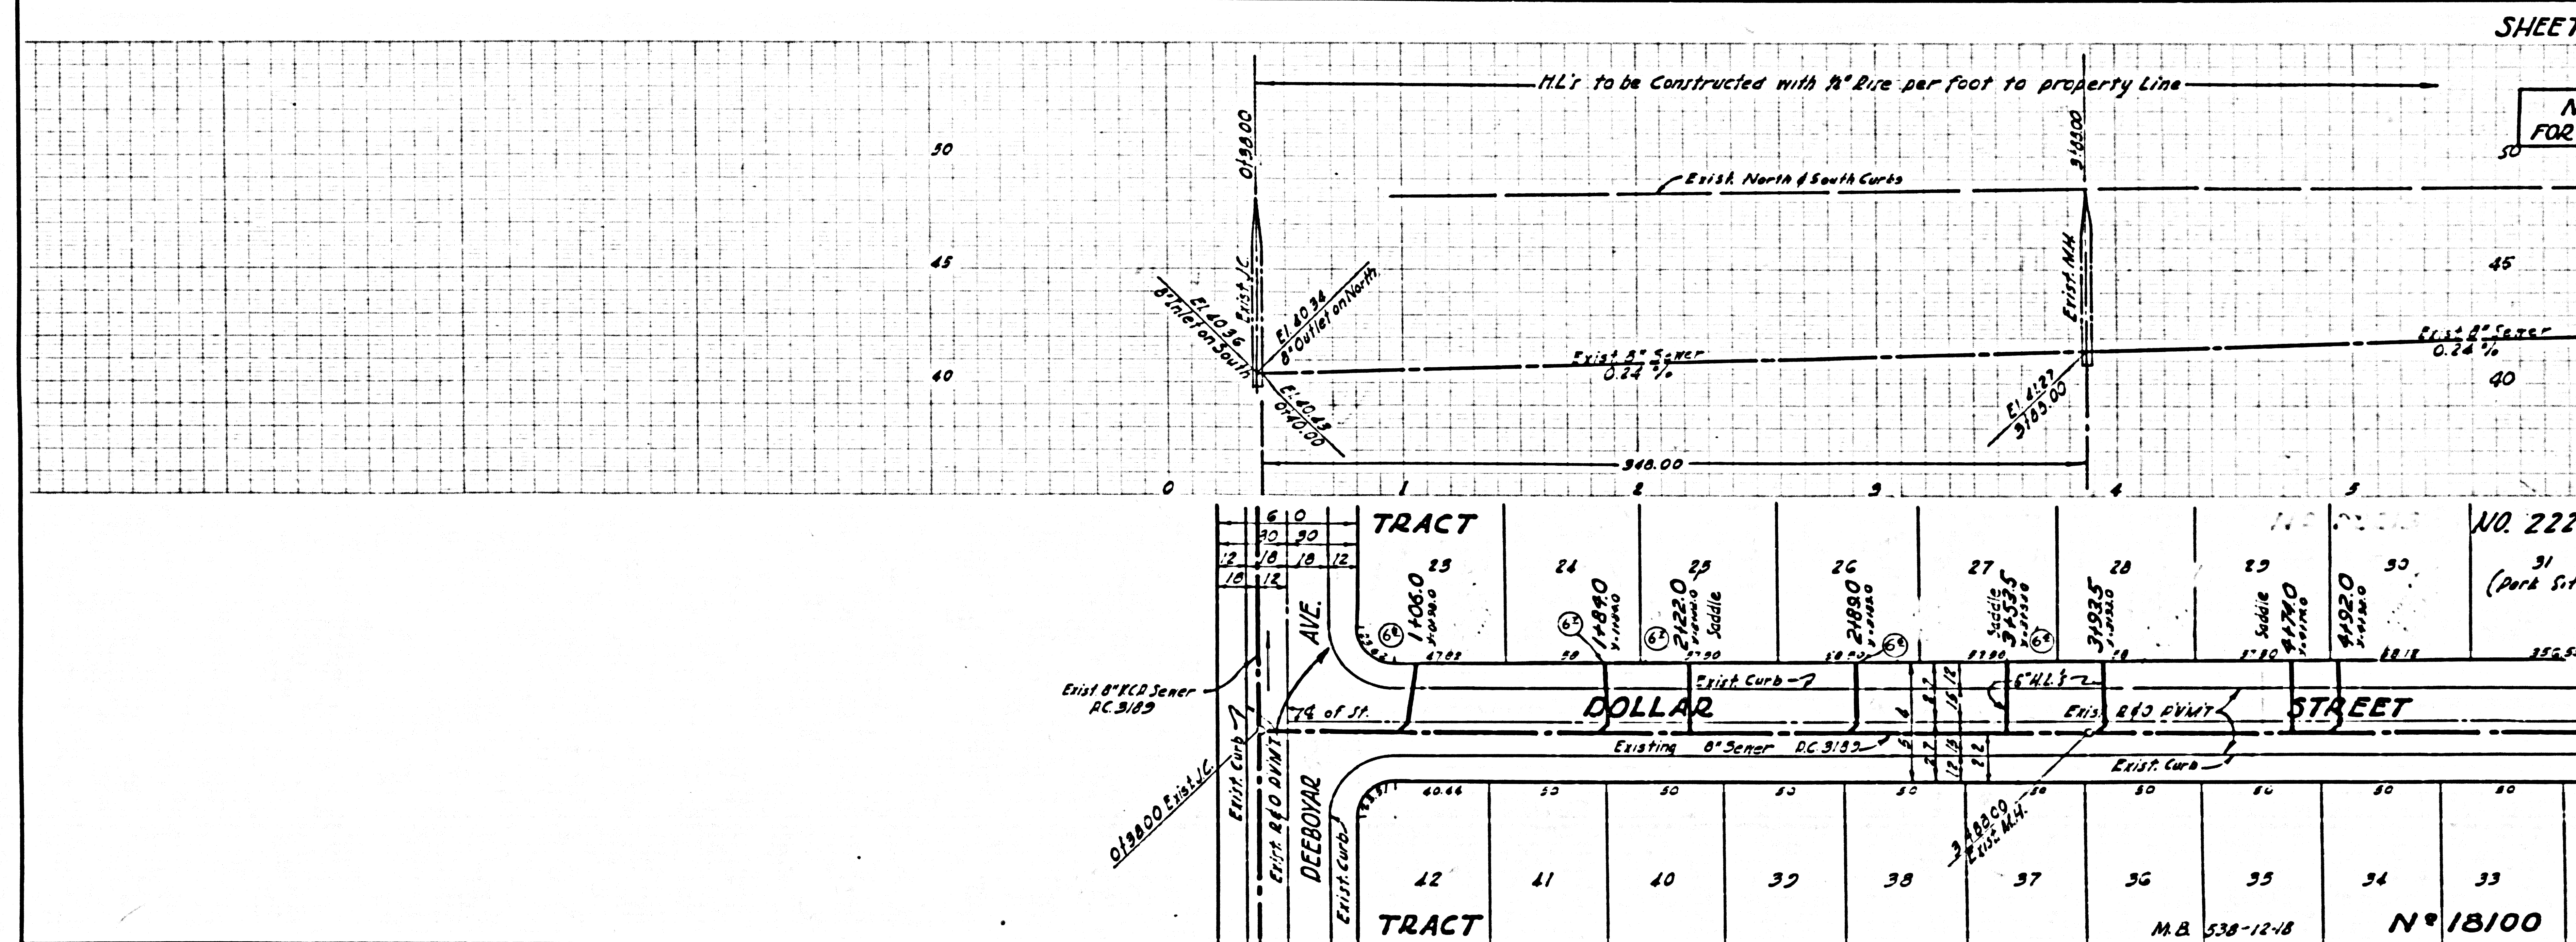

CITY OF LAKEWOOD
 PARK SITE
 31
 NO. 22213
 NO. 18100
 M.B. 538-12-18
 R.L.