

WHITTIER BLDG. DIST. NO. 11


PROFILE ALIGNMENT AND GRADE OF P.C. 4971
 SANITARY SEWERS PAGE 1
 TO BE CONSTRUCTED IN

TRACT No 24476 (26804)
 PRIVATE CONTRACT NO. 4971
 W.S. 34137

3 SHEETS, 5 PAGES
 SCALE: VERT. 1"=4' HORIZ. 1"=40'
 NOVEMBER, 1958
 PREPARED IN THE OFFICES OF
BARNETT, HOPEN & SMITH
 REG. C. E. NO. 1216

FOR LEGEND SEE PLAN NO. S-A-64

B.M. WZ-394 El. 335.729 P.B. 1971-207
 CATALINA AVE. & FOURTH ST. SW. Cor.
 Bt. Spk. in cb. 5' W. of W. End C.R.

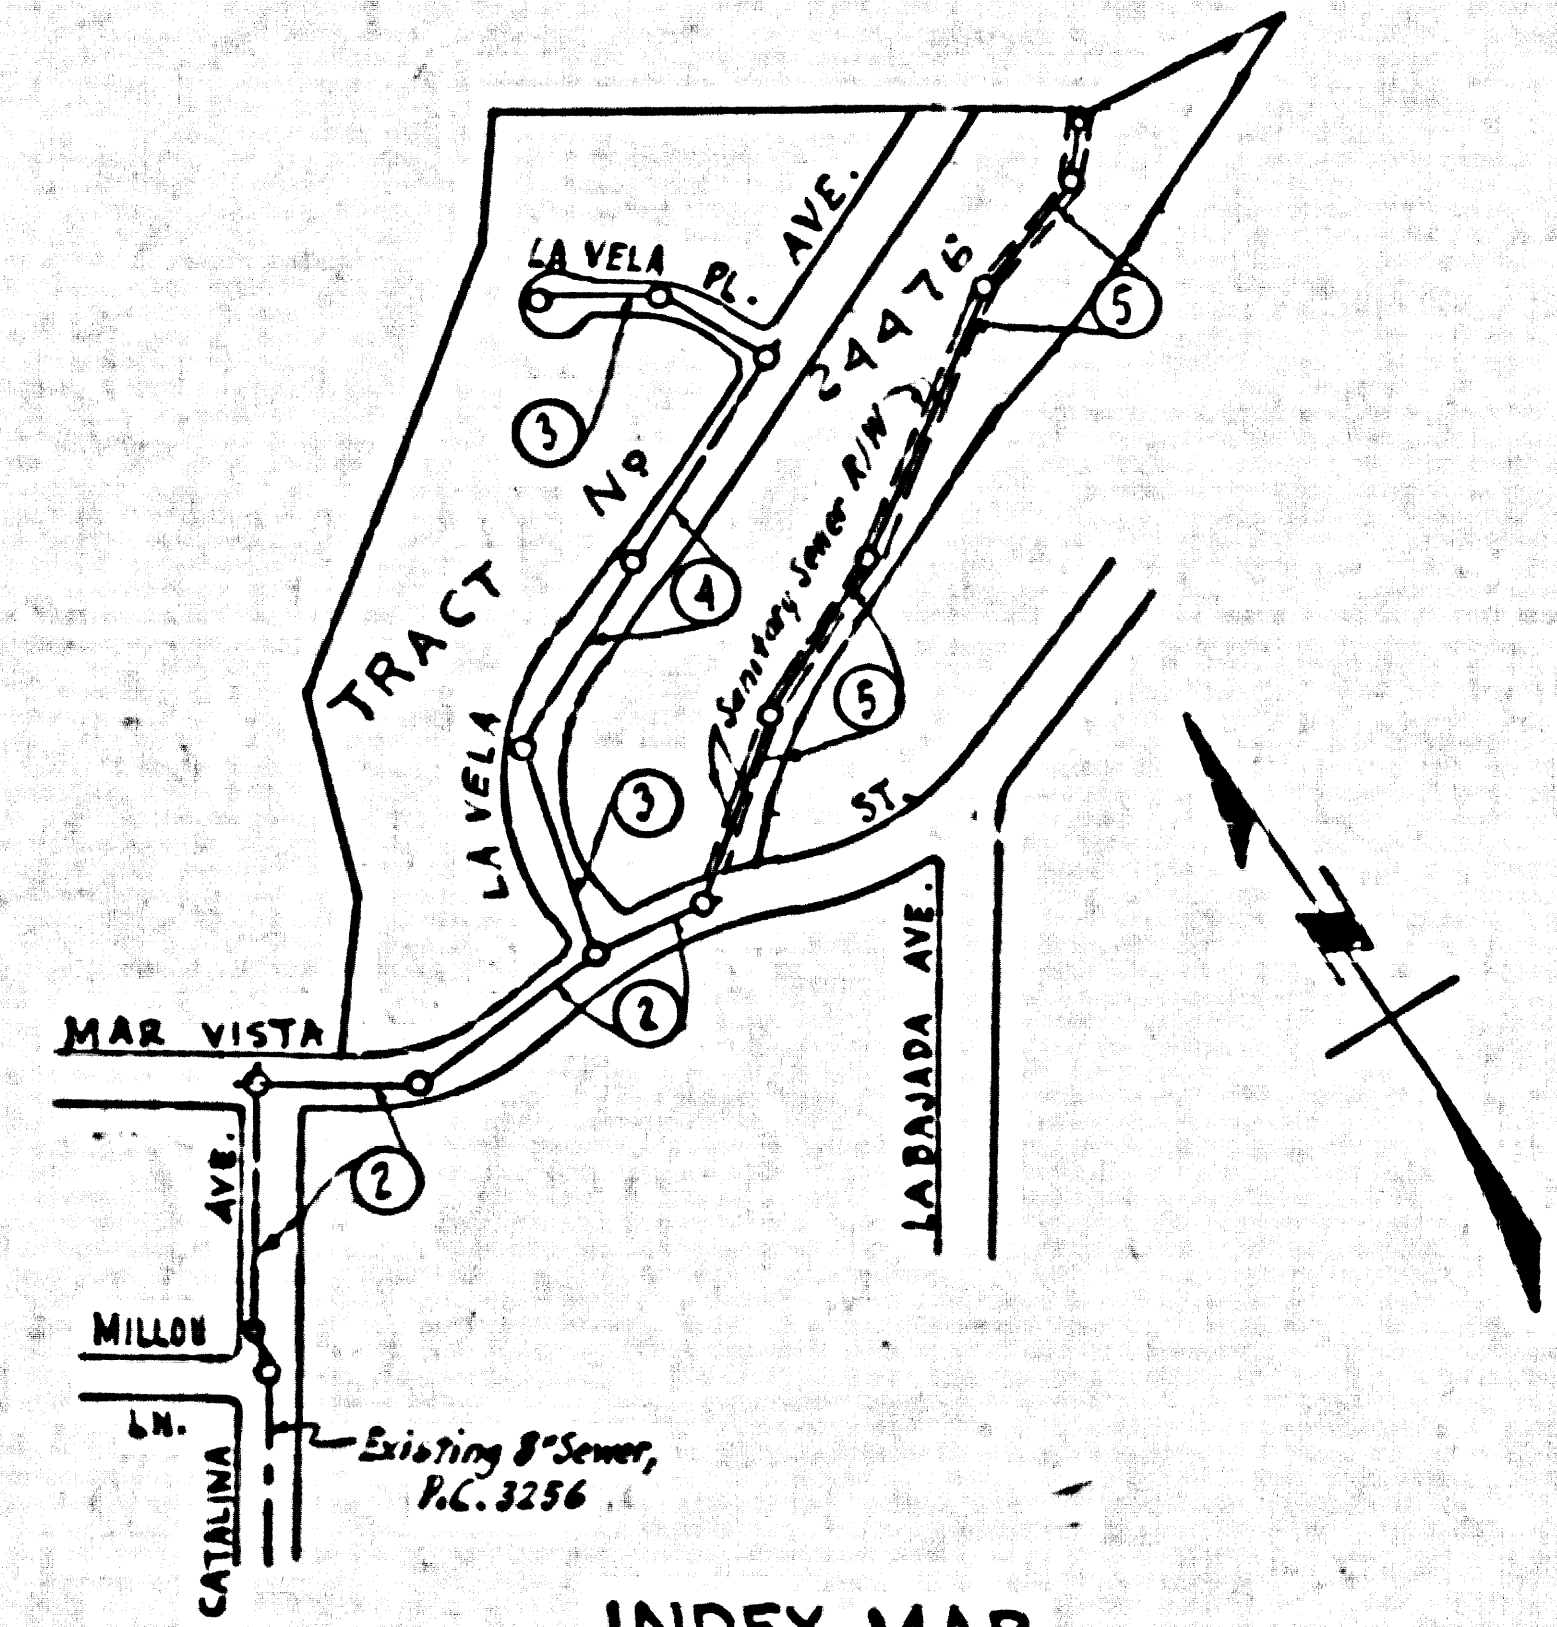

INDEX MAP
 P.C. 4971
 TRACT No 24476
 SCALE: 1"=300'

COLLECT CHARGES AS INDICATED
Carl H. Pomeroy 12-18-58


- NOTES:
1. PROVIDE STAKES ON THE PROPERTY LINE OR PROPERTY LINES PRODUCED AT RIGHT ANGLES TO THE SEWER LINE AT THE CENTER LINE OF EACH MANHOLE.
 2. NO REPRESENTATIVE OF THE COUNTY ENGINEER WILL SURVEY OR LAY OUT ANY PORTION OF THE WORK.
 3. THE OWNER OR HIS AUTHORIZED REPRESENTATIVE SHALL FURNISH THE COUNTY ENGINEER WITH GRADE SHEETS AND STATIONING FOR ALL HOUSE LATERALS AND T BRANCHES AND SHALL PROVIDE STAKES FOR THEM AT THESE PROPOSED LOCATIONS WITH STATIONING PLAINLY MARKED. ANY CHANGE IN LOCATION SHALL BE REQUESTED IN WRITING BY THE OWNER OR HIS REPRESENTATIVE.
 4. THE PRIVATE ENGINEER SHALL FURNISH THE HOUSE LATERAL DEPTH AT THE PROPERTY LINE BELOW THE TOP OF CURB ELEVATION PLUS EACH HOUSE LATERAL 1/4" IN THE GRADE SHEET.
 5. NO REVISIONS SHALL BE MADE IN THESE PLANS WITHOUT THE APPROVAL OF THE COUNTY ENGINEER.
 6. USE STANDARD MANHOLE FRAMES AND COVERS, 1-6-117, EXCEPT AS NOTED.
 7. USE STANDARD STRENGTH PIPE EXCEPT AS NOTED.
 8. USE CHAIN SHORTER OR "WEDGE-LOCK" OR "SPUR-MAIL" FOR ALL V.C.P. JOINTS PER SPEC'S, SECS. 35 & 41.
 9. RESURFACE ALL TRENCH WITHIN PAVED AREA TO MEET L.A. COUNTY ROAD DEPT. OR CALIF. STATE HIGHWAY REQUIREMENTS IN ACCORDANCE WITH PERMITS.
 10. INCASE FOUR FEET OF SEWER AT POINTS OF INTERFERENCE, WITH FOURS, CASE RE. 5-172.
 11. HOUSE LATERALS TO BE CONSTRUCTED WITH INVERTS AT PROPERTY LINE 6" FEET BELOW CURB GRADE EXCEPT AS NOTED.
 12. ALL STRUCTURES SHALL BE BRICK SEWER STRUCTURES, 5-194, EXCEPT AS NOTED.
 13. FOR ALLOWABLE LEAKAGE TEST USE FORMULA NO. 1, SPEC'S, SEC. 34.
 14. MANHOLE TOPS IN UNIMPROVED RIGHTS-OF-WAY TO BE 20 INCHES ABOVE FINISHED GRADE.
 15. THE CONTRACTOR SHALL NOTIFY THE CONSTRUCTION & FROM DRAIN DIVISION BY TELEPHONE, MADISON 5-4747, EXT. 341, AT LEAST TWENTY-FOUR HOURS BEFORE STARTING ANY WORK UNDER THIS CONTRACT.

NOTE:
 GRADES TO WHICH THIS IMPROVEMENT IS TO BE CONSTRUCTED ARE SHOWN ON PLANS AND PROFILES. GRADE POINTS FOR TOP OF CURB, CENTER LINE OF STREET, OR CENTER LINE OF ALLEYS ARE SHOWN BY C. ACTS ON PROFILES AT ALL POINTS BETWEEN MANHOLE POINTS. THE GRADE SHALL BE ESTABLISHED SO AS TO COMFORM TO A STRAIGHT LINE BETWEEN SAID DETERMINED POINTS.
 ELEVATIONS ARE IN FEET ABOVE U.S.C. & G.S. SEA LEVEL DATUM OF 1929.
 THE DRAWING AND THE DATA HEREON ARE HEREBY MADE A PART OF THE SPECIFICATIONS.
 WORK SHALL BE CONSTRUCTED ACCORDING TO SPECIFICATIONS ON FILE IN THE OFFICE OF THE COUNTY ENGINEER AND SHALL BE PROSECUTED ONLY IN THE PRESENCE OF THE COUNTY ENGINEER.
 BEFORE WORK CAN BE STARTED, THE CONTRACTOR MUST OBTAIN A PERMIT TO EXCAVATE IN COUNTY STREETS FROM THE L.A. COUNTY ROAD DEPT., DISTRICT OFFICE NO. 4, AND MAKE A DEPOSIT WITH THE COUNTY ENGINEER FROM THE AMERICAN BURNING OIL CO. ROADWAY SURVEY TO COVER THE COST OF CONSTRUCTION INSPECTION AND RECORD PLANS.
 APPROVAL OF THIS PLAN BY THE COUNTY OF LOS ANGELES DOES NOT CONSTITUTE A REPRESENTATION AS TO THE ACCURACY OF THE LOCATION OF OR THE EXISTENCE OR NON-EXISTENCE OF ANY UNDERGROUND UTILITY PIPE, OR STRUCTURE WITHIN THE LIMITS OF THIS PROJECT. THIS NOTE APPLIES TO ALL PAGES.
 IF WORK IS TO BE DONE IN A STATE HIGHWAY, A PERMIT MUST BE OBTAINED FROM THE STATE OF CALIFORNIA, DIVISION OF HIGHWAYS, 128 SOUTH BRIDGE STREET.

COUNTY OF LOS ANGELES, CALIFORNIA

APPROVED, JOHN A. LAMBE, COUNTY ENGINEER
 APPROVED, *Carl H. Pomeroy*, CHIEF ENGINEER
 BY *Carl H. Pomeroy*, SANITATION ENGINEER
 CHECKED BY *Carl H. Pomeroy*
 OFFICE OF COUNTY ENGINEER, REG. C. E. NO. 2226
 Approved By *John L. Pomeroy*, Industrial Waste Division
 SUBMITTED BY: *John L. Pomeroy*, REG. REGIONAL ENGINEER, R.C.E. NO. 3871

REVISED: 2-6-59 SEWER IN CATALINA AVE., PAGE 2, MOVED FROM 23 FEET EAST OF CENTERLINE TO 5 FEET WEST OF CENTERLINE. SEWER IN MARVISTA ST. EXTENDED 28.36 FEET WESTERLY.
 APPROVED: *Carl H. Pomeroy 2-6-59*
 OFFICE OF COUNTY ENGINEER, R.C.E. NO. 2226

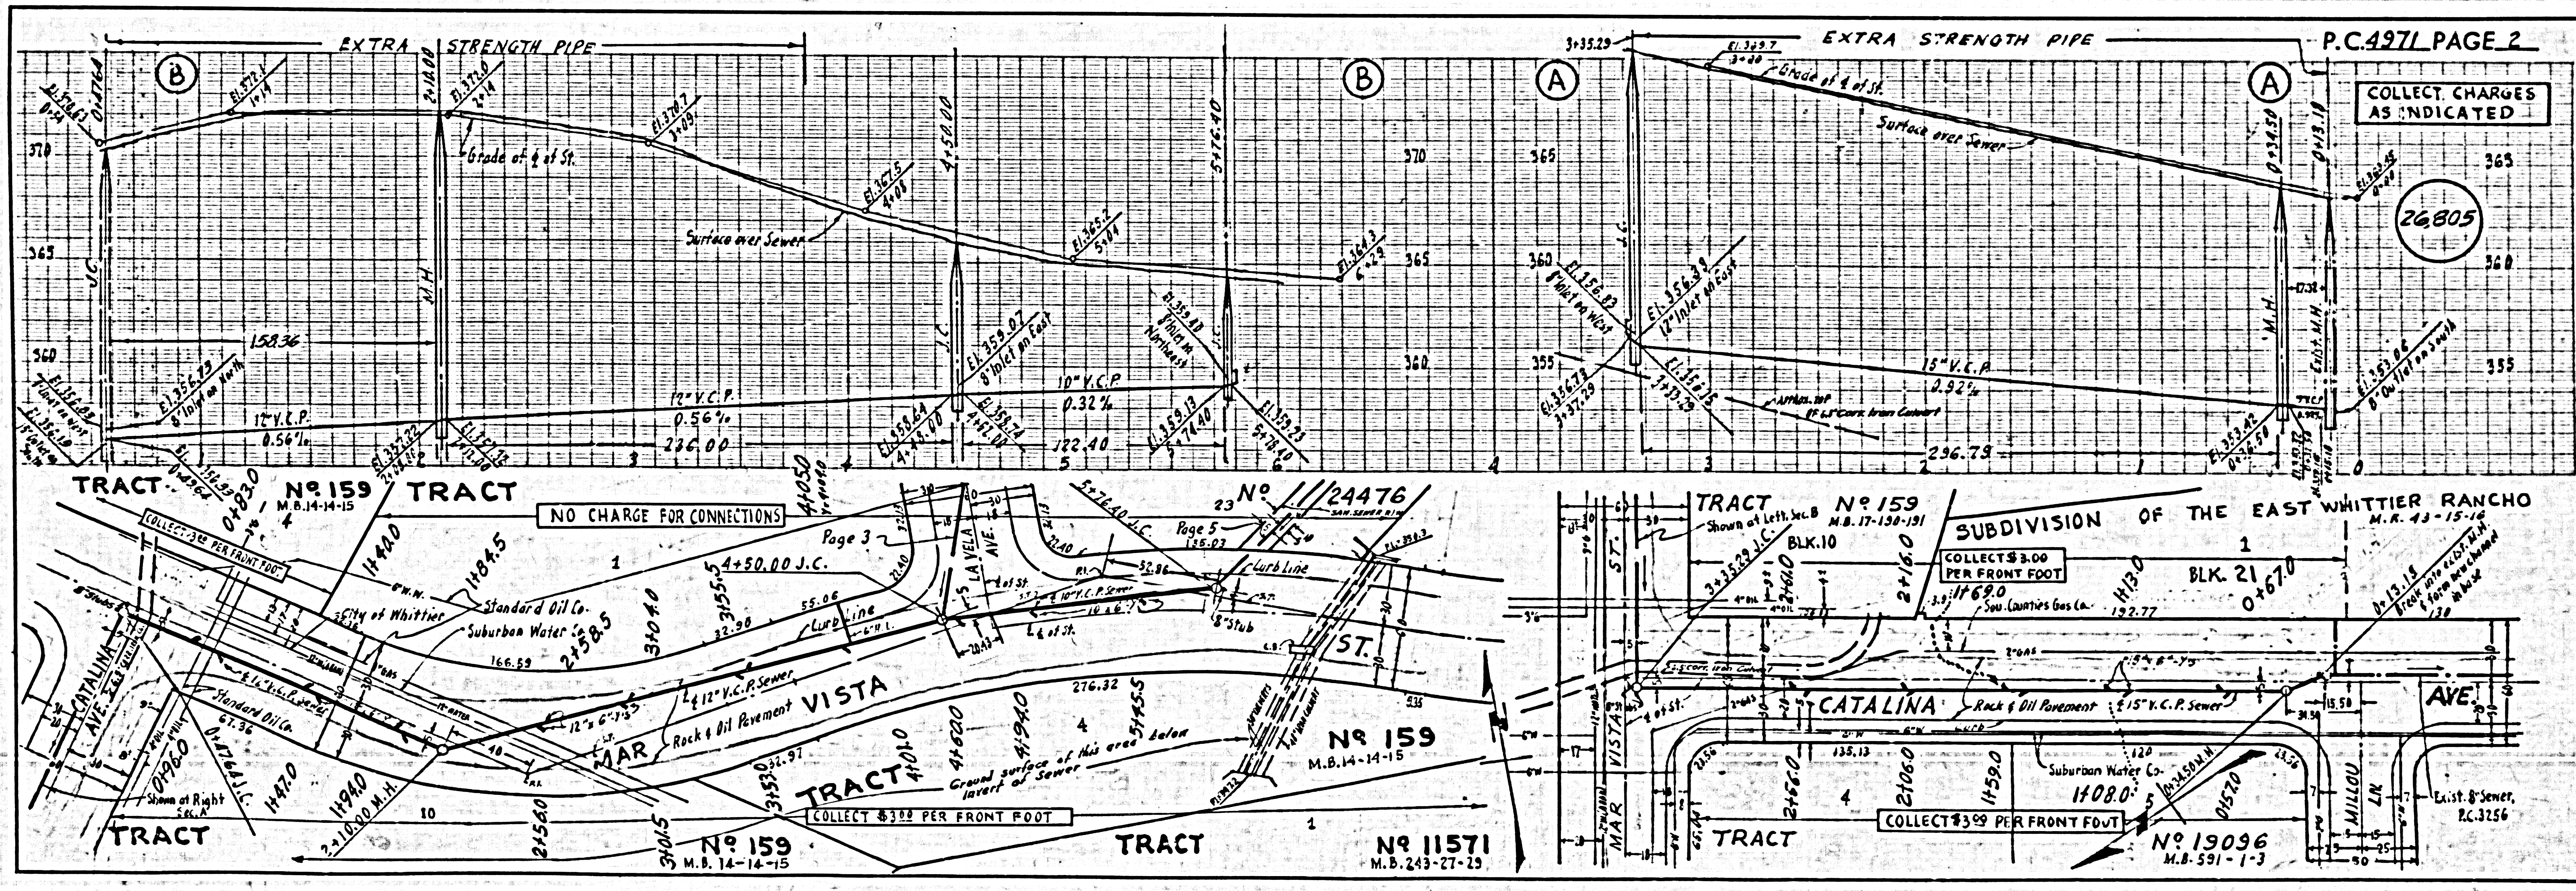

P.C. 4971 PAGE 2

COLLECT CHARGES AS INDICATED
 (26805)

TRACT No 159 M.B. 14-14-15
 TRACT No 24476 M.B. 14-14-15
 TRACT No 159 M.B. 14-14-15
 TRACT No 11571 M.B. 243-27-29
 TRACT No 19096 M.B. 591-1-3
 SUBDIVISION OF THE EAST WHITTIER RANCHO M.R. 43-15-16
 COLLECT \$3.00 PER FRONT FOOT
 COLLECT \$3.00 PER FRONT FOOT
 COLLECT \$3.00 PER FRONT FOOT
 NO CHARGE FOR CONNECTIONS
 Standard Oil Co. Suburban Water
 Rock & Oil Pavement
 15" V.C.P. Sewer
 12" V.C.P. Sewer
 10" V.C.P. Sewer
 8" V.C.P. Sewer
 6" V.C.P. Sewer
 4" V.C.P. Sewer
 3" V.C.P. Sewer
 2" V.C.P. Sewer
 1" V.C.P. Sewer
 1/2" V.C.P. Sewer
 1/4" V.C.P. Sewer
 1/8" V.C.P. Sewer
 1/17592186444416" V.C.P. Sewer
 1/35184372888832" V.C.P. Sewer
 1/70368745777664" V.C.P. Sewer
 1/140737491555328" V.C.P. Sewer
 1/281474983110656" V.C.P. Sewer
 1/562949966221312" V.C.P. Sewer
 1/112589993242624" V.C.P. Sewer
 1/225179986485248" V.C.P. Sewer
 1/450359972970496" V.C.P. Sewer
 1/900719945940992" V.C.P. Sewer
 1/1801439891881984" V.C.P. Sewer
 1/3602879783763968" V.C.P. Sewer
 1/7205759567527936" V.C.P. Sewer
 1/14411519135054784" V.C.P. Sewer
 1/28823038270109568" V.C.P. Sewer
 1/57646076540219136" V.C.P. Sewer
 1/11529215308043824" V.C.P. Sewer
 1/23058430616087648" V.C.P. Sewer
 1/46116861232175296" V.C.P. Sewer
 1/92233722464350592" V.C.P. Sewer
 1/188894637606990012416" V.C.P. Sewer
 1/377789275213980024832" V.C.P. Sewer
 1/755578550427960049664" V.C.P. Sewer
 1/151115710085590099328" V.C.P. Sewer
 1/302231420171180198656" V.C.P. Sewer
 1/604462840342360397312" V.C.P. Sewer
 1/1208925680684720794624" V.C.P. Sewer
 1/2417851361369441589248" V.C.P. Sewer
 1/4835702722738883178496" V.C.P. Sewer
 1/9671405445477766356992" V.C.P. Sewer
 1/19342810890955532713984" V.C.P. Sewer
 1/386856217819510654279808" V.C.P. Sewer
 1/773712435639021308559616" V.C.P. Sewer
 1/1547424871278042617119232" V.C.P. Sewer
 1/3094849742576085234238464" V.C.P. Sewer
 1/6189699485152170468477216" V.C.P. Sewer
 1/1237939897030434093754432" V.C.P. Sewer
 1/2475879794060868187500864" V.C.P. Sewer
 1/495175958812173637001728" V.C.P. Sewer
 1/990351917624347274003456" V.C.P. Sewer
 1/1980703835248695488006912" V.C.P. Sewer
 1/3961407670497390976013824" V.C.P. Sewer
 1/7922815340994781952027648" V.C.P. Sewer
 1/1584563068198956384005296" V.C.P. Sewer
 1/3169126136397912768010592" V.C.P. Sewer
 1/6338252272795825536021184" V.C.P. Sewer
 1/12676504545591651072043776" V.C.P. Sewer
 1/25353009091183421440087552" V.C.P. Sewer
 1/50706018182366842880175104" V.C.P. Sewer
 1/101412036364733685760350208" V.C.P. Sewer
 1/202824072729467371520700416" V.C.P. Sewer
 1/405648145458934743040140832" V.C.P. Sewer
 1/811296290917869486080281664" V.C.P. Sewer
 1/1622592581837738972160563328" V.C.P. Sewer
 1/3245185163675477944321126656" V.C.P. Sewer
 1/649037032735095588864225312" V.C.P. Sewer
 1/1298074065470191177728450624" V.C.P. Sewer
 1/2596148130940383354456901248" V.C.P. Sewer
 1/5192296261880776708913782496" V.C.P. Sewer
 1/10384592527661553417827564992" V.C.P. Sewer
 1/20769185055323106835355329984" V.C.P. Sewer
 1/41538370110646213670710659968" V.C.P. Sewer
 1/830767402212924273414211919936" V.C.P. Sewer
 1/166153480425184854682843739872" V.C.P. Sewer
 1/332306960850369709365687479744" V.C.P. Sewer
 1/664613921700739418731374959488" V.C.P. Sewer
 1/1329227843401478837462749918976" V.C.P. Sewer
 1/2658455686802957674925499837952" V.C.P. Sewer
 1/5316911373605915349850999675904" V.C.P. Sewer
 1/10633822747211830699701999351808" V.C.P. Sewer
 1/212676454944236613999403998703616" V.C.P. Sewer
 1/425352909888473227998807997407232" V.C.P. Sewer
 1/850705819776946455997615994814464" V.C.P. Sewer
 1/1701411639553892911995231993628928" V.C.P. Sewer
 1/340282327910778582399046398725776" V.C.P. Sewer
 1/680564655821557164798092797451552" V.C.P. Sewer
 1/136112931164311429597618559490304" V.C.P. Sewer
 1/2722258623286228591952371189806016" V.C.P. Sewer
 1/544451724657245718390474357936032" V.C.P. Sewer
 1/1088903449314491367800948755872064" V.C.P. Sewer
 1/2177806898628982735601897511744128" V.C.P. Sewer
 1/4355613797257965471203795023488256" V.C.P. Sewer
 1/871122759451593094240759004696512" V.C.P. Sewer
 1/17422451989031861884801518091393024" V.C.P. Sewer
 1/3484490397806372376960303618386048" V.C.P. Sewer
 1/6968980795612744753920607236772096" V.C.P. Sewer
 1/1393796159122489506784121447544192" V.C.P. Sewer
 1/2787592318244979013568242895088384" V.C.P. Sewer
 1/5575184636489958027136484790176768" V.C.P. Sewer
 1/11150369272979916054271296838353536" V.C.P. Sewer
 1/223007385459598321085425816766707072" V.C.P. Sewer
 1/44601477091919664217085163533414144" V.C.P. Sewer
 1/89202954183839328434170327066828288" V.C.P. Sewer
 1/178405908367678656868340654133656576" V.C.P. Sewer
 1/3568118167353573137366801082873131152" V.C.P. Sewer
 1/71362363347071462747333621657462262304" V.C.P. Sewer
 1/142724726744142924949466433149244448" V.C.P. Sewer
 1/285449453488285849898932866298888896" V.C.P. Sewer
 1/570898906976571697977857332597777792" V.C.P. Sewer
 1/114179781395314339595571465195555544" V.C.P. Sewer
 1/228359562790628679191142831191111088" V.C.P. Sewer
 1/4567191255812573583822856623822221776" V.C.P. Sewer
 1/9134382511625147167645532447644443552" V.C.P. Sewer
 1/18268765023250294335289064955288887104" V.C.P. Sewer
 1/36537530046500588670578130110577774208" V.C.P. Sewer
 1/7307506009300117734115626022115555441632" V.C.P. Sewer
 1/14615012018600234668223252044211110864" V.C.P. Sewer
 1/2923002403720046933644650408842222217128" V.C.P. Sewer
 1/5846004807440093867289300817684444434256" V.C.P. Sewer
 1/11692009614880197734577601635368888684512" V.C.P. Sewer
 1/233840192297603944691554327067777736896" V.C.P. Sewer
 1/46768038459520788938311086541355555437792" V.C.P. Sewer
 1/93536076919041577876622173088671111075536" V.C.P. Sewer
 1/1870721538380831557532442561731111014112" V.C.P. Sewer
 1/374144307676166311510648851362222222222224" V.C.P. Sewer
 1/74828861535233262201297770272444444444448" V.C.P. Sewer
 1/14965772306466524402595540444888888888896" V.C.P. Sewer
 1/29931544612933104805191108889777777777792" V.C.P. Sewer
 1/59863089225666209610382217777777777777796" V.C.P. Sewer
 1/11972617845132441822076435555555555555392" V.C.P. Sewer
 1/239452356902648836441511111111111111111784" V.C.P. Sewer
 1/478904713805297672883022222222222222223568" V.C.P. Sewer
 1/95780942761059534576644444444444444447136" V.C.P. Sewer
 1/1915618553221191091532888888888888888828272" V.C.P. Sewer
 1/3831237106443821823065677777777777777756544" V.C.P. Sewer
 1/7662474212887643646131355555555555555113088" V.C.P. Sewer
 1/153249484257752872922626711111111111111226176" V.C.P. Sewer
 1/306498968515504557845253422222222222222452352" V.C.P. Sewer
 1/61299793703009111568850684444444444444904704" V.C.P. Sewer
 1/1225995874060182233777013688888888888881809408" V.C.P. Sewer
 1/245199174812036446755402737777777777777361807808" V.C.P. Sewer
 1/490398349624072893508054467555555555555723536161567616" V.C.P. Sewer
 1/9807966992481457870161095111111111111114470713313312" V.C.P. Sewer
 1/19615933984962915403220182022222222222228940426626624" V.C.P. Sewer
 1/392318679699258308064403640444444444444178808853253248" V.C.P. Sewer
 1/784637359398516616012888080808080808083576177065065968" V.C.P. Sewer
 1/15692747179770332202561616161616161616715234413113112" V.C.P. Sewer
 1/313854943595406644051232323232323232321430688262262248" V.C.P. Sewer
 1/62770988719081332810246464646464646464286137152452496" V.C.P. Sewer
 1/125541977438162656204929292929292929257227430491392" V.C.P. Sewer
 1/2510839548763253124098585858585858585811444480808784" V.C.P. Sewer
 1/5021679097526506248197171717171717171722889616161616" V.C.P. Sewer
 1/10043358195053012495943434343434343434457792323232" V.C.P. Sewer
 1/20086716390106024991886868686868686868915546464646" V.C.P. Sewer
 1/40173432780212049973737373737373737373830911309113" V.C.P. Sewer
 1/8034686556042409994747474747474747474766182226182226" V.C.P. Sewer
 1/16069373112084819989494949494949494993223636363636" V.C.P. Sewer
 1/321387462241696399789898989898989899664547645476" V.C.P. Sewer
 1/6427749244833927995797979797979797993271151151151" V.C.P. Sewer
 1/1285549849666785599159595959595959598544223022302230" V.C.P. Sewer
 1/257109969933357119831919191919191919708884444444444" V.C.P. Sewer
 1/514219939866714356638383838383838381417768888888888" V.C.P. Sewer
 1/102843979773342871372767676767676767283553776767676" V.C.P. Sewer
 1/20568795954668574254531531531531531567110711071107" V.C.P. Sewer
 1/411375919093371490906262626262626261342214221422142" V.C.P. Sewer
 1/82275183818674298181251251251251251268442844284428" V.C.P. Sewer
 1/164550367373485963625025025025025025368885656565656" V.C.P. Sewer
 1/32910073474697192725005005005005005073777113777113" V.C.P. Sewer
 1/6582014694939438545001000100010001001475542266666666" V.C.P. Sewer
 1/13164029389798770900020002000200020029510885333333333" V.C.P. Sewer
 1/263280587795975418000400040004000400590217766666666" V.C.P. Sewer
 1/526561175591950836000800080008000801180435533333333" V.C.P. Sewer
 1/10531223519239017200016001600160016002360871066666666" V.C.P. Sewer
 1/21062447038478034400032003200320032004721742133333333" V.C.P. Sewer
 1/421248940769560688000640064006400640094434846666666" V.C.P. Sewer
 1/8424978815391213760001280128012801280188868866666666" V.C.P. Sewer
 1/1684995723082427520002560256025602560377337733333333" V.C.P. Sewer
 1/3369991446164455040005120512051205120754675466666666" V.C.P. Sewer
 1/67399828923289100800010241024102410241509350933333333" V.C.P. Sewer