
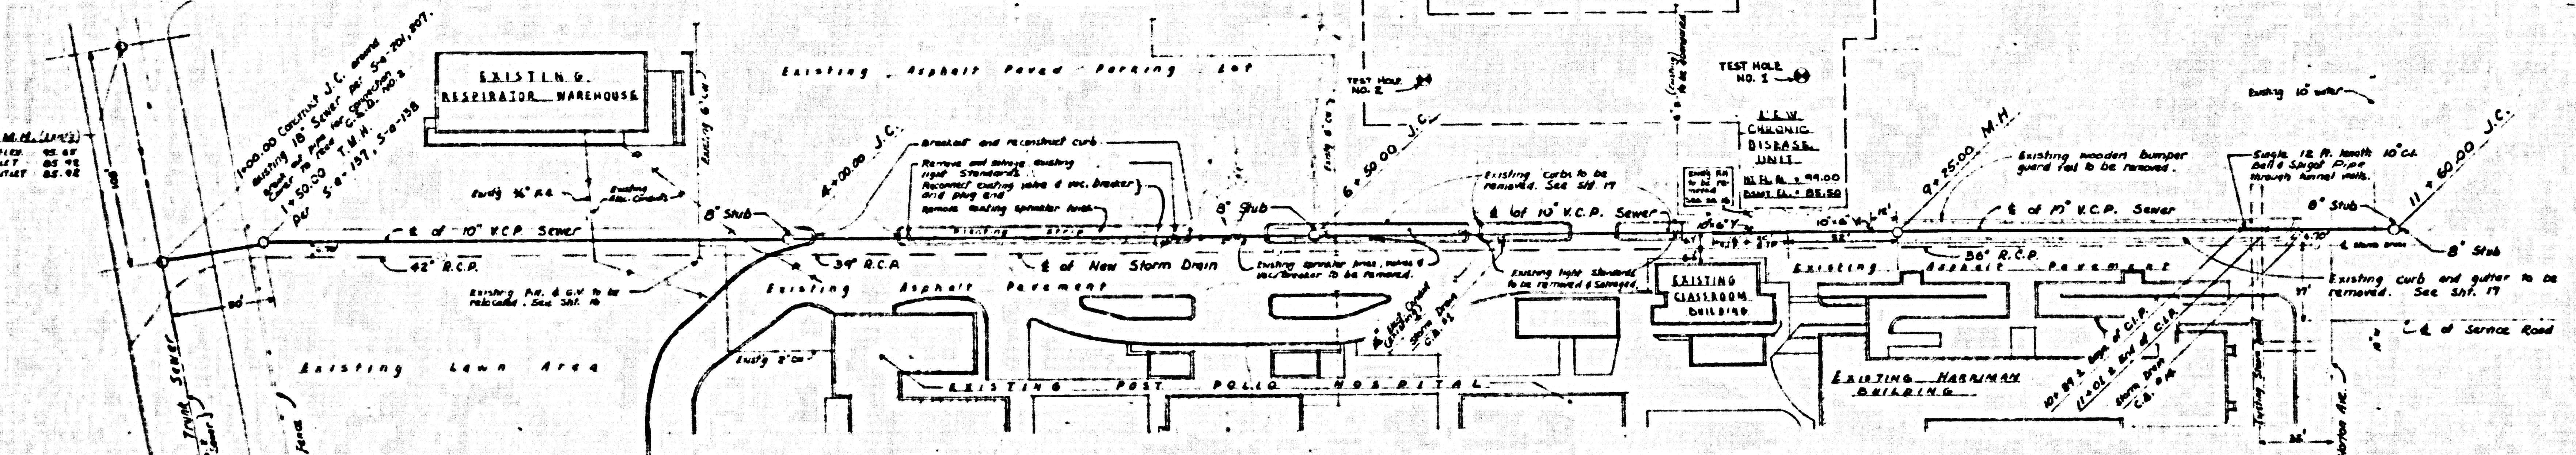


DM # 4 S.E. corner of Ambulance loading dock on East side of Herriman Bldg. L.A.C.O. Bldg # 1180 Brass cap Elevation 99.16 LB 471-35

NOTE:
All elevations are based on Rancho Los Amigos Local Datum.

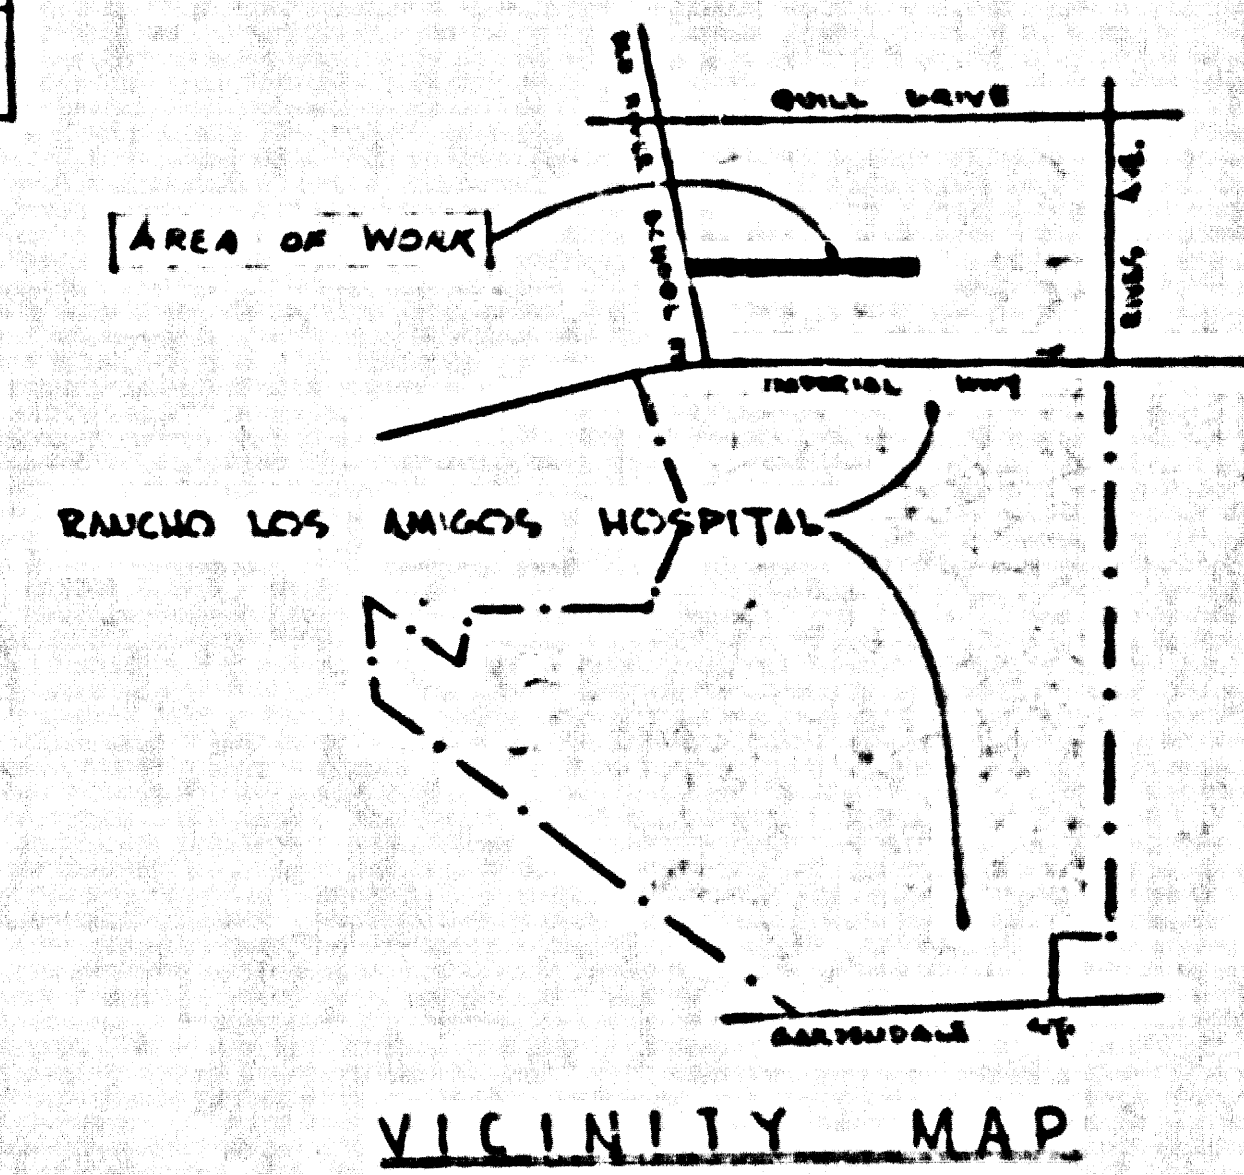

TEST HOLE DATA

NO.	HOLE NO. I	HOLE NO. R
1	1	1
2	2	2
3	3	3
4	4	4
5	5	5
6	6	6
7	7	7
8	8	8
9	9	9
10	10	10
11	11	11
12	12	12

- DOWNEY BUILDING DISTRICT NO. 4.1**
TITLE NOTES
- Use standard manhole frames and covers, S-a-117, except as noted.
 - Use standard strength pipe except as noted.
 - Use standard joints for all vitrified Clay Pipe per specs., Secs. 36 & 38.
 - Resurface all trench within paved area of Old River School Road to meet the City of Downey Road Dept. requirements in accordance with permits.
 - All structures shall be brick sewer structures, S-a-104, except as noted.
 - For allowable leakage test, use Formula No. 1 Specs., Sec. 54.
 - The contractor shall notify the Design Division by telephone, Madison 4-4747, extension 362, at least 24 hours before starting any work under this contract.
 - Sewer to be constructed prior to the Storm Drain catch basins.
 - Restore all damaged surface areas to their original conditions, including lawns, pavements, curbs, etc.

- SOIL INVESTIGATION DATA**
- No ground water encountered or anticipated in future years.
 - No rock and no probability of quicksand.
 - No nearby bodies of water.
 - No probabilities of freshets.
 - No frost effects.
 - Soil does not contain alkali in sufficient quantity to affect concrete foundations.
 - No mines or old workings in vicinity.
 - Site is not subject to adverse mineral rights.

Before breaking into any existing structure and before final acceptance of this work, County Sanitation Division should be notified in order that required inspection may be made.

P.C. NO. 5399

SUBMITTED: *Walter Slavin* DRAWING ENGINEER
 APPROVED: *Walter Slavin* SANITATION ENGINEER

C. R. COMPTON
 CHIEF ENGINEER OF COUNTY SANITATION DISTRICT NO. 3
 BY: *Walter Slavin* OFFICE ENGINEER


SYMBOLS & ABBREVIATIONS	
Water (Surface, etc.)	Sanitary Sewer
Fire (existing)	Cold Water
Electric Conduit (new)	Gas (Pipe)
C.V. Cold Water	R.O.C. Point of Connection
Conduit	R.P. Return
Elevation	R.C.R. Running Concrete Pipe
Fire Hydrant	SSM Sewer Manhole
Future Unit	SAY Snap Off Valve
Gas (Fuel)	Sup. Supply
Gate Valve	V.C.P. Vitrified Clay Pipe
N.S.W. Hot Soft Water	Y.B. Yard Box
J.C. Junction Chamber	ENC. ENCLOSURE
M.H. Manhole	TRM Trip Manhole
A.S. Air Sign	

APPROVALS


Walter Slavin 12/31/59
 SUPERINTENDENT OF CHARITIES DATE

Walter Slavin
 DIRECTOR, RANCHO LOS AMIGOS HOSPITAL DATE

DEPARTMENT OF THE COUNTY ENGINEER ARCHITECTURAL DIVISION COUNTY OF LOS ANGELES	DATE: SEPT. 22, 1959 JOB NO. 276 DRAWN BY: [Signature] CHECKED BY: [Signature] AS BUILT CONNECTIONS	SANITARY SEWER SITE PLAN & PROFILE CHRONIC DISEASE UNIT RANCHO LOS AMIGOS HOSPITAL 7601 EAST IMPERIAL HWY. DOWNEY, CALIF.	SPEC. NO. 5092 OF 1959 DATE: 12/31/59 JOB NO. 276 JOB NO. 276 JOB NO. 276
--	---	---	---

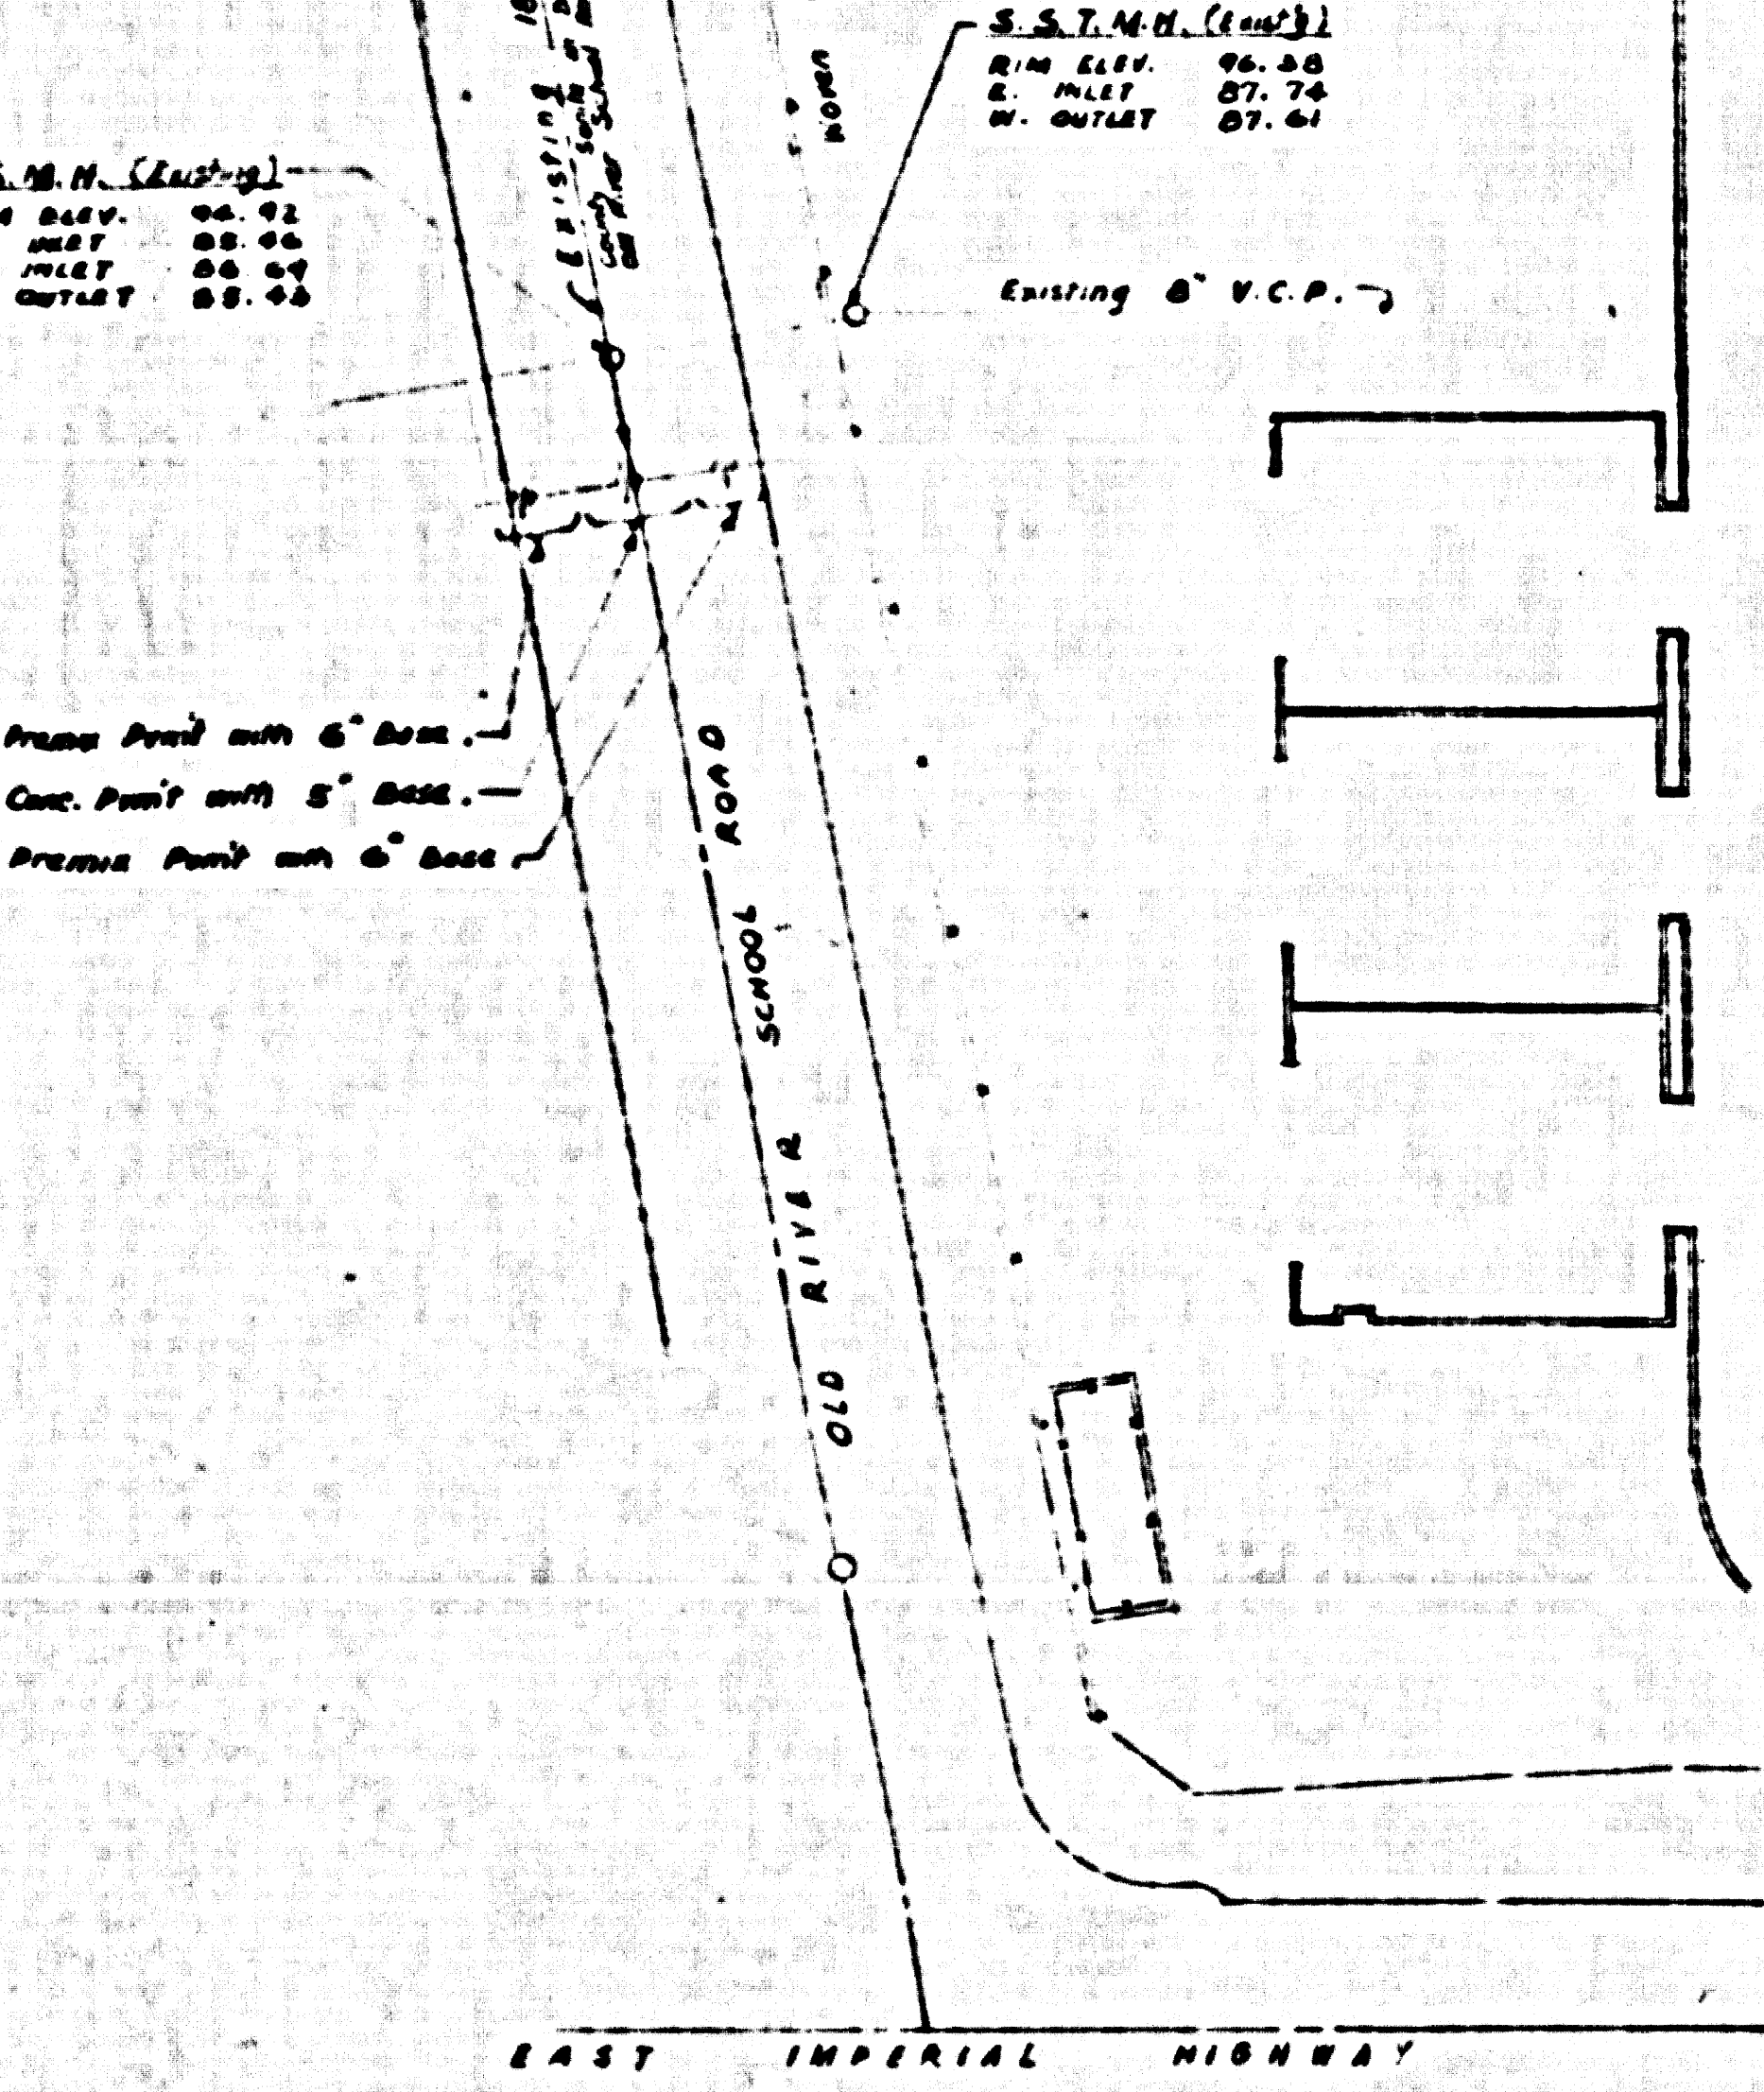


SANITARY SEWER SITE PLAN
SCALE: 1" = 50'-0"

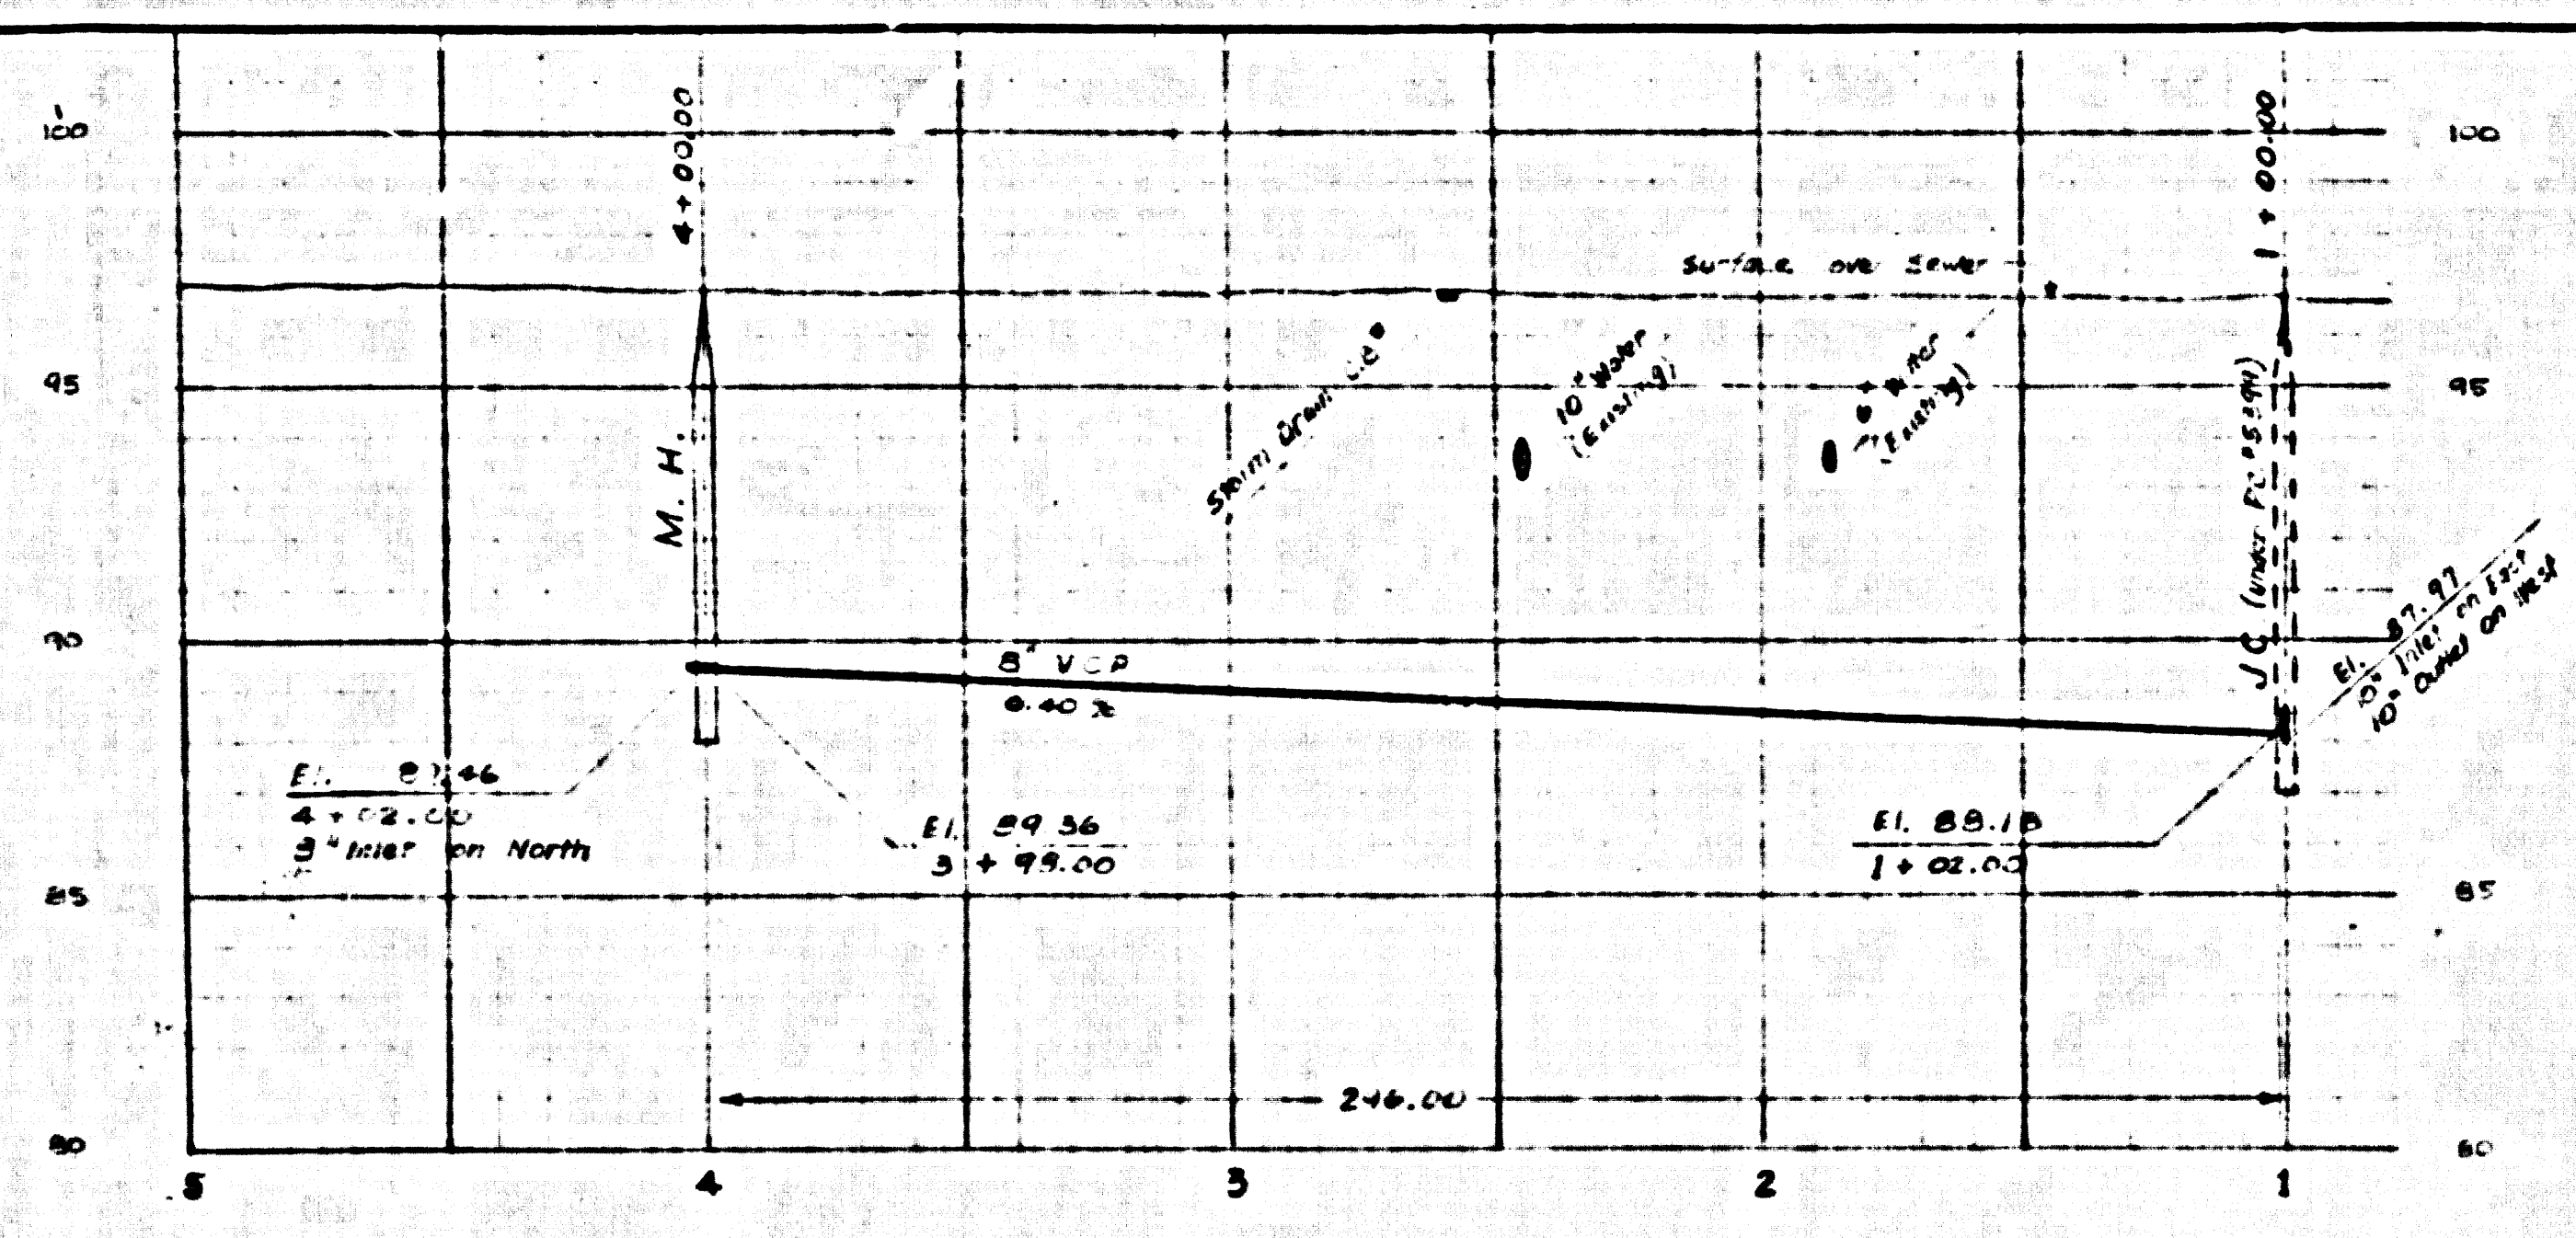

SANITARY SEWER PROFILE

SCALE: VERTICAL 1" = 4'-0"
HORIZONTAL 1" = 40'-0"

BM #4 S.P. CORNER OF AMBULANCE
LOADING DOCK ON EAST SIDE OF
HARRIMAN BLDG. L.A. CO.
ELEV. 88.1100 GRADE LAP
ELEV. 88.1200 L.S. 671 = 88

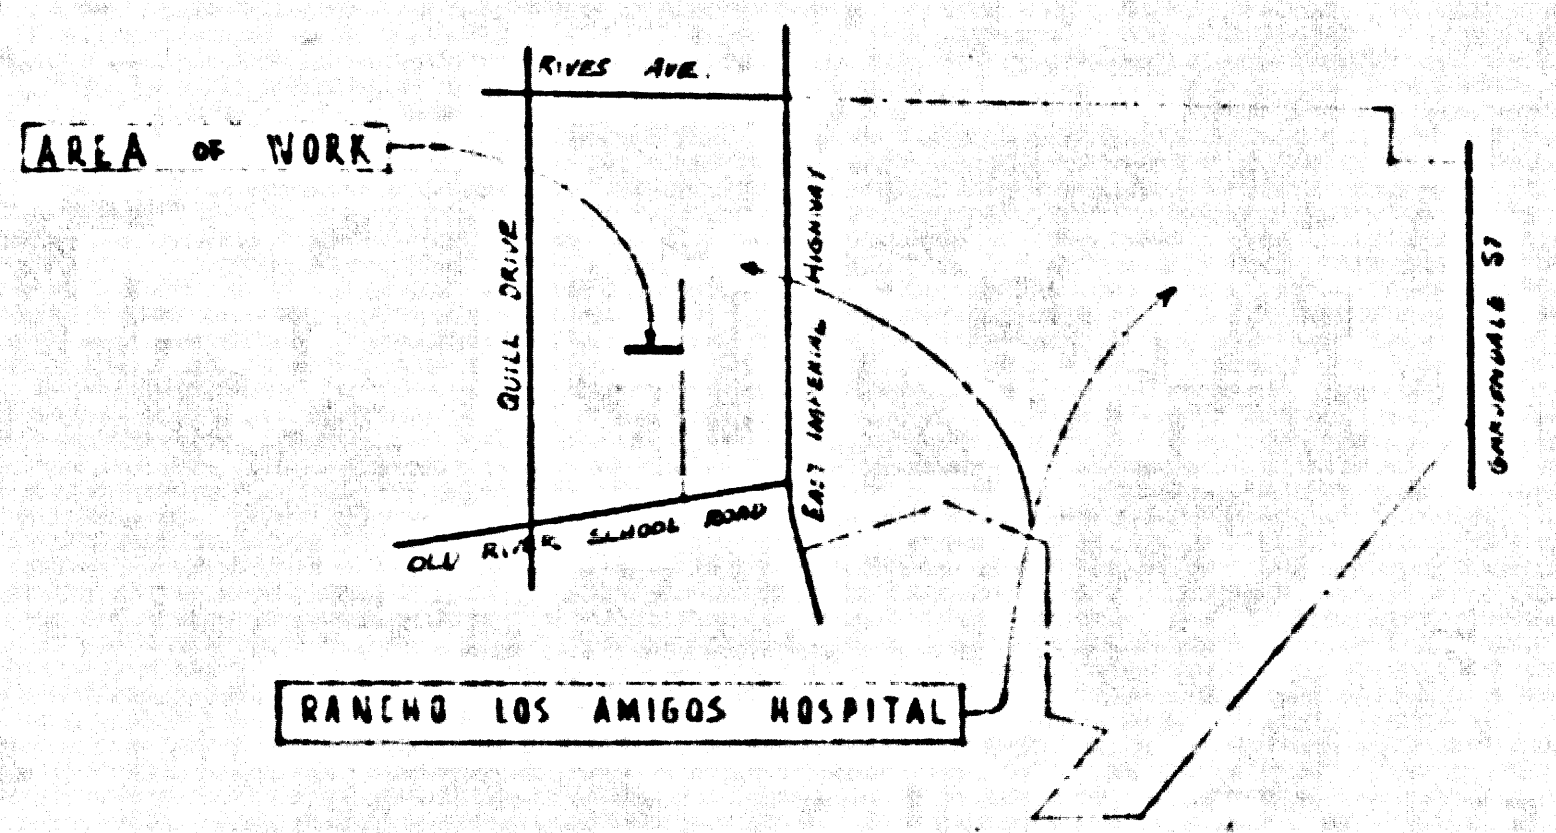

VICINITY MAP


NOT TO SCALE

DOWNNEY BUILDING DISTRICT NO. 4.1

TITLE NOTES

1. Use standard manhole frame and cover - S-a-117.
2. Use standard strength pipe.
3. Use Plastisol Joints for all Vitrified Clay Pipe per Specs., sections 36 & 40.
4. All structures shall be brick sewer structures, S-a-104.
5. For allowable leakage test, use Formula No. 1, Specs. Section 54.
6. The contractor shall notify the Construction Division by telephone, Madison 9-4747 Extension 81551, at least 24 hours before starting any work under this contract.
7. Restore all damaged surface areas to their original conditions, including lawns, pavements, walks, etc.

Before breaking into any existing structure and before final acceptance of this work, County Sanitation District should be notified in order that required inspection may be made.

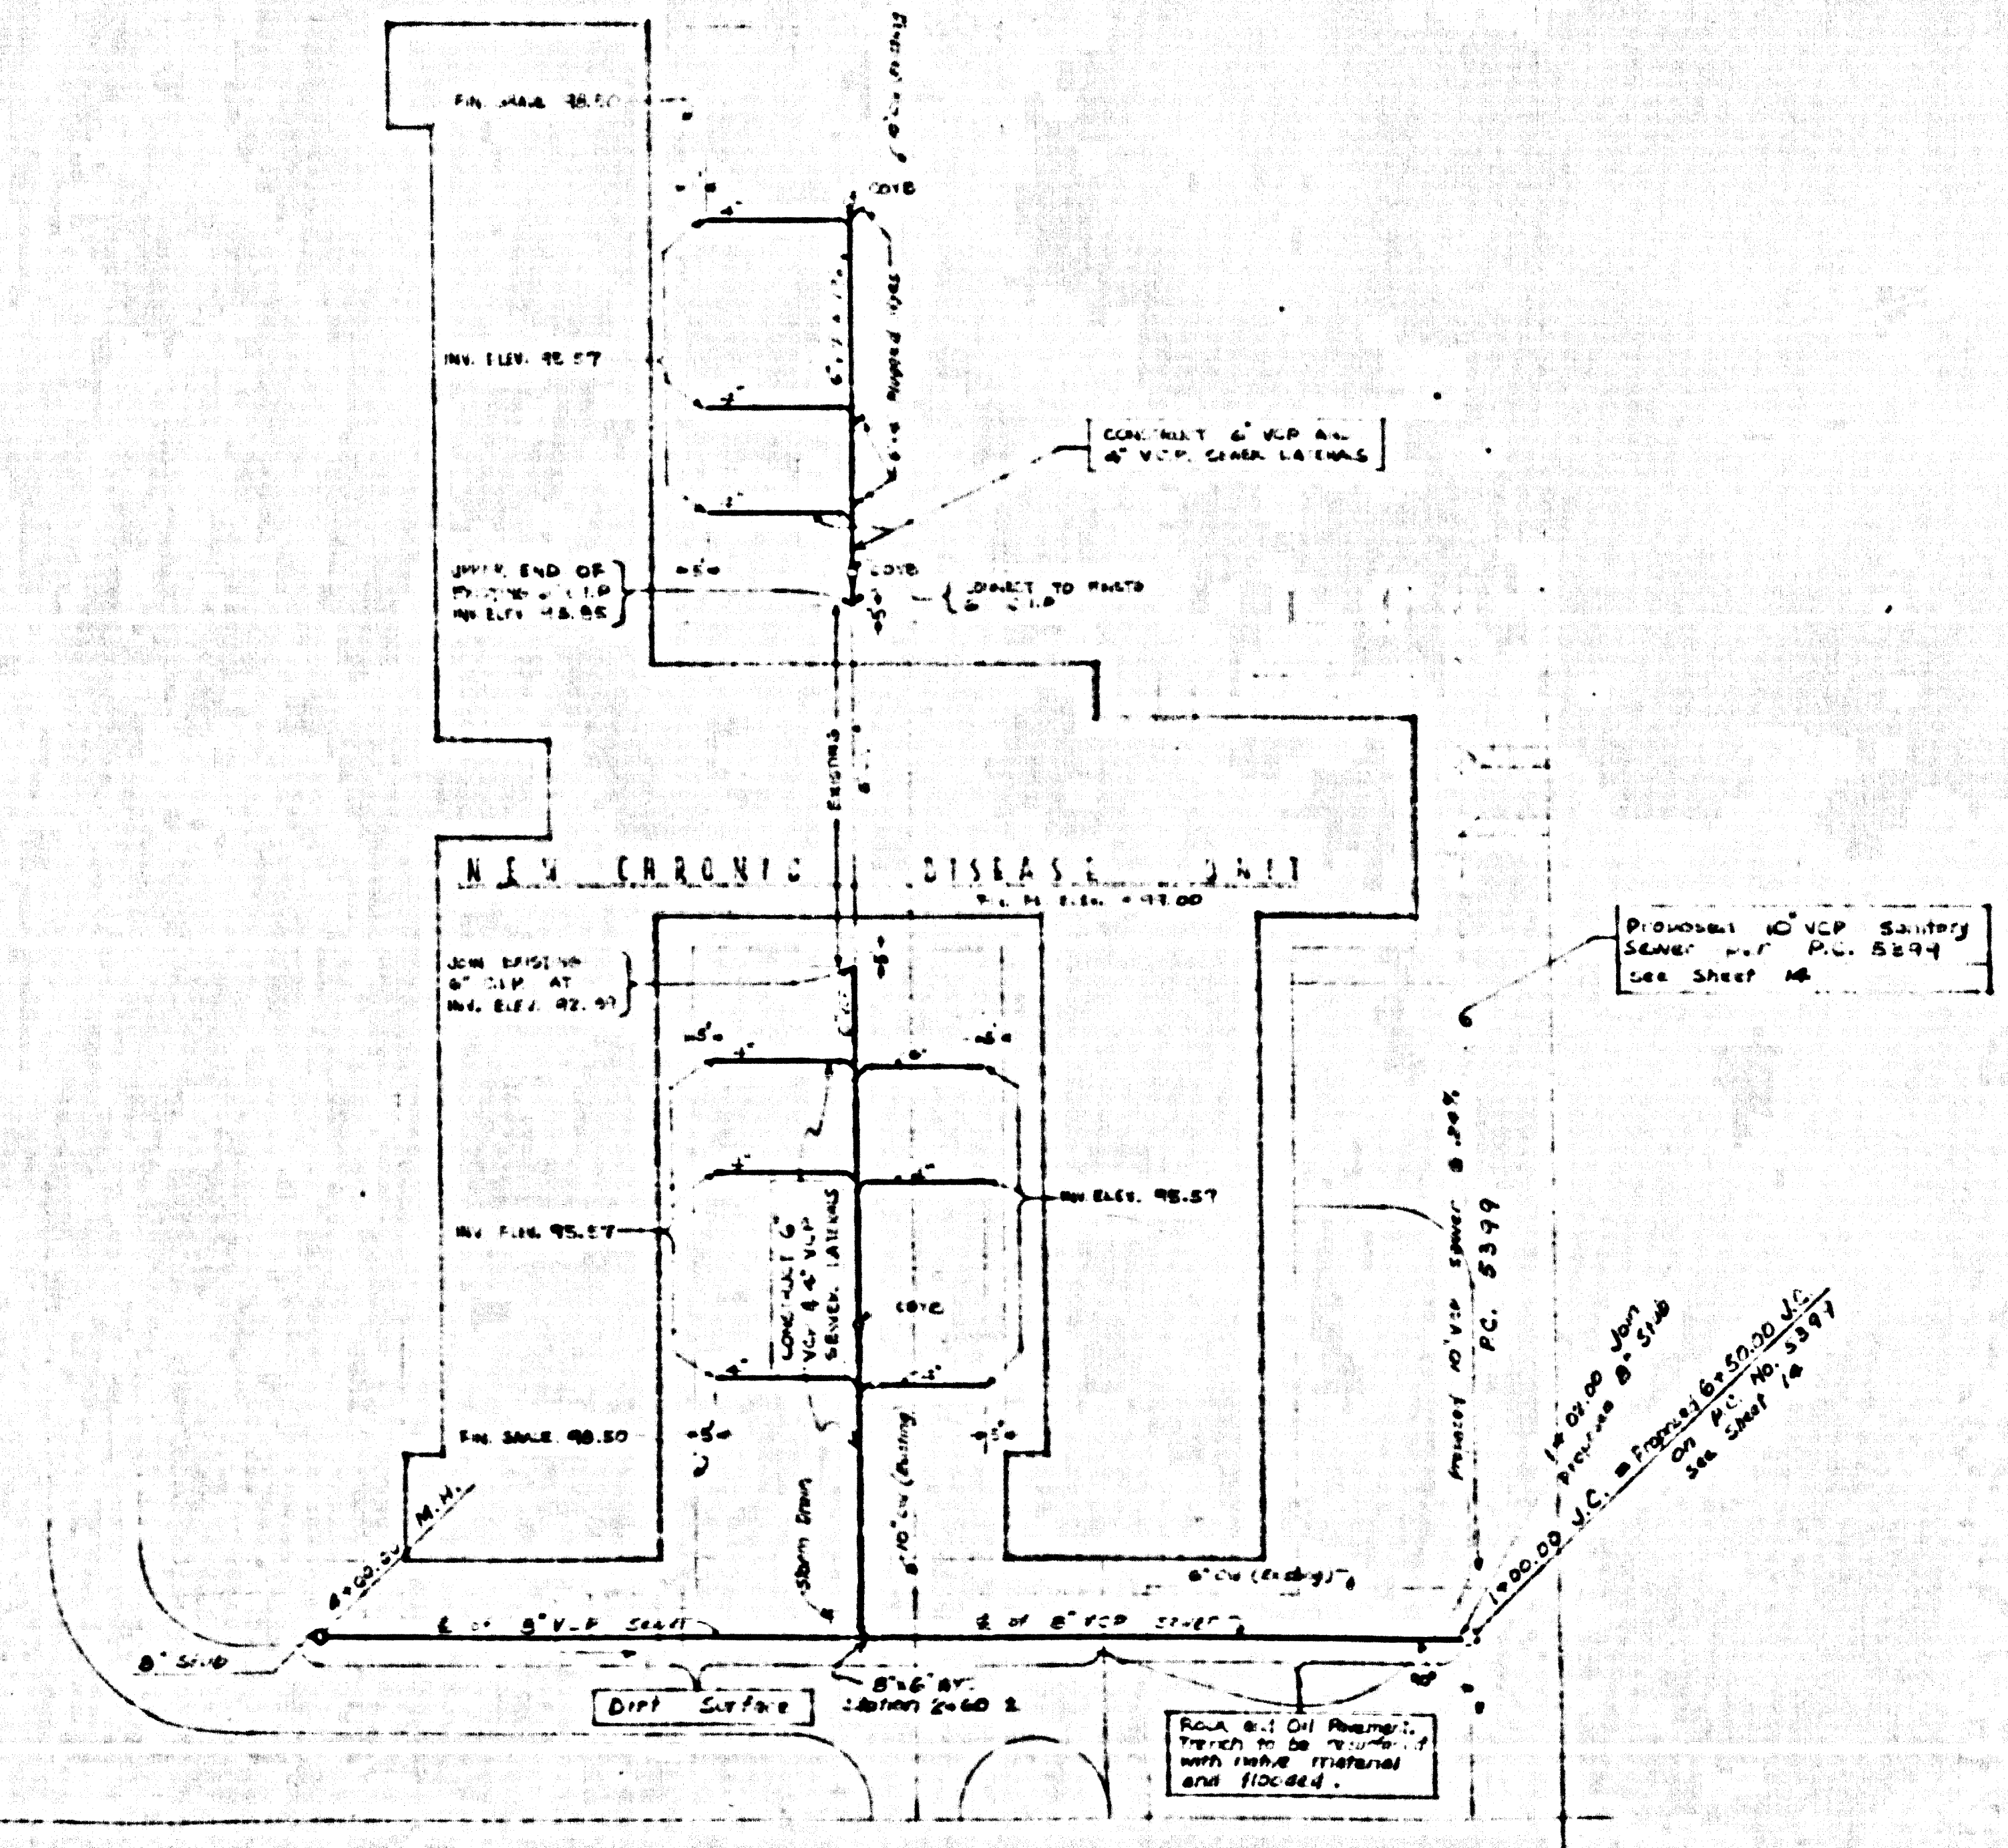

SANITARY SEWER SITE PLAN

SCALE: 1" = 40'-0"

D. C. NO. 5399A

SUBMITTED *Phillip Hamlin 7-2-60*
DESIGN ENGINEER

APPROVED: *[Signature]*
SANITATION ENGINEER
C. R. COMPTON COUNTY
CHAIRMAN MEMBER OF
SANITATION DISTRICT NO. 3
BY *[Signature]*
OFFICIAL ENGINEER

SYMBOLS		ABBREVIATIONS	
—	Sanitary Sewer	RO-C	Point of Connection
—	Cold water (not softened)	RET	Return
—	Gas (fuel)		
—	Water (drinking not softened)		
—	Fire (existing)		
—	Electric Conduit (existing)		
—	Cold water		
—	Conduit		
—	Clear 8" x 8" in Y-2' dia		
—	EL	SE-M.H.	Sanitary Sewer Manhole
—	M.H.	SOV	Shut-off Valve
—	G	SUP	Supply
—	G.V.	W.C.P.	Vitrified Clay Pipe
—	M.H. ELEV.	Y.C.	Yard Box
—	J.C.		
—	M.H.		

DEPARTMENT OF THE COUNTY ENGINEER ARCHITECTURAL DIVISION COUNTY OF LOS ANGELES	DATE SEPEZ, 1960	SANITARY SEWER SITE PLAN CONTINUED PROFILE	APPROVED
	BY RYS		PROJECT NO. 8311 01
	DESIGNED BY RYS	SITE DEVELOPMENT CHRONIC DISEASE UNIT RANCHO LOS AMIGOS HOSPITAL	SHEET NO. 15
	CHECKED BY RYS		7601 EAST IMPERIAL HWY. DOWNNEY, CALIF.

NOTE: CONTRACTOR SHALL VERIFY ALL DIMENSIONS AND BE RESPONSIBLE FOR SAME.