

BENCH MARKS

BY ORDER OF THE COUNTY ENGINEER, L.A. COUNTY
SANITARY SEWER DIST. NO. 4.2
NO. 117, 121, 122, 123, 999, 1000

Note: Lots 101 to 103, 108 to 109, 125 to 131 are served by sewer constructed under P.C. 5000
Lots 32 to 33, 46 to 57 incl. served by sewer constructed under P.C. 5100
Lots 1 to 2, 30 to 31, 34 to 41, 62 to 69, 110 to 117 incl. served by sewer constructed under P.C. 5437


NORWALK BLDG. DIST. NO. 4.2

PROFILE ALIGNMENT AND GRADE OF **P.C. 5458**
SANITARY SEWERS PAGE 1
TO BE CONSTRUCTED IN **J.N. 0353.00**

TRACT No. 24961
PRIVATE CONTRACT NO. 5458

W.S. 34
4 SHEETS: 7 PAGES
SCALE: VERT. 1"=4'
HORIZ. 1"=40'
MARCH, 1960
PREPARED IN THE OFFICES OF
McINTIRE & QUIROS, INC.
By: Olen Murray 7/5/60
REG. C. E. NO. 3548
FOR LEGEND SEE PLAN NO. SA-64

29,668

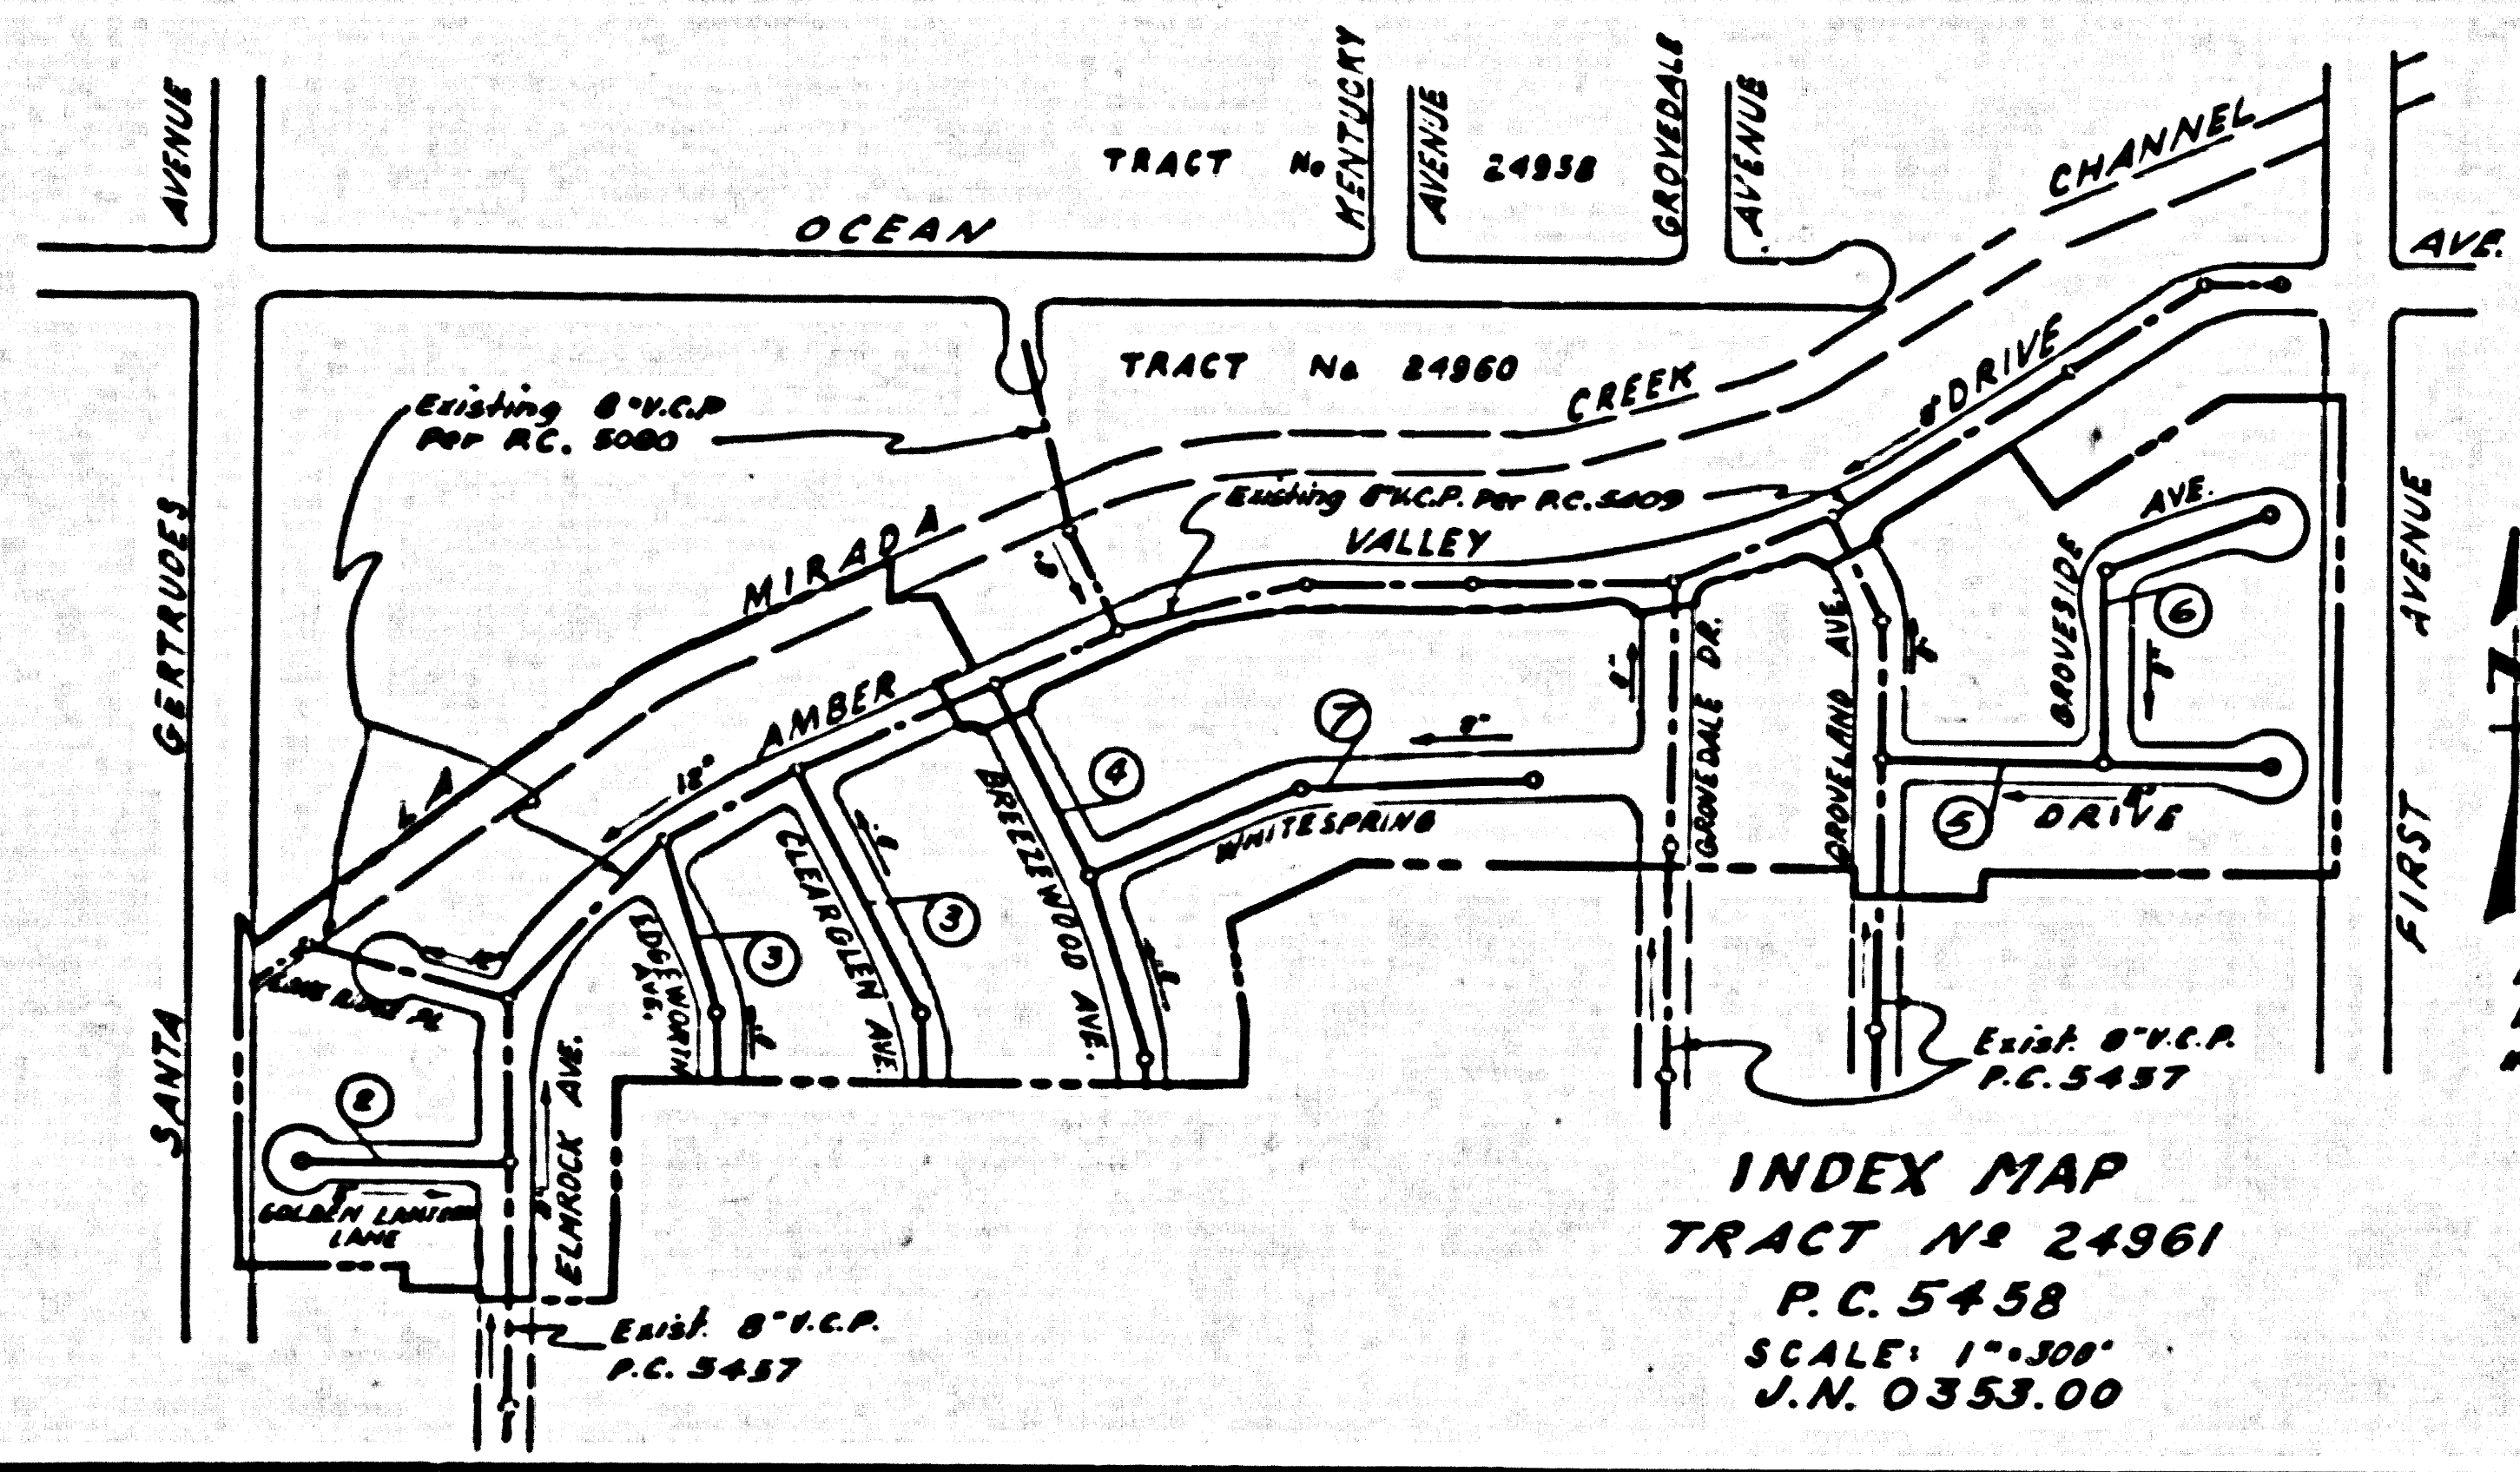

INDEX MAP
TRACT No 24961
P.C. 5458
SCALE: 1"=300'
J.N. 0353.00

NOTE: NUMBERS IN CIRCLES INDICATE PAGE NUMBERS

- NOTES**
1. PROFILE STAKES ON THE PROPERTY LINE OR PROPERTY LINES PRODUCED AT RIGHT ANGLES TO THE SEWER LINE AT THE CENTER LINE OF EACH MANHOLE.
 2. NO REPRESENTATIVE OF THE COUNTY ENGINEER WILL SURVEY OR LAY OUT ANY PORTION OF THE WORK.
 3. THE OWNER OR HIS AUTHORIZED REPRESENTATIVE SHALL FURNISH THE COUNTY ENGINEER WITH GRADE SHEETS AND STATIONING FOR ALL HOUSE LATERALS AND Y BRANCHES AND SHALL PROFILE GRADE FOR THEM AT THEIR PROPER LOCATIONS WITH STATIONING PLAINLY MARKED. ANY CHANGE IN LOCATION SHALL BE REQUESTED IN WRITING BY THE OWNER OR HIS REPRESENTATIVE.
 4. THE COUNTY ENGINEER SHALL FURNISH THE HOUSE LATERAL DEPTH AT THE PROPERTY LINE BELOW THE TOP OF CURB ELEVATION FOR EACH HOUSE LATERAL ON THE GRADE SHEET.
 5. NO REVISIONS SHALL BE MADE IN THESE PLANS WITHOUT THE APPROVAL OF THE COUNTY ENGINEER.
 6. USE STANDARD MANHOLE FRAMES AND COVERS, S-117.
 7. USE STANDARD STRENGTH PIPE EXCEPT AS NOTED.
 8. USE CEMENT MORTAR OR "WEDG-LOCK" OR "SPEED-SEAL" FOR ALL P.E.R. JOINTS PER SPECS. SECS. 16 & 18.
 9. BRIDGE ALL TRENCH WITHIN PAVED AREA TO MEET L.A. COUNTY ROAD DEPT. OR CALIF. STATE HIGHWAY REQUIREMENTS IN ACCORDANCE WITH PERMITS.
 10. BRIDGE FOUR FEET OF SEWER AT POINTS OF INTERFERENCE WITH POLES, OR WHEN COVER IS LESS THAN FIVE FEET, PER S-6-178, CASE III.
 11. HOUSE LATERALS TO BE CONSTRUCTED WITH INVERTS AT PROPERTY LINE 8 FEET BELOW CURB GRADE EXCEPT AS NOTED.
 12. ALL STRUCTURES SHALL BE BRICK SEWER STRUCTURES, S-104, EXCEPT AS NOTED.
 13. FOR ALLOWABLE LEAKAGE TEST USE FORMULA NO. 101, SPECS. SEC. 14.
 14. MANHOLE TOPS IN UNIMPROVED RIGHTS-OF-WAY TO BE SIX INCHES ABOVE FINISHED GRADE.
 15. THE CONTRACTOR SHALL NOTIFY THE CONSTRUCTION DIVISION BY TELEPHONE, MADISON 5-40, EXTENSION AT LEAST TWENTY-FOUR HOURS BEFORE STARTING ANY WORK UNDER THIS CONTRACT.
- MAJOR CONSTRUCTION SHALL BE PERMITTED IN FILLED AREAS UNLESS ACCEPTABLE CERTIFICATION IS SUBMITTED TO THE CONSTRUCTION DIVISION OF THE COUNTY ENGINEER'S DEPT. THAT COMPACTING IS GREATER THAN 80%.
- IF COMPACTING IS GREATER THAN 80%, CAPLINES OR LATERAL ALN BASES ARE NOT REQUIRED. HOWEVER, IF COMPACTING MUST BE QUALIFIED THE COUNTY ENGINEER FOR ALL UNFILLED AREAS.
- IF COMPACTING IS LESS THAN 80%, THE SEWER MUST BE GRADED AS SHOWN ON PLANS (PER S-6-162)
17. STANDARD SPECIFICATIONS DATED JAN. 1, 1960, APPLY IN THE CONSTRUCTION OF THIS PROJECT.

NO CHARGE FOR CONNECTIONS
C. B. Heistand 7-26-60

NOTES

GRADES TO WHICH THIS IMPROVEMENT IS TO BE CONSTRUCTED ARE SHOWN ON PLANS AND PROFILE GRADE POINTS FOR TOP OF CURBS CENTER LINE OF STREETS OR CENTER LINE OF ALLEYS ARE SHOWN BY CIRCLES ON PROFILES AT ALL POINTS BETWEEN DESIGNATED POINTS THE GRADE SHALL BE ESTABLISHED SO AS TO CONFORM TO A STRAIGHT LINE DRAWN BETWEEN SAID DESIGNATED POINTS.

ELEVATIONS ARE IN FEET ABOVE U.S.C. & G.S. SEA LEVEL DATUM OF 1929.

THIS DRAWING AND THE DATA HEREON ARE HEREBY MADE A PART OF THE SPECIFICATIONS.

WORK SHALL BE CONSTRUCTED ACCORDING TO SPECIFICATIONS ON FILE IN THE OFFICE OF THE COUNTY ENGINEER AND SHALL BE PROSECUTED ONLY IN THE PRESENCE OF THE COUNTY ENGINEER.


BEFORE WORK CAN BE STARTED THE CONTRACTOR MUST OBTAIN A PERMIT TO OCCUPY IN COUNTY STREETS FROM THE L.A. COUNTY ROAD DEPT., DISTRICT OFFICE NO. 7, AND PAY A FEE WITH THE COUNTY ENGINEER ROOM 324 SAN AMERICAN BUILDING, 253 SO. BROADWAY SUFFICIENT TO COVER THE COST OF CONSTRUCTION INSPECTION AND RECORD PLANS.

APPROVAL OF THIS PLAN BY THE COUNTY OF LOS ANGELES DOES NOT CONSTITUTE A REPRESENTATION AS TO THE ACCURACY OF THE LOCATION OR OF THE EXISTENCE OR NON-EXISTENCE OF ANY UNDERGROUND UTILITY PIPE OR STRUCTURE WITHIN THE LIMITS OF THIS PROJECT. THIS NOTE APPLIES TO ALL PAGES.

IF WORK IS TO BE DONE IN A STATE HIGHWAY, A PERMIT MUST BE OBTAINED FROM THE STATE OF CALIFORNIA, DIVISION OF HIGHWAYS, 126 SOUTH SPRING STREET.



COUNTY OF LOS ANGELES, CALIFORNIA
APPROVED, JOHN A. LAMBIE, COUNTY ENGINEER
APPROVED, C. B. Heistand, CHIEF ENGINEER
BY: C. E. Heistand DIST. SANITATION ENGINEER
BY: C. B. Heistand OFFICE ENGINEER
CHECKED BY: J. K. Orinda 7-28-60
OFFICE OF COUNTY ENGINEER, REG. C. E. NO. 3406

SUBMITTED BY: John L. Orton 7-28-60
Los Carrizos Regional Engineer, Reg. C.E. No. 3871


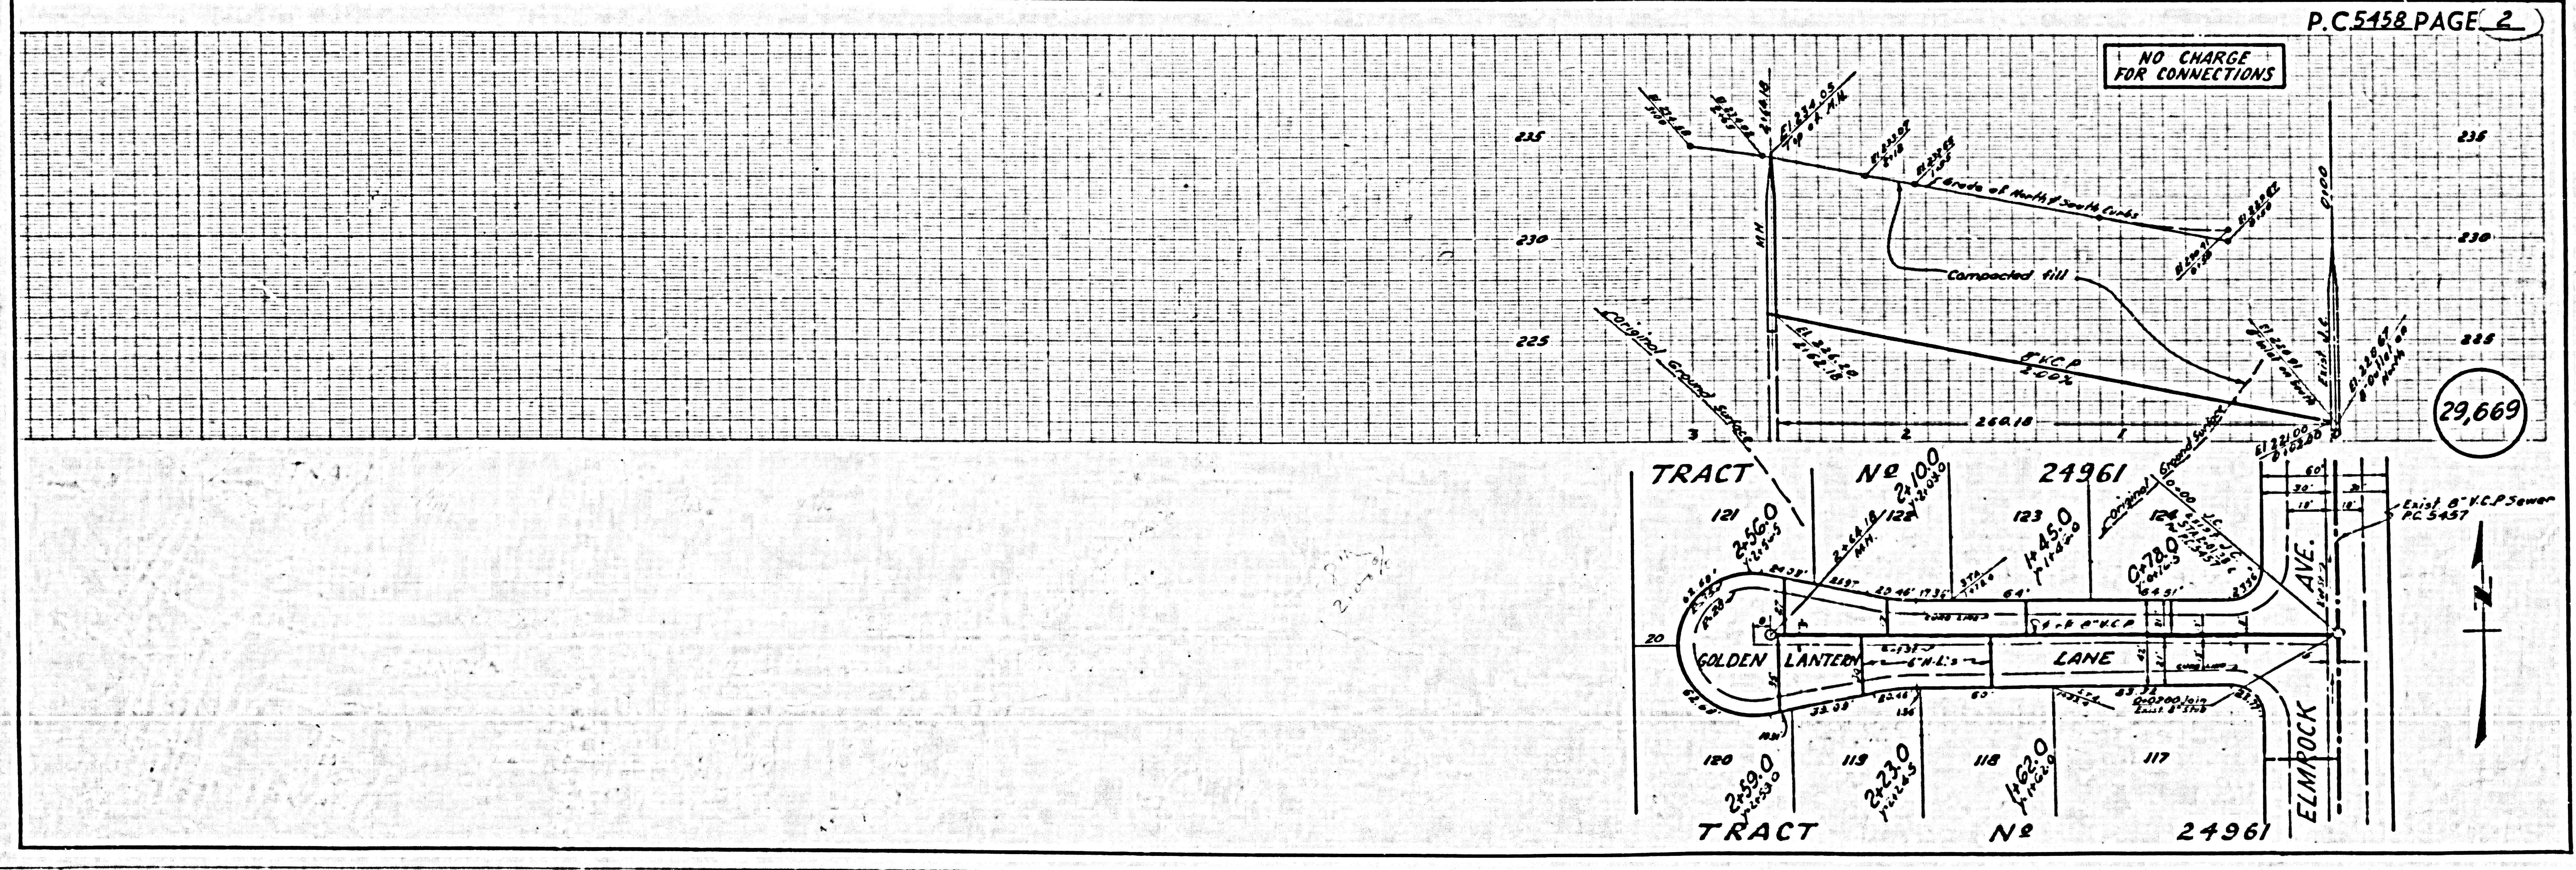


NO CHARGE FOR CONNECTIONS

29,669

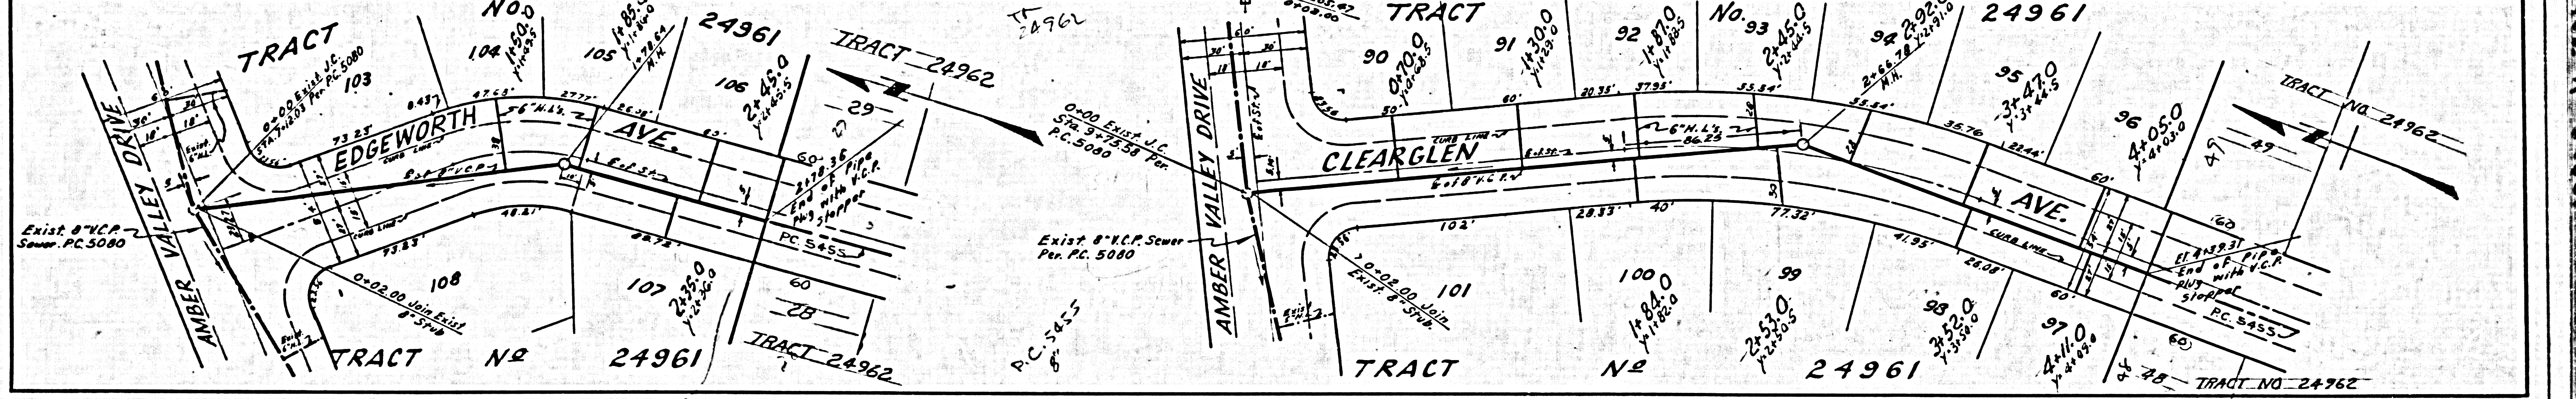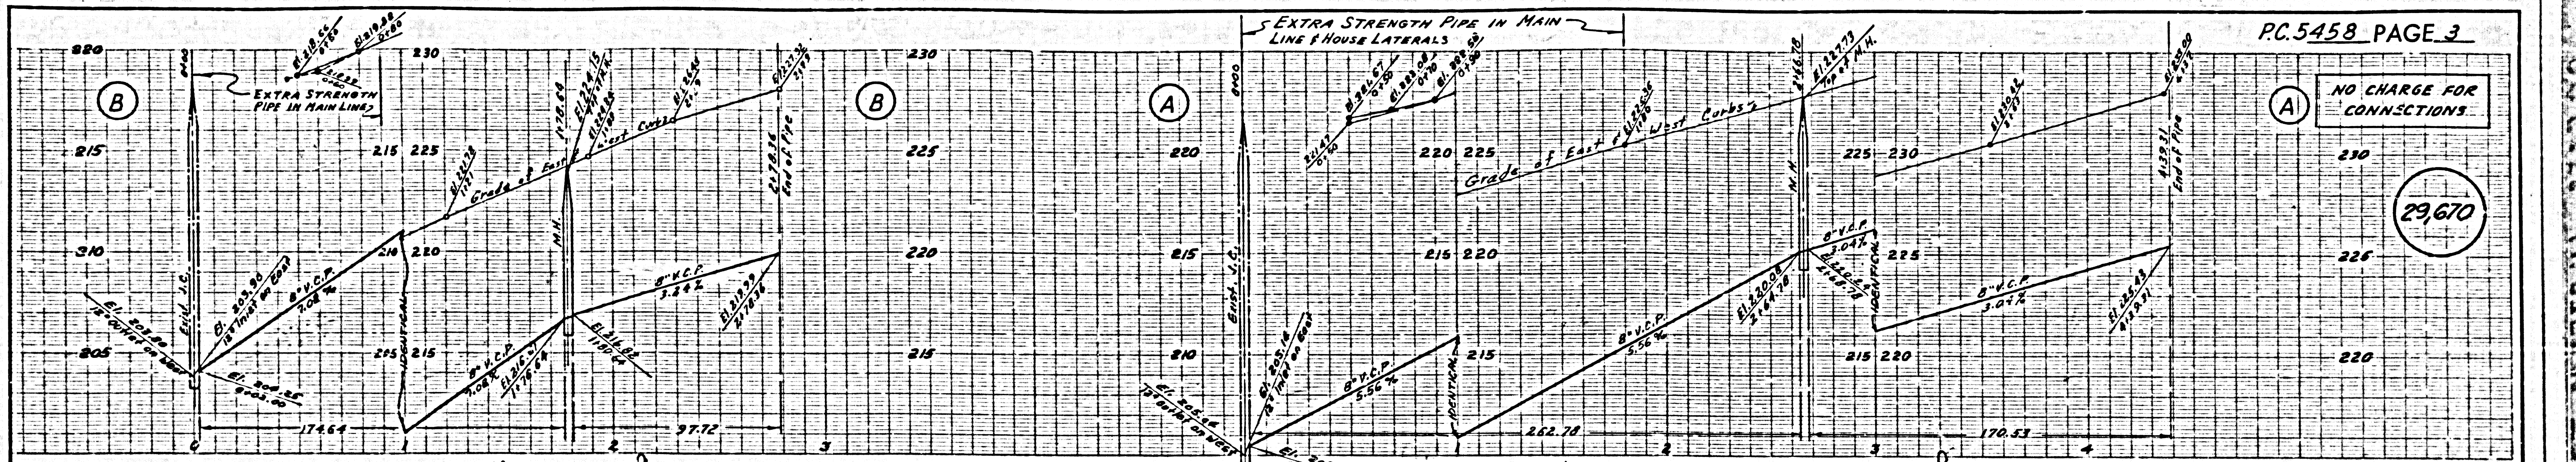



Use this line

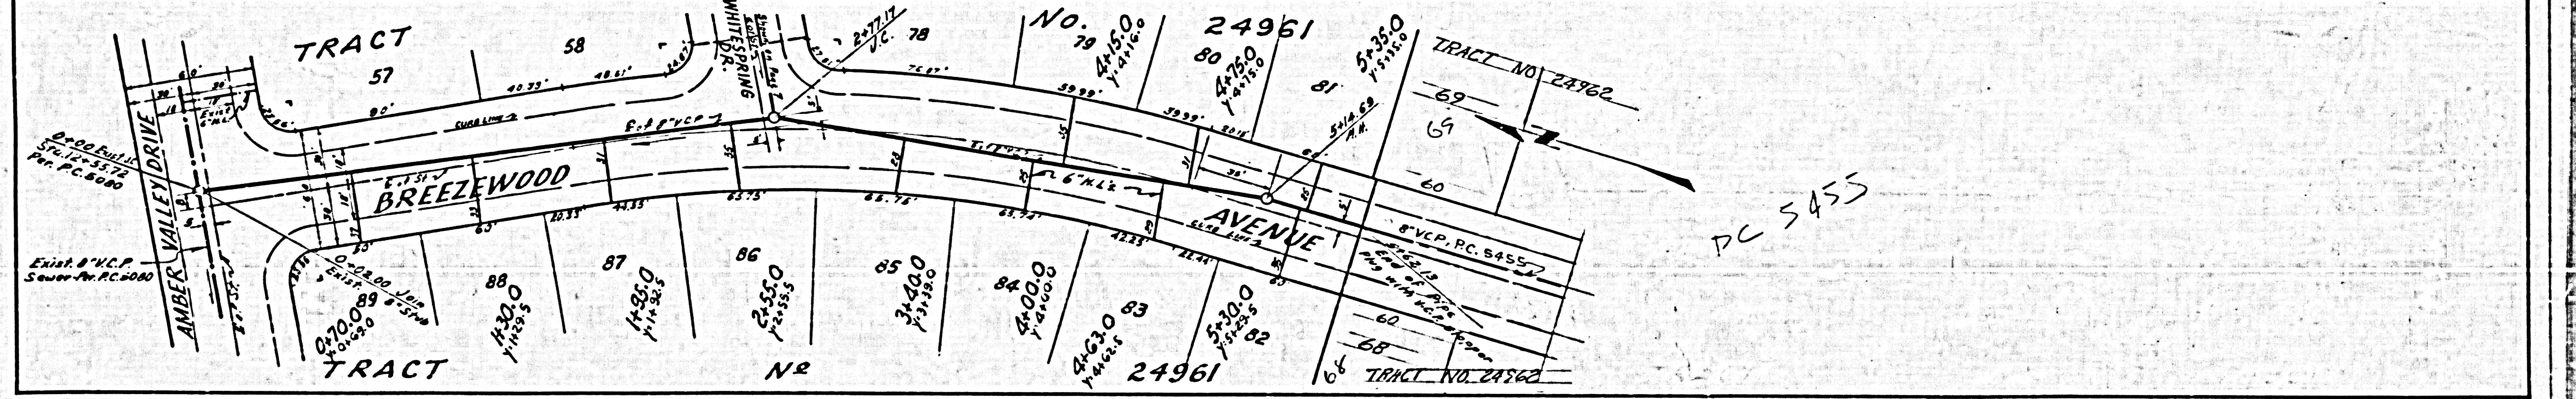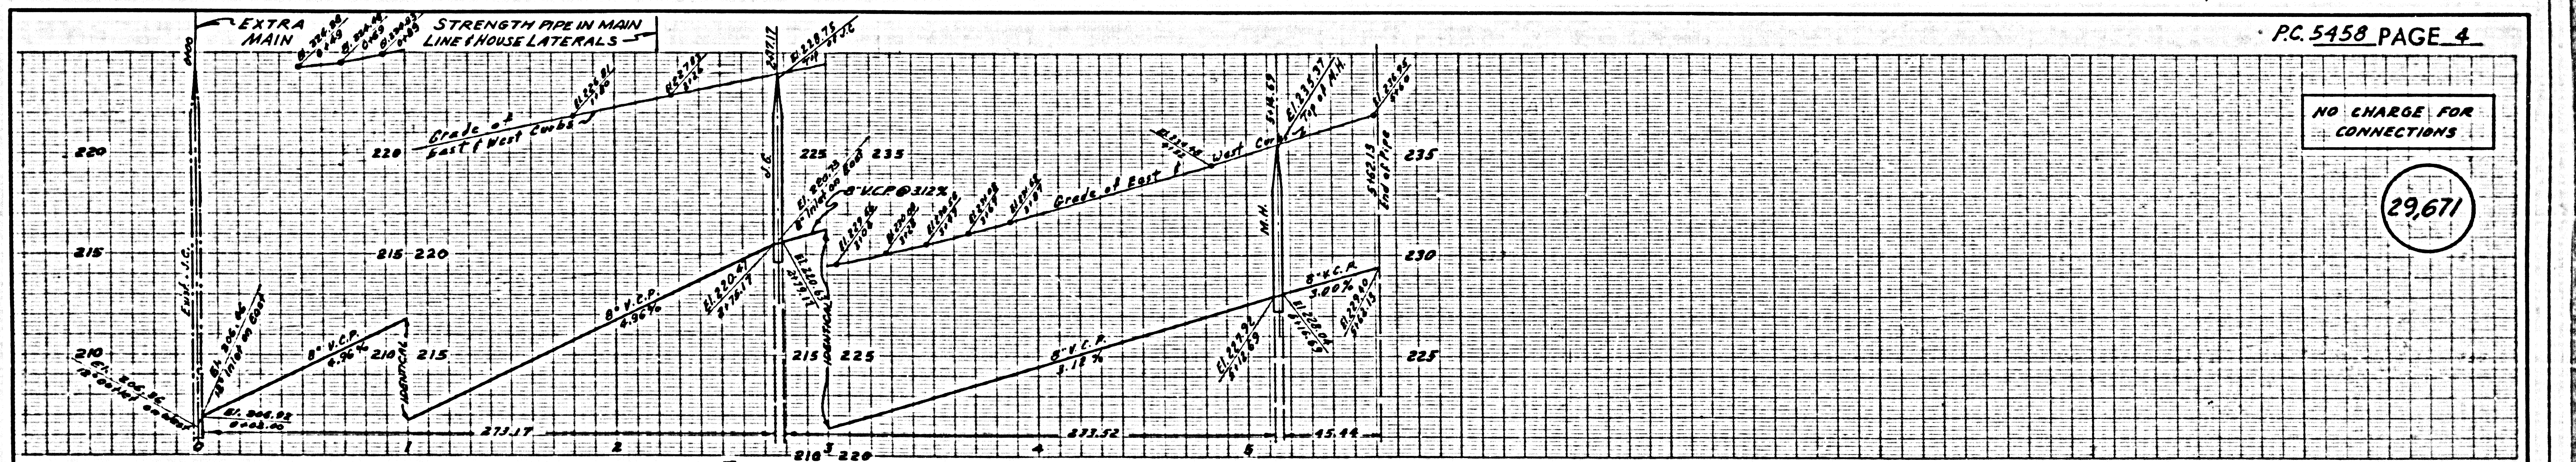

PC 5455




NO CHARGE FOR CONNECTIONS


29,672

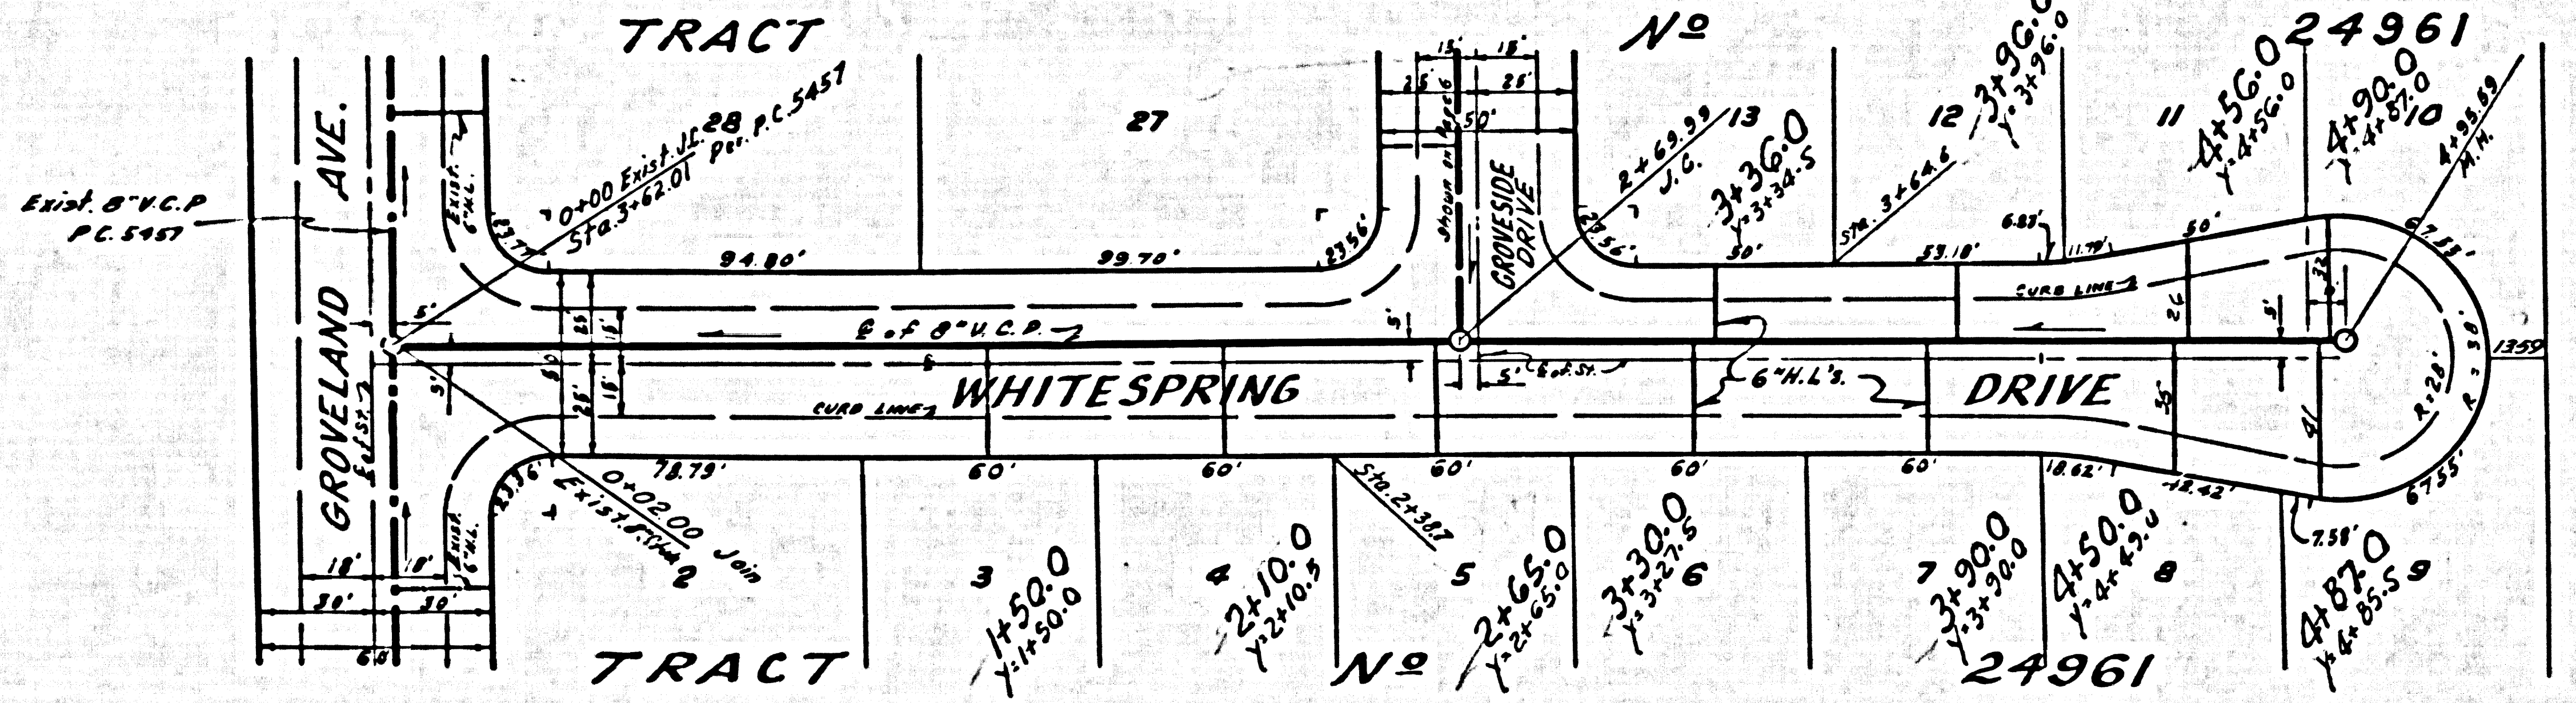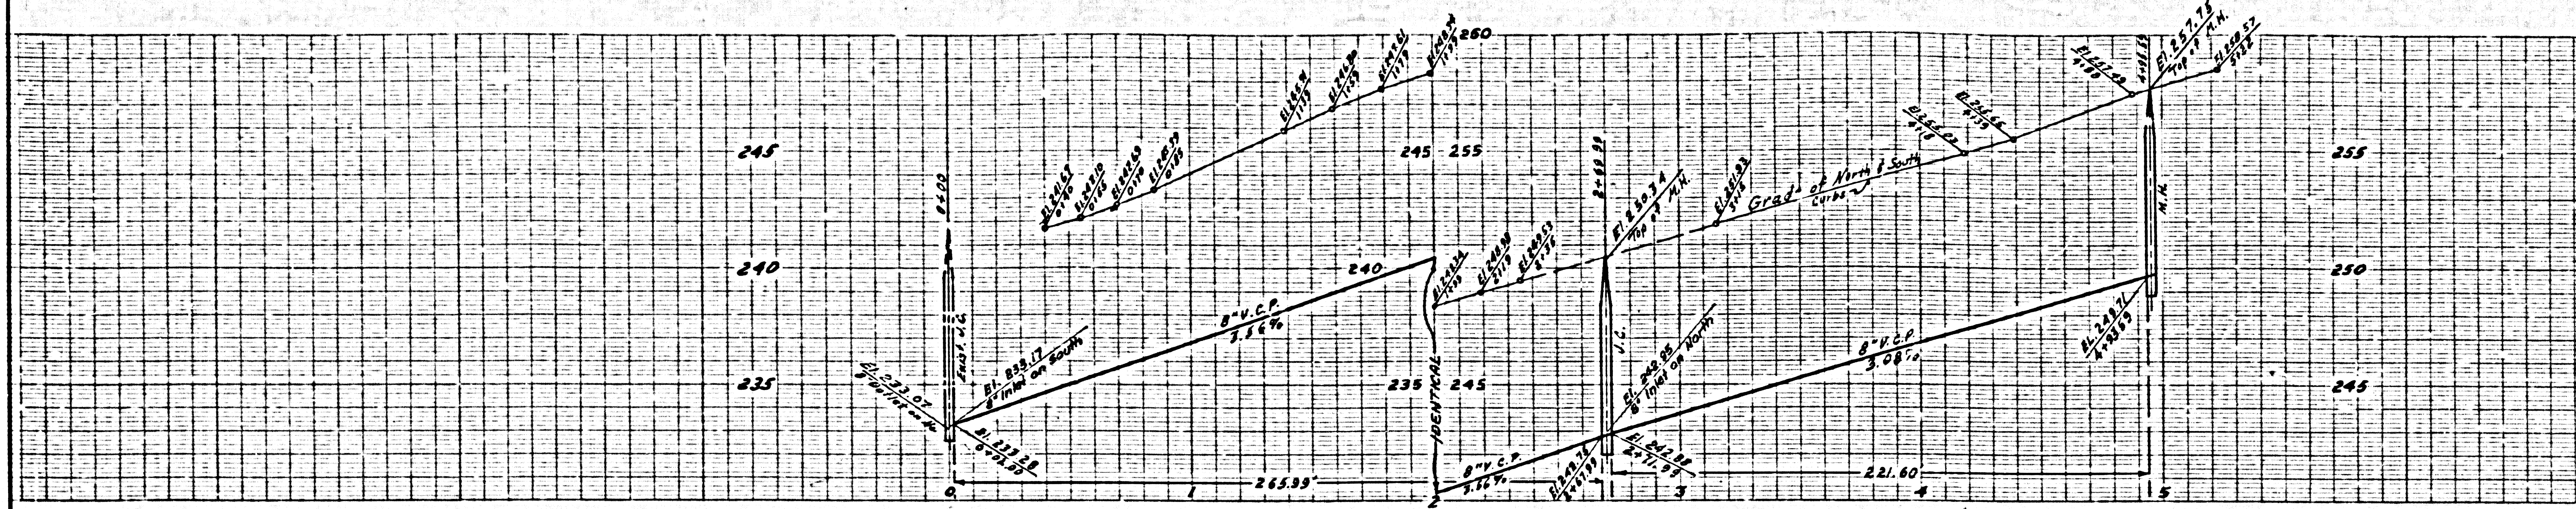

NO CHARGE FOR CONNECTIONS

29,673

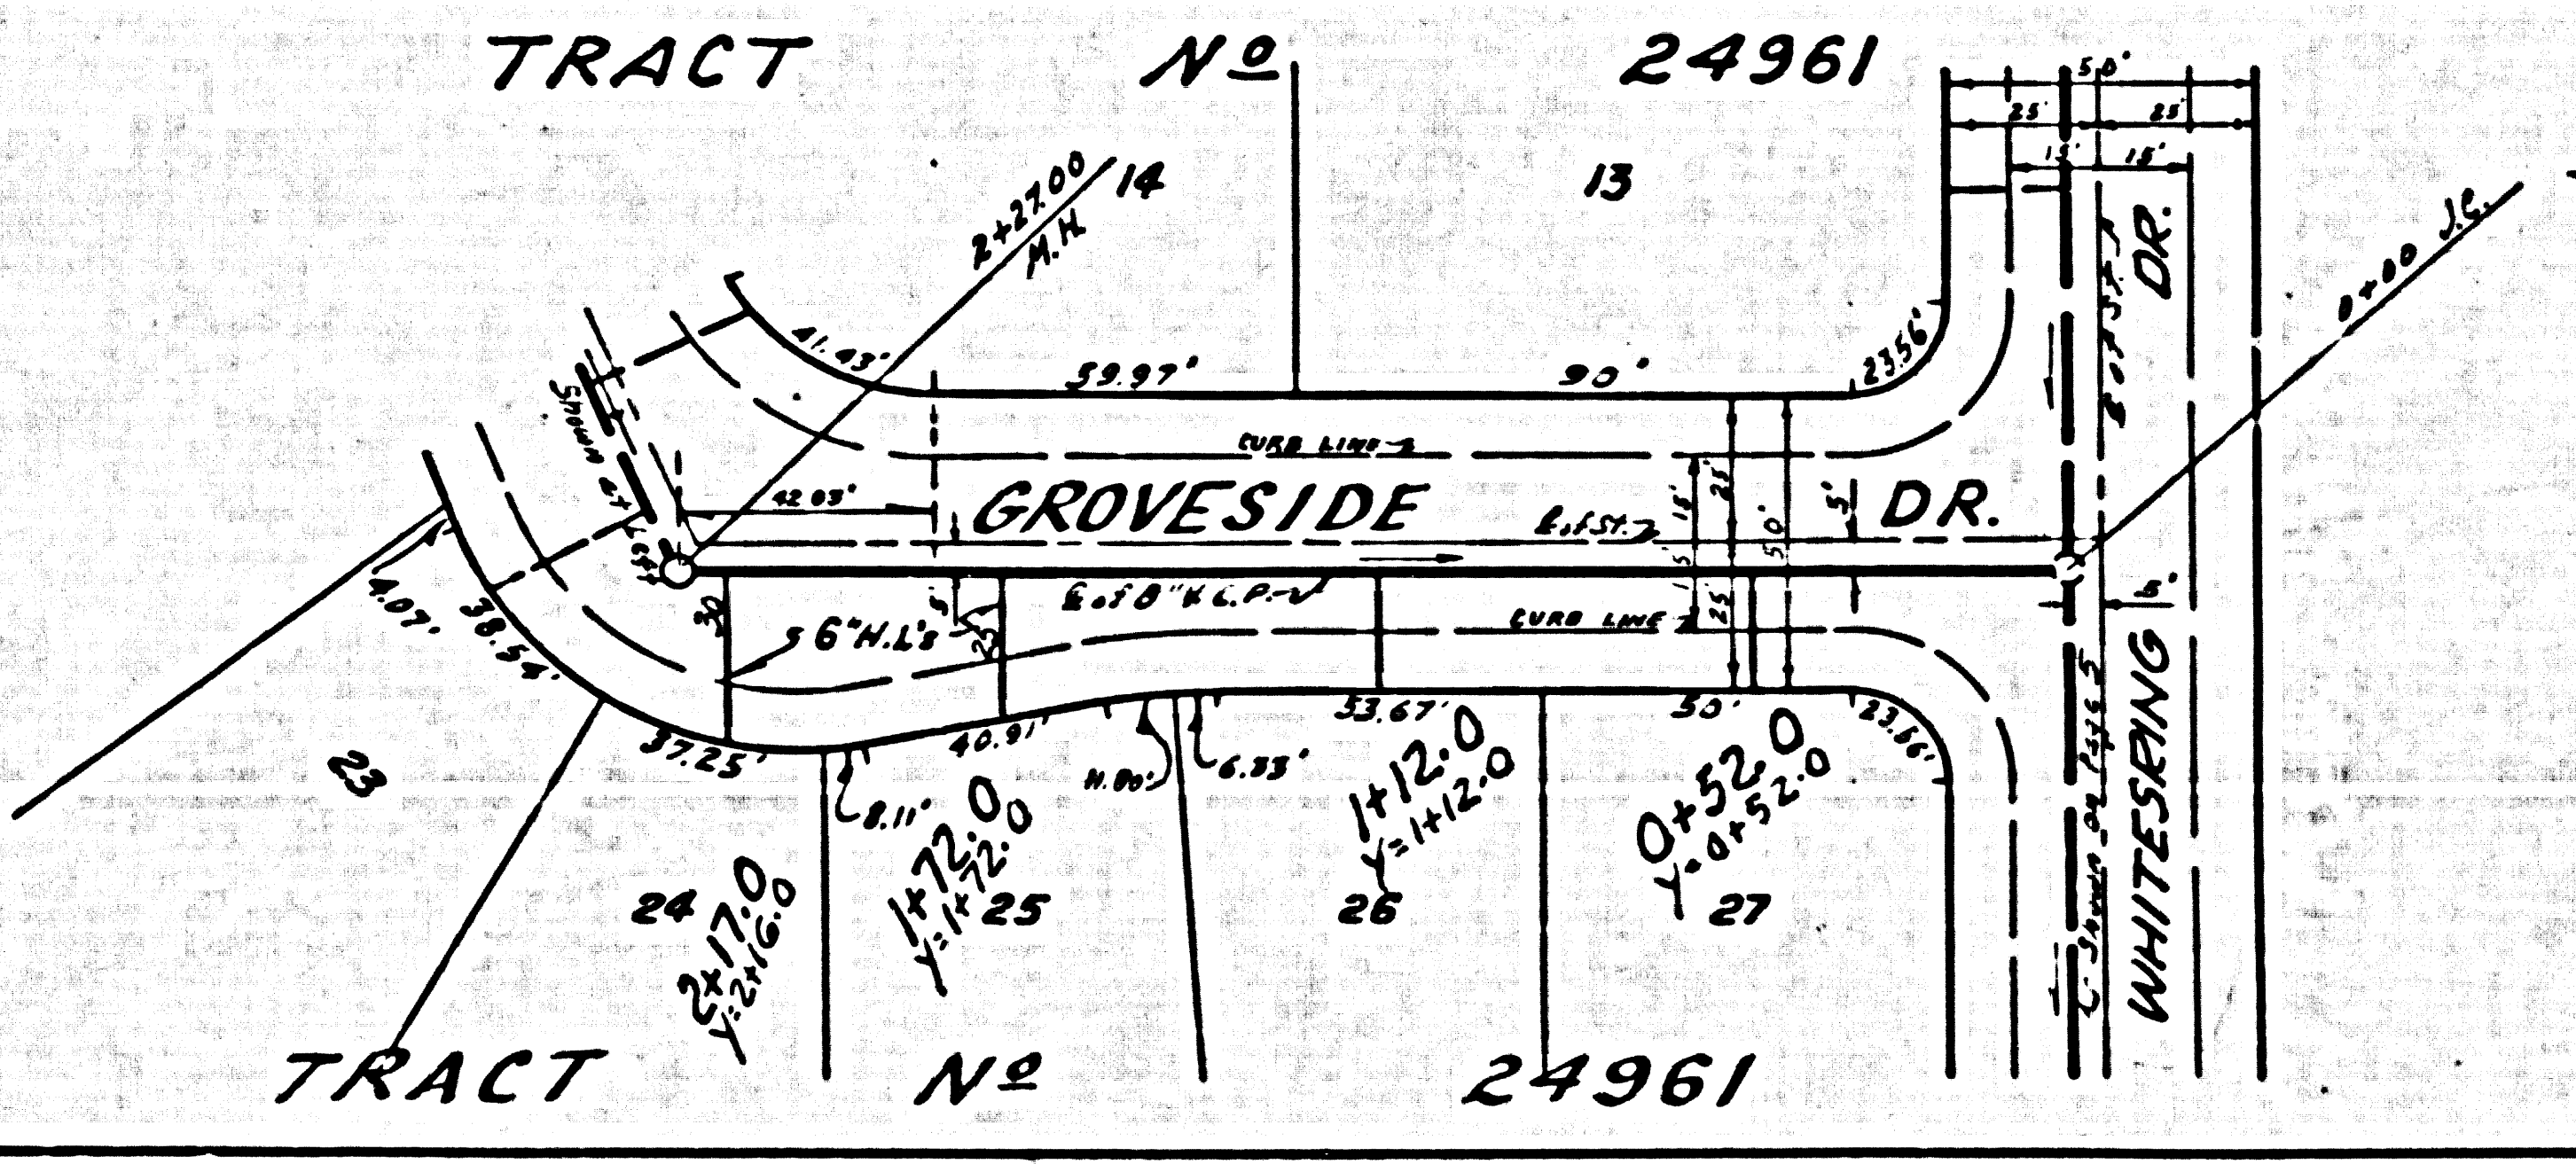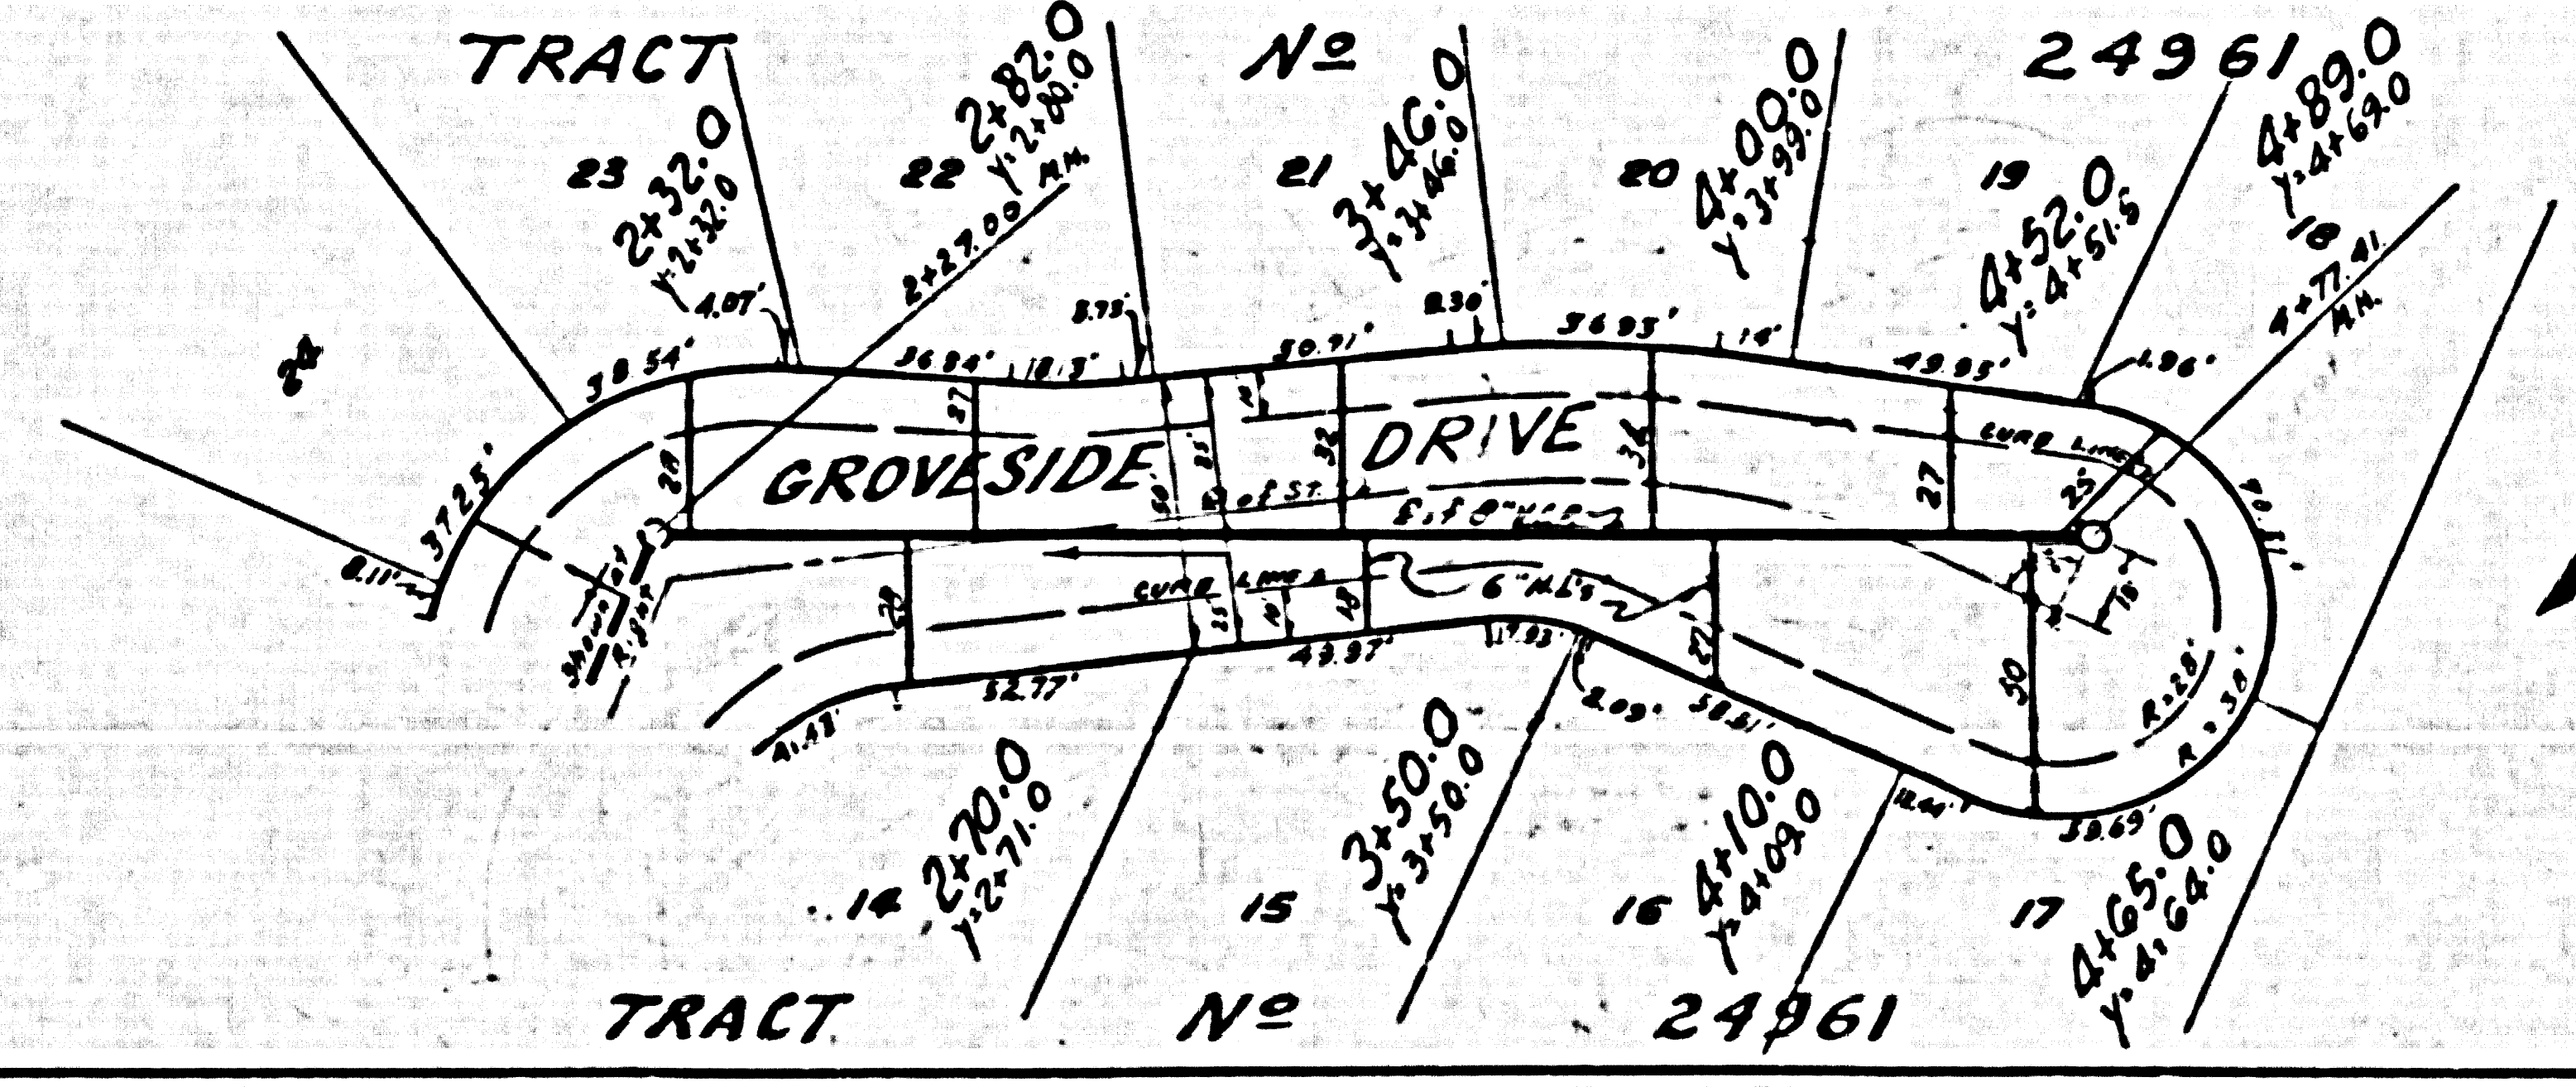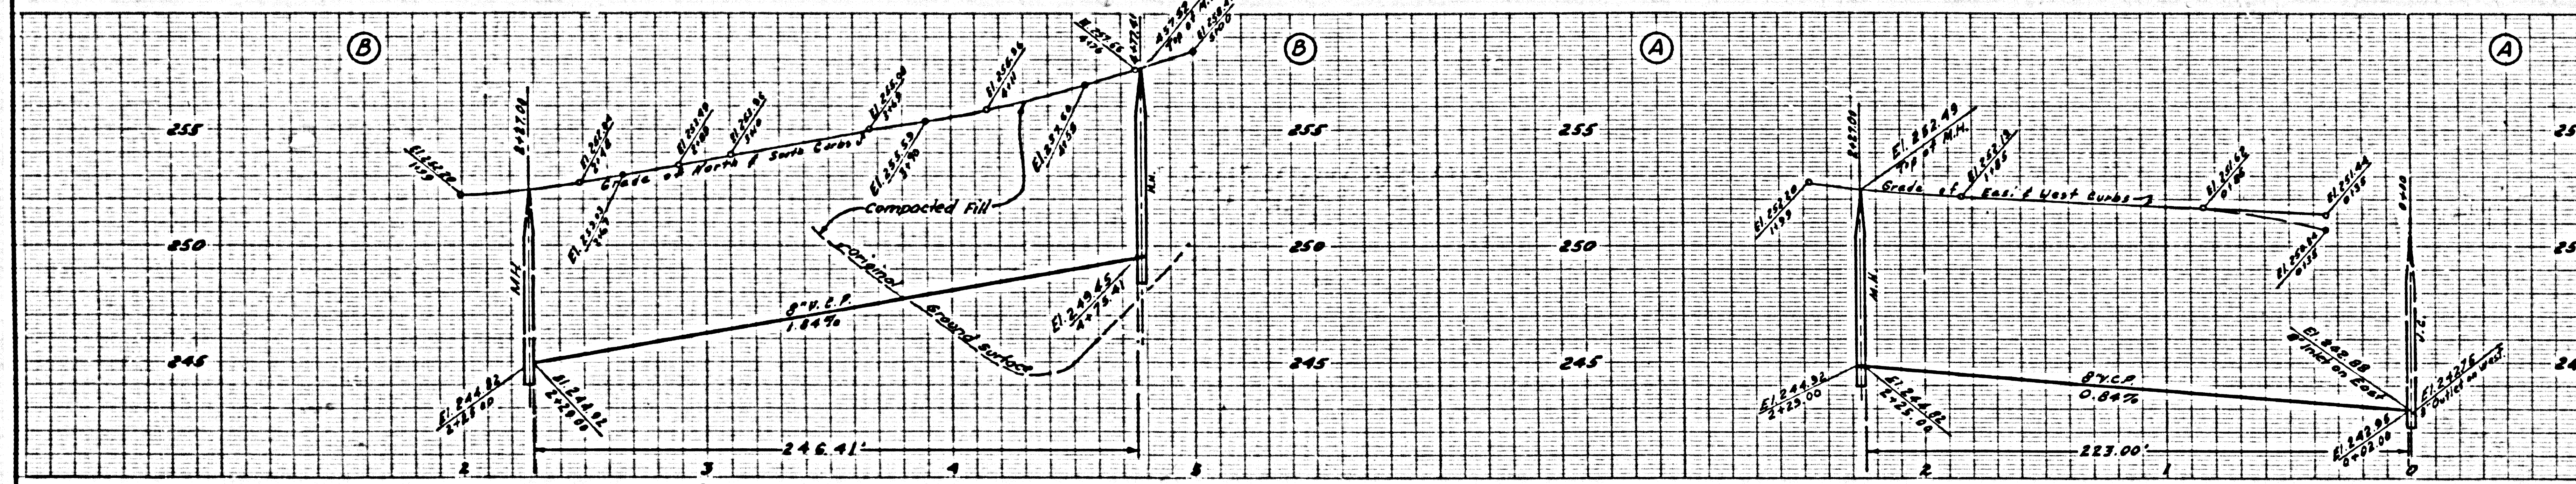

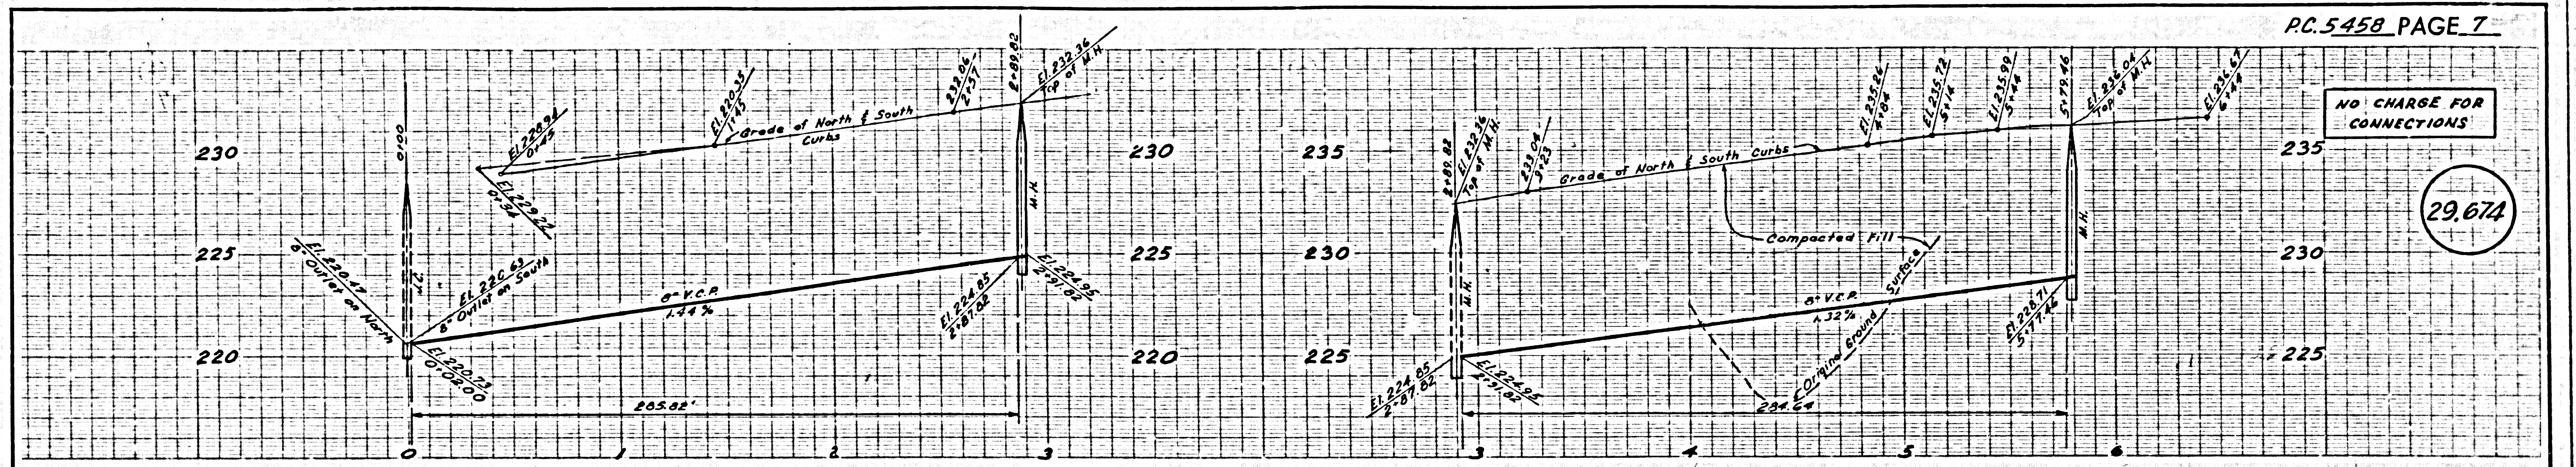

NO CHARGE FOR CONNECTIONS

29,674

