



REIMB. CHARGE CALL CENTRAL OFFICE

DOUBLE SCALE

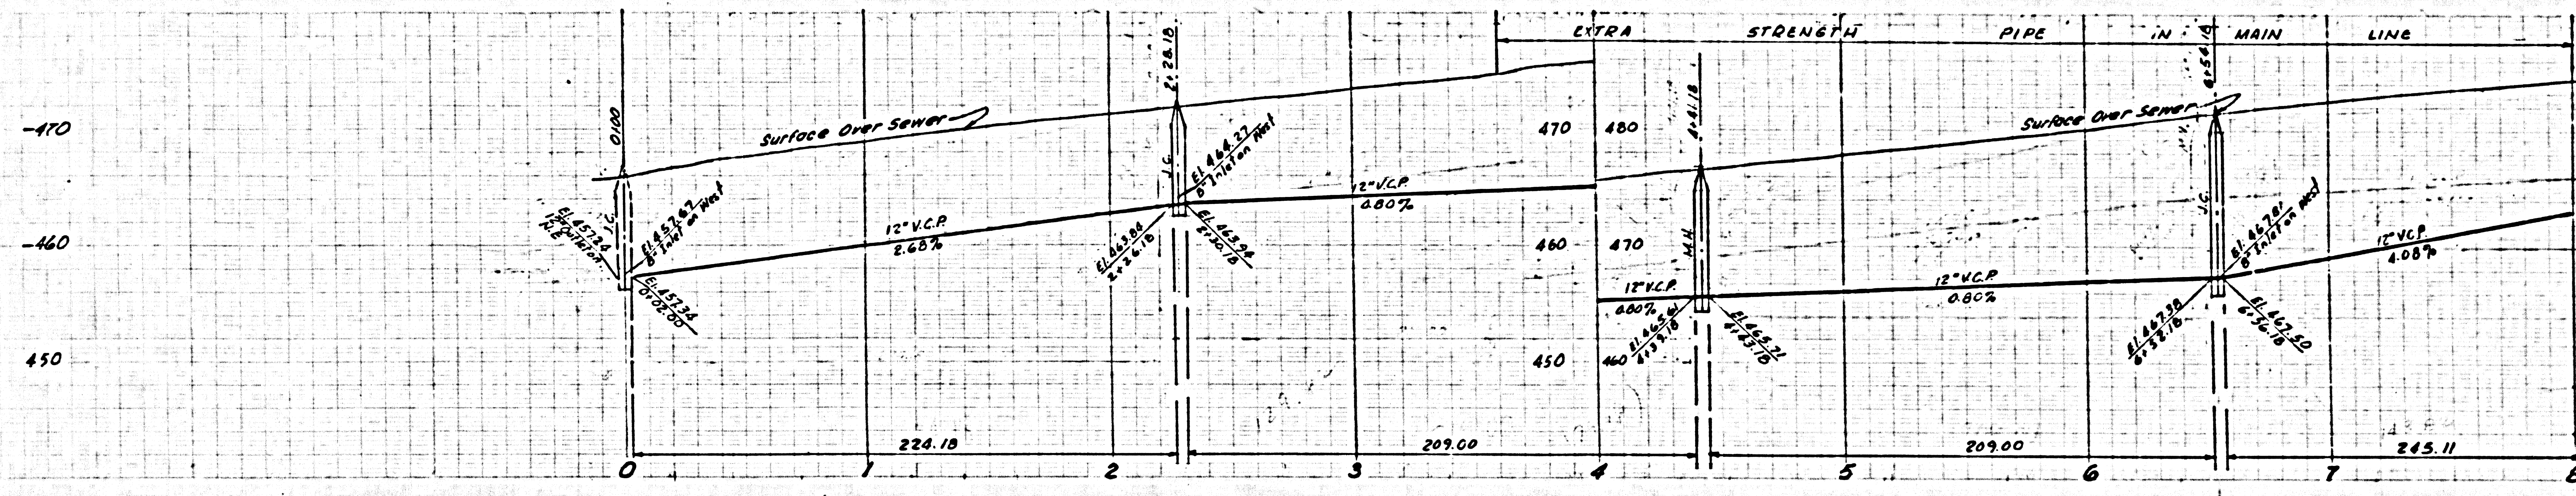


30716

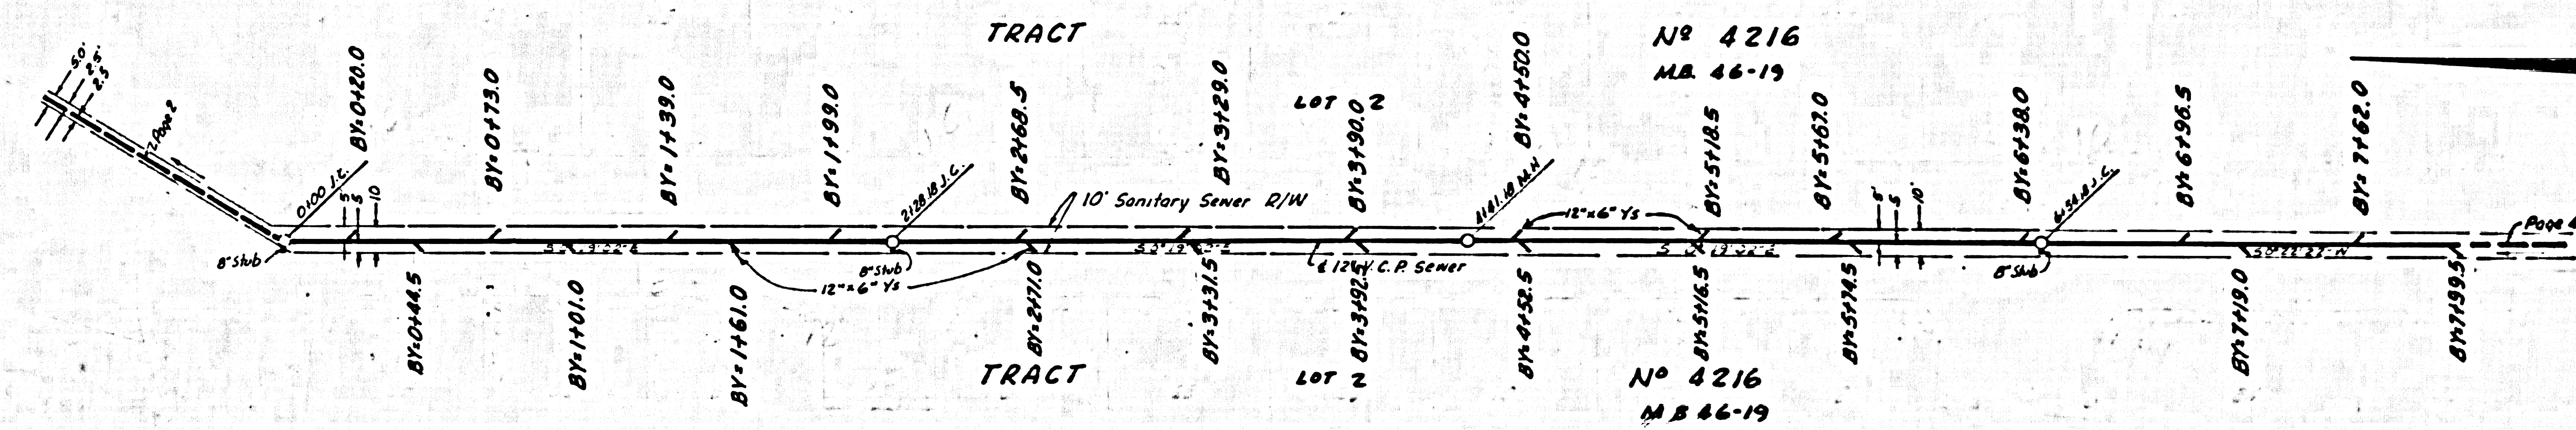


REIMB. CHARGE CALL CENTRAL OFFICE


DOUBLE SCALE

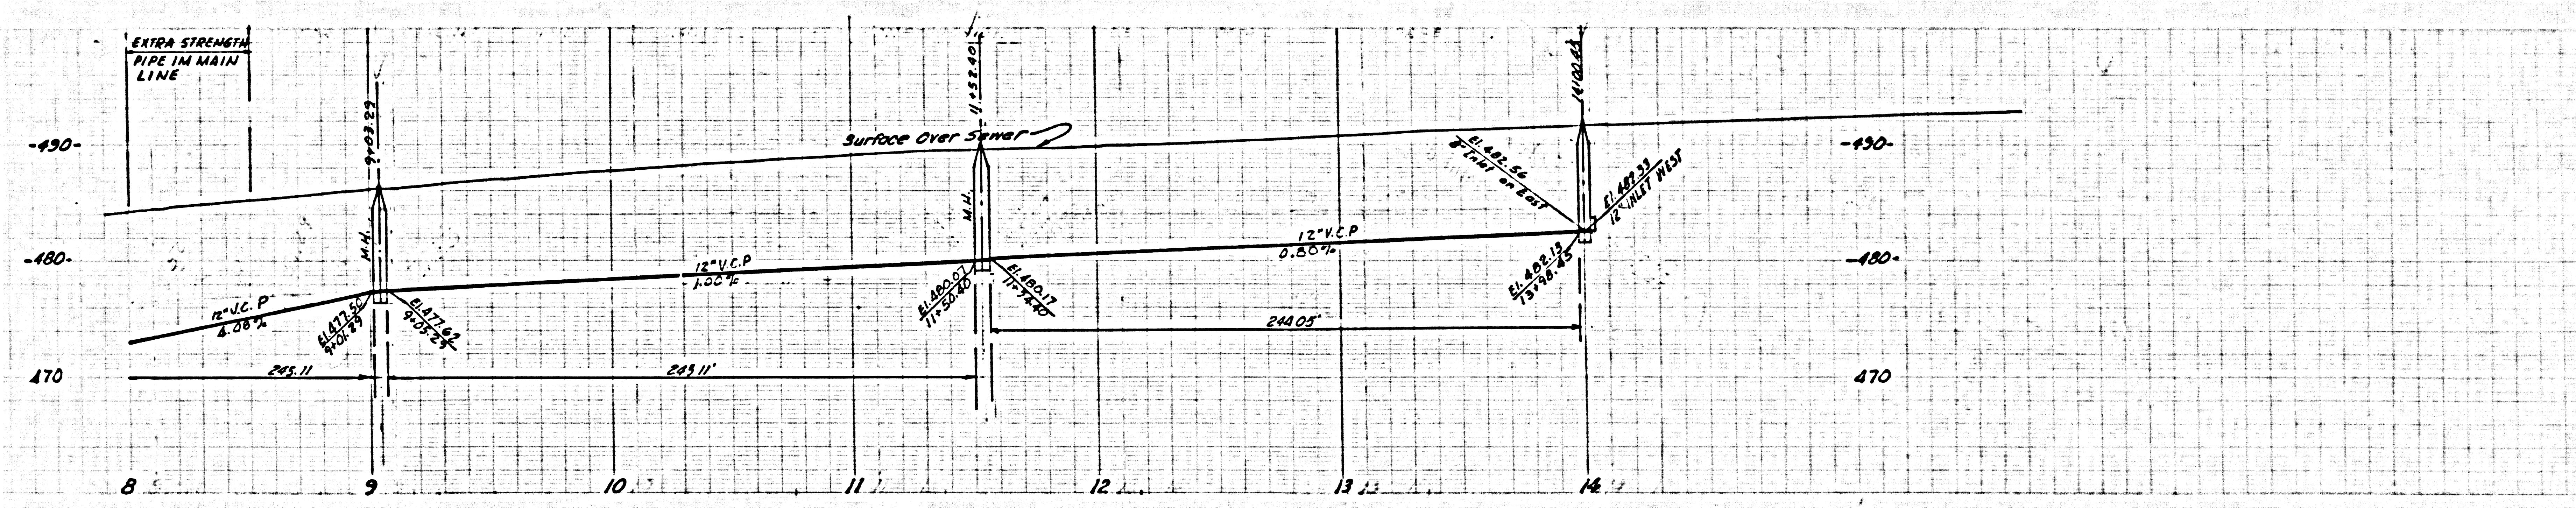


30716

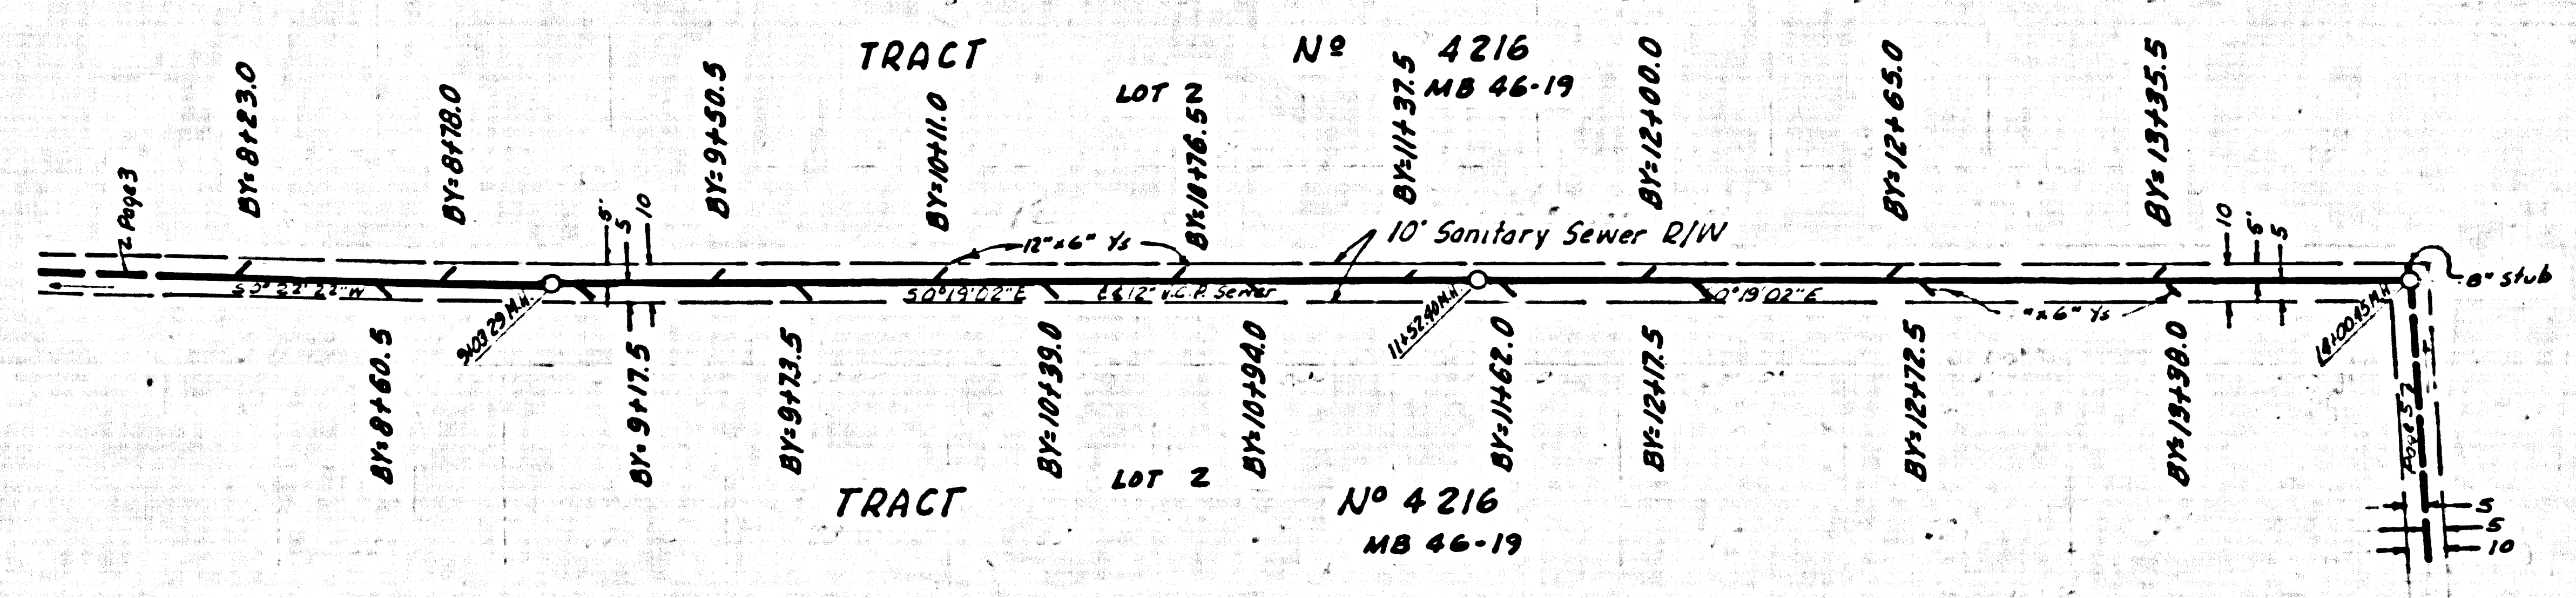


REIMB. CHARGE CALL CENTRAL OFFICE
DOUBLE SCALE

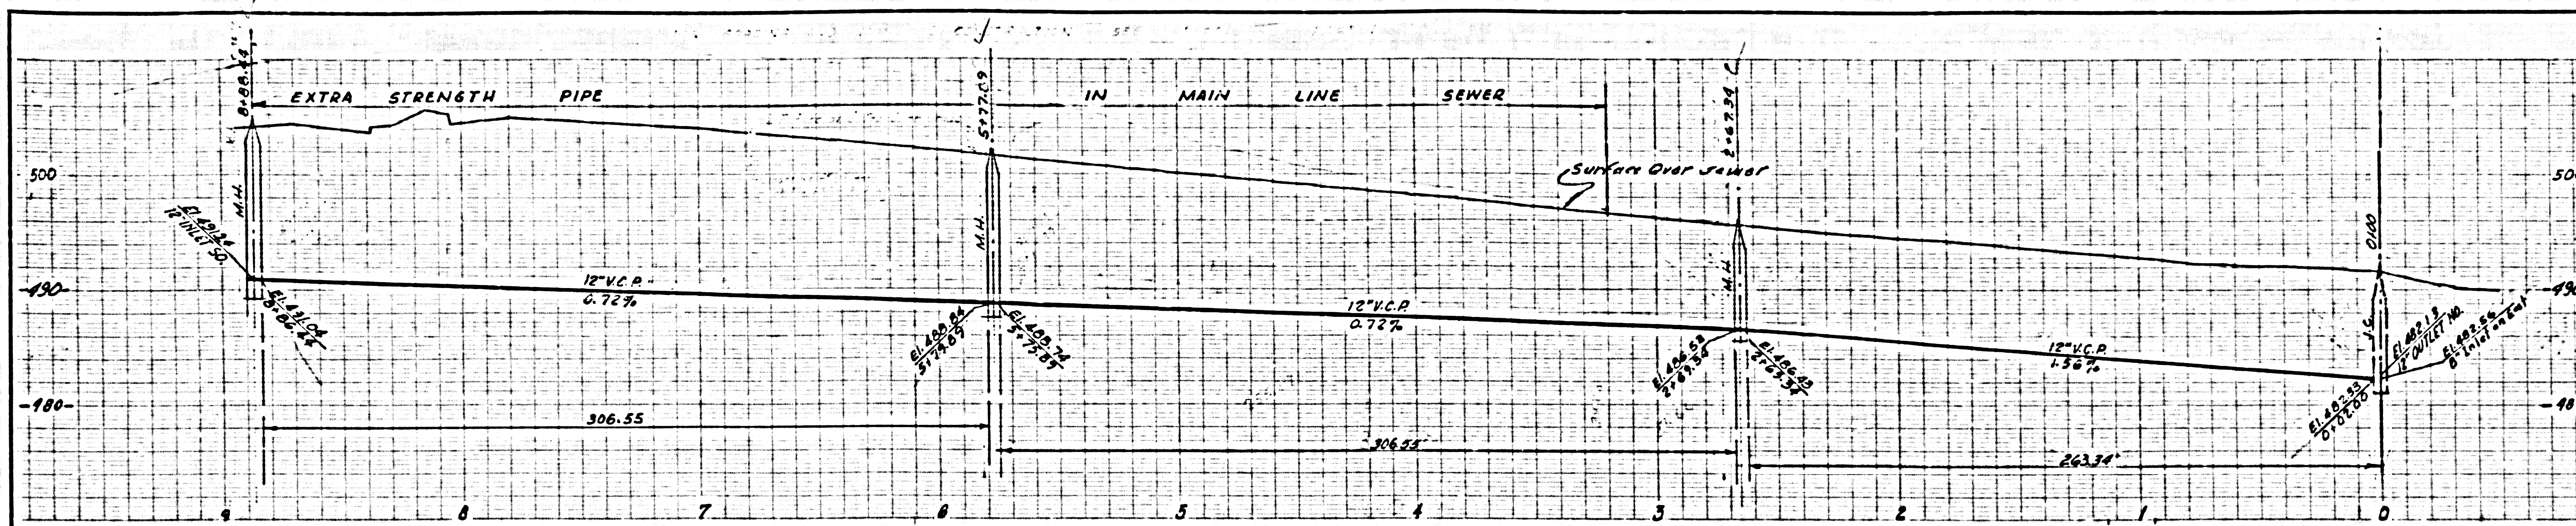


30718

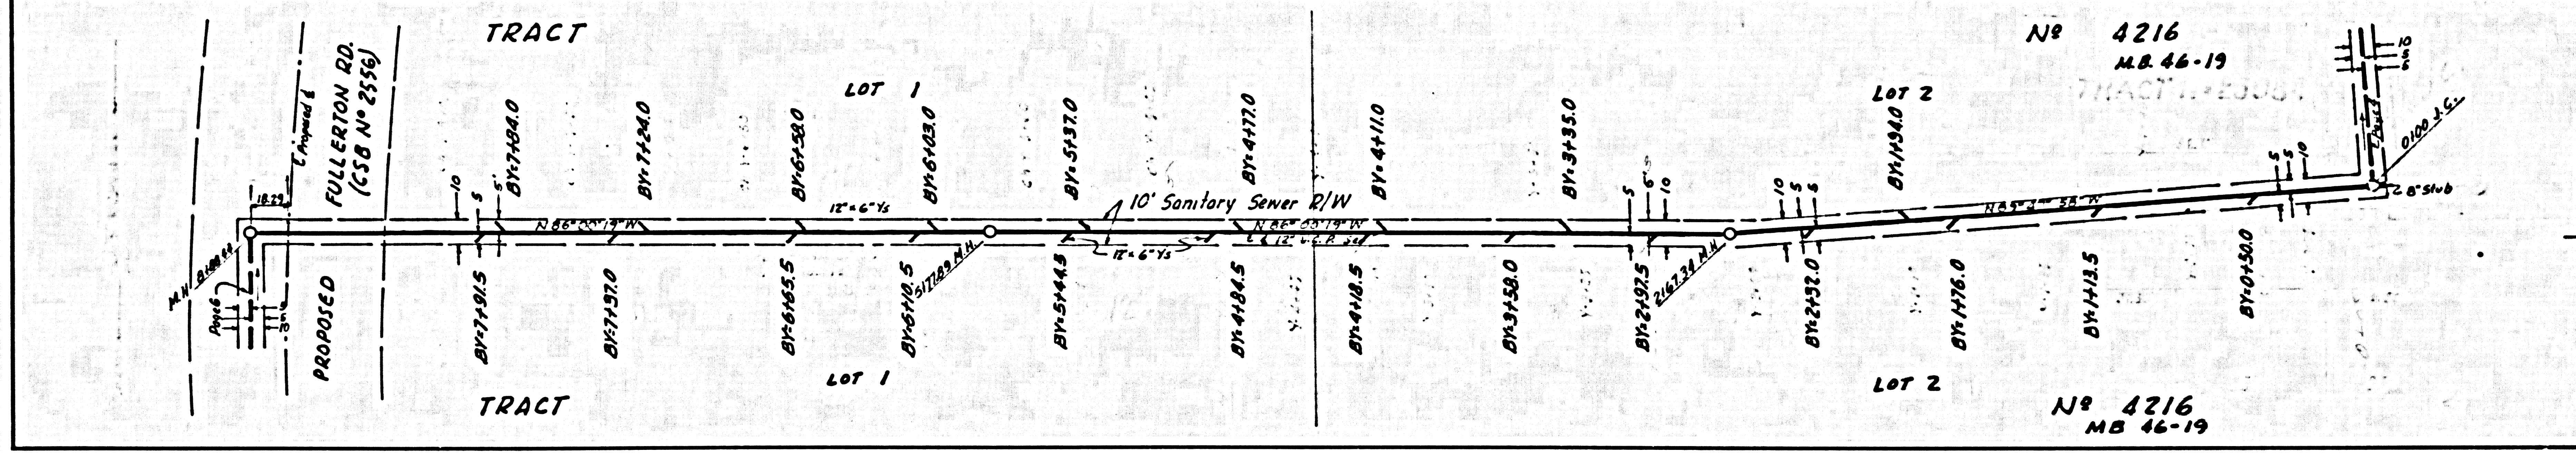


ISSUE NO PERMITS CALL REGIONAL OFFICE
DOUBLE SCALE

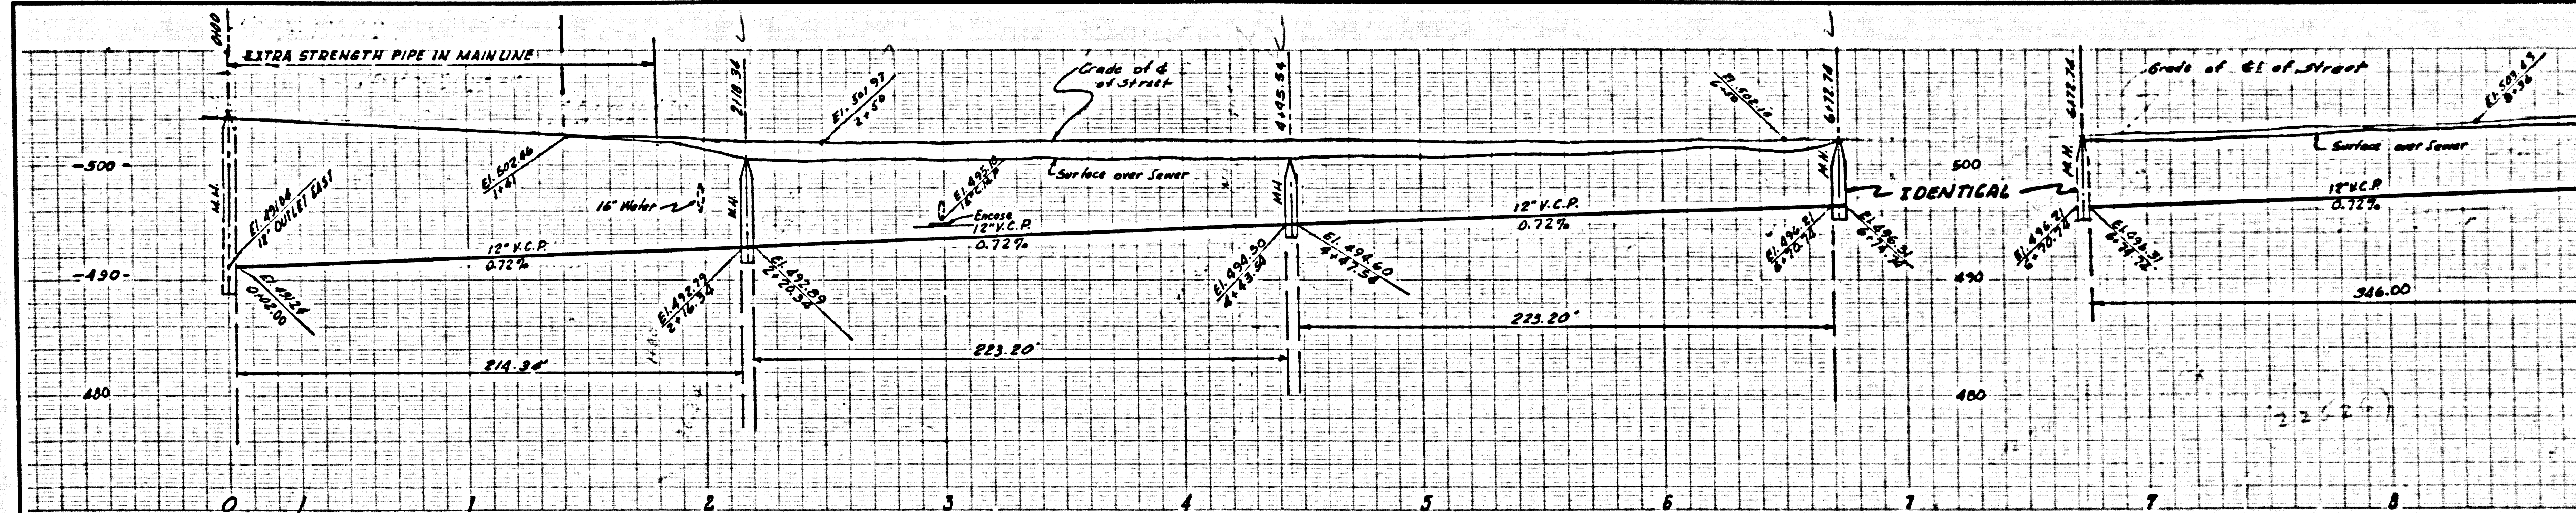

30719



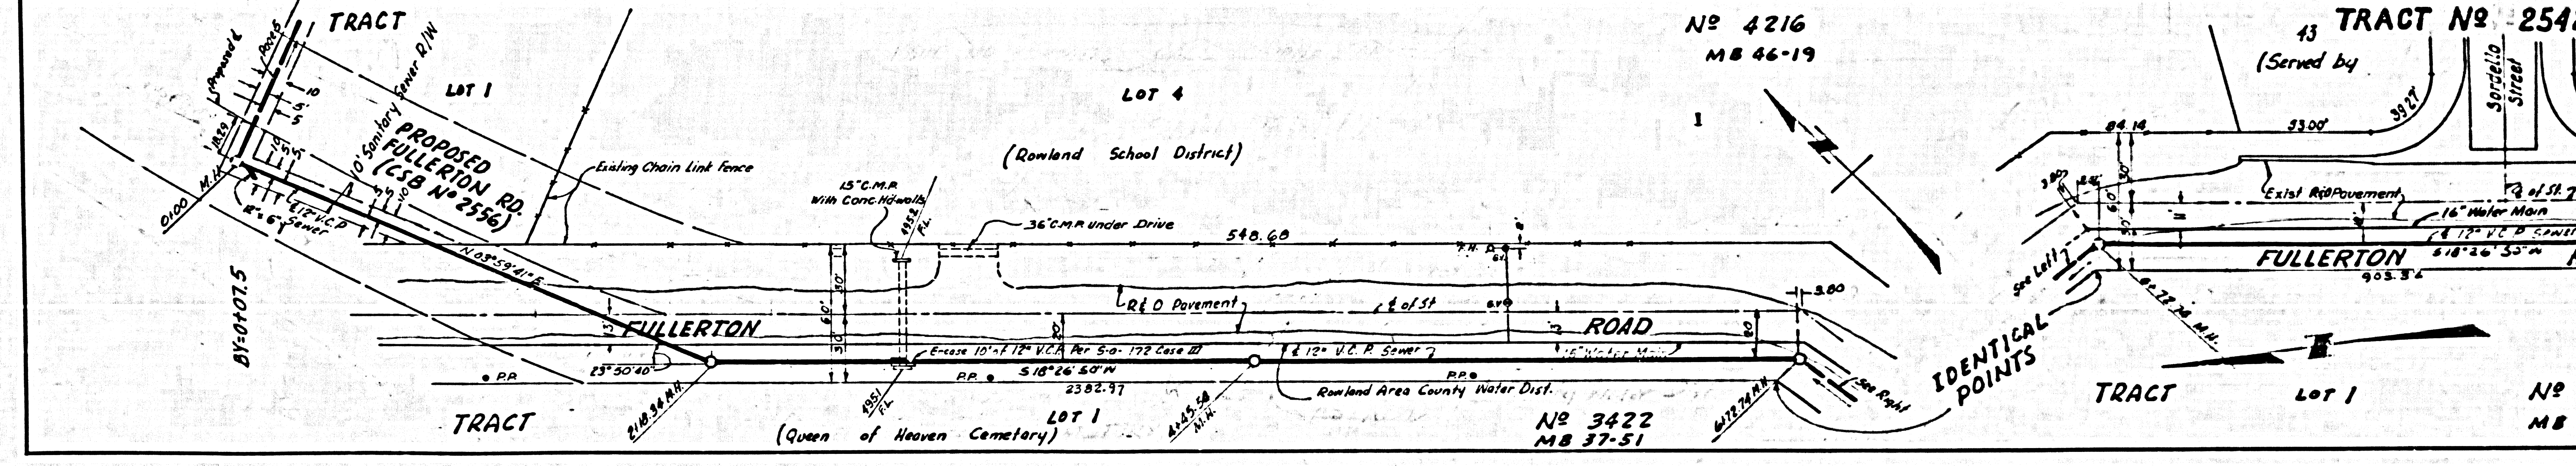


IDENTICAL POINTS

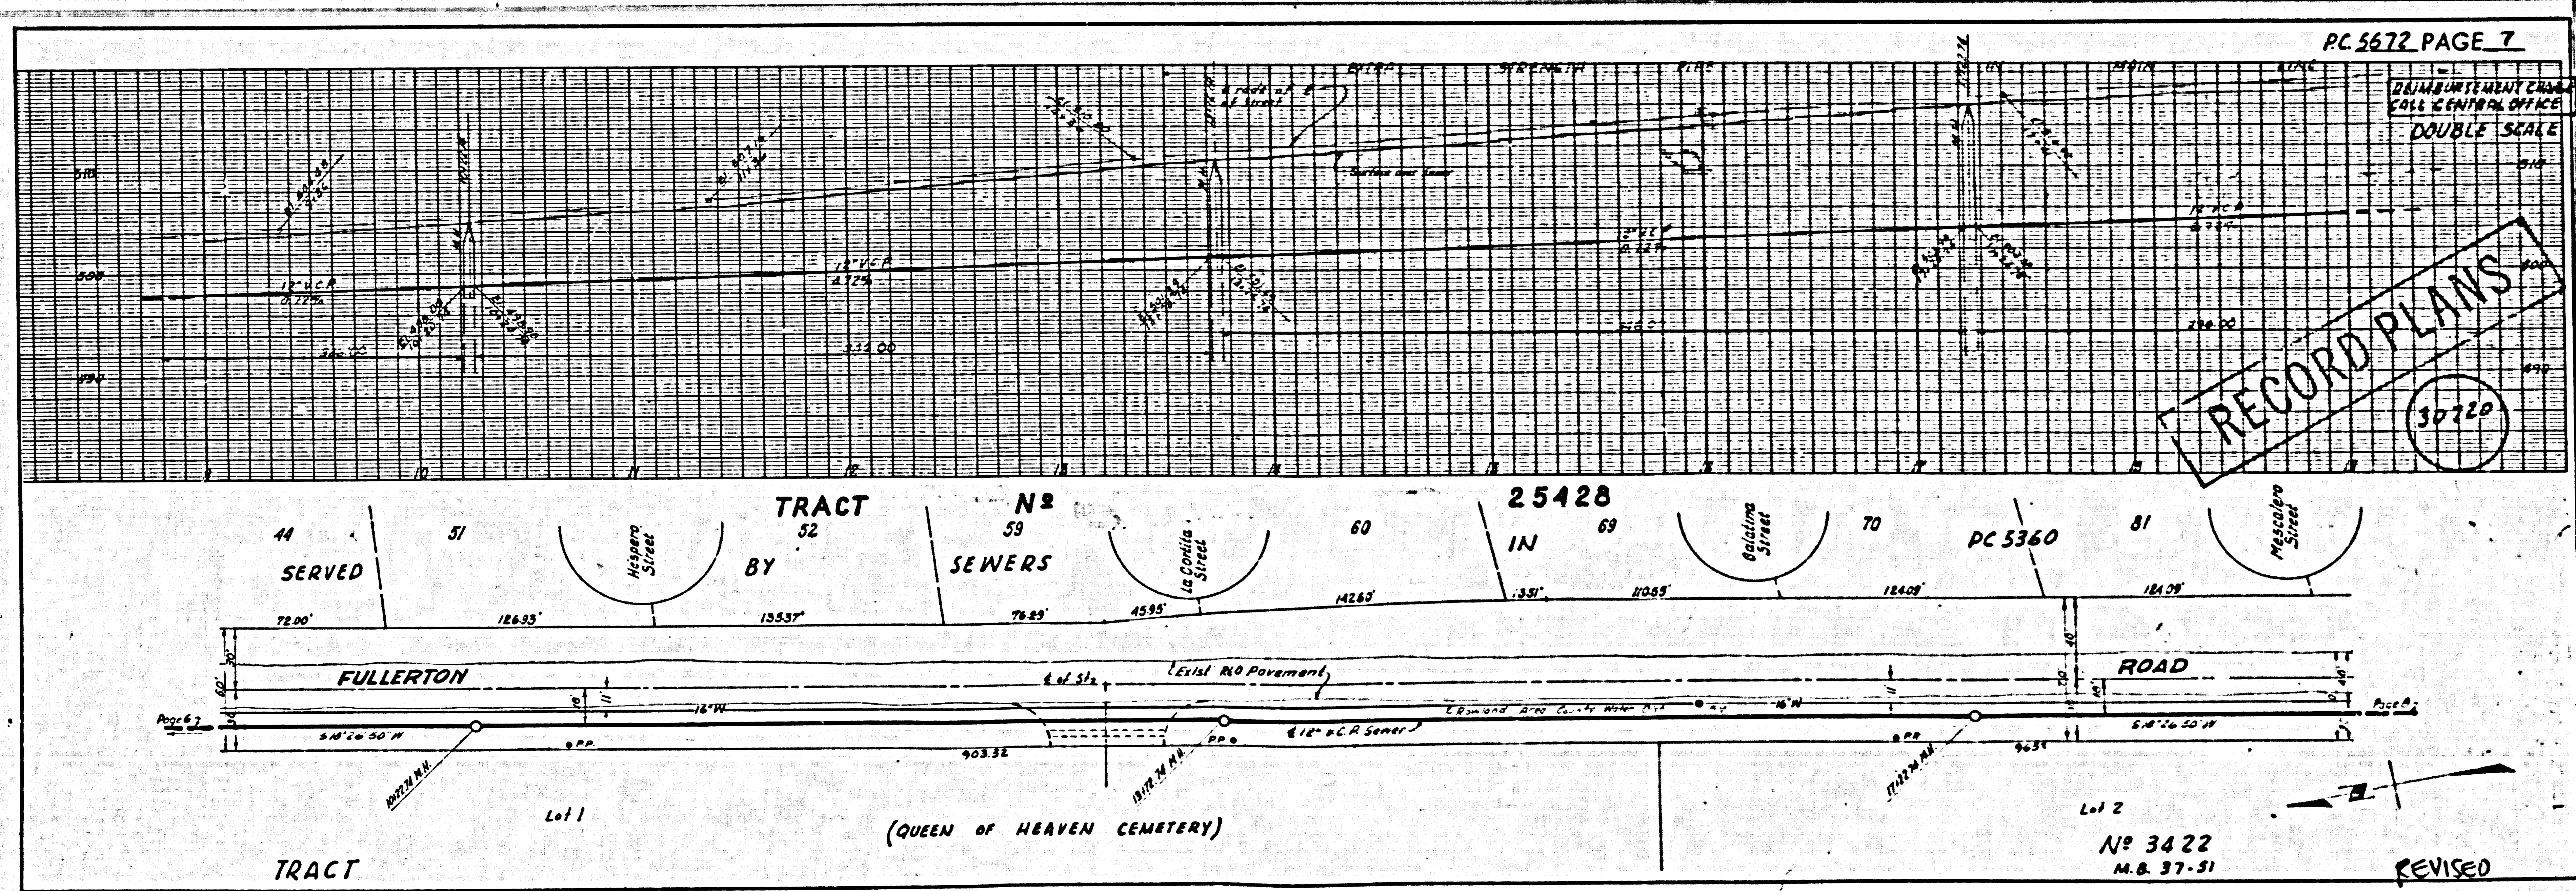

REPAIRMENT WORK
CALL CENTRAL OFFICE

DOUBLE SCALE

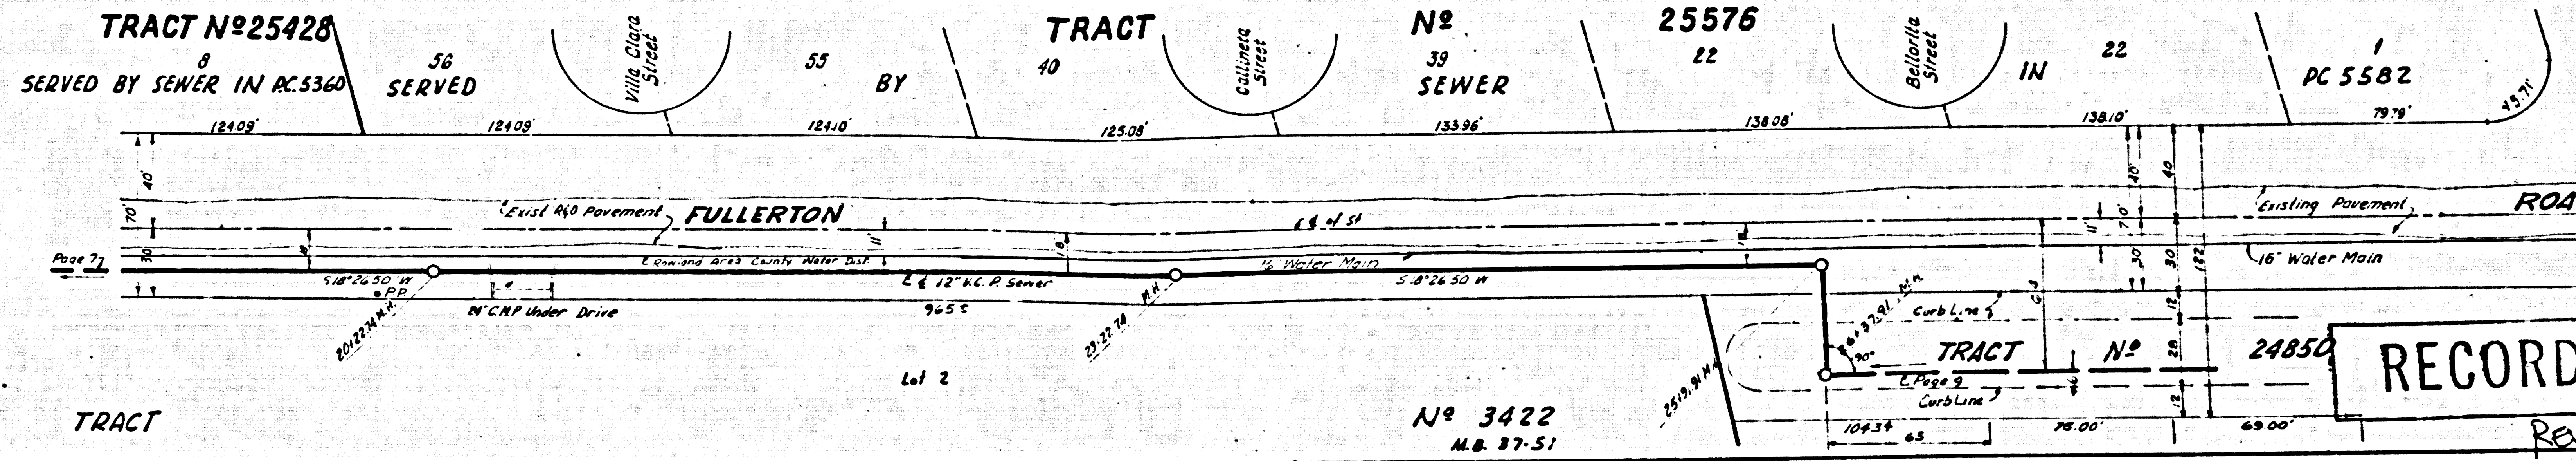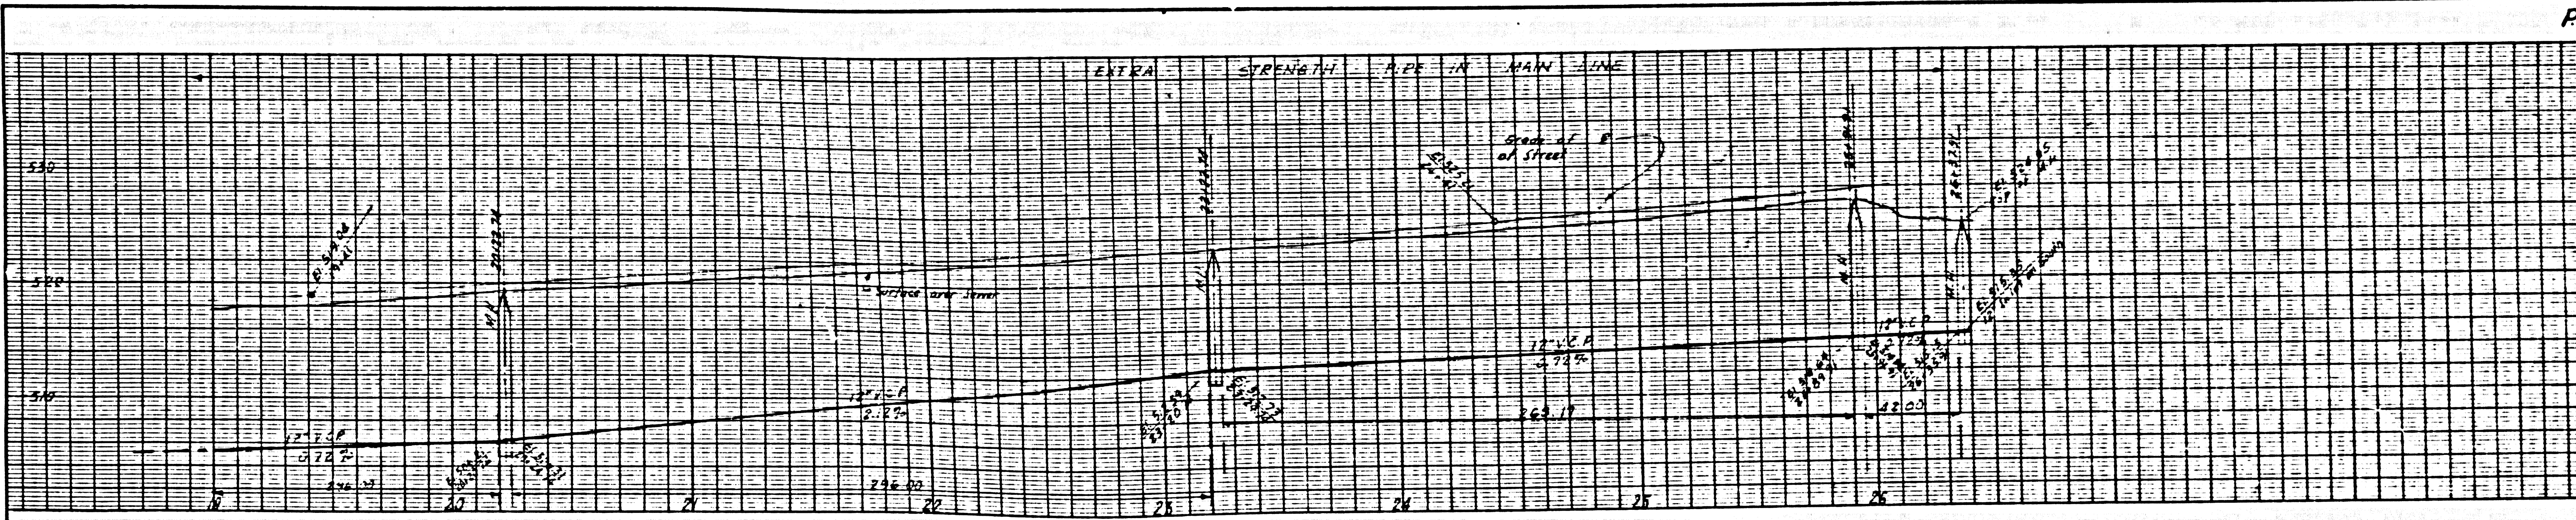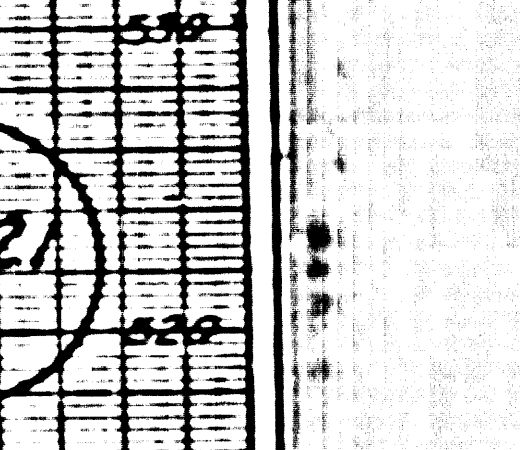

RECORD PLANS

Revised

MS

MS

MS

