

DOUBLE SCALE
CITY OF WALNUT BLDG. DIST. NO. 205

PROFILE ALIGNMENT AND GRADE OF P.C. 6066
SANITARY SEWERS PAGE 1
TO BE CONSTRUCTED IN
TRACT No. 26857 31982

PRIVATE CONTRACT NO. 6066

W.S. 39

8 SHEETS; 13 PAGES

SCALE: VERT. 1" = 4'
HORIZ. 1" = 40' OCTOBER, 1961


PREPARED IN THE OFFICES OF
ENGINEERING SERVICE CORPORATION

By: *R. E. Kuhn* REG. C. E. NO. 3692

FOR LEGEND SEE PLAN NO. S-A-64

BENCH MARK:
B.M. 36. 1881 Beginning @ Int. San Jose Hills Rd & Temple Ave.,
thence N 1/4 along San Jose Hills Rd ± 0.6 mi. ± 30' South approx. &
± 5' S of 3rd pole, a R.D.M. mon. in well 8' dia., 2" 1P, 2'S 3' up
Corina 1955 Elev. 749.14G'

- NOTES:
- PROVIDE STAKES ON THE PROPERTY LINE OR PROPERTY LINES PRODUCED AT RIGHT ANGLES TO THE SEWER LINE AT THE CENTER LINE OF EACH MANHOLE.
 - NO REPRESENTATIVE OF THE CITY ENGINEER WILL SURVEY OR LAYOUT ANY PORTION OF THE WORK.
 - THE OWNER OR HIS AUTHORIZED REPRESENTATIVE SHALL FURNISH THE CITY ENGINEER WITH GRADE SHEETS AND STATION FOR ALL HOUSE LATERALS AND Y BRANCHES AND SHALL PROVIDE STAKES FOR THEM AT THEIR PROPER LOCATIONS WITH STATIONING PLAINLY MARKED. ANY CHANGE IN LOCATION SHALL BE REQUESTED IN WRITING BY THE OWNER OR HIS REPRESENTATIVE.
 - NO REVISIONS SHALL BE MADE IN THESE PLANS WITHOUT THE APPROVAL OF THE CITY ENGINEER.
 - USE STANDARD MANHOLE FRAMES AND COVERS, S.A.117
 - USE EXTRA STRENGTH PIPE ALL PIPE STANDARD DEPTH, EXCEPT AS NOTED.
 - USE CEMENT MORTAR OR "WEDGE-LOCK" OR "SPEED SEAL" FOR ALL V.C.P. JOINTS PER SPECS, SEC. 3B § 3B
 - RESURFACE ALL TRENCH WITHIN PAVED AREA TO MEET L.A. COUNTY ROAD DEPT., OR CALIF. STATE HIGHWAY DEPT. REQUIREMENTS IN ACCORDANCE WITH PERMITS.
 - ENCASE FOUR FEET OF SEWER AT POINTS OF INTERFERENCE WITH POLES, CASE III 5-2-172
 - HOUSE LATERALS TO BE CONSTRUCTED WITH INVERTS AT PROPERTY LINE $\frac{1}{2}$ FEET BELOW CURB GRADE
 - ALL MANHOLES SHALL BE BRICK SEWER STRUCTURES, S.A.104, PRECAST CONCRETE MANHOLES PER S.A.135, OR S.A.173 MAY BE USED AS AN ALTERNATE IN LOCATIONS APPROVED BY THE COUNTY ENGINEER
 - FOR ALLOWABLE LEAKAGE TEST USE FORMULA NO. _____ SPECS., SEC. 54
 - MANHOLE TOPS IN UNIMPROVED RIGHTS-OF-WAY TO BE 6" ABOVE FINISHED GRADE
 - THE PRIVATE ENGINEER IS TO FURNISH THE HOUSE LATERAL DEPTH AT THE PROPERTY LINE BELOW THE TOP OF CURVE ELEVATION FOR EACH HOUSE LATERAL ON THE GRADE SHEET.
 - THE CONTRACTOR SHALL NOTIFY THE CONSTRUCTION DIVISION BY TELEPHONE, MADISON 9-4747, EXT. 21551 AT LEAST 24 HOURS BEFORE STARTING ANY WORK UNDER THIS CONTRACT.
 - STANDARD SPECIFICATIONS DATED OCT. 29, 1961 SHALL APPLY IN THE CONSTRUCTION OF THIS PROJECT.
 - WHERE NOTED ON PLANS CONSTRUCT H.L. PER S-2-172, CASE III AND ENCASE PER CASE III, 5-2-172

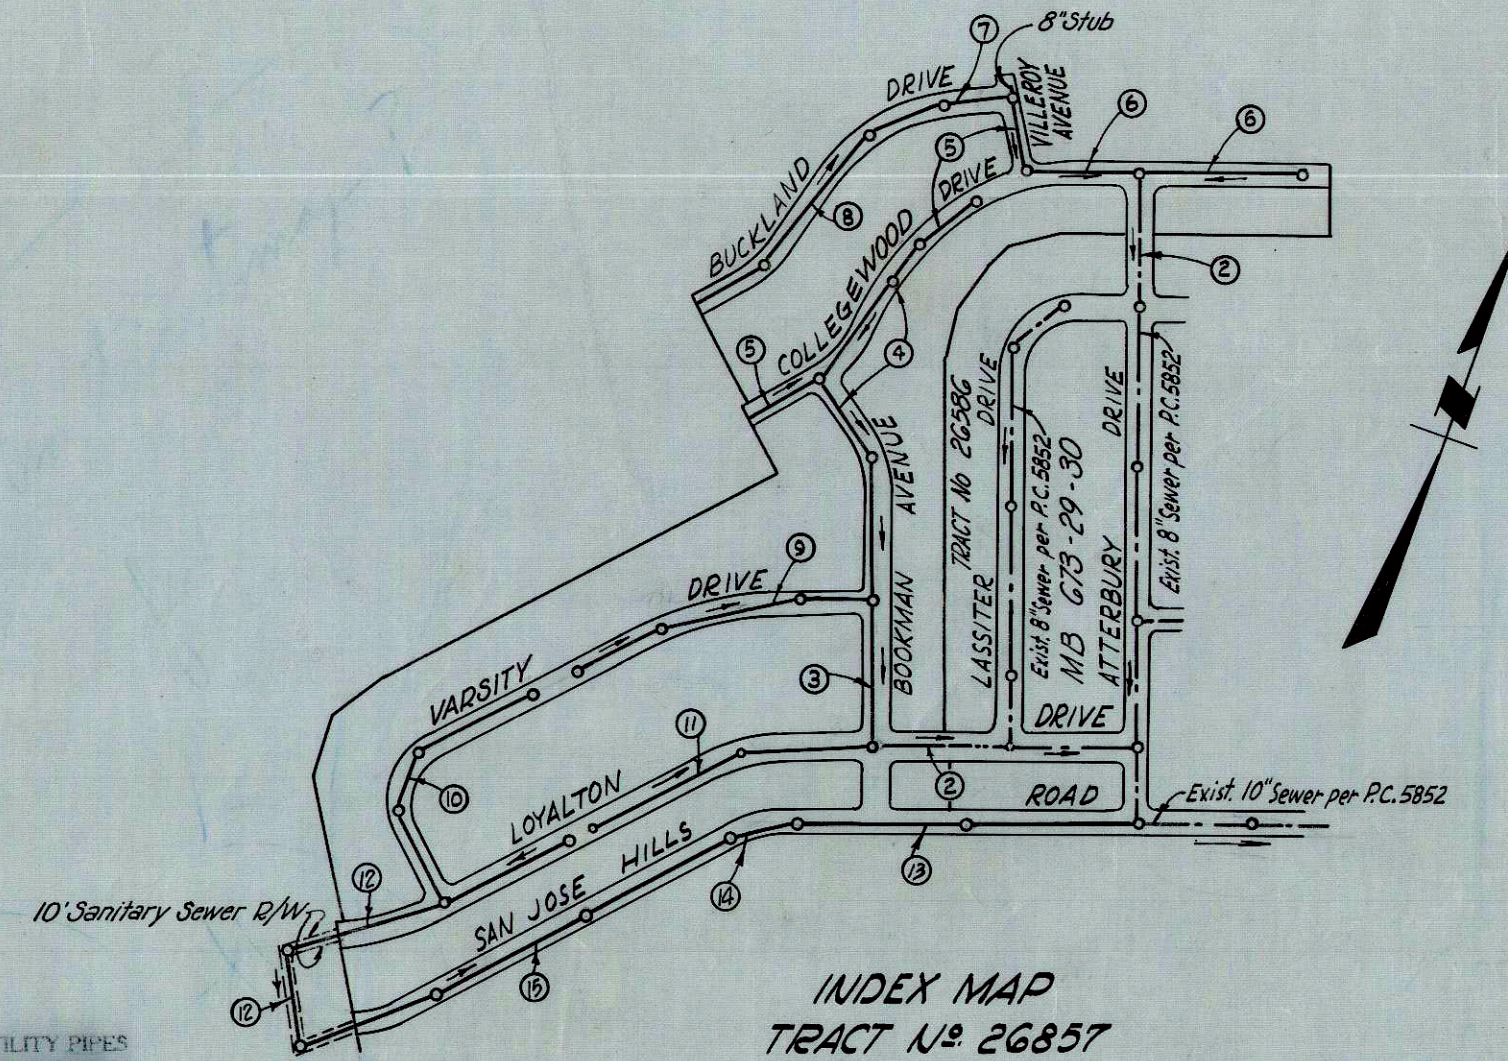

COLLECT CHARGES AS INDICATED, SCHOOL ACCEPANCE REIMBURSEMENT TO BE PAID TO THE CITY OF WALNUT BEFORE PERMIT IS ISSUED.
St. Under 1-15-62

ENGINEERING SERVICE CORPORATION
1127 W. WASHINGTON BLVD. RI. 9-7281

REVISIONS		TRACED BY <i>F.B.</i>			
		DES'G'D BY <i>C.T.A.</i>			
		CK'D BY <i>A.A.M.</i>			
		SUBMITTED			
SUB STRUCTURES OK'D					
W. O. NO.	DWG. NO.	DATE	SCALE	L. B.	F. B.
6066-65		10-61	AS NOTED		

PRIVATE ENGINEERS
NOTICE TO CONTRACTOR
THE EXISTENCE AND LOCATION OF ANY UNDERGROUND UTILITY PIPES OR STRUCTURES SHOWN ON THESE PLANS ARE OBTAINED BY A SEARCH OF THE AVAILABLE RECORDS. TO THE BEST OF OUR KNOWLEDGE THERE ARE NO EXISTING UTILITIES EXCEPT AS SHOWN ON THIS MAP. THE CONTRACTOR IS REQUIRED TO TAKE PRECAUTIONARY MEASURES TO PROTECT THE UTILITY LINES SHOWN AND ANY OTHER LINES NOT OF RECORD OR NOT SHOWN ON THIS DRAWING.

NO CONNECTIONS FOR THE DISPOSAL OF INDUSTRIAL WASTES SHALL BE MADE TO SEWERS SHOWN ON THESE DRAWINGS WITHOUT WRITTEN PERMISSION FROM THE CHIEF ENGINEER AND GENERAL MANAGER OF THE COUNTY SANITATION DISTRICTS.


NOTES:
GRADES TO WHICH THIS IMPROVEMENT IS TO BE CONSTRUCTED ARE SHOWN ON PLANS AND PROFILES. GRADE POINTS FOR TOP OF CURBS, CENTER LINE OF STREETS, OR CENTER LINE OF ALLEYS ARE SHOWN BY CIRCLES ON PROFILES. AT ALL POINTS BETWEEN DESIGNATED POINTS THE GRADE SHALL BE ESTABLISHED SO AS TO CONFORM TO A STRAIGHT LINE DRAWN BETWEEN SAID DESIGNATED POINTS.
ELEVATIONS ARE IN FEET ABOVE U.S.C. & G.S. SEA LEVEL DATUM OF 1929.
THIS DRAWING AND THE DATA HEREON ARE HEREBY MADE A PART OF THE SPECIFICATIONS.
BEFORE WORK CAN BE STARTED, THE CONTRACTOR MUST OBTAIN A PERMIT TO EXCAVATE IN CITY STREETS FROM THE DIST. OFFICE NO. 1 AND PAY A FEE TO THE CITY OF WALNUT, 20334 CARREY ROAD, CITY OF WALNUT. SUFFICIENT TO COVER THE COST OF CONSTRUCTION INSPECTION AND RECORD PLANS.
APPROVAL OF THIS PLAN BY THE CITY OF WALNUT DOES NOT CONSTITUTE A REPRESENTATION AS TO THE ACCURACY OF THE LOCATION OF OR THE EXISTENCE OR NON-EXISTENCE OF ANY UNDERGROUND UTILITY PIPE, OR STRUCTURE WITHIN THE LIMITS OF THIS PROJECT. THIS NOTE APPLIES TO ALL PAGES.
IF WORK IS TO BE DONE IN A STATE HIGHWAY, A PERMIT MUST BE OBTAINED FROM THE STATE OF CALIFORNIA, DIVISION OF HIGHWAYS, 120 SOUTH SPRING STREET.

CITY OF WALNUT CALIFORNIA
APPROVED, JOHN A. LAMBIE, CITY ENGINEER
APPROVED, J.D. DAWKINER, CHIEF ENGINEER
By: *Richard E. Kuhn* ASST. SANITATION ENGINEER
By: *J. Posthumus* OFFICE ENGINEER
CHECKED BY: *St. Under 1-15-62*
OFFICE OF CITY ENGINEER, REG. C. E. NO. 9406
SUBMITTED *W.C. Reinhardt* SAN DIMAS REGIONAL ENGINEER

AS-BUILT


DOUBLE SCALE
NO CHARGE FOR CONNECTIONS

31983

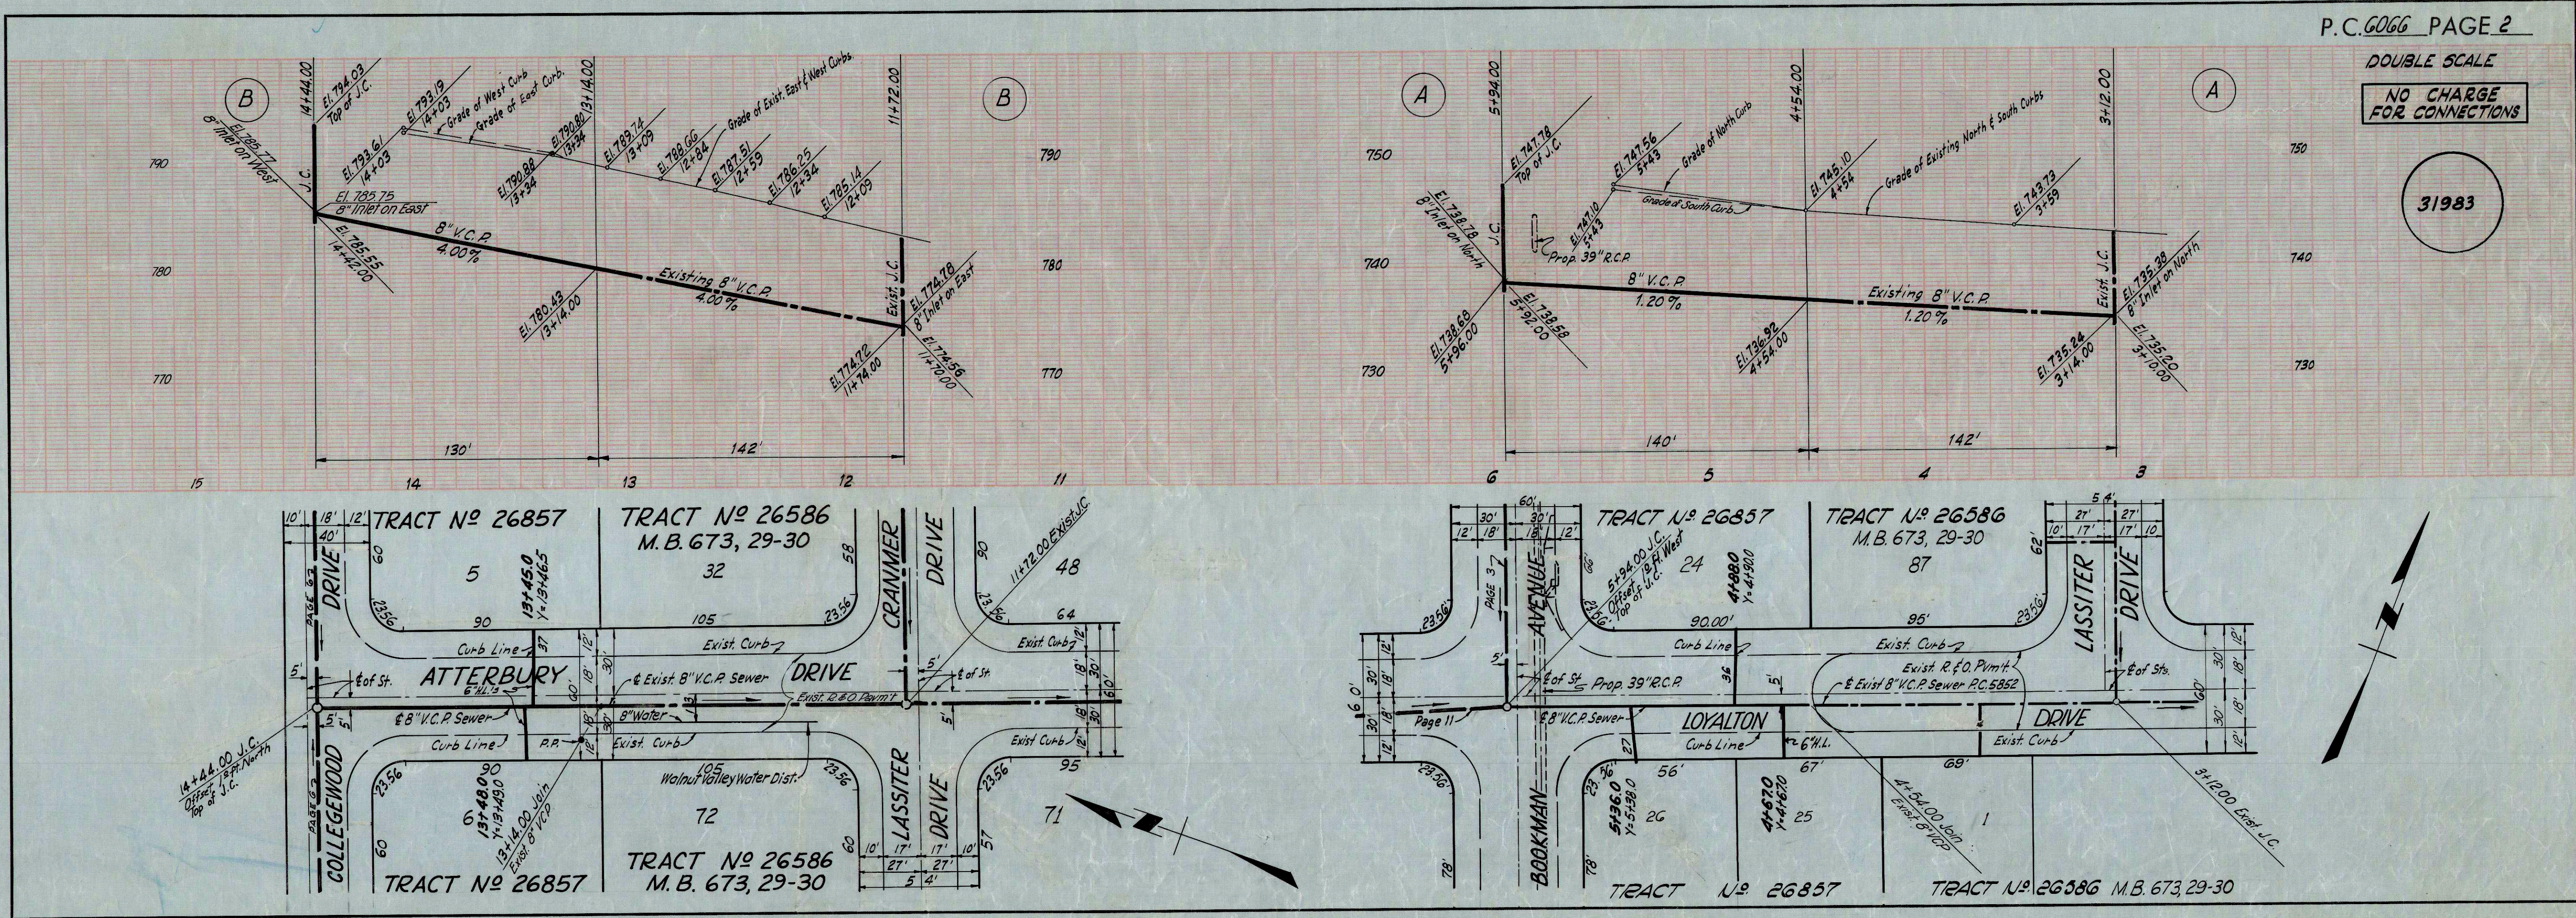


DOUBLE SCALE
NO CHARGE FOR
CONNECTIONS

31984

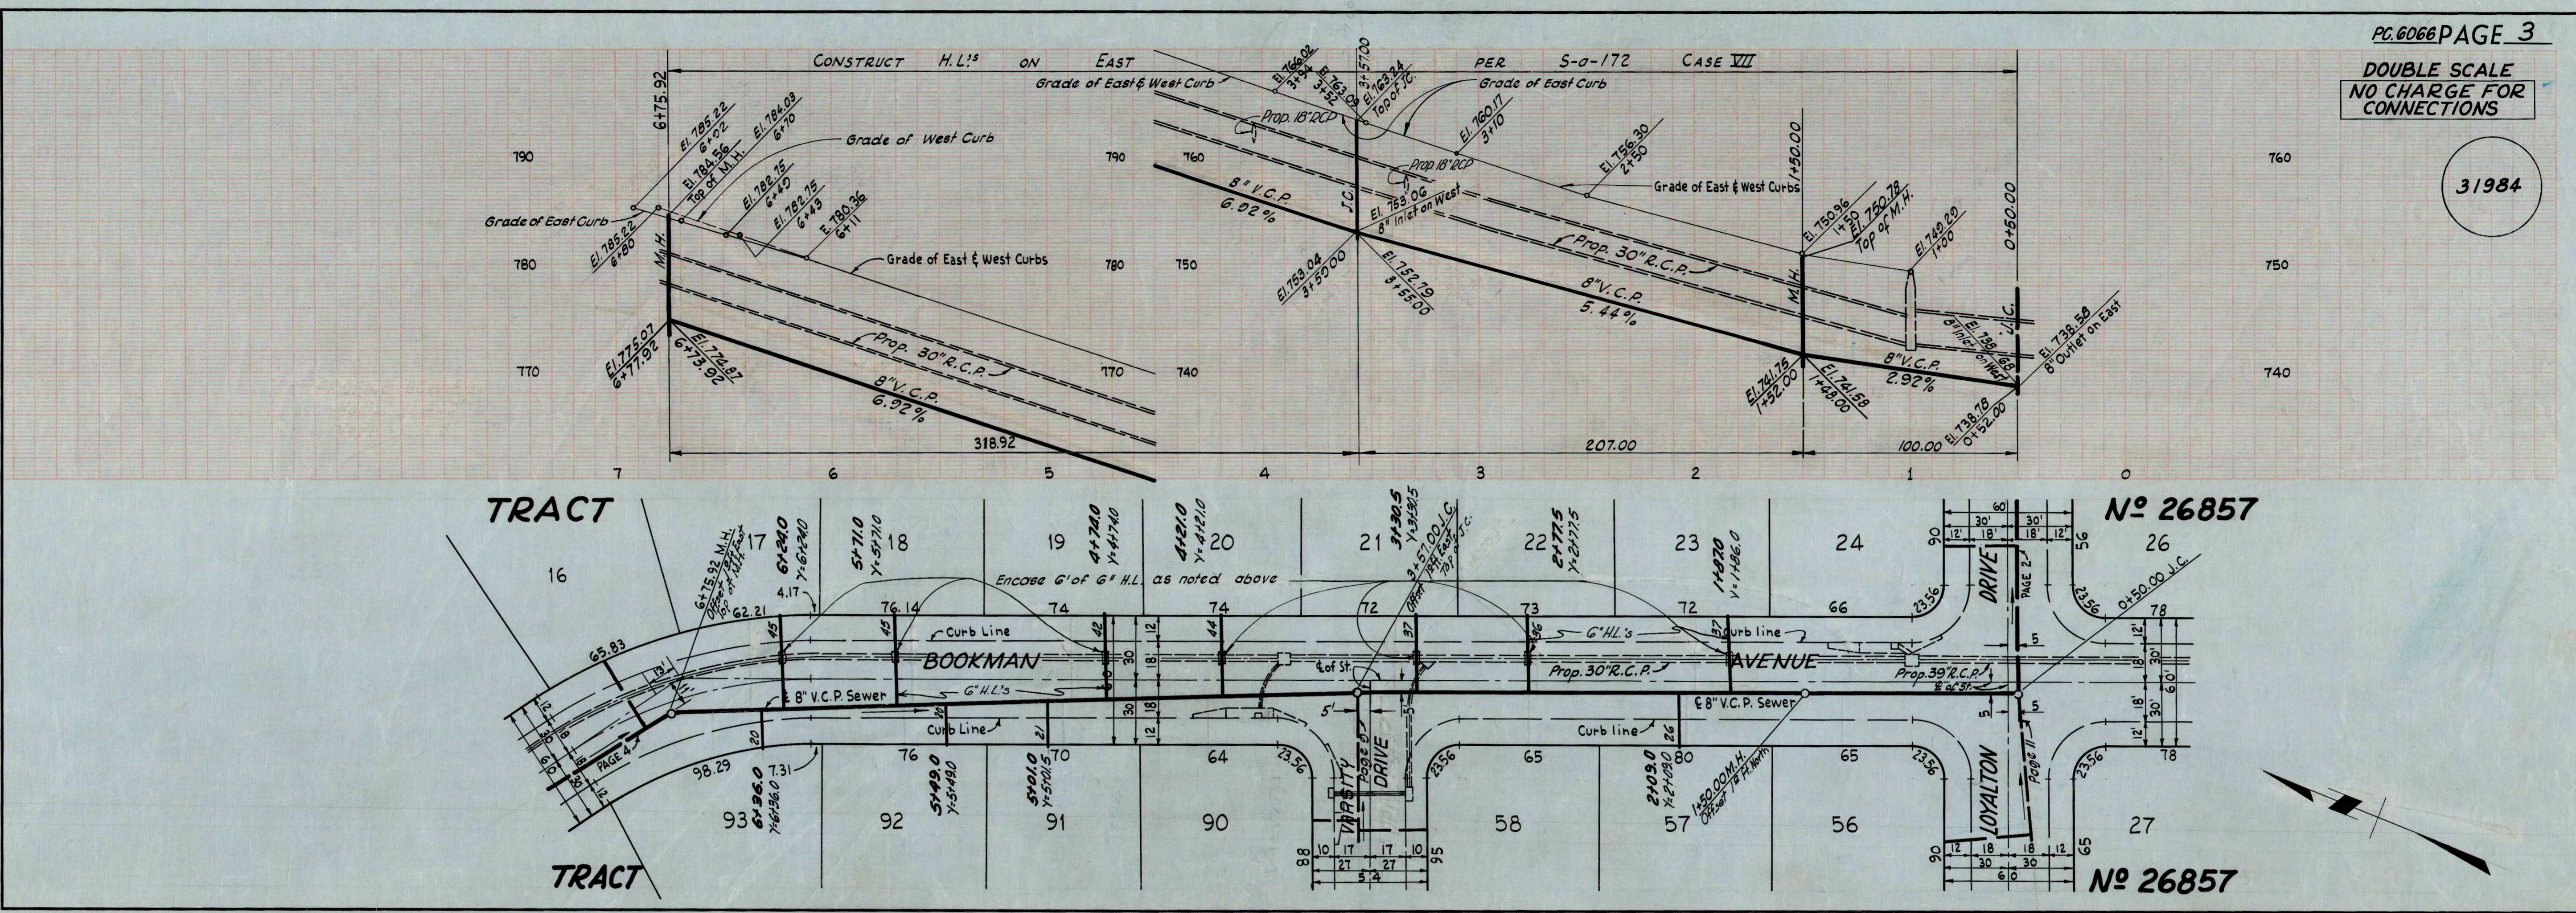


DOUBLE SCALE
NO CHARGE FOR
CONNECTIONS

31985

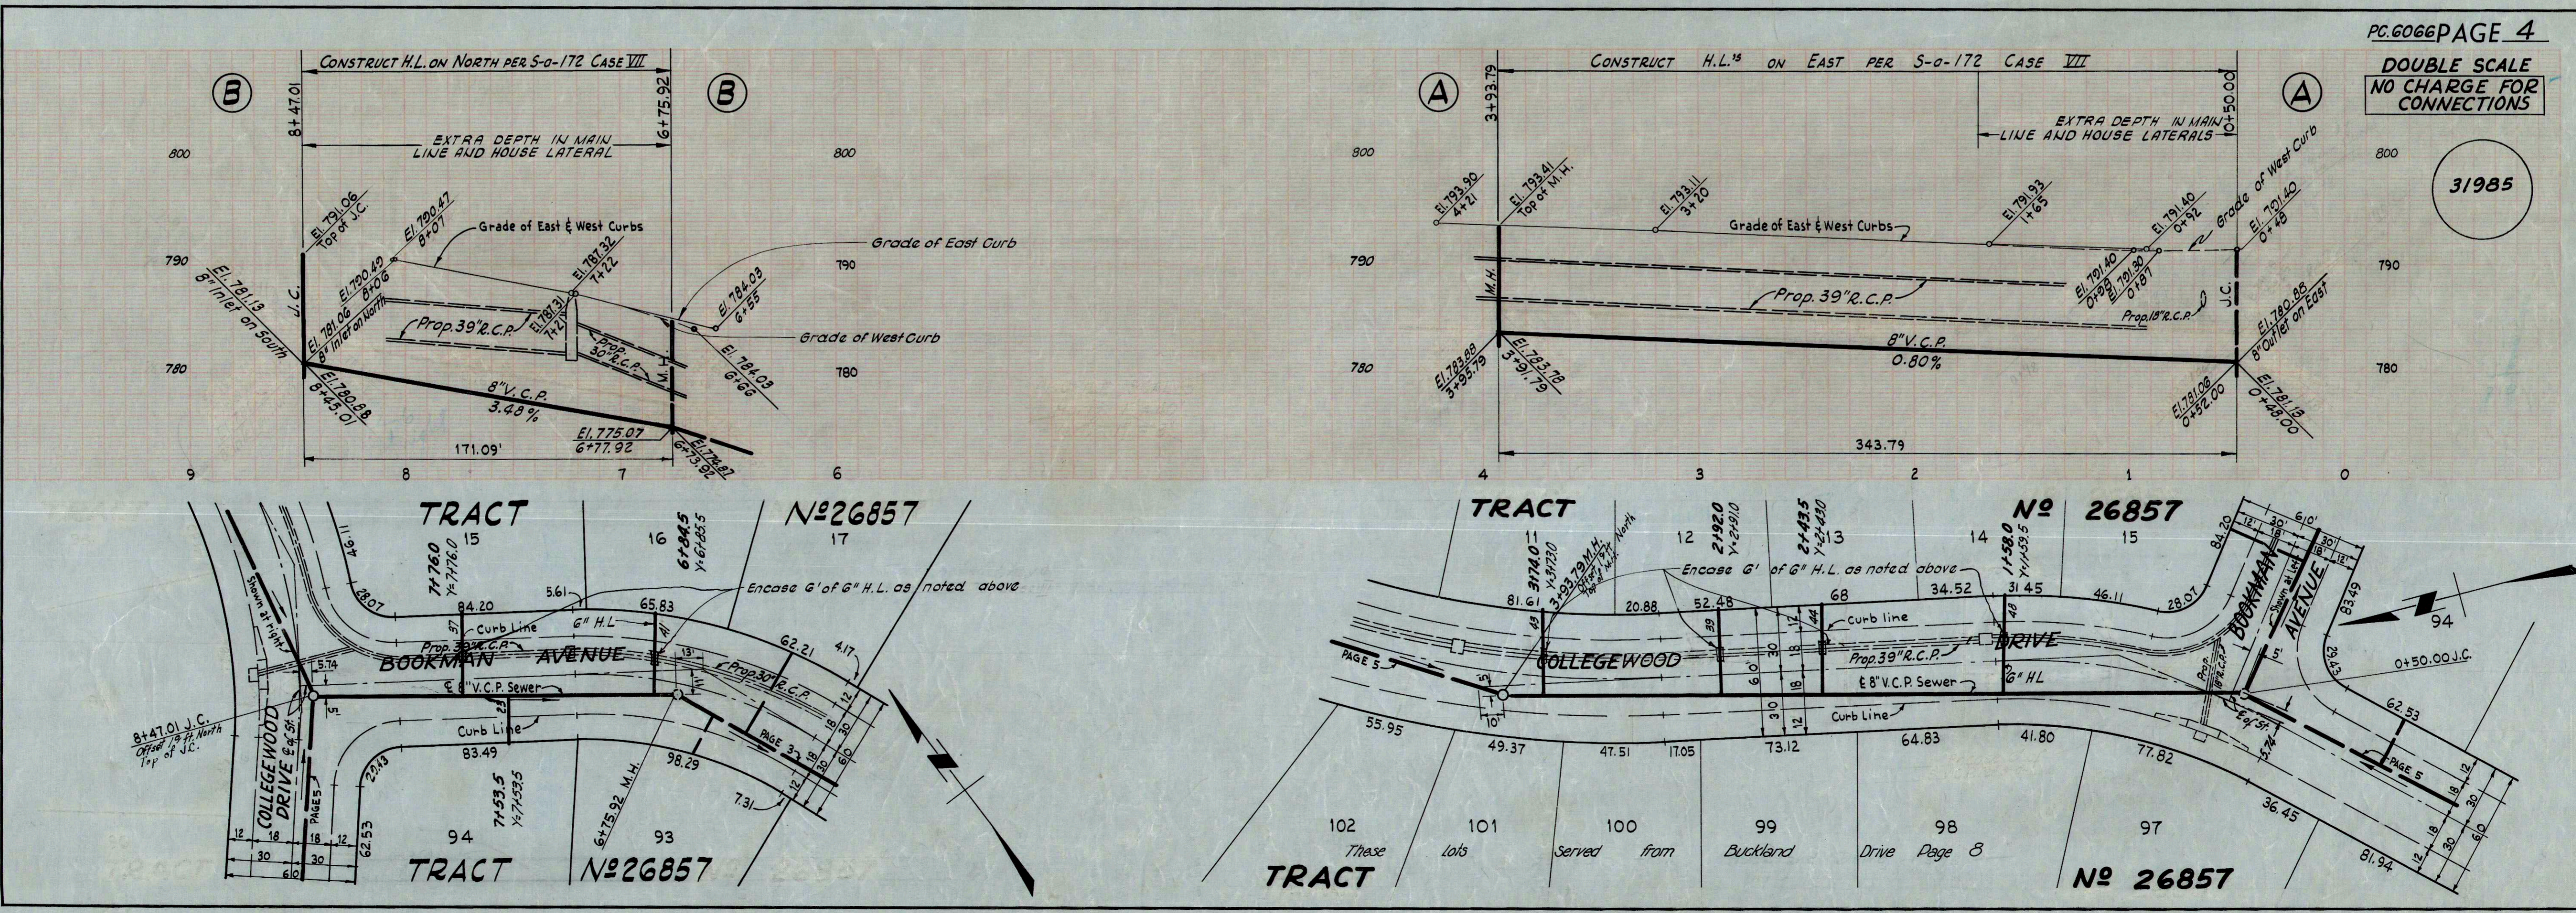


DOUBLE SCALE
COLLECT CHARGES
AS INDICATED

31986

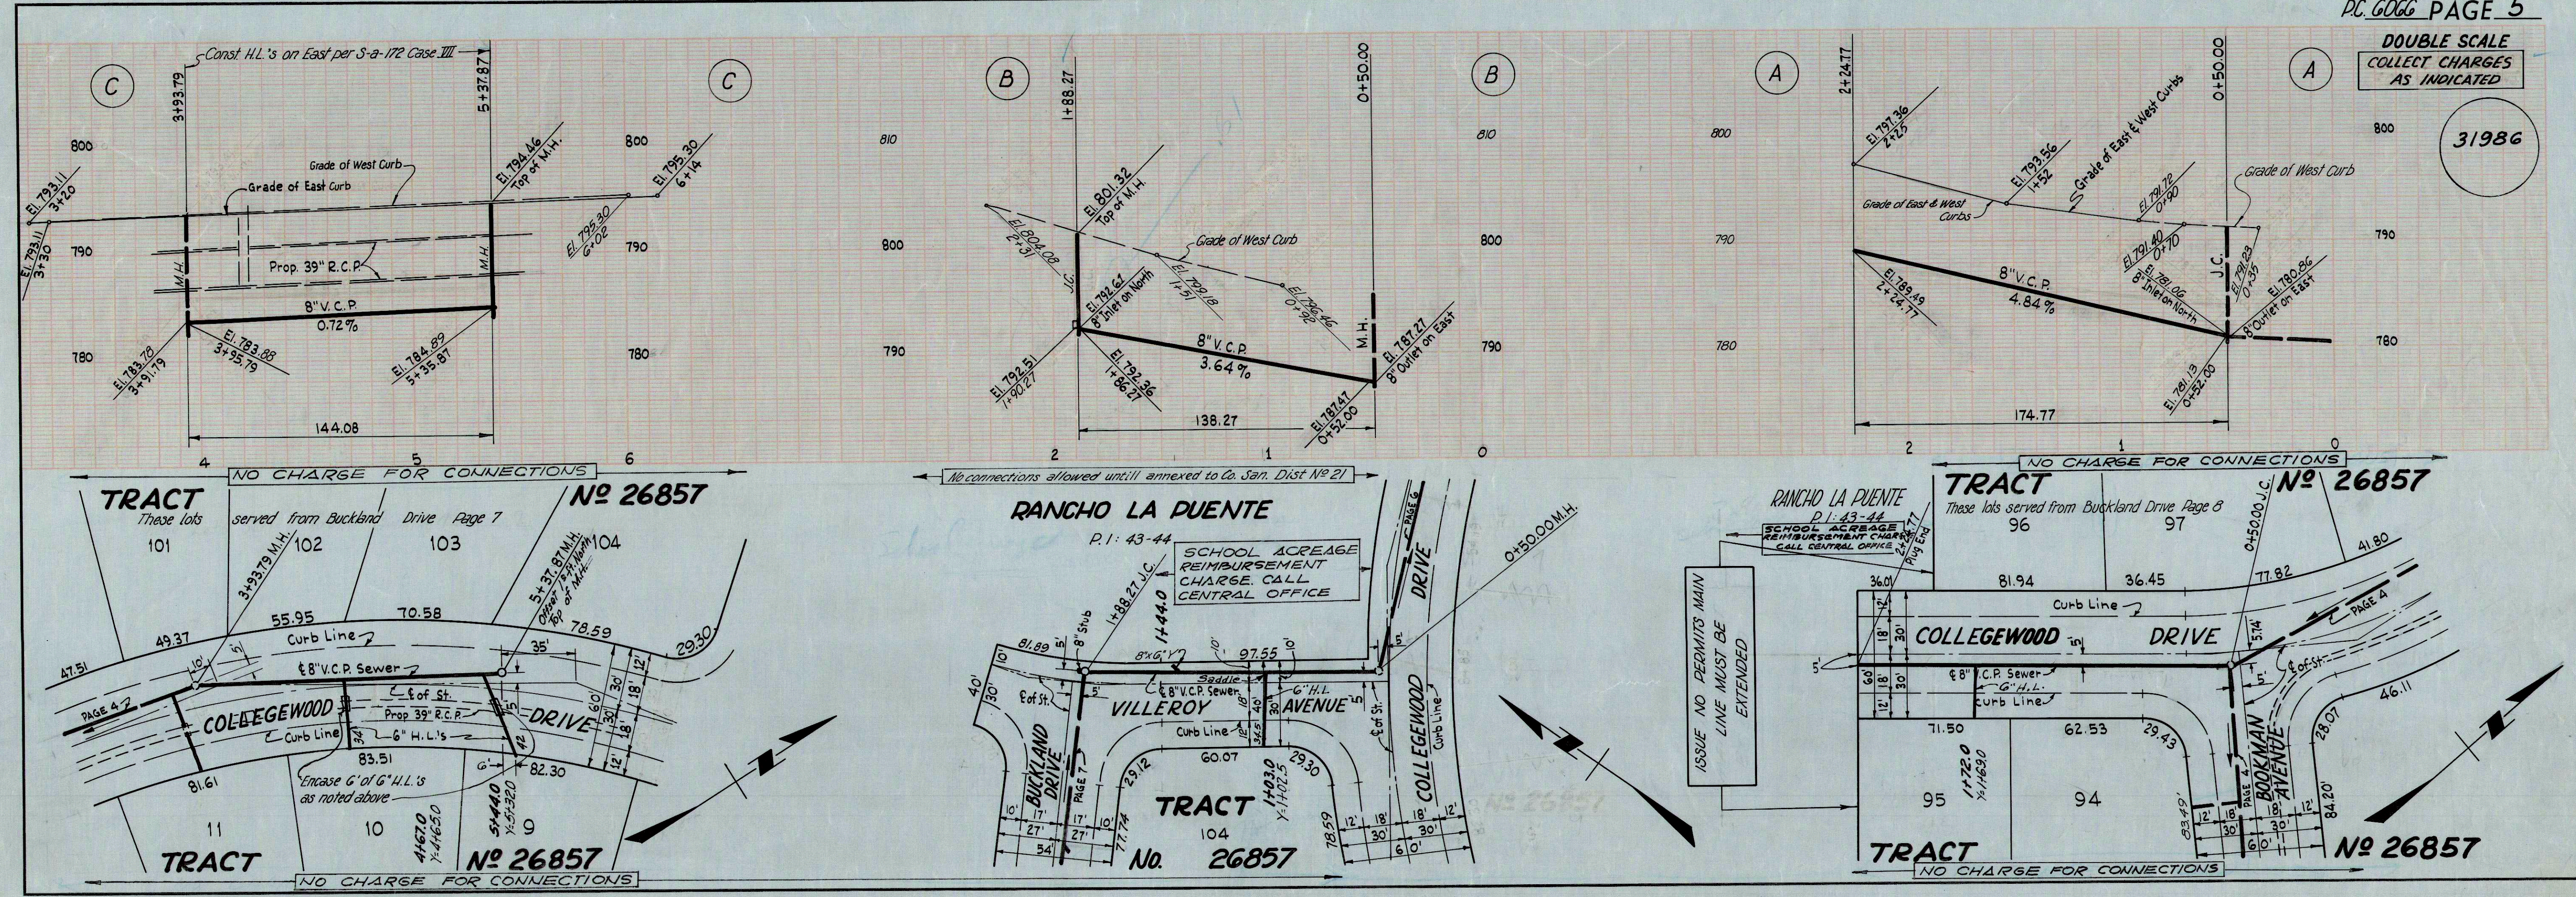




DOUBLE SCALE
COLLECT CHARGES
AS INDICATED

31987

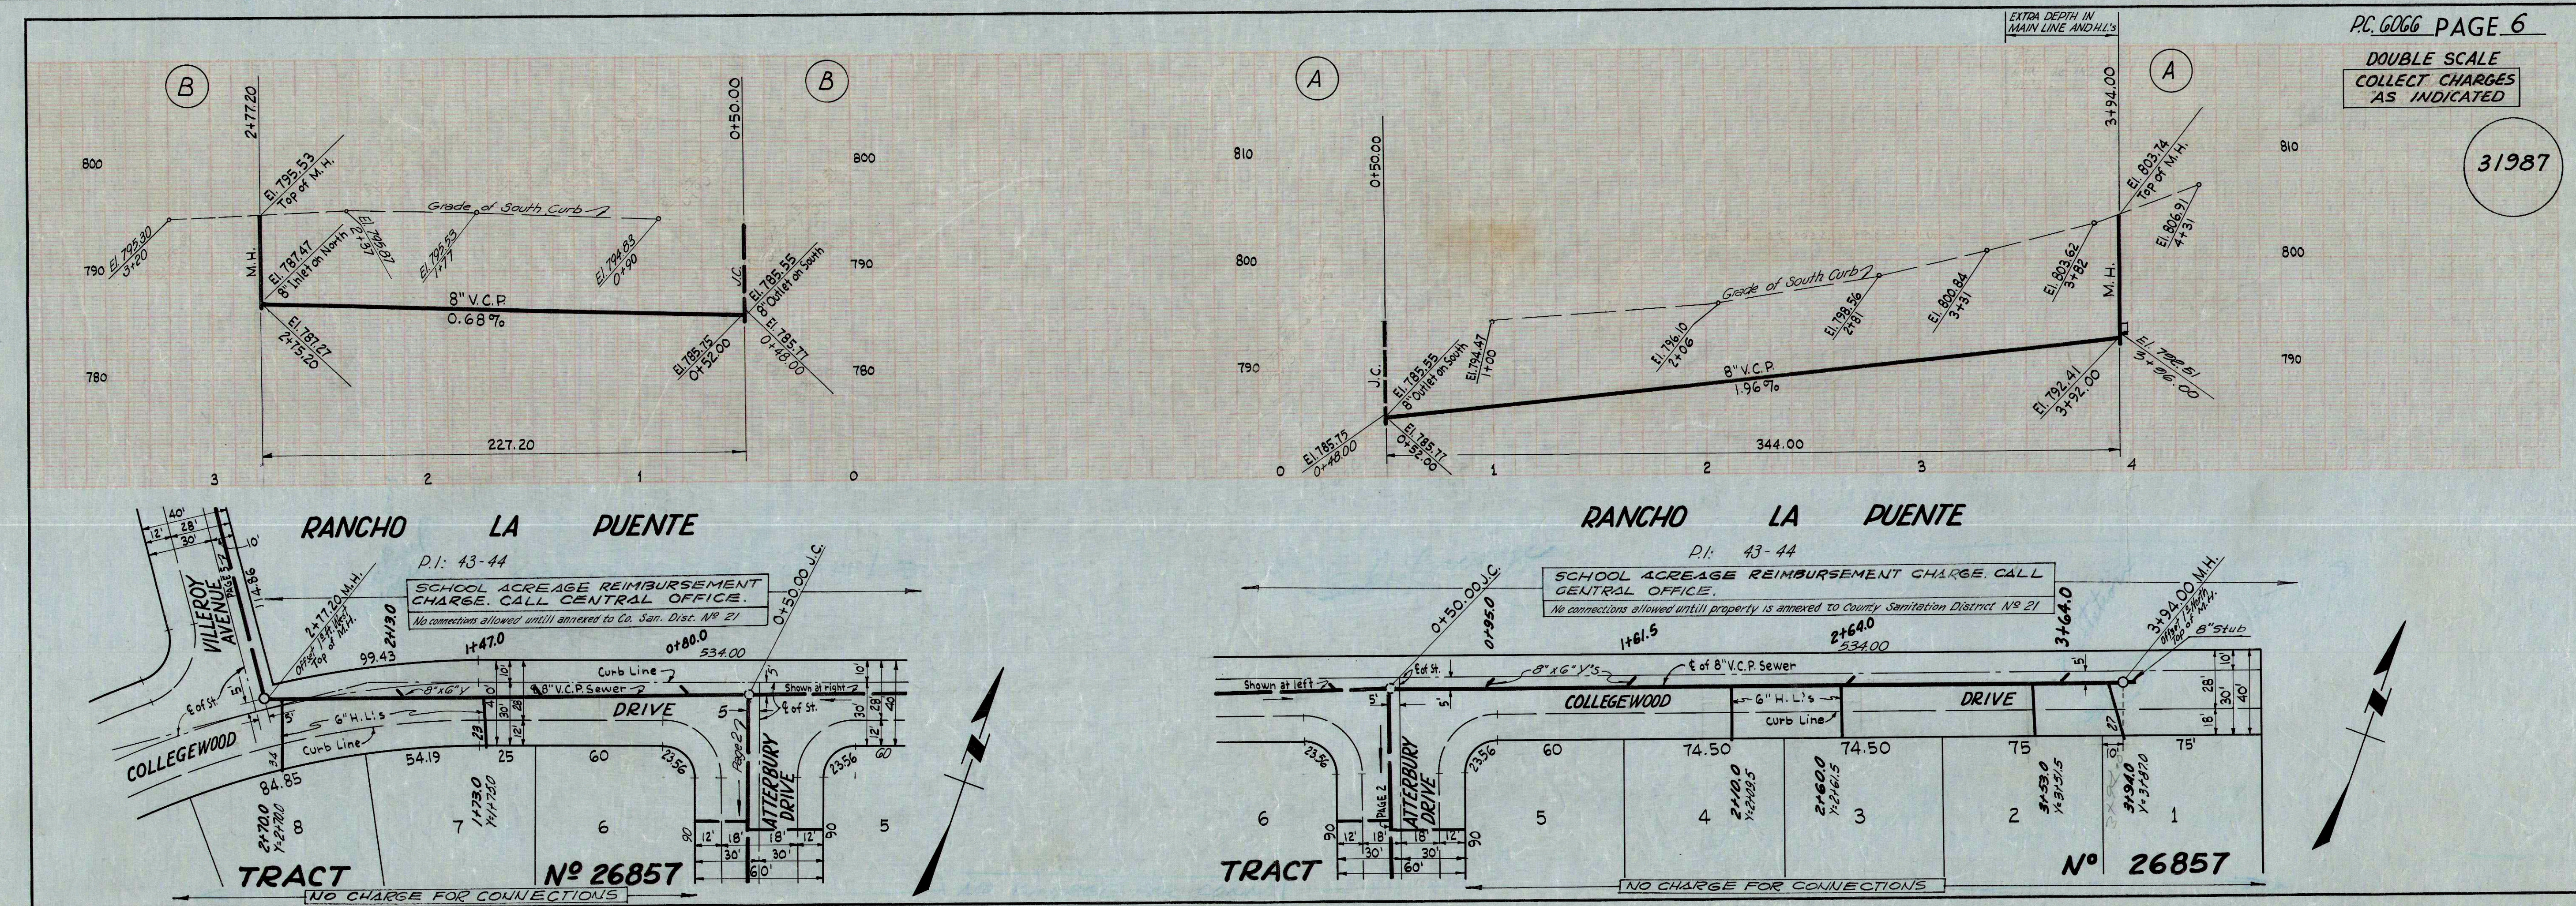




DOUBLE SCALE
COLLECT CHARGES
AS INDICATED

31988

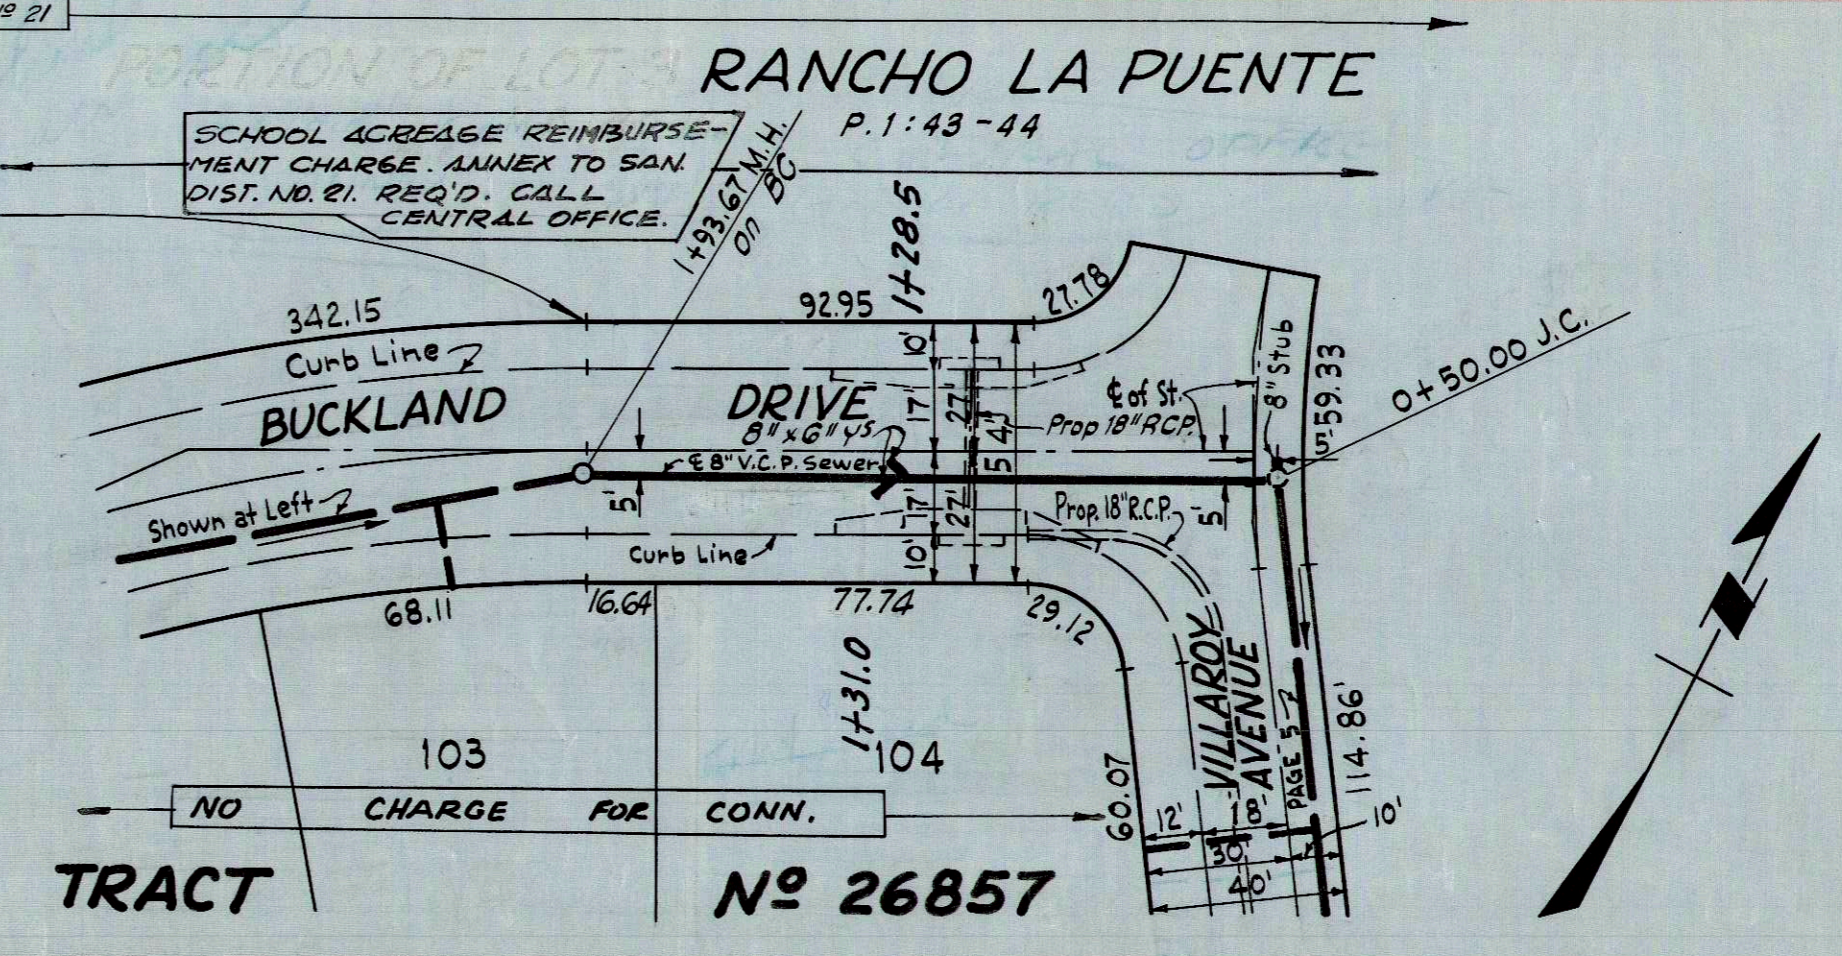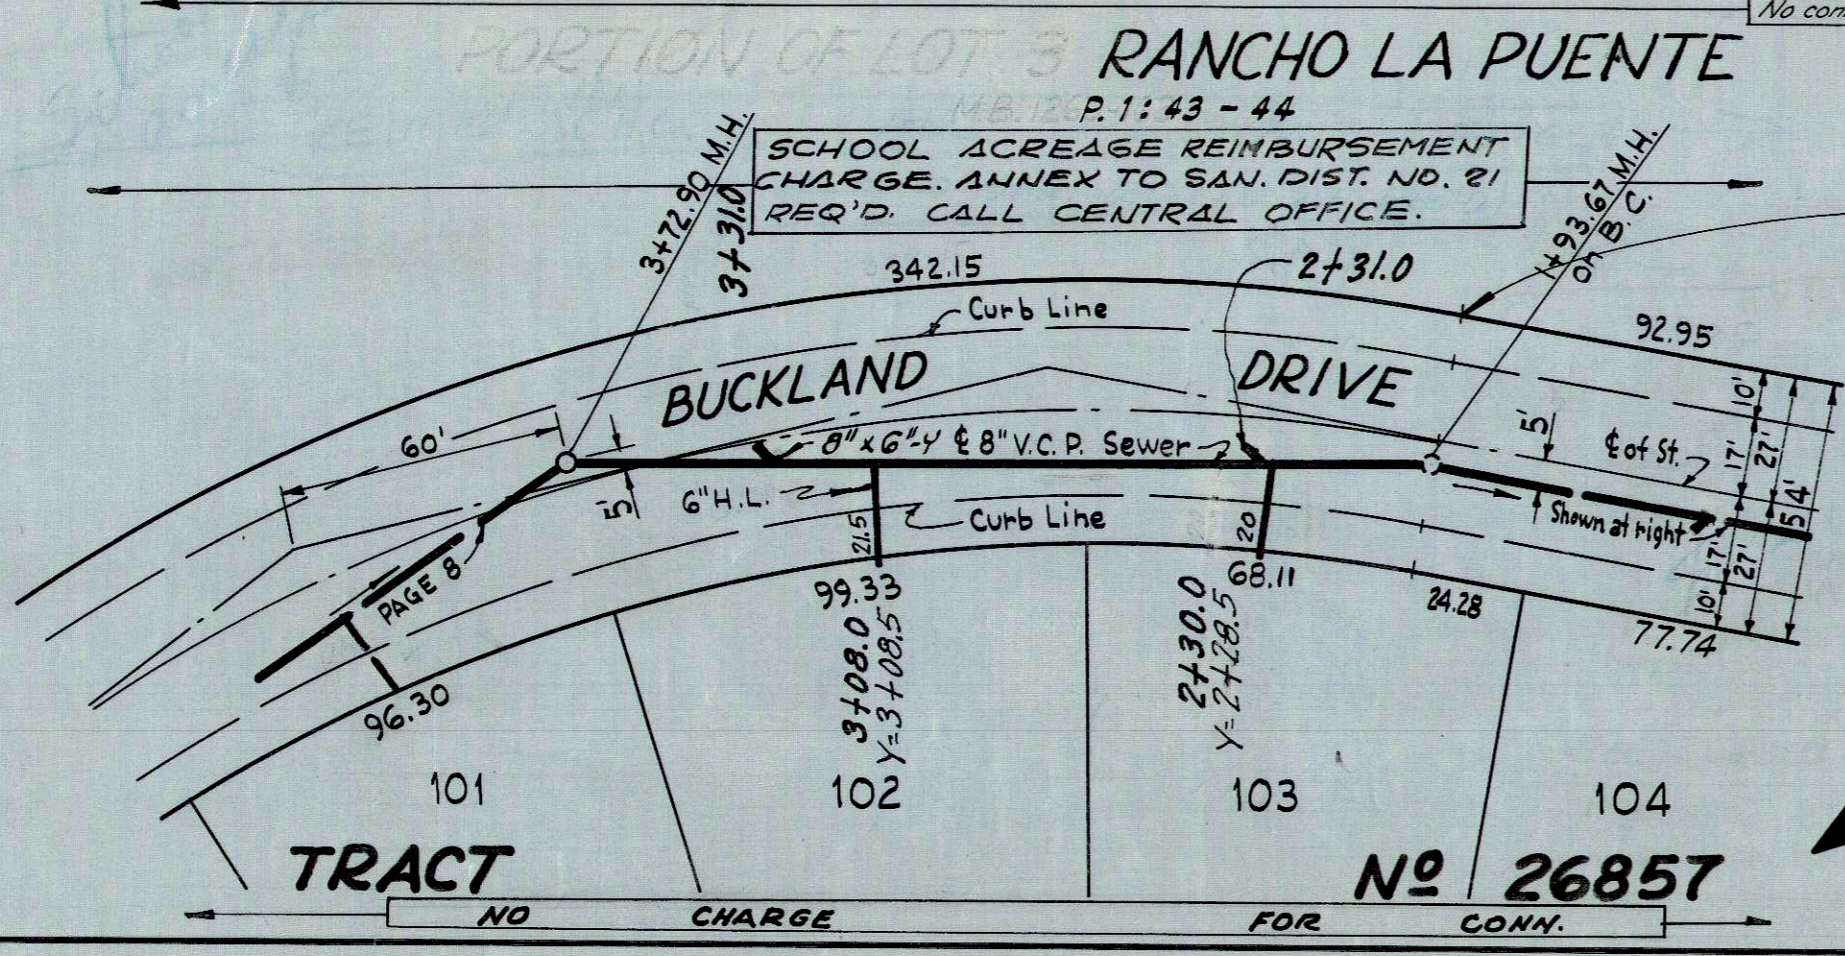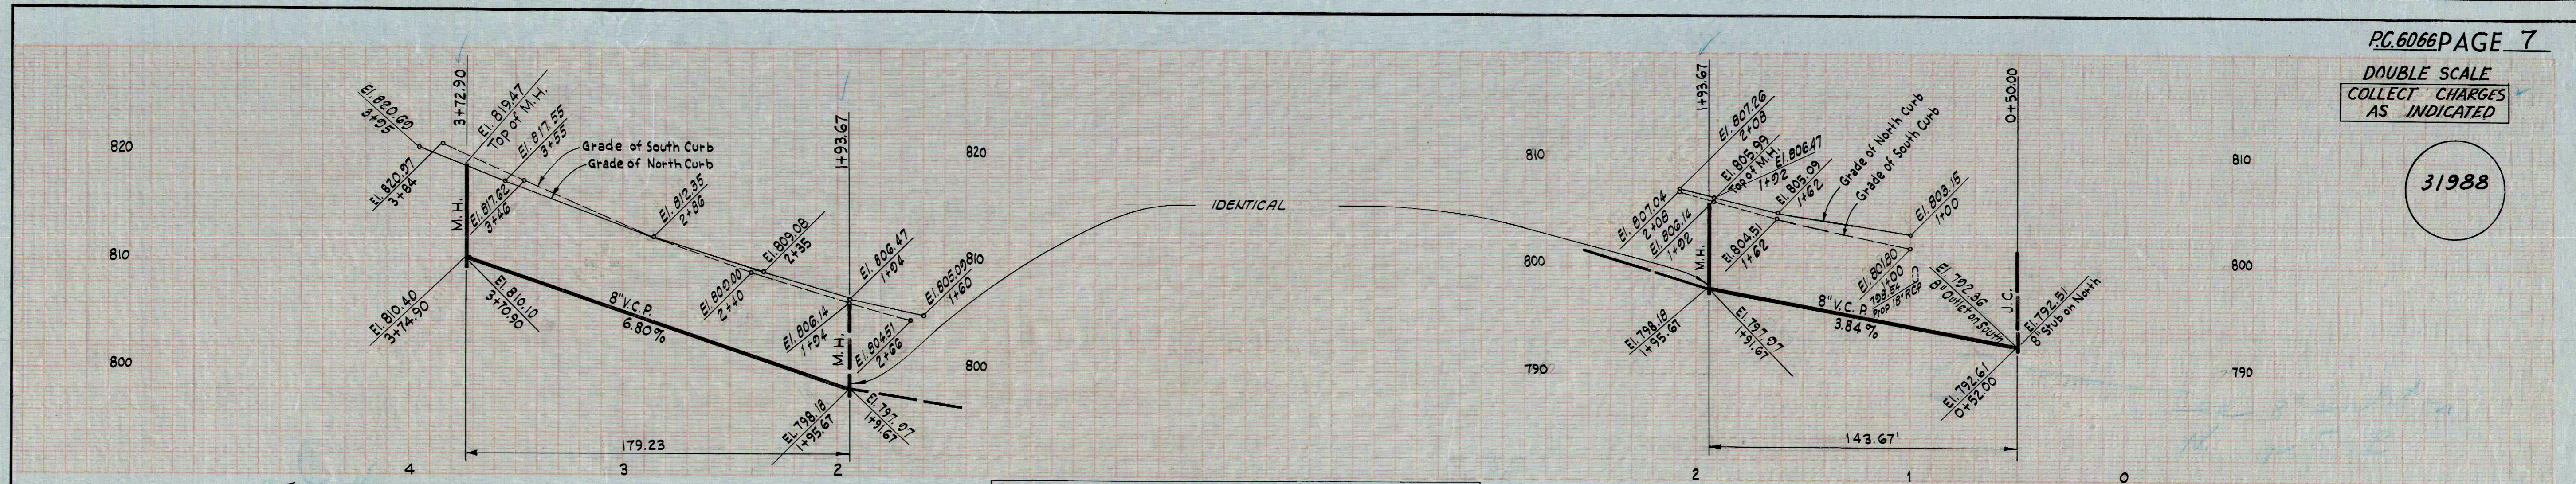

DOUBLE SCALE
COLLECT CHARGES
AS INDICATED

31989

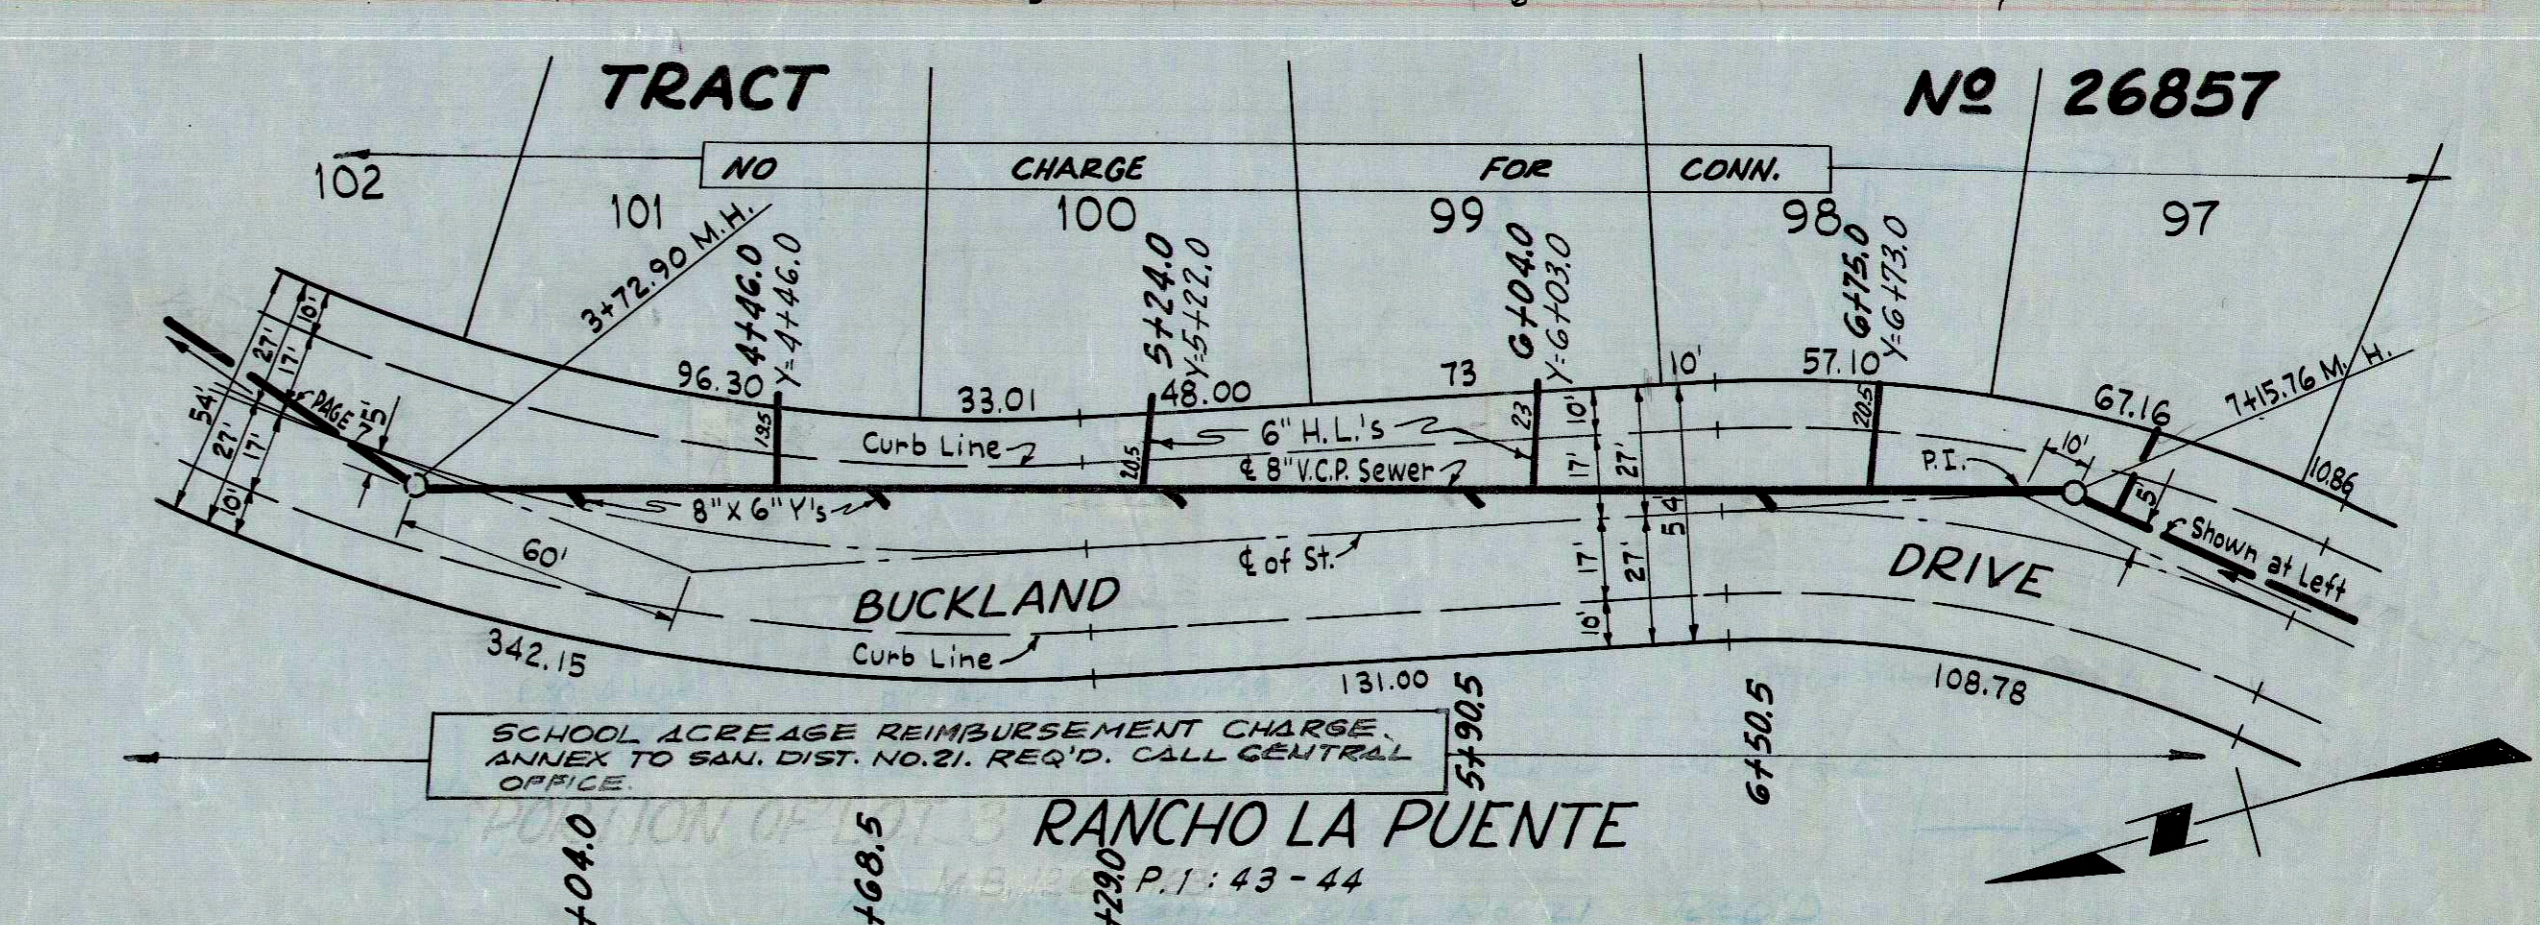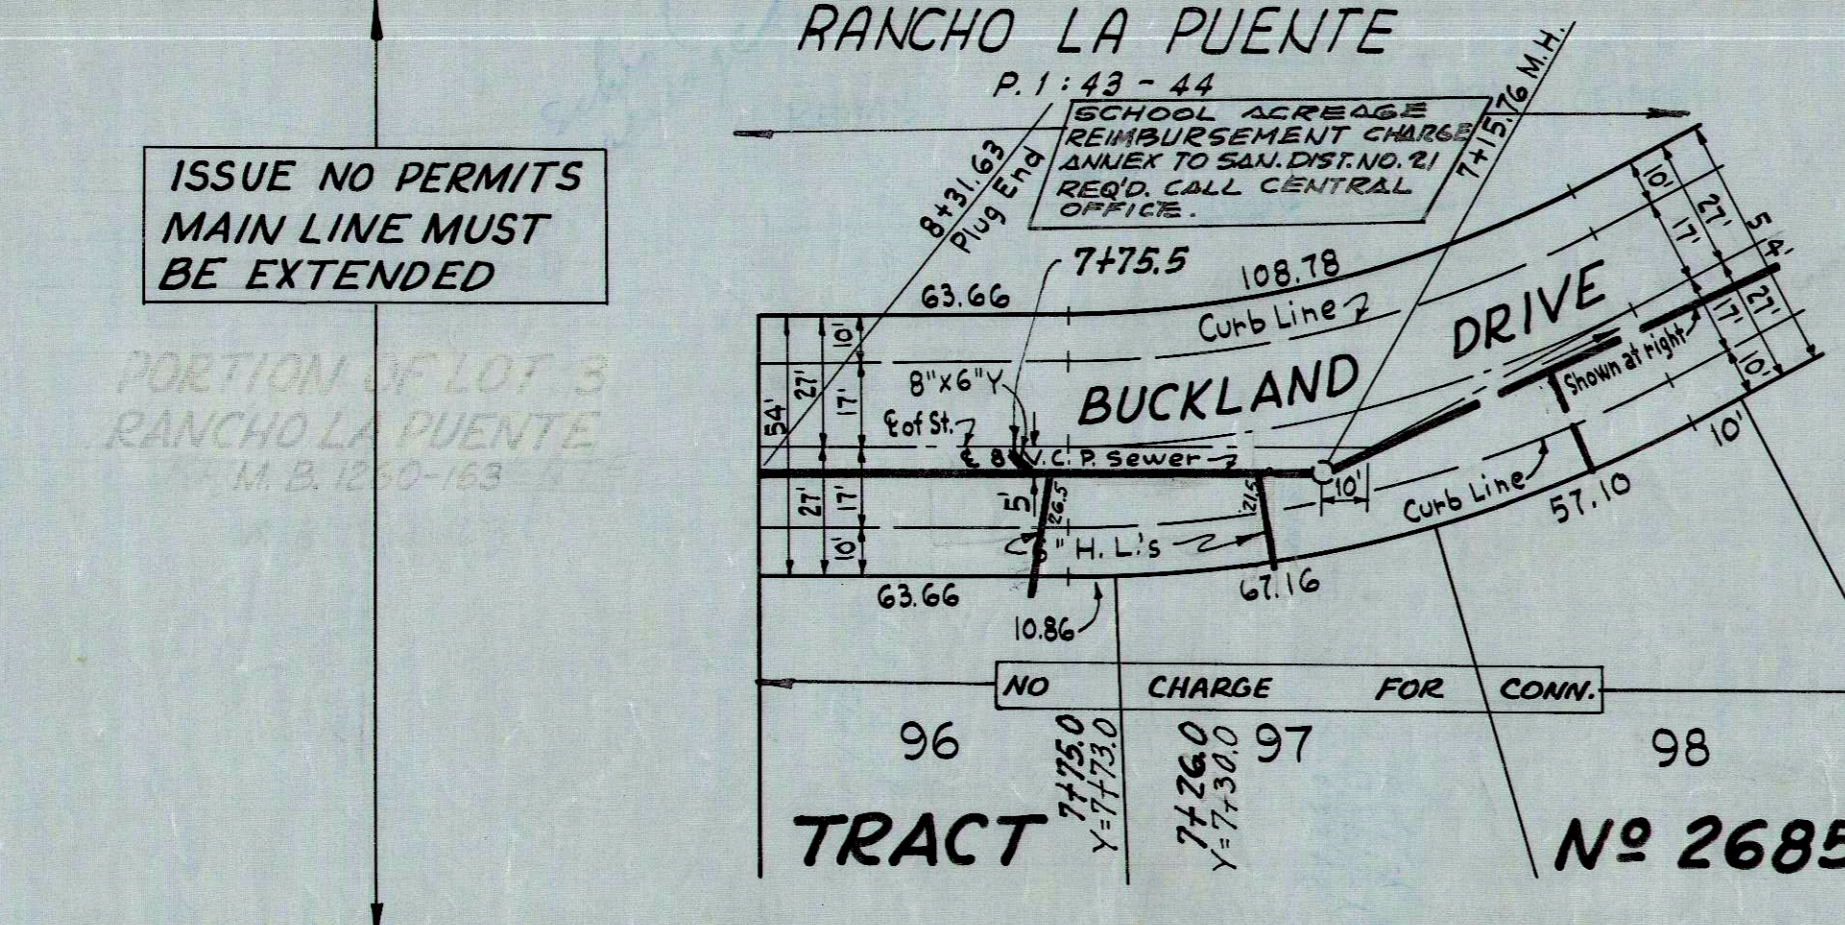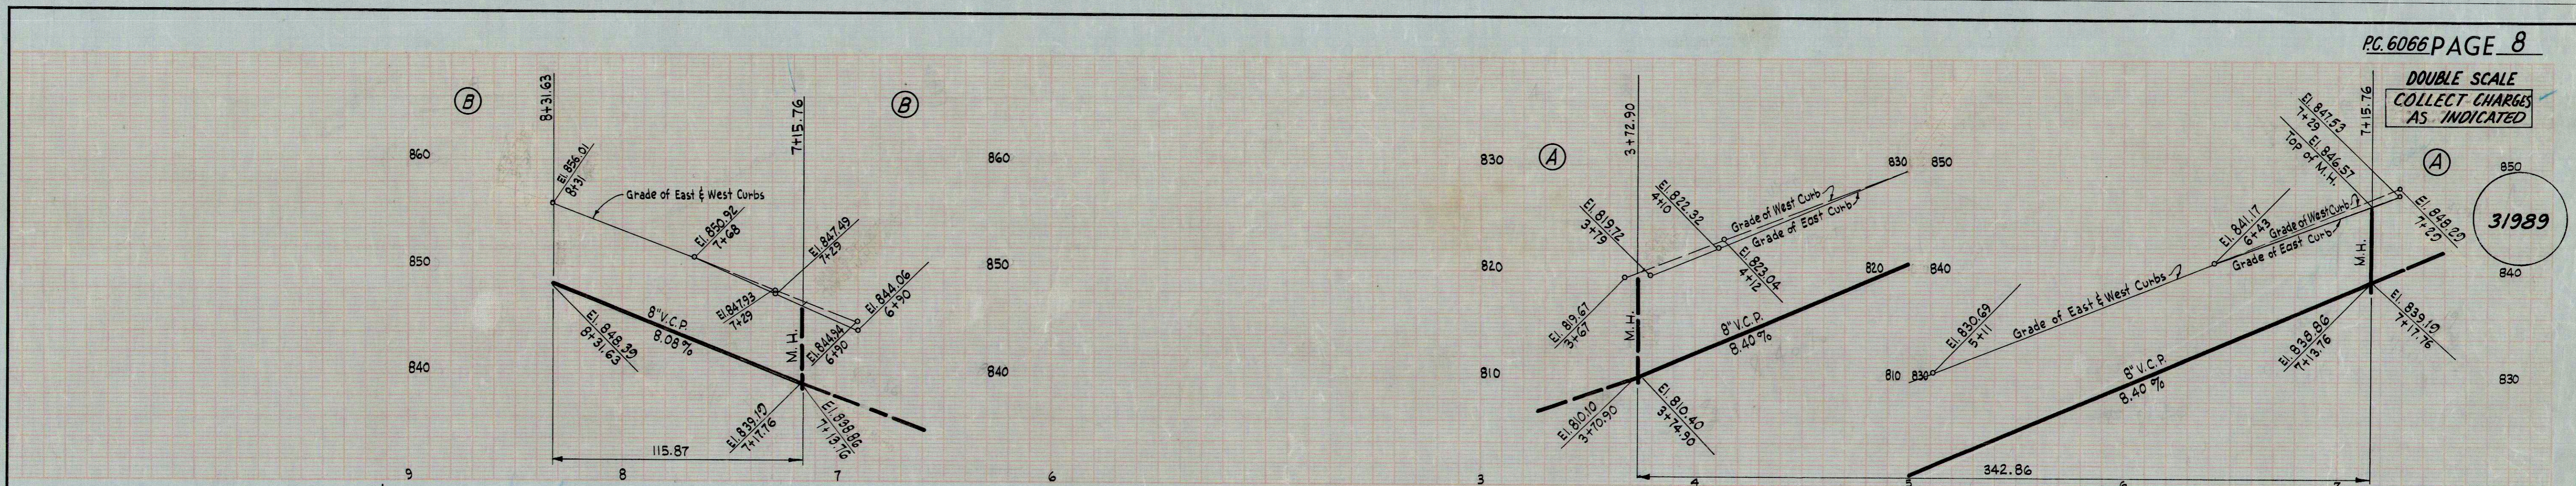


ISSUE NO PERMITS
MAIN LINE MUST
BE EXTENDED

PORTION OF LOT 3
RANCHO LA PUENTE
M.B. 12-10-163


DOUBLE SCALE
NO CHARGE FOR
CONNECTIONS

31990

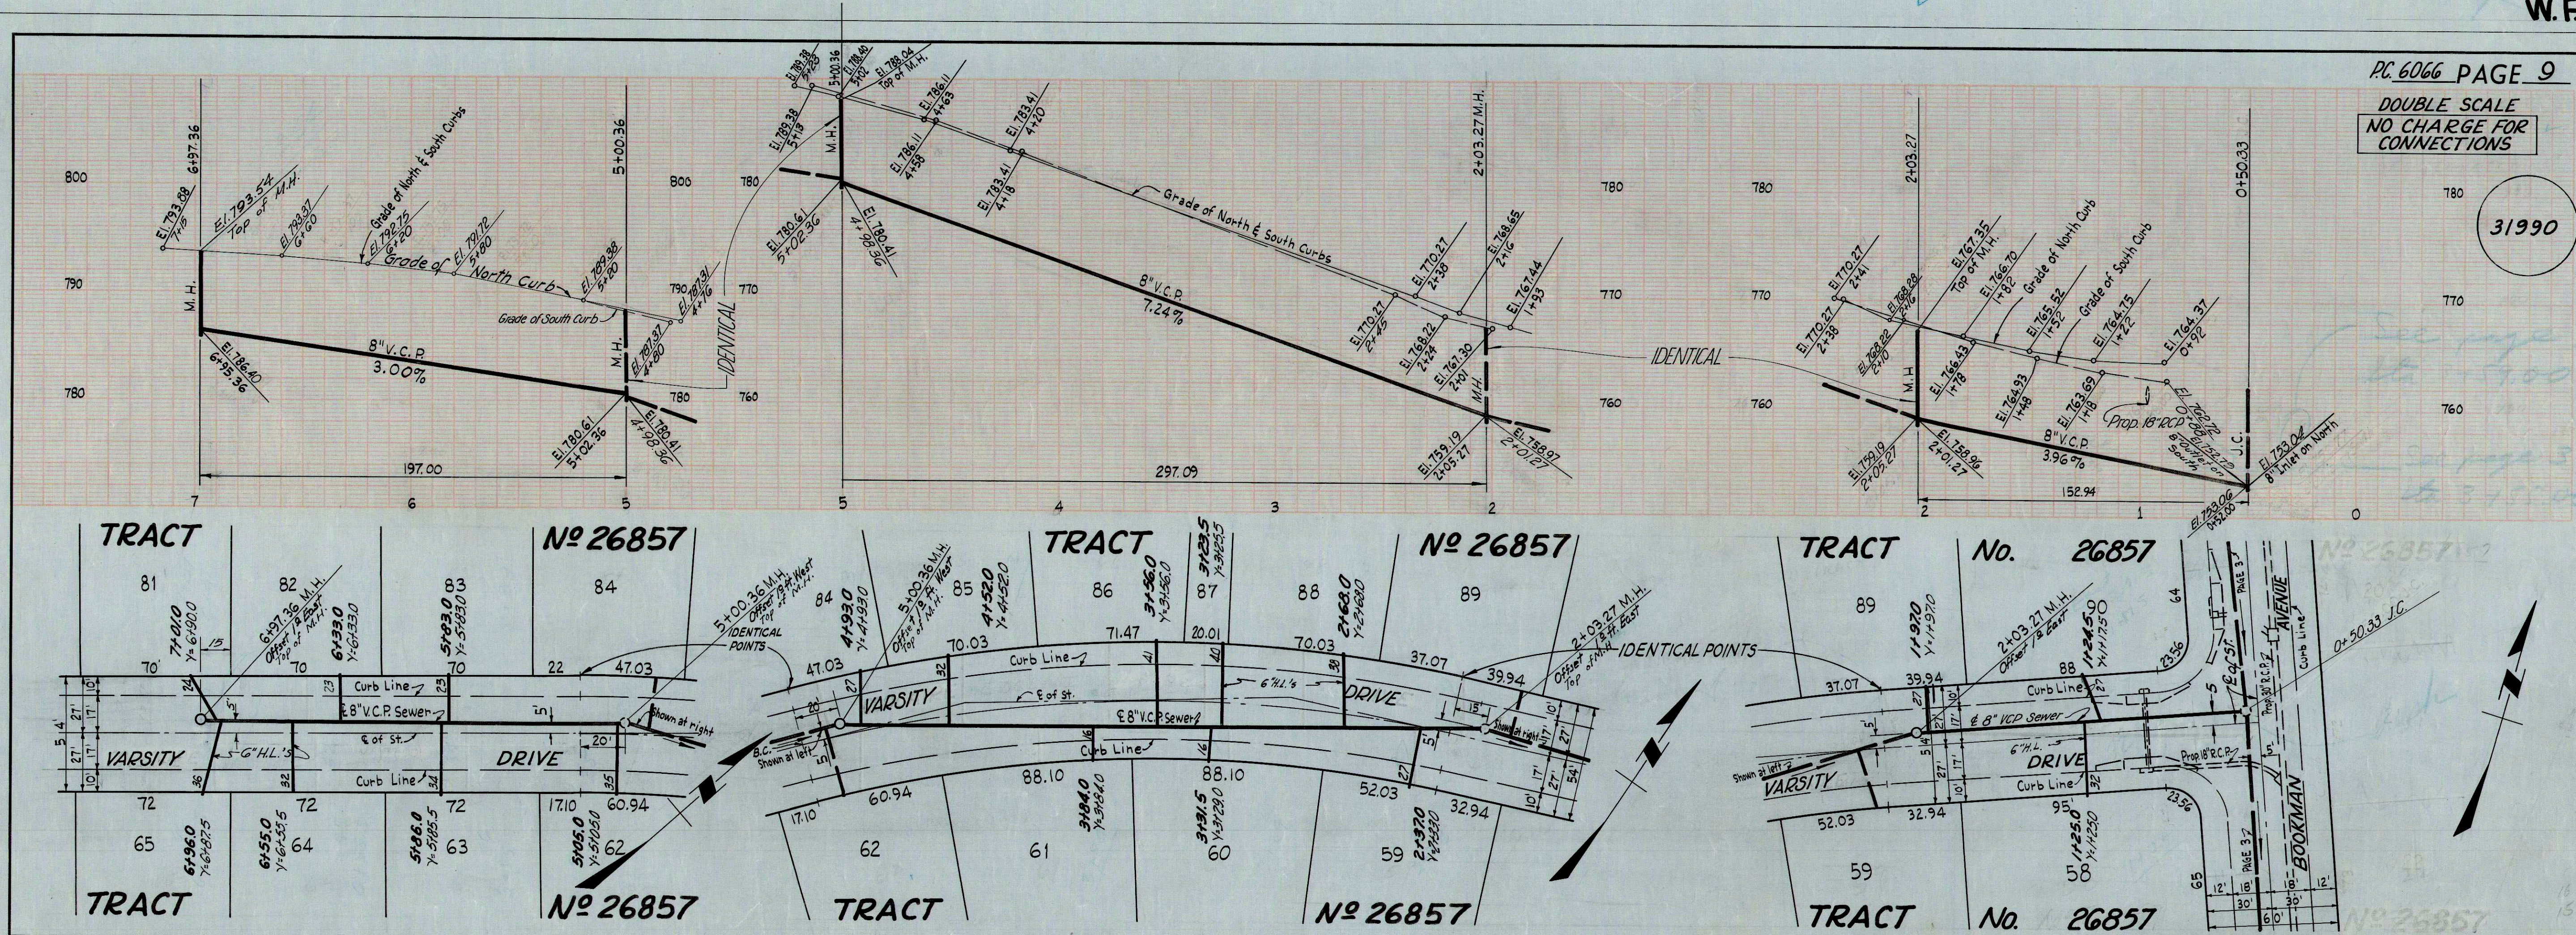



DOUBLE SCALE
NO CHARGE FOR
CONNECTIONS

31991

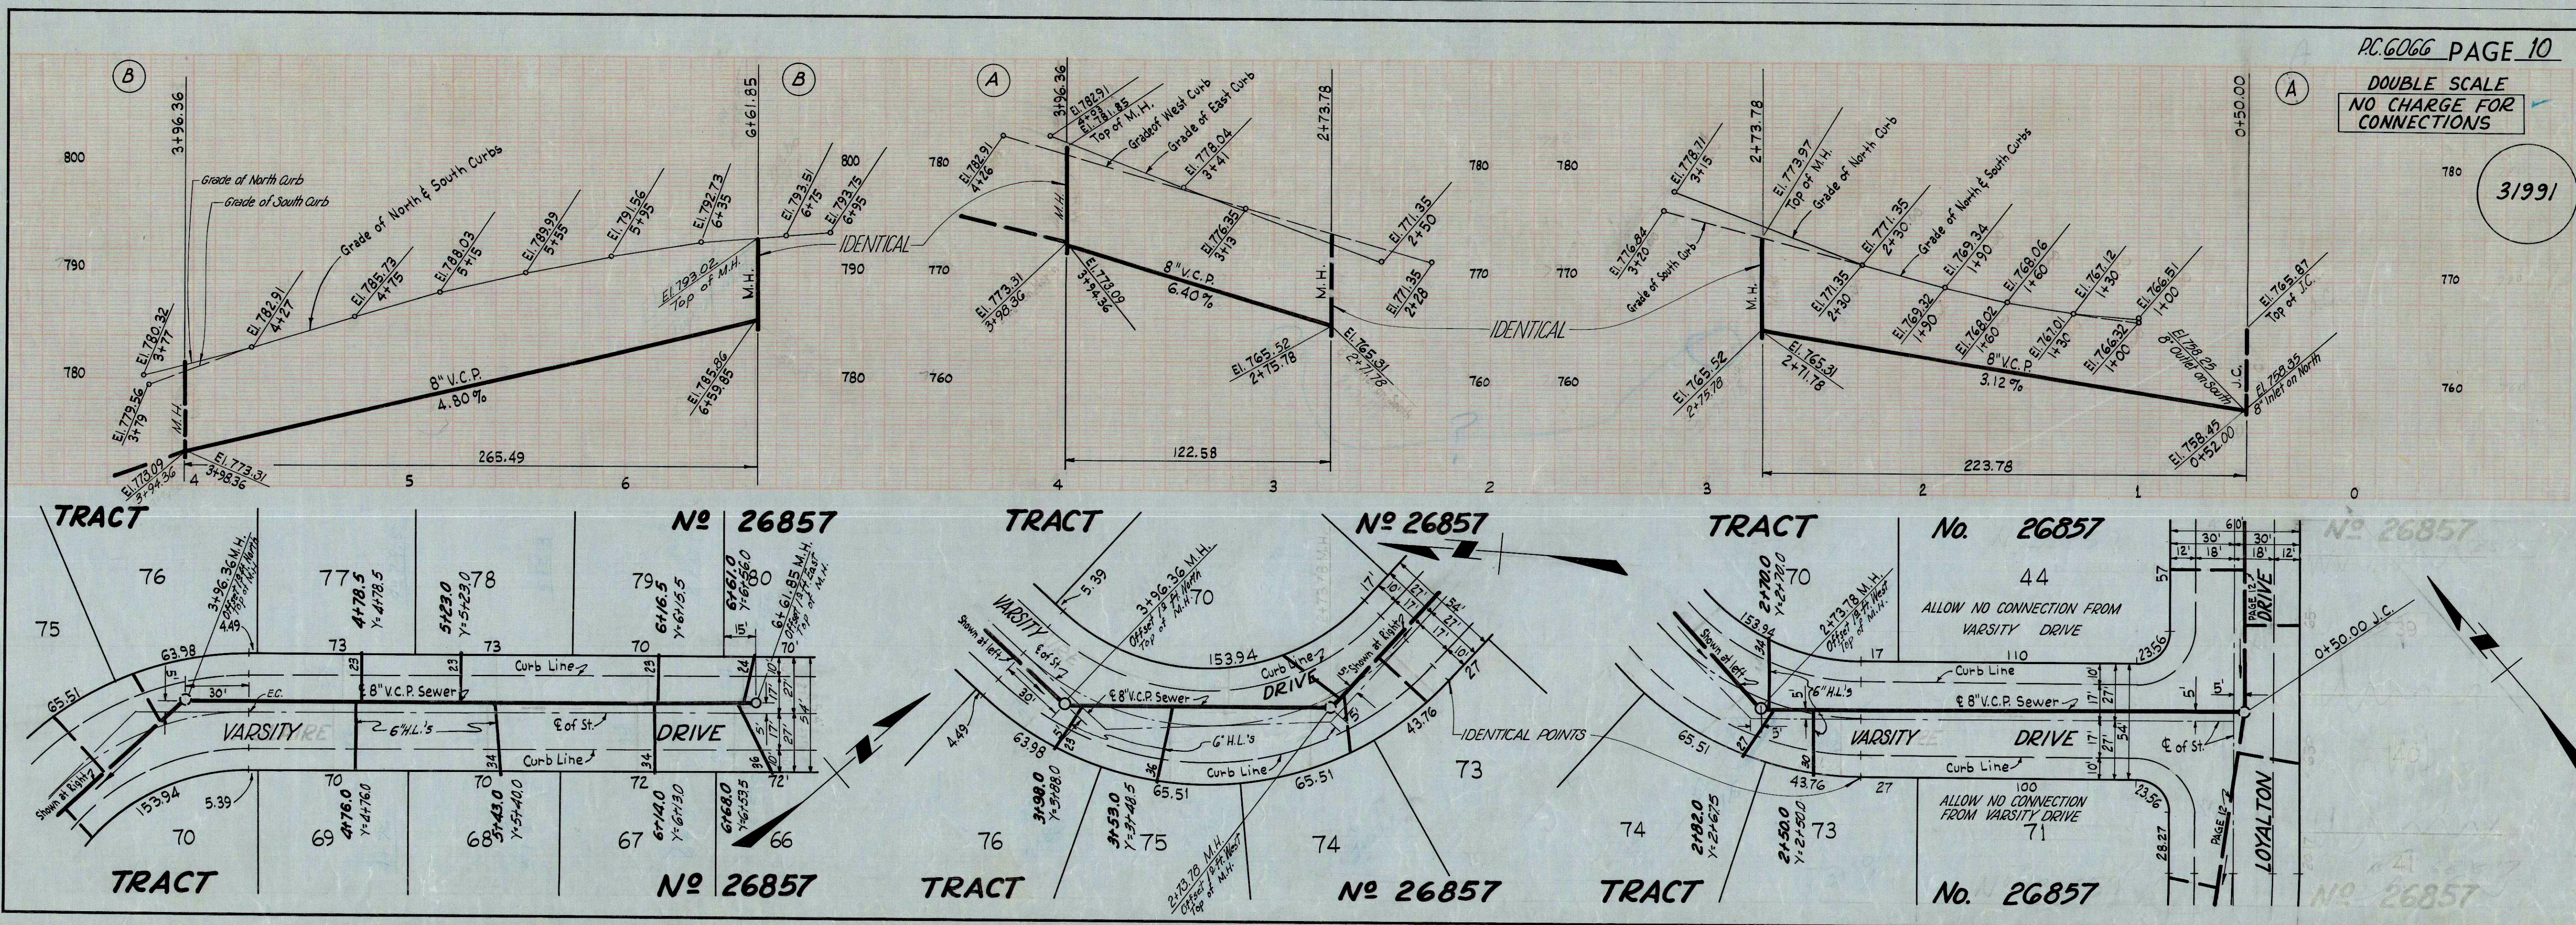



DOUBLE SCALE
NO CHARGE
FOR CONNECTIONS

31992

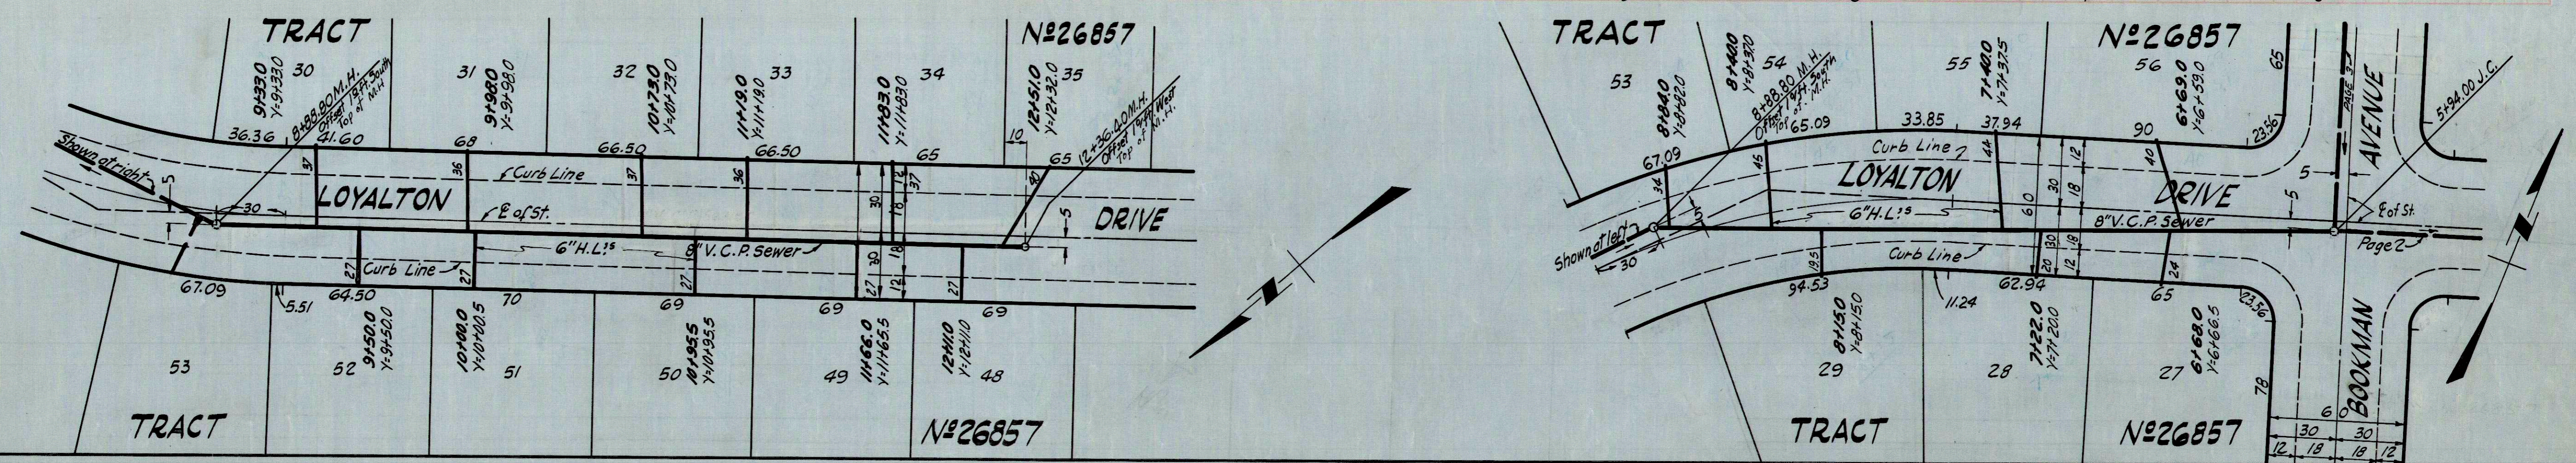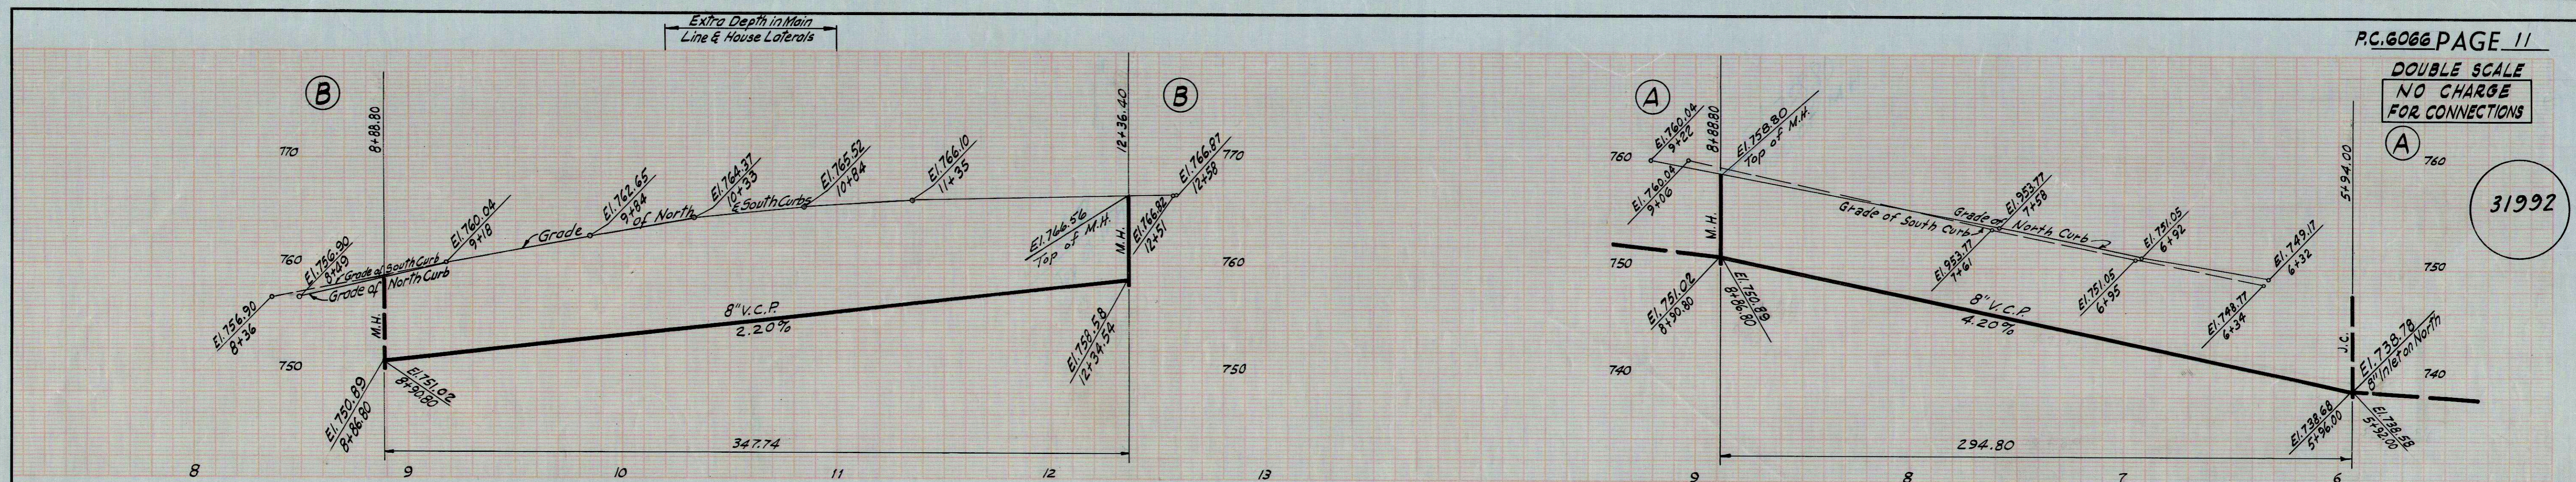


DOUBLE SCALE
COLLECT
CHARGES
AS
INDICATED

31993

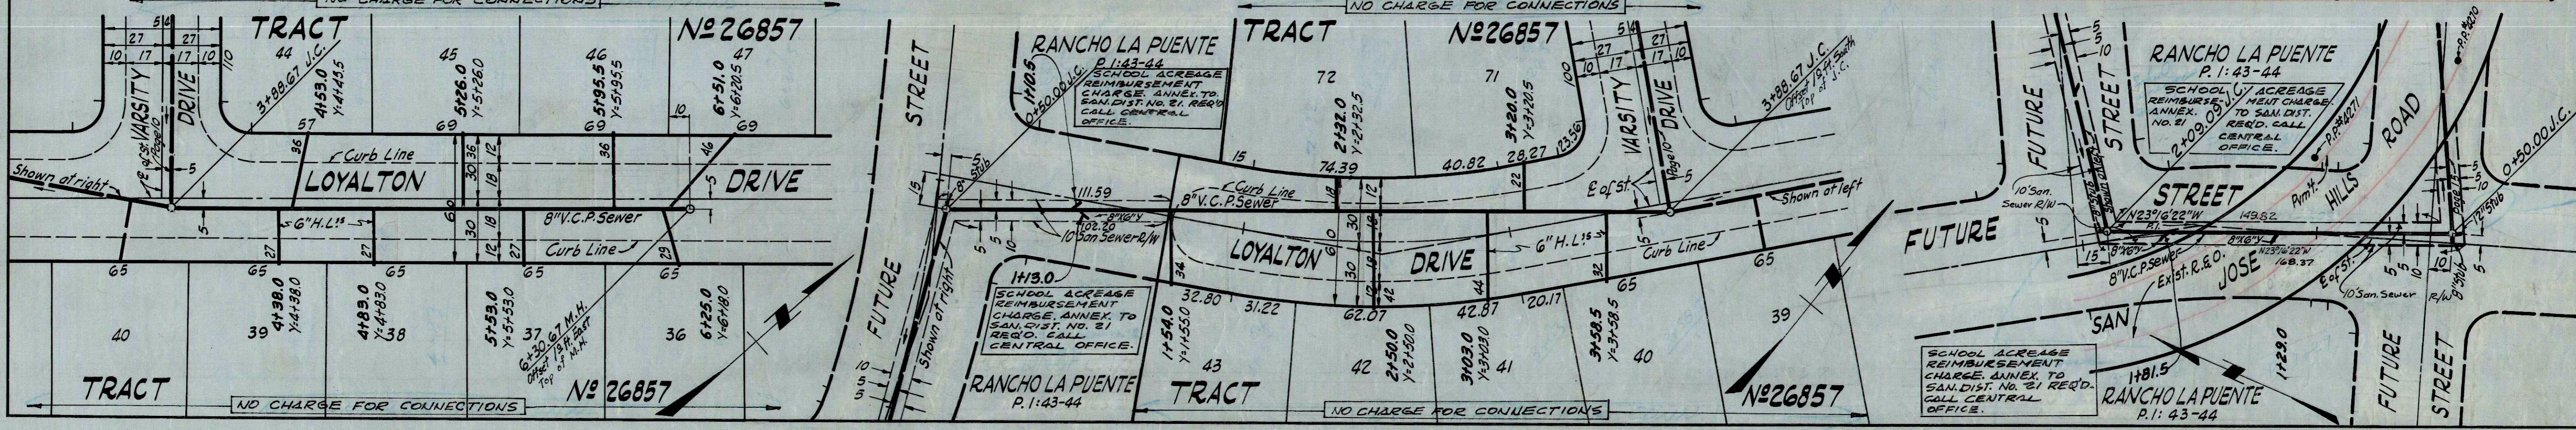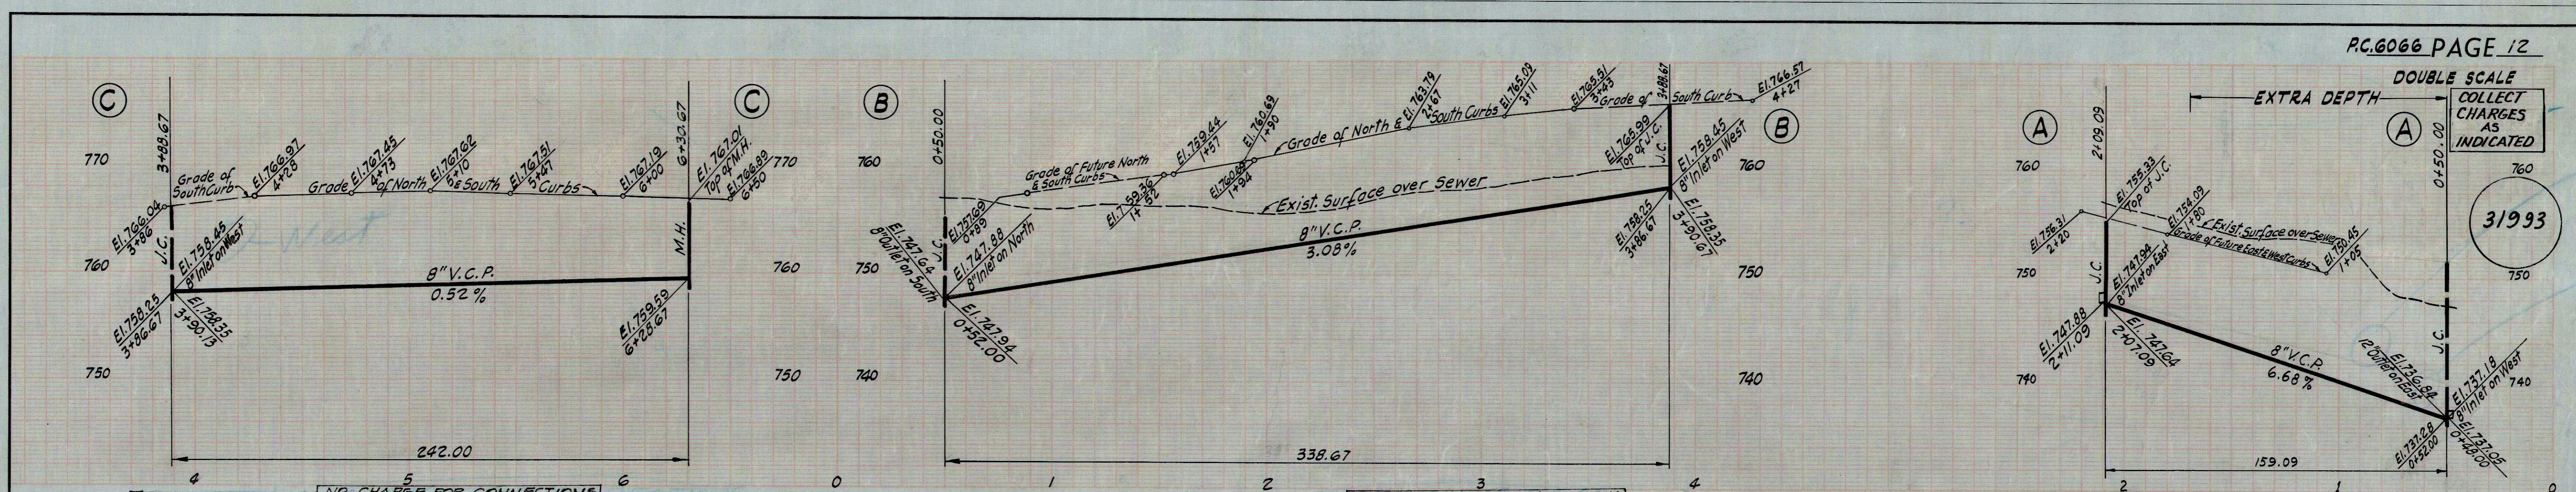

DOUBLE SCALE
COLLECT CHARGES
AS INDICATED

31994

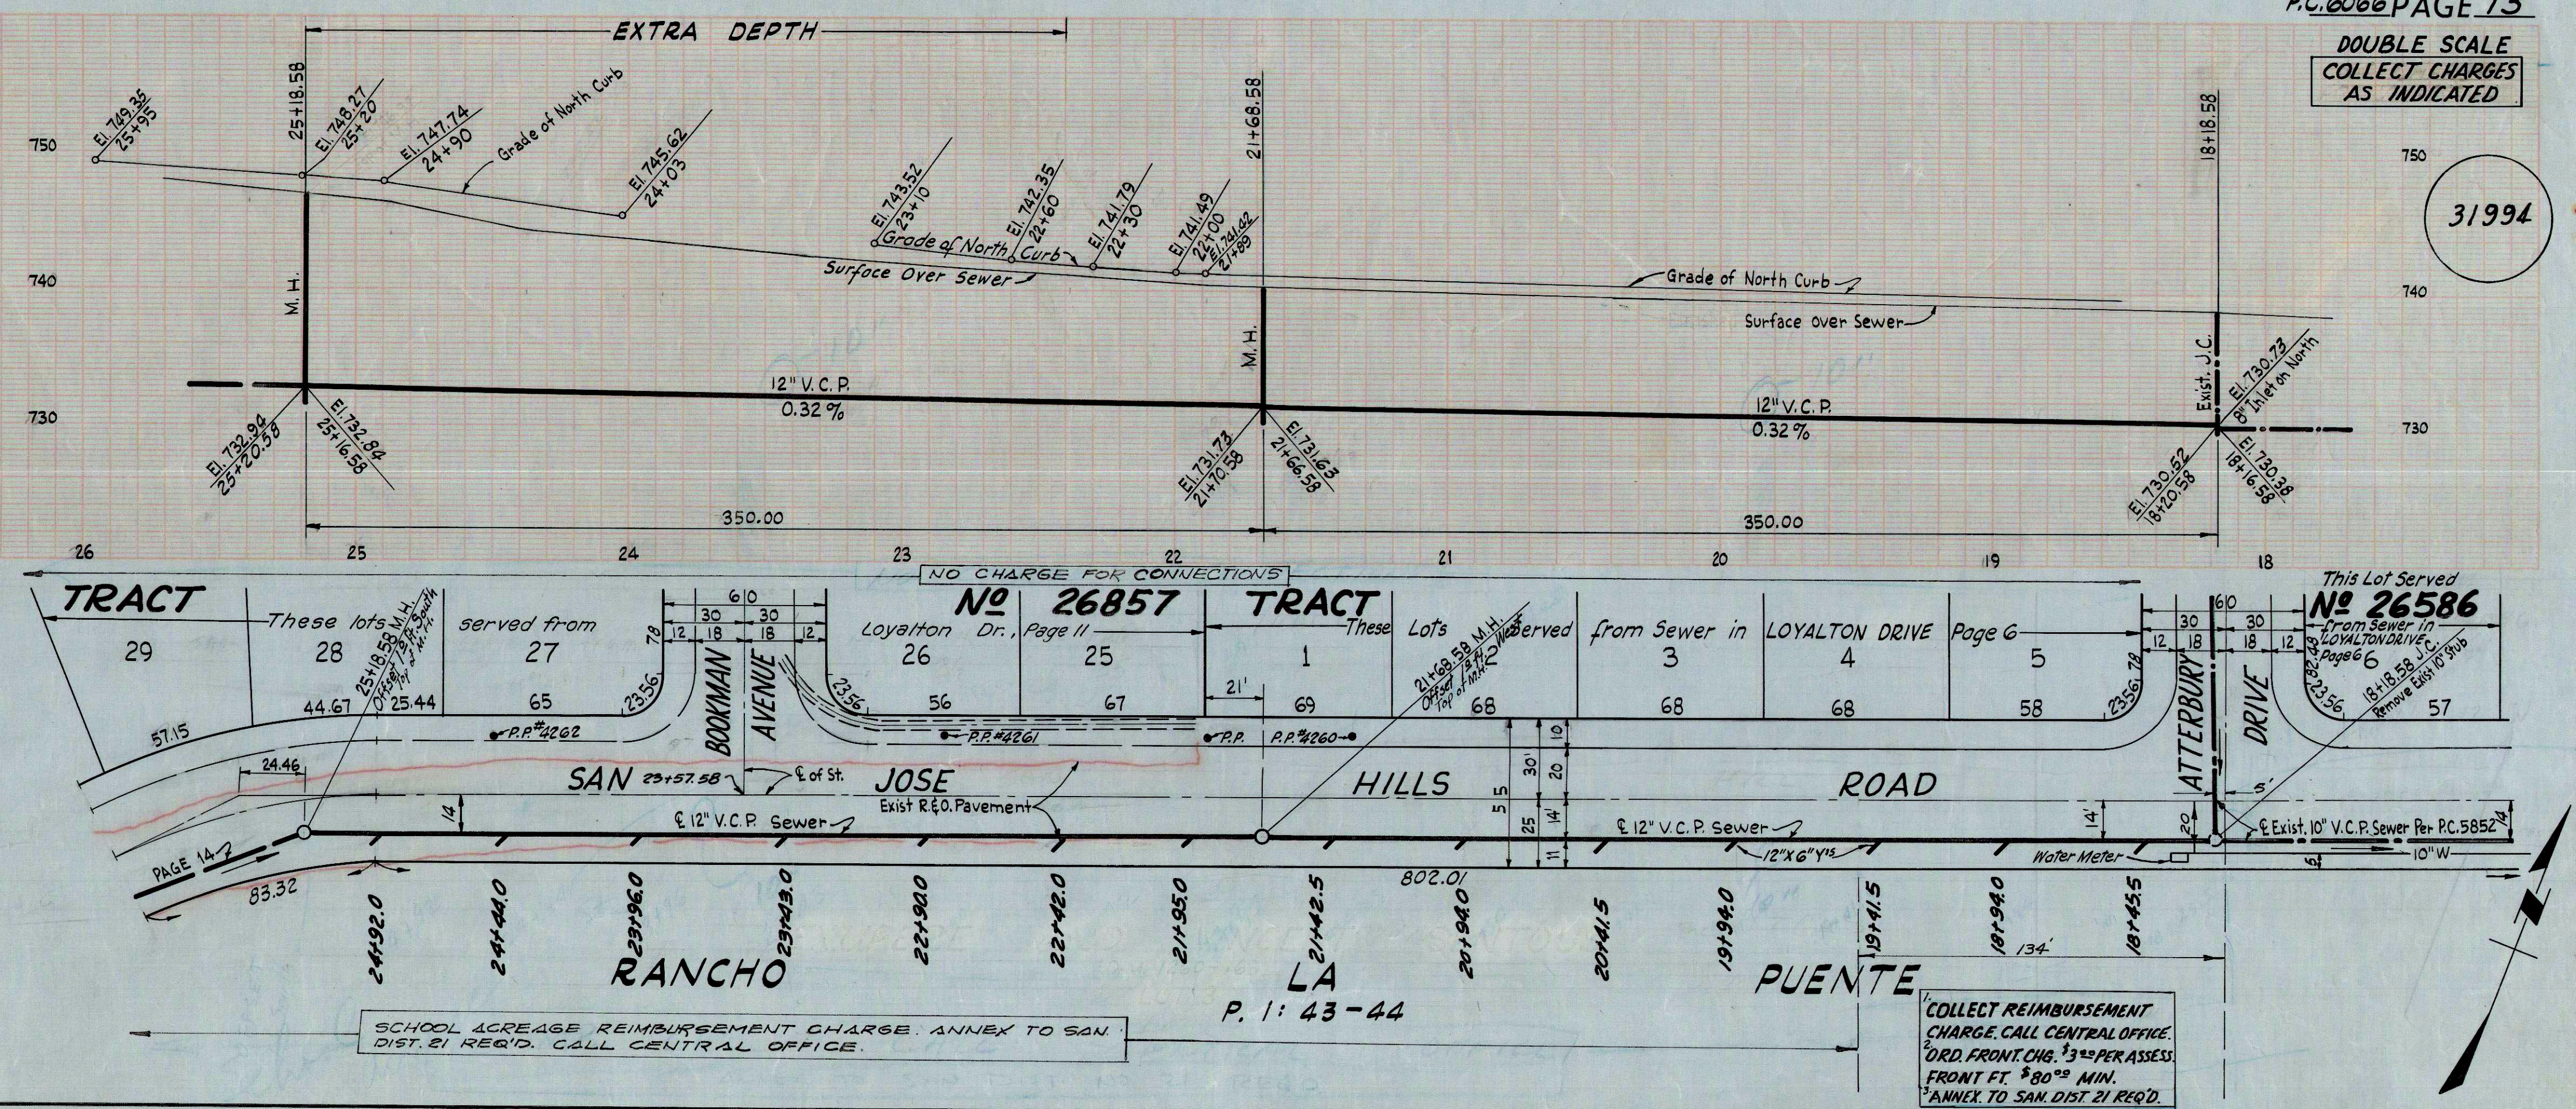


SCHOOL ACREAGE REIMBURSEMENT CHARGE. ANNEX TO SAN DIST. 21 REQ'D. CALL CENTRAL OFFICE.

COLLECT REIMBURSEMENT CHARGE. CALL CENTRAL OFFICE. ORD. FRONT CHG. \$3.00 PER ASSESS. FRONT FT. \$80.00 MIN. ANNEX TO SAN DIST 21 REQ'D.

DOUBLE SCALE
COLLECT CHARGES
AS INDICATED

31995

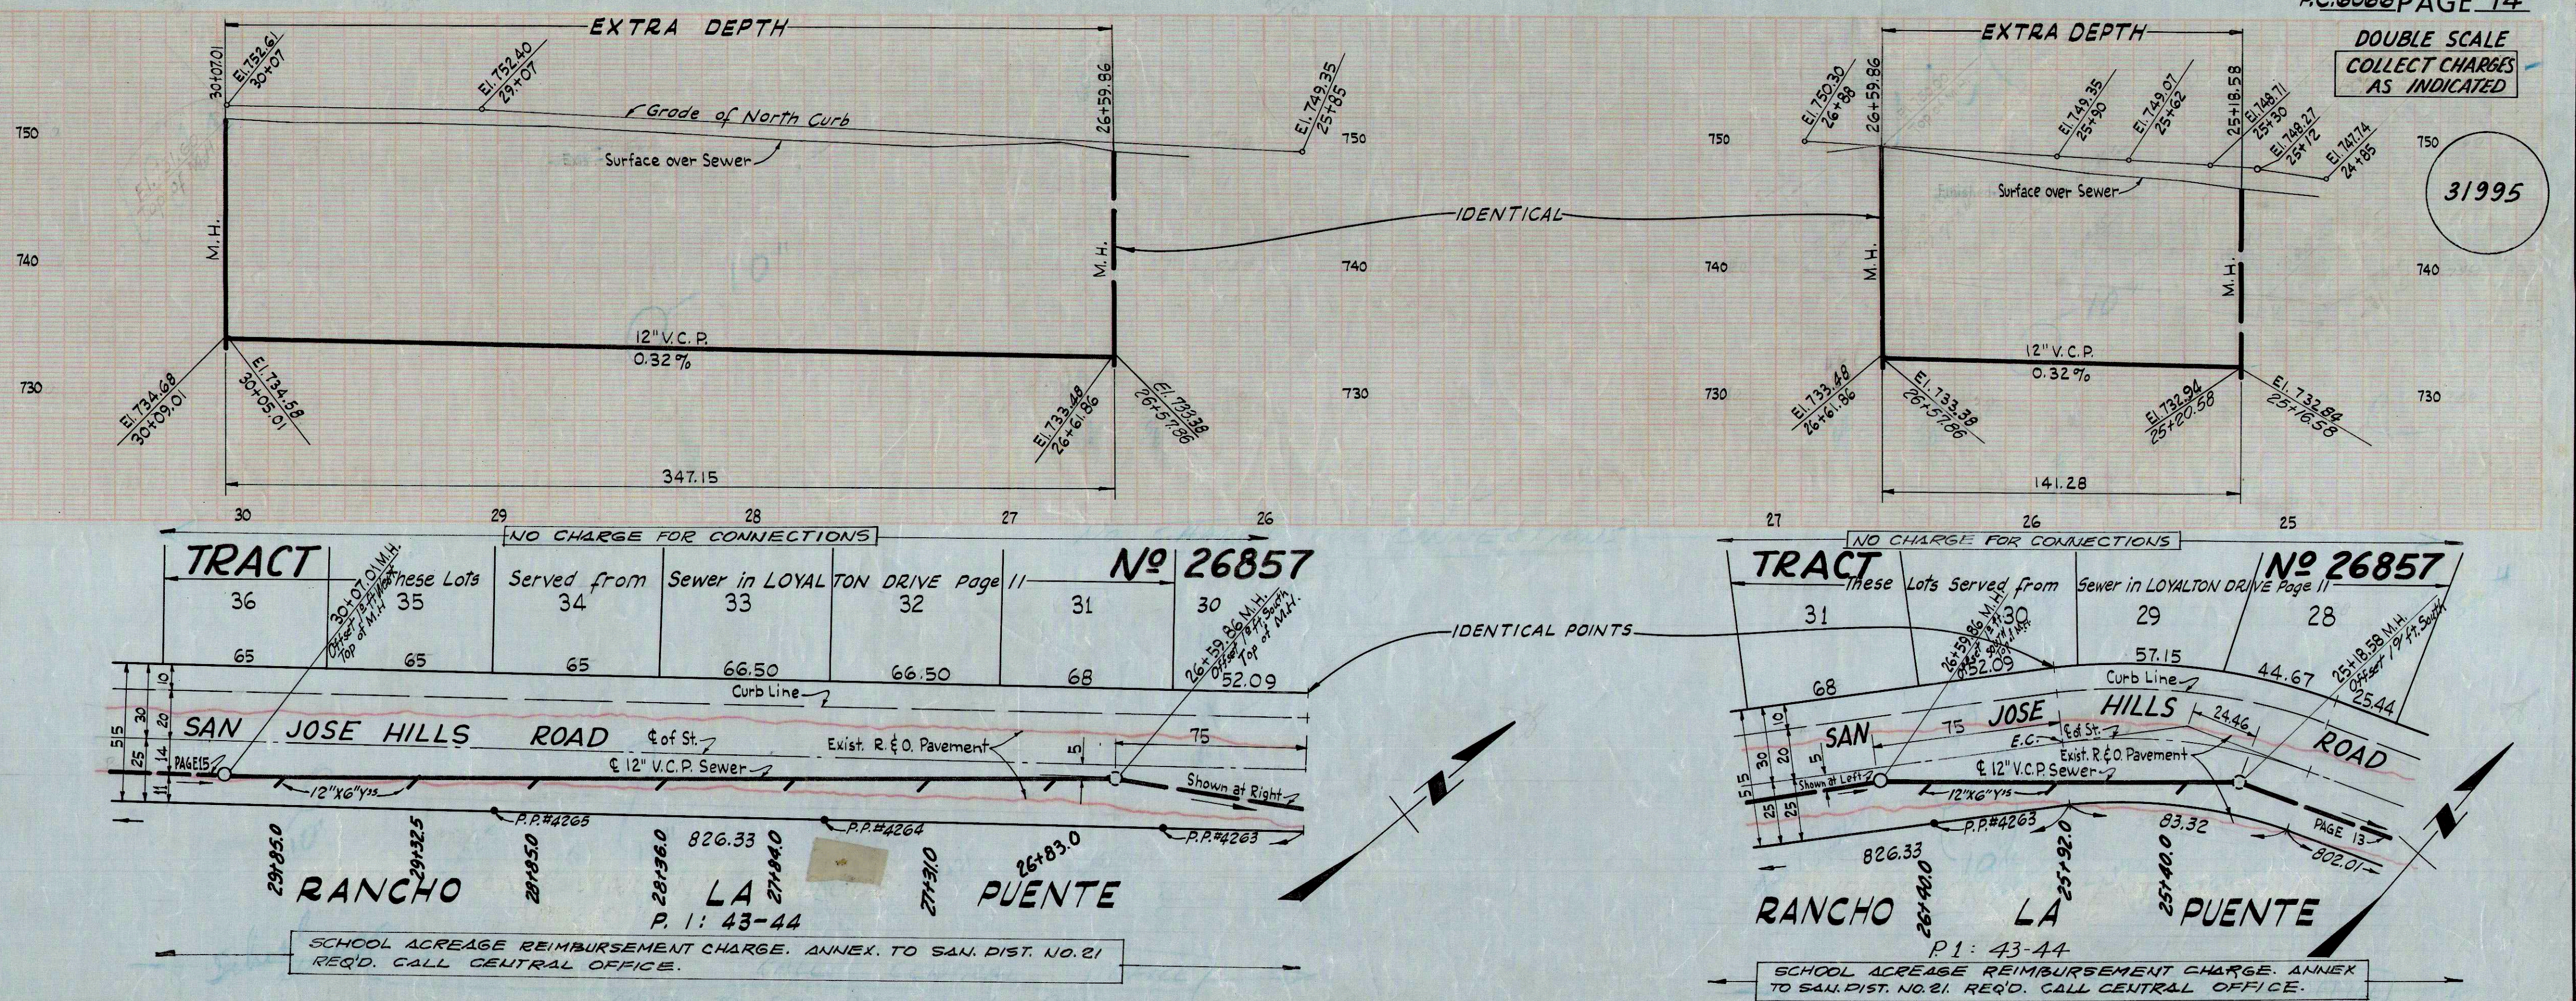


SCHOOL ACREAGE REIMBURSEMENT CHARGE. ANNEX. TO SAN. DIST. NO. 21 REQ'D. CALL CENTRAL OFFICE.

SCHOOL ACREAGE REIMBURSEMENT CHARGE. ANNEX TO SAN. DIST. NO. 21. REQ'D. CALL CENTRAL OFFICE.

DOUBLE SCALE
COLLECT CHARGES
AS INDICATED

31996

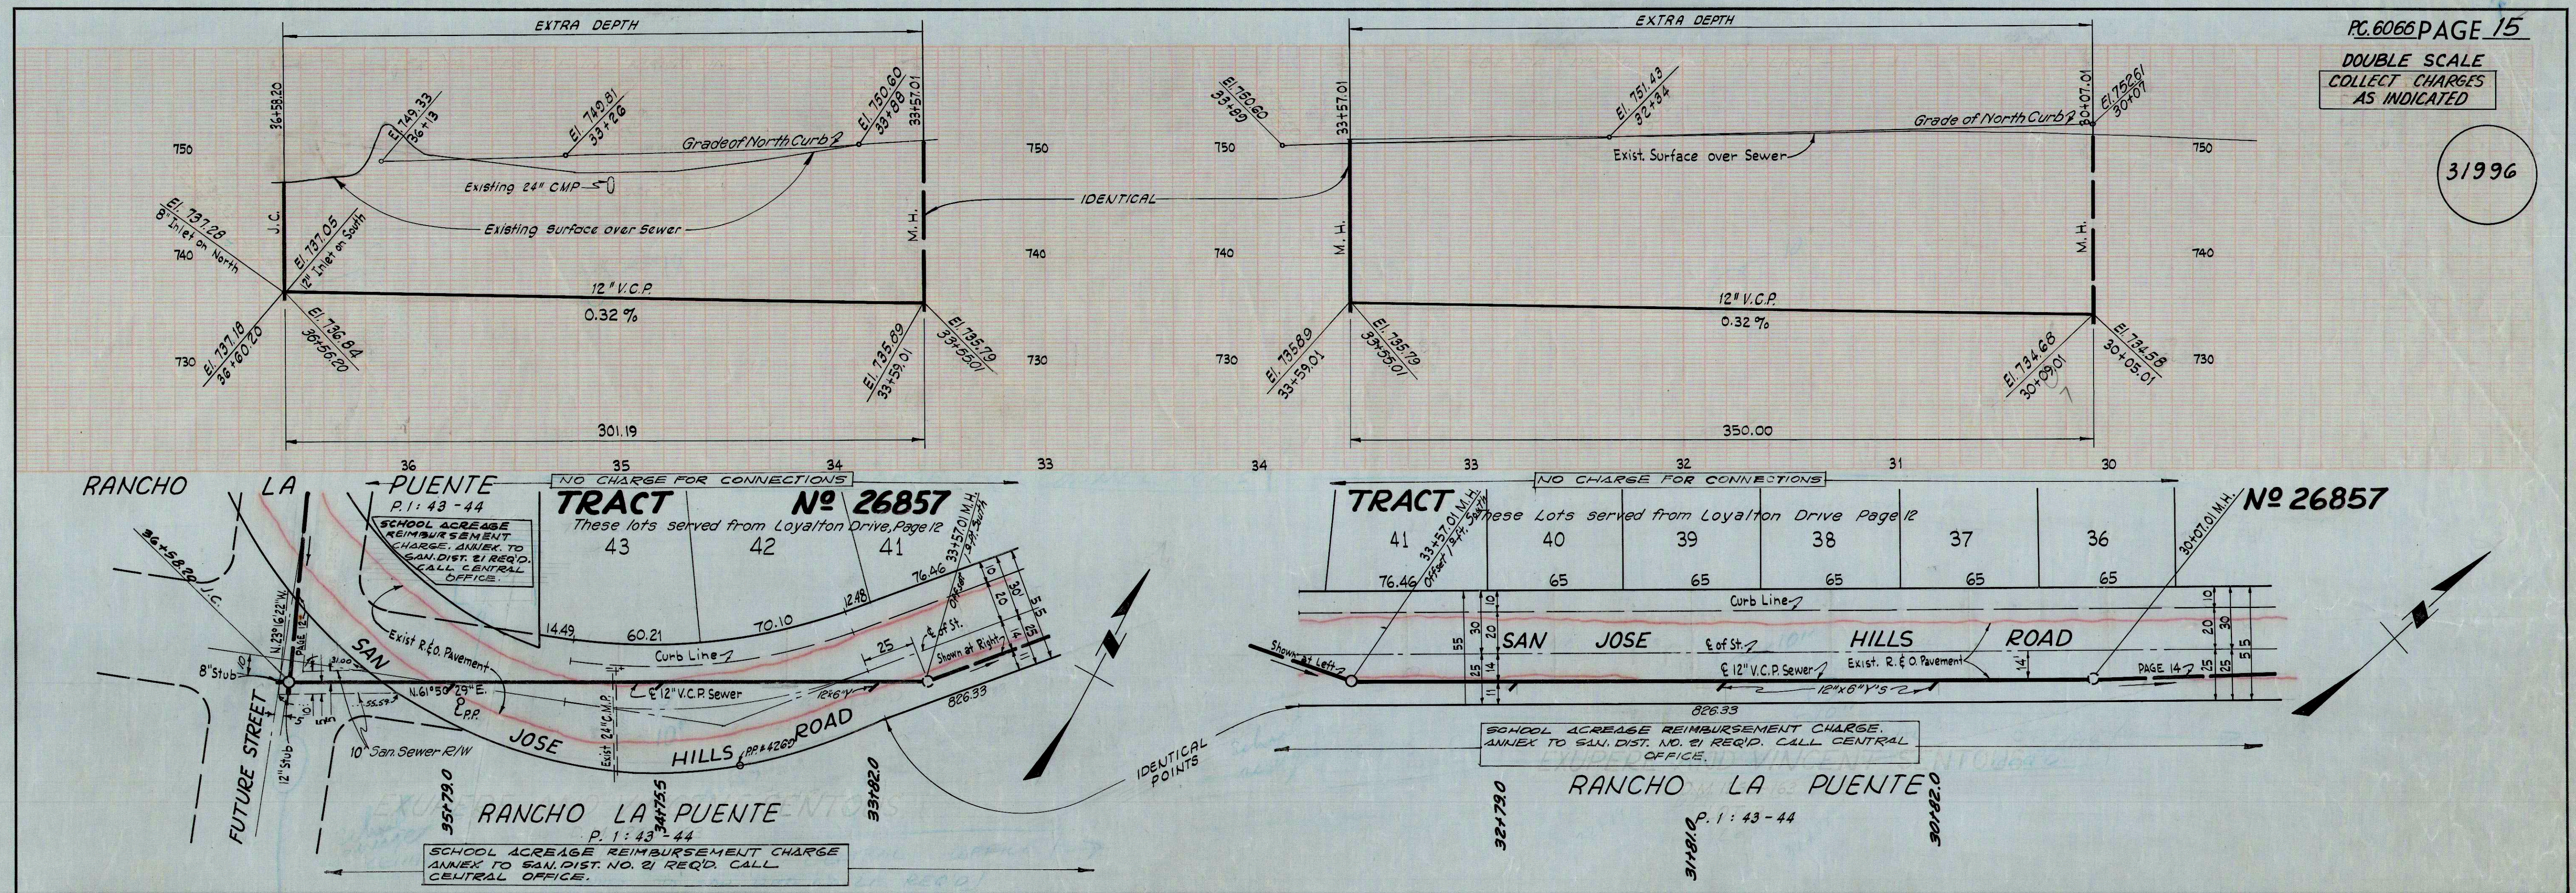

W.P.C. 79

W.P.C. 79