

B.M. SY 3972 ELEV. 44.037
 At 1.30 and 0.90 m. Max. flush with
 ground 1.33 m. E. of Wilmington Ave. 125'
 N. Driv. to house No. 2017 Wilmington
 Ave. Mod. "N-780-1942"
 GARDENA QUAD. 19 60

NOTICE TO CONTRACTOR
 The existence and location of any underground
 utility pipes or structures shown on these
 plans are obtained by a search of the
 available records. The Contractor is required
 to take due ordinary measures to protect
 the utility lines not of record or not shown on
 these plans.

LENNOX BLDG. DIST. NO. 7

PROFILE ALIGNMENT AND GRADE OF
SANITARY SEWERS PAGE 1

TO BE CONSTRUCTED IN
CITY OF CARSON

PRIVATE CONTRACT NO. 7377

W.S. 26

SHEETS: 2 PAGES


SCALE: VERT. 1"=4' HORIZ. 1"=40'

MAY 1965

PREPARED IN THE OFFICES OF
VOORHEIS-TRINDLE-NELSON
 13794 BEACH BLVD. WESTMINSTER, CALIF.

By *James E. Whittle*
 REG. C. E. NO. 14305

FOR LEGEND SEE PLAN NO. S-1

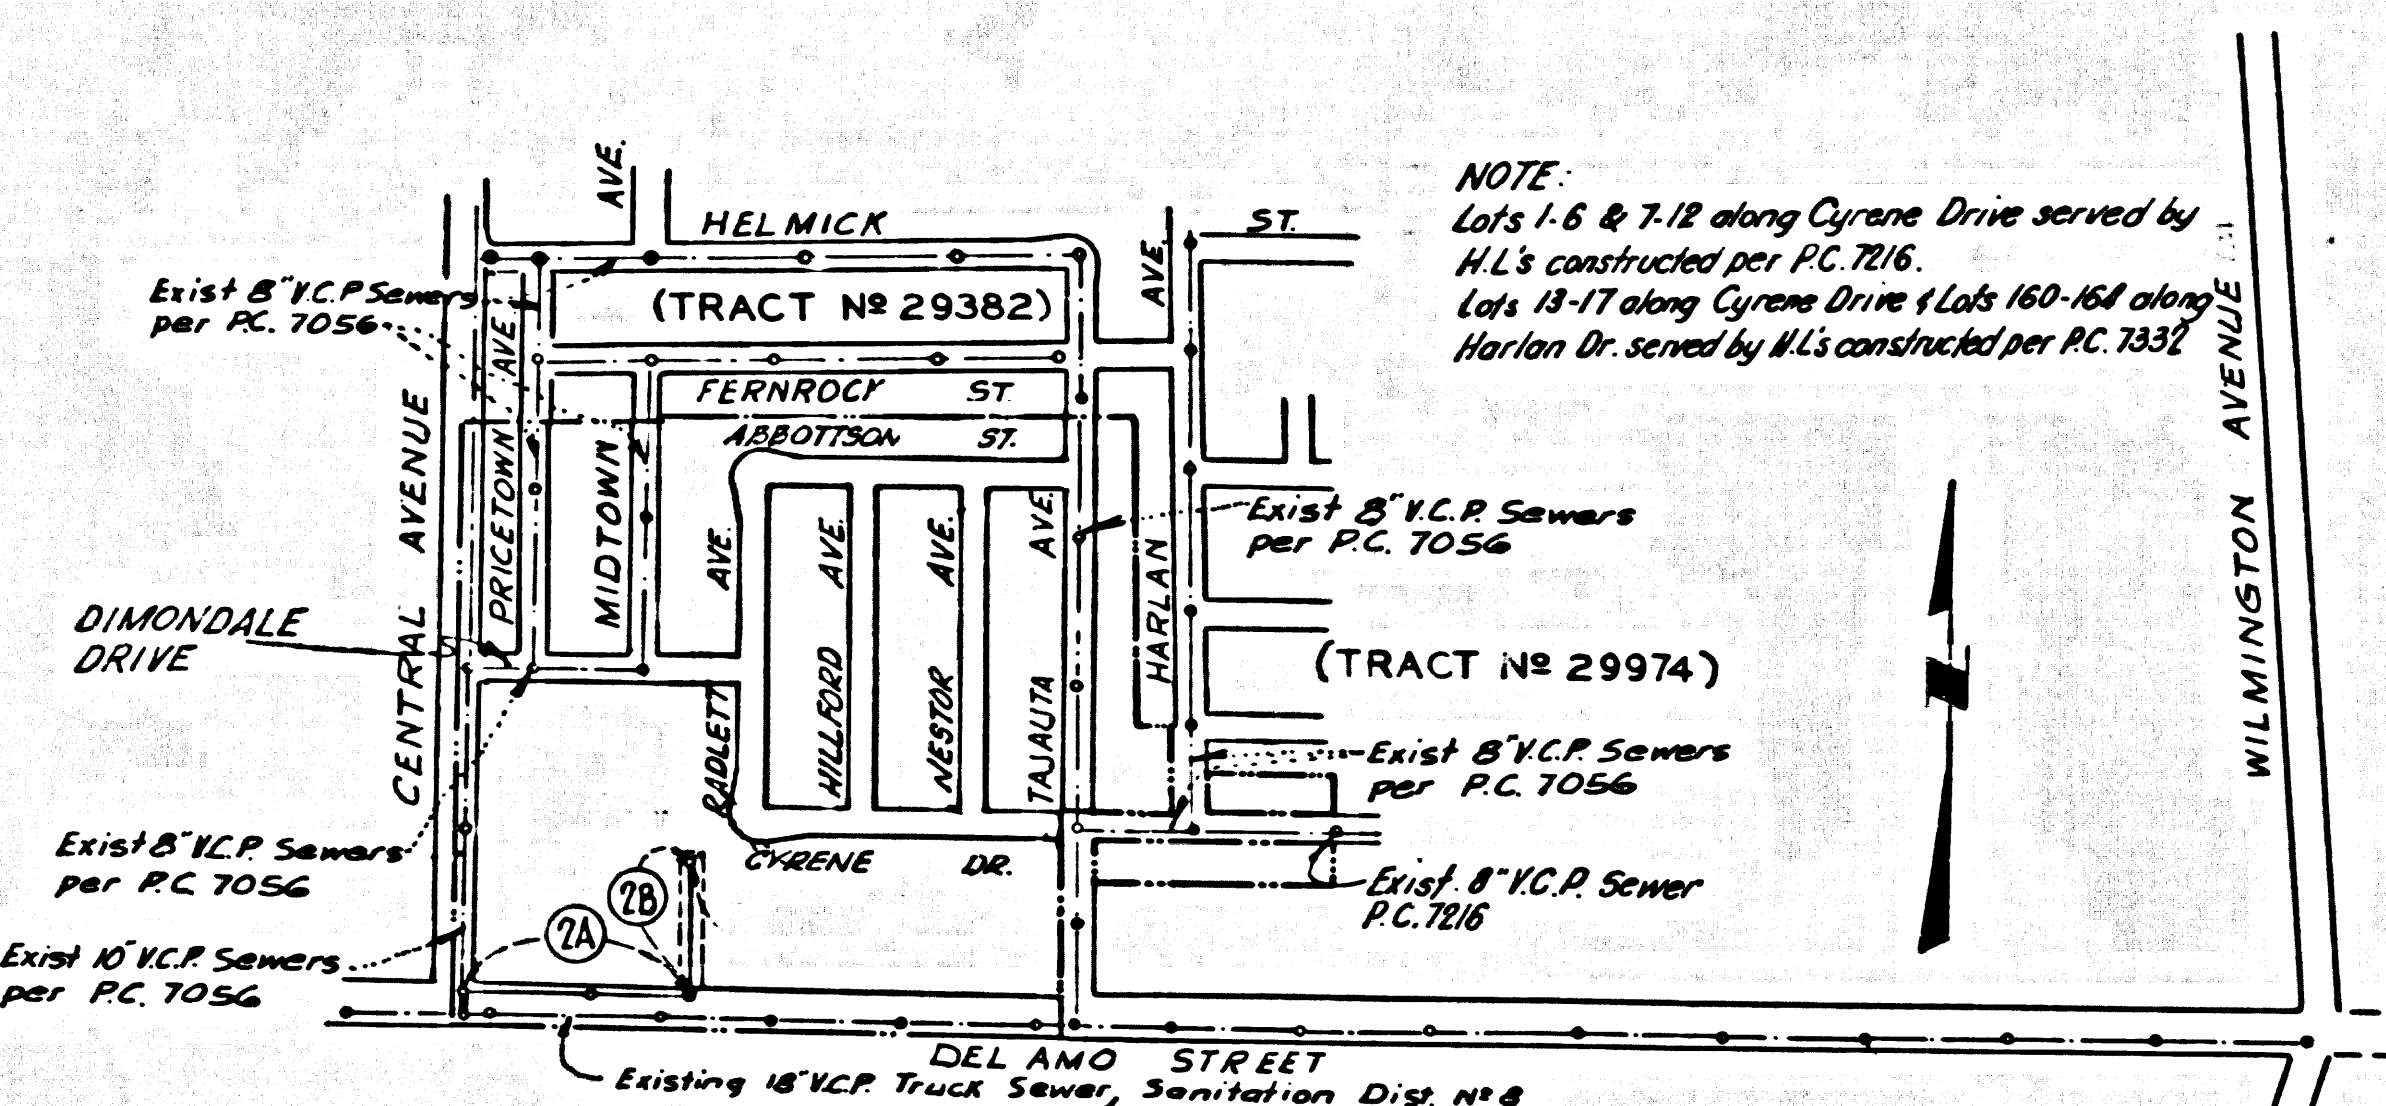

INDEX MAP
 SCALE 1"=600'

REVISION: 6" House Laterals revised
 to 4" House Laterals on all Pages
 except #12, #14, #15, #16, #999, #1000

REVISION: Eliminated Chimney
 at Sta. 2127 and 2128
 Page 2-B on 10' Easement.
 1-18-66
 Approved: *Edward J. Valerky*

REVISION: DELETION OF PAGES
 3 thru 11 PAGE 11 PERMITTED
 AS BUILT OF P.C. 7377, SECTION OF
 KEY MAP TO REFLECT SAME.
 5-23-68
 Approved: *Edward J. Valerky* DATE: 5/1/68

**COLLECT CHARGES
 AS INDICATED**
James C. Gattuso 7/20/65

NO CONNECTIONS FOR THE DISPOSAL OF
 INDUSTRIAL WASTES SHALL BE MADE TO
 SEWERS SHOWN ON THESE DRAWINGS
 WITHOUT WRITTEN PERMISSION FROM THE
 CHIEF ENGINEER AND GENERAL MANAGER
 OF THE COUNTY SANITATION DISTRICTS.

COUNTY OF LOS ANGELES, CALIFORNIA
 JOHN A. LAMBIE, COUNTY ENGINEER J. D. PARKHURST, CHIEF ENGINEER
 APPROVED BY: *Ed. J. Valerky* APPROVED BY: *J. D. Parkhurst*
 SUBMITTED BY: *James E. Whittle* REGIONAL ENGINEER OFFICE ENGINEER
 CHECKED BY: *James E. Whittle* REG. C. E. NO. 14305
 42456
 J.N. 0365.81

