

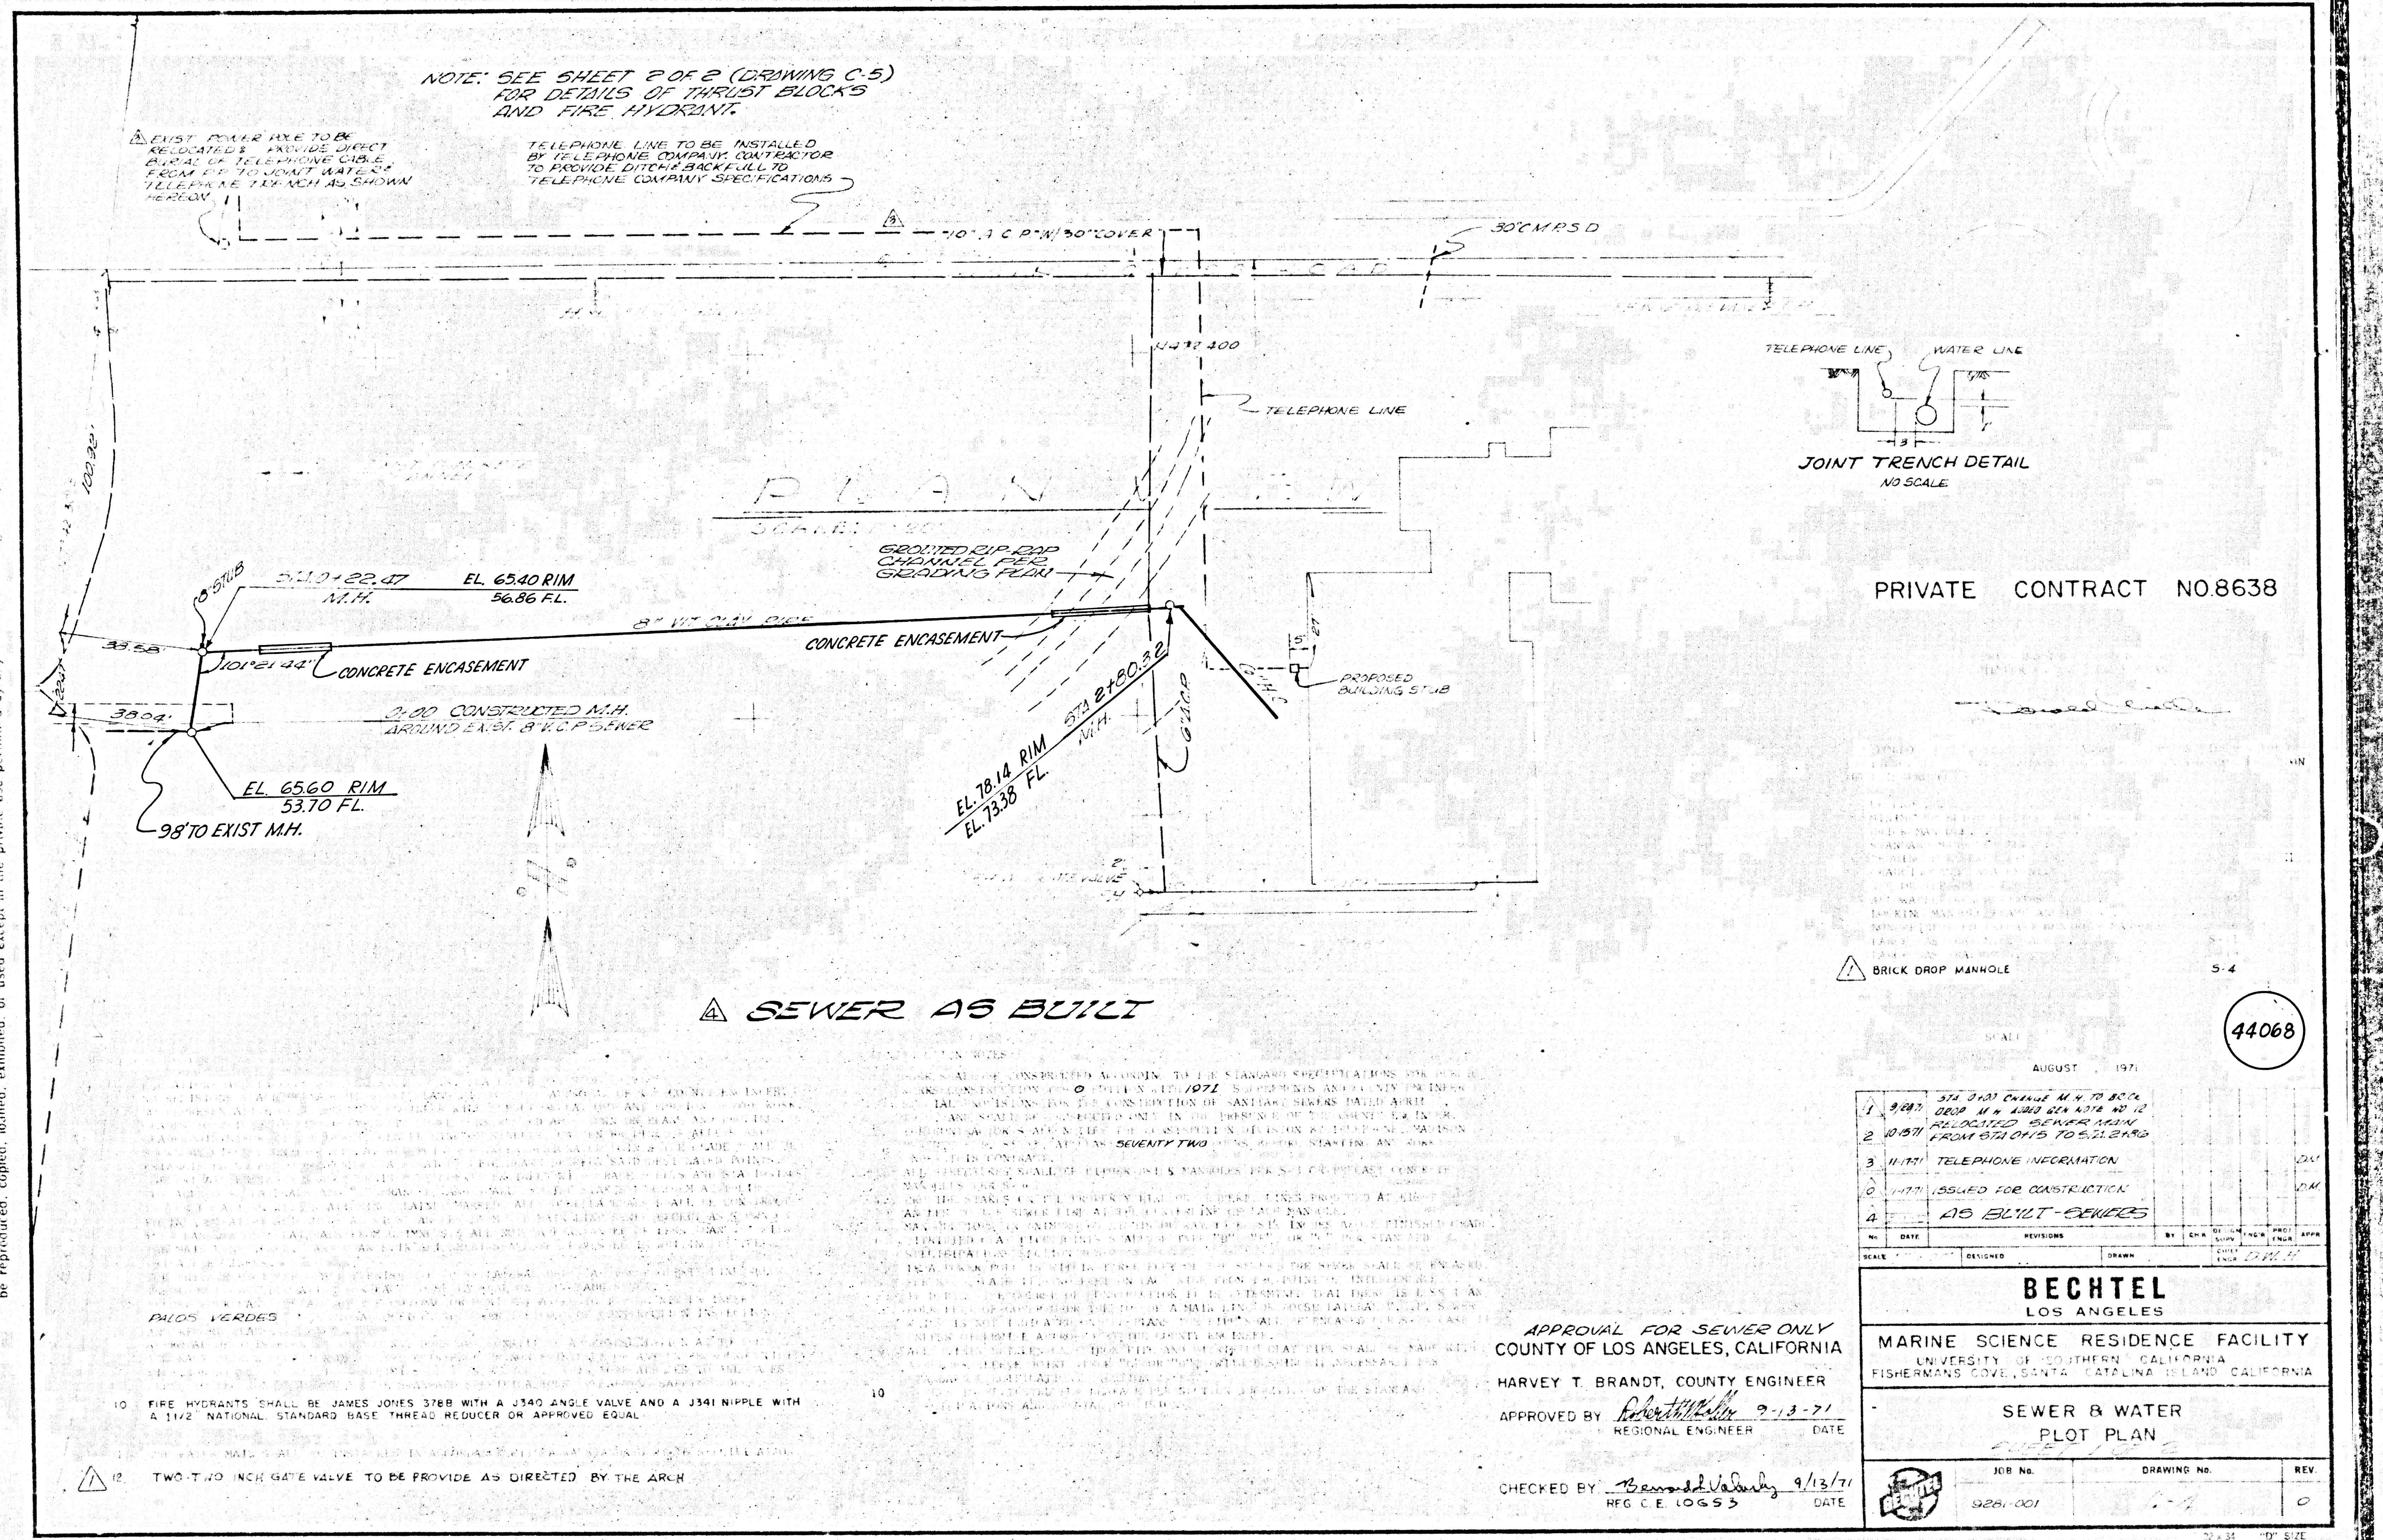
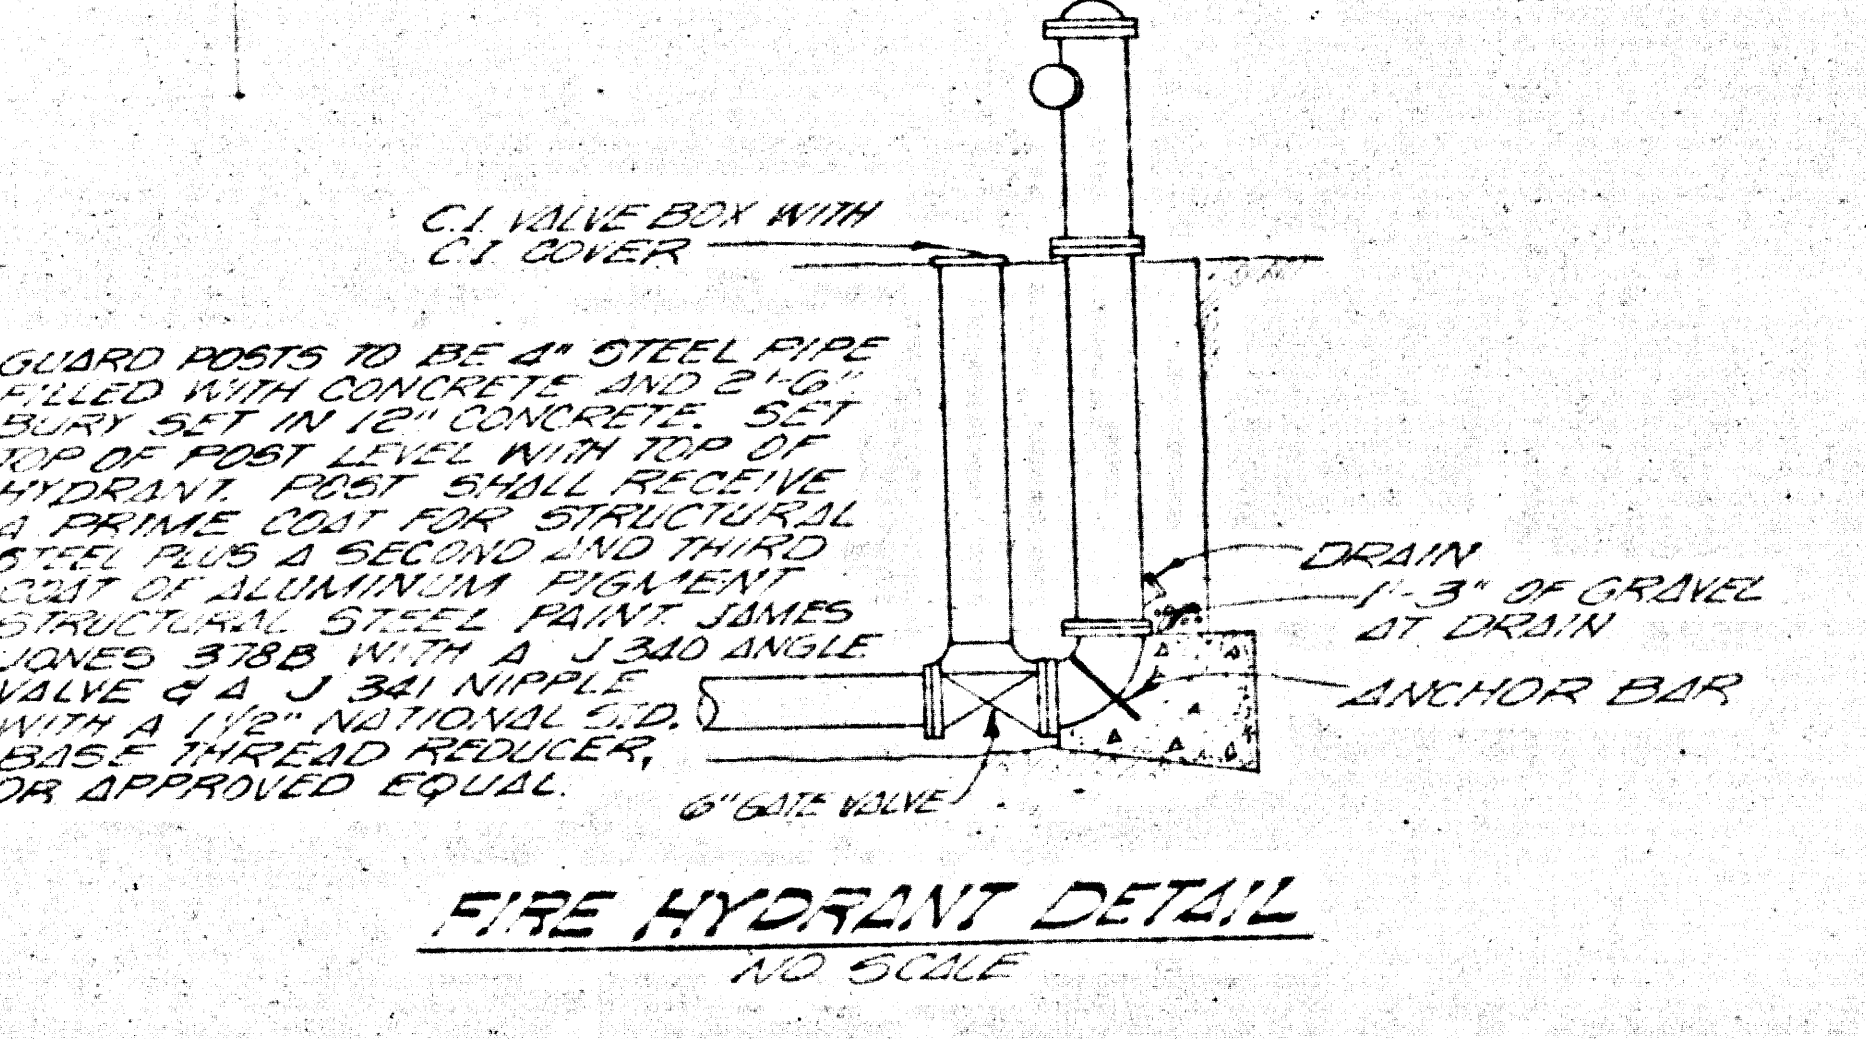


This drawing and the design it covers are the property of BECHTEL. They are merely loaned and on the borrower's express agreement that they will not be reproduced, copied, loaned, exhibited or used except in the private use permitted by the owner to the borrower.

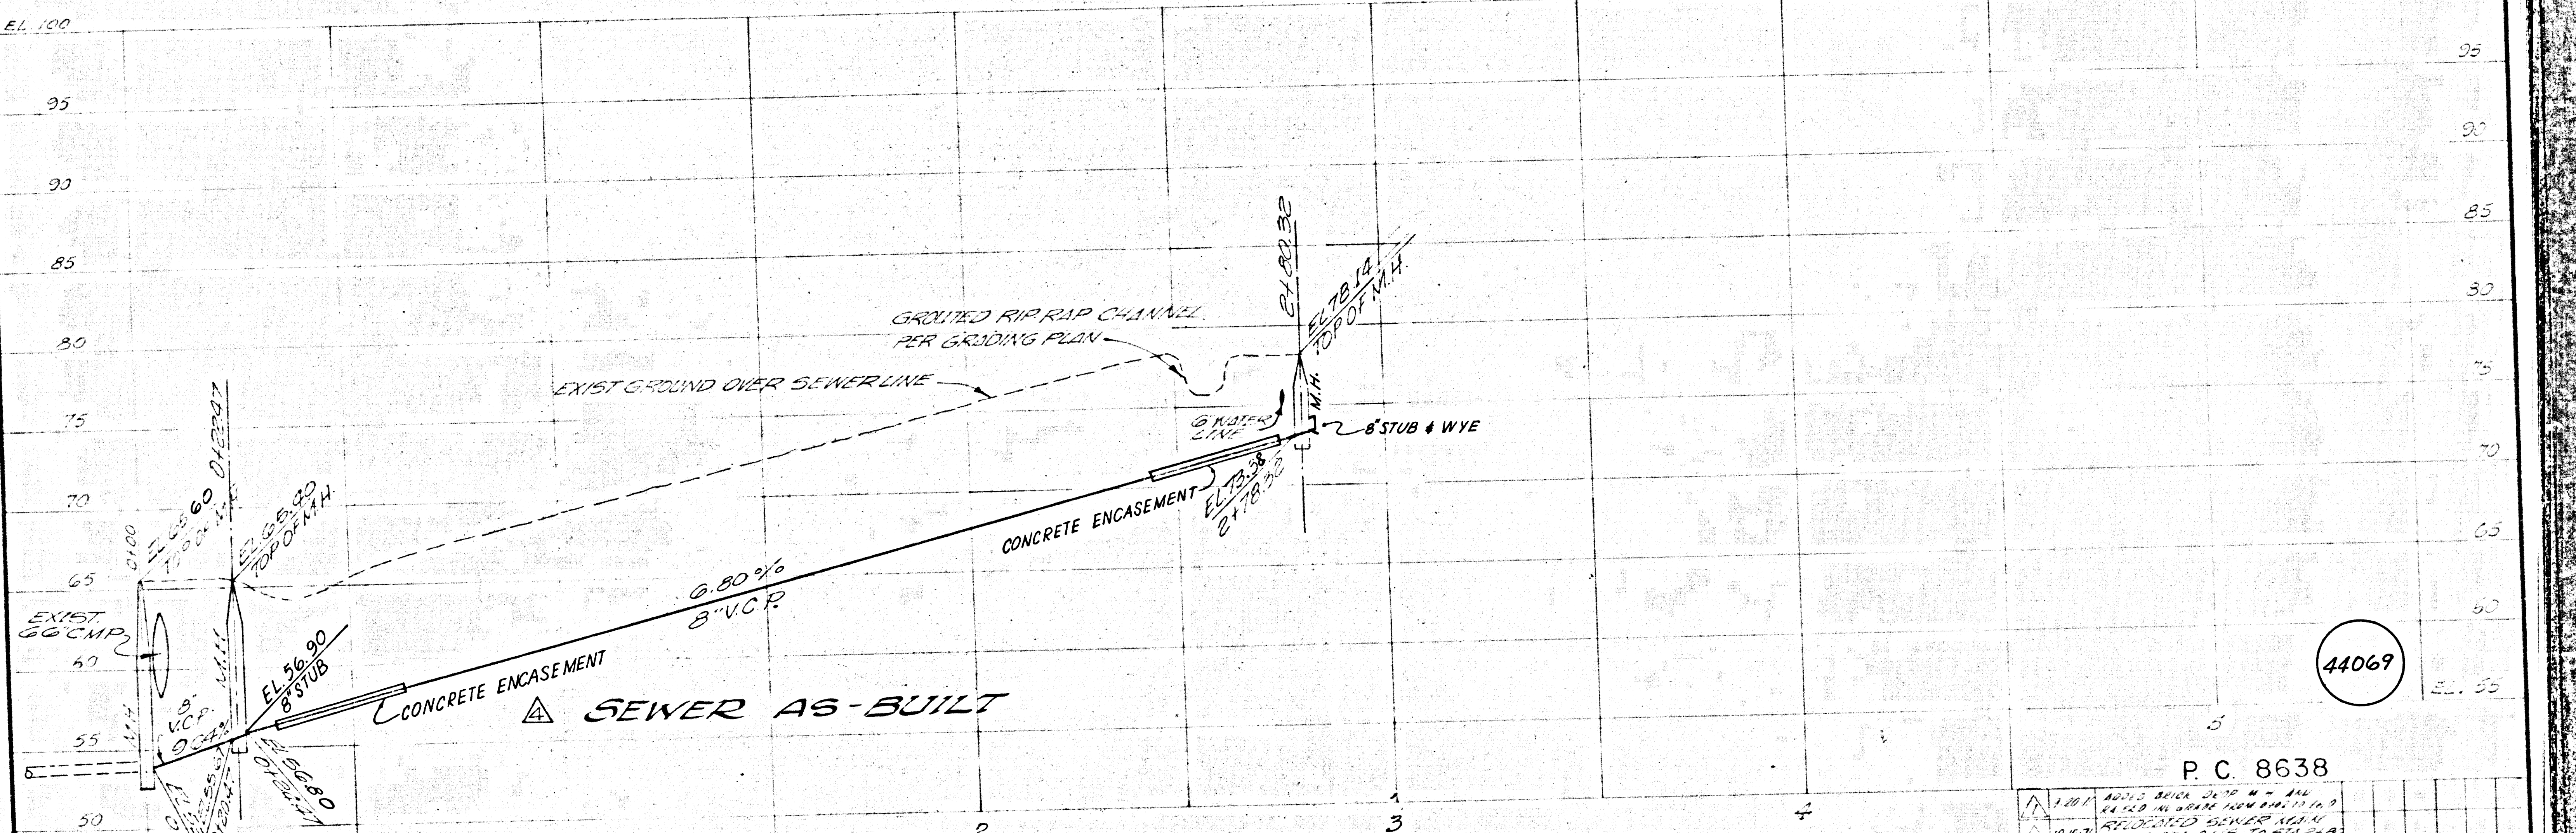

This drawing and the design it covers are the property of BECHTEL. They are hereby loaned and on the borrower's express agreement that they will not be reproduced, copied, loaned, exhibited, or used except in the private use permitted by any written consent given by the lender to the borrower.

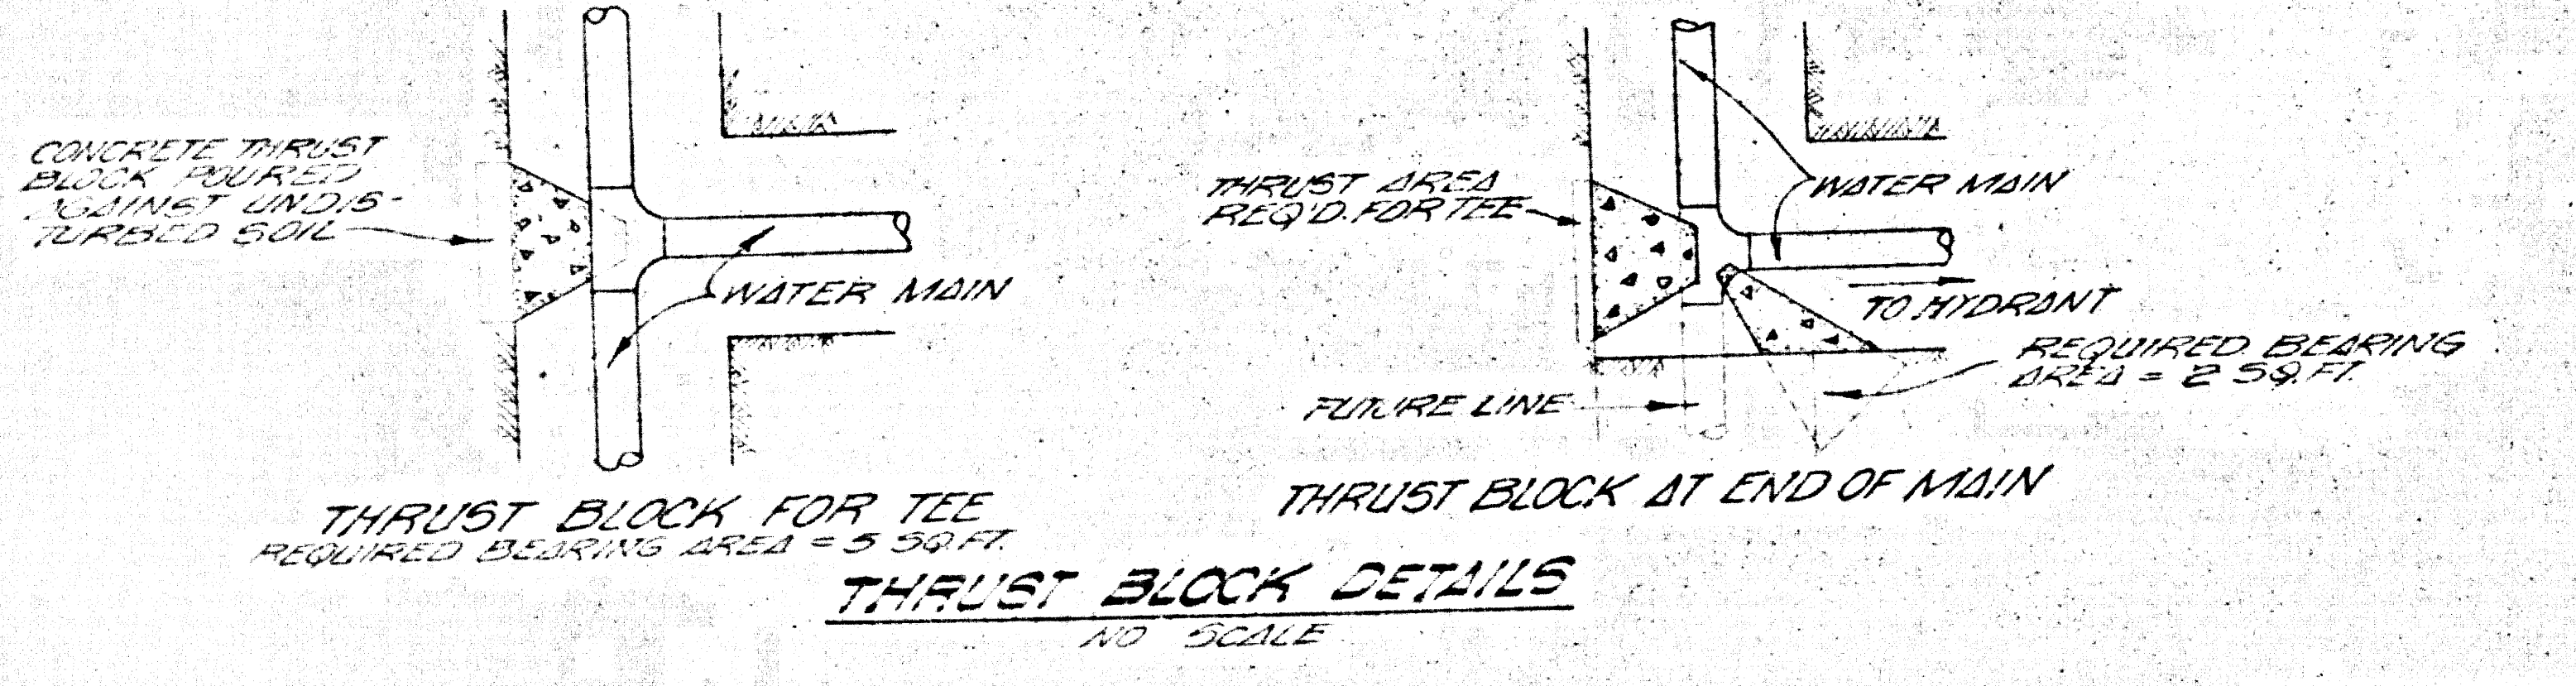

NOTE:
1. ALL ELEV. SHOWN ALONG SEWER LINE ARE INVERT ELEV.
2. ELEVATIONS ARE BASED UPON ELEV. OF FLOOR AT DOOR ON SOUTH SIDE OF EXIST. MARINE SCIENCE BUILDING 3. M. + CONC. @ DOOR ELEV. 55.50

P. C. 8638

NO.	DATE	REVISIONS	BY	CHECKED	INCH	APP.
1	12/17/57	ISSUED FOR CONSTRUCTION				
2	1/15/58	AS BUILT - SEWERS				

BECHTEL
LOS ANGELES

MARINE SCIENCE RESIDENCE FACILITY
UNIVERSITY OF SOUTHERN CALIFORNIA
FISHERMANS COVE, SANTA CATALINA ISLAND, CALIFORNIA

SEWER PROFILE

JOB No.	DRAWING No.	REV.
3281-001	15	0

22 x 34 1/2" SHEET

44069