


PROFILE


HORIZ. SCALE 1" = 40'
VERT. SCALE 1" = 4'

93 RD. STREET
5-20

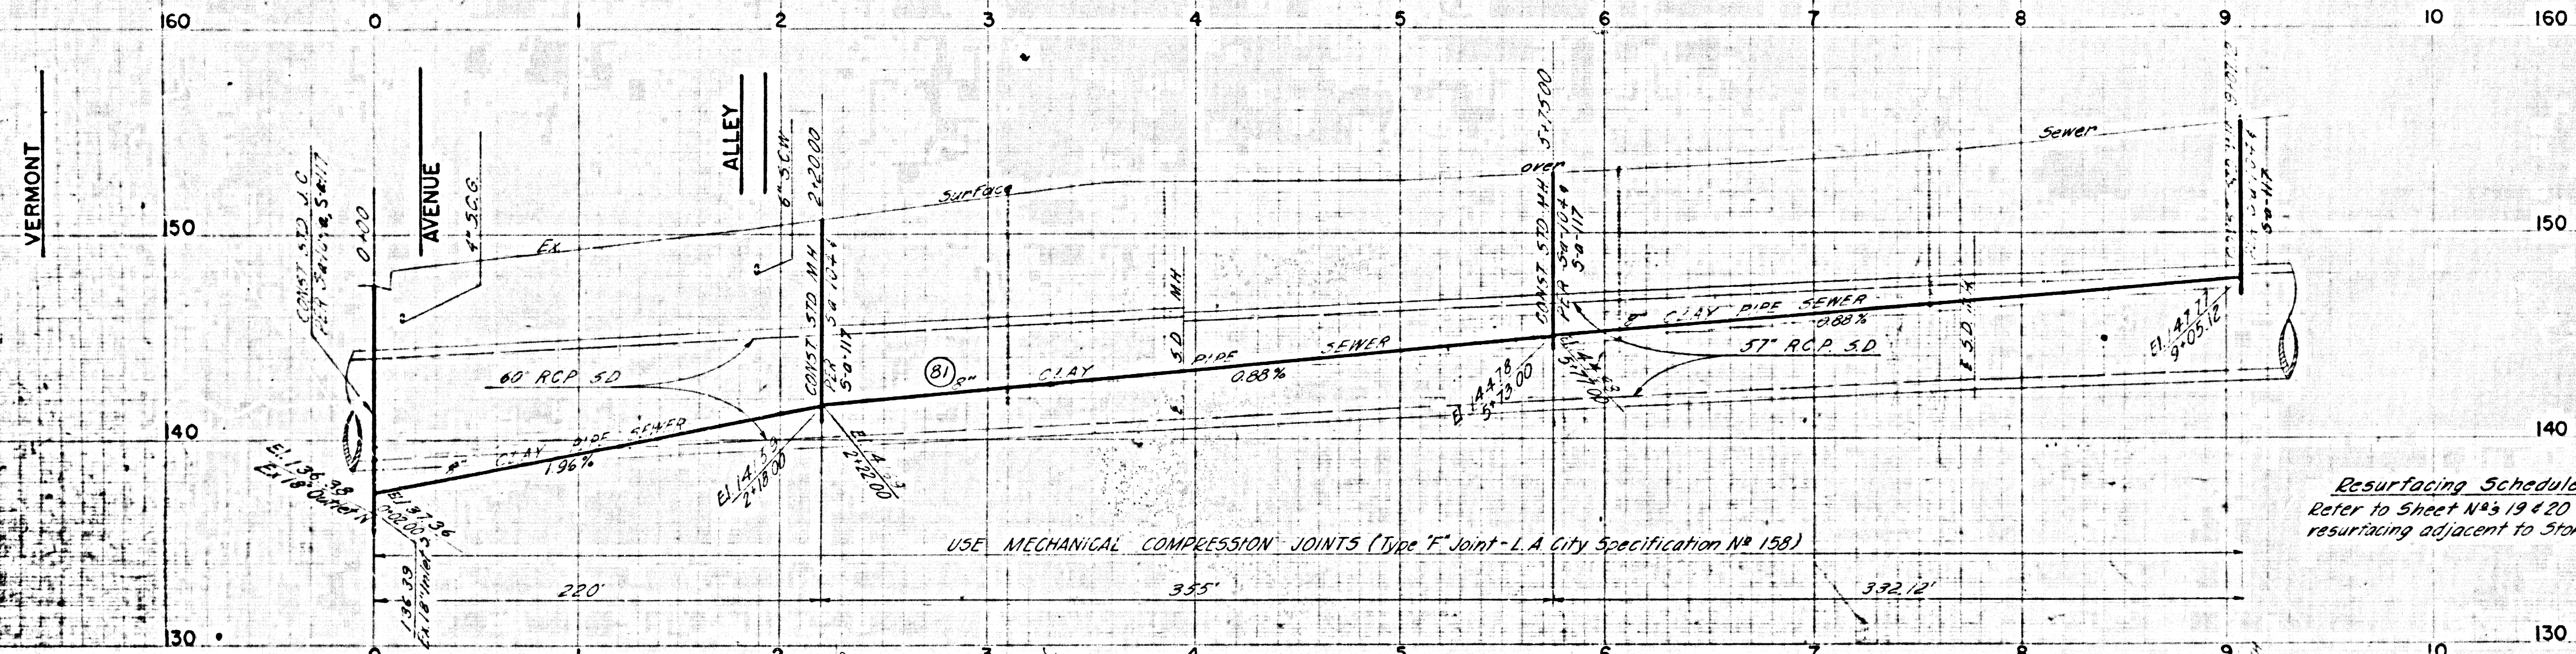


Resurfacing Schedule
Refer to Sheet Nos 19 & 20 for
resurfacing adjacent to Storm Drain

APPROVED: _____
COUNTY OF LOS ANGELES
JOHN A. LAMBE, COUNTY ENGINEER
BY: _____
ASSISTANT SANITARY ENGINEER

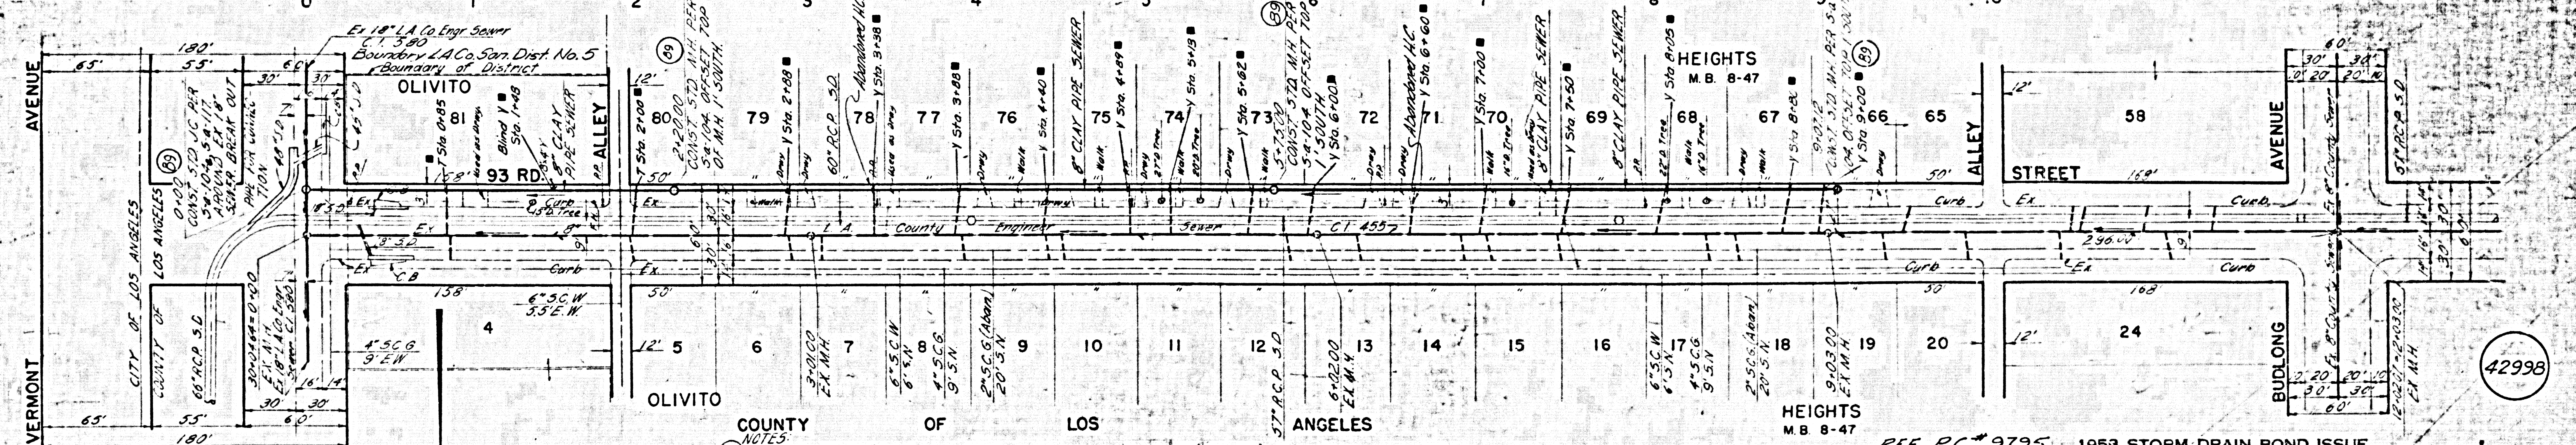

- NOTES:
- RECONNECT EX. H.C.'S ON SOUTH SIDE OF 93 RD. STREET AT PROPERTY LINE FROM STA 0+00 TO STA 9+01.12 PER STANDARD DRAWING 2-D250.
 - ALL H.C.'S 6' DEEP AT CURB LINE.
 - ALL STRUCTURES SHALL BE BRICK SEWER STRUCTURES PER 5-a-104 AND 5-a-104a.
 - USE STANDARD MANHOLE FRAMES & COVERS PER 5-a-117.
 - AN 8"x4" Y IS TO BE LAID TO EACH LOT WHERE THE EXISTING HOUSE LATERAL HAS BEEN ABANDONED.

BENCH MARK:
Set 5th W. Curb Vermont Ave
9' 1/4" 93rd St (W) Elev 147.865

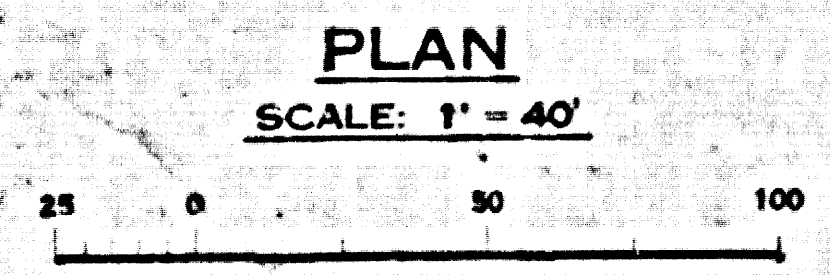

REF. P.C. # 9795 1953 STORM DRAIN BOND ISSUE

CITY OF LOS ANGELES BUREAU OF ENGINEERING		REVISIONS		LOS ANGELES COUNTY FLOOD CONTROL DISTRICT	
MARK	DATE	DESCRIPTION			
■	3-18-60	"As Built"			
SUBMITTED Nov 16 1952 BY: _____ DIVISION OF DISTRICT ENGINEERS			PROJECT NO. 489-UNIT 2 VERMONT AVENUE STORM DRAIN SUMMARY SCALE RELOCATION IN 93 RD STREET FROM VERMONT AVENUE TO 884 FEET WEST OF VERMONT AVENUE PLAN AND PROFILE		
APPROVED Nov 16 1952 BY: _____ CITY ENGINEER			DRAWN BY: _____ CHECKED BY: _____ DESIGNED BY: _____		
SCALE			DATE		
AS SHOWN			MAY 63 SHEET 12 OF 43		