


B.M. BL 4236 ELEV. 1211.232  
 RD. BN TAG N CB AVENIDA NAVARRE  
 77E + 30 N/O INT MCBEAN PKWY  
 @ NE COR  
 NEWHALL QUAD. 19.22

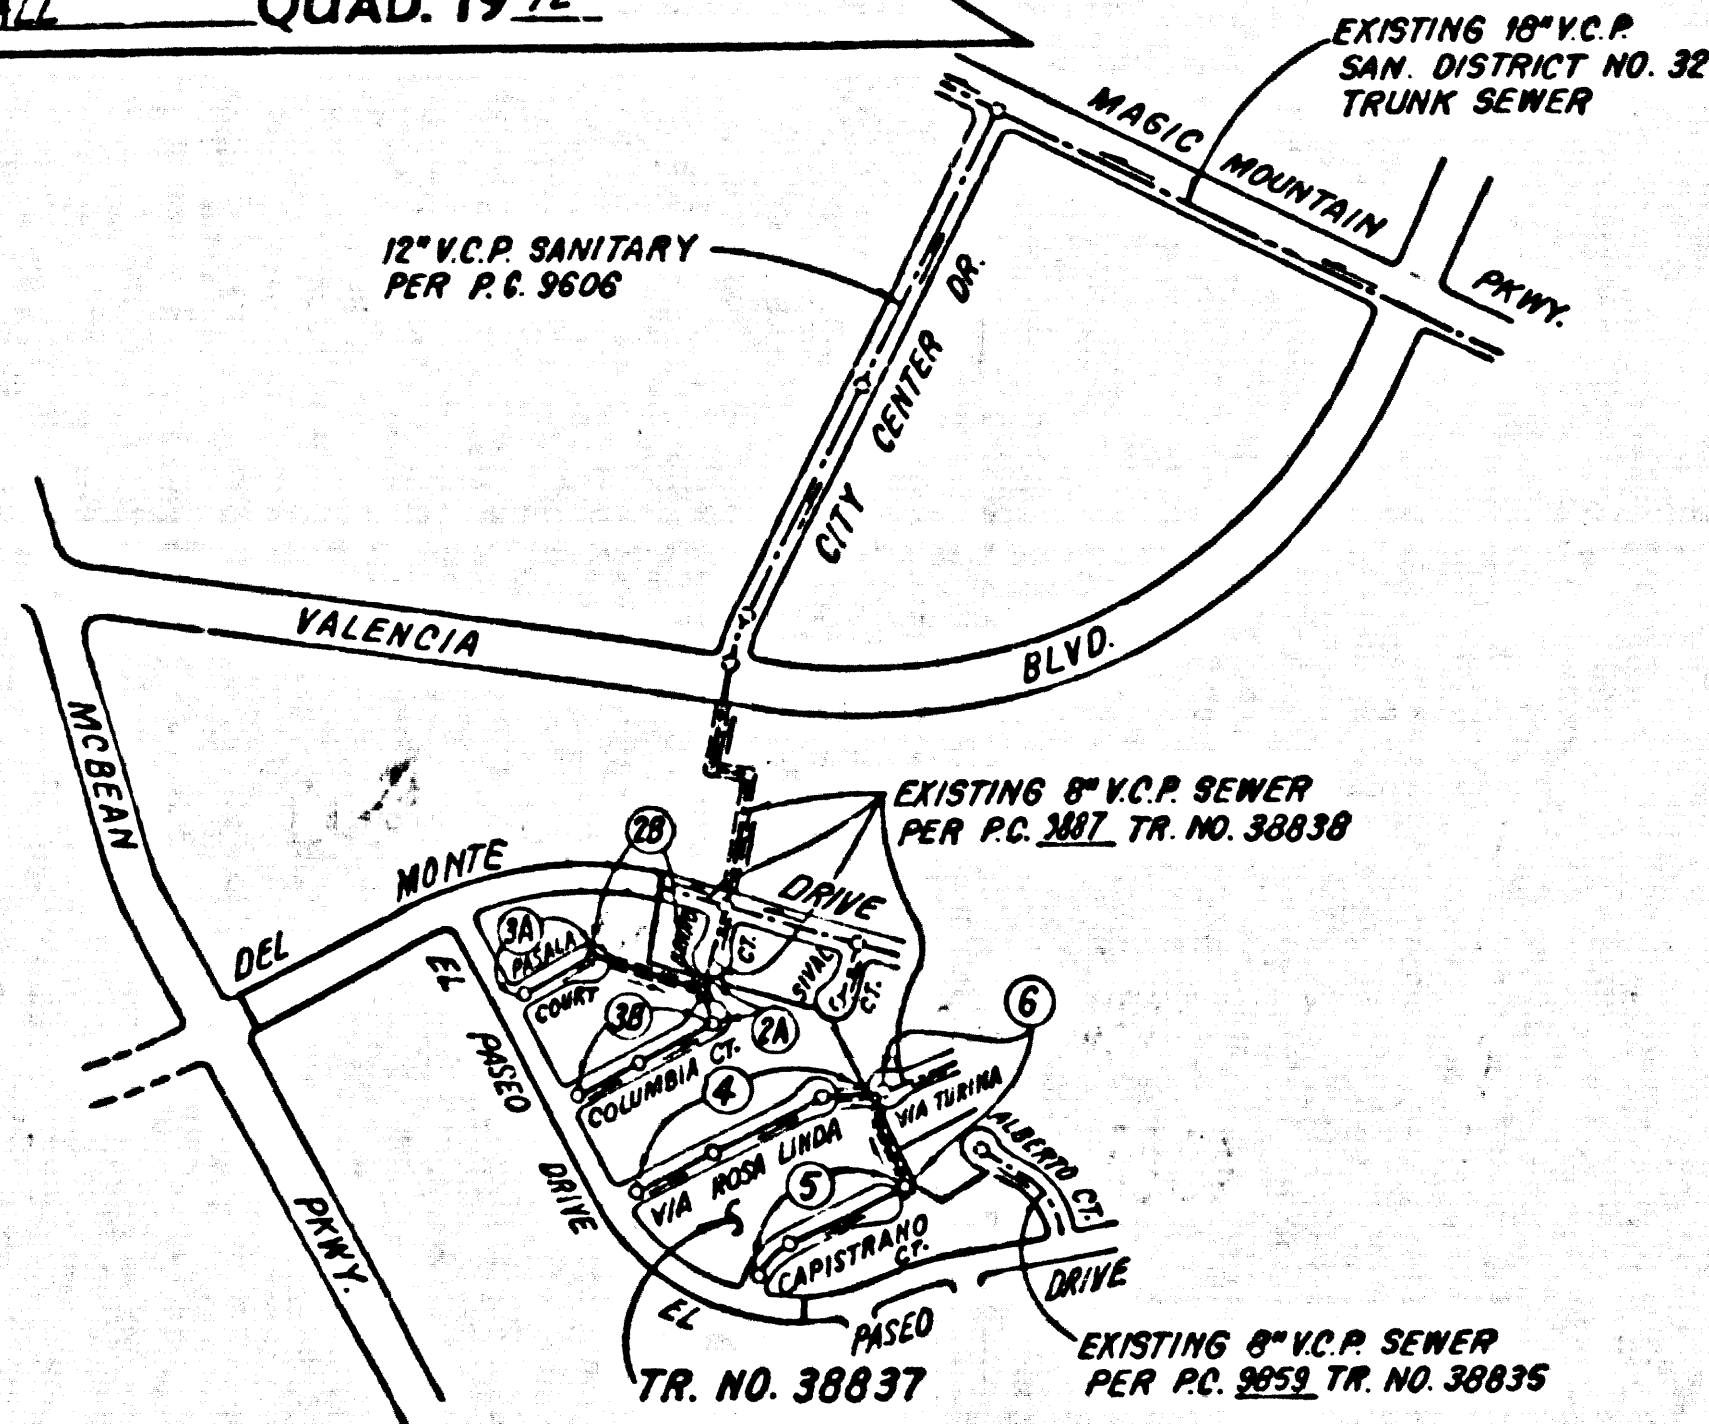

**INDEX MAP**  
 SCALE: 1"=500'  
 P.C. 3886  
 TRACT NO. 38837

NOTE: NUMBERS IN CIRCLES INDICATE PAGE NUMBERS

**REVISION: NO. 1**

PAGE 1. REVISED POSITION OF END MANHOLE IN PASALA COURT, COLUMBIA COURT, VIA ROSA LINDA. DELETED MANHOLE IN CUL. DE SAC IN CASTRANO COURT AND DELETED P.C. 9859 FROM "BOX FOR HOUSE CONNECTION PERMIT"

PAGE 3A. REVISED POSITION OF END MANHOLE IN COLUMBIA COURT, & 3B. AND PASALA COURT

PAGE 4. REVISED POSITION OF END MANHOLE IN VIA ROSA LINDA, ADDED 8" INLET ON S.W. ON MANHOLE AT STATION 1+00.00 AND CORRESPONDING 8" V.C.P. SEWER IN PLAN & PROFILE.

PAGE 5. DELETED MANHOLE AT STATION 3+40.00 IN CASTRANO COURT, AND ADDED MANHOLE AT STATION 2+82.56, AND DELETED SEWER IN TRACT NO. 38835 IN EASEMENT.

PAGE 6 ADDED PAGE 6 (PLAN & PROFILE)

APPROVED: *[Signature]* DATE: 6-21-83

ALLOW NO HOUSE CONNECTION PERMIT UNTIL OUTLET P.C. 9887 IS ACCEPTED & SAN SEWER EASEMENT IS RECORDED

NO CONNECTION FOR THE DISPOSAL OF INDUSTRIAL WASTES SHALL BE MADE TO SEWERS SHOWN ON THESE DRAWINGS UNTIL A PERMIT FOR INDUSTRIAL WASTEWATER DISCHARGE HAS BEEN ISSUED BY THE SANITATION DISTRICTS FOR SAID CONNECTION.

BEFORE BREAKING INTO OR CONSTRUCTION ON A COUNTY SANITATION DISTRICT SEWER AND PRIOR TO FINAL ACCEPTANCE OF THE PROJECT, SANITATION DISTRICT INSPECTOR SHALL BE NOTIFIED BY PHONE - 962-8605, 638-1161 SO THAT REQUIRED INSPECTION CAN BE MADE.

**GENERAL NOTES:**

- ELEVATIONS ARE IN FEET ABOVE U.S.C. & G.S. SEA LEVEL DATUM OF 1929.
- NO REVISIONS SHALL BE MADE IN THESE PLANS WITHOUT THE APPROVAL OF THE COUNTY ENGINEER.
- NO REPRESENTATIVE OF THE COUNTY ENGINEER WILL SURVEY OR LAY OUT ANY PORTION OF THE WORK.
- GRADES TO WHICH THE IMPROVEMENT IS TO BE CONSTRUCTED ARE SHOWN ON PLANS AND PROFILES. GRADE POINTS FOR TOP OF CURBS, CENTER LINE OF STREETS, OR CENTER LINE OF ALLEYS ARE SHOWN BY CIRCLES ON PROFILES. AT ALL POINTS BETWEEN DESIGNATED POINTS THE GRADE SHALL BE ESTABLISHED SO AS TO CONFORM TO A STRAIGHT LINE DRAWN BETWEEN SAID DESIGNATED POINTS.
- THE PRIVATE ENGINEER SHALL FURNISH THE COUNTY ENGINEER WITH GRADE SHEETS AND STATIONING FOR ALL HOUSE LATERALS AND "T" OR "T" BRANCHES AND SHALL PROVIDE STAKES FOR THEM AT THEIR PROPER LOCATIONS WITH STATIONING PLAINLY MARKED. ALL HOUSE LATERALS SHALL BE CONSTRUCTED BY A STRAIGHT ALIGNMENT AT RIGHT ANGLES FROM THE MAIN LINE SEWER EXCEPT AS SHOWN ON THE PLANS. HOUSE LATERALS FROM CHIMNEYS SHALL NOT HAVE AN ANGLE OF LESS THAN 45° WITH THE MAIN LINE SEWER. ANY CHANGE IN ALIGNMENT SHALL BE REQUESTED IN WRITING BY THE PRIVATE ENGINEER.
- THE PRIVATE ENGINEER SHALL FURNISH THE HOUSE LATERAL DEPTH AT THE PROPERTY LINE BELOW THE TOP OF CURB ELEVATION FOR EACH HOUSE LATERAL ON THE GRADE SHEET.
- BEFORE WORK CAN BE STARTED, THE CONTRACTOR MUST OBTAIN A PERMIT TO EXCAVATE IN COUNTY STREETS FROM THE L.A. COUNTY ROAD DEPT., DISTRICT OFFICE NO. 6, AND PAY A FEE TO THE COUNTY ENGINEER, \$50 & RETURN A: L.A. 90890 TO COVER THE COST OF CONSTRUCTION INSPECTION AND RECORD PLANS.
- IF WORK IS TO BE DONE ON A STATE HIGHWAY, A PERMIT MUST BE OBTAINED FROM THE STATE OF CALIFORNIA, DIVISION OF HIGHWAYS, 120 SOUTH SPRING STREET, LOS ANGELES, CALIFORNIA.
- APPROVAL OF THIS PLAN BY THE COUNTY OF LOS ANGELES DOES NOT CONSTITUTE A REPRESENTATION AS TO THE ACCURACY OF THE LOCATION OR OF THE EXISTENCE OR NON-EXISTENCE OF ANY UNDERGROUND UTILITY PIPE, OR STRUCTURE WITHIN THE LIMITS OF THIS PROJECT. THIS NOTE APPLIES TO ALL PAGES.
- REFER TO SECTION 7-18.4.1 OF THE STANDARD SPECIFICATIONS, REGARDING SAFETY CORDS.
- PRIOR TO THE PRELIMINARY OF THE REQUIRED SEWER CONNECTION PERMIT THE CONTRACTOR SHALL OBTAIN AND FILE WITH THE COUNTY ENGINEER COPIES OF A PERMIT TO EXCAVATE IN COUNTY STREETS FROM THE L.A. COUNTY ENGINEER ROAD DEPARTMENT, A PERMIT FOR EXCAVATION AND TRENCHING FROM THE STATE OF CALIFORNIA DIVISION OF HIGHWAYS, AND A CERTIFICATE OF WORKERS COMPENSATION INSURANCE WITH THE COMMISSION OF COUNTY ENGINEERS, 543 SOUTH WASHINGTON, P.O. BOX 101, LOS ANGELES, CALIFORNIA 90009. NAMED AS THE CONTRACTOR HOLDER TO BE NOTIFIED 30 DAYS PRIOR TO CANCELLATION OF POLICY.

**CONSTRUCTION NOTES:**

- WORK SHALL BE CONSTRUCTED ACCORDING TO THE STANDARD SPECIFICATIONS FOR PUBLIC WORKS CONSTRUCTION 1979 EDITION WITH THE SUPPLEMENTS AND COUNTY ENGINEER SPECIAL PROVISIONS FOR THE CONSTRUCTION OF SANITARY SEWERS DATED 8/78.
- THE CONTRACTOR SHALL NOTIFY THE ENV. DIV. DIVISION BY TELEPHONE, MADISON 6-67, EXT. 8150, AT LEAST TWENTY-FOUR HOURS BEFORE STARTING ANY WORK UNDER THIS CONTRACT.
- HOUSE LATERALS TO BE CONSTRUCTED WITH INVERTS AT PROPERTY LINE 4 FEET BELOW CURB GRADE EXCEPT AS NOTED.
- IF ON THE MANHOLES MAY BE USED FOR CONNECTIONS TO MAINLINE SEWERS EXCEPT AS NOTED.
- ALL STRUCTURES SHALL BE EITHER BRICK MANHOLES PER S-3 OR PRECAST CONCRETE MANHOLES PER S-3A, EXCEPT AS NOTED.
- PROVIDE STAKES ON THE PROPERTY LINE OR PROPERTY LINES PRODUCED AT RIGHT ANGLES TO THE SEWER LINE AT THE CENTER LINE OF EACH MANHOLE.
- MANHOLE TOPS ON UNIMPROVED RIGHTS OF WAY TO BE SIX INCHES ABOVE FINISHED GRADE.
- WITHIN CLAY PIPE JOINTS SHALL BE FIVE "D", OR "G" PER STANDARD SPECIFICATIONS SECTION 306-3.
- IF A POWER POLE IS WITHIN THREE FEET OF THE SEWER, THE SEWER SHALL BE ENCASED PER S-3A, CASE 2, TWO FEET ON EACH SIDE FROM THE POINT OF INTERFERENCE.
- IF DURING THE COURSE OF CONSTRUCTION IT IS DETERMINED THAT THERE IS LESS THAN FOUR FEET OF COVER OVER THE TOP OF A MAIN LINE OR HOUSE LATERAL V.C.P. SEWER WHICH IS NOT INDICATED ON THE PLANS, THE PIPE SHALL BE ENCASED PER S-3A, CASE 2X UNLESS OTHERWISE APPROVED BY THE COUNTY ENGINEER.
- ALL JOINTS BETWEEN CAST IRON PIPE AND WITHIN CLAY PIPE SHALL BE MADE WITH A RUBBER SLEEVE JOINT, TYPE "C" OR "B", WITH GASKETS IF NECESSARY PER STANDARD SPECIFICATIONS, SECTION 306-2.
- SEWERS TO BE TESTED FOR LEAKAGE PER SECTION 306-1.8 OF THE STANDARD SPECIFICATIONS AND SPECIAL PROVISIONS.
- RESURFACE ALL TRENCHES WITHIN PAVED AREAS TO MEET L.A. COUNTY ROAD DEPT. OR CALIFORNIA STATE HIGHWAY REQUIREMENTS IN ACCORDANCE WITH PERMITS.
- PERMITS PRIOR TO THE ISSUANCE OF A CERTIFICATE OF PARTIAL ACCEPTANCE.
- FULL COMPLIANCE WITH SECTION 306-1.5B OF THE SPECIAL PROVISIONS WILL BE REQUIRED FOR BACKFILL IN STREETS. CERTIFICATION OF BACKFILL COMPACTION AND SAND EQUIVALENTS BY A QUALIFIED, REGISTERED TESTING LABORATORY SHALL BE PROVIDED BY THE PERMITTEE PRIOR TO THE ISSUANCE OF A CERTIFICATE OF PARTIAL ACCEPTANCE.
- SPECIAL BACKFILL IN STREET CONSTRUCTION: (A) BACKFILL PERIOD AND REPLACE OTHER EARTH AS IS TO ACHIEVE THE ORIGINAL OR FINISHED GRADE AND REPAIR THEREIN ON THE ORIGINAL PLAN APPROVED FOR THIS DEVELOPMENT BY THE ENGINEER & SUFFICIENT TO BE USED FOR CONNECTIONS TO MAINLINE SEWERS SHALL BE CONSTRUCTED TO A MINIMUM OF 95% OF MAXIMUM DENSITY PER ASTM D 1557 METHOD OF TEST D 1557-73 AS MODIFIED ACCEPTABLE BACKFILLING OF SOIL CONSTRUCTION SHALL BE SUBMITTED TO THE ENVIRONMENTAL DEVELOPMENT DIVISION.

PROFILE, ALIGNMENT AND GRADE OF  
**SANITARY SEWERS** PAGE 1  
 TO BE CONSTRUCTED IN  
**TRACT NO. 38837**  
 PRIVATE CONTRACT NO. 9886

W.S. 62  
 3 SHEETS, 6 PAGES  
 SCALE: VERT. 1"=4' JULY, 1980  
 HORIZ. 1"=40'  
 PREPARED IN THE OFFICES OF  
 SIKAND ENGINEERING ASSOCIATES  
 15230 SUNBANK BLVD. VAN NUYS  
 CA. 91411 (213) 781-8332  
 BY: *[Signature]*  
 REG. C. E. NO. 21833

50341

THE FOLLOWING LATEST REVISED STANDARD PLANS ON FILE IN THE OFFICE OF THE COUNTY ENGINEER SHALL APPLY IN THE CONSTRUCTION OF THIS PROJECT.

MINIMUM PUBLIC SAFETY REQUIREMENTS	S-3
BRICK MANHOLE	S-3
STANDARD MANHOLE STEP	S-17
BEDDING FOR SEWER PIPE	S-18
GRAVING AND BRICKWORK	S-19
WYE OR TEE SUPPORT	S-20
ALLOWABLE TRENCH WIDTHS	S-20
LOCKING MANHOLE FRAME AND COVER	S-20
NON-REINFORCED PRECAST CONCRETE MANHOLE	S-20

COUNTY OF LOS ANGELES, CALIFORNIA  
 COUNTY ENGINEER  
 STEPHEN J. KOONCE, COUNTY ENGINEER WALTER E. GARRISON, CHIEF ENGINEER  
 CO. SAN DIST. NO. 32  
 APPROVED: *Malcolm L. Murphy* 3-17-81 APPROVED: *Frank R. Davis* 3/20/81  
 (DATE) (DATE)  
 OFFICE ENGINEER  
 CHECKED: *Ralph Davis* 3/16/81  
 (DATE)  
 REG. C. E. NO. 16393  
 SANTA CLARITA VALLEY BLDG. DIST. 82

