

**SANITARY SEWERS**

TO BE CONSTRUCTED IN

TRACT NO. 44330

PRIVATE CONTRACT NO. 10476

A-290 W.S. 71  
6 SHEETS, 12 PAGES

51588

SCALE: VERT. 1" = 4'  
HORIZ. 1" = 40'


DEC. 1985  
PREPARED IN THE OFFICES OF  
SISKAND ENGINEERING ASSOCIATES  
15230 BURBANK BLVD.  
VAN NUYS, CA. 91411 PHONE (818) 787-8550  
BY: *James Brunson* (KEENAN GIRISGEN)  
REG. C.E. No. 21743

THE FOLLOWING LATEST REVISED STANDARD PLANS ON FILE IN THE OFFICE OF THE DEPARTMENT OF PUBLIC WORKS SHALL APPLY IN THE CONSTRUCTION OF THIS PROJECT:

|   |      |
|---|------|
| LEGEND                                  | 0-1  |
| MINIMUM PUBLIC SAFETY REQUIREMENTS      | 0-2  |
| BRICK MANHOLE                           | 0-3  |
| STANDARD MANHOLE STEP                   | 0-17 |
| BEDDING FOR SEWER PIPE                  | 0-21 |
| CRACKING AND ENCASUREMENT               | 0-22 |
| WYE OR TEE SUPPORT                      | 0-23 |
| ALLOWABLE TRENCH WIDTHS                 | 0-26 |
| LOCKING MANHOLE FRAME AND COVER         | 0-28 |
| NON-REINFORCED PRECAST CONCRETE MANHOLE | 0-30 |

COUNTY OF LOS ANGELES, CALIFORNIA  
THOMAS A. TIDEMANSON  
DIRECTOR OF PUBLIC WORKS  
APPROVED: *Carl J. DeLeon* 5/23/86 (DATE)  
APPROVED: *John J. DeLeon* 5/24/86 (DATE)  
CHECKED: *James Brunson* 5/24/86 (DATE)  
REG. C.E. NO. 16641  
ANTELOPE VALLEY BLDG. DIST. 8

B.M. CL 397 ELEV. 2513.813  
CS MON IN WELL 22 IN DN & CIL  
INT OF AVE M & 60TH ST W MKD  
(SEC COR 34 35 32 17N 16N R13W)  
LANCASTER QUAD. 19 75

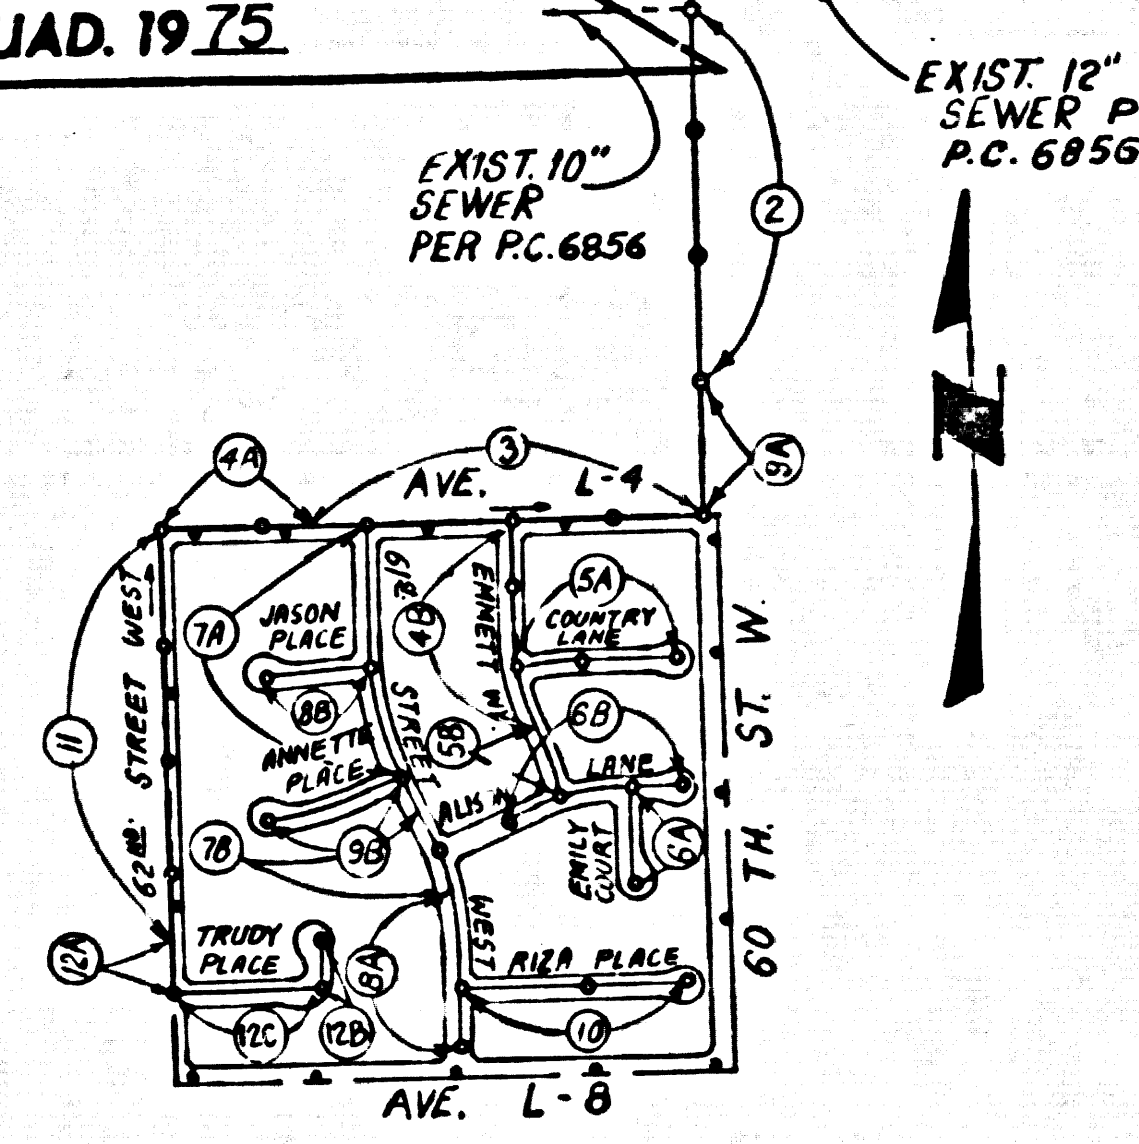

INDEX MAP  
SCALE: 1" = 600'

TRACT NO. 44330  
P.C. 10476

NOTE:  
NUMBERS IN CIRCLES INDICATE  
PAGE NUMBERS.

**CONSTRUCTION NOTES:**

- 16- FULL COMPLIANCE WITH PART IV OF THE SPECIAL PROVISIONS IS REQUIRED FOR THE INSTALLATION OF A.B.S. COMPOSITE PIPE.
- 17- MANHOLE WATER STOP GASKETS AND CLAMPS ARE REQUIRED FOR THE CONNECTION OF A.B.S. COMPOSITE PIPE TO MANHOLE STRUCTURES.
- 18- A.B.S. SOLID WALL PIPE MUST BE USED FOR WYE AND HOUSE LATERAL CONNECTIONS TO A.B.S. COMPOSITE MAINLINE SEWER PIPE.
- 19- A.B.S. COMPOSITE PIPE SHALL BE BEDDED IN CONFORMANCE WITH THE TABLE IN SECTION B-3.1 PART IV OF THE SPECIAL PROVISIONS.
- 20- 3 DEGREE DEFLECTION COUPLERS MUST BE USED TO ACCOMPLISH RADIUS OF CURVATURE LESS THAN 380'.

NO CONNECTION FOR THE DISPOSAL OF INDUSTRIAL WASTES SHALL BE MADE TO SEWERS SHOWN ON THESE DRAWINGS UNTIL A PERMIT FOR INDUSTRIAL WASTEWATER DISCHARGE HAS BEEN ISSUED BY THE SANITATION DISTRICTS FOR SAID CONNECTION.

BEFORE BREAKING INTO OR CONSTRUCTION ON A COUNTY SANITATION DISTRICT SEWER AND PRIOR TO FINAL ACCEPTANCE OF THE PROJECT, SANITATION DISTRICT INSPECTOR SHALL BE NOTIFIED BY PHONE 818-962-8605 SO THAT REQUIRED INSPECTION CAN BE MADE.

REVISION NO. 1 DATE 7-7-86  
PAGE 9: DELETE ENCASUREMENT OF HOUSE LATERALS FOR LOTS 43 THROUGH 45, INCLUSIVE  
PAGE 7B: DELETE ENCASUREMENT OF HOUSE LATERALS FOR LOTS 83, 84 AND 85  
PAGE 8A: DELETE ENCASUREMENT OF HOUSE LATERALS FOR LOTS 84, 90 AND 91  
PAGE 10: DELETE ENCASUREMENT OF HOUSE LATERALS FOR LOT 4 THROUGH 9, INCLUSIVE  
PAGE 12C: DELETE ENCASUREMENT OF HOUSE LATERALS FOR LOTS 94 THROUGH 104, INCLUSIVE  
APPROVED: *Sandy G. Holt*  
DEPARTMENT OF PUBLIC WORKS


REVISION NO. 2 DATE 9-24-86  
PAGE 3: SHIFT 3 CHIMNEYS TO STA. 5+23, 5+44 AND 2+41  
PAGE 6A: REVISED LATERAL TO LOT 17  
PAGE 6B: REVISED LATERAL TO LOT 25  
PAGE 8A: REVISED LATERAL TO LOT 91; DELETED STUD UPSTREAM OF M.H. @ STA. 15+75  
PAGE 12B: REVISED LATERALS TO LOTS 93, 94 AND 96  
PAGE 12C: REVISED LATERAL TO LOT 99  
PAGE 11: ADDED LATERAL TO LOT 117  
APPROVED: *Sandy G. Holt* 9-26-86, *David C. Hays* 9/26/86  
DEPARTMENT OF PUBLIC WORKS

**GENERAL NOTES:**

1. ELEVATIONS ARE IN FEET ABOVE 1985 B.S.S. SEA LEVEL DATUM OF 1985.
2. NO REVISIONS SHALL BE MADE IN THESE PLANS WITHOUT THE APPROVAL OF THE DIVISION OF PUBLIC WORKS.
3. NO REPRESENTATIVE OF THE DEPARTMENT OF PUBLIC WORKS WILL SURVEY OR LAY OUT ANY PORTION OF THE WORK.
4. GRADES TO WHICH THIS IMPROVEMENT IS TO BE CONSTRUCTED ARE SHOWN ON PLANS AND PROFILES AT ALL POINTS BETWEEN DESIGNATED POINTS. CENTER LINE OF STREETS OR CENTER LINE OF ALLEYS ARE SHOWN BY CIRCLES OR PROFILES AT ALL POINTS BETWEEN DESIGNATED POINTS. GRADE SHALL BE ESTABLISHED SO AS TO CONFORM TO A STRAIGHT LINE OR CURVE BETWEEN SAID DESIGNATED POINTS.
5. THE PRIVATE ENGINEER SHALL FURNISH THE DEPARTMENT OF PUBLIC WORKS WITH GRADE SHEETS AND STATIONING FOR ALL HOUSE LATERALS AND 12" OR 18" BRANCHES AND SHALL PROVIDE STAKES FOR THEM AT THEIR PROPER LOCATIONS WITH STATIONING PLAINLY MARKED. ALL HOUSE LATERALS SHALL BE CONSTRUCTED IN A STRAIGHT ALIGNMENT AT RIGHT ANGLES FROM THE MAIN LINE SEWER EXCEPT AS SHOWN ON THE PLANS. HOUSE LATERALS FROM CHIMNEYS SHALL NOT HAVE AN ANGLE OF LESS THAN 45° WITH THE MAIN LINE SEWER. ANY CHANGE IN ALIGNMENT SHALL BE REQUESTED IN WRITING BY THE PRIVATE ENGINEER.
6. THE PRIVATE ENGINEER SHALL FURNISH THE HOUSE LATERAL DEPTH AT THE PROPERTY LINE BELOW THE TOP OF CURB ELEVATION FOR EACH HOUSE LATERAL ON THE GRADE SHEET.
7. BEFORE WORK CAN BE STARTED, THE CONTRACTOR MUST OBTAIN A PERMIT TO EXCAVATE IN COUNTY STREETS FROM THE ROAD ELEMENT OF THE LOS ANGELES DEPARTMENT OF PUBLIC WORKS, DISTRICT OFFICE NO. 5, AND PAY A FEE TO THE DIRECTOR OF PUBLIC WORKS, 800 S. VERMONT AVE., LOS ANGELES, CALIFORNIA 90005, TO COVER THE COST OF CONSTRUCTION INSPECTION AND RECORD PLANS.
8. IF WORK IS TO DONE IN A STATE HIGHWAY A PERMIT MUST BE OBTAINED FROM THE STATE OF CALIFORNIA, DIVISION OF HIGHWAYS, 120 SOUTH SPRING STREET, LOS ANGELES, CALIFORNIA.
9. APPROVAL OF THIS PLAN BY THE COUNTY OF LOS ANGELES DOES NOT CONSTITUTE A REPRESENTATION AS TO THE ACCURACY OF THE LOCATION OF OR THE EXISTENCE OR NON-EXISTENCE OF ANY UNDERGROUND UTILITY PIPE, OR STRUCTURE WITHIN THE LIMITS OF THIS PROJECT. THIS NOTE APPLIES TO ALL PAGES.
10. REFER TO SECTION 716.1 OF THE STANDARD SPECIFICATIONS REGARDING SAFETY ORDERS.
11. PRIOR TO THE ISSUANCE OF THE REQUIRED SEWER CONSTRUCTION PERMIT, THE CONTRACTOR SHALL OBTAIN AND FILE WITH THE DEPARTMENT OF PUBLIC WORKS COPIES OF A PERMIT TO EXCAVATE IN COUNTY STREETS FROM THE ROAD ELEMENT AT THE DEPARTMENT OF PUBLIC WORKS, A PERMIT FOR EXCAVATIONS AND TRENCHES FROM THE STATE OF CALIFORNIA, A DIVISION OF INDUSTRIAL SAFETY AND A CERTIFICATE OF WORKERS COMPENSATION INSURANCE WITH THE DEPARTMENT OF PUBLIC WORKS, 800 S. VERMONT AVE., LOS ANGELES, CALIFORNIA 90005, ROOM 818, NAMED AS THE CERTIFICATE HOLDER TO BE NOTIFIED 90 DAYS PRIOR TO CANCELLATION OF POLICY.

**CONSTRUCTION NOTES:**

1. WORK SHALL BE CONSTRUCTED ACCORDING TO THE STANDARD SPECIFICATIONS FOR PUBLIC WORKS CONSTRUCTION (1985 EDITION) WITH THE FOLLOWING AMENDMENTS AND COUNTY ENGINEER SPECIFICATIONS FOR THE CONSTRUCTION OF SANITARY SEWERS DATED SEPT. 21, 1976 AND SHALL BE PROSECUTED ONLY IN THE PRESENCE OF THE COUNTY ENGINEER.
2. THE CONTRACTOR SHALL NOTIFY THE CONSTRUCTION DIVISION BY TELEPHONE, 228-2821, AT LEAST TWENTY-FOUR HOURS BEFORE STARTING ANY WORK UNDER THIS CONTRACT.
3. HOUSE LATERALS TO BE CONSTRUCTED WITH INVERTS AT PROPERTY LINE 8 FEET BELOW CURB GRADE EXCEPT AS NOTED.
4. WYE OR TEE BRANCHES MAY BE USED FOR CONNECTIONS TO MAINLINE SEWERS EXCEPT AS NOTED.
5. ALL STRUCTURES SHALL BE EITHER BRICK MANHOLES PER B-3 OR PRECAST CONCRETE MANHOLES PER B-26, EXCEPT AS NOTED.
6. PROVIDE STAKES ON THE PROPERTY LINE OR PROPERTY LINES PRODUCED AT RIGHT ANGLES TO THE SEWER LINE AT THE CENTER LINE OF EACH MANHOLE.
7. MANHOLE TOPS IN UNIMPROVED RIGHTS OF WAY TO BE SIX INCHES ABOVE FINISHED GRADE.
8. WITHEFIED CLAY PIPE JOINTS SHALL BE TYPE "D" OR "E" PER STANDARD SPECIFICATIONS SECTION 200-2.
9. IF A POWER POLE IS WITHIN THREE FEET OF THE SEWER THE SEWER SHALL BE ENCASED PER B-25. CASE 1: TWO FEET ON EACH SIDE FROM THE POINT OF INTERFERENCE.
10. IF DURING THE COURSE OF CONSTRUCTION IT IS DETERMINED THAT THERE IS LESS THAN FOUR FEET OF COVER OVER THE TOP OF A MAIN LINE OR HOUSE LATERAL V.C.P. SEWER WHICH IS NOT INDICATED ON THE PLANS, THE PIPE SHALL BE ENCASED PER B-25, CASE II UNLESS OTHERWISE APPROVED BY THE DIRECTOR OF PUBLIC WORKS.
11. ALL JOINTS BETWEEN CLAY PIPE AND WITHEFIED CLAY PIPE SHALL BE MADE WITH A RUBBER SLEEVE JOINT, TYPE "C" OR "D", WITH BUSHING IF NECESSARY PER STANDARD SPECIFICATIONS, SECTION 200-2.
12. SEWERS TO BE TESTED FOR LEAKAGE PER SECTION 200-1.4 OF THE STANDARD SPECIFICATIONS AND SPECIAL PROVISIONS.
13. RESURFACE ALL TRENCHES WITHIN PAVED AREAS TO MEET LOS ANGELES COUNTY PUBLIC WORKS OR CALIFORNIA STATE HIGHWAY REQUIREMENTS IN ACCORDANCE WITH PERMITS.
14. FULL COMPLIANCE WITH SECTION 200-1.3.2 OF THE SPECIAL PROVISIONS WILL BE REQUIRED FOR BACKFILL IN STREETS. CERTIFICATION OF BACKFILL COMPOSITION AND SAND EQUIVALENTS BY A QUALIFIED, REGISTERED TESTING LABORATORY SHALL BE PROVIDED BY THE PERMITTEE PRIOR TO THE ISSUANCE OF A CERTIFICATE OF PARTIAL ACCEPTANCE.
15. SPECIAL BACKFILL IN EASEMENT CONSTRUCTION OR BACKFILL TRENCH AND REPLACE OTHER EARTH SO AS TO ACHIEVE THE NATURAL OR FINISHED GRADES AND SLOPES SHOWN ON THE GENERAL PLAN APPROVED FOR THIS DEVELOPMENT BY THE BUILDING AND SAFETY DIVISION (IN ALL BACKFILL AND EARTH REPLACED SHALL BE COMPACTED TO A MINIMUM OF 90% OF MAXIMUM DENSITY PER A.S.T.M. STD. METHOD OF TEST D698-57) AS MODIFIED. ACCEPTABLE CERTIFICATION OF SUCH COMPACTION SHALL BE SUBMITTED TO THE CONSTRUCTION DIVISION.

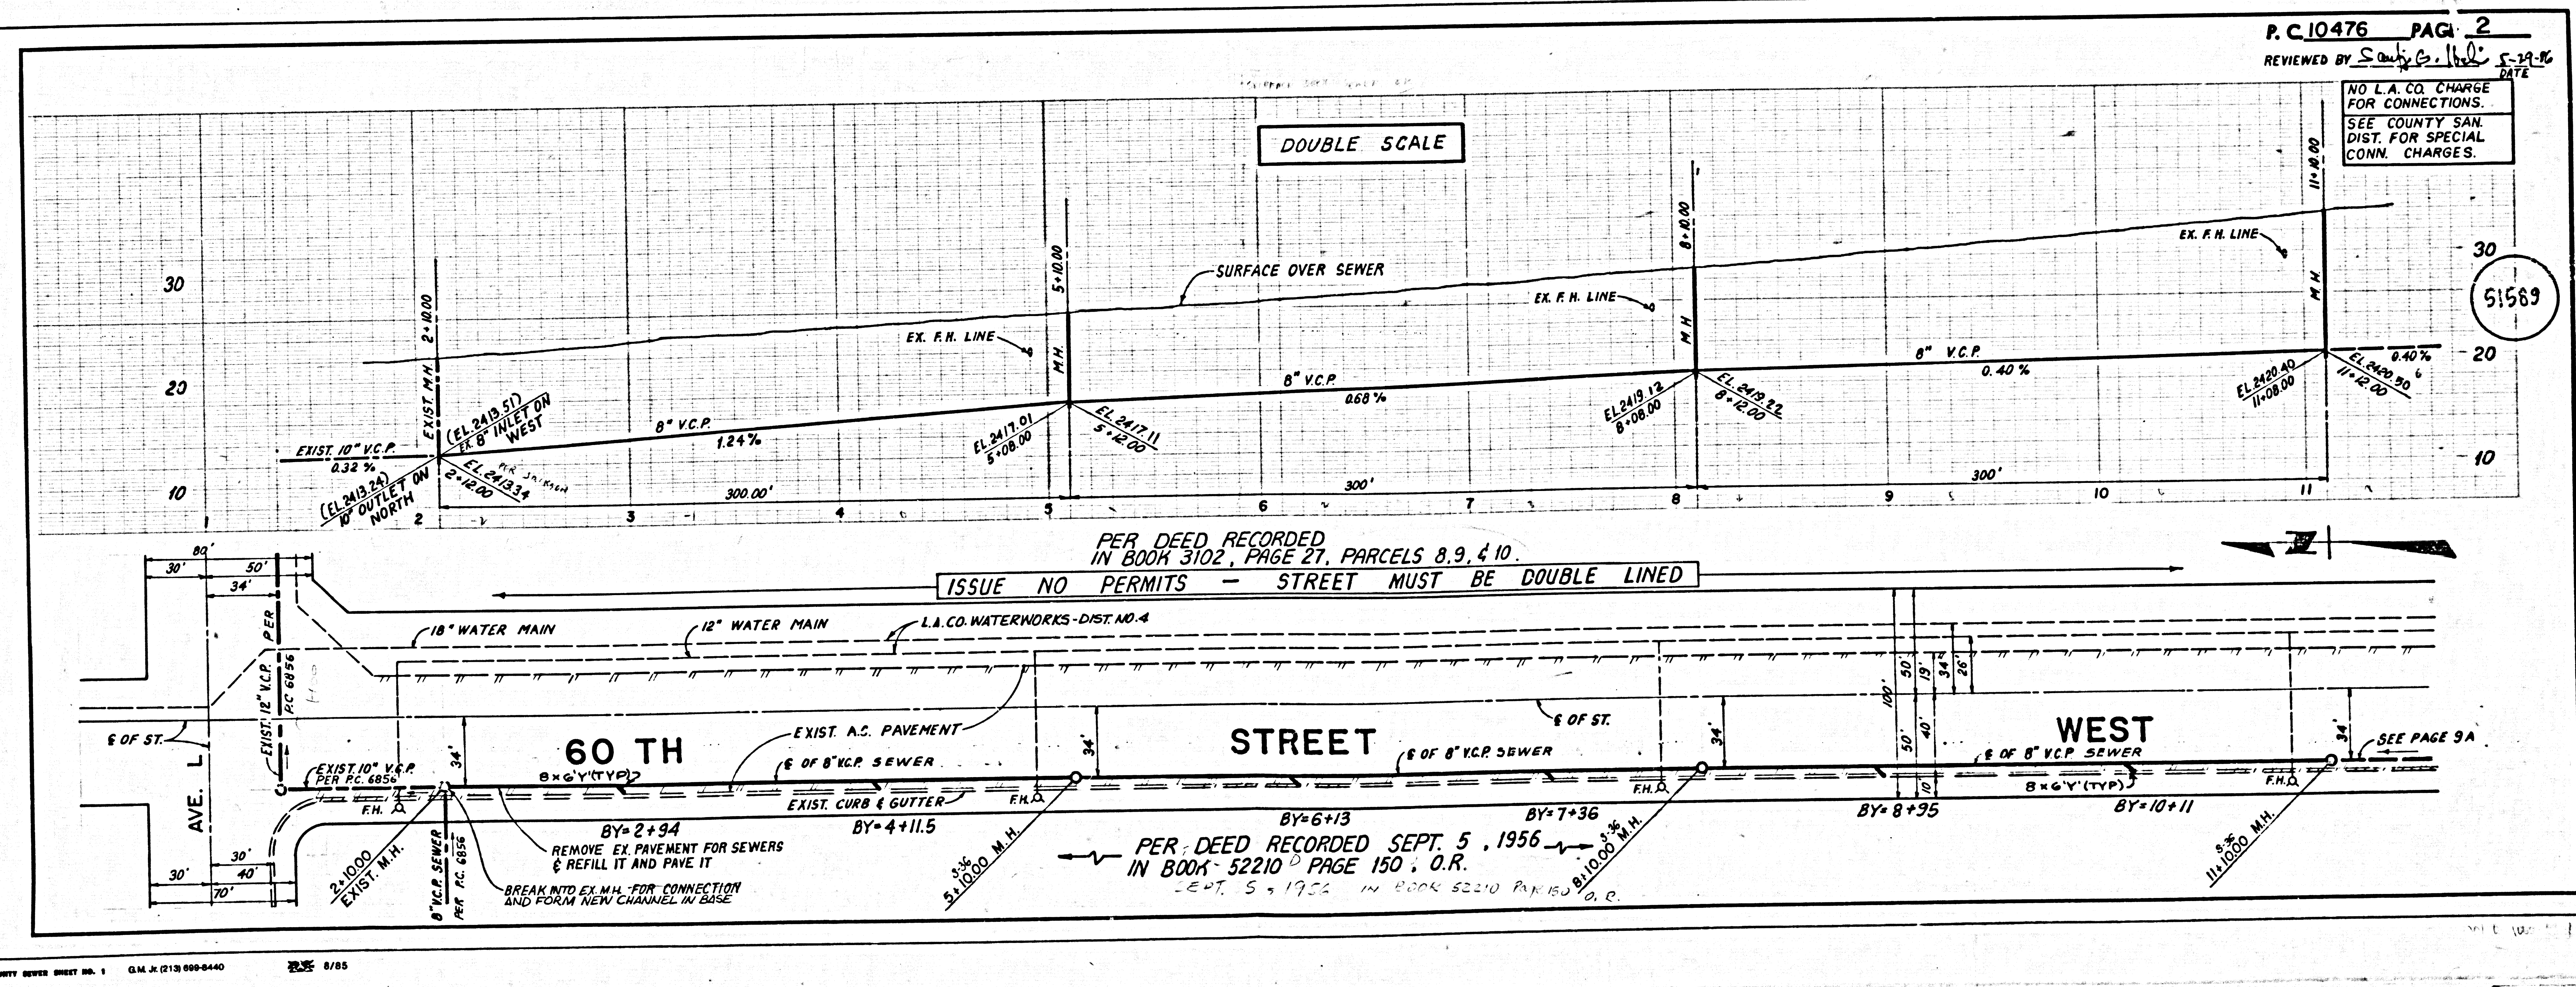

P.C. 10476 PAGE 2  
REVIEWED BY *Sandy G. Holt* 5-24-86

NO L.A. CO. CHARGE FOR CONNECTIONS. SEE COUNTY SAN. DIST. FOR SPECIAL CONN. CHARGES.

51569



PER DEED RECORDED IN BOOK 3102, PAGE 27, PARCELS 8, 9, & 10.  
ISSUE NO PERMITS - STREET MUST BE DOUBLE LINED

PER DEED RECORDED SEPT. 5, 1956 IN BOOK 52210 PAGE 150; O.R.  
SEPT. 5, 1956 IN BOOK 52210 PARCEL 10, O.R.





NO L.A. CO. CHARGE FOR CONNECTIONS. SEE COUNTY SAN. DIST. FOR SPECIAL CONN. CHARGES.

51590

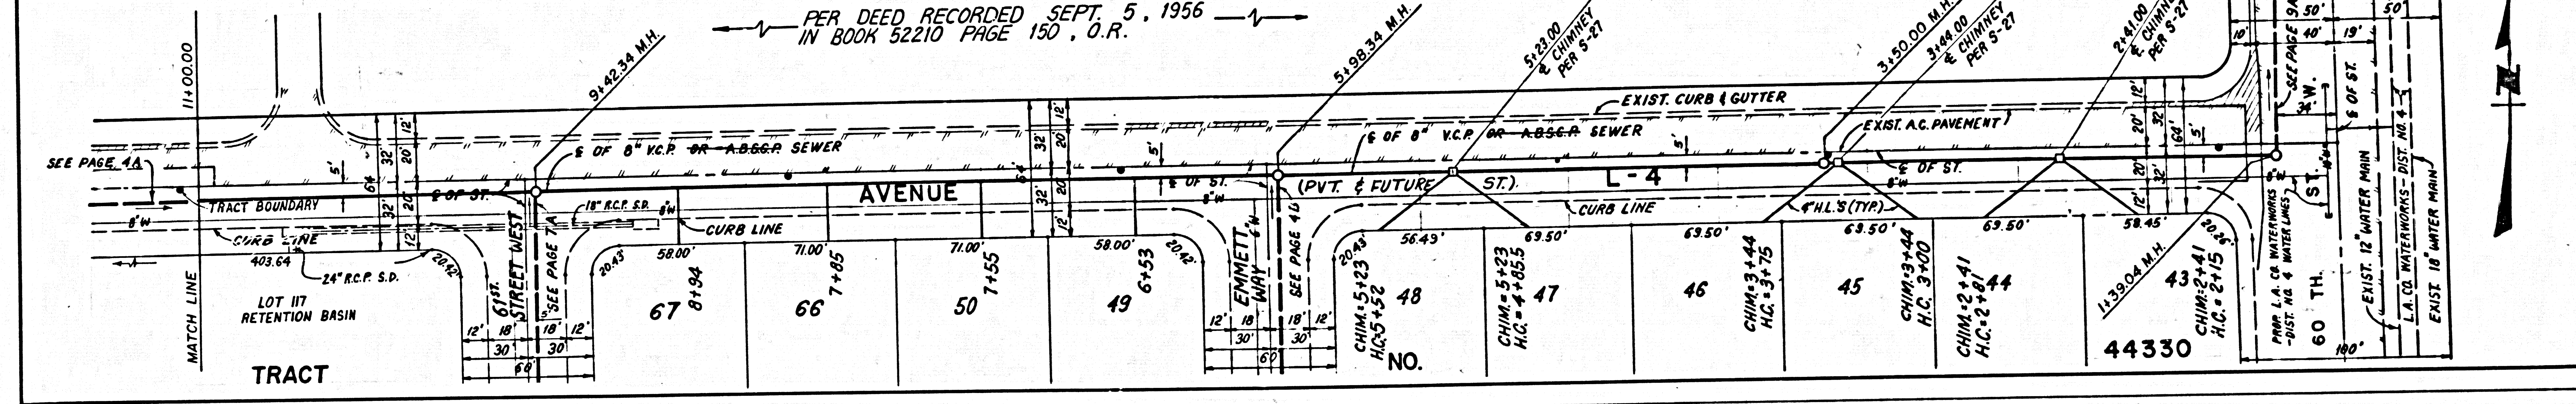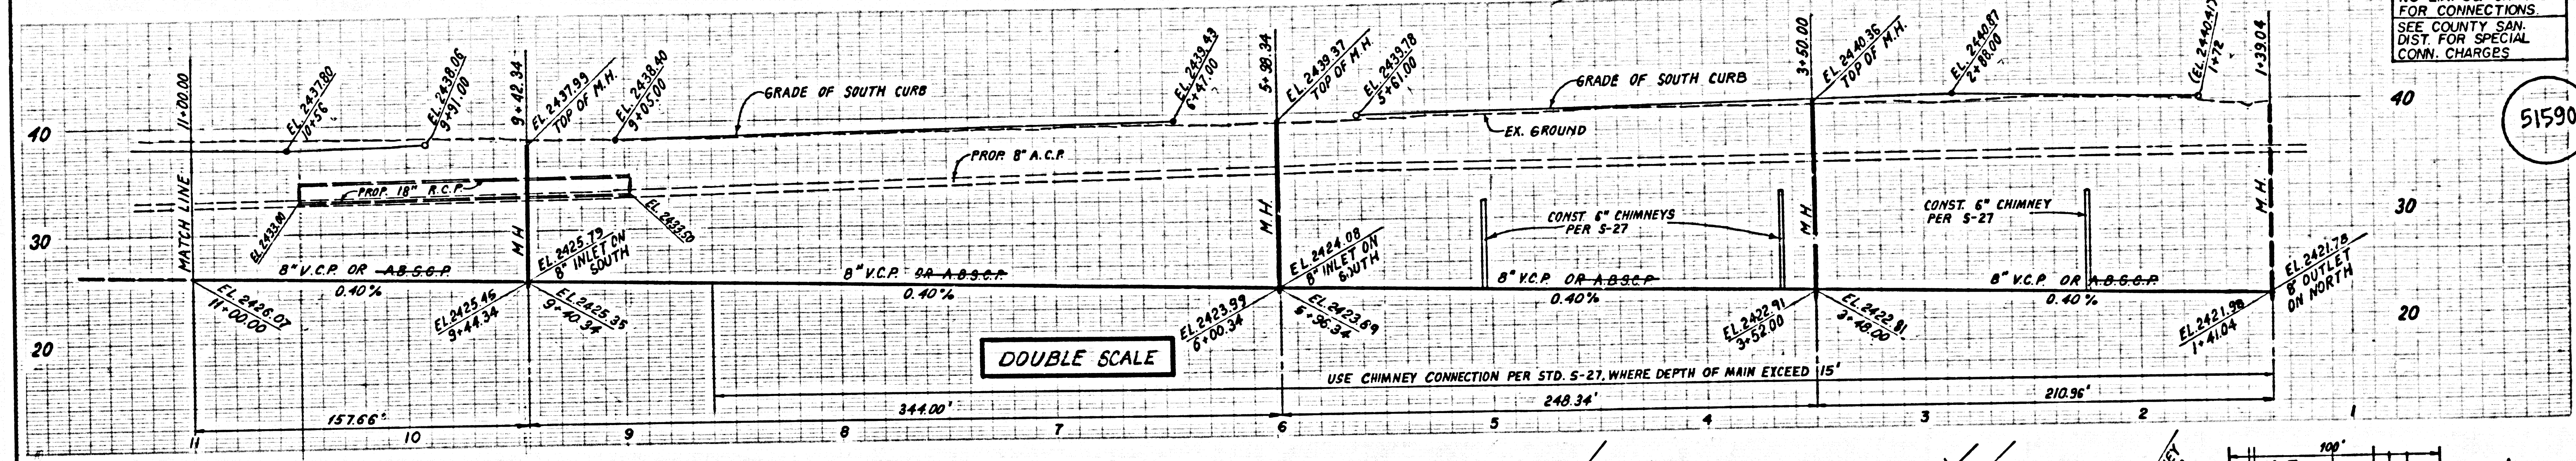

NO L.A. CO. CHARGE FOR CONNECTIONS. SEE COUNTY SAN. DIST. FOR SPECIAL CONN. CHARGES.


51591

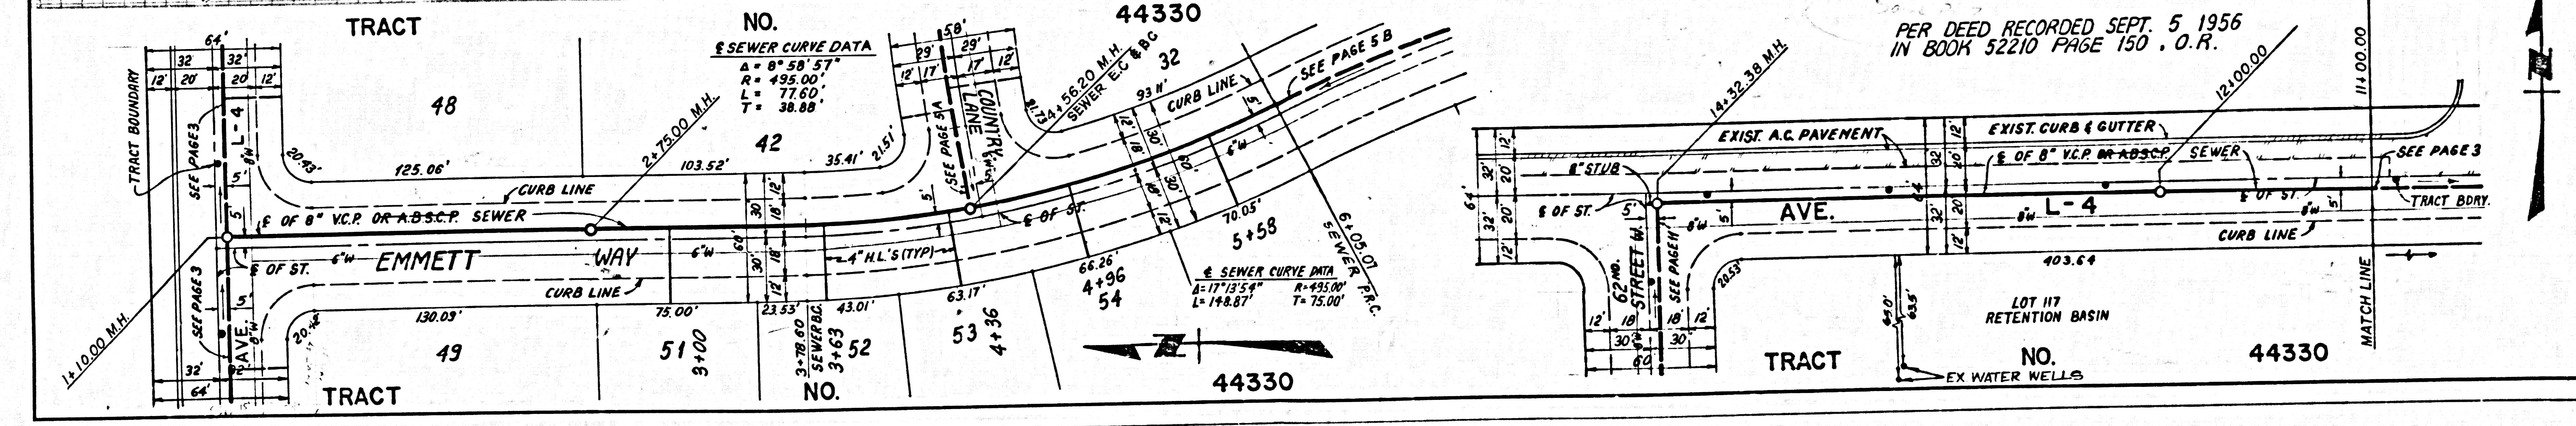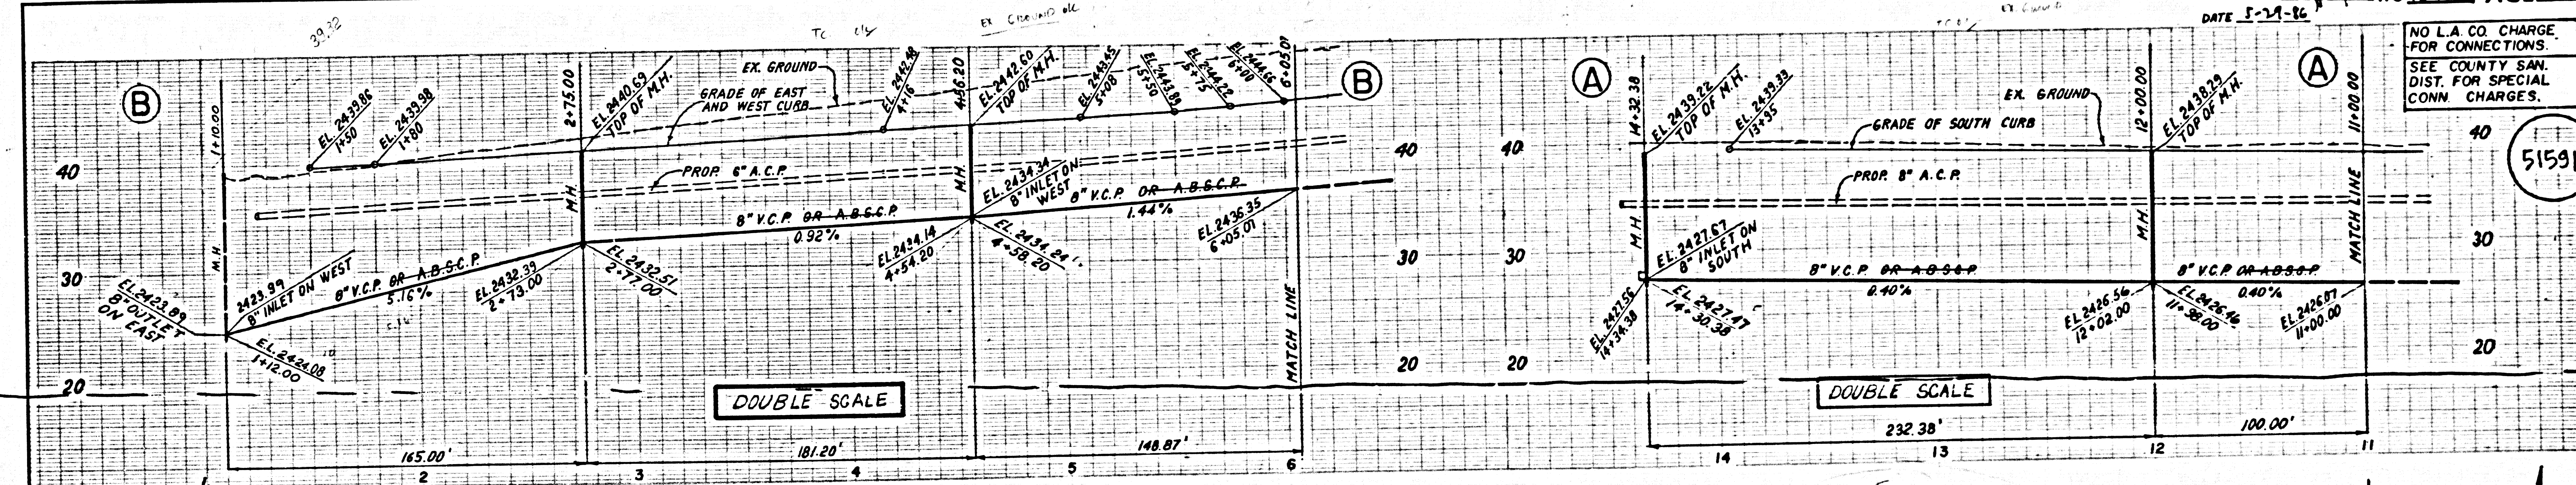




51590 0534 ON TRACT

51591





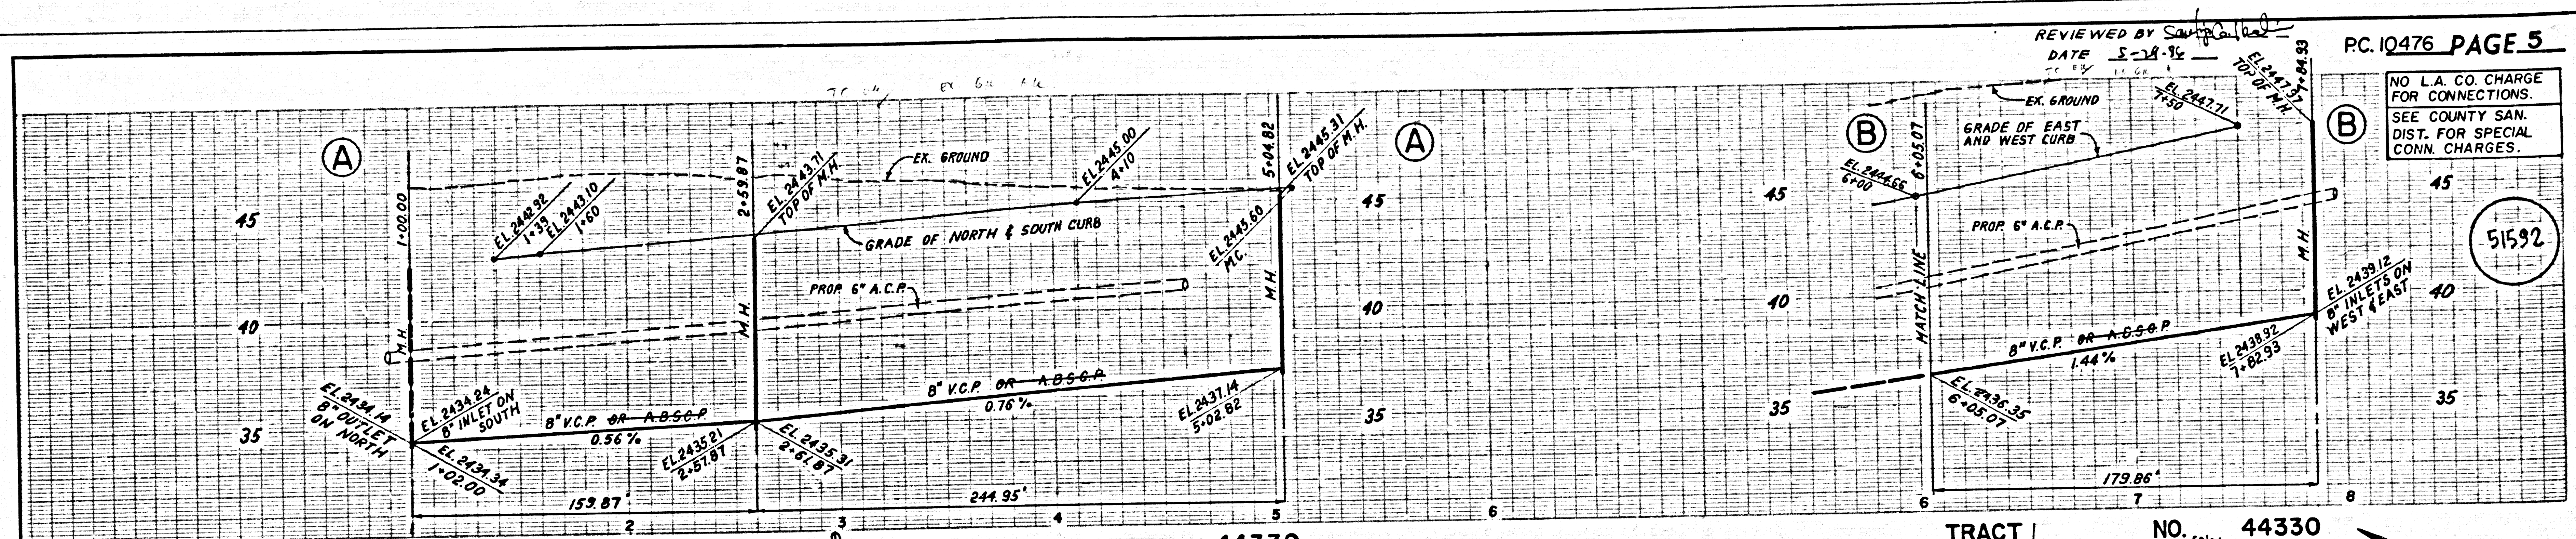

PC. 10476 PAGE 5  
 NO L.A. CO. CHARGE FOR CONNECTIONS. SEE COUNTY SAN. DIST. FOR SPECIAL CONN. CHARGES.

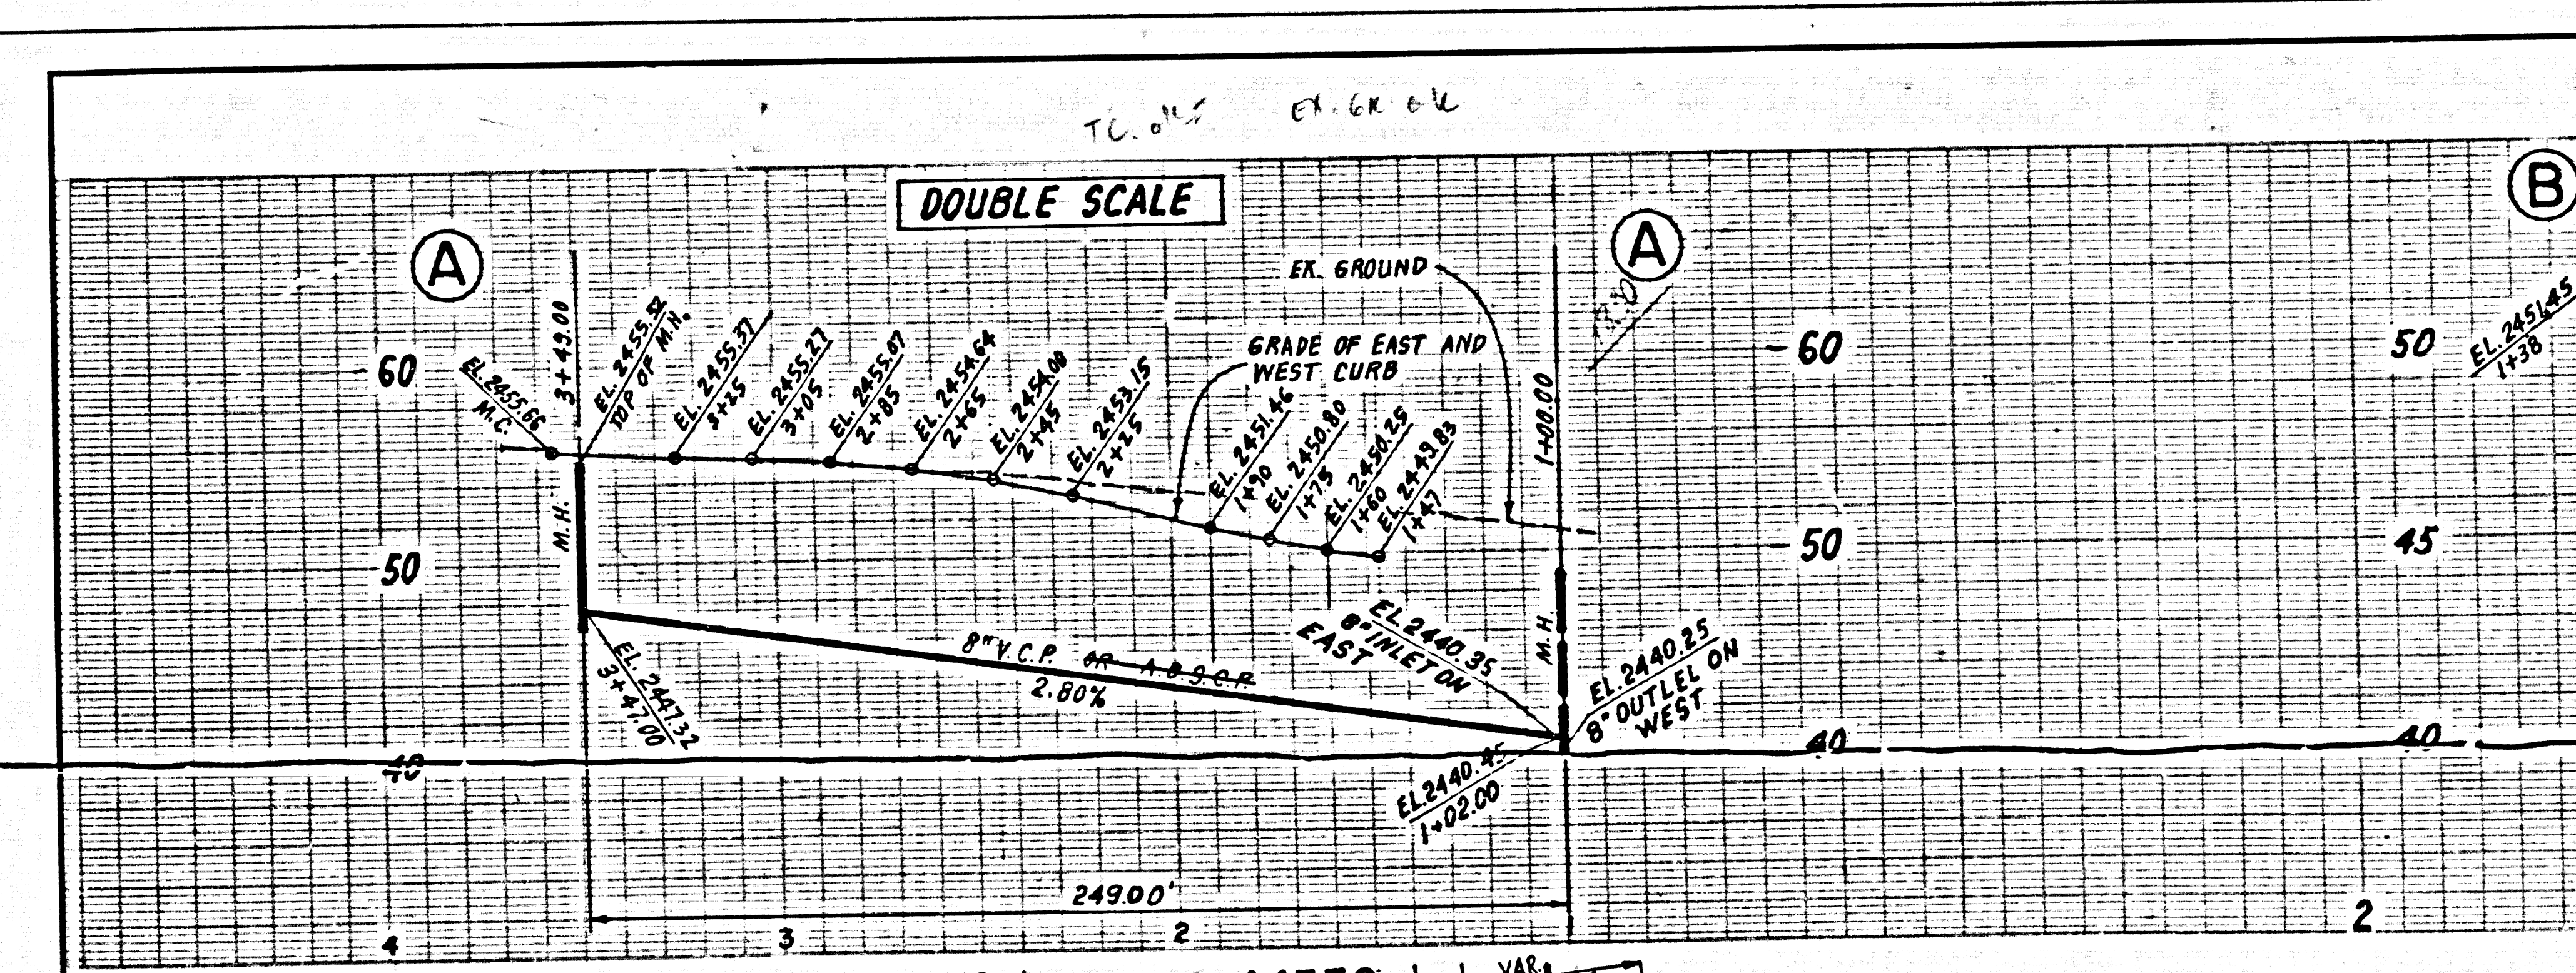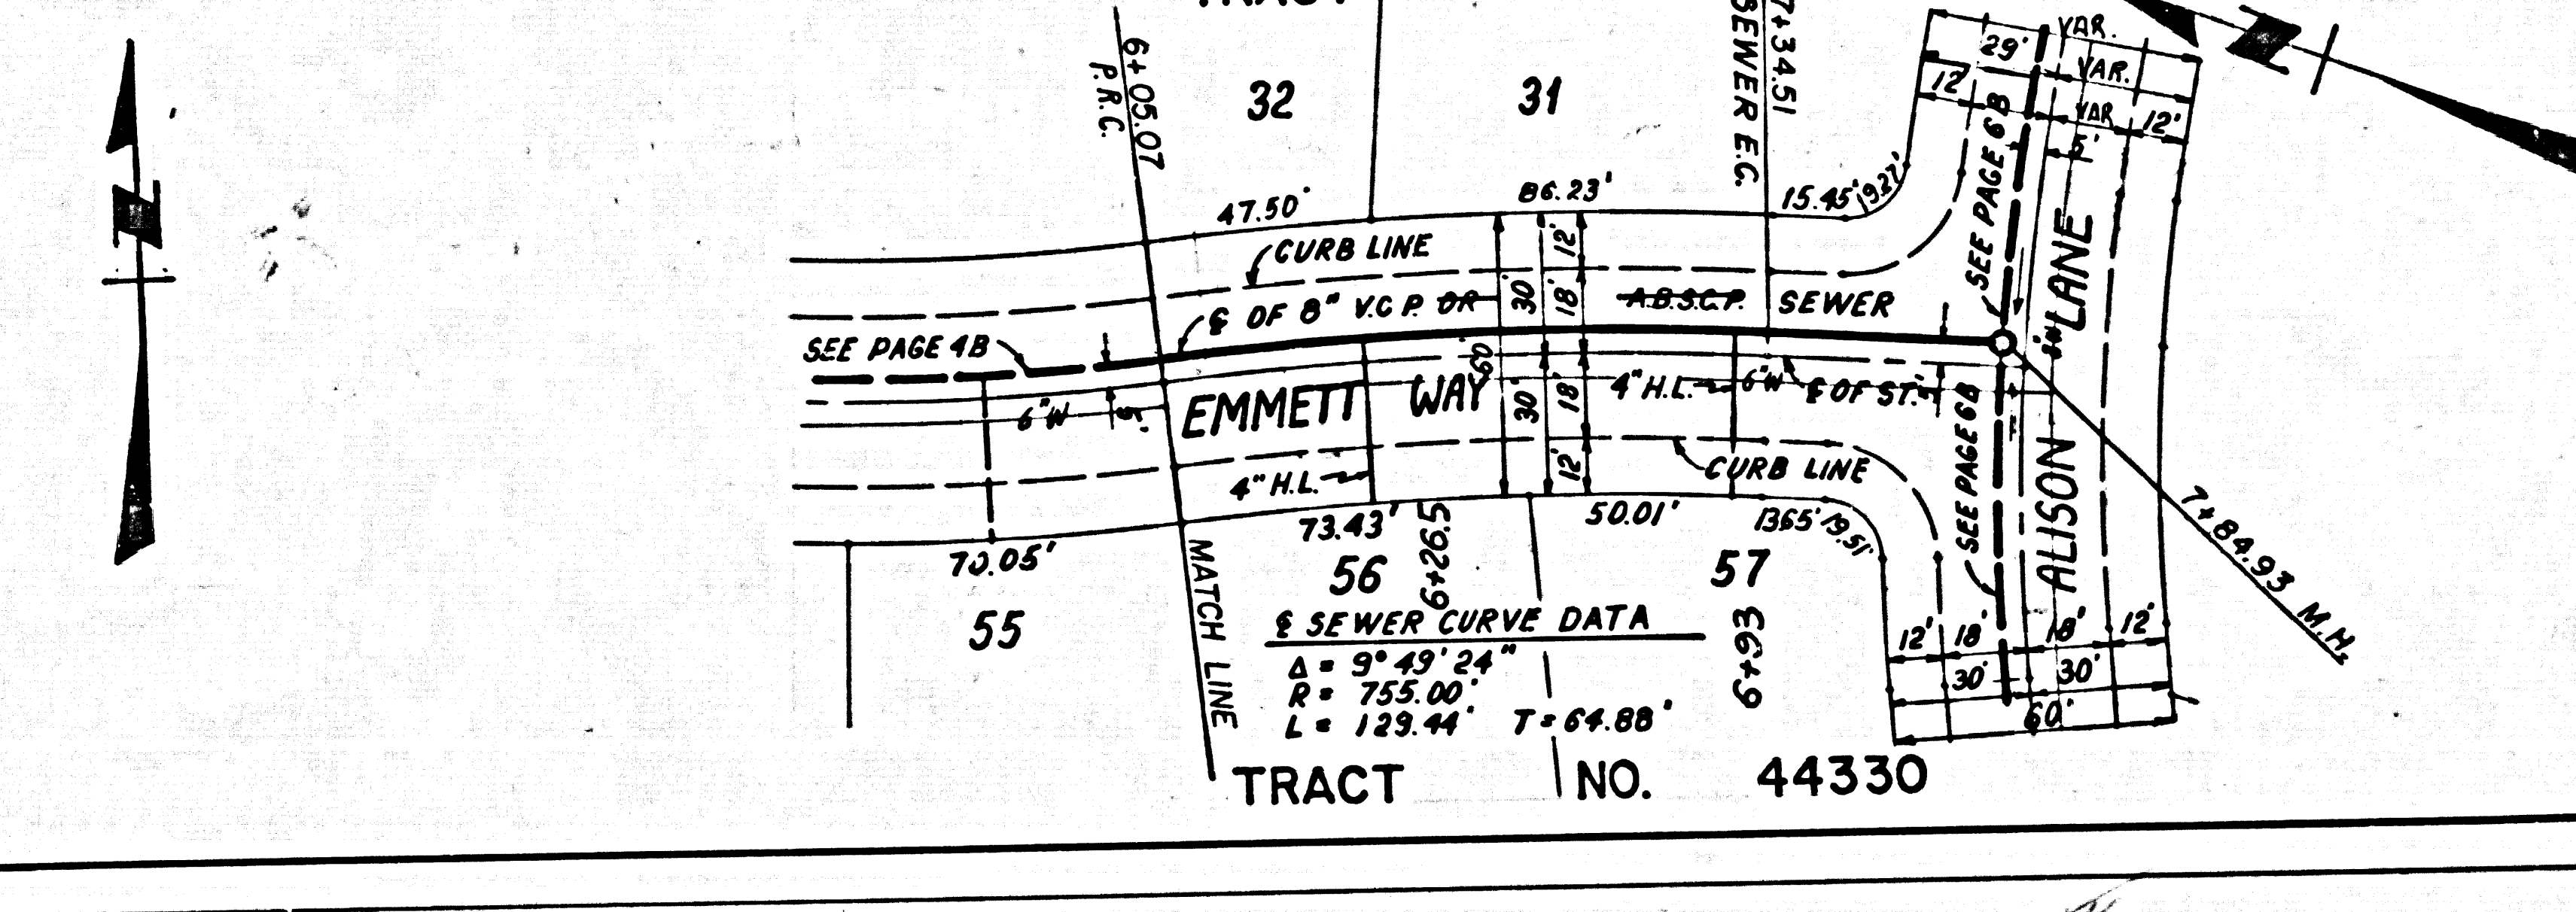
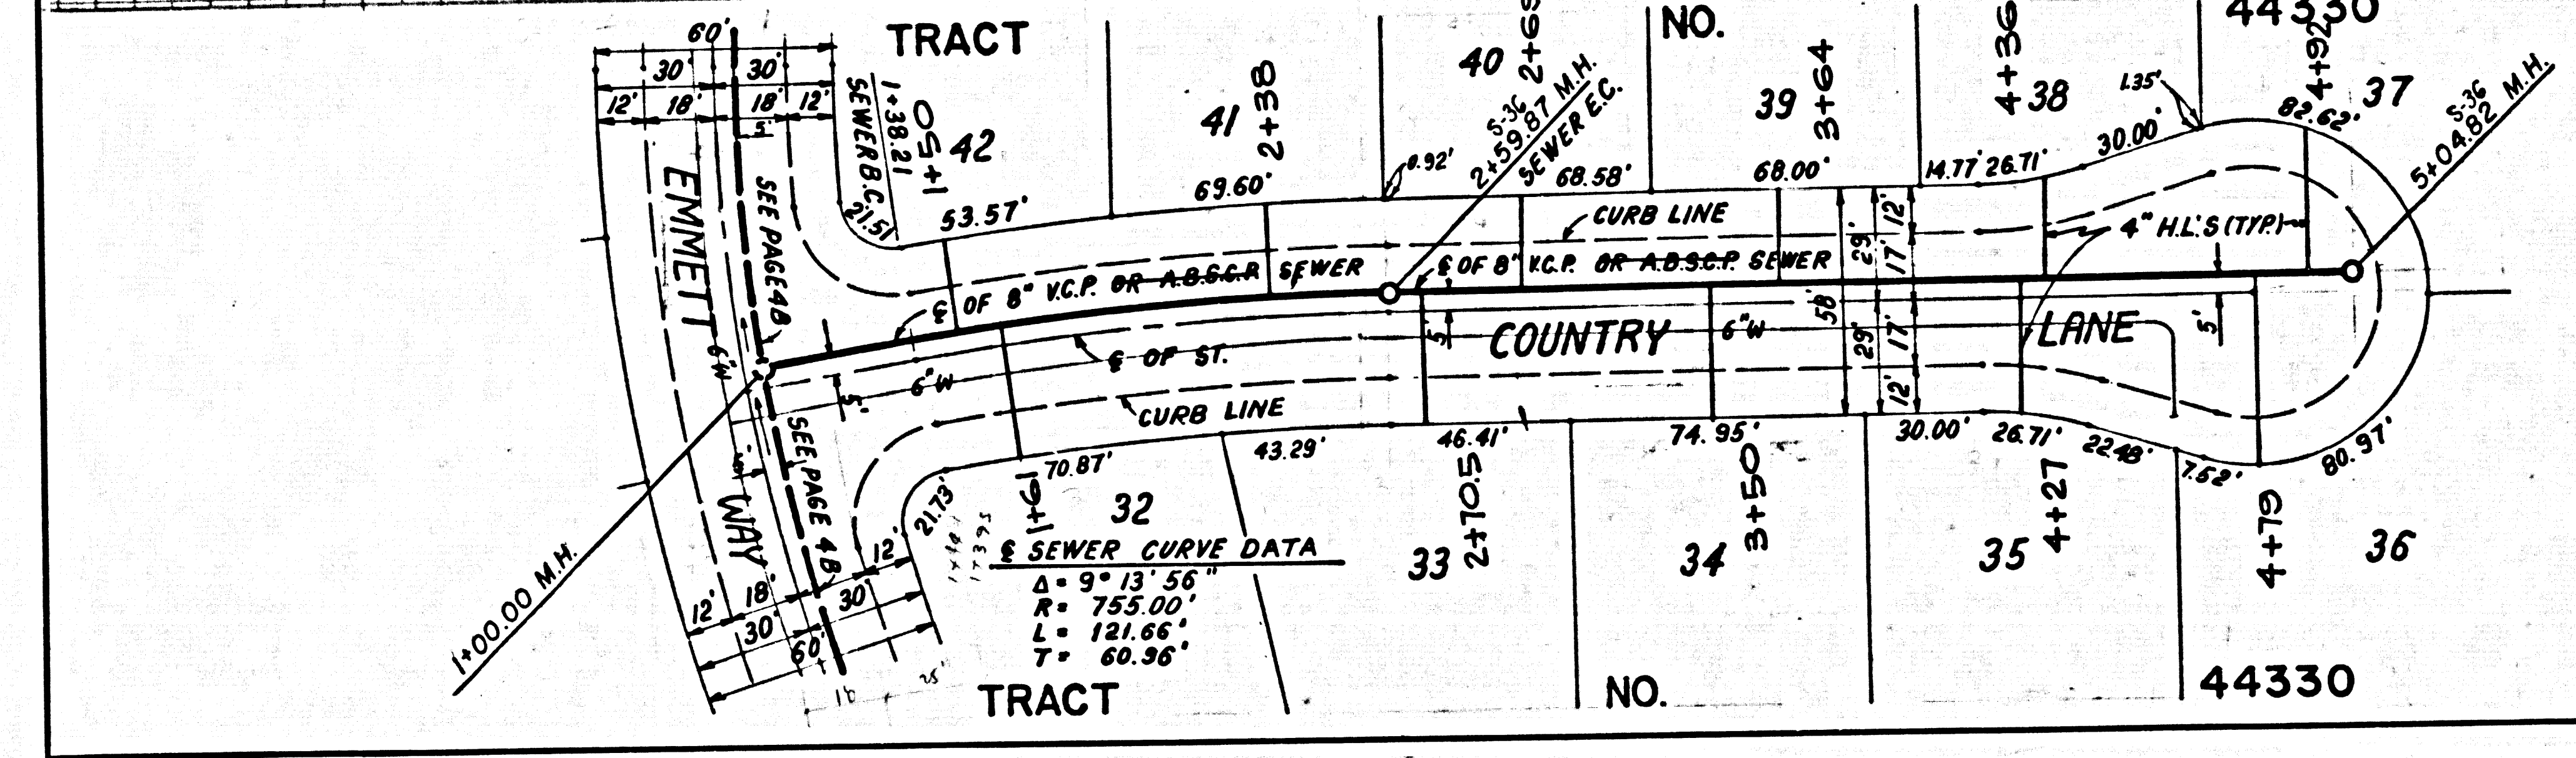


PC. 10476 PAGE 6  
 NO L.A. CO. CHARGE FOR CONNECTIONS. SEE COUNTY SAN. DIST. FOR SPECIAL CONN. CHARGES.

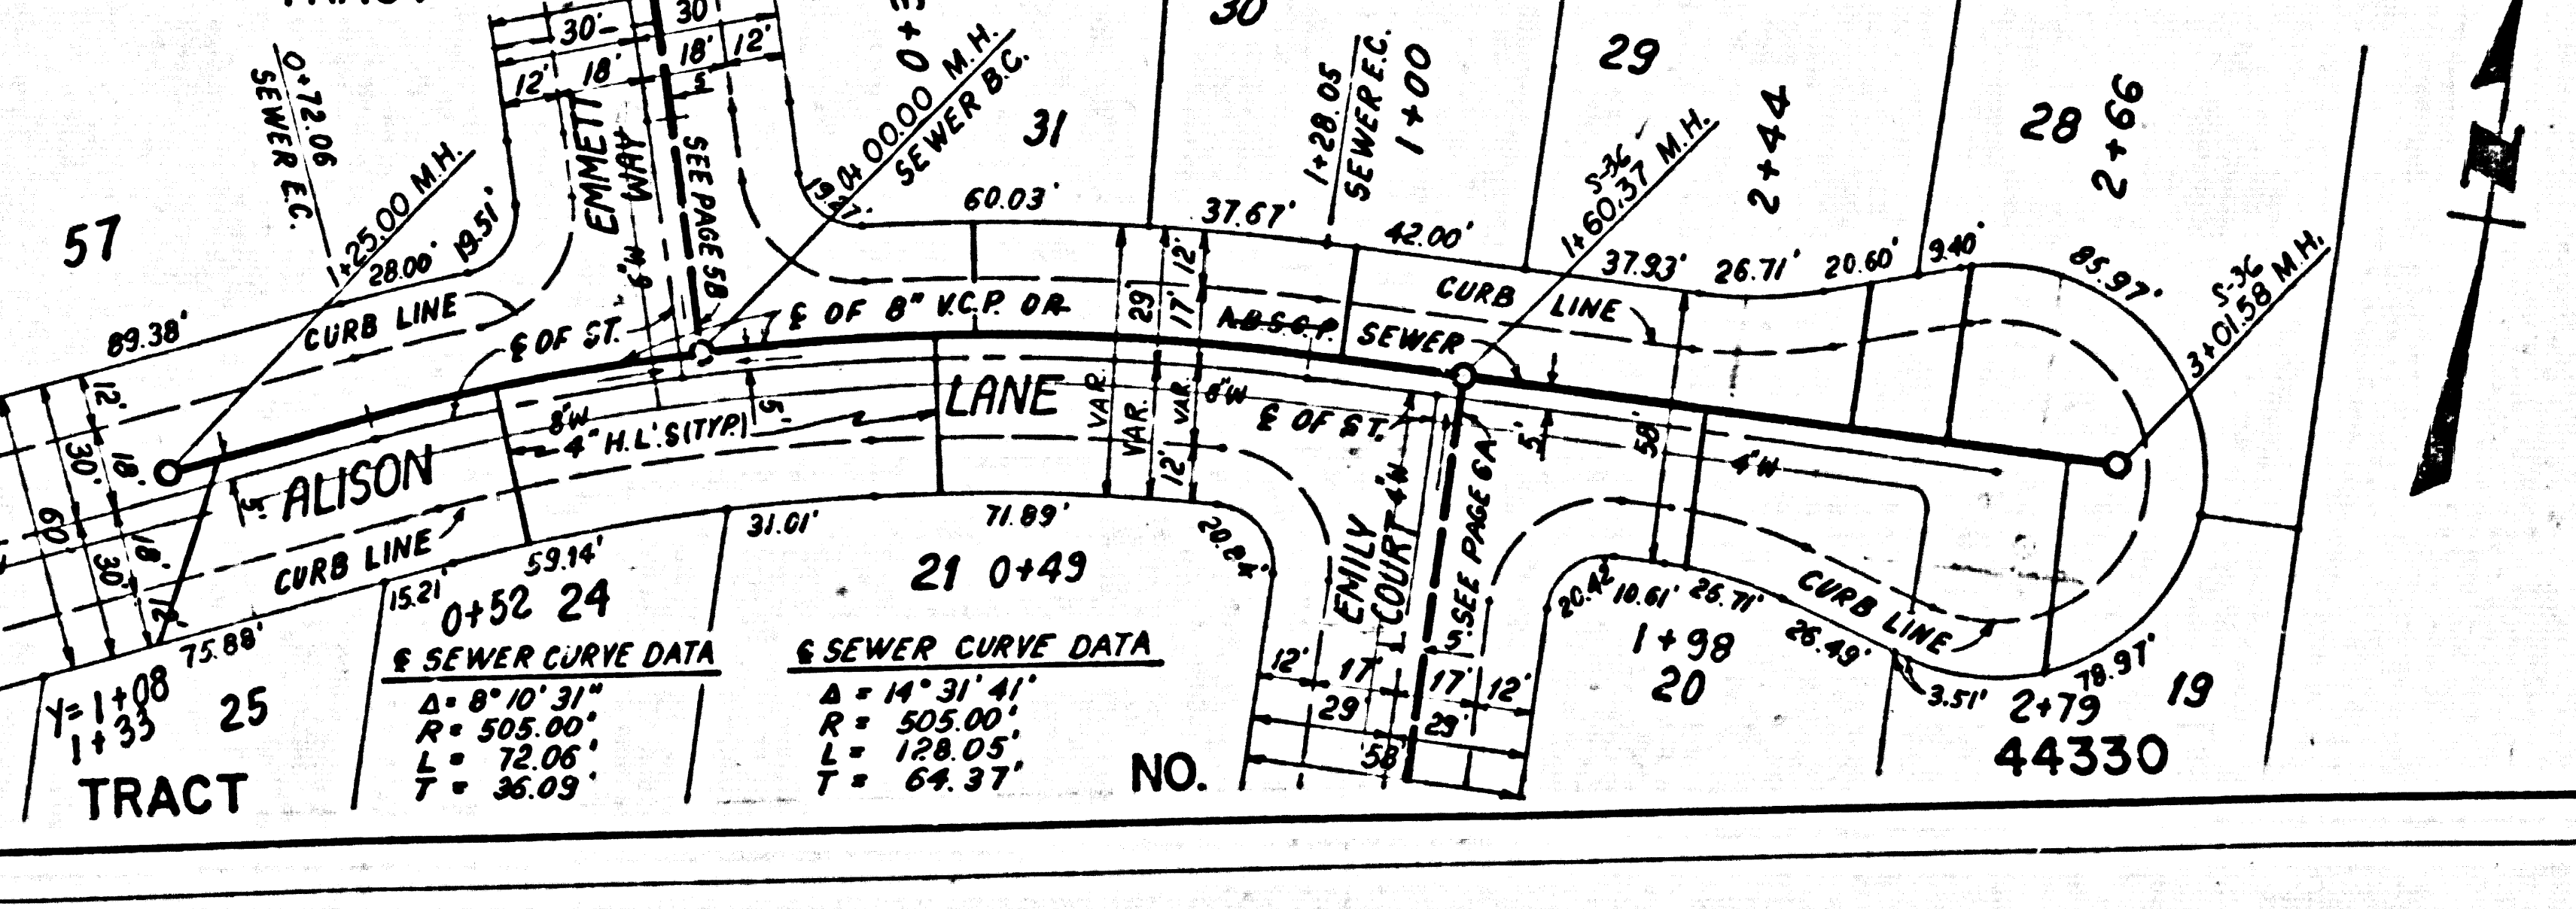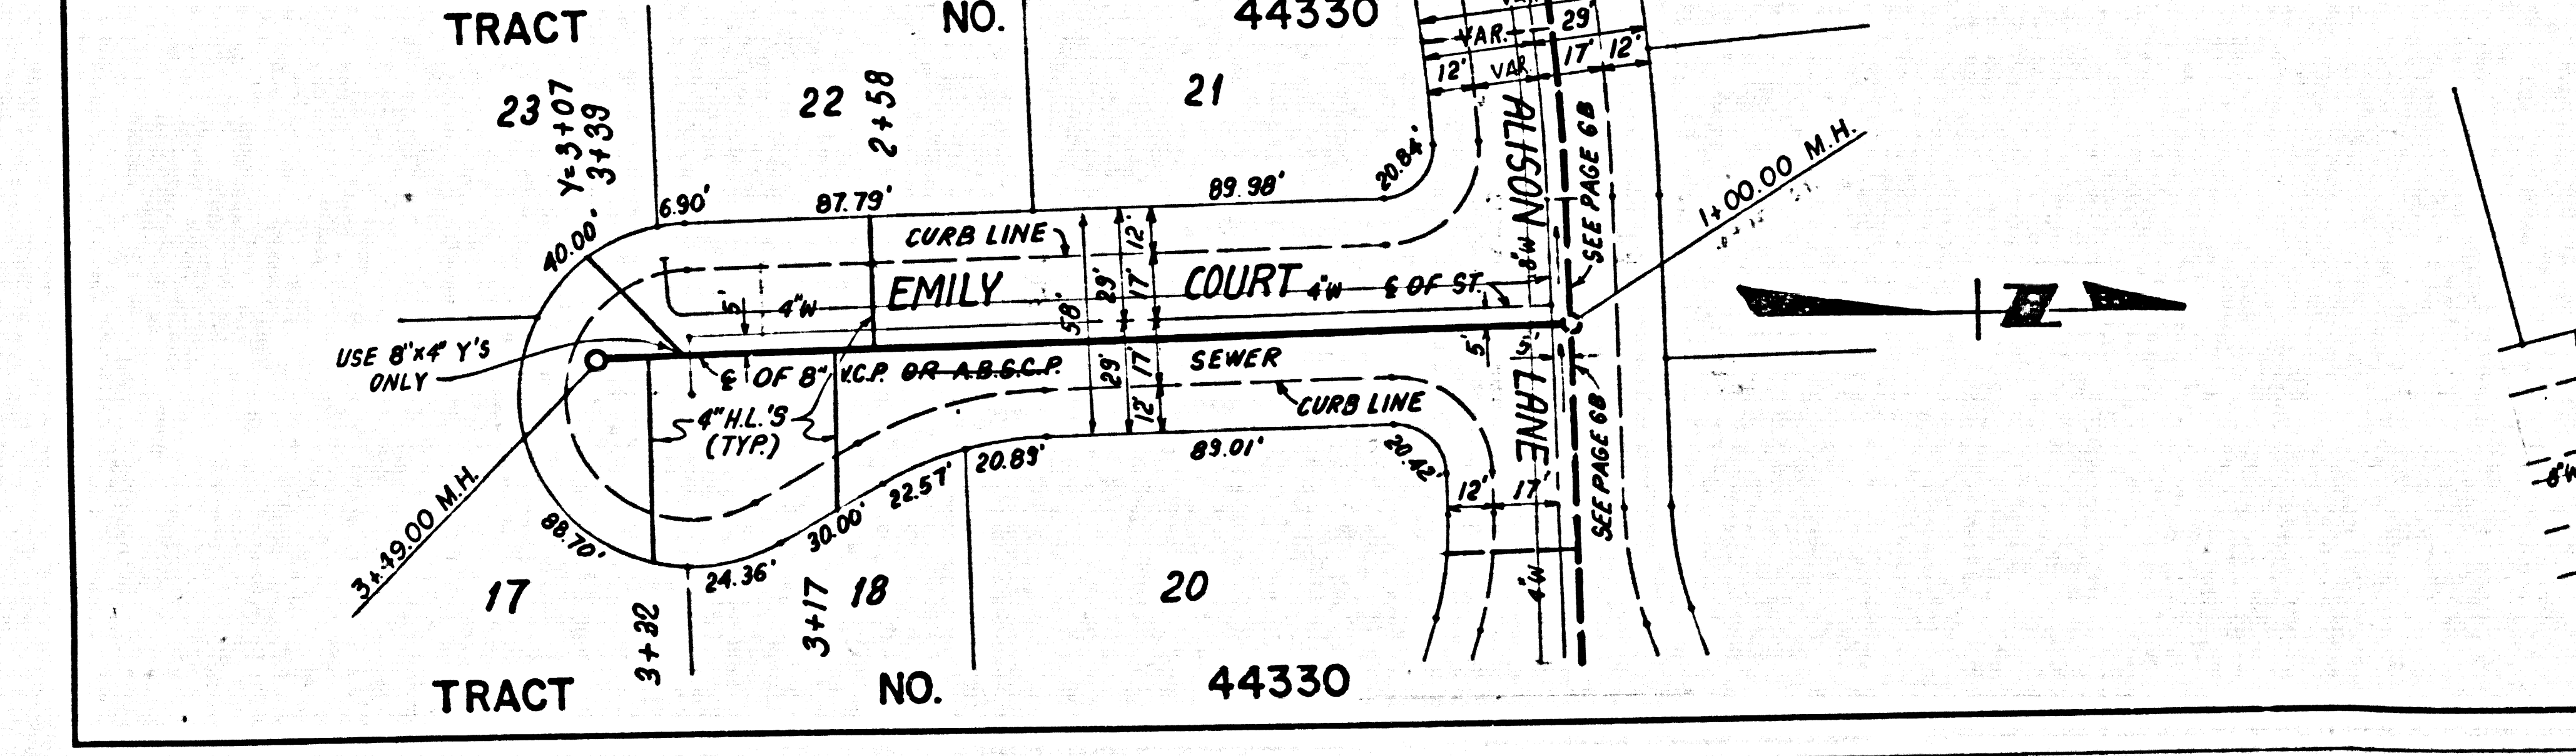

51592  
 51593  
 51594  
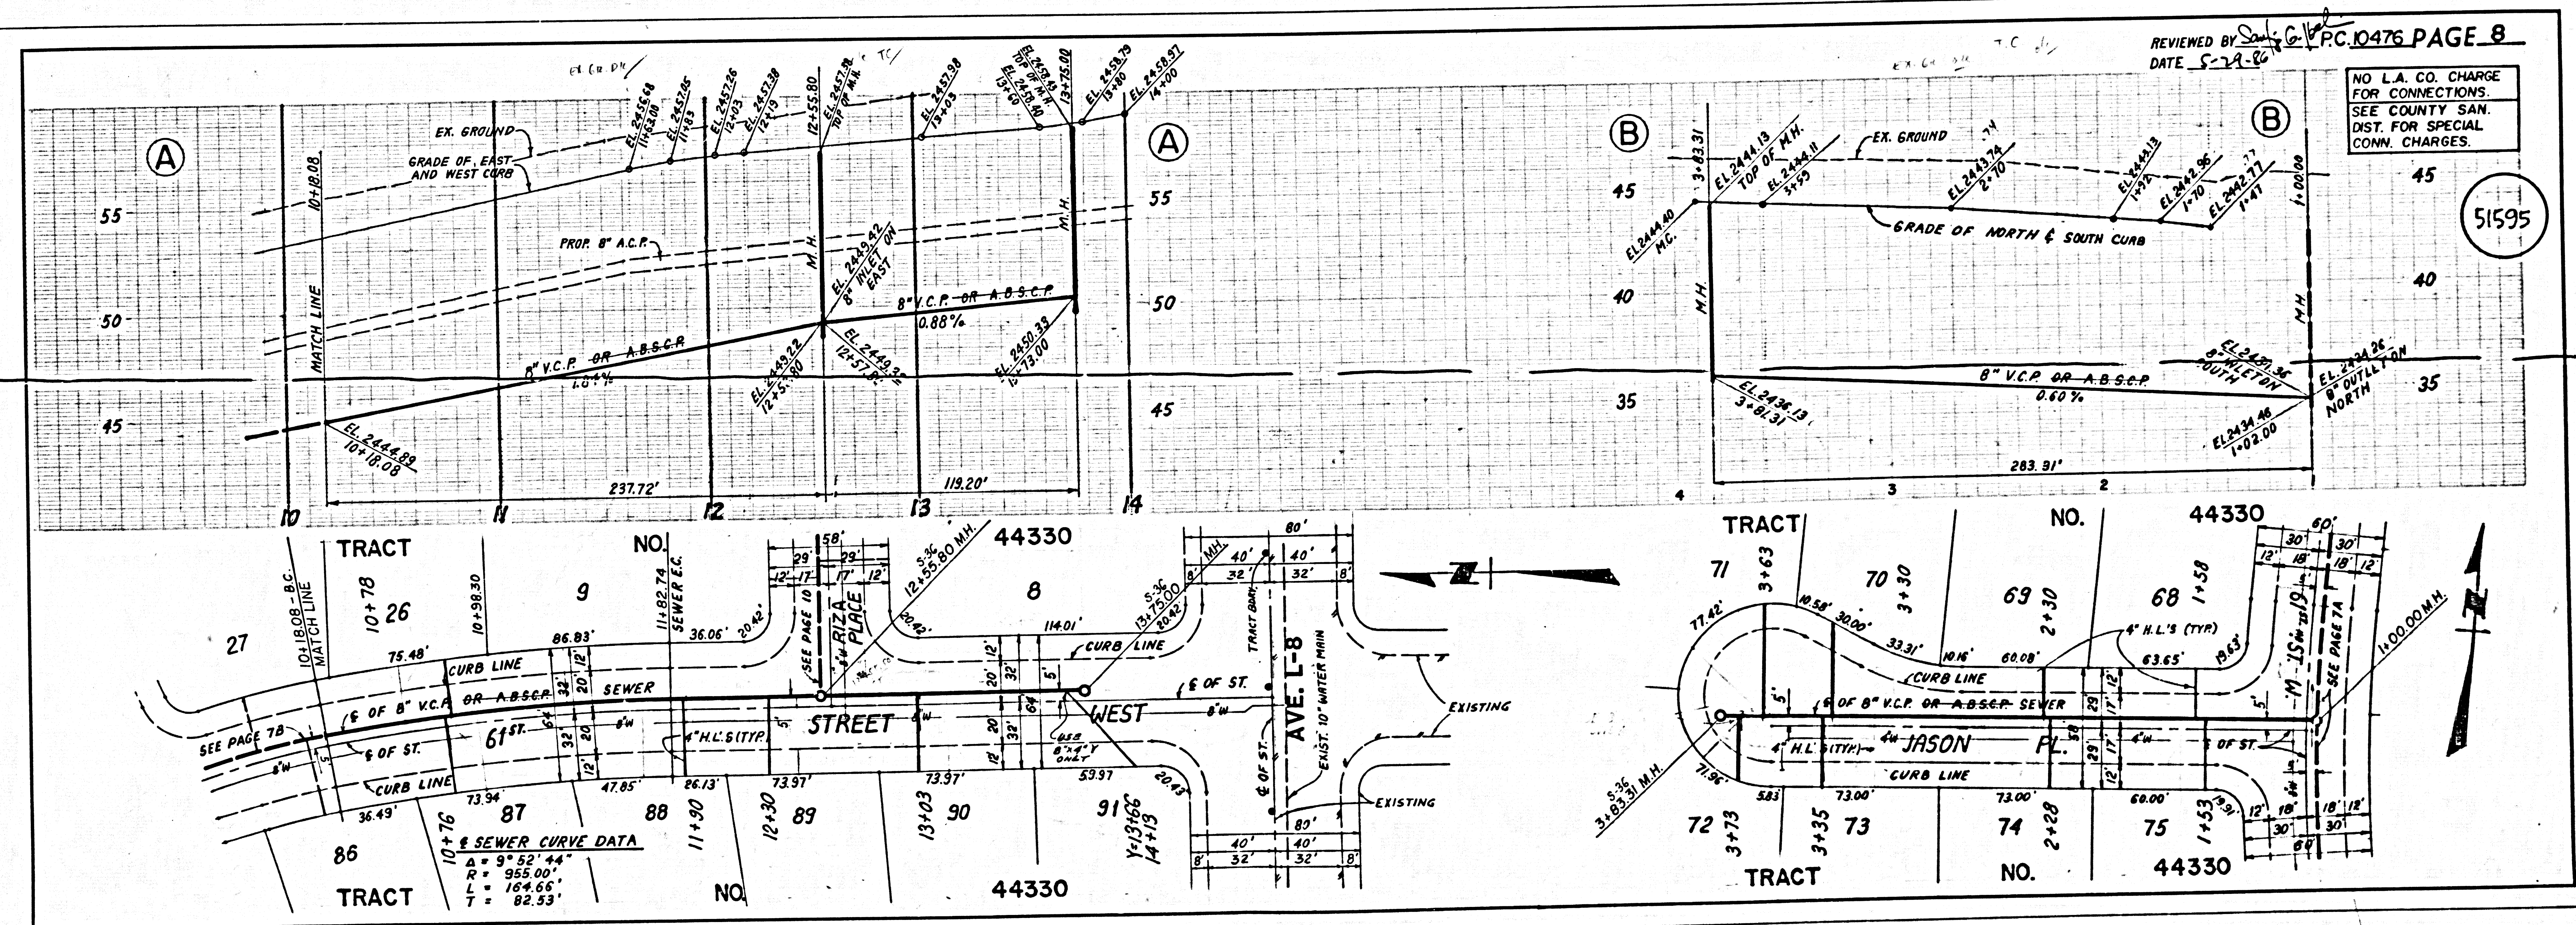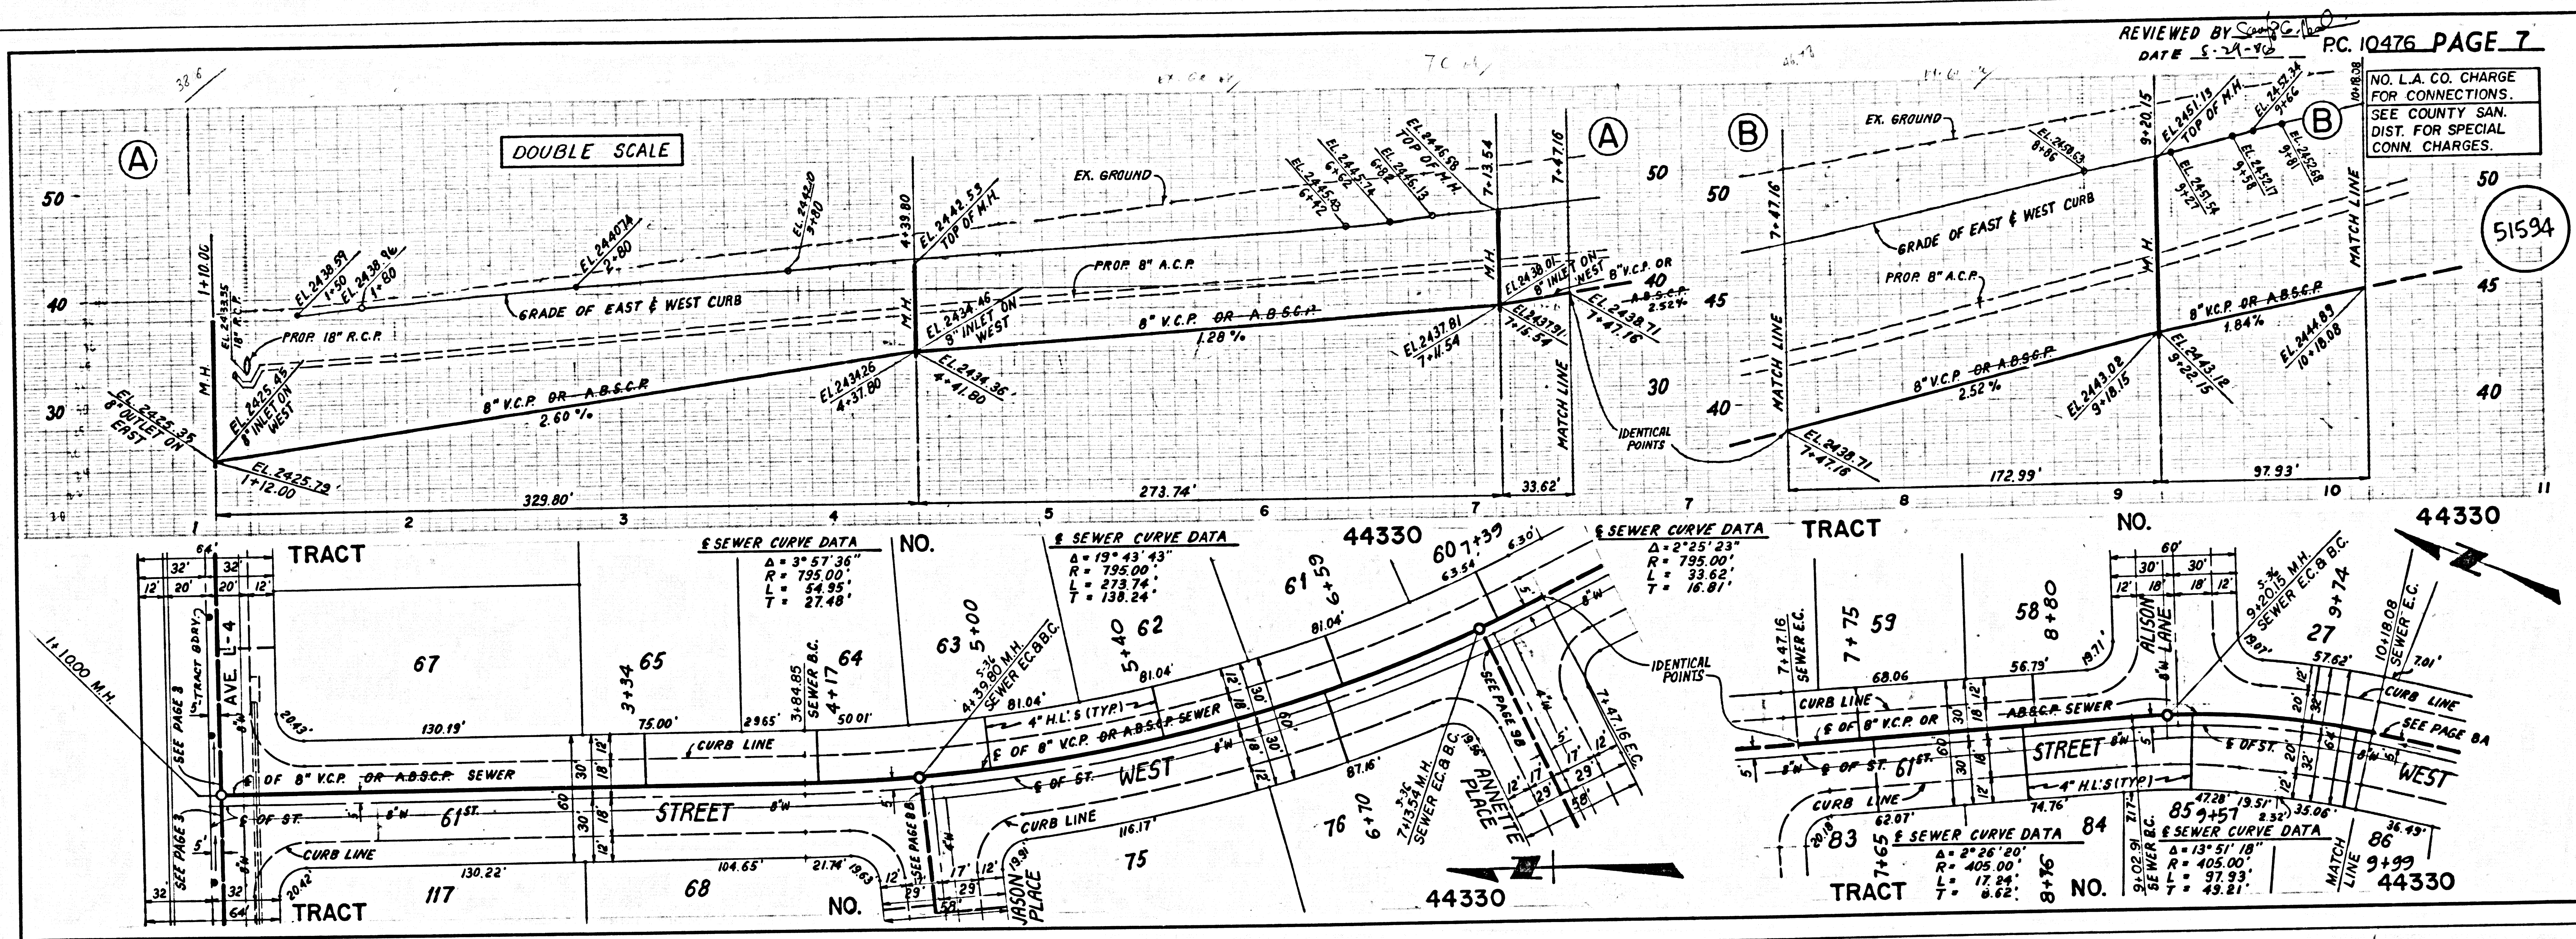



4 2701.29 05349 ON TRACT



NO L.A. CO. CHARGE FOR CONNECTIONS. SEE COUNTY SAN. DIST. FOR SPECIAL CONN. CHARGES.

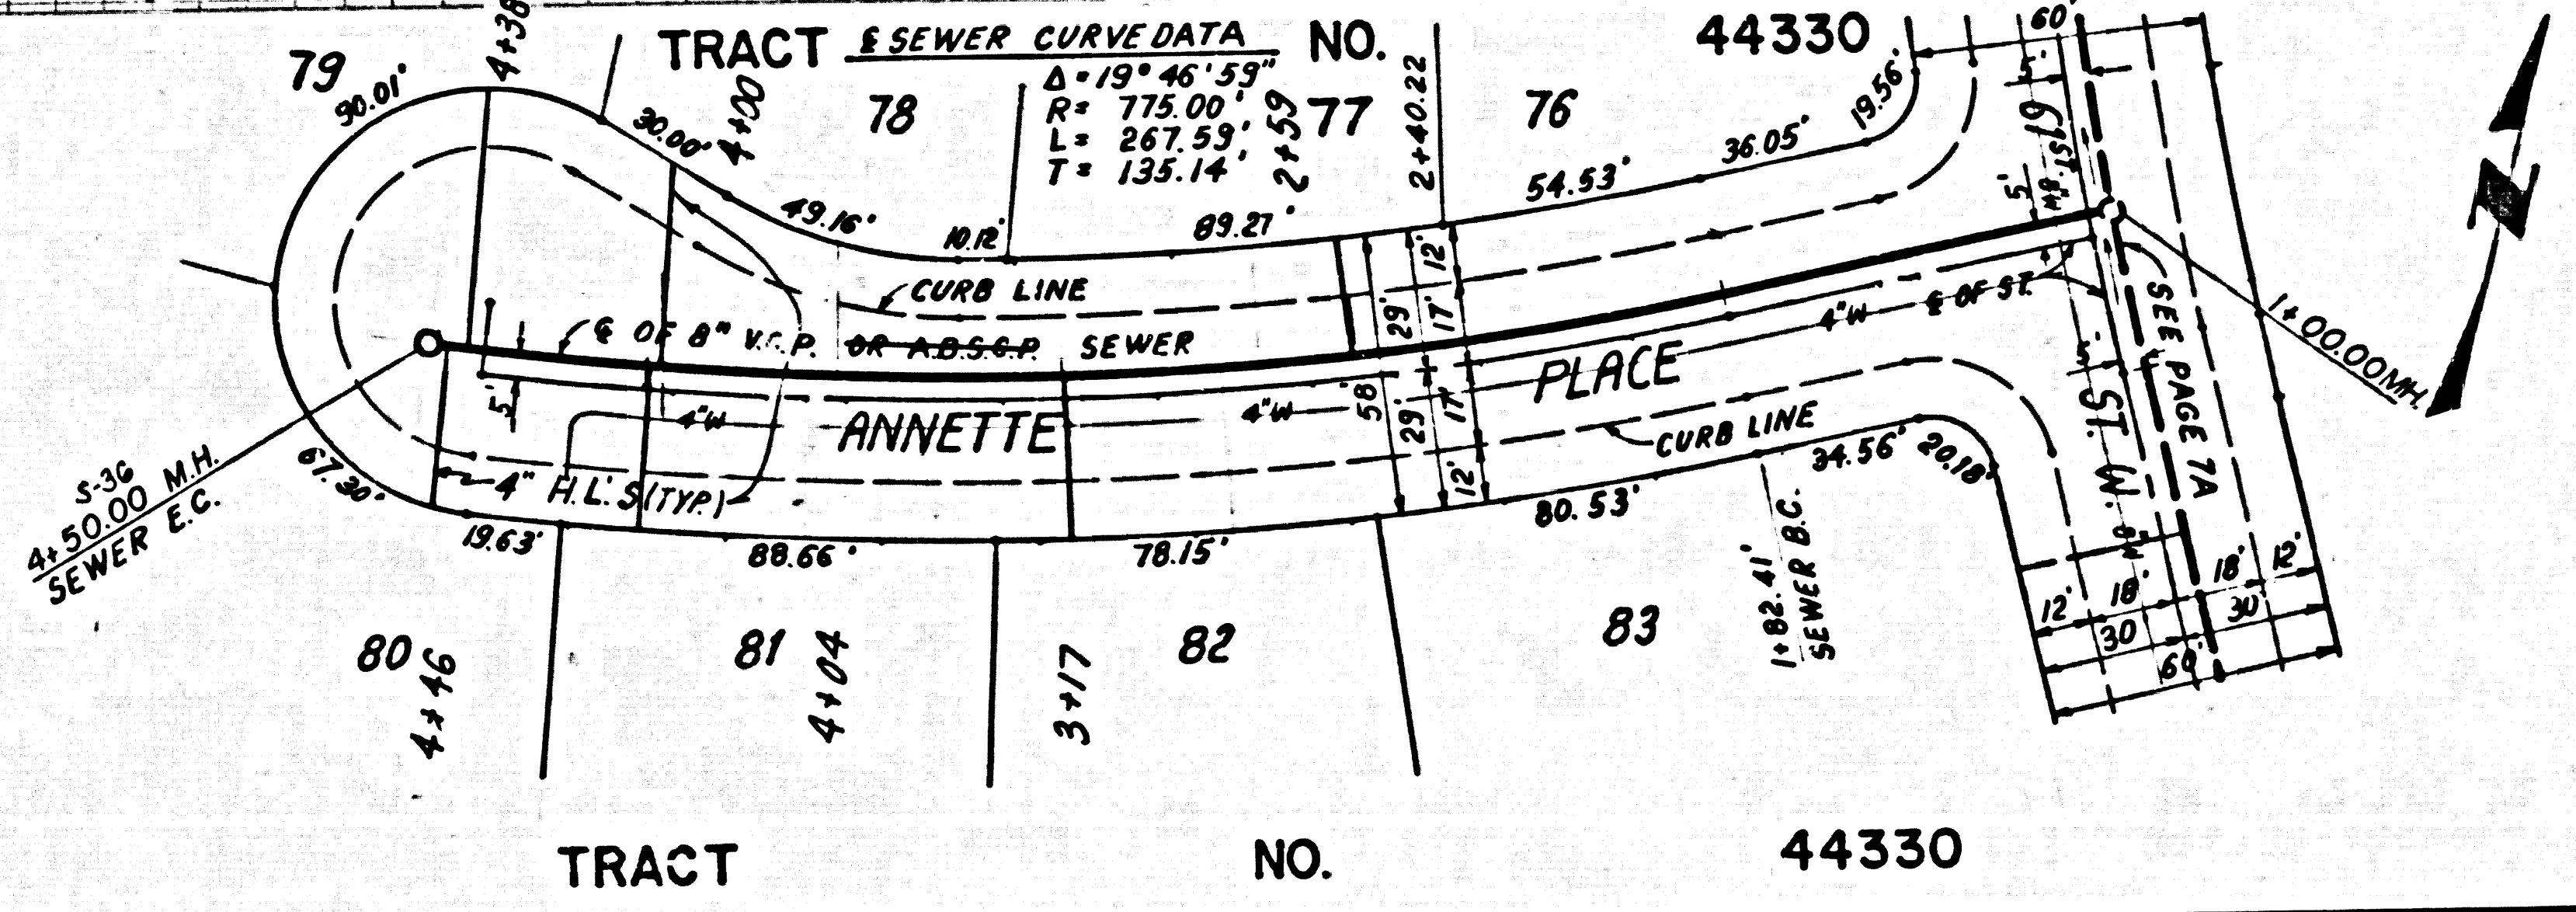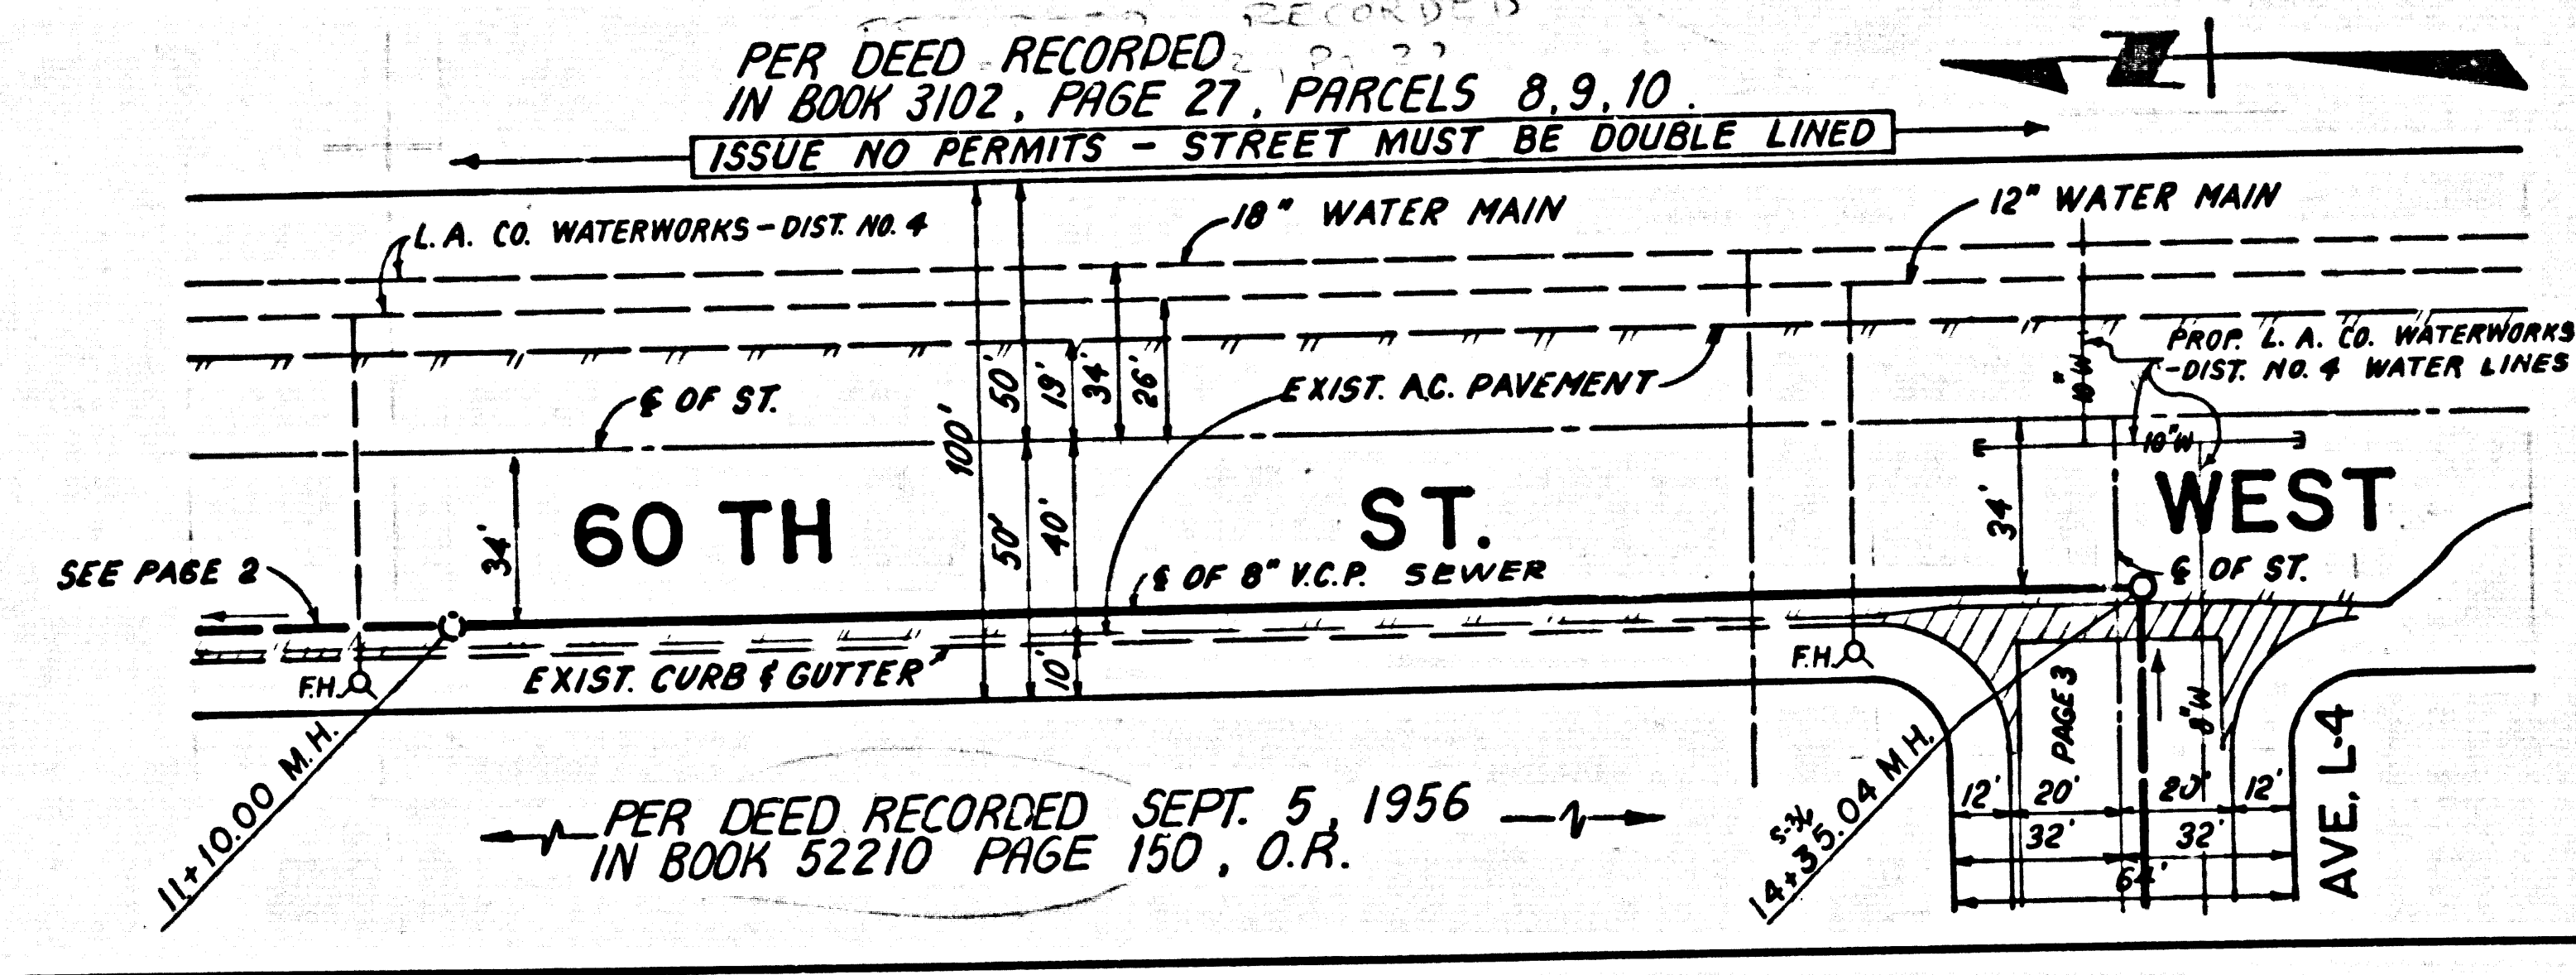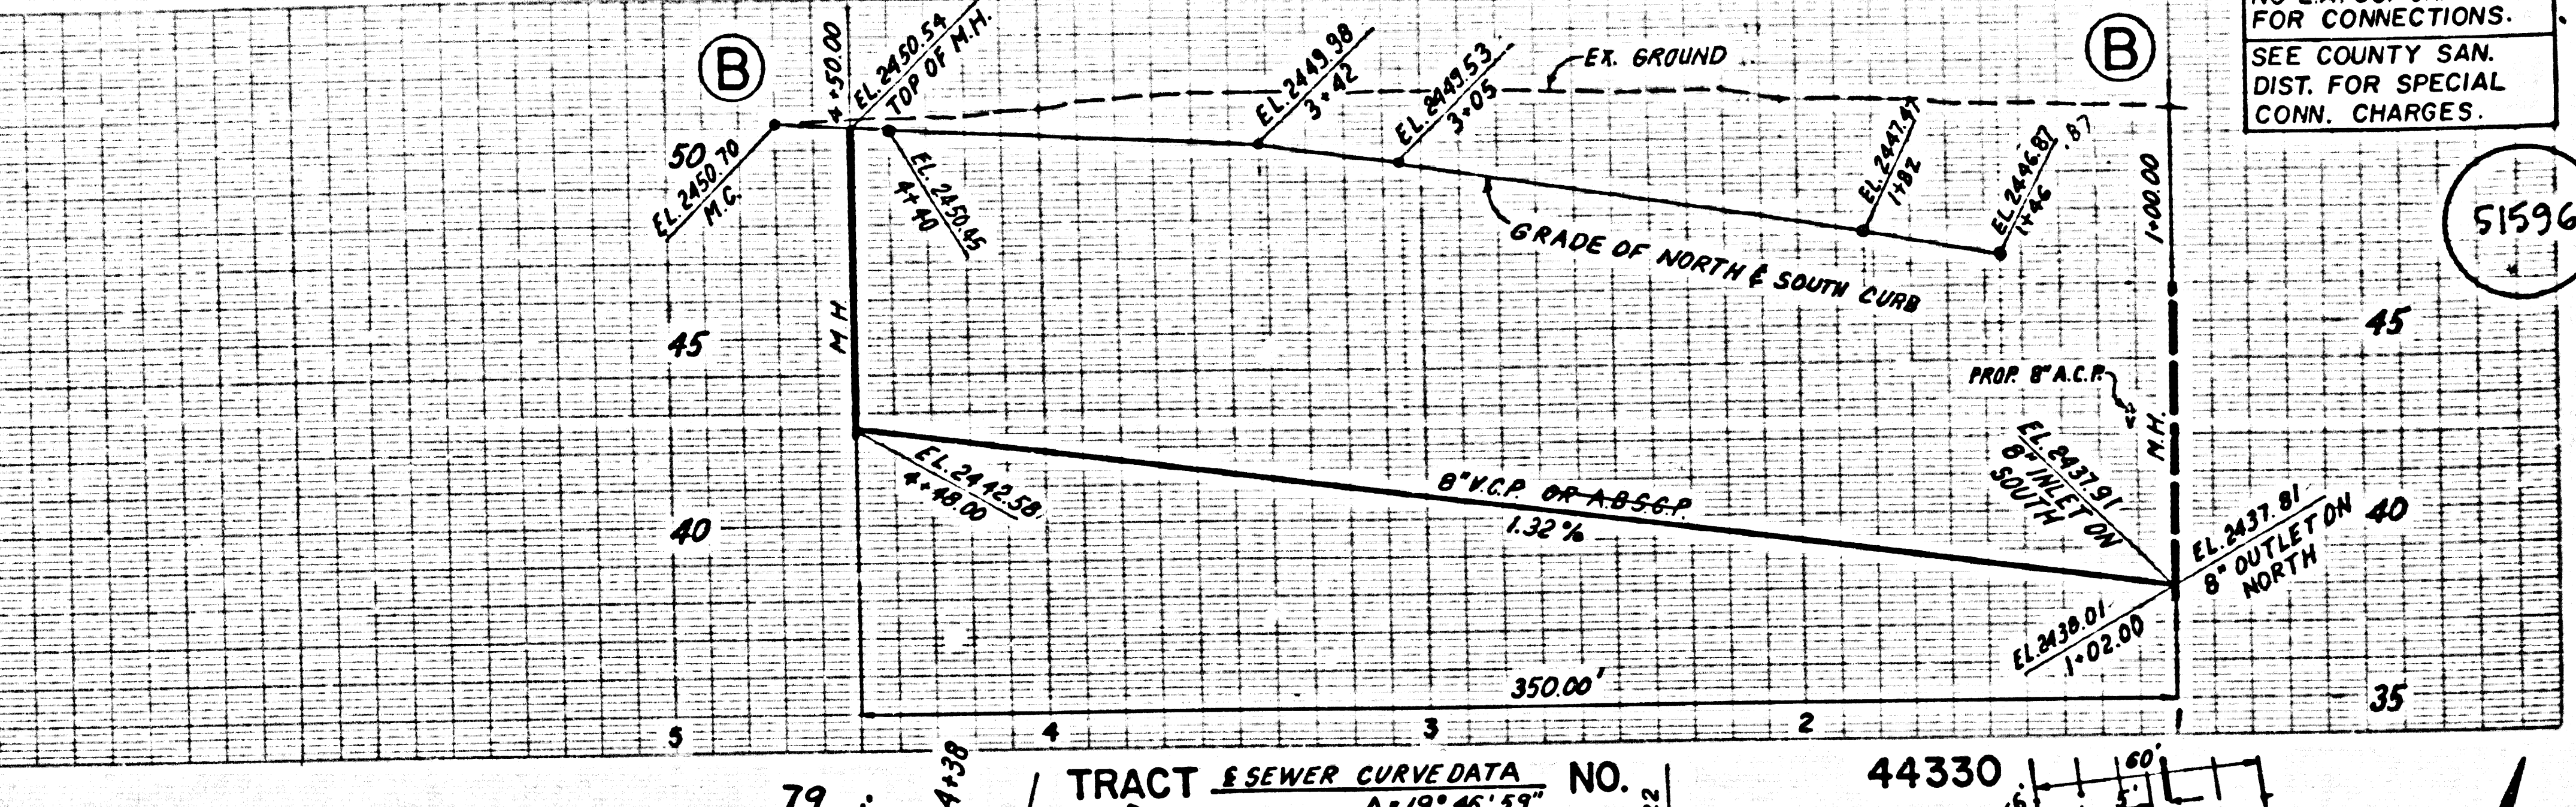
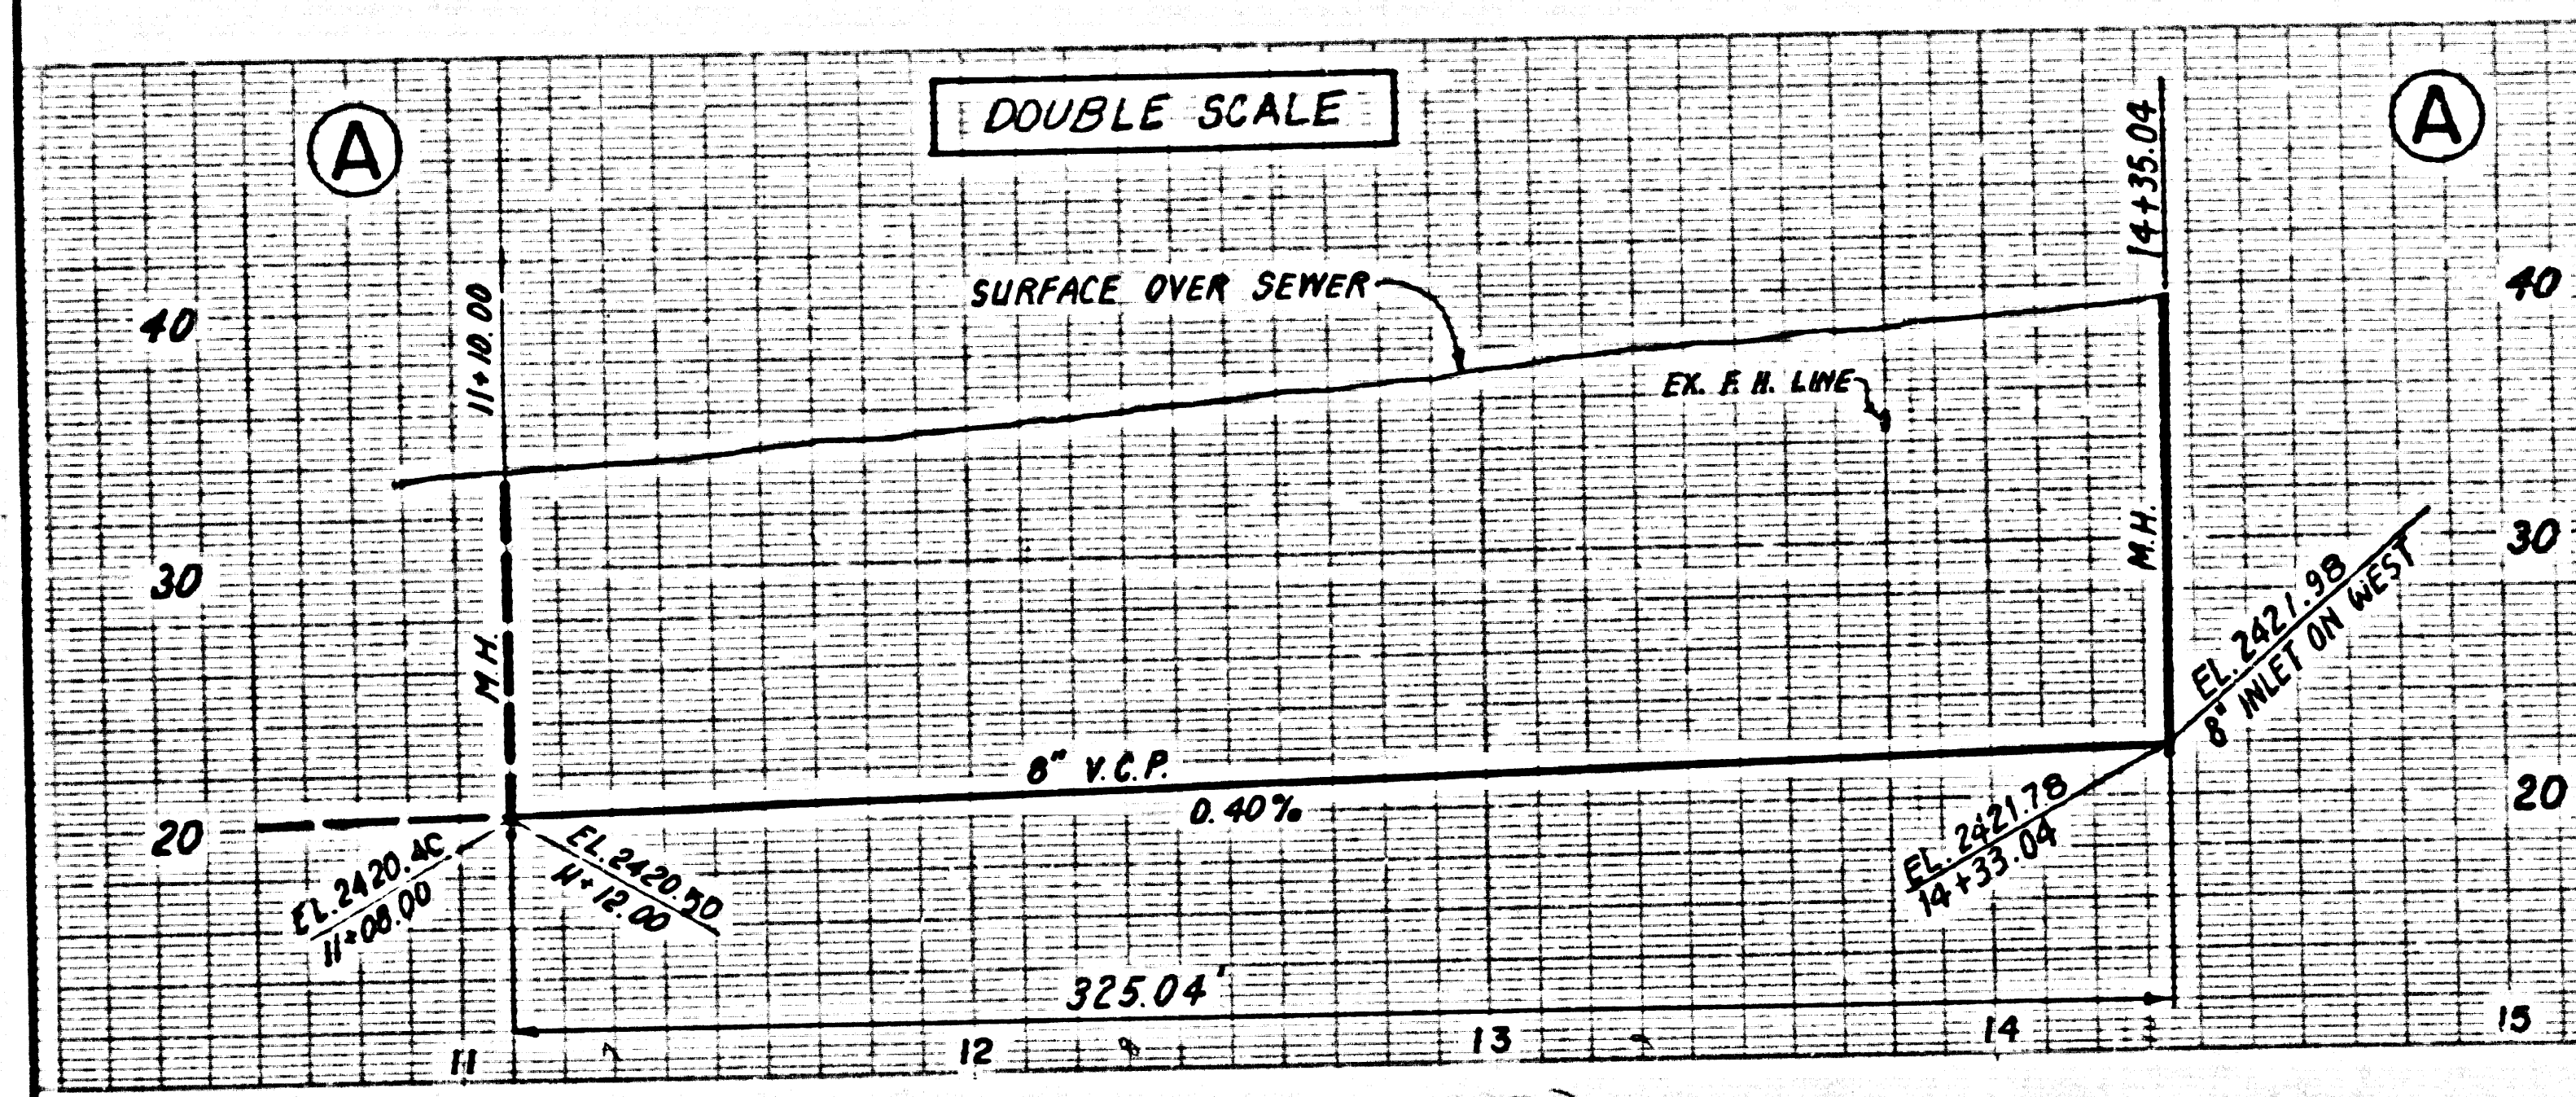


NO L.A. CO. CHARGE FOR CONNECTIONS. SEE COUNTY SAN. DIST. FOR SPECIAL CONN. CHARGES.

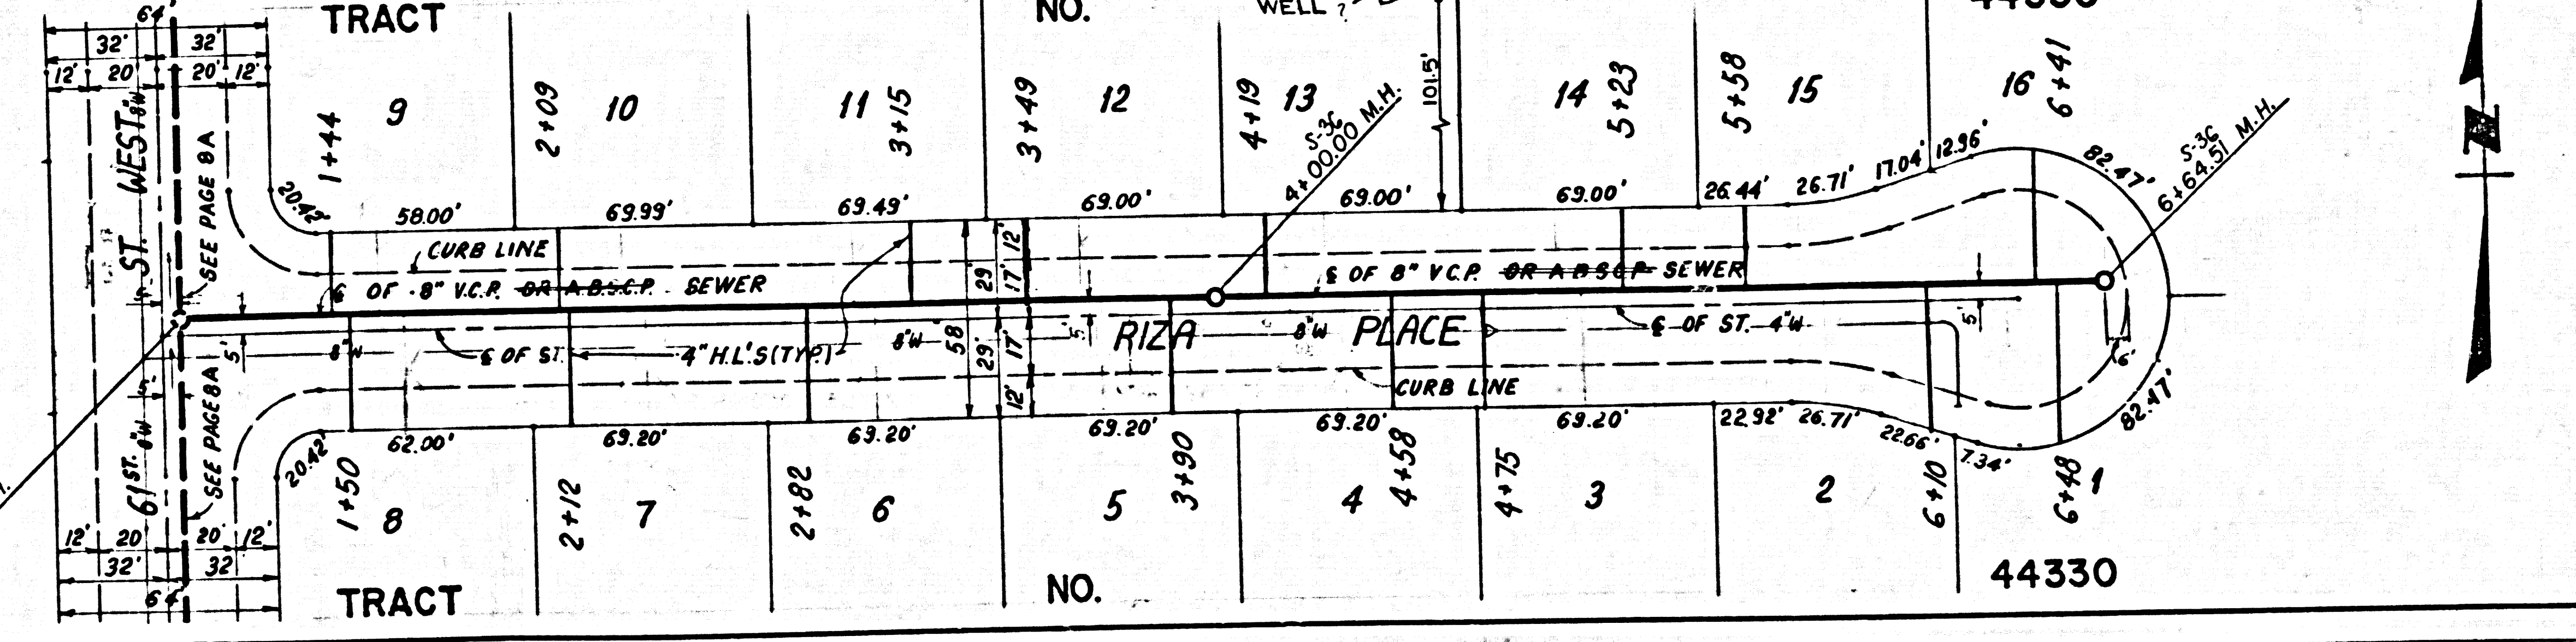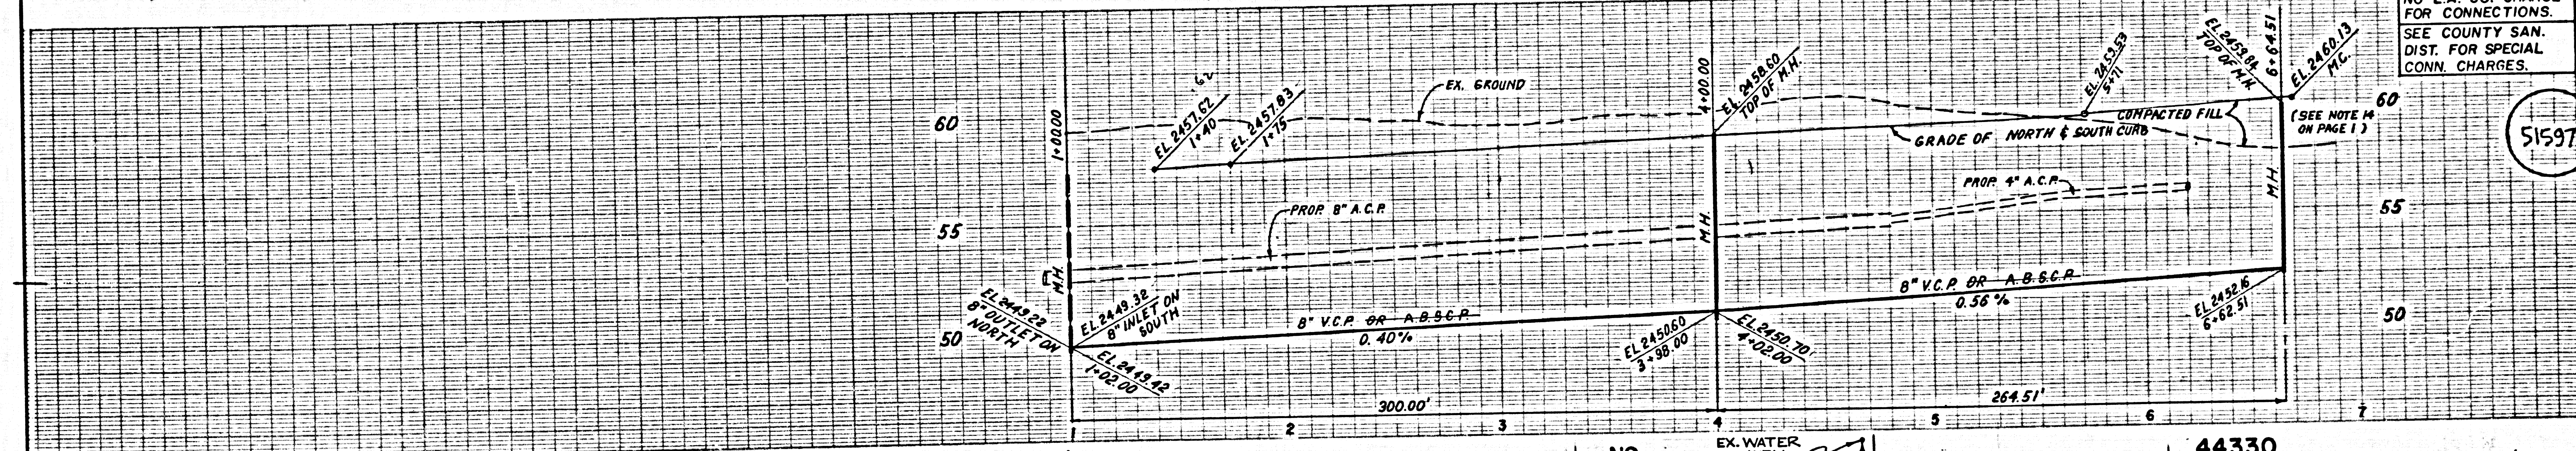

2  
 27401.39  
 05343 ON TRACT



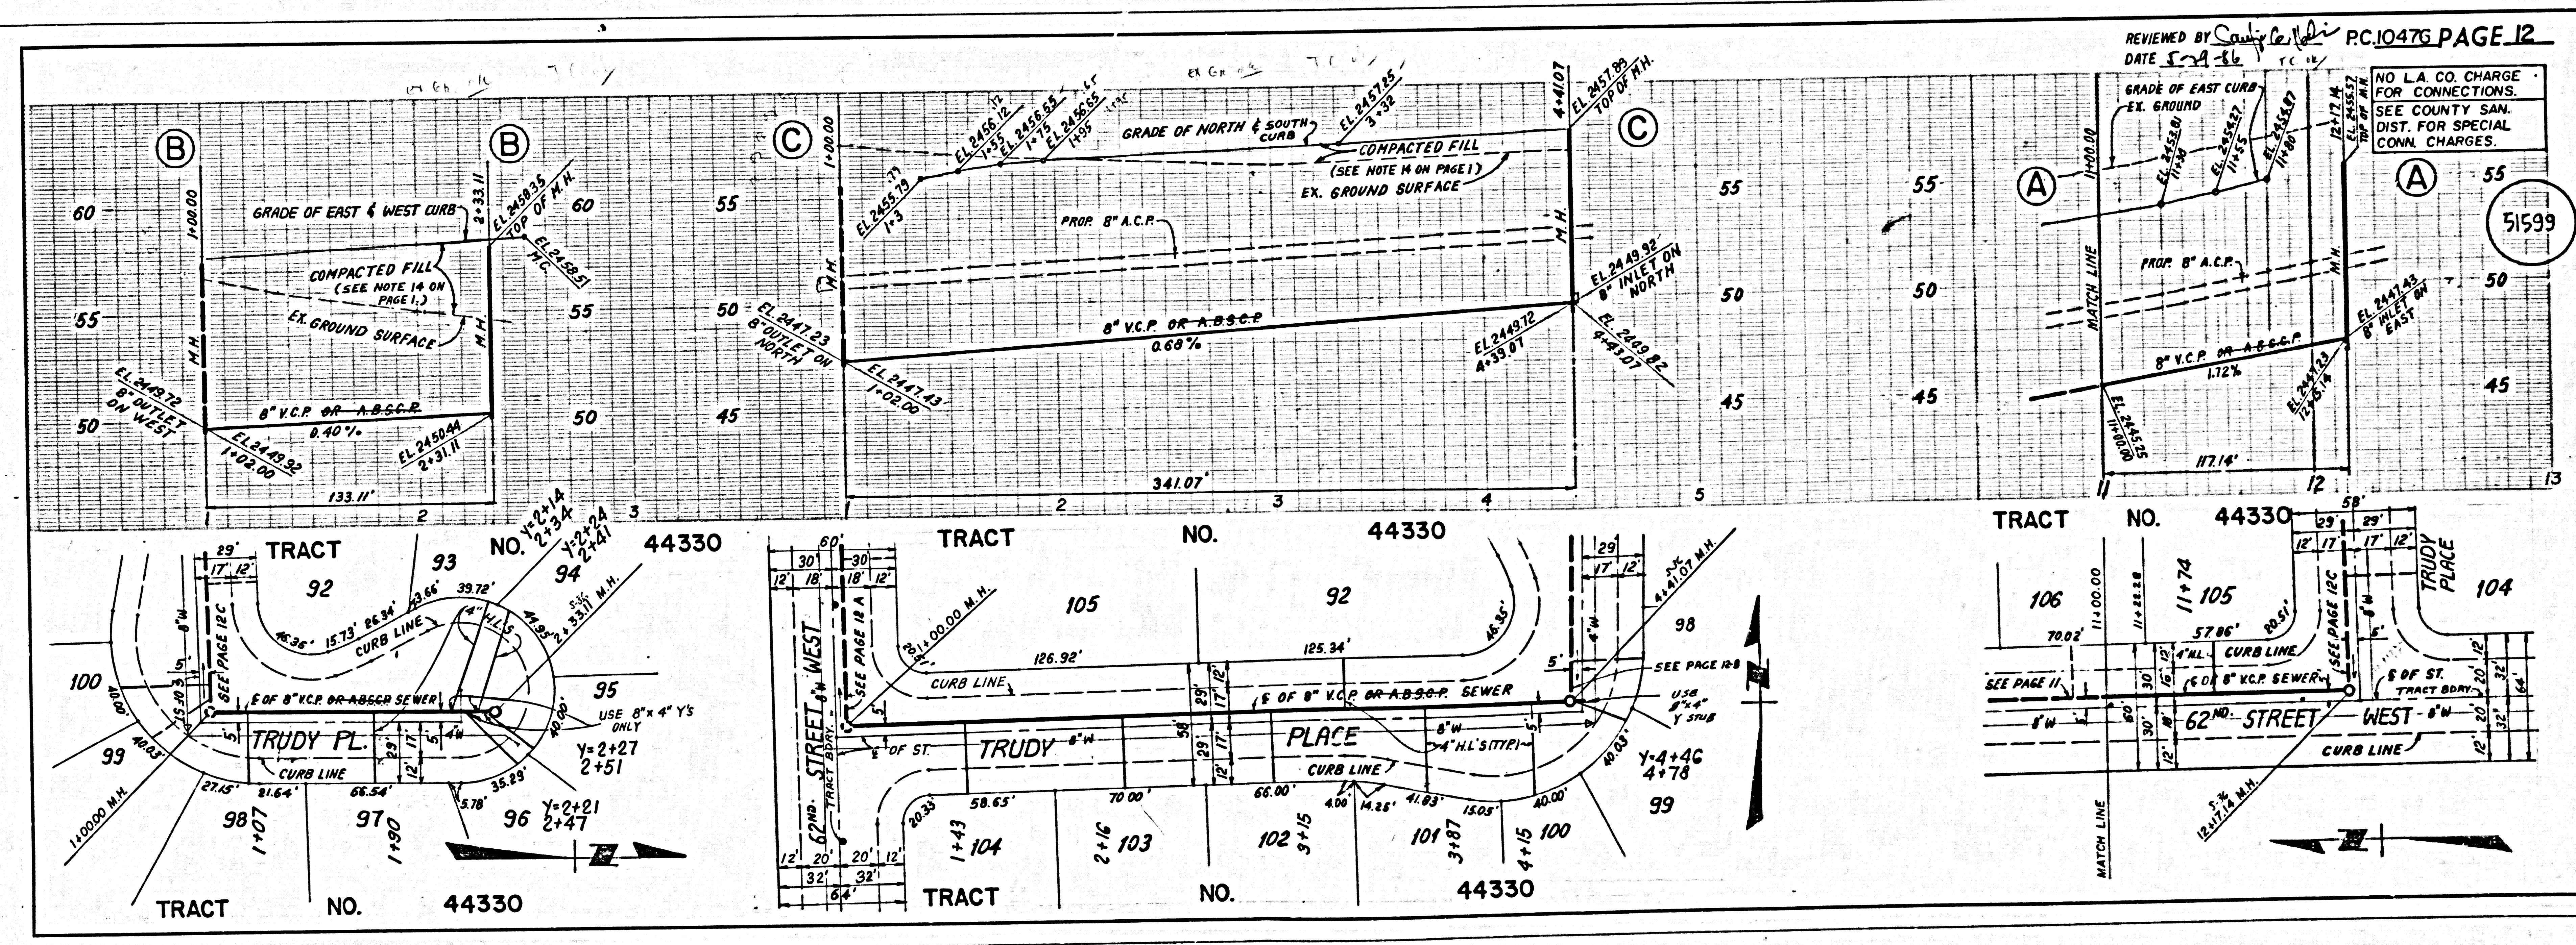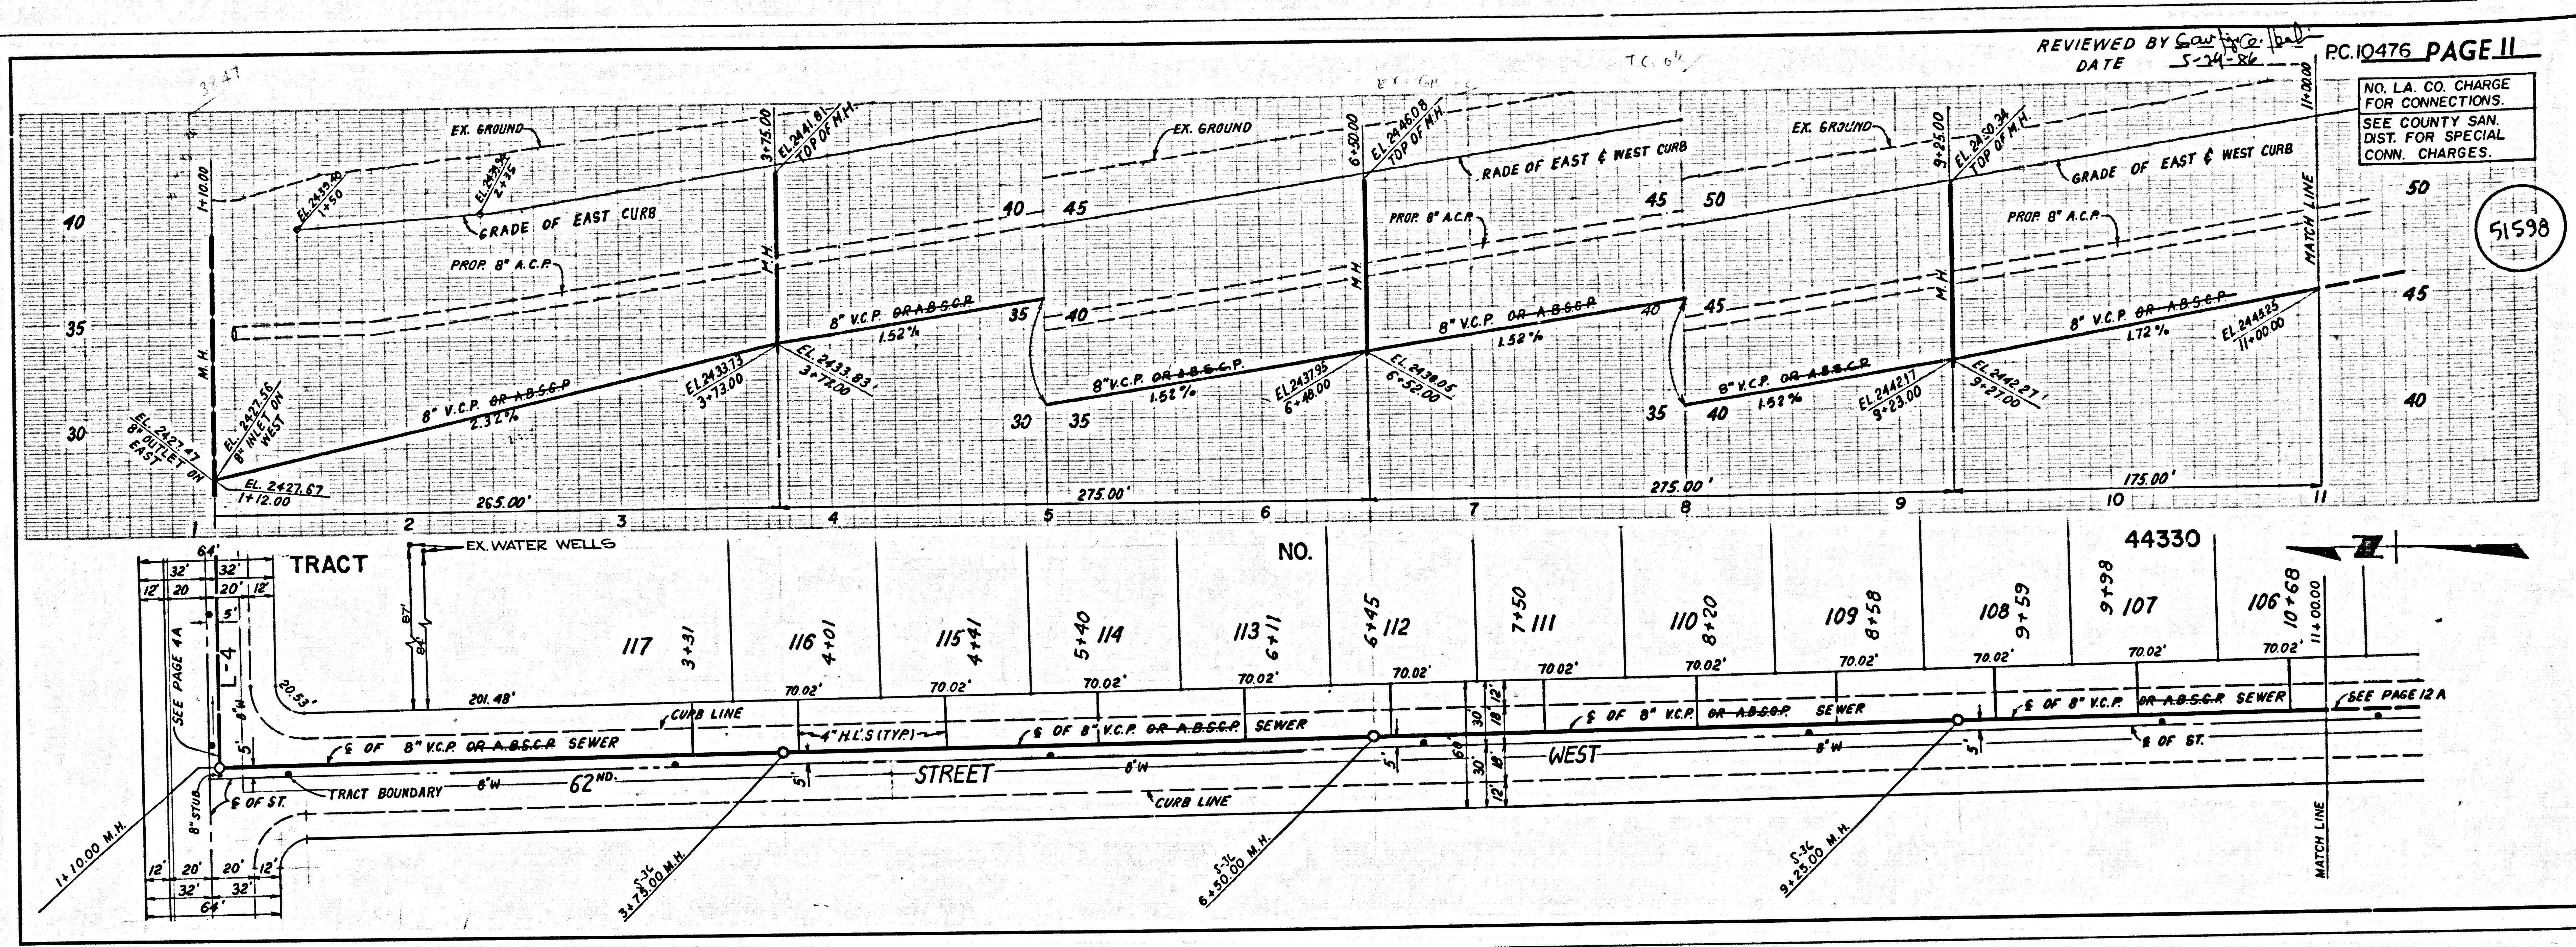

PC 10476  
TRACT NO. 44330