




S

54901 39 05581 01 119

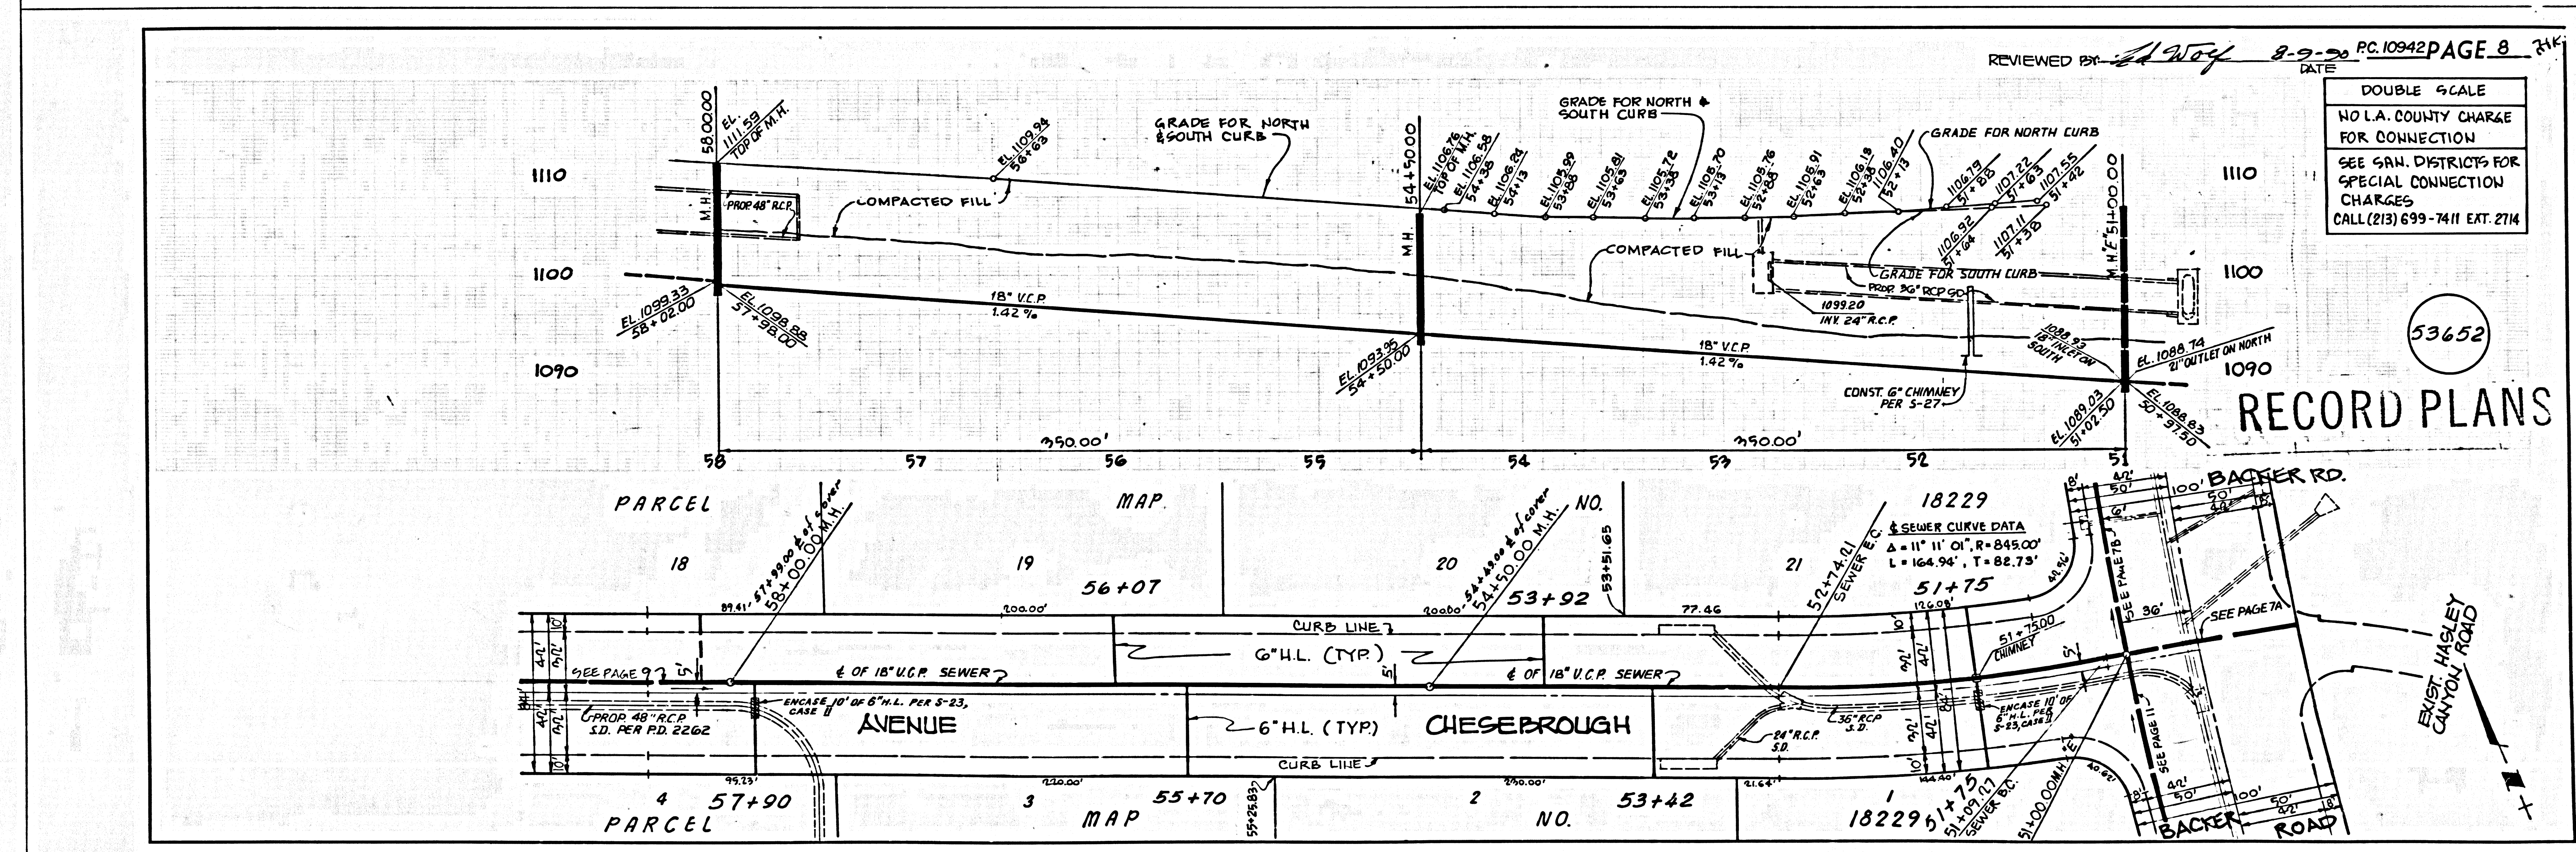

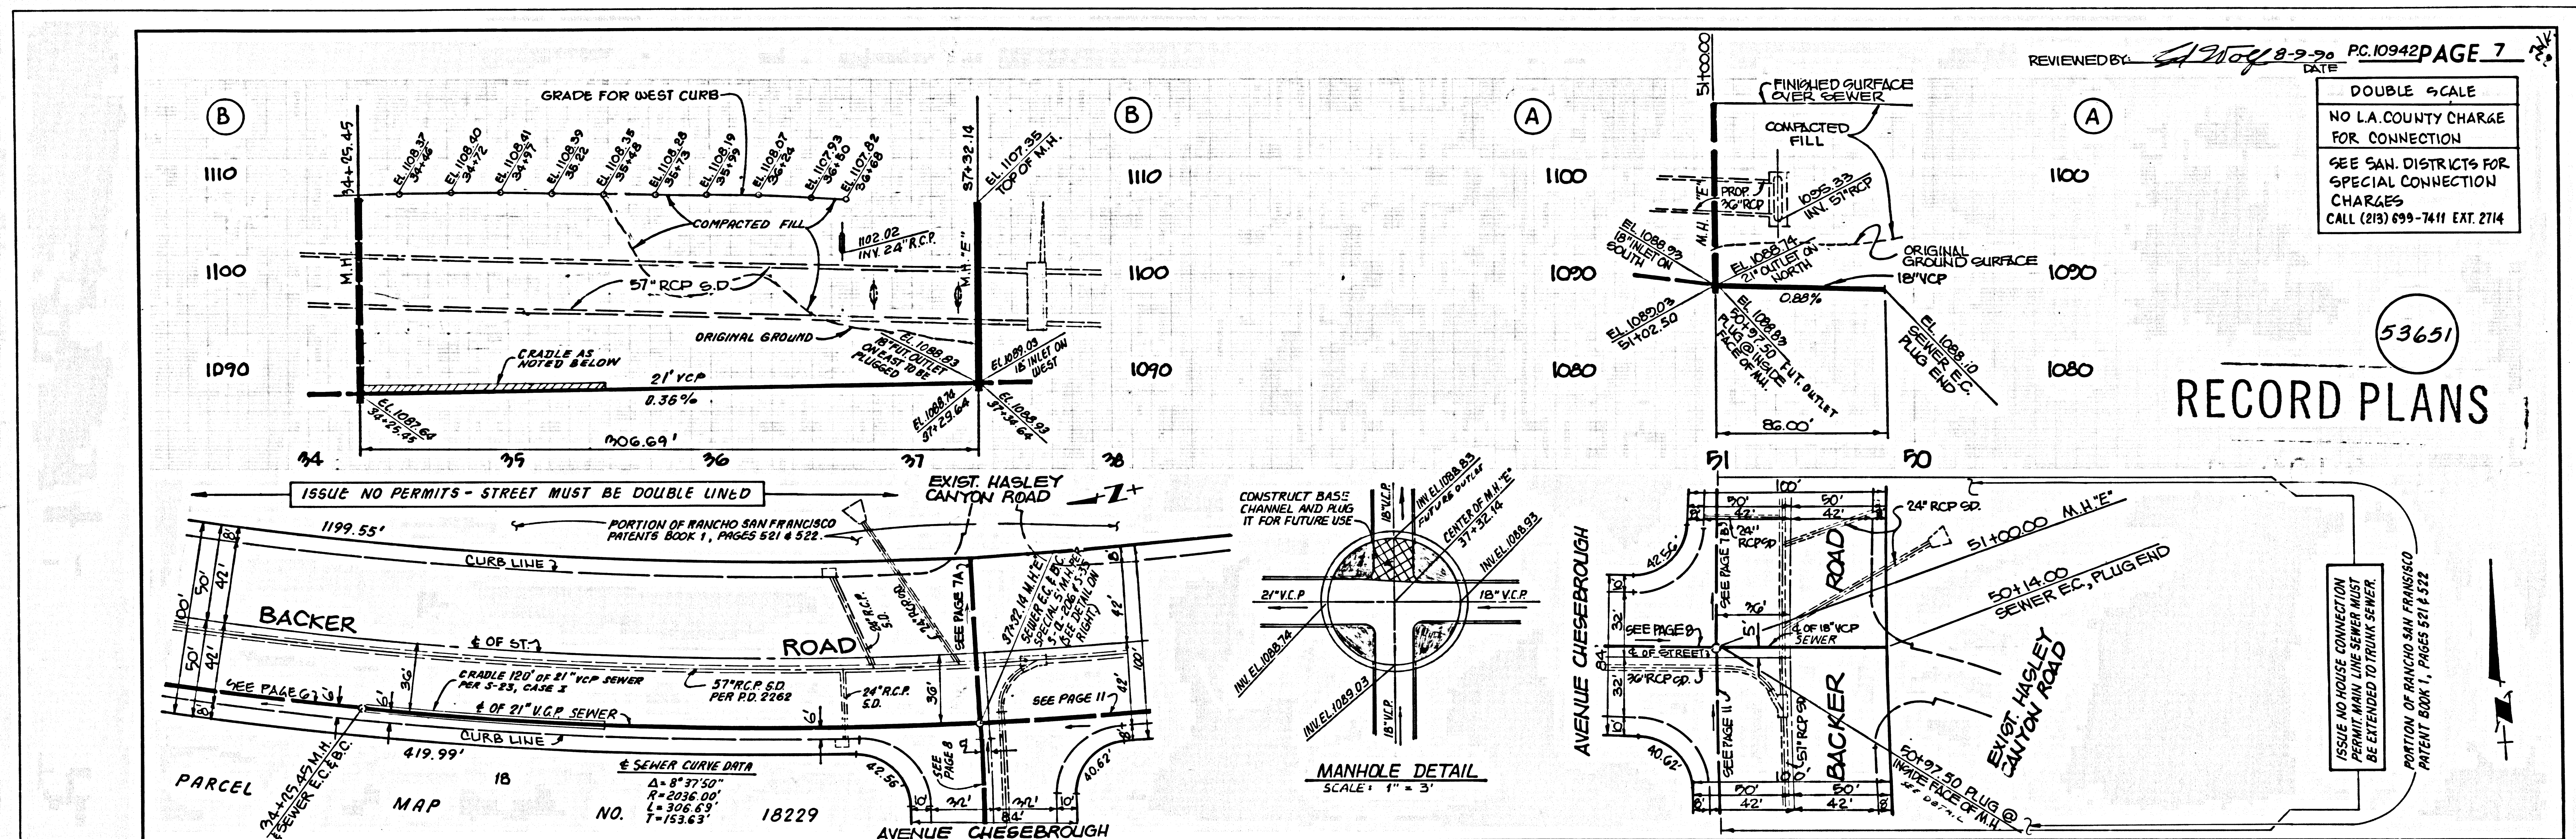

4  
54E01 29 65S81 0M .M.P

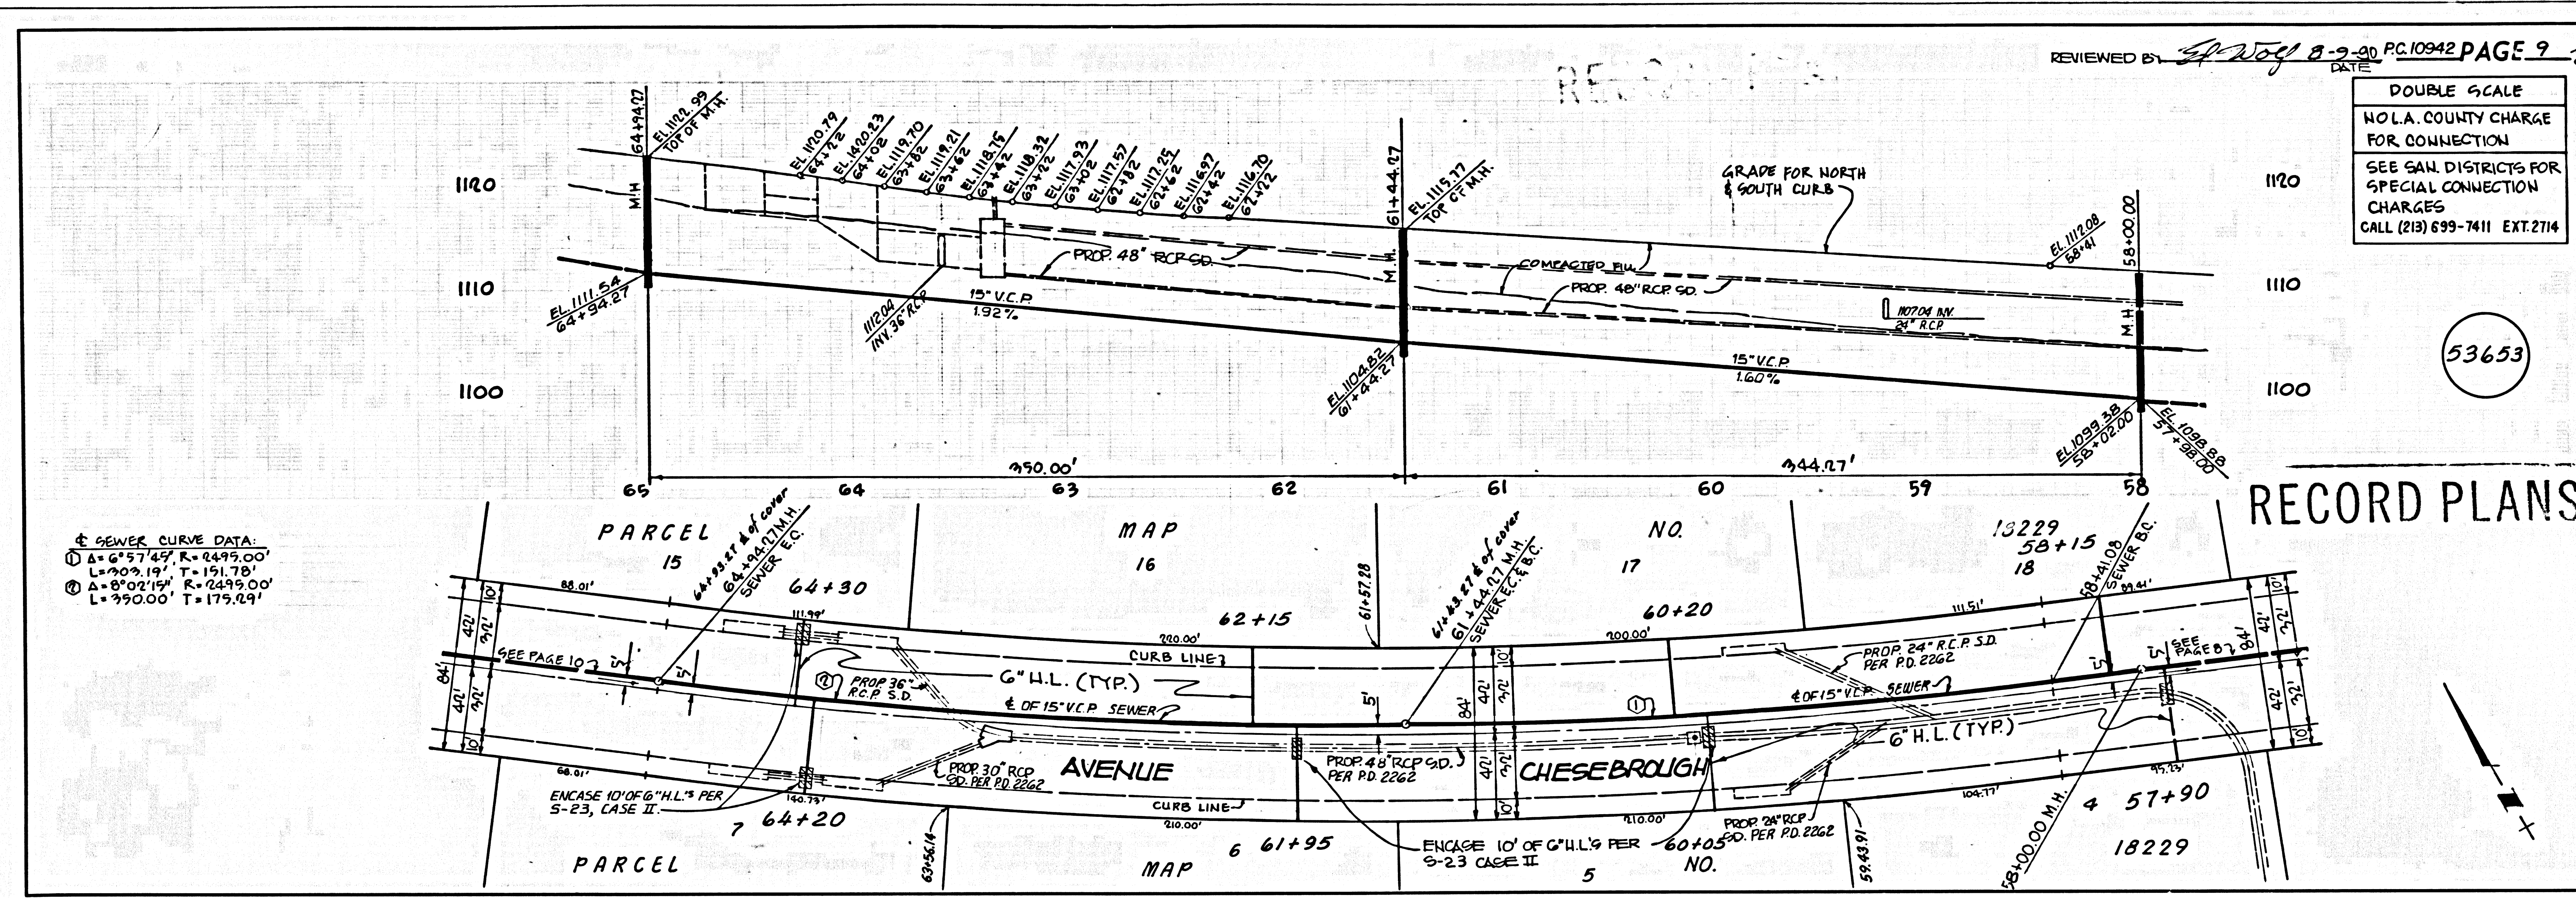


SEWER CURVE DATA  
 ① Δ=6°15'47" R=8495.00'  
 L=909.19' T=151.78'  
 ② Δ=8°02'15" R=2499.00'  
 L=990.00' T=179.49'

REVIEWED BY: *[Signature]* 8-9-90 PC.10942 PAGE 9  
 DATE

DOUBLE SCALE  
 NO L.A. COUNTY CHARGE  
 FOR CONNECTION  
 SEE SAN. DISTRICTS FOR  
 SPECIAL CONNECTION  
 CHARGES  
 CALL (213) 699-7411 EXT. 2714

53653

RECORD PLANS

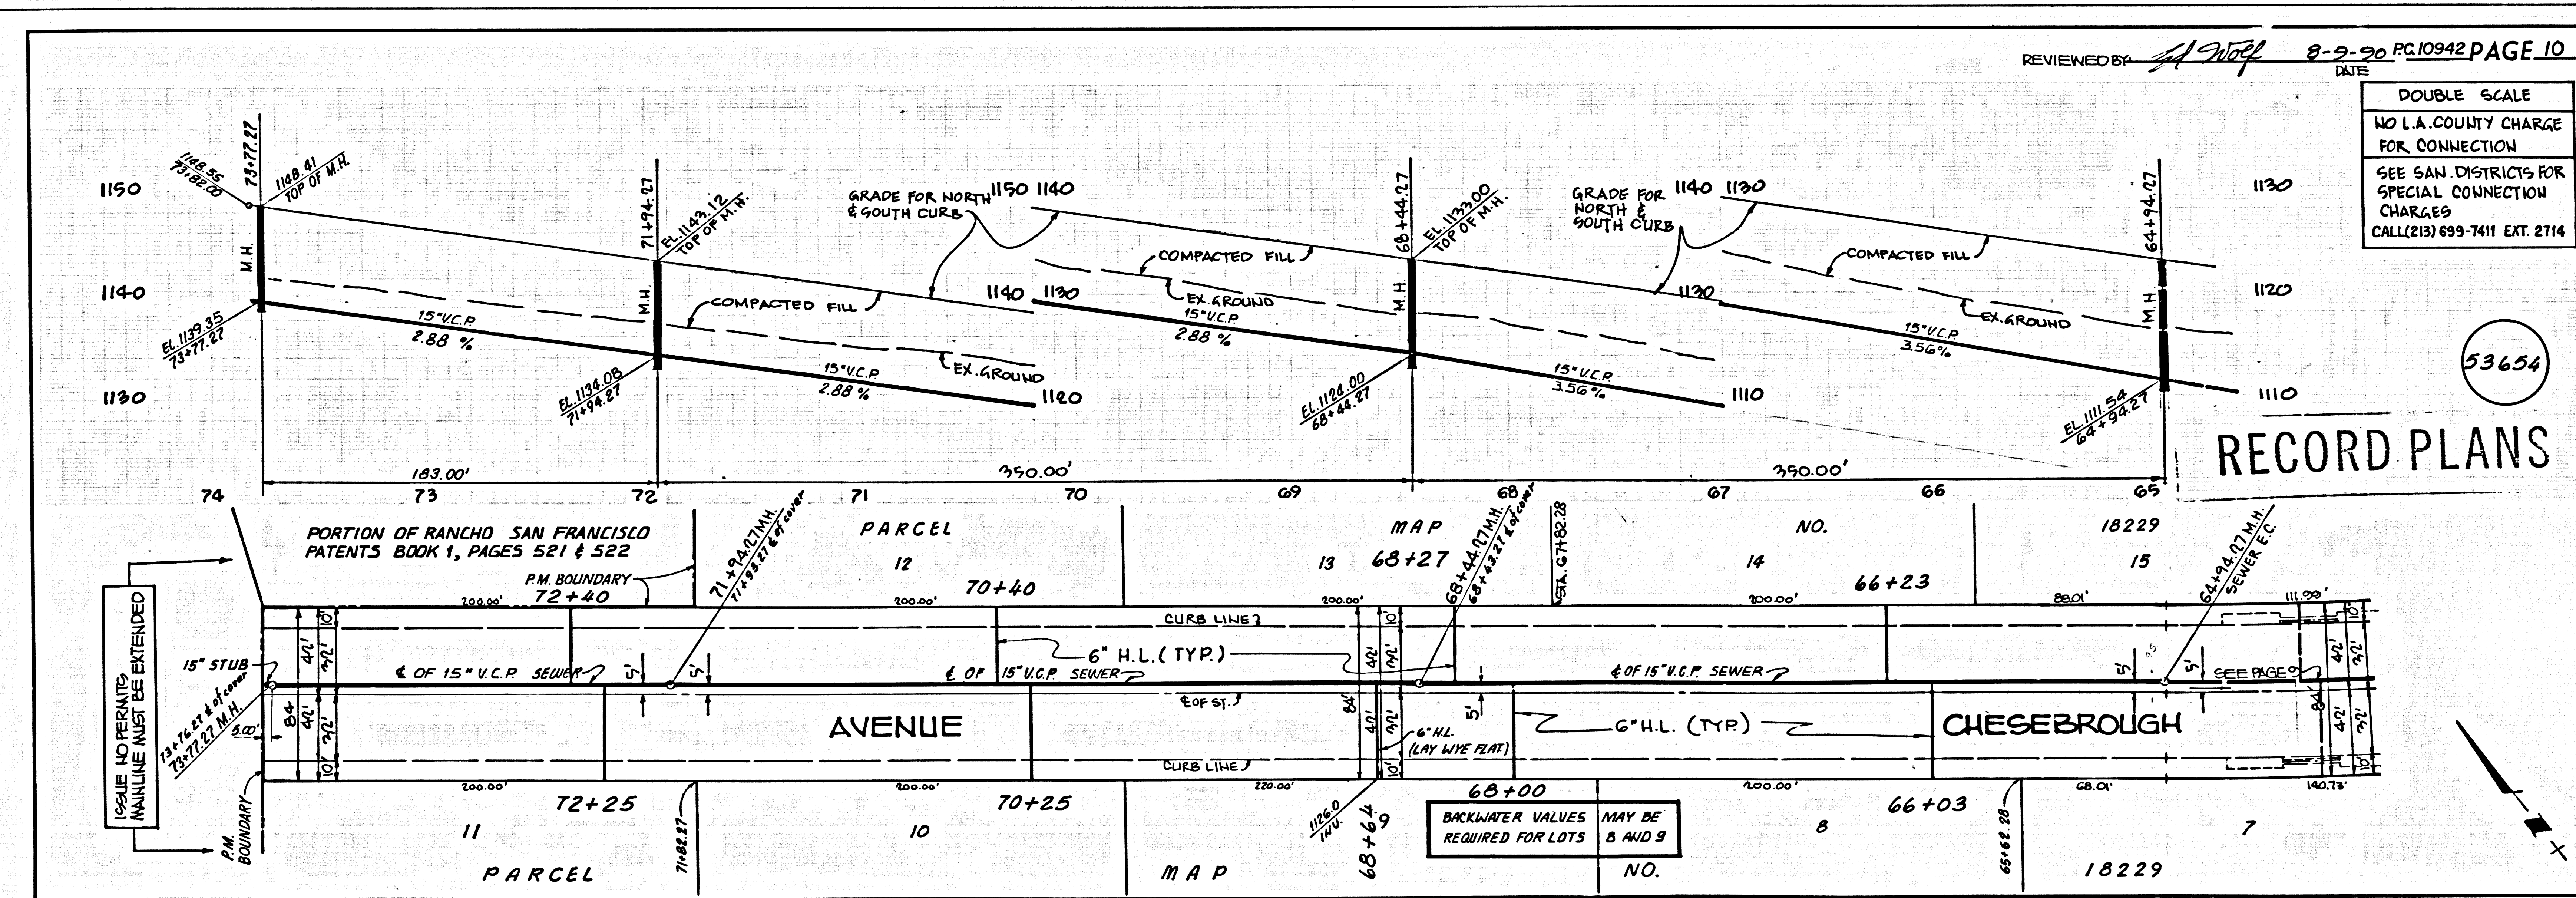

SCALE AND PERMITS  
 MANHOLE MUST BE EXTENDED  
 15" STUB  
 2' MIN. LAY LAY  
 73+77.27


REVIEWED BY: *[Signature]* 8-9-90 PC.10942 PAGE 10  
 DATE

DOUBLE SCALE  
 NO L.A. COUNTY CHARGE  
 FOR CONNECTION  
 SEE SAN. DISTRICTS FOR  
 SPECIAL CONNECTION  
 CHARGES  
 CALL (213) 699-7411 EXT. 2714


53654

RECORD PLANS

2  
 54901 CA 05581 ON M9


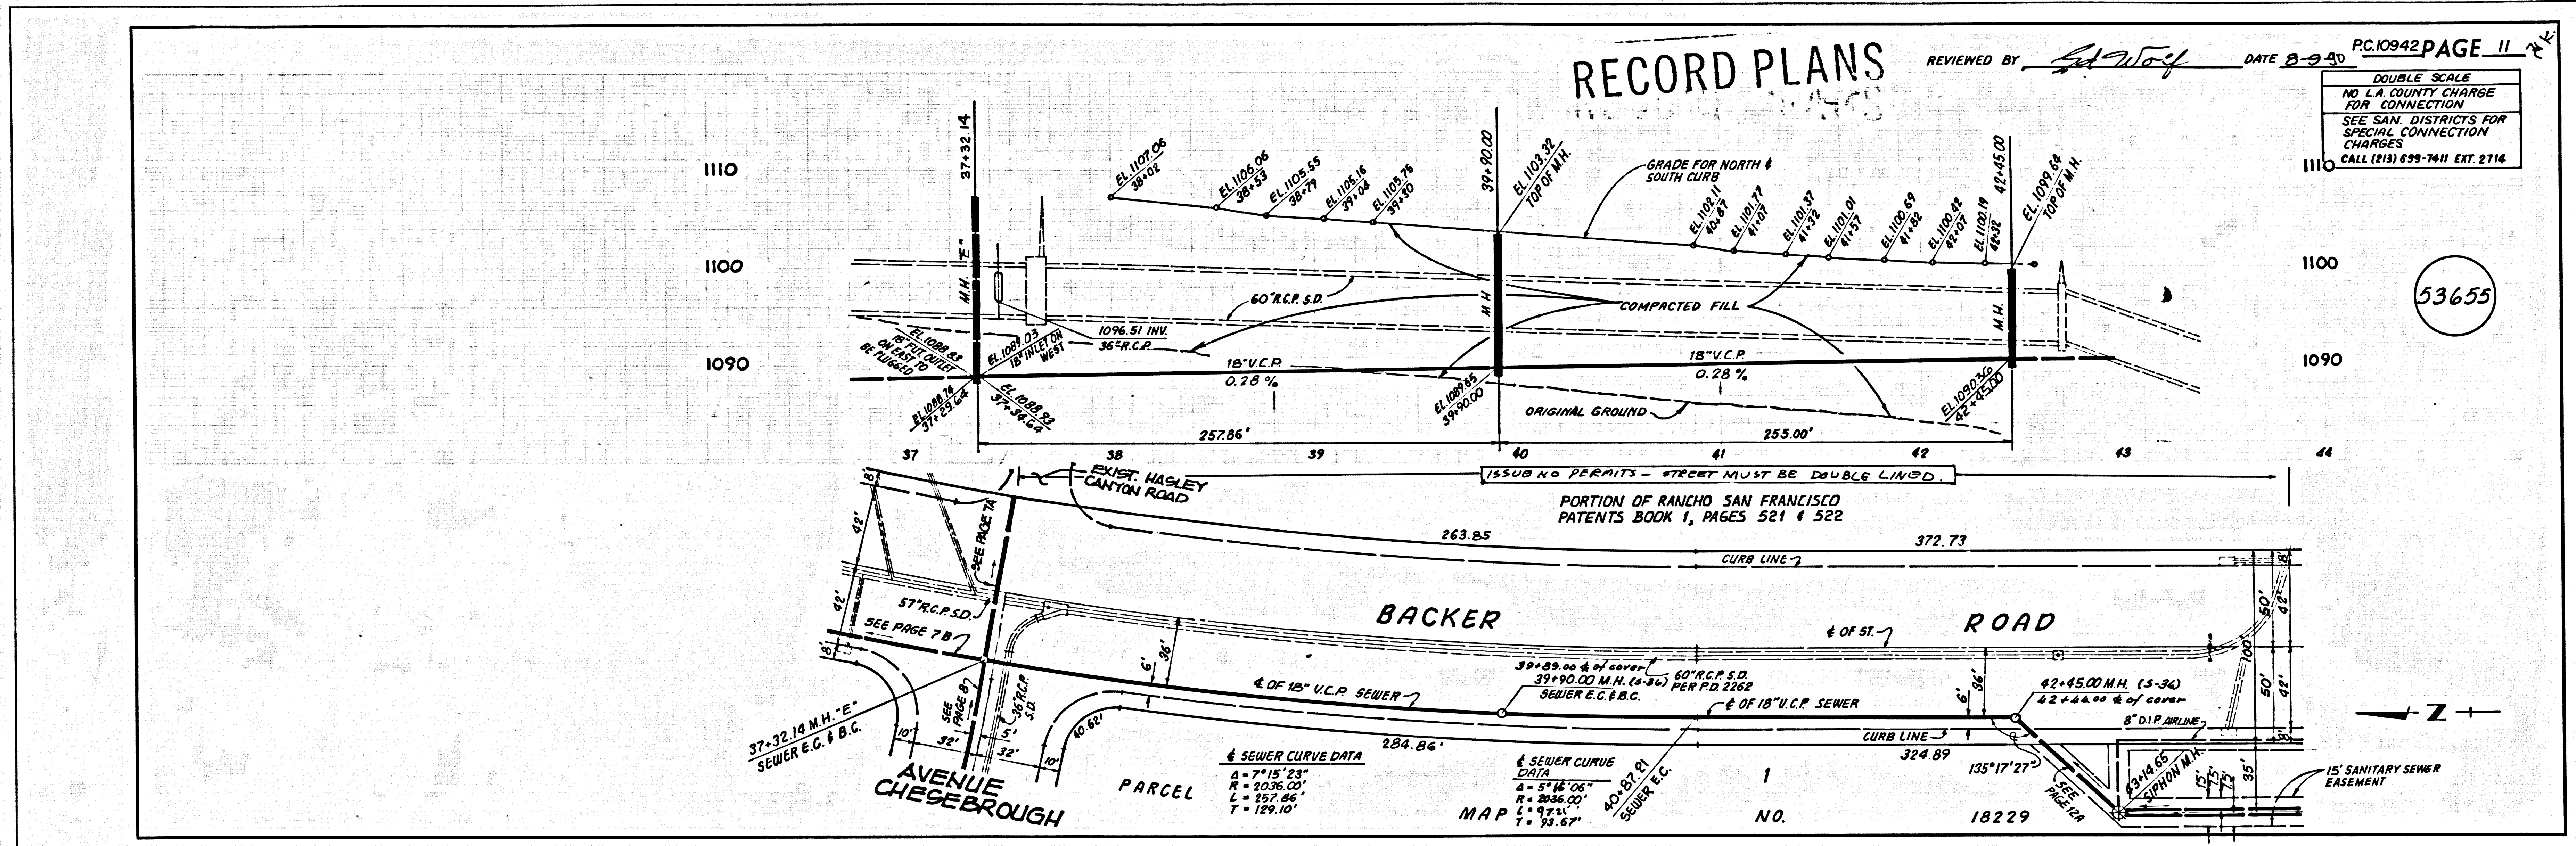



53655

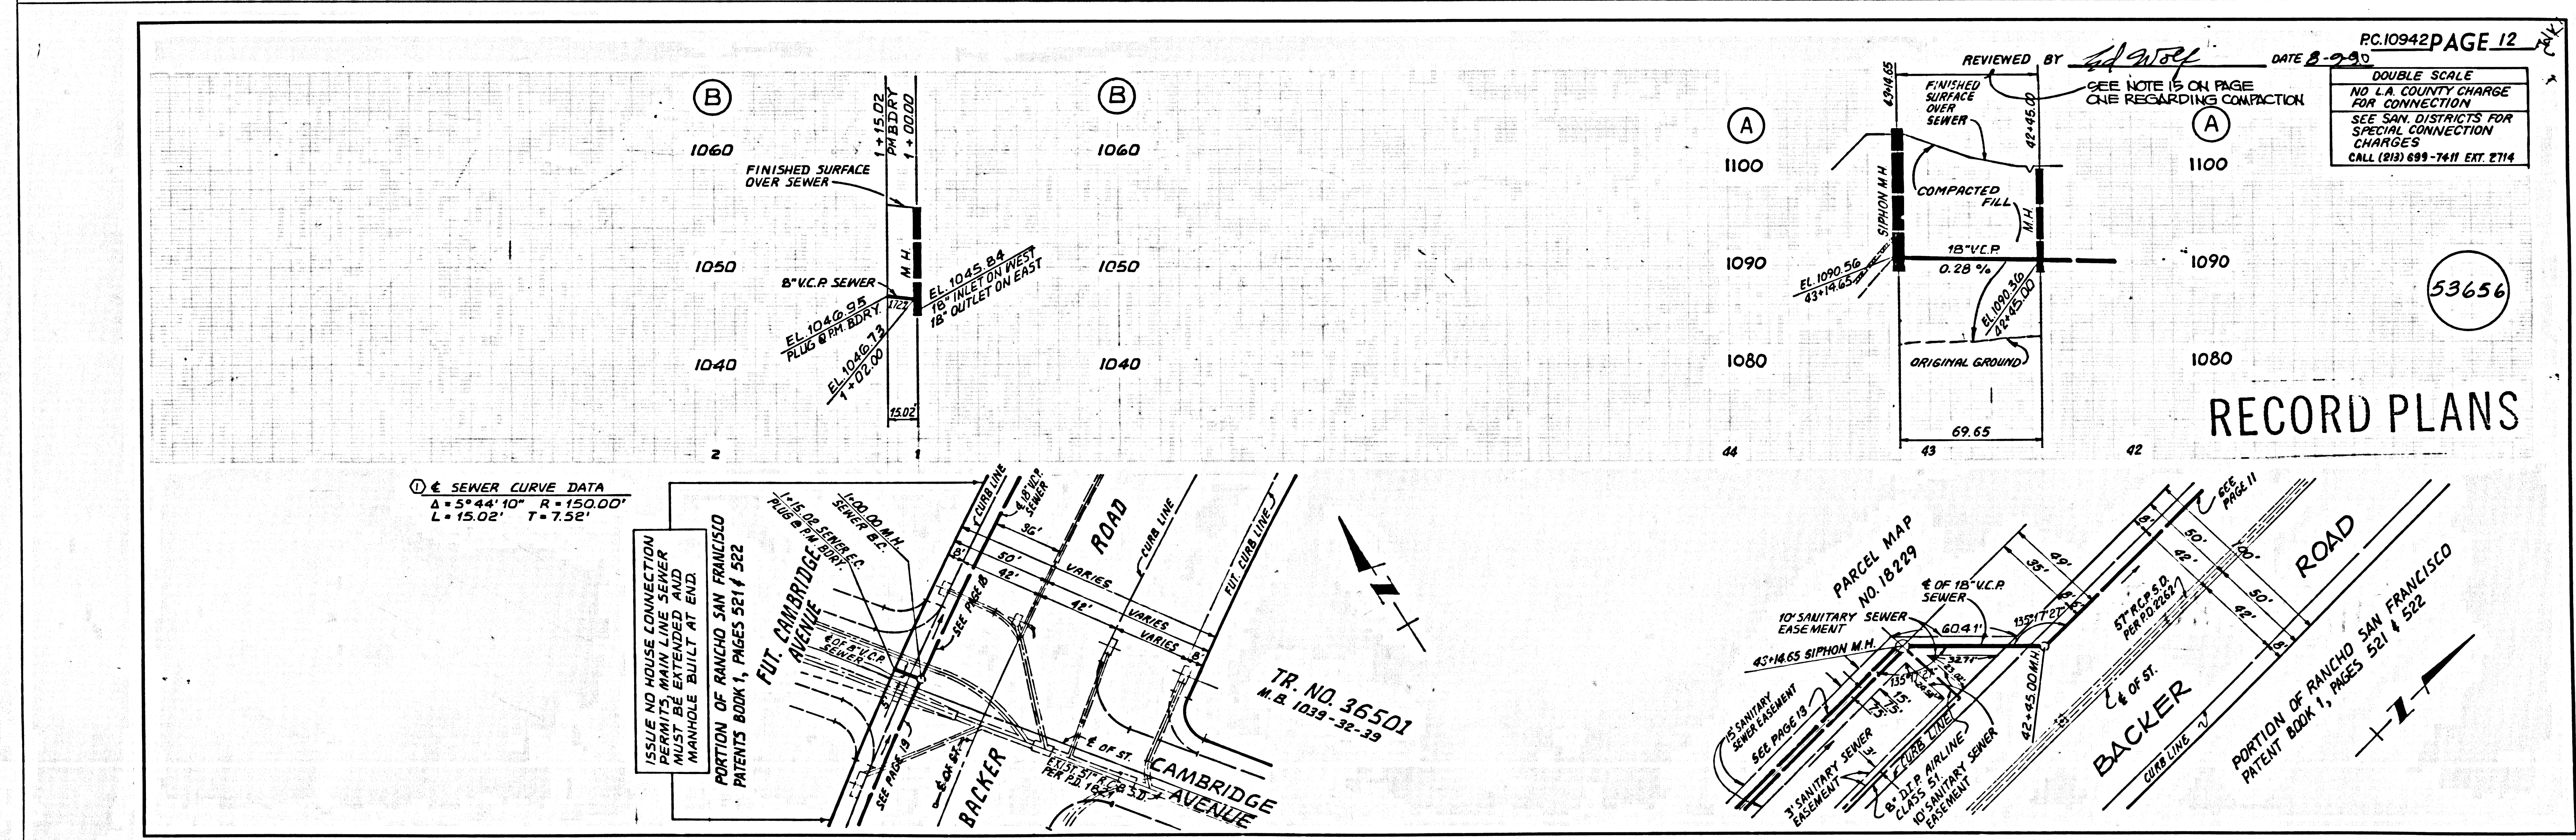

53656

54E01 3A 65581 .0N .M 9

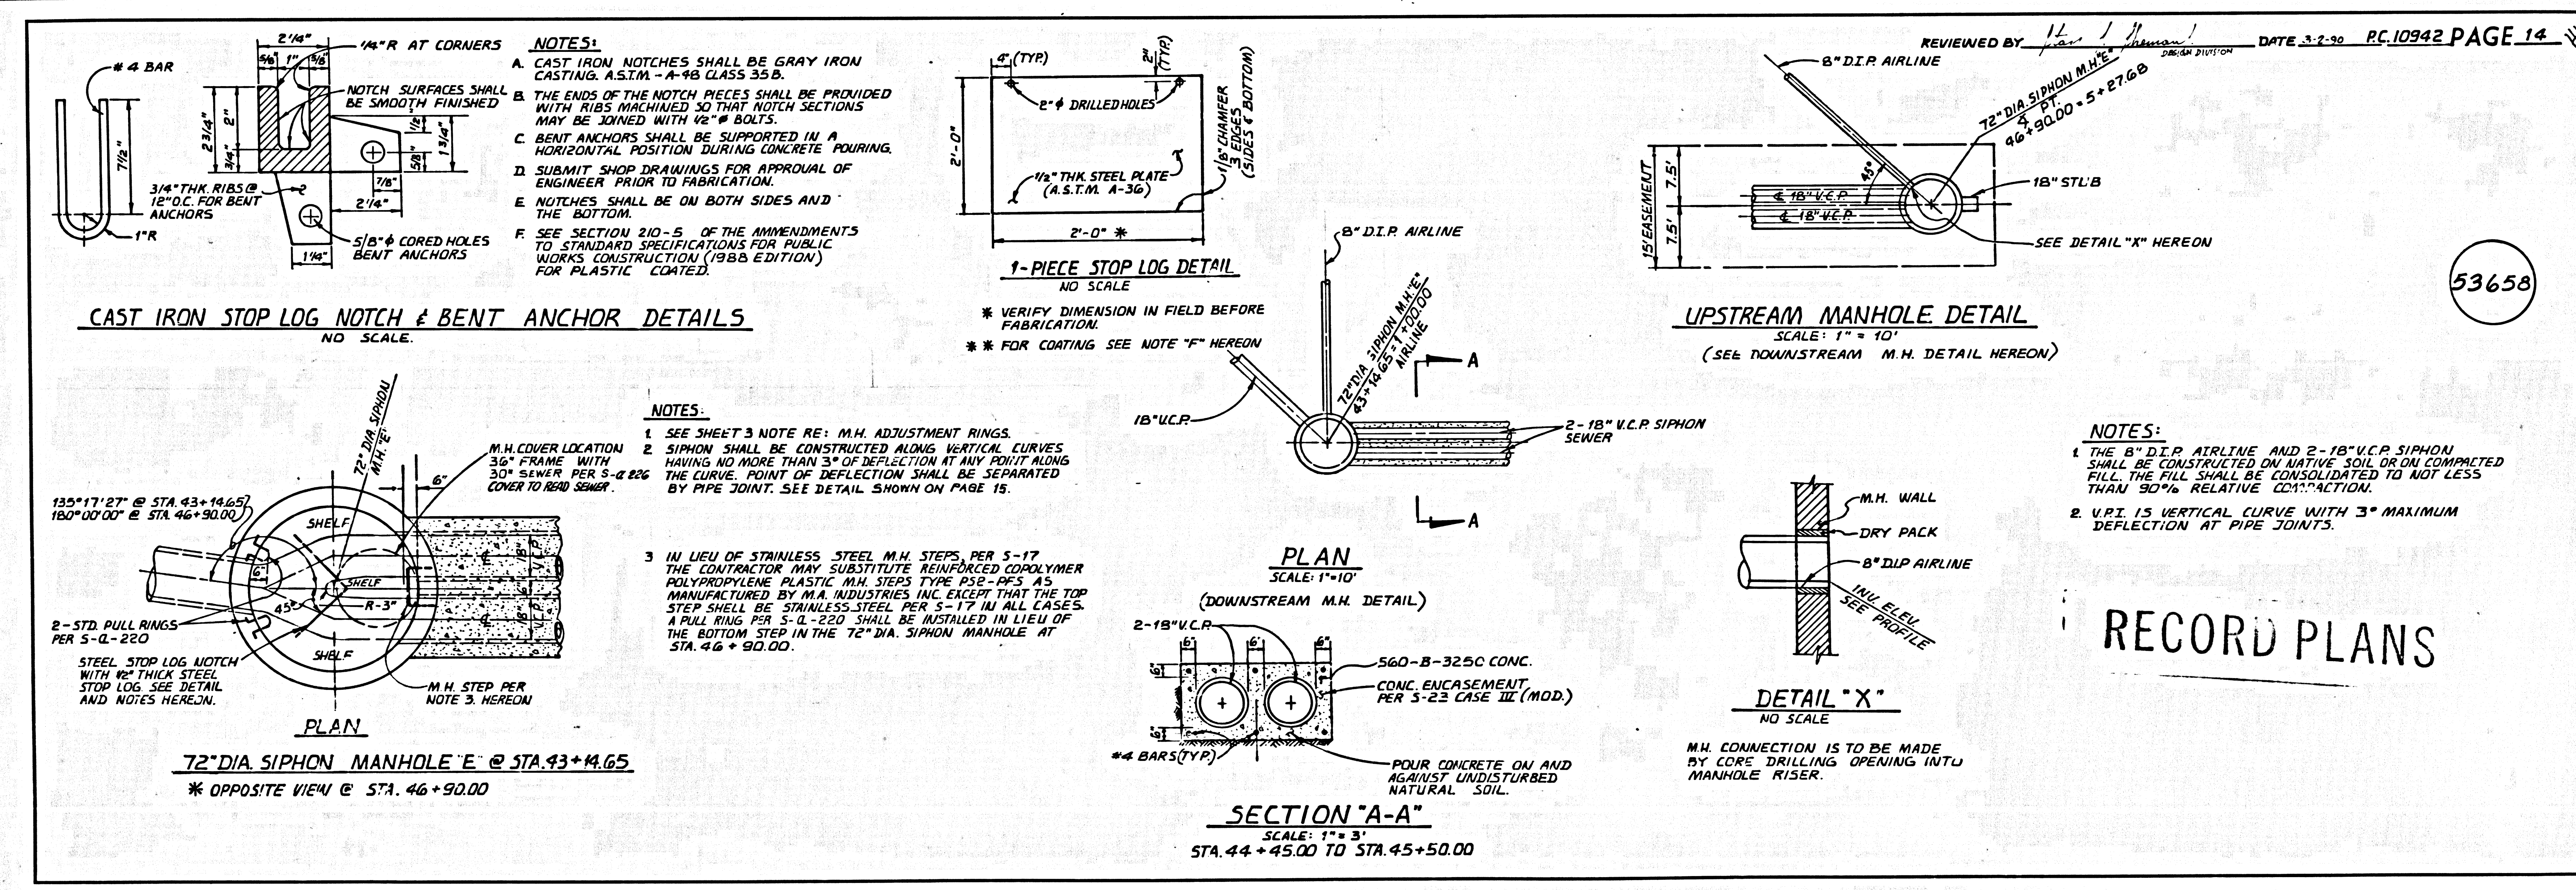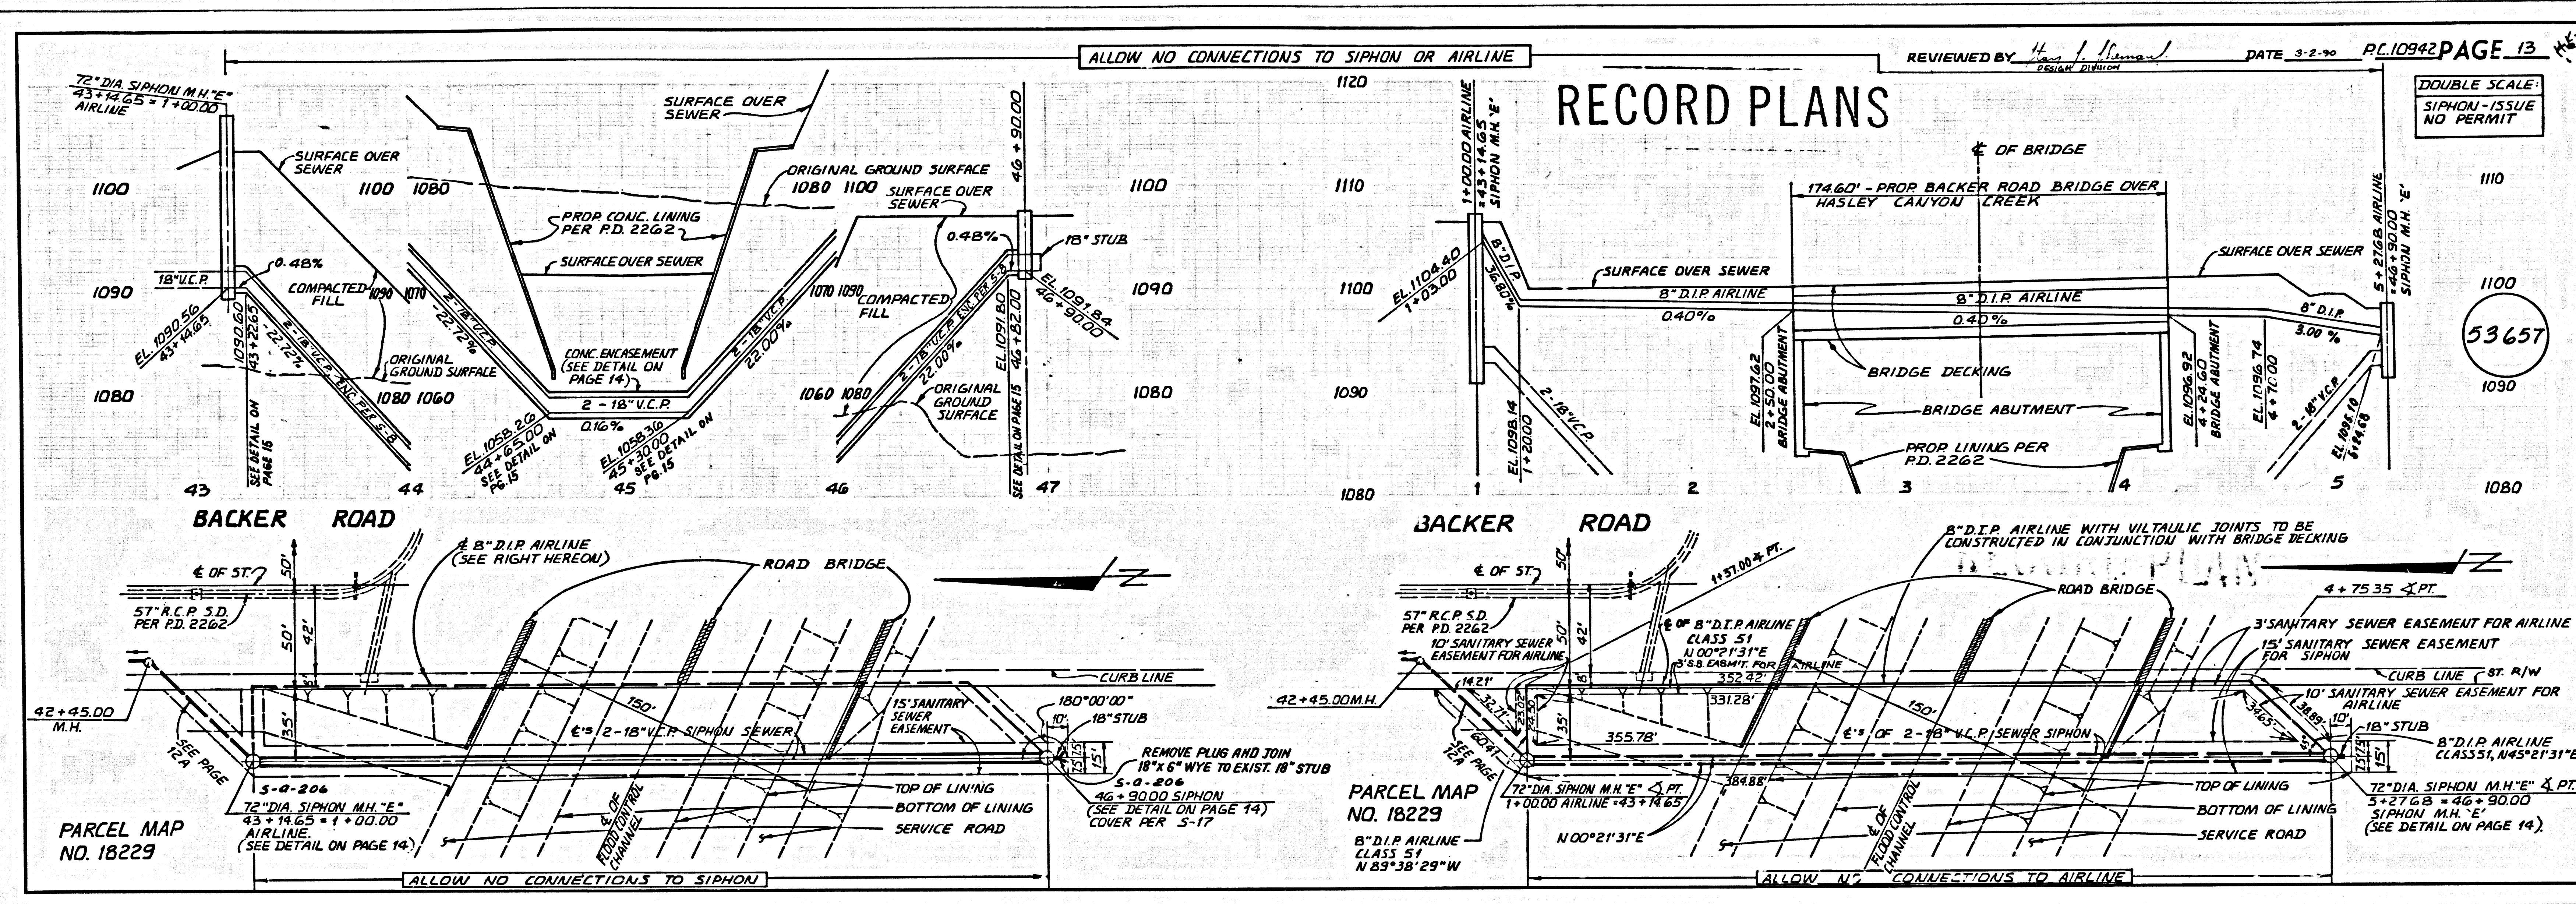

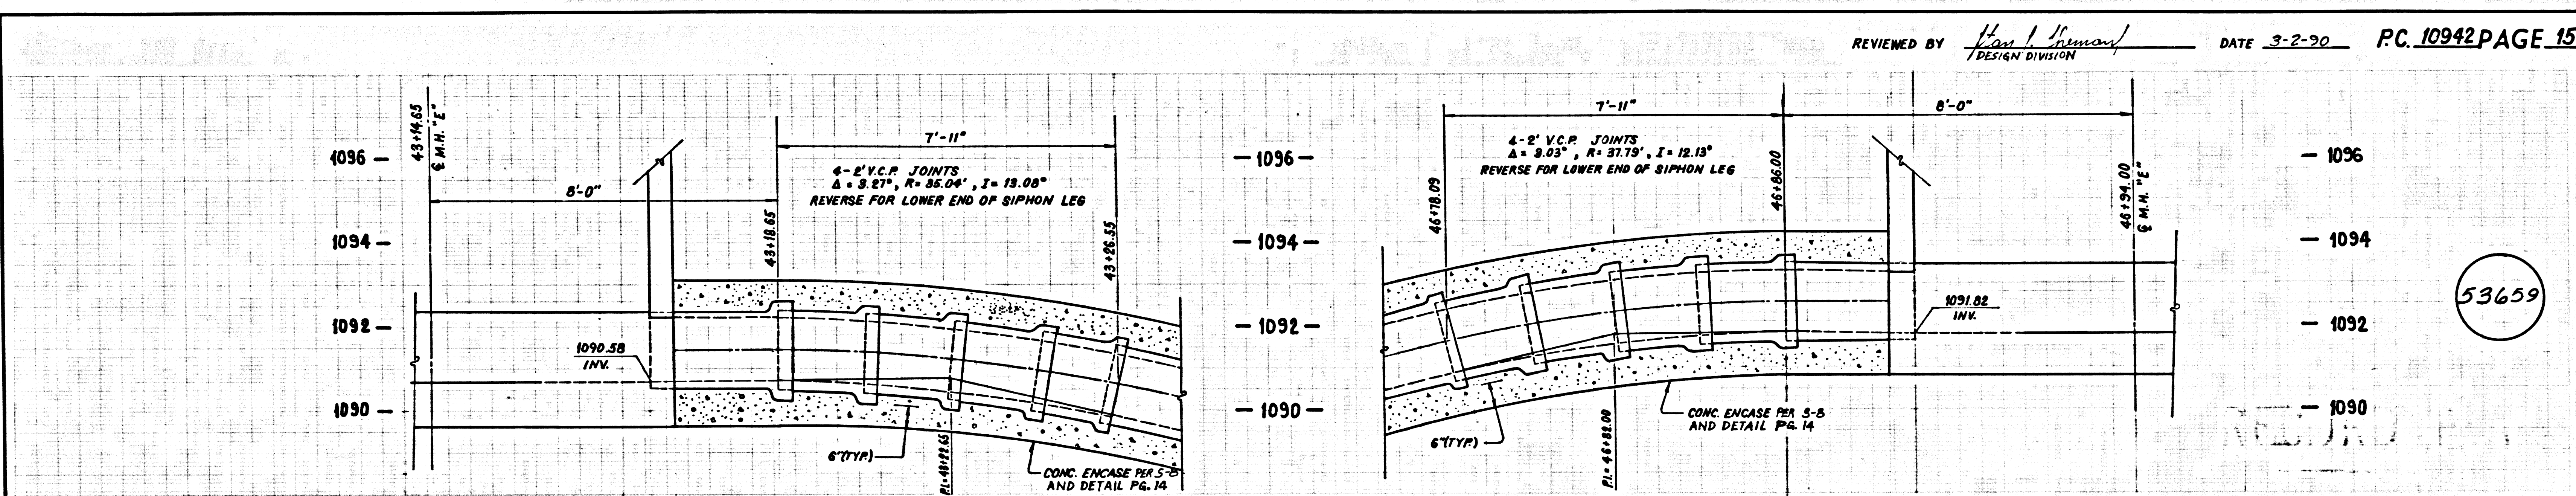


**VERTICAL CURVE JOINTS DETAIL**  
 SEE PLAN & PROFILE ON PAGE 13  
 SCALE: 1" = 8'

**RECORD PLANS**

REVIEWED BY *[Signature]* DATE 3-2-90 P.C. 10942 PAGE 15

53659

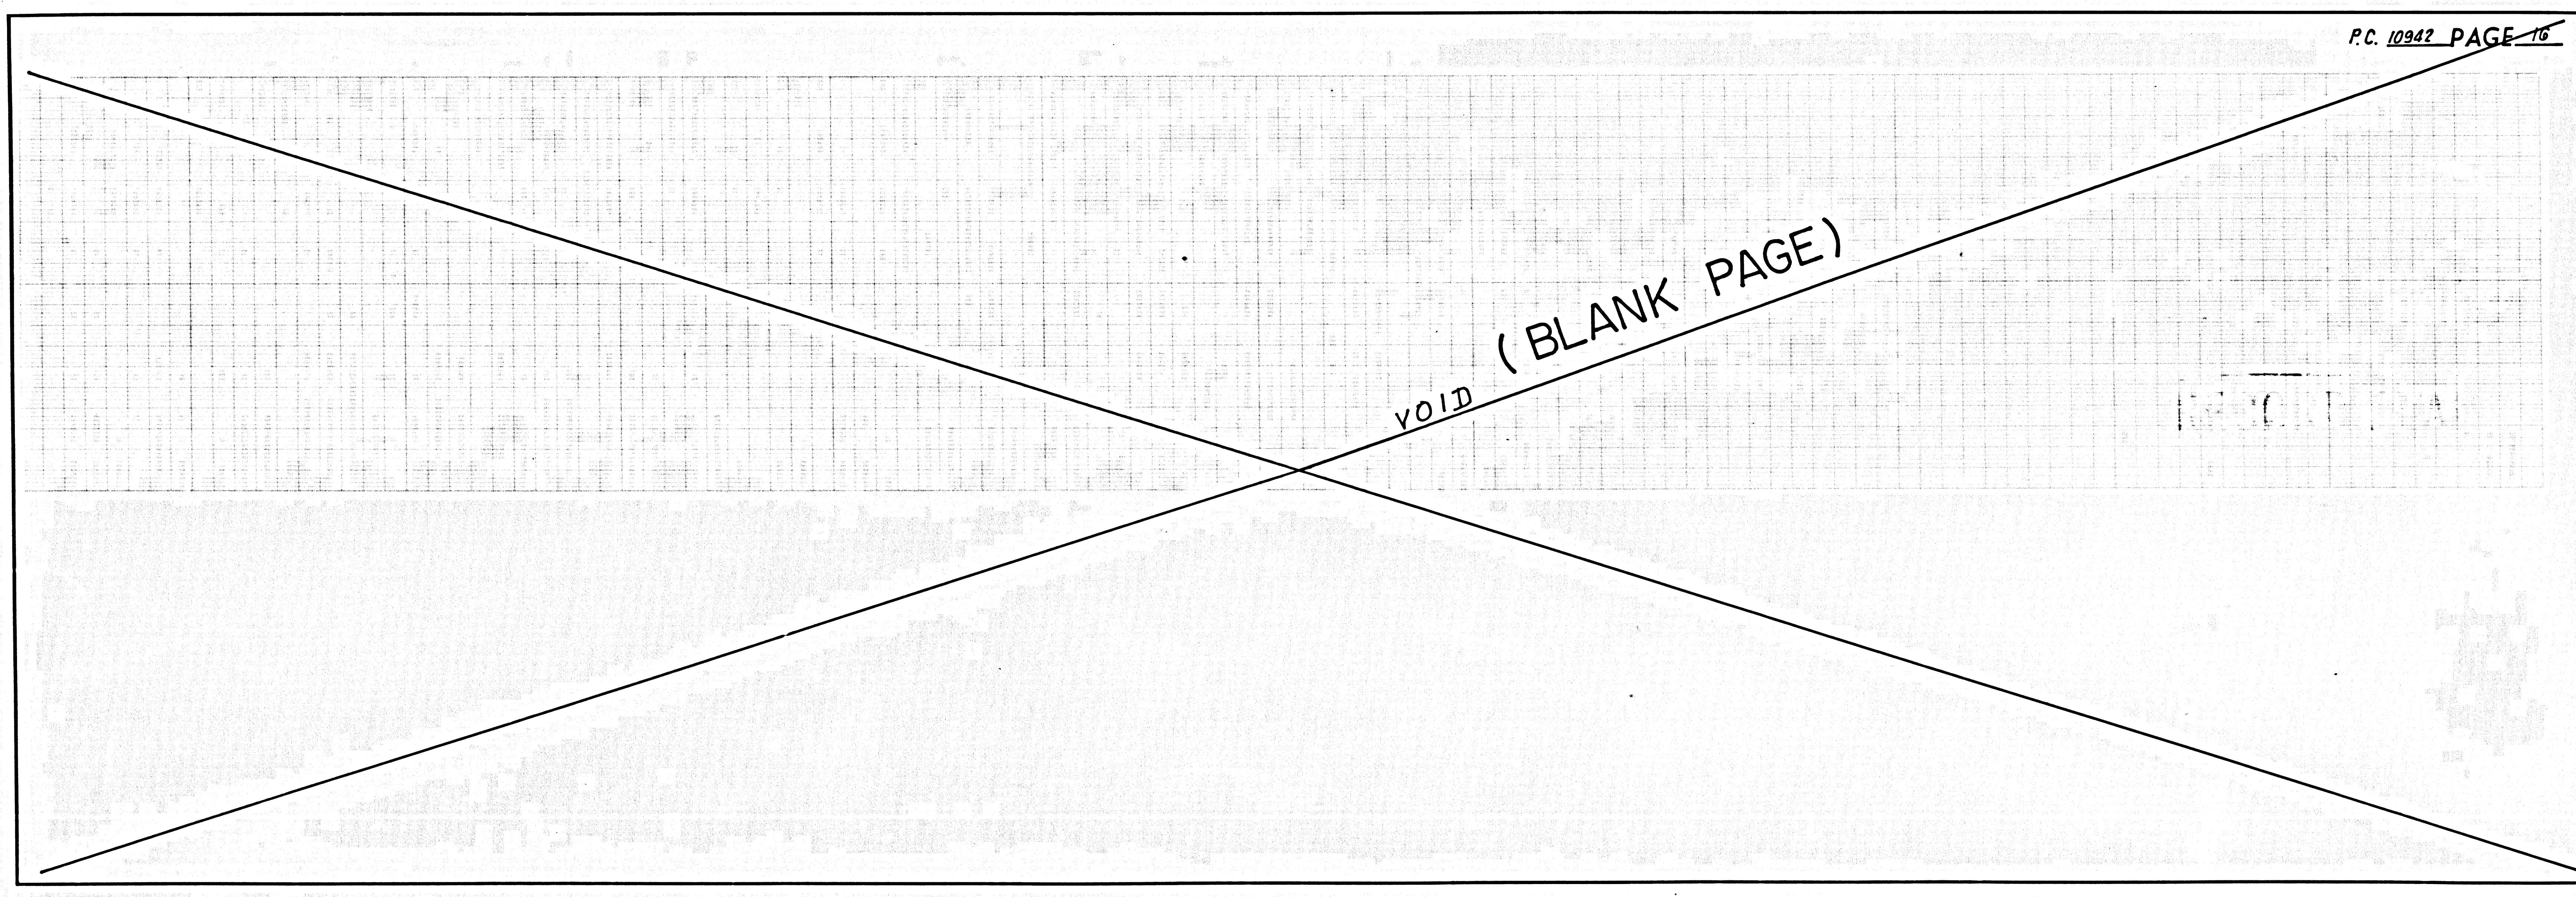

P.C. 10942 PAGE 16



8

S4801 3-9

ESS81 08 M 9





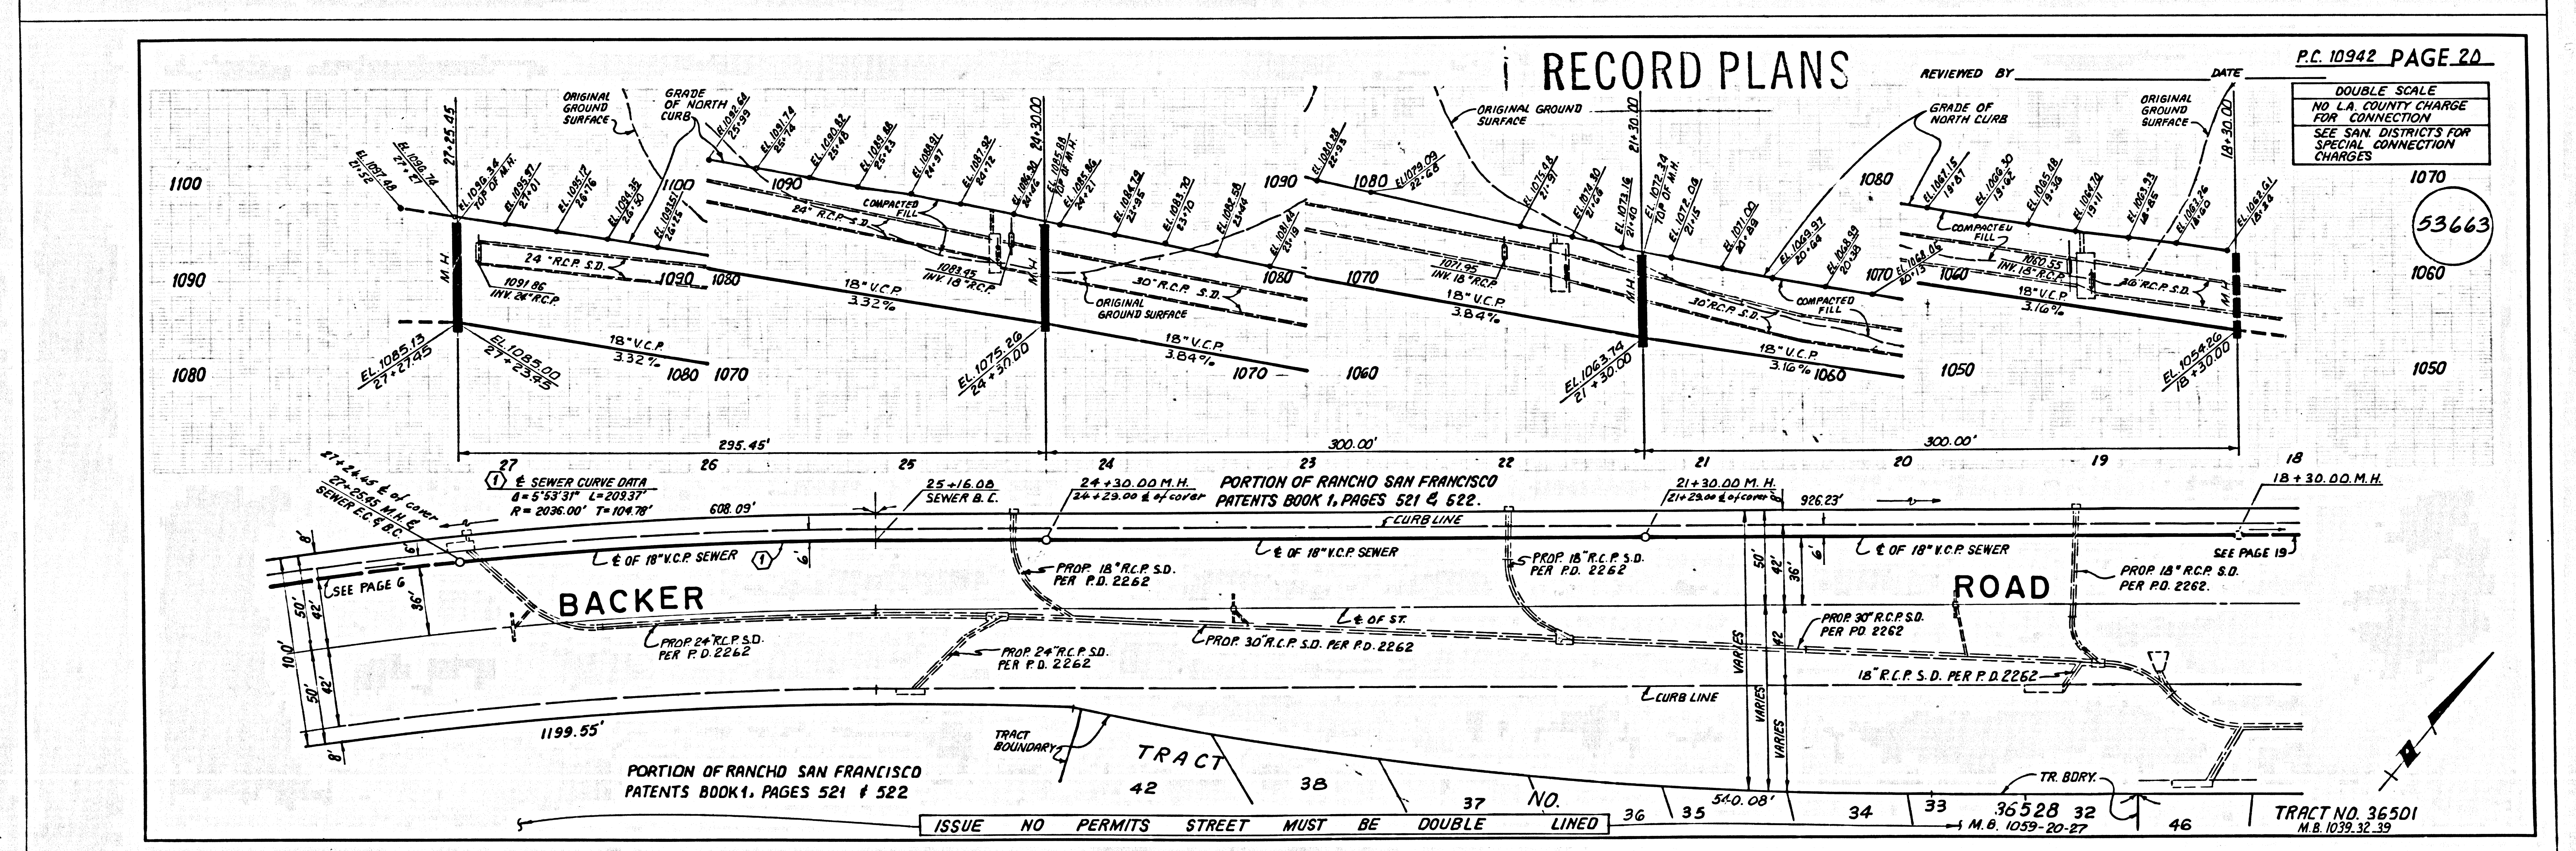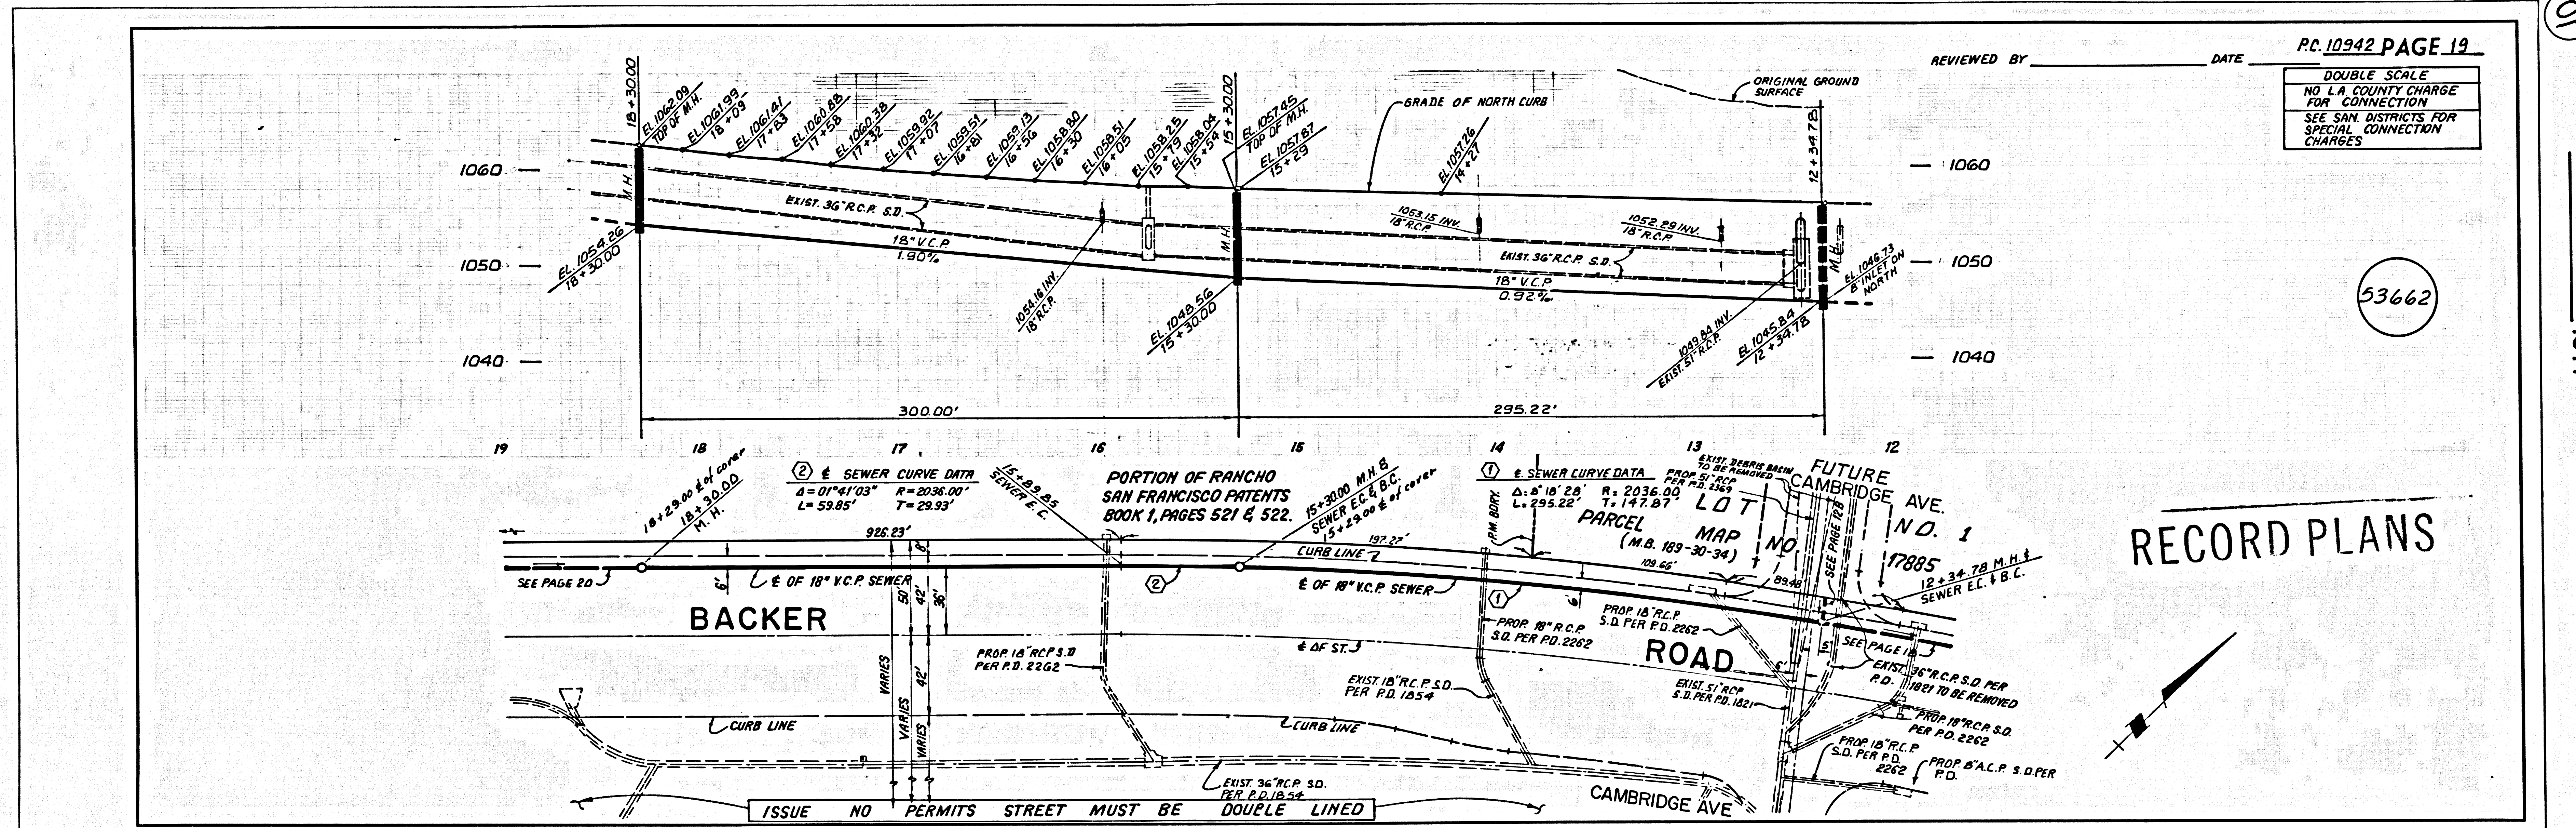

101

SP901 39

ESS81 0M M9