

NO L.A. CO CHARGES FOR CONNECTION  
 SEE CO. SANITATION DISTRICT FOR SPECIAL CONNECTION CHARGES  
 TEL. (562) 699-7411 EX. 2727  
 DOUBLE SCALE

55261

RECORD PLANS


| C/L SEWER CURVE DATA |           |          |         |         |
|----------------------|-----------|----------|---------|---------|
| A                    | R         | L        | T       |         |
| 1                    | 16°11'25" | 595.00'  | 169.13' | 84.63'  |
| 2                    | 22°08'53" | 595.00'  | 230.09' | 116.45' |
| 3                    | 04°54'56" | 1195.00' | 102.52' | 51.29'  |

\*- BACKWATER VALVES MAY BE REQUIRED.

REVIEWED LAND DEVELOPMENT DIVISION  
 BY *Saul G. Kralis* 2/9/2000  
 SUBDIVISION PLAN CHECKING SECTION DATE

SCALE: 1" = 40'

PROFESSIONAL ENGINEER  
 NO. 42830  
 CIVIL  
 STATE OF CALIFORNIA

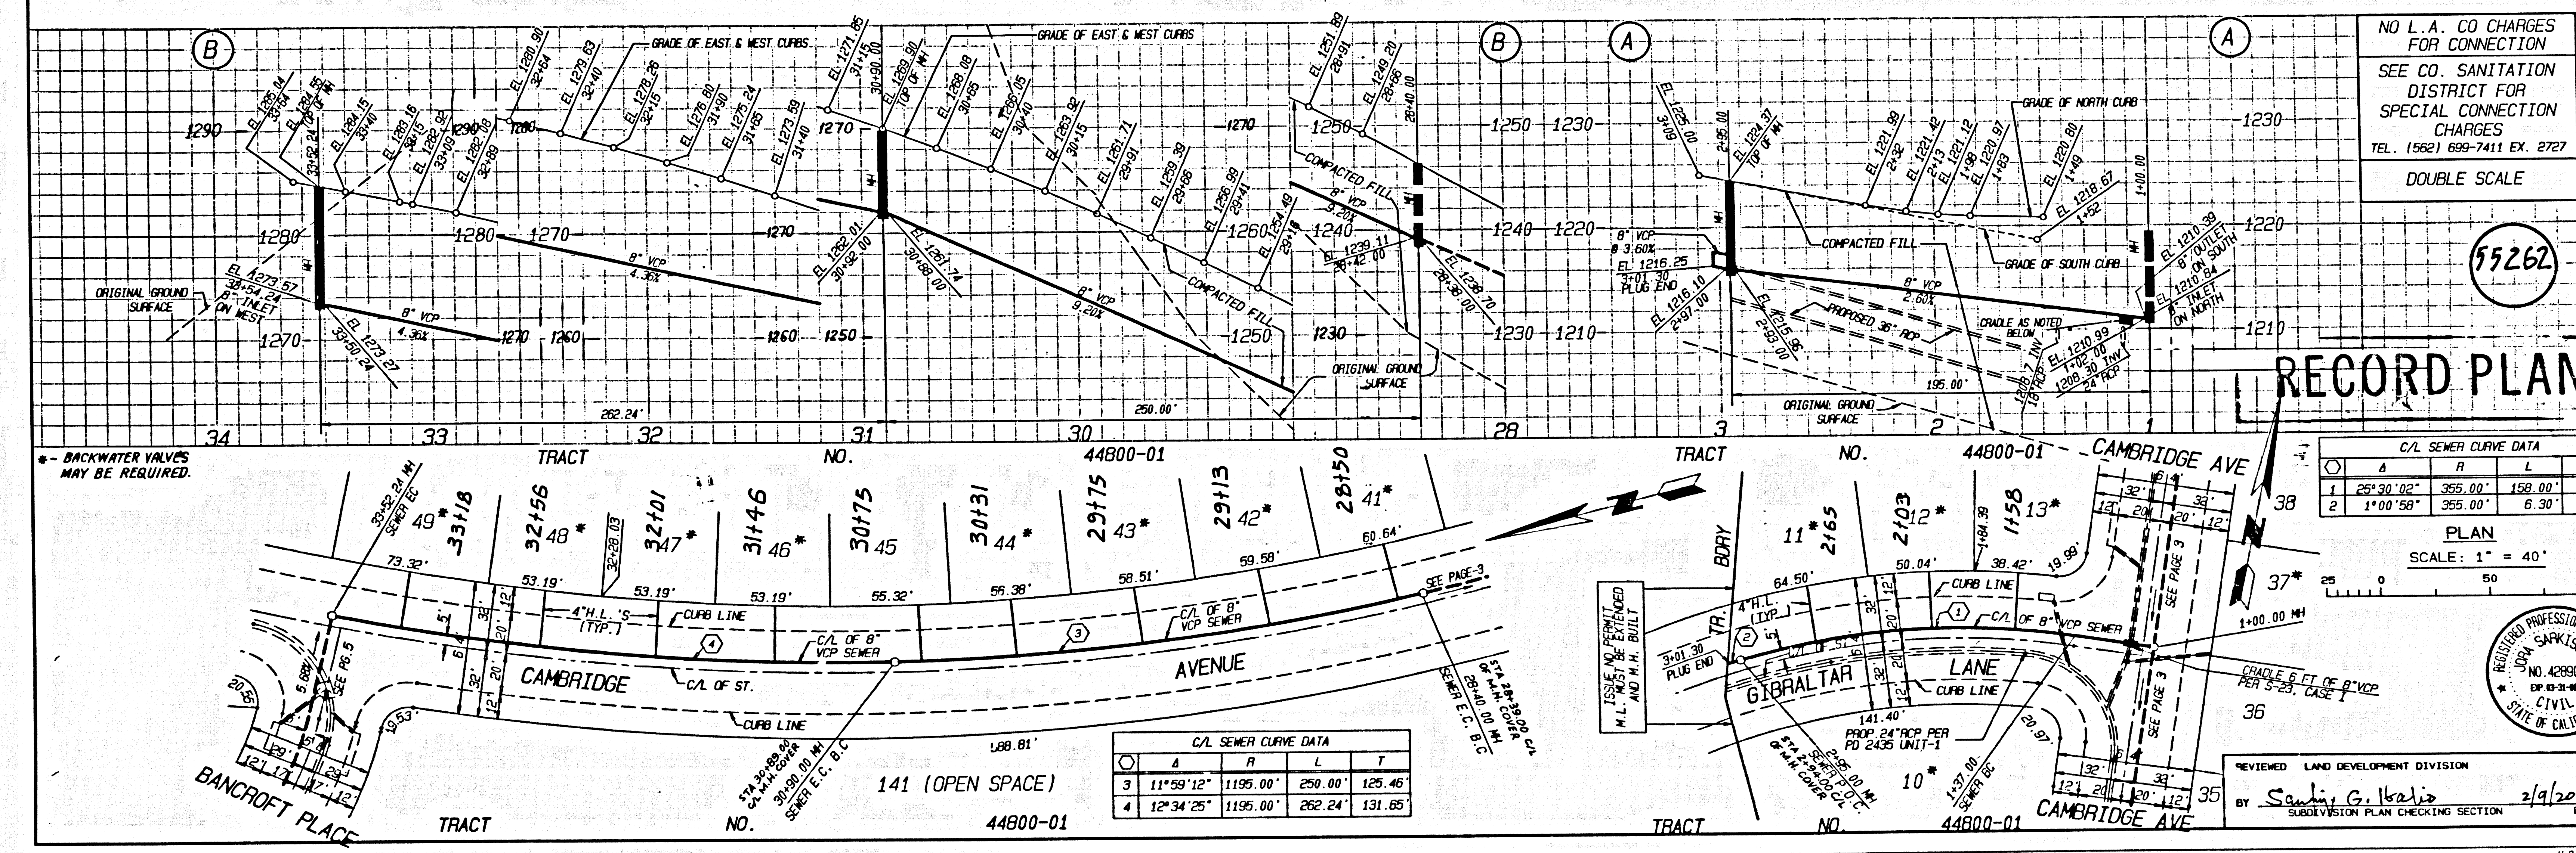

NO L.A. CO CHARGES FOR CONNECTION  
 SEE CO. SANITATION DISTRICT FOR SPECIAL CONNECTION CHARGES  
 TEL. (562) 699-7411 EX. 2727  
 DOUBLE SCALE

55262

RECORD PLANS

| C/L SEWER CURVE DATA |           |         |         |        |
|----------------------|-----------|---------|---------|--------|
| A                    | R         | L       | T       |        |
| 1                    | 25°30'02" | 355.00' | 158.02' | 80.33' |
| 2                    | 1°00'59"  | 355.00' | 6.30'   | 3.15'  |

\*- BACKWATER VALVES MAY BE REQUIRED.


REVIEWED LAND DEVELOPMENT DIVISION  
 BY *Saul G. Kralis* 2/9/2000  
 SUBDIVISION PLAN CHECKING SECTION DATE

SCALE: 1" = 40'

PROFESSIONAL ENGINEER  
 NO. 42830  
 CIVIL  
 STATE OF CALIFORNIA

5



B.W. NO. 44800-01 BC 11450

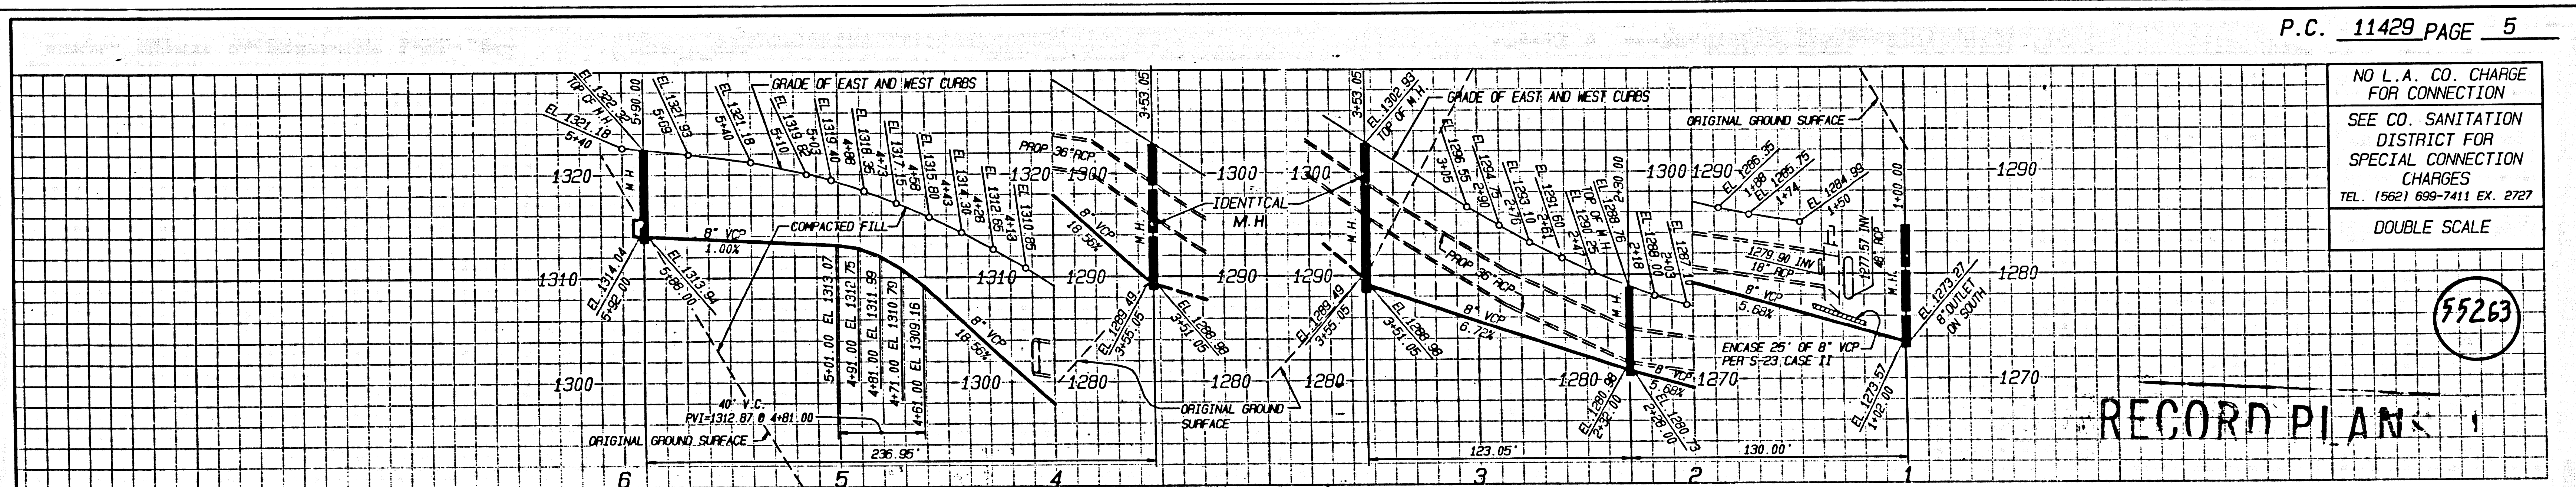

NO L.A. CO. CHARGE FOR CONNECTION  
SEE CO. SANITATION DISTRICT FOR SPECIAL CONNECTION CHARGES  
TEL. (562) 699-7411 EX. 2727  
DOUBLE SCALE

75263



RECORD PLAN

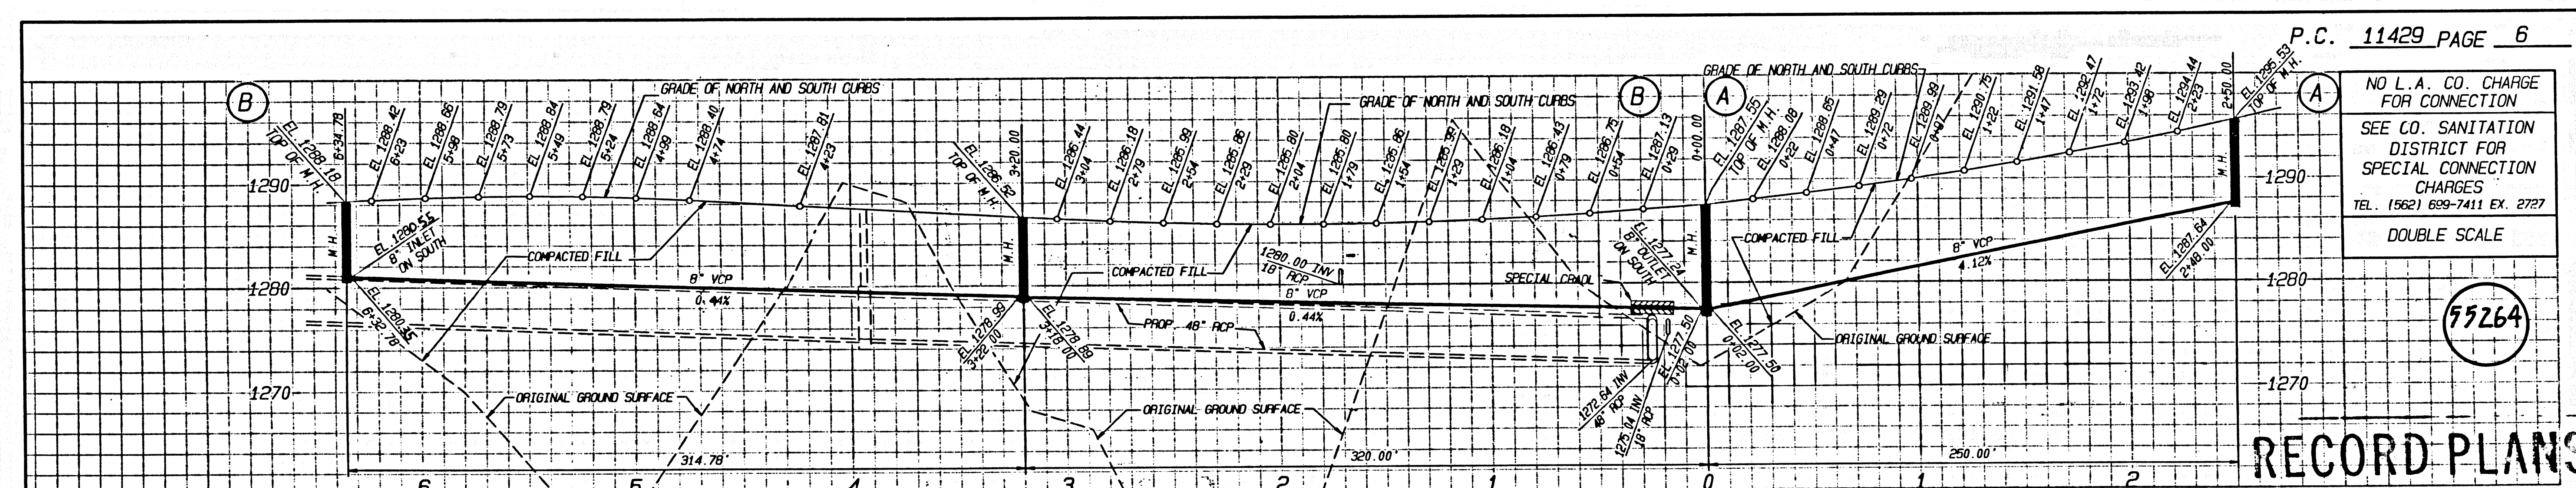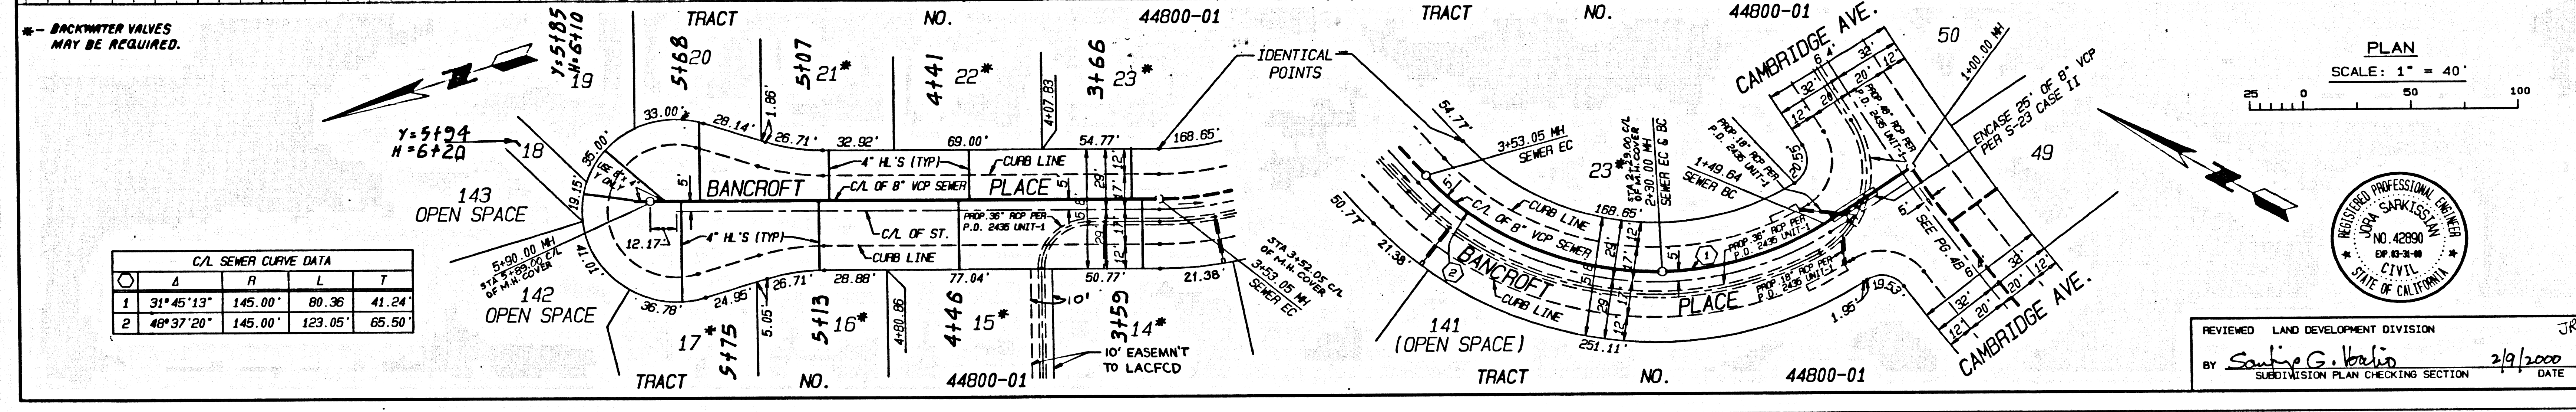

NO L.A. CO. CHARGE FOR CONNECTION  
SEE CO. SANITATION DISTRICT FOR SPECIAL CONNECTION CHARGES  
TEL. (562) 699-7411 EX. 2727  
DOUBLE SCALE

75264

RECORD PLANS

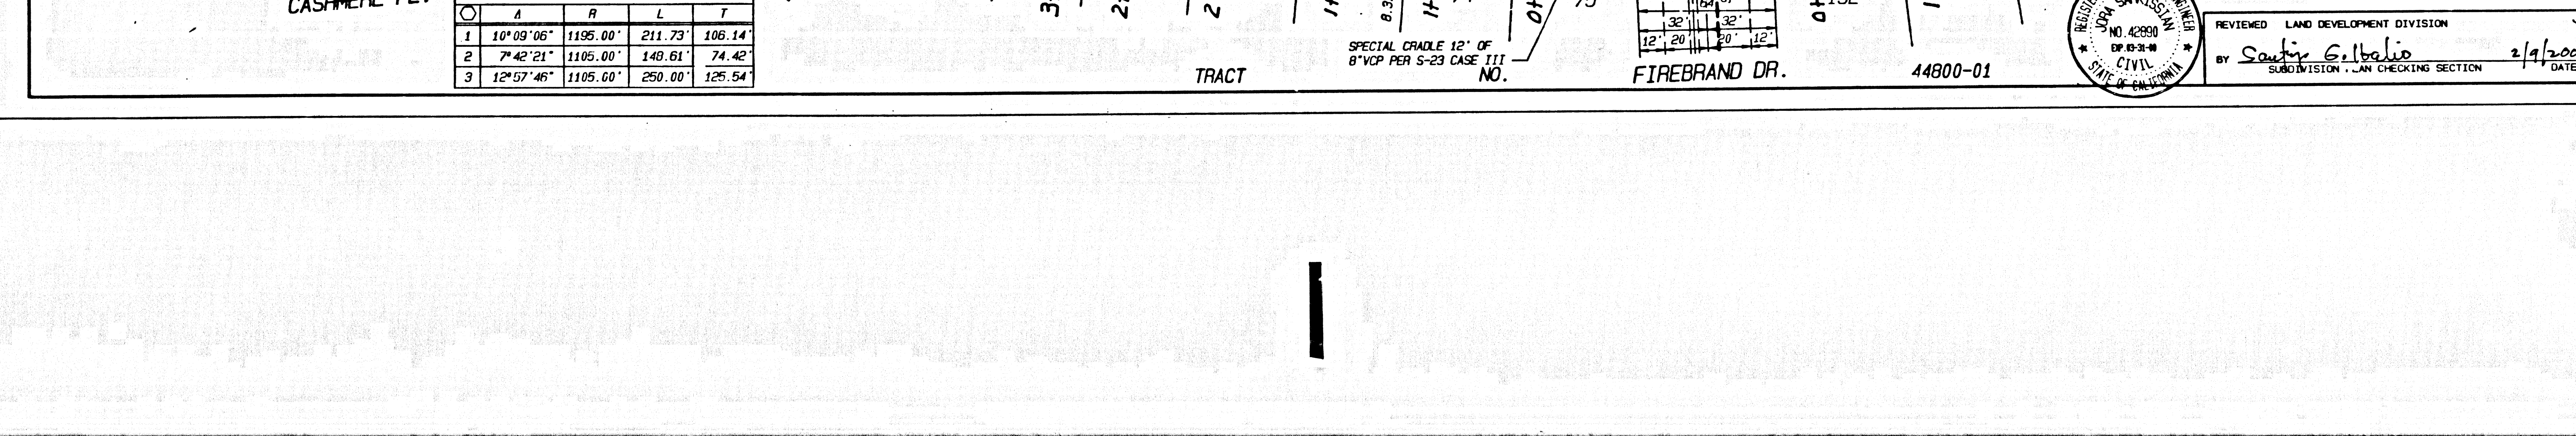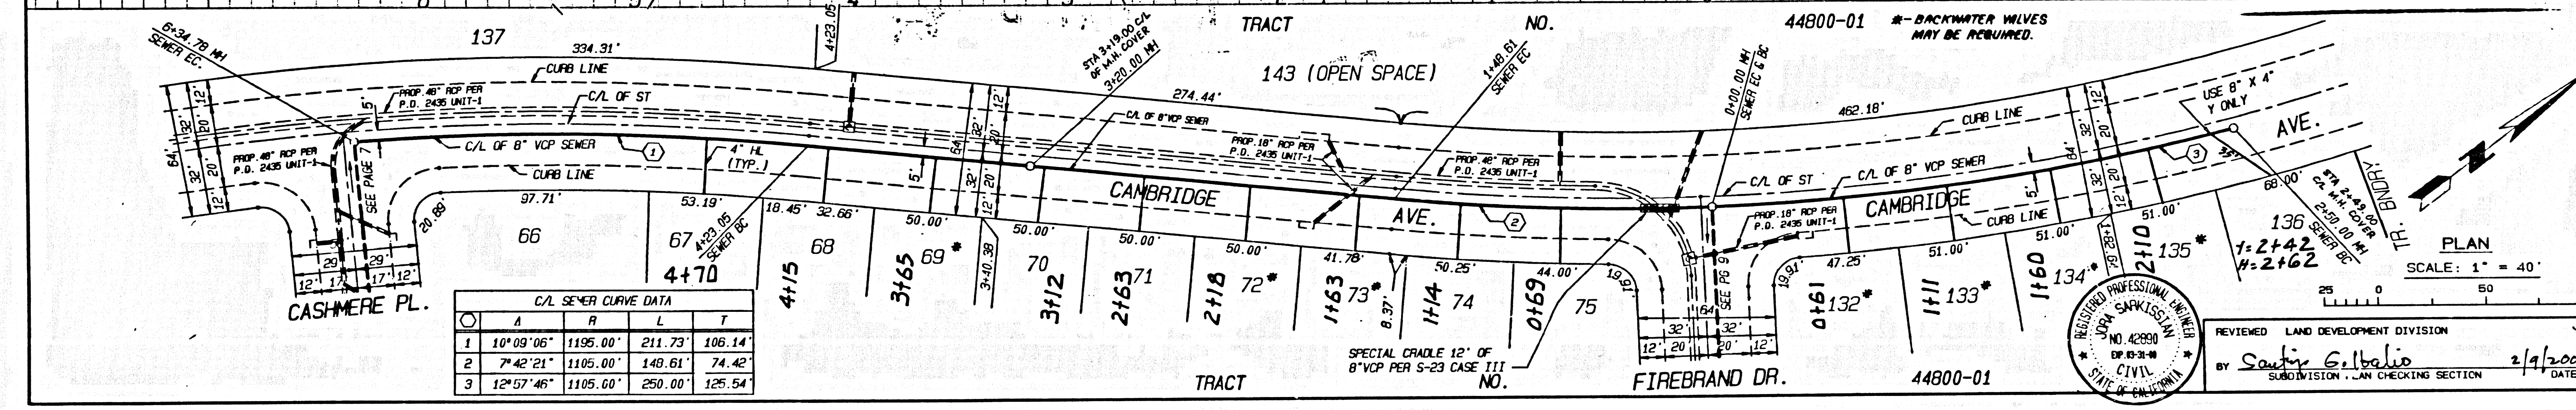

NO L.A. CO. CHARGE FOR CONNECTION  
SEE CO. SANITATION DISTRICT FOR SPECIAL CONNECTION CHARGES  
TEL. (562) 699-7411 EX. 2727  
DOUBLE SCALE

75264

RECORD PLANS

C/L SEWER CURVE DATA

| Δ | R         | L       | T       |        |
|---|-----------|---------|---------|--------|
| 1 | 31°45'13" | 145.00' | 80.36'  | 41.24' |
| 2 | 48°37'20" | 145.00' | 123.05' | 65.50' |

C/L SEWER CURVE DATA


| Δ | R         | L        | T       |         |
|---|-----------|----------|---------|---------|
| 1 | 10°09'06" | 1105.00' | 211.73' | 106.14' |
| 2 | 7°42'21"  | 1105.00' | 140.61' | 74.42'  |
| 3 | 12°57'46" | 1105.00' | 250.00' | 125.54' |

REVIEWED LAND DEVELOPMENT DIVISION  
BY *Santia G. Galbino* 2/9/2000  
SUBMITTAL PLAN CHECKING SECTION DATE

REGISTERED PROFESSIONAL ENGINEER  
NO. 42990  
CIVIL  
STATE OF CALIFORNIA


OSN 11 09 10 0084 ON M.P. 44800-01 BC 11453



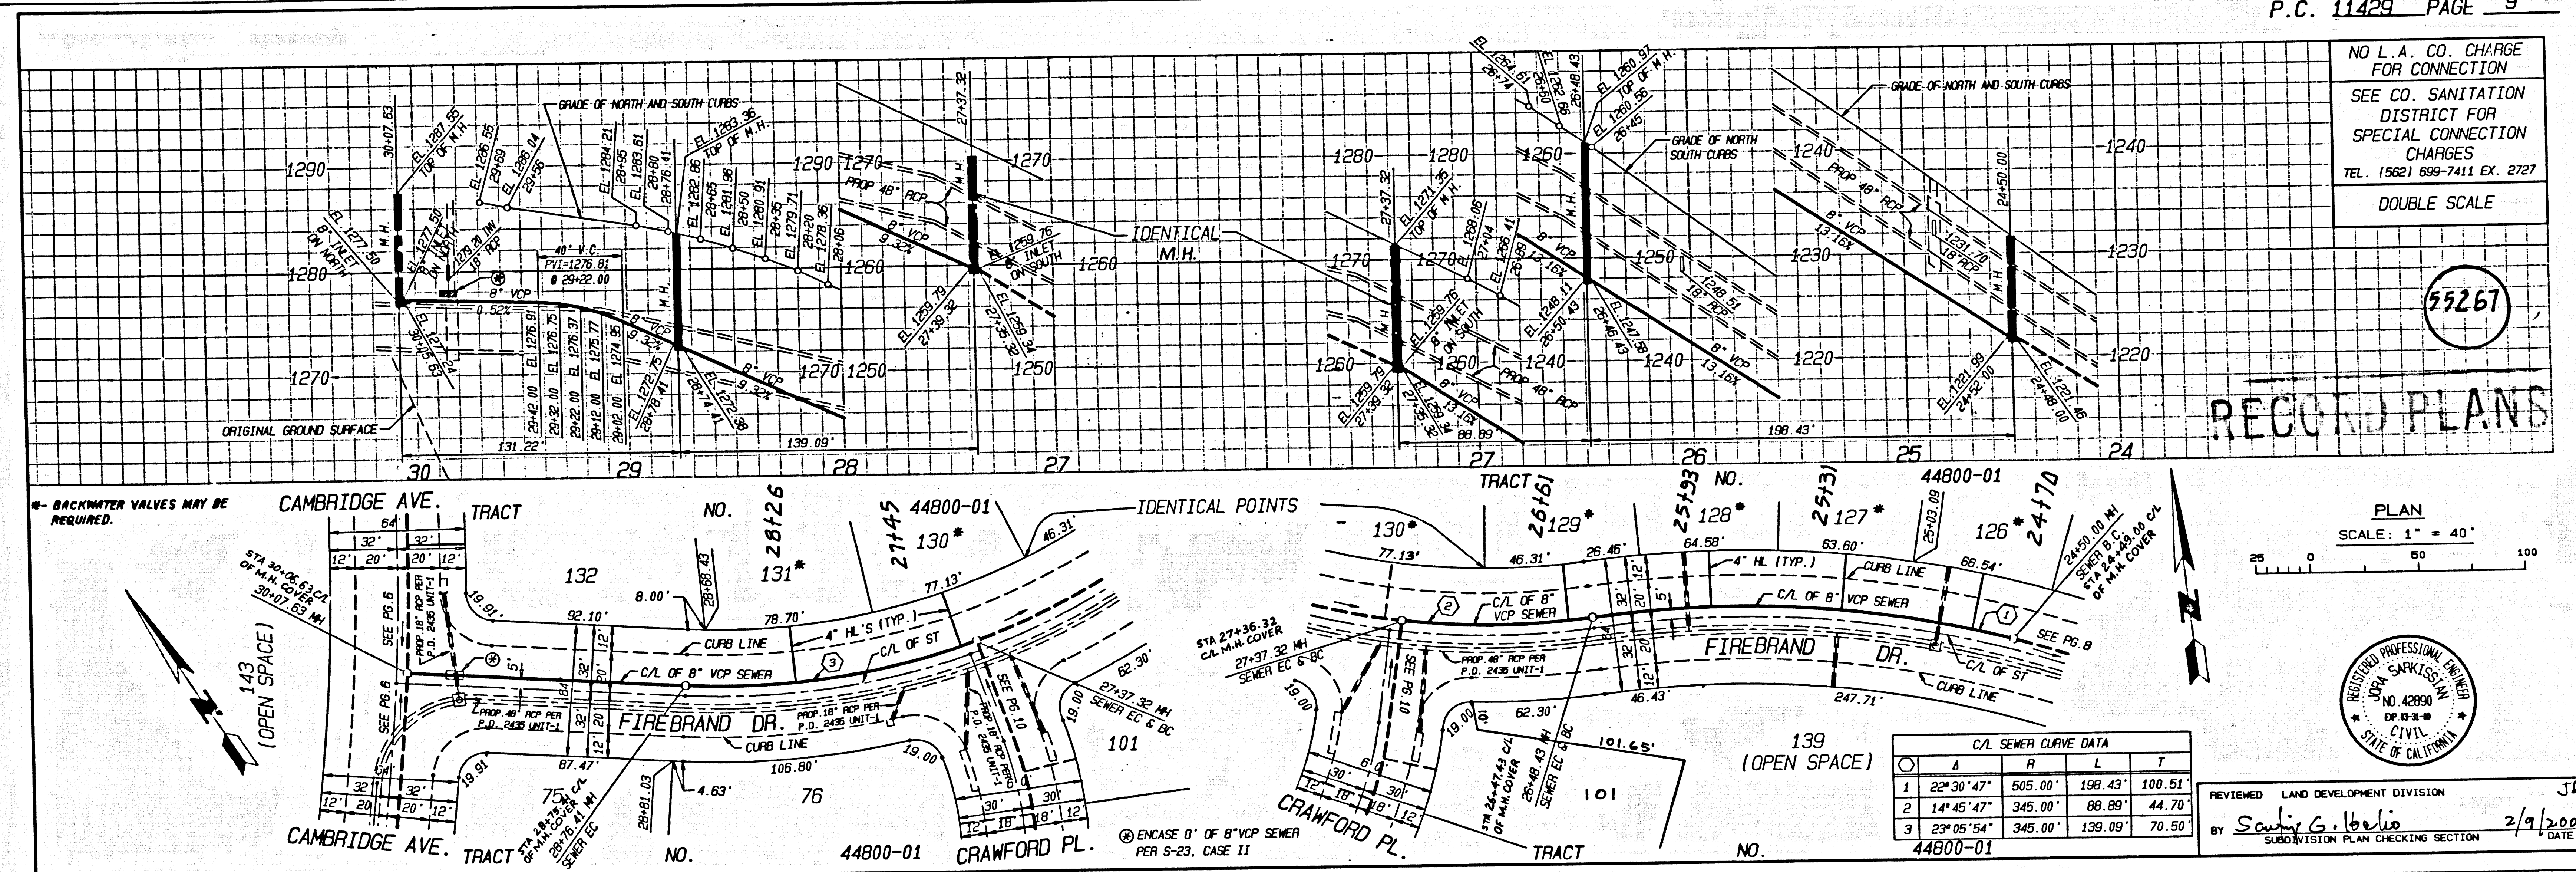

2

B.W. NO. 44800-01 BC 11458

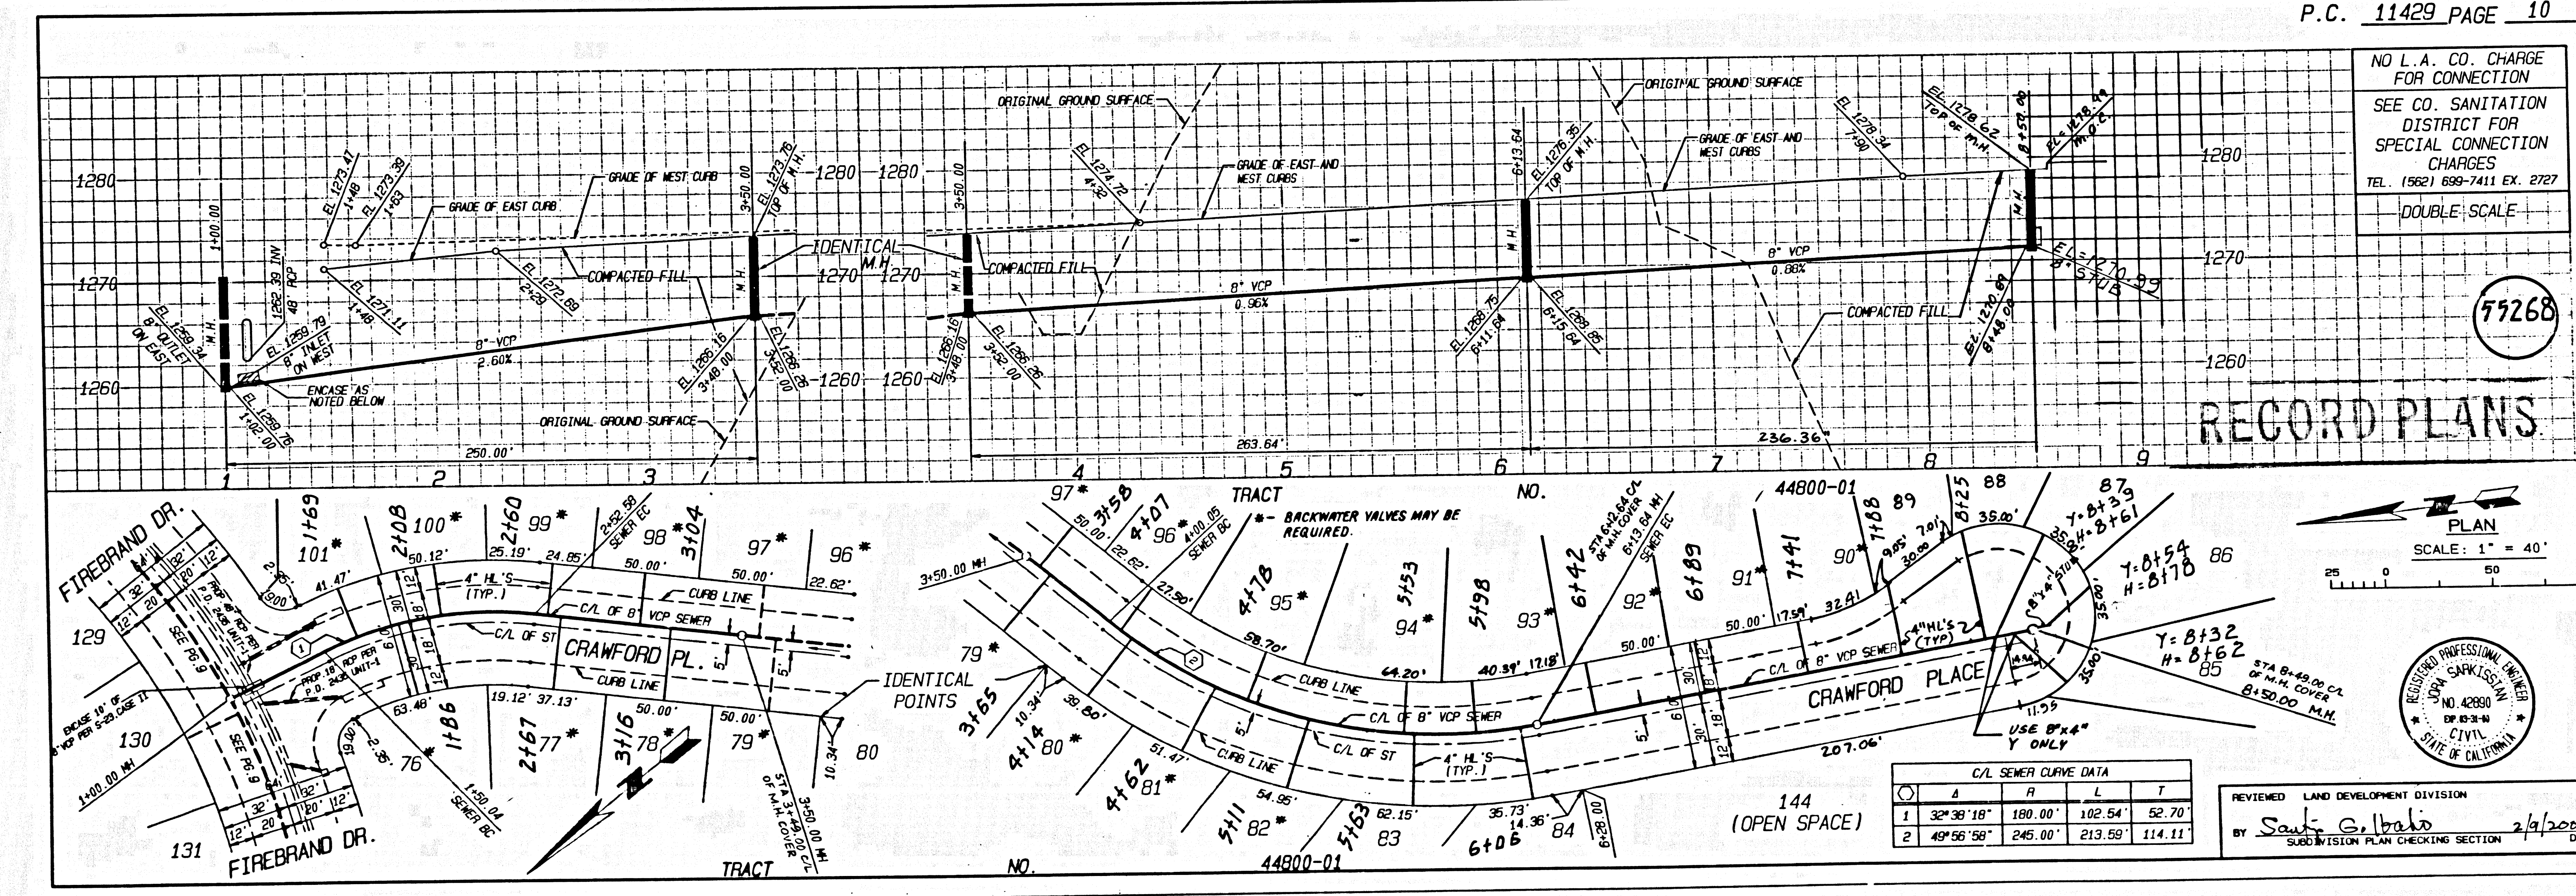



2

B.W. NO. 44800-01 BC 11458

NO L.A. CO. CHARGE FOR CONNECTION  
 SEE CO. SANITATION DISTRICT FOR SPECIAL CONNECTION CHARGES  
 TEL. (562) 699-7411 EX. 2727  
 DOUBLE SCALE

55269

RECORD PLANS

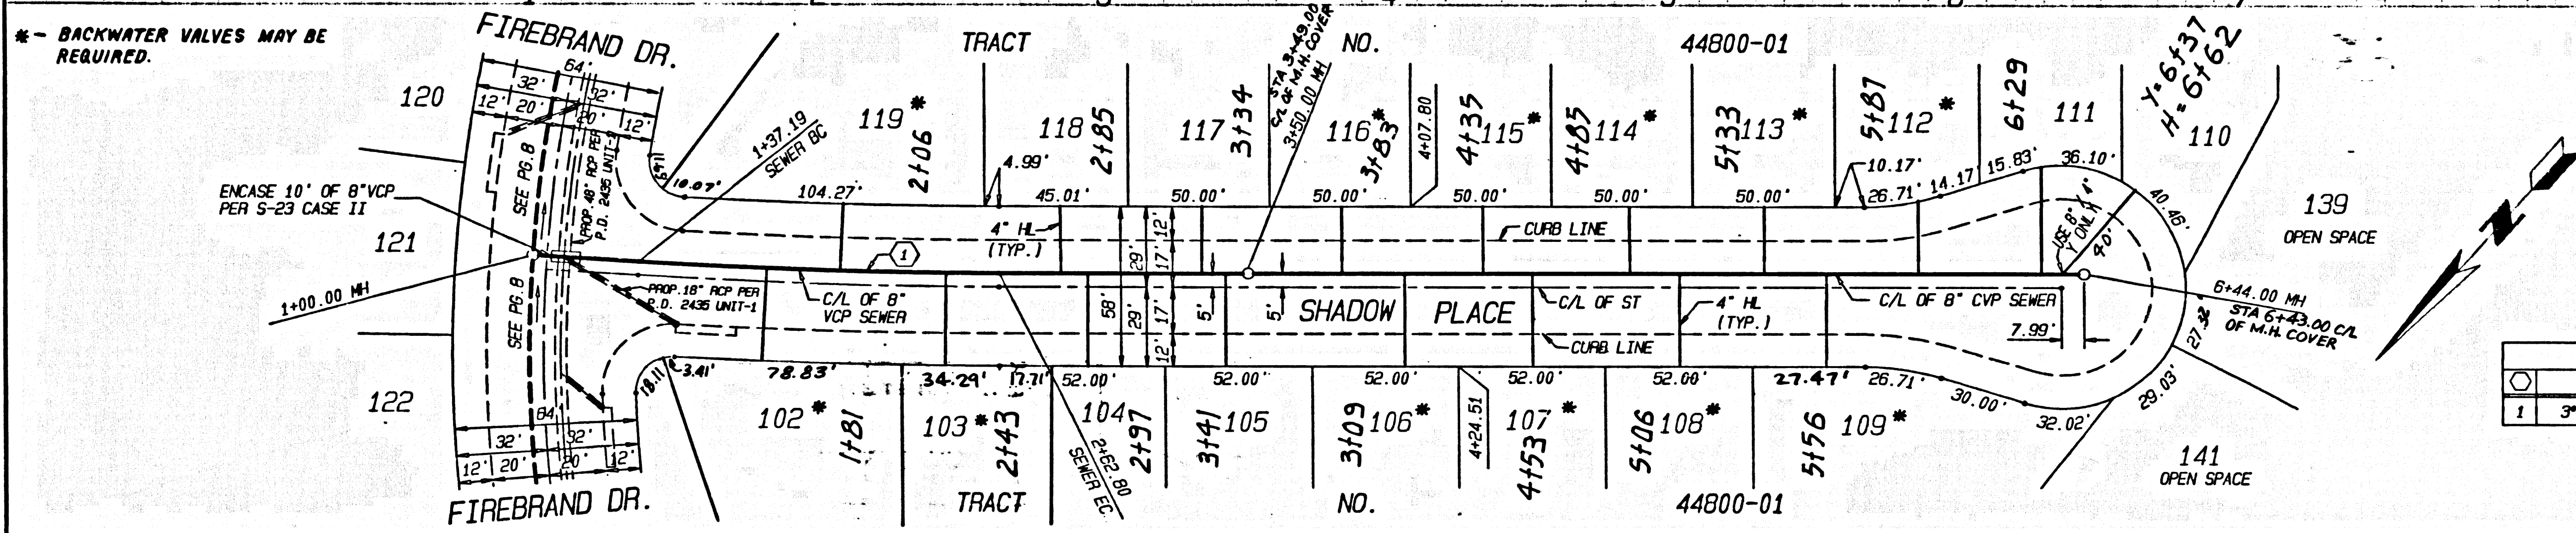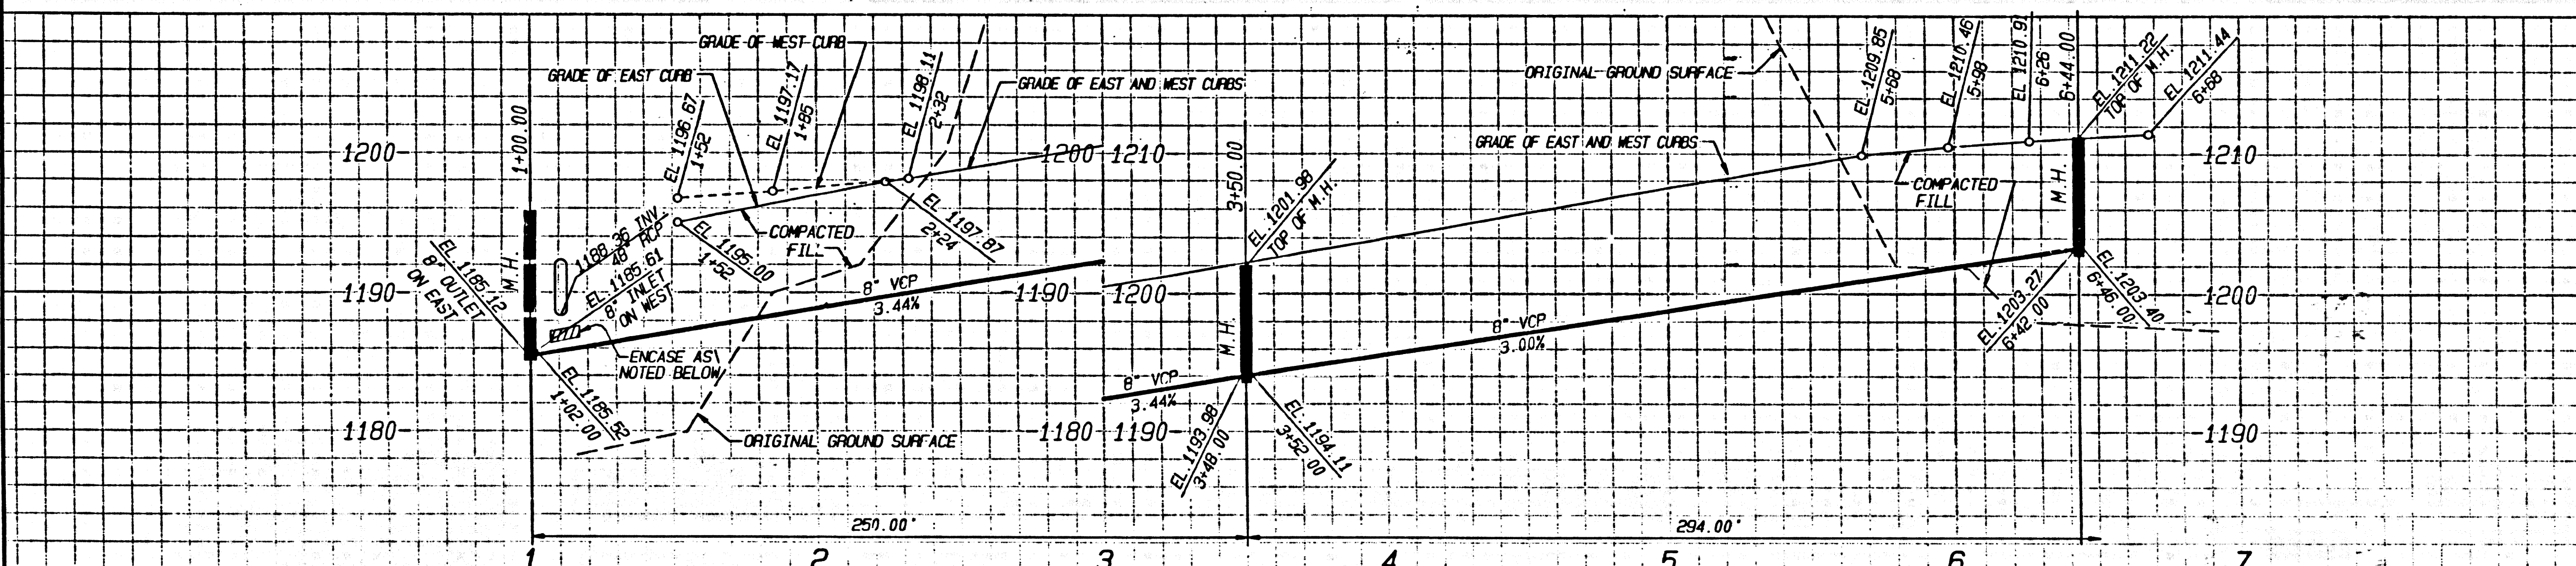


PLAN  
 SCALE: 1" = 40'



| C/L SEWER CURVE DATA |            |          |         |        |
|----------------------|------------|----------|---------|--------|
| A                    | R          | L        | T       |        |
| 1                    | 3° 30' 27" | 1995.00' | 125.61' | 62.83' |

REVIEWED LAND DEVELOPMENT DIVISION  
 BY Scott G. Ibarra 2/9/2002  
 SUBDIVISION PLAN CHECKING SECTION DATE

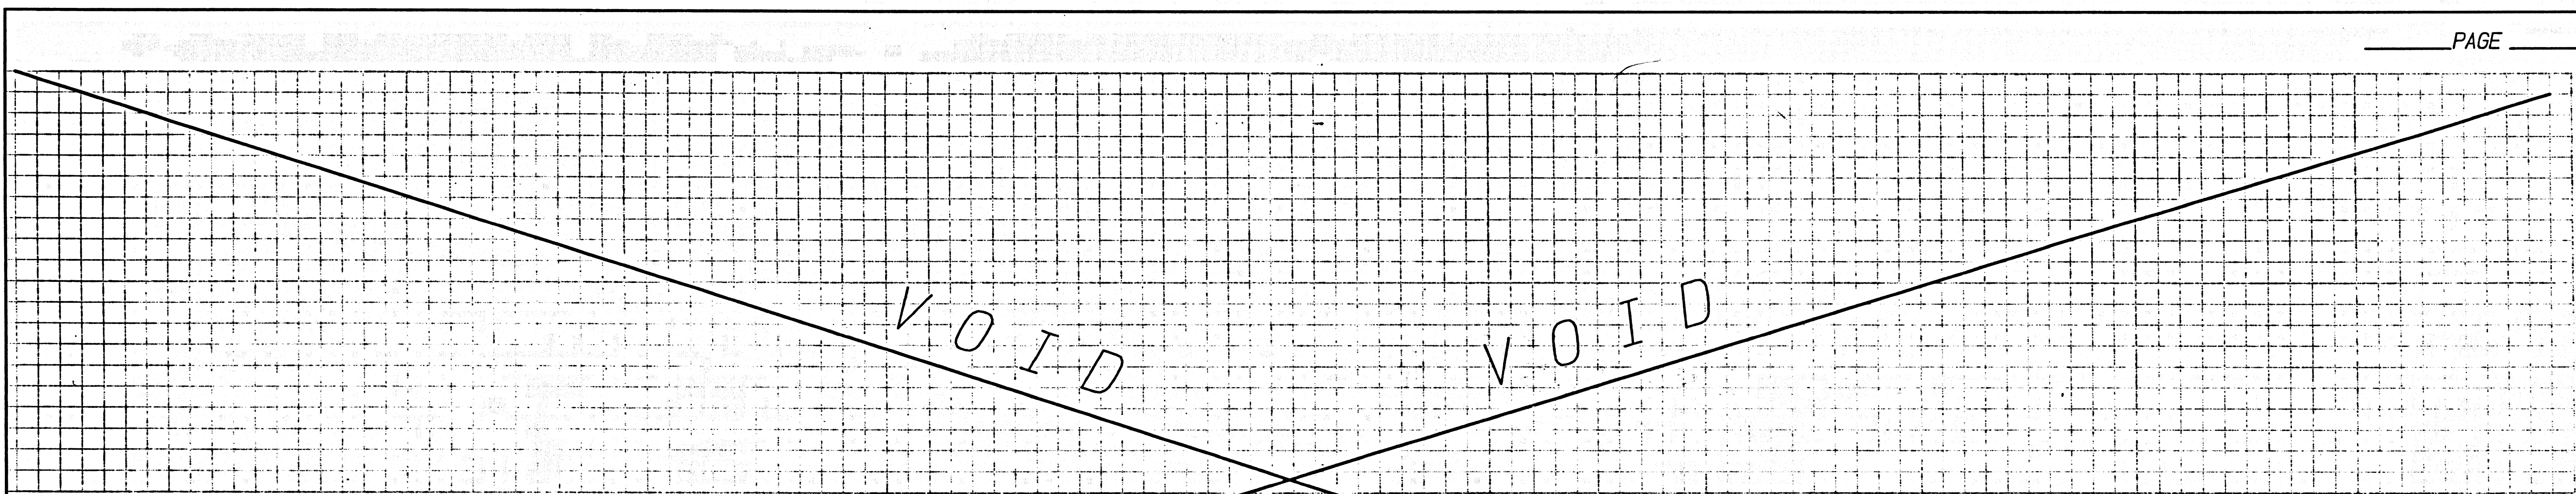

PAGE

REVIEWED LAND DEVELOPMENT DIVISION  
 BY  
 SUBDIVISION PLAN CHECKING SECTION DATE

B.W. NO. 44800-01 BC 11450