

P.C. 11491 PAGE 3


NO L.A. CO. CHARGE FOR CONNECTION

SEE CO. SANITATION DISTRICT FOR SPECIAL CONNECTION CHARGES

TEL. (842) 696-7411 EX. 2727

DOUBLE VERTICAL SCALE

77362

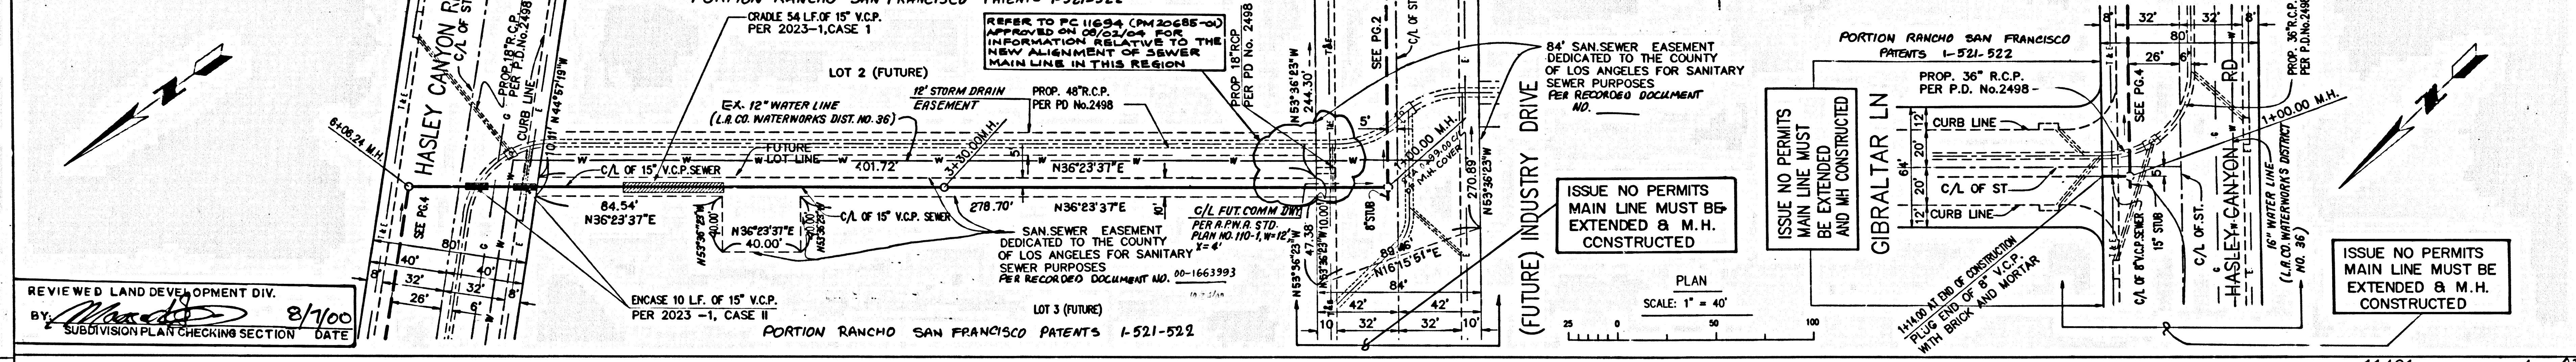

P.C. 11491 PAGE 4


NO L.A. CO. CHARGE FOR CONNECTION

SEE CO. SANITATION DISTRICT FOR SPECIAL CONNECTION CHARGES

TEL. (842) 696-7411 EX. 2727

DOUBLE VERTICAL SCALE

77363

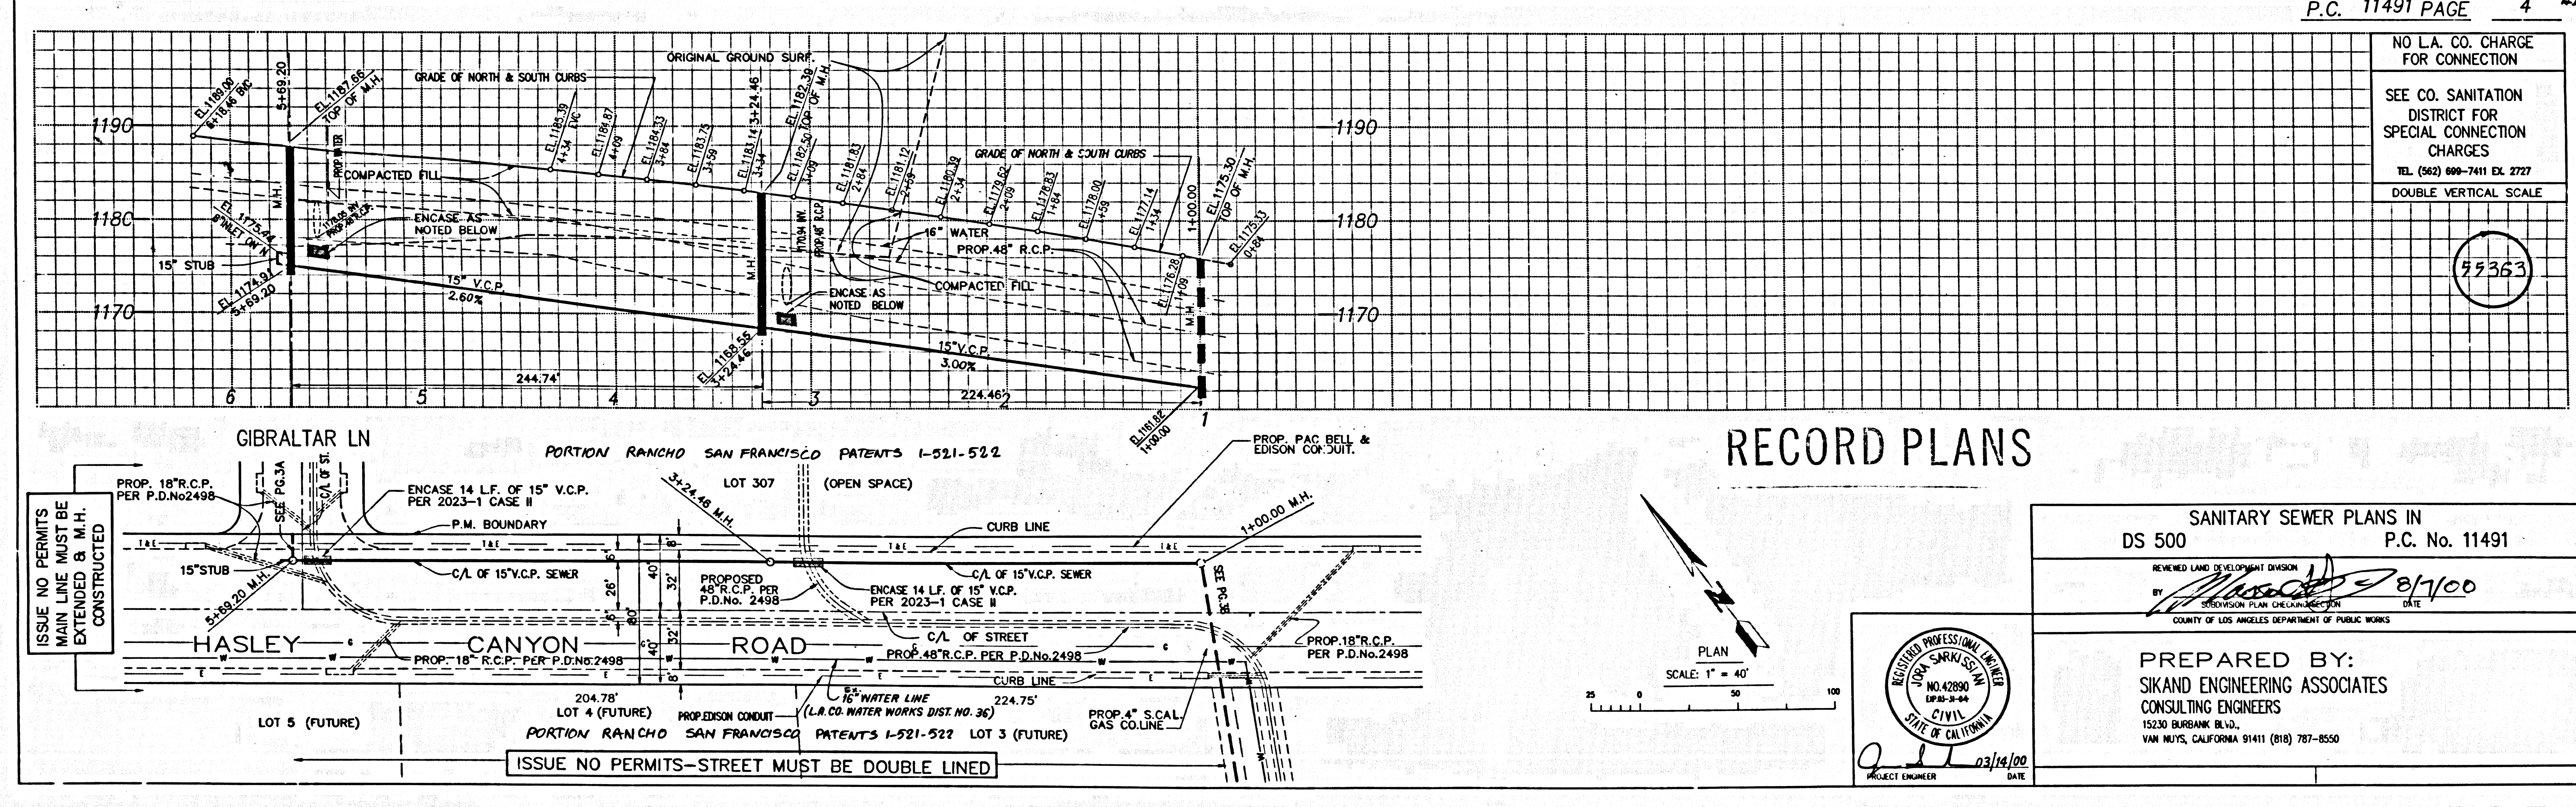

P.C. 11491 PAGE 5

NO L.A. CO. CHARGE FOR CONNECTION

SEE CO. SANITATION DISTRICT FOR SPECIAL CONNECTION CHARGES

TEL. (842) 696-7411 EX. 2727

DOUBLE VERTICAL SCALE

77364

REVIEWED LAND DEVELOPMENT DIV. BY: *[Signature]* 8/100 DATE: SUBDIVISION PLAN CHECKING SECTION

ISSUE NO PERMITS MAIN LINE MUST BE EXTENDED 8 M.H. CONSTRUCTED

ISSUE NO PERMITS MAIN LINE MUST BE EXTENDED 8 M.H. CONSTRUCTED

ISSUE NO PERMITS MAIN LINE MUST BE EXTENDED 8 M.H. CONSTRUCTED

ISSUE NO PERMITS—STREET MUST BE DOUBLE LINED

SCALE: 1" = 40'

PLAN

REGISTERED PROFESSIONAL ENGINEER NO. 42890 EXPIRES 06/30/04 CIVIL STATE OF CALIFORNIA

PROJECT ENGINEER 03/14/00 DATE

SANITARY SEWER PLANS IN DS 500 P.C. No. 11491

REVIEWED LAND DEVELOPMENT DIVISION BY: *[Signature]* 8/100 DATE: SUBDIVISION PLAN CHECKING SECTION COUNTY OF LOS ANGELES DEPARTMENT OF PUBLIC WORKS

PREPARED BY: SIKAND ENGINEERING ASSOCIATES CONSULTING ENGINEERS 15200 BARBANK BLVD. VAN NUYS, CALIFORNIA 91411 (818) 787-8550

1