


P.C.11548 PAGE 3
 NO L.A. CO. CHARGES FOR CONNECTION
 SEE CO. SANITATION DISTRICT FOR SPECIAL CONNECTION CHARGES
 TEL. (562) 699-7411 EX. 2727
 DOUBLE SCALE

RECORD PLANS

CURVE DATA:


CURVE	DELTA	RADIUS	LENGTH	TANGENT
C1	01°56'01"	2136.00'	70.09'	36.05'
C2	08°51'06"	2136.00'	330.00'	165.33'
C3	09°16'01"	2136.00'	345.47'	173.11'

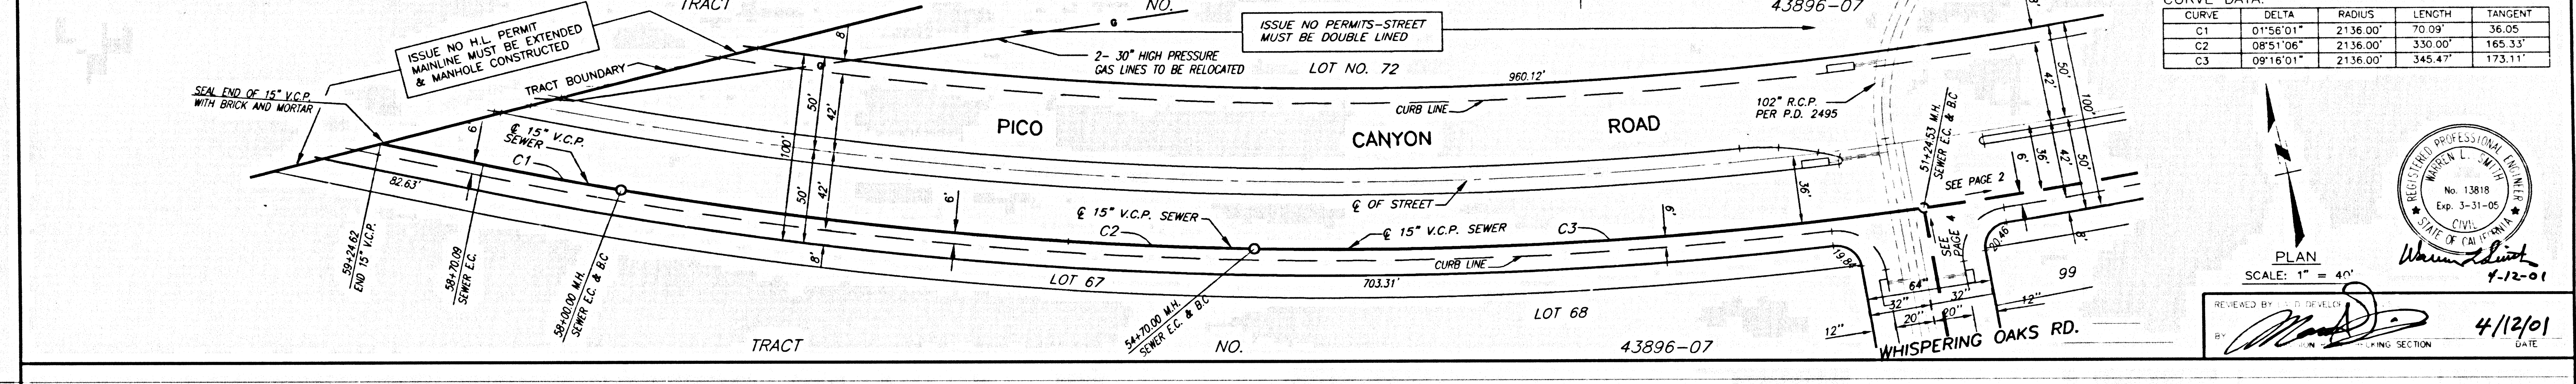

PLAN SCALE: 1" = 40'

REVEALED BY: [Signature] DATE: 4/12/01

PROFESSIONAL ENGINEER
 WALTER L. JUMPER
 No. 13818
 Exp. 3-31-05
 CIVIL
 STATE OF CALIFORNIA
 4-12-01

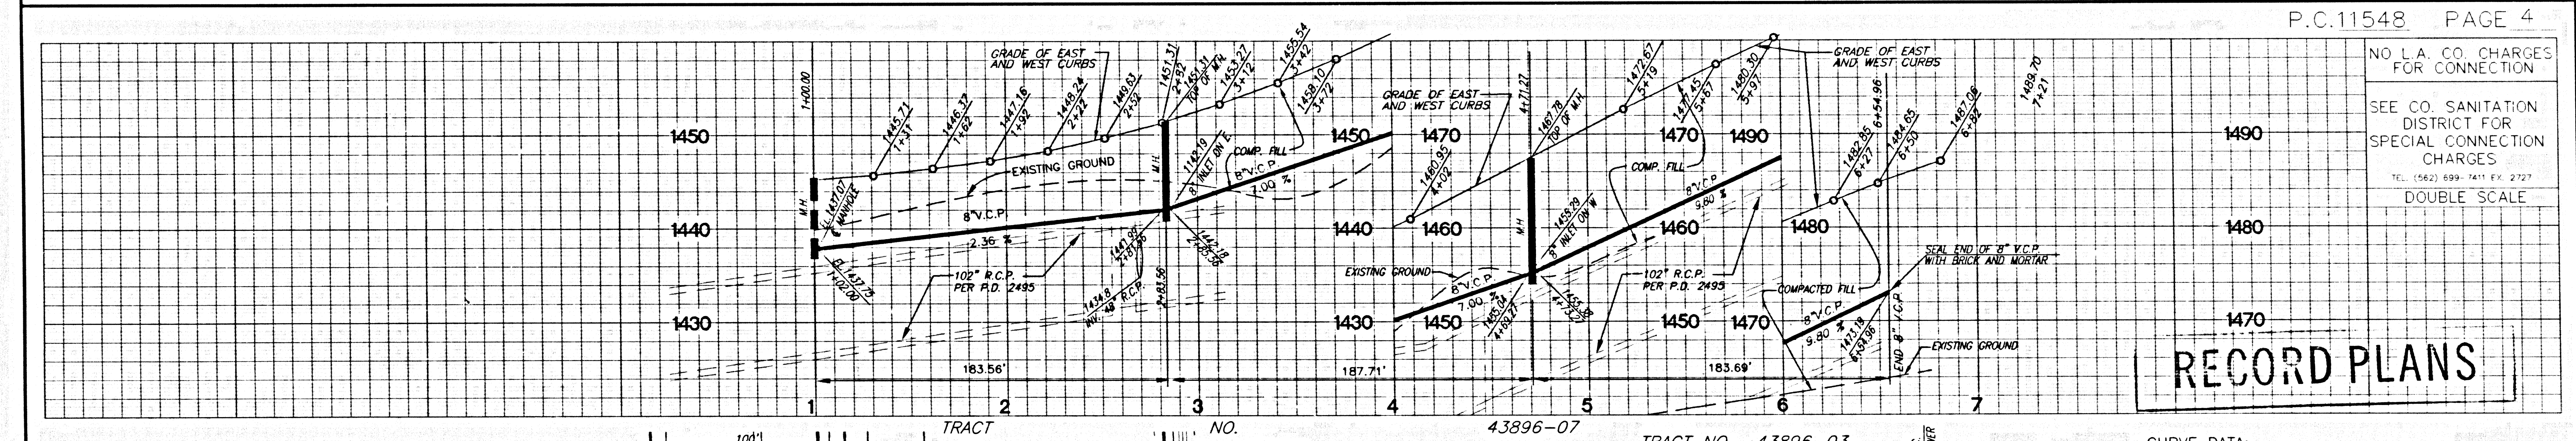


P.C.11548 PAGE 4
 NO L.A. CO. CHARGES FOR CONNECTION
 SEE CO. SANITATION DISTRICT FOR SPECIAL CONNECTION CHARGES
 TEL. (562) 699-7411 EX. 2727
 DOUBLE SCALE

RECORD PLANS

CURVE DATA:

CURVE	DELTA	RADIUS	LENGTH	TANGENT
C1	0°51'48"	345.00'	5.20'	2.60'


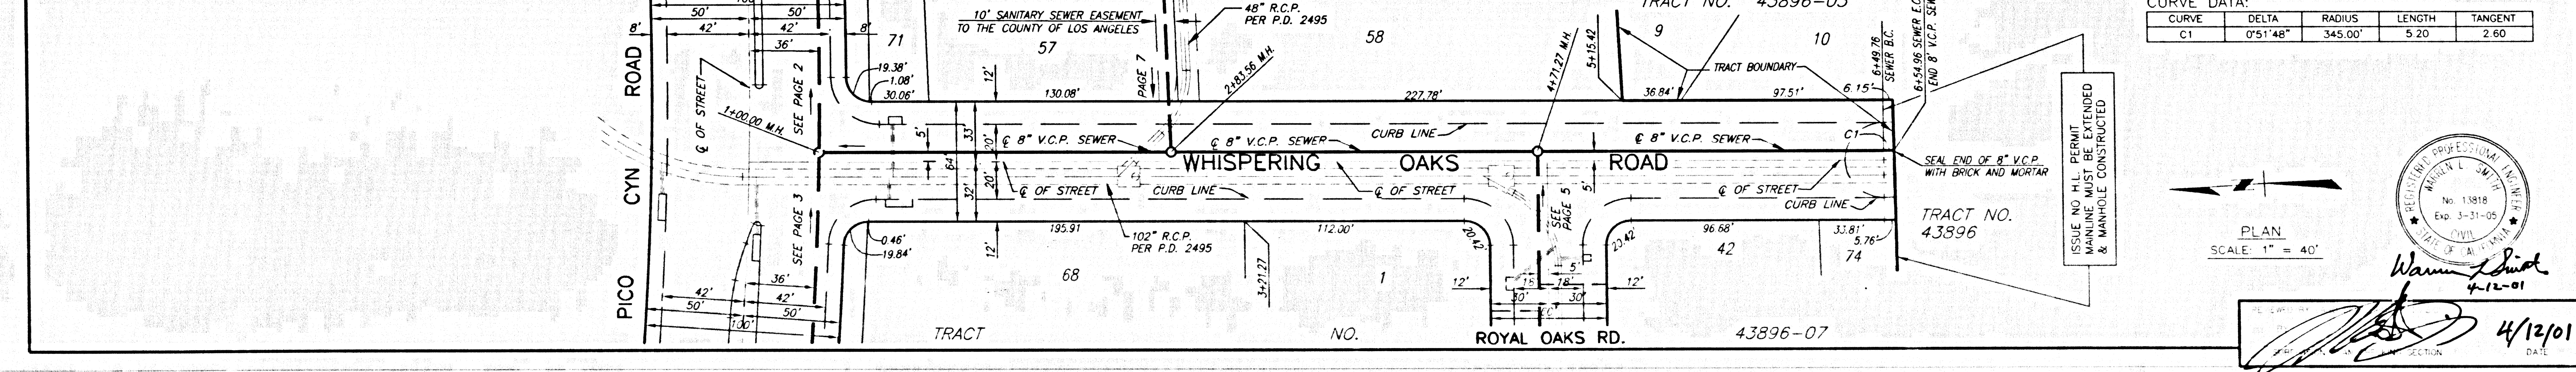


PLAN SCALE: 1" = 40'


REVEALED BY: [Signature] DATE: 4/12/01

PROFESSIONAL ENGINEER
 WALTER L. JUMPER
 No. 13818
 Exp. 3-31-05
 CIVIL
 STATE OF CALIFORNIA
 4-12-01


84211 .C.P. TO-08854 .OM TRACT

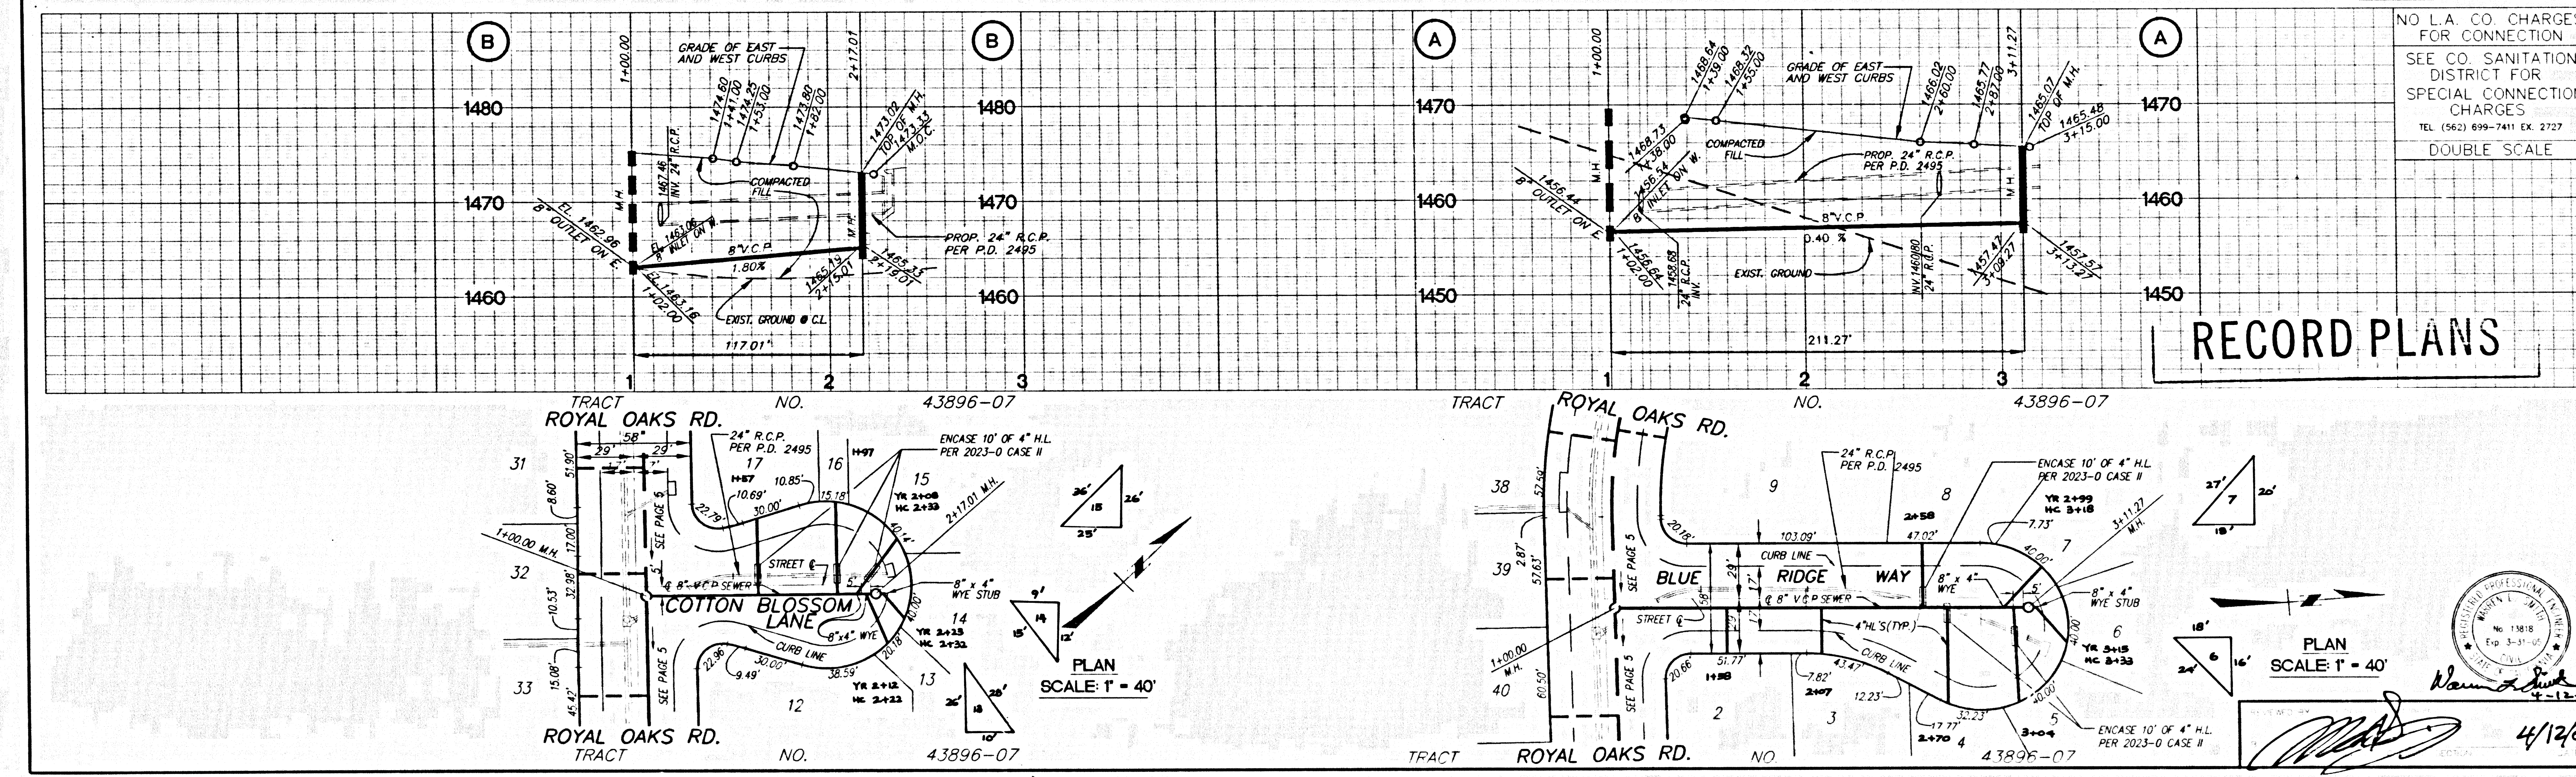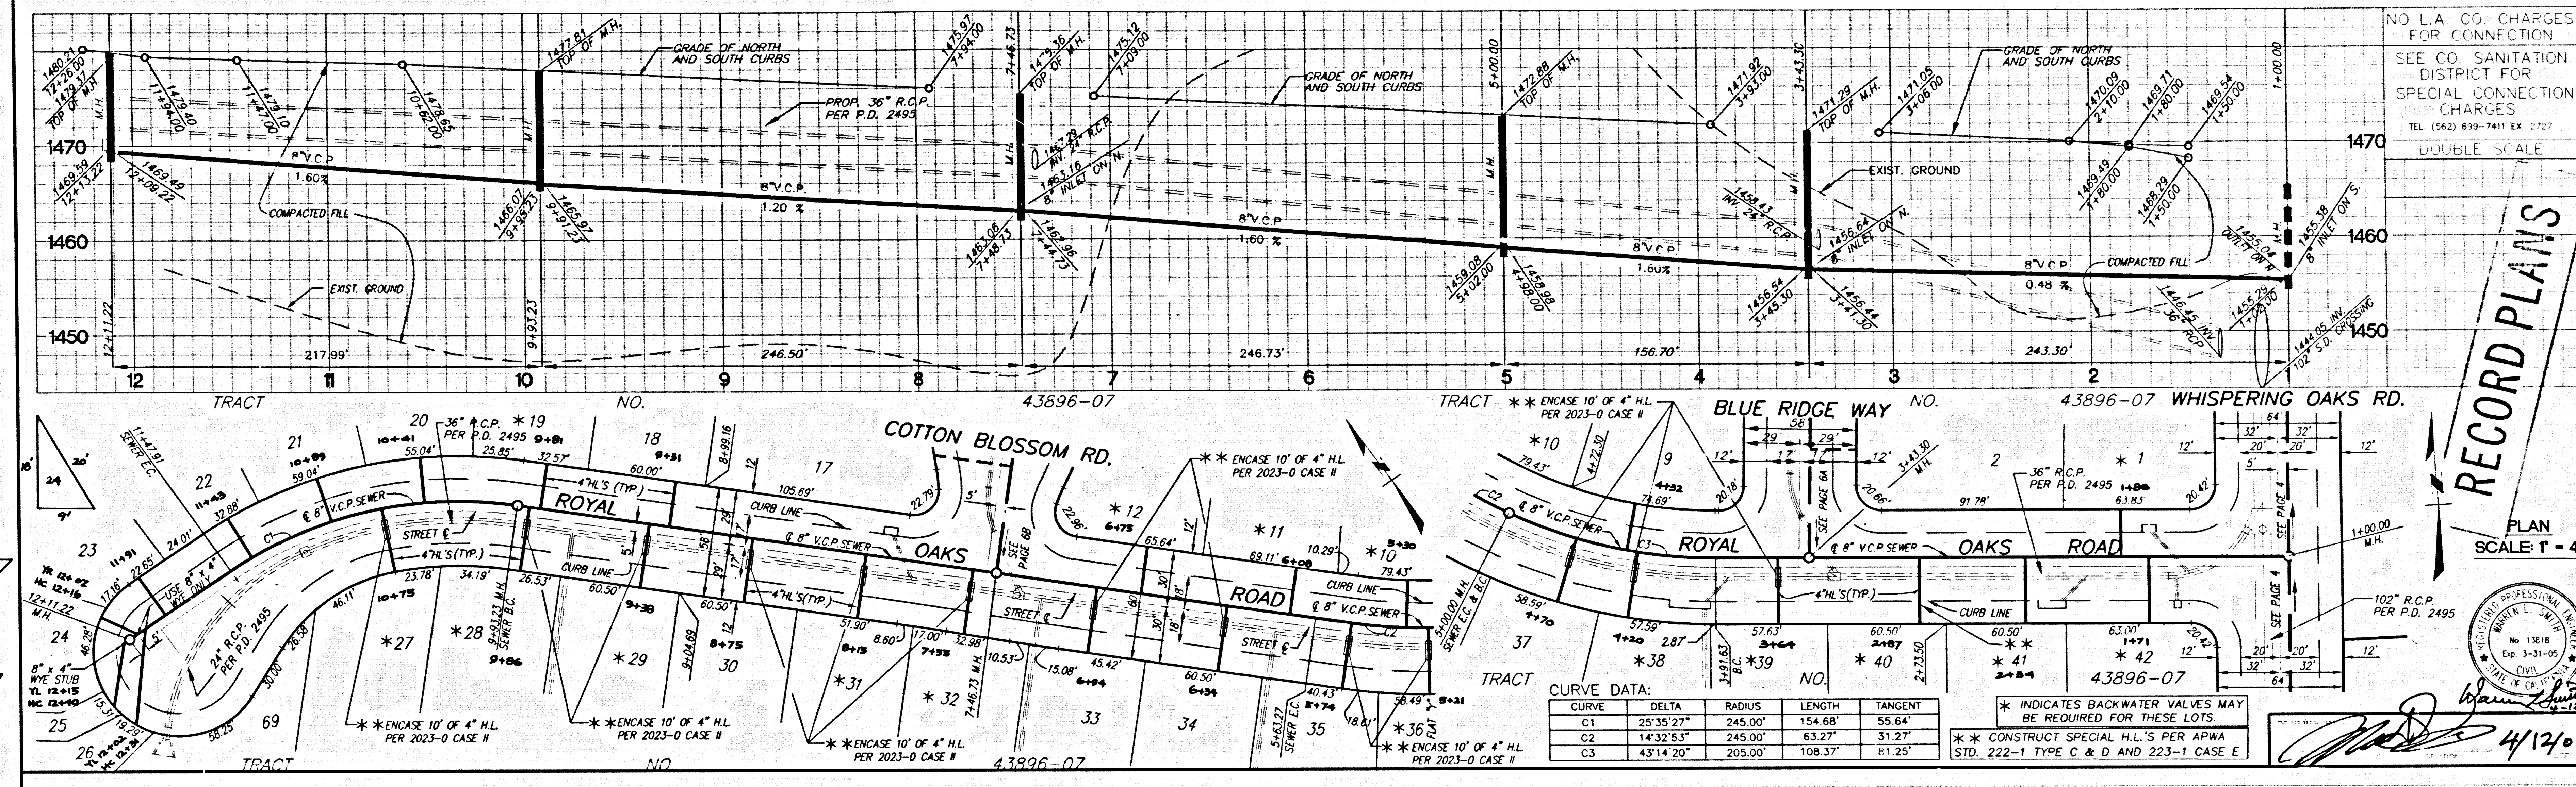

3 8A211 9.C. 124834-00 TCAST

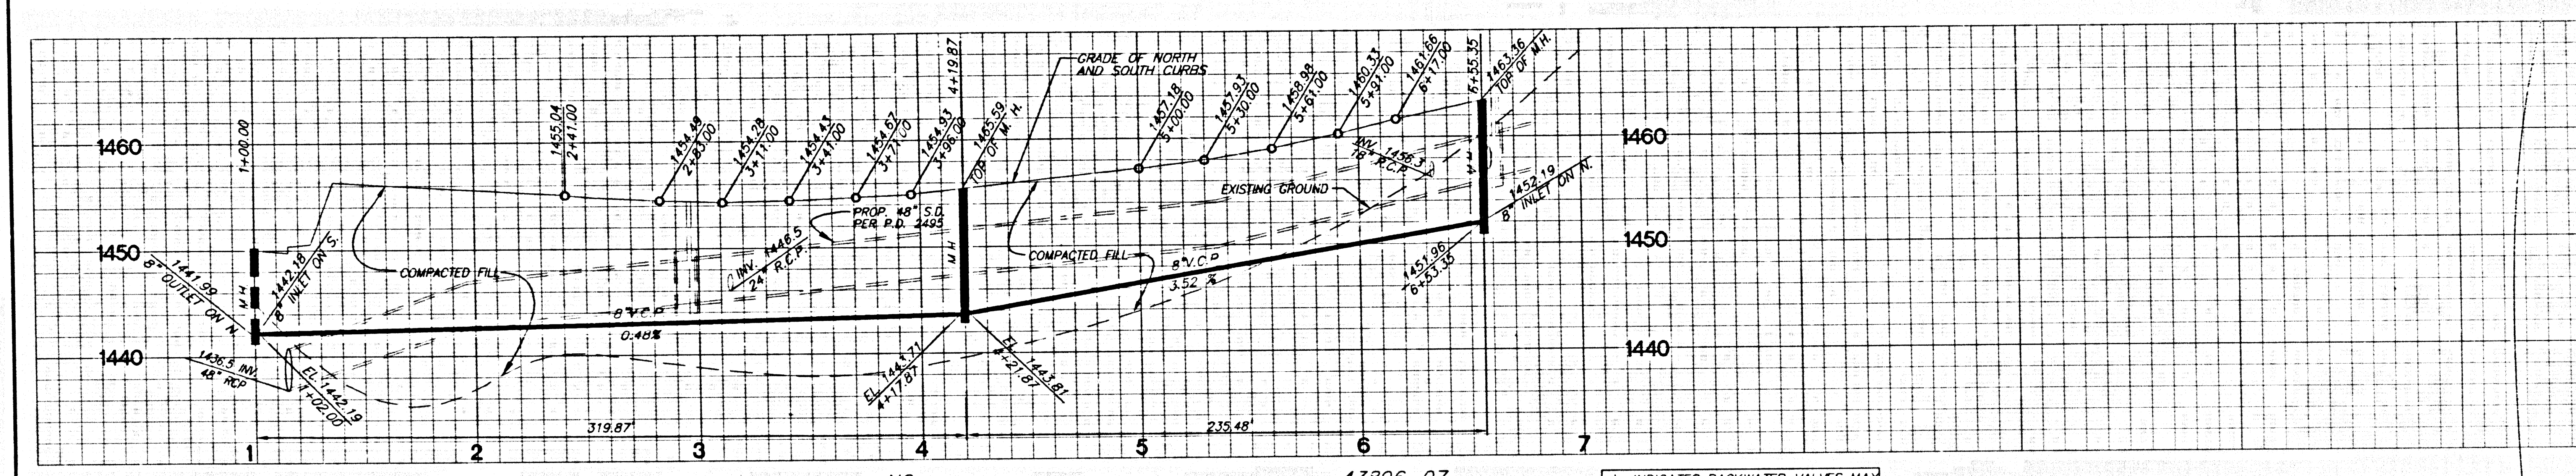

NO L.A. CO. CHARGES FOR CONNECTION
SEE CO. SANITATION DISTRICT FOR SPECIAL CONNECTION CHARGES
DOUBLE SCALE

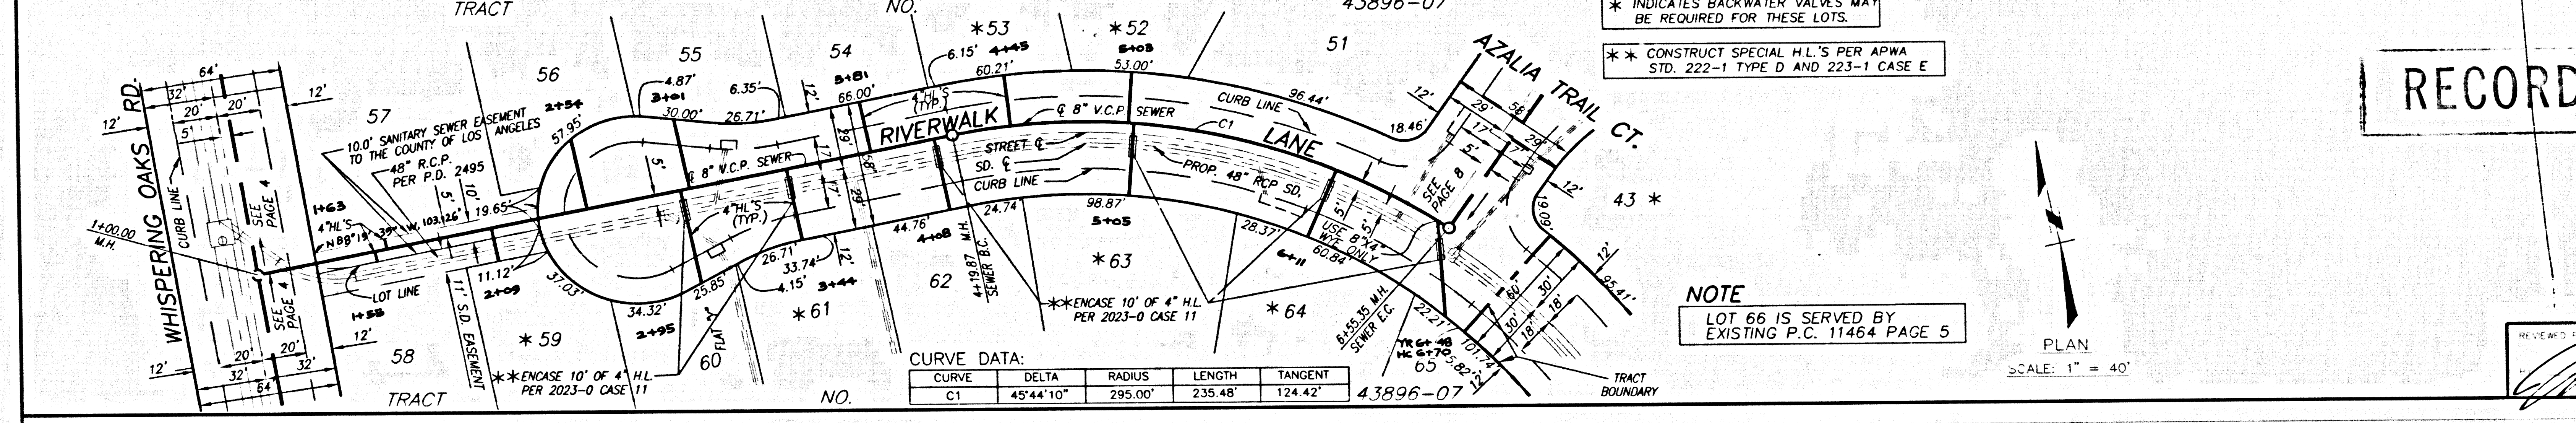


RECORD PLANS




REVIEWED BY: [Signature]
DATE: 4/12/01

TRACT NO. 43896-07

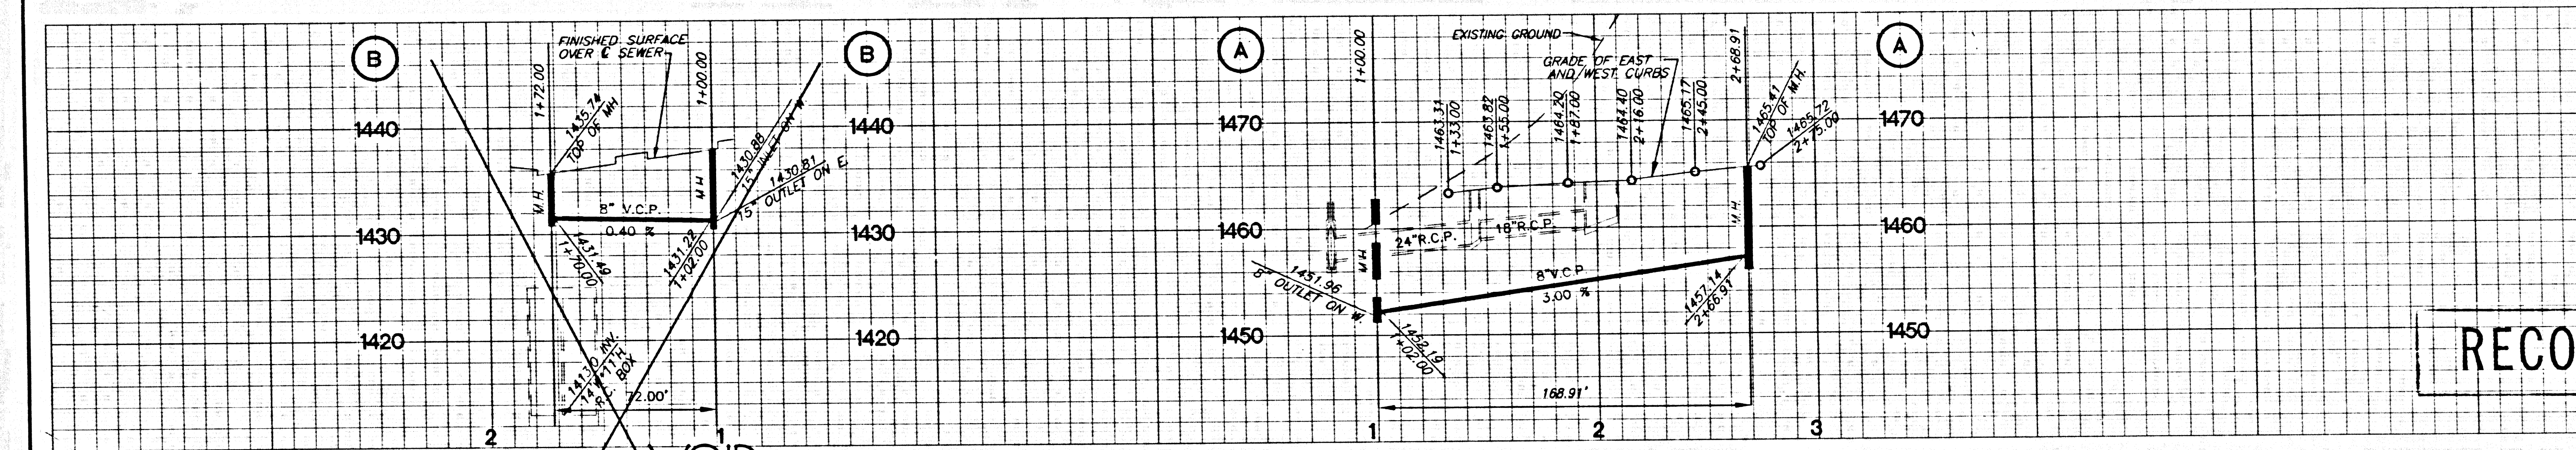


NO L.A. CO. CHARGES FOR CONNECTION
SEE CO. SANITATION DISTRICT FOR SPECIAL CONNECTION CHARGES
DOUBLE SCALE

RECORD PLANS

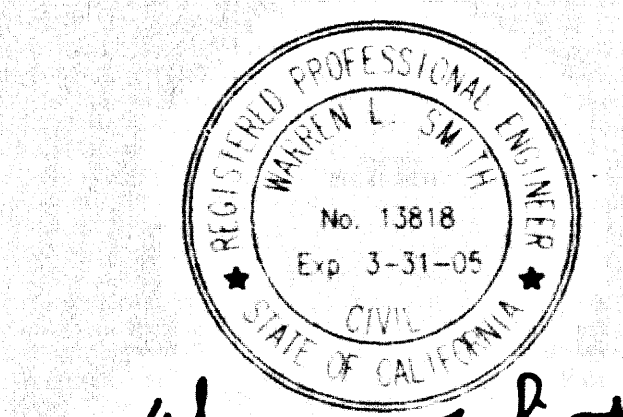


REVIEWED BY: [Signature]
DATE: 4/12/01

TRACT NO. 43896-07

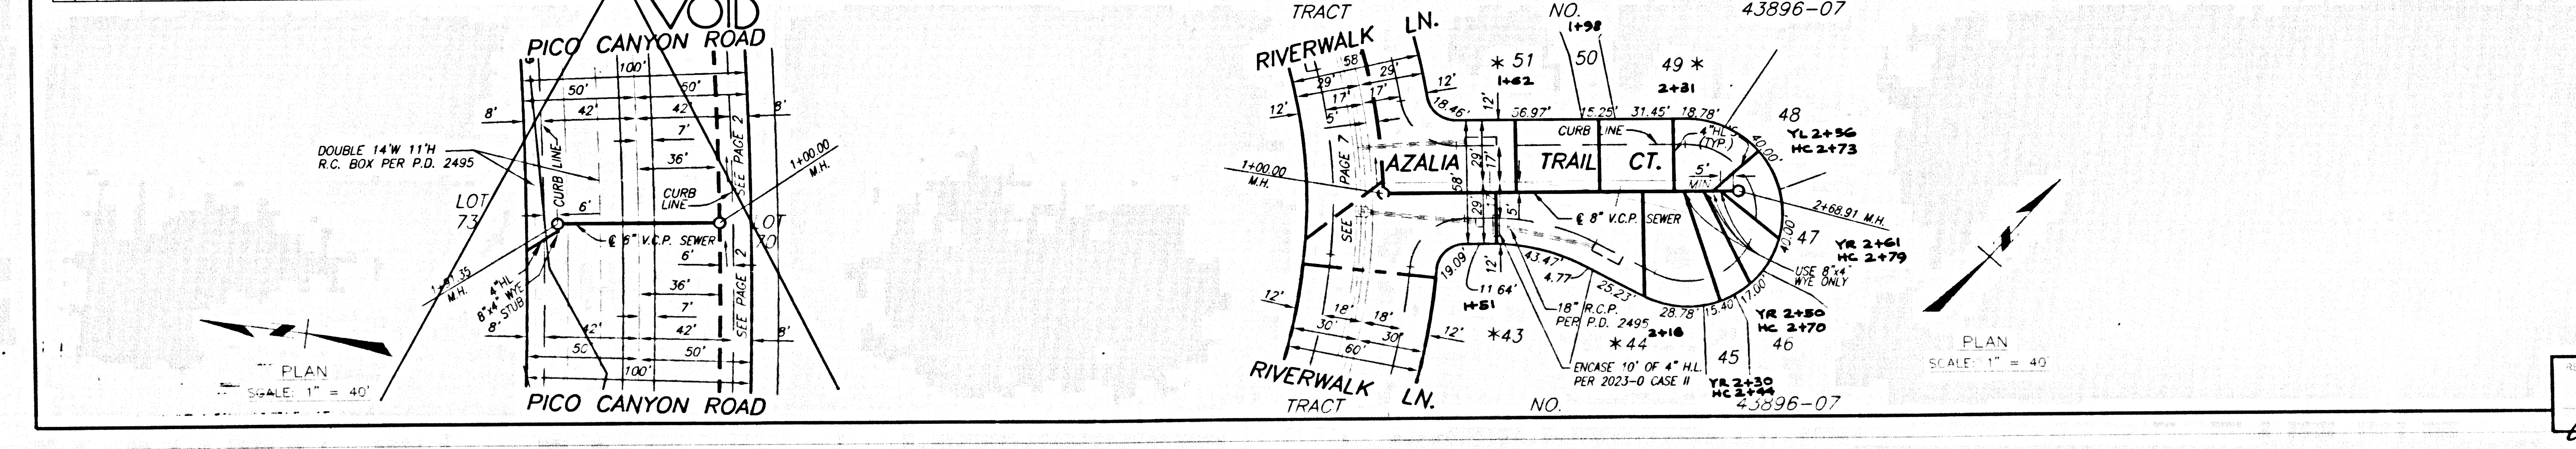

NO L.A. CO. CHARGES FOR CONNECTION
SEE CO. SANITATION DISTRICT FOR SPECIAL CONNECTION CHARGES
DOUBLE SCALE

RECORD PLANS

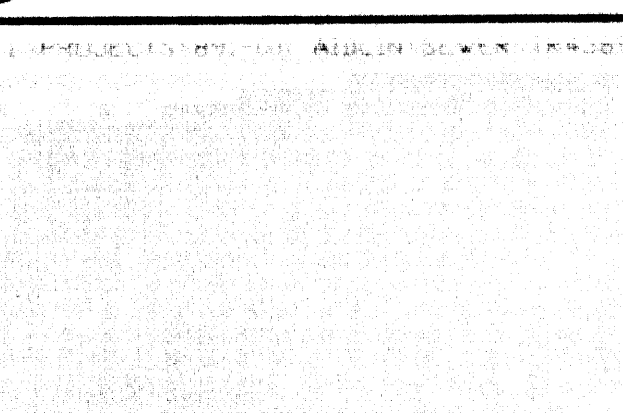

REVIEWED BY: [Signature]
DATE: 4/12/01

TRACT NO. 43896-07