


BENCH MARK: L.A.C.R.D. L 3826
RD BM TAG IN C.B. 9 FT. SO. B.C.R. 55 FT. SO. &
42 FT. W/C.L. INT. BOUQUET CANYON RD.
STEVE JON ST.
NEWHALL QUAD. (1993) ELEV. 1374.703

Per Title 20.24.140 of
LA County Code,
obstructing access to
sewer easement(s) is prohibited.
No object difficult to remove
shall be located over
the sewer easement(s) or to
interfere with ready access
to sewer facilities.

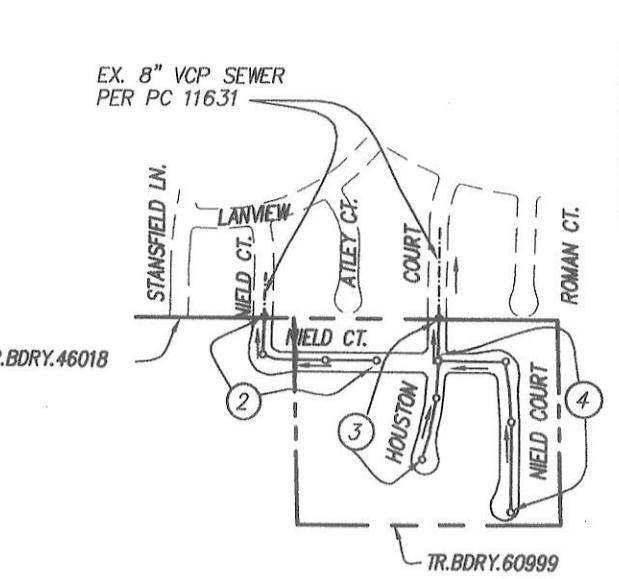

THE BEARINGS SHOWN HEREON ARE BASED ON THE BEARING NORTH 09°22'54" EAST OF THE SOUTH LINE OF SECTION 15, RIVER RANGE 15 WEST, SAN BERNARDINO MERIDIAN, AS SHOWN ON THE 1910 U.S. GLOBALE SURVEY MAPS, PAGES 77 THROUGH 85, INCLUSIVE, OF MAPS, RECORDS OF LOS ANGELES COUNTY, AND SHOWN ON THIS MAP AS NORTH 89°28'53" EAST.

CONTRACTOR TO PROTECT AND PRESERVE
IN PLACE ALL EXISTING SURVEY MONUMENTS.
AFTER CONSTRUCTION IS COMPLETED, THESE MONUMENTS
MUST BE RESET BY A LICENSED LAND SURVEYOR AND THE
APPROPRIATE CORNER RECORD MUST BE FILED
WITH THE COUNTY OF LOS ANGELES

INDEX MAP

SCALE: 1" = 600' CSMD INDEX N-1373
P.C. 12036 TR. NO. 60999

THOMAS GUIDE PAGE: 4461 F-6

NOTE: NUMBER IN CIRCLE INDICATES PAGE NUMBER.

BUILDING & SAFETY DISTRICT OFFICE SANTA CLARITA

AS-BUILT PLAN DATED 11/21/2016

NO.	REVISION	REVISED BY	APPROVED BY	DATE

STORMWATER POLLUTION PLAN NOTES

- A. NOTES:
1. Sediments and other pollutants must be retained on site and may not be transported from the site via sheetflow, swales, area drains, natural drainage courses or wind.
2. Stoops of earth and other construction related materials must be protected from being transported from the site by the forces of wind or water.
3. Fuels, oils, solvents and other toxic materials must be stored in accordance with their listing and are not to contaminate the soil and surface waters. Appropriate storage containers are to be protected from the weather. Spills must be cleaned up immediately and disposed of in a proper manner. Spills must not be washed into the drainage system. Provisions shall be made to retain concrete wastes or waste concrete may not be dumped into the public way or any other drainage system. Provisions shall be made to retain concrete wastes on site until they can be disposed of as solid waste.
4. Excess or waste concrete must be deposited into a covered receptacle to prevent contamination of rainwater and dispersal to sewer facilities.
5. Trash and construction related solid wastes must be deposited into a covered receptacle to prevent contamination of rainwater and dispersal to sewer facilities.
6. Sediments and other materials may not be tracked from the site by vehicle traffic. The construction entrance roadway must be stabilized so as to inhibit sediments from being deposited into the public way. Accidental depositions must be swept up immediately and may not be washed down by rain or other means.
7. Any temporary dredging or dredge material placement must be stabilized so as to inhibit erosion by wind and water.
8. The following BMP's as outlined in, but not limited to, the CALIFORNIA STORMWATER QUALITY ASSOCIATION, 2009 CONSTRUCTION BMP HANDBOOK/PORTAL, the latest revised edition, may apply during the construction of this project (additional measures may be required if deemed appropriate by county inspector, the project engineer or consulting engineer):

EROSION CONTROL

- EC11 - Scheduling
- EC2 - Preservation of Existing Vegetation
- EC3 - Hydrologic Mulch
- EC4 - Soil Protection
- FCS - Soil Binders
- EC6 - Straw Mulch
- EC7 - Geotextiles and Mats
- EC9 - Earth and Drainage Swales
- EC10 - Velocity Dissipation Devices
- EC11 - Slope Drains
- EC12 - Treadboard Stabilization
- EC13 - Rootcots
- EC14 - Compost Blankets
- EC15 - Soil Preparation/Roughening
- EC16 - Non-vegetated Stabilization

EQUIPMENT TRACKING CONTROL

- TC1 - Stabilized Construction Entrance/Exit
- TC2 - Stabilized Construction Roadway
- TC3 - Entrance/Outlet Tire Wash

WIND EROSION CONTROL

- WE1 - Wind Erosion Control

TEMPORARY MANAGEMENT CONTROL

- SE1 - Site Fence
- SE2 - Sediment Basin
- SE3 - Sediment Trap
- SE4 - Check Dam
- SE5 - Filter Stripping
- SE6 - Gravel Bag Berms
- SE7 - Street Sweeping and Vacuuming
- SE8 - Storm Drains
- SE9 - Storm Drain Inlet Protection
- SE10 - Active Treatment Systems
- SE11 - Temporary Silt Dike
- SE12 - Temporary Silt Wall
- SE13 - Compact Socks and Berms
- SE14 - Blotter Bags

NON-STORMWATER MANAGEMENT

- NS1 - Water Conservation Practices

- NS2 - De-watering Operations

- NS3 - Paving and Grinding Operations

- NS4 - Temporary Stream Crossing

- NS5 - Clear Water Discharge

- NS6 - Stormwater Discharge

- NS7 - Portable Water/Irrigation

- NS8 - Vehicle and Equipment Cleaning

- NS9 - Vehicle and Equipment Fueling

- NS10 - Vehicle and Equipment Maintenance

- NS11 - Pipe Driveway Operations

- NS12 - Concrete Curing

- NS13 - Material and Equipment Use

- NS14 - Material Adjustment To Water

- NS15 - Temporary Batch Plants

- NS16 - Temporary Bulk Plants

PRIVATE CONTRACT SEWER GENERAL NOTES

1. A sewer construction permit shall be obtained and a fee paid for construction inspection and record plans to the County at least 72 hours prior to starting work under this permit. Copies of all other required permits, such as Rod Excavation, Caltrans, etc., must be filed with the permit application.
2. Prior to issuance of any permit, the contractor shall file a permit for excavations and trenches from the State of California Division of the Public Works, and a Certificate of Worker's Compensation Insurance with the Department of Public Works prior to cancellation of the insurance policy.
3. If work is done in a State Highway, a permit must be obtained from the State of California Division of Highways, 120 South Spring Street, Los Angeles, California.
4. When working in a contract city, the contractor must contact the Director of Public Works of that city, to determine the location to point inspection.
5. The contractor shall contact the district office listed on the "Application for Construction Permit" to arrange for an acceptable construction start date.
6. Approval of this plan by the County of Los Angeles Department of Public Works does not constitute an representation as to acceptability of the proposed work or non-existence of any underground utility pipe or structure within the limits of this project. This note applies to all permits issued.
7. All work shall be in accordance with the latest approved edition of the "Standard Specifications for Public Works Construction", including supplements (if there is any), the latest "Additions and Amendments to the Standard Specifications for Public Works Construction" and the latest "Special Provisions for the Construction of Sanitary Sewer" and shall be submitted in the name of the County of Los Angeles Department of Public Works.
8. The contractor's attention is drawn to Section 10.4.1 of the "Standard Specifications for Public Works Construction" in regard to safety orders and shall conform to the "Minimum Public Safety Requirement" as shown on Los Angeles Department of Public Works' standard plan 6008-1.
9. Elevations are in feet above U.S.C. & G.S. sea level datum of 1988.
10. No revisions shall be made in these plans without the approval of the County of Los Angeles Department of Public Works.
11. No representations shall be made in these plans by the County of Los Angeles Department of Public Works will survey or lay out any portion of the property.
12. Grades to which this improvement is to be constructed are shown on plans and profiles. Grade points for top of curbs, centerline of streets, or centerline of alleys, are shown by circles on profiles of all points between said designed points.
13. The private engineer shall furnish the plans of the proposed grade lines and stationing for all house laterals and "Y" or "T" branches and shall provide stakes for them at their proper grade lines with staking plainly marked. All house laterals shall be constructed in a straight alignment at right angles from the main line sewer except as shown on the plans. House laterals from chimneys shall not have an angle of less than 45 degrees with the main sewer. Any change in alignment shall be requested in writing by the private engineer.
14. The private engineer shall furnish the house lateral depth of the property line below the top of curb elevation for each house lateral on the grade sheet.
15. An approved backwater valve is required when the pad is lower in elevation than the top of the next upstream manhole.
16. Contour Environmental Programs Division for industrial waste discharge permit # (026) 458-3517

CONSTRUCTION NOTES

1. Provide survey stakes at the property line or property lines produced at right angles to the sewer line at the centerline of each manhole.
2. Vitrified clay pipe joints shall be type "D" or "C" per "Standard Specifications for Public Works Construction" Section 208-2.
3. If a pipehole is within three feet of the sewer, the sewer shall be encased per LACDPW standard plan 2023-2, Case 202-2.
4. All joints between iron pipe and vitrified clay pipe shall be made with a rubber sleeve joint, type "D" (with bushing if necessary) per "Standard Specifications for Public Works Construction" Section 208-2.
5. House laterals to be constructed with invert at the property line 5 feet below curb grade except as noted.
6. Wye or tee branches may be used for connections to the mainline sewers except as noted.
7. If during the course of construction, it is determined that there is less than four feet of cover over the top of a manhole, the manhole shall be removed and shall be replaced by a larger one as required by LACDPW standard plan 2023-2, Case II, unless otherwise approved by the County of Los Angeles Department of Public Works.
8. All structures shall be either brick sewer manholes per LACDPW standard plan S-3 (SPWC 2003-2), or precast concrete sewer manholes per LACDPW standard plan S-36 (SPWC 2003-3), or reinforce precast concrete manhole per LACDPW standard plan S-36 (SPWC 2003-3), except as noted.
9. Reinforce all trenches with steel cables to meet Department of Public Works or California State Highway requirements in accordance with the permit.
10. Full compliance with Section 306-1.3 of the "Standard Specifications for Public Works Construction" will be required for backfill in street. Certification of backfill compaction, and sand equivalents by a qualified civil engineer shall be provided by the permittee prior to the issuance of a certificate of partial acceptance.
11. All manholes shall be compacted to 90% of the maximum density as determined by ASTM soil compaction test D 1577-78 method 7 unless otherwise specified. This shall be certified by a qualified civil engineer. This certification shall be submitted to the Construction Division of the Department of Public Works prior to the acceptance of the permit.
12. Manhole tops in improved rights of way to be six inches above finished grade.
13. Survey to be taken for location and section of "S" of "Standard Specifications for Public Works Construction" as applicable.
14. Manhole tops in improved rights of way to be level with finished grade.
15. All wyes and/or house laterals are to be located at least 5' apart and when possible not closer than 5' to any
16. All pipe materials shall be vitrified clay pipe or ductile iron pipe or other materials approved by the County of Los Angeles Department of Public Works.

17. All sanitary sewer manhole shafts and frames shall be watertight.

NOTICE TO CONTRACTOR:

Maintain sewer flow at all times during construction.

BWV BACKWATER VALVES MAY BE NECESSARY FOR LOTS/BUILDING/UNITS 3,4,5,13,14,15,18,19,20

ISSUE NO HOUSE LATERAL CONNECTION PERMITS UNTIL OUTLET SEWER PC 11631 & PC 12036 ARE ACCEPTED FOR PUBLIC USE BY THE COUNTY OF LOS ANGELES.

LOT NOS 41-43 ARE RESTRICTED FROM CONSTRUCTION OF BUILDINGS AND WILL NOT BE SERVED BY THIS SEWER.

THE DEVELOPER SHALL BE RESPONSIBLE FOR THE CONTINUED MAINTENANCE OF PC 12036 SANITARY SEWER UNTIL THE COUNTY FORMALLY ACCEPTS IT FOR MAINTENANCE. ALL MAINLINE, MANHOLES AND LATERALS SHALL BE PROTECTED FROM DAMAGE AND INFILTRATION.

SEWER VIDEO OF ALL SEGMENTS SHALL BE SUBMITTED PRIOR TO PARTIAL FIELD ACCEPTANCE (85%) AND COMPLETED FIELD ACCEPTANCE (98%). FINAL MAP AND AS-BUILT SEWER PLANS SHALL BE SUBMITTED PRIOR TO PARTIAL FIELD ACCEPTANCE.

PER LEIGHTON GEOTECHNICAL REPORT, ALL SEWERS SHALL BE CONSTRUCTED ON A TWO FOOT MINIMUM THICKNESS BLANKET OF PROPERLY COMPAKTED FILL.

PROFILE, ALIGNMENT, AND GRADE OF SANITARY SEWERS

TO BE CONSTRUCTED IN

TRACT NO. 60999 PC NO. 12036

2 SHEETS: 4 PAGES

COUNTY OF LOS ANGELES CALIFORNIA

CSMD INDEX N-1373

GAIL FARBER DIRECTOR OF PUBLIC WORKS
APPROVED BY LAND DEVELOPMENT DIVISION
BY ASSISTANT DIVISION ENGINEER DATE
SUBMITTED BY DOUG FARMER 6/18/14

SANTA CLARA VALLEY SANITATION DISTRICT
OF LOS ANGELES COUNTY, CALIFORNIA
GRACE ROBINSON, HYDE-CHIEF ENGINEER AND GENERAL MANAGER
APPROVED BY DOUG FARMER 6/18/14

CITY OF SANTA CLARITA APPROVAL
TRACT 60999 PC NO 12036

CITY OF SANTA CLARITA □ DISCHARGE □ OUTLET APPROVED
WE APPROVE THIS SEWER AREA STUDY/PLAN AND CONCUR WITH THE FOLLOWING FINDINGS WITHIN THE CITY □ NO MITIGATION □ WITH MITIGATION MITIGATION FEE PAID
APPROVED BY RAY CUMMINGS CITY ENGINEER 5/23/14 4/14/14

PRIVATE ENGINEERS NOTICE TO CONTRACTORS:

THE EXISTENCE AND LOCATION OF ANY UNDERGROUND UTILITY PIPES OR STRUCTURES SHOWN ON THESE PLANS IS REQUIRED BY A SEARCH OF AVAILABLE RECORDS TO THE BEST OF OUR KNOWLEDGE. THERE ARE NO EXISTING UTILITIES EXCEPT AS SHOWN ON THIS MAP. THE CONTRACTOR IS RESPONSIBLE TO TAKE ALL NECESSARY MEASURES TO PROTECT THE UTILITY LINES SHOWN AND ANY OTHER LINES NOT OF RECORD OR NOT SHOWN ON THIS DRAWING. PRIOR TO EXCAVATION THE CONTRACTOR SHALL CALL TOLL FREE 1-800-424-2411 TO LOCATE UNDERGROUND LOCATION OF GAS AND TELEPHONE LINES. THE CONTRACTOR SHALL THEN CALL MR. RAY CUMMINGS OF GENERAL PLUMBING COMPANY AT 1-805-948-4871 SO THAT THEY CAN MARK THE LOCATION OF UNDERGROUND TELEPHONE LINES.

RCE NO. 49041 EXP. 09-30-14 DATE

P.C. 12036 PAGE 2

NO. L.A. Co. DPW CHARGES FOR CONNECTIONS
SEE COUNTY SANITATION DISTRICTS FOR SPECIAL CONNECTION CHARGES

TEL. (562) 303-4288 EX. 2727
DOUBLE SCALE


REGISTERED PROFESSIONAL ENGINEER
DOUG FARMER
No. 49041
Exp. 09-30-2014
CIVIL
STATE OF CALIFORNIA
PROJECT ENGINEER 4-14-14
DATE


SANITARY SEWER PLANS IN TRACT NO. 60999 PC NO. 12036

REVIEWED BY LAND DEVELOPMENT DIVISION
BY DOUG FARMER 6/18/14


COUNTY OF LOS ANGELES DEPARTMENT OF PUBLIC WORKS

SIKAND
Engineering | Planning | Surveying
15230 Burbank Blvd., Van Nuys, CA 91411
Tel: (818) 787-8550
Fax: (818) 901-7451
info@siikand.com

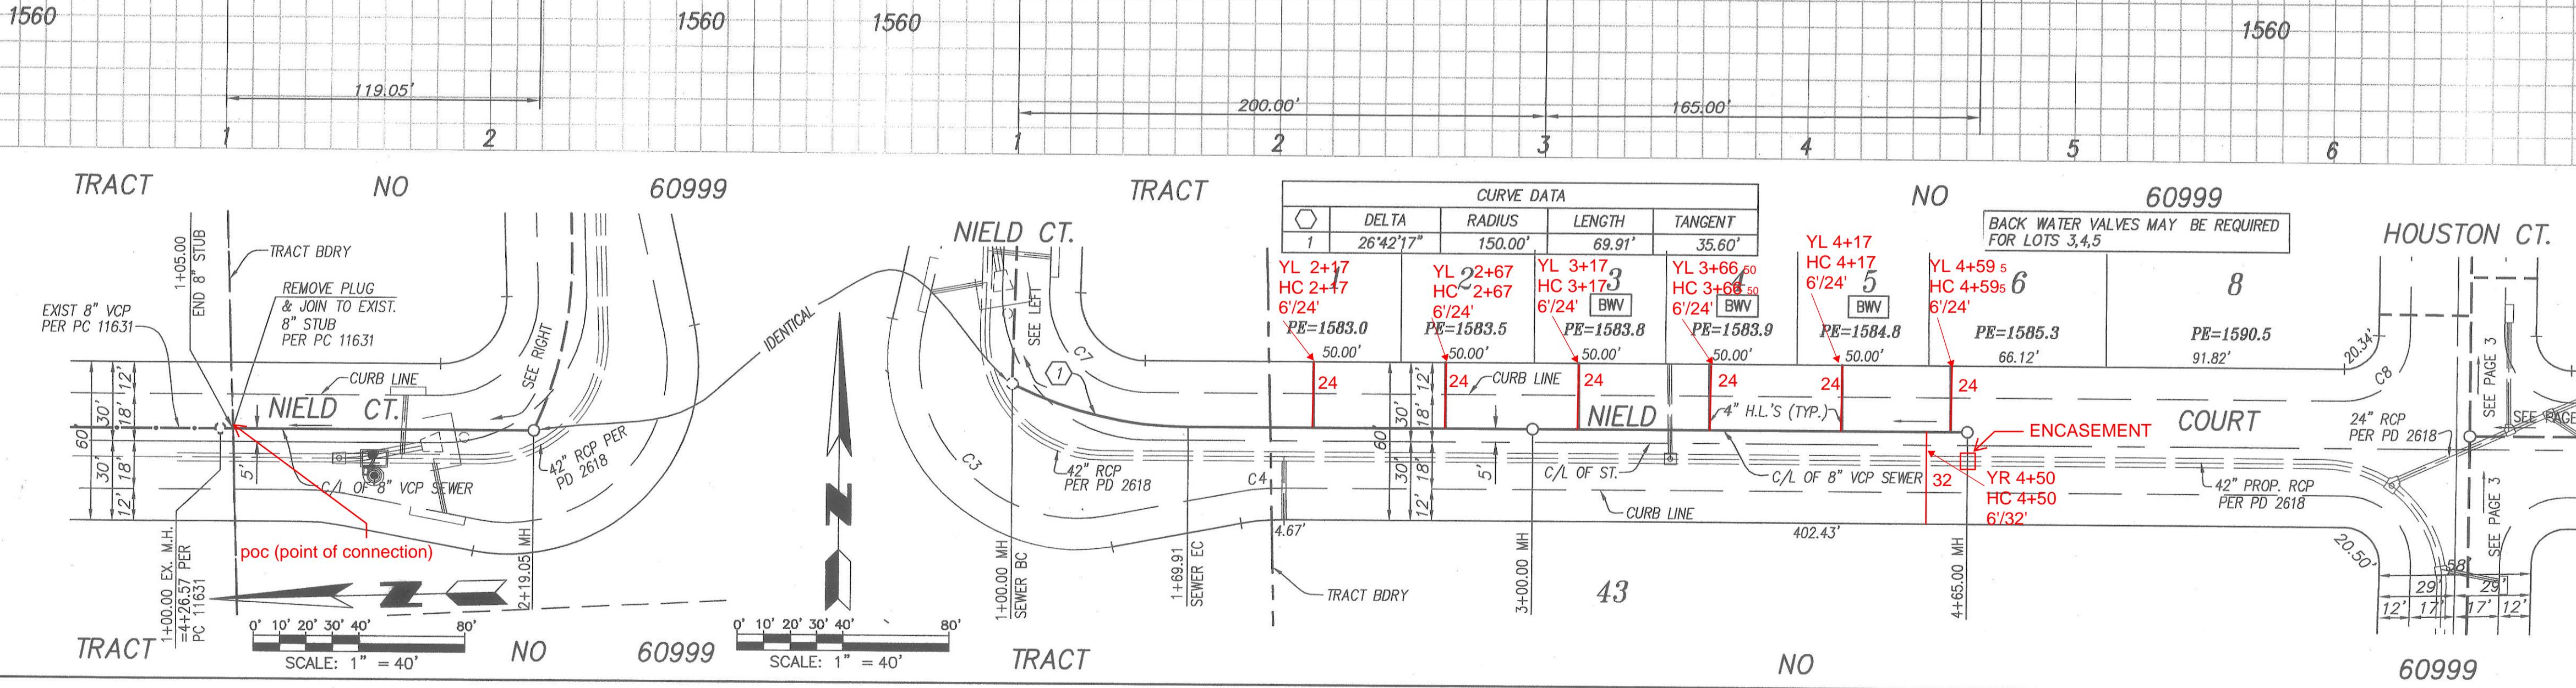

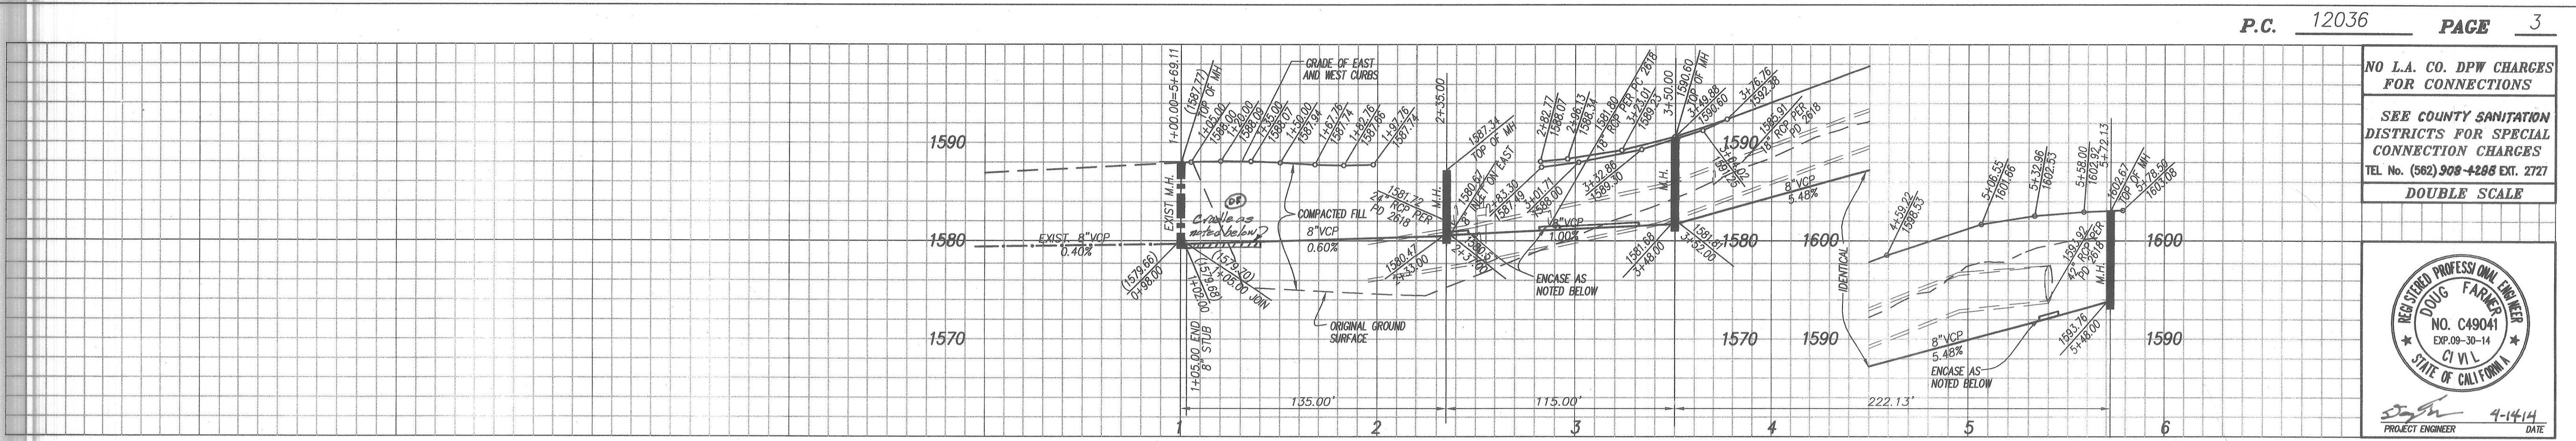

AS-BUILT PLAN DATED 11/21/2016

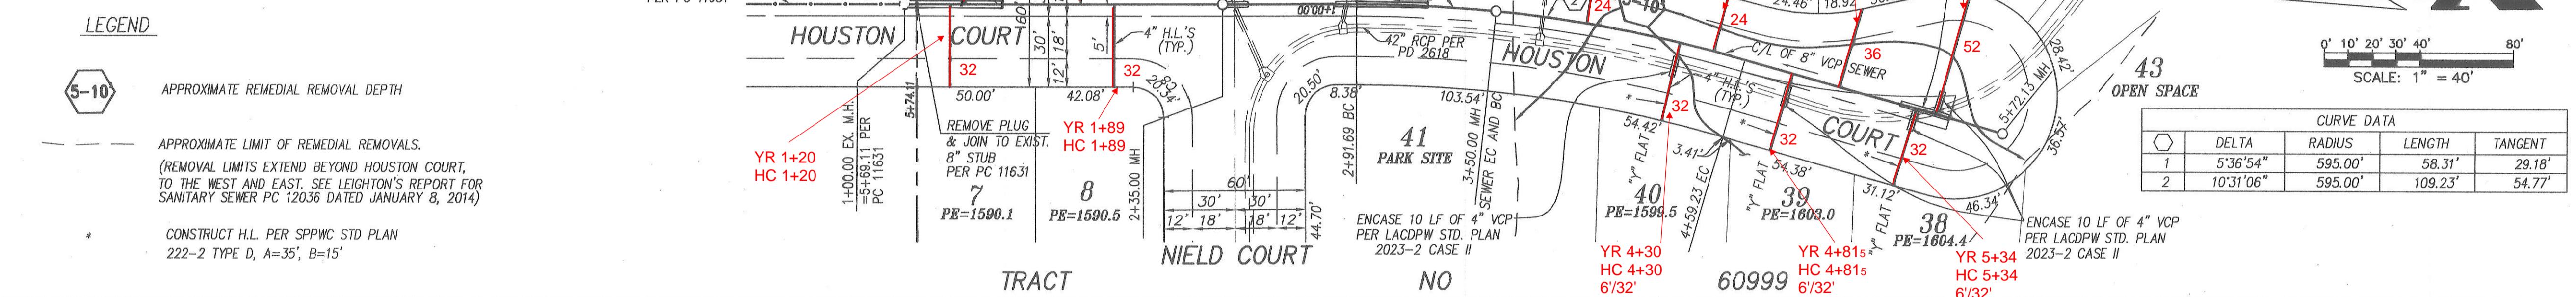

C.C. 12036 PAGE 4

