





00557 09 148984 011 TCA1719AM 120524

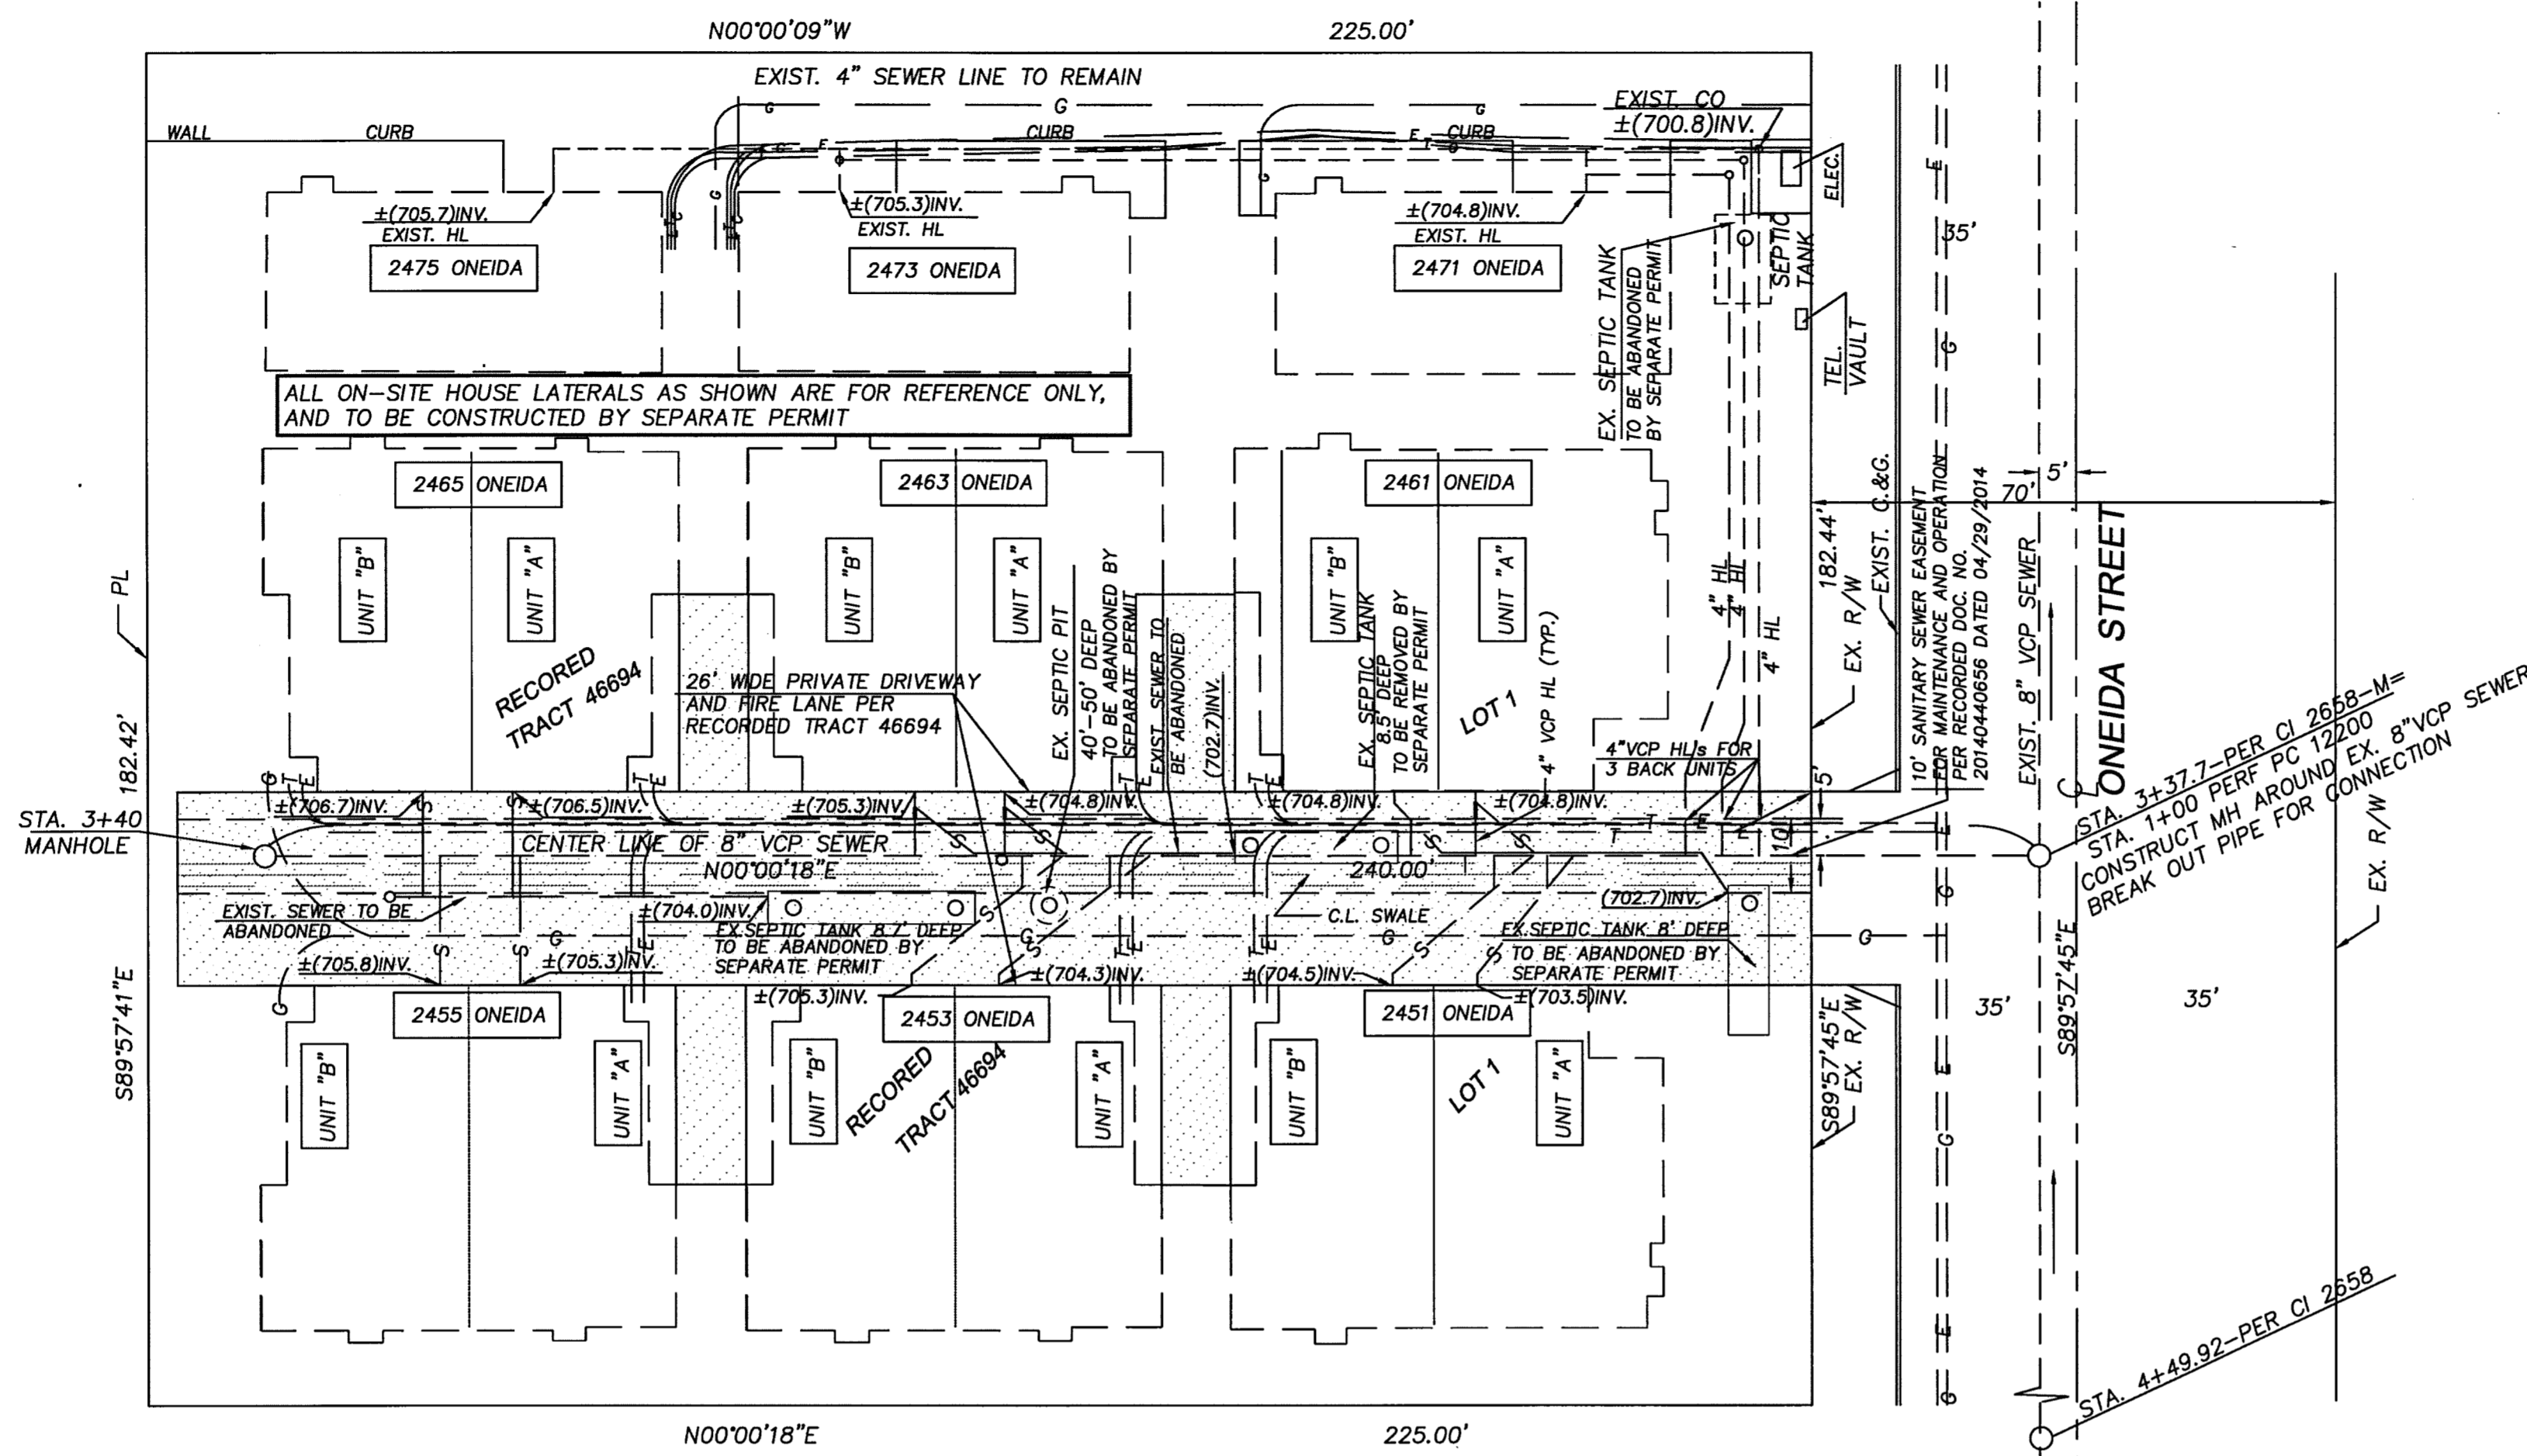


**AS BUILT**  
DATED: 08/19/2015

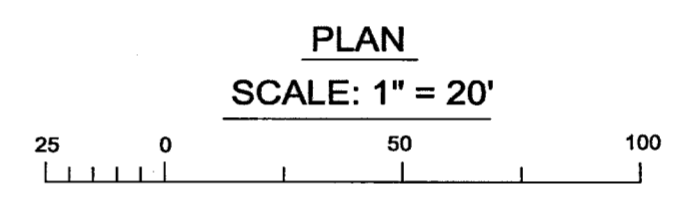

REGISTERED PROFESSIONAL ENGINEER  
 YEFIM TSALYUK  
 NO. C052871  
 EXP. 12/31/14  
 CIVIL  
 STATE OF CALIFORNIA

REVIEWED BY LAND DEVELOPMENT DIVISION  
 BY: [Signature] DATE: 05/12/2014  
 SUBDIVISION PLAN CHECKING SECTION

VOID

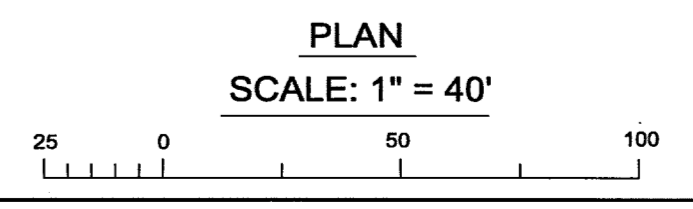

REVIEWED BY LAND DEVELOPMENT DIVISION  
 BY: [Signature] DATE: [Blank]  
 SUBDIVISION PLAN CHECKING SECTION