


NO LA COUNTY CHARGES FOR CONNECTION
 SEE COUNTY SANITATION DISTRICTS FOR SPECIAL CONNECTION CHARGES
 TEL. (662) 908-4288 EX. 2727
 SCALE: VERT. 1" = 4'
 HORIZ. 1" = 40'


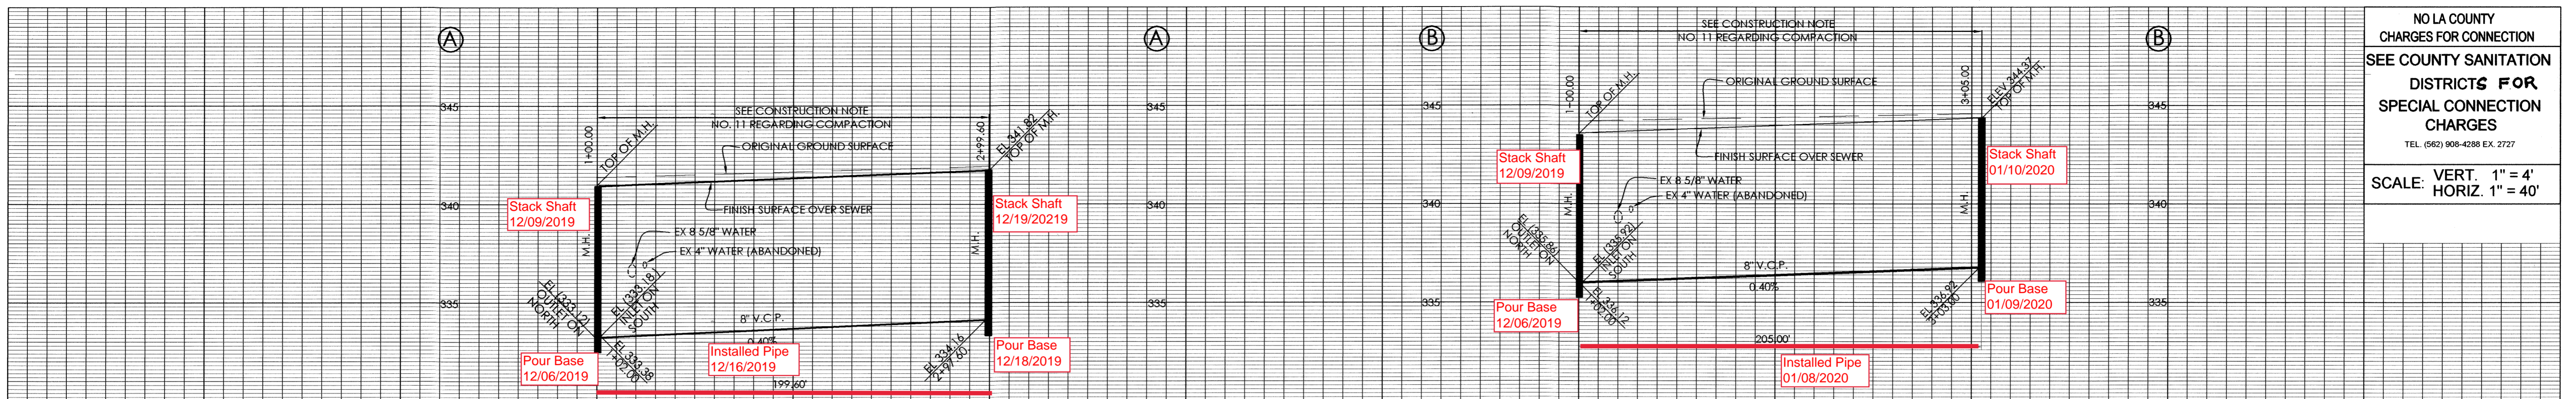


PROPOSED EASEMENTS
 [A] PROPOSED 10' WIDE SANITARY SEWER EASEMENT TO COUNTY OF LOS ANGELES FOR SANITARY SEWER PURPOSES PER TR 60358.
 [B] PROPOSED VARIABLE WIDTH EASEMENT TO THE COUNTY OF LOS ANGELES FOR SANITARY SEWER INGRESS AND EGRESS PER TR 60358.

AS-BUILT PLAN DATED 07/21/2021

- Unit #1 YL, HC=1+68, HL = 8'/5'
- Unit #2 YL, HC=2+01, HL = 8'/5'
- Unit #3 YL, HC=2+32, HL = 8'/5'
- Unit #4 YL, HC=2+66, HL = 8'/5'
- Unit #5 YL, HC=2+87, HL = 8'/5'
- Unit #6 YR, HC=2+92, HL = 8'/5'
- Unit #7 YR, HC=2+74, HL = 8'/5'
- Unit #8 YR, HC=2+40, HL = 8'/5'
- Unit #9 YR, HC=2+08, HL = 8'/5'
- Unit #10 YR, HC=1+75, HL = 8'/5'

- Unit #11 YL, HC=1+79, HL = 8'/5'
- Unit #12 YL, HC=2+05, HL = 8'/5'
- Unit #13 YL, HC=2+39, HL = 8'/5'
- Unit #14 YL, HC=2+71, HL = 8'/5'
- Unit #15 YL, HC=2+91, HL = 8'/5'
- Unit #16 YR, HC=2+96, HL = 8'/5'
- Unit #17 YR, HC=2+76, HL = 8'/5'
- Unit #18 YR, HC=2+44, HL = 8'/5'
- Unit #19 YR, HC=2+12, HL = 8'/5'
- Unit #20 YR, HC=1+84, HL = 8'/5'

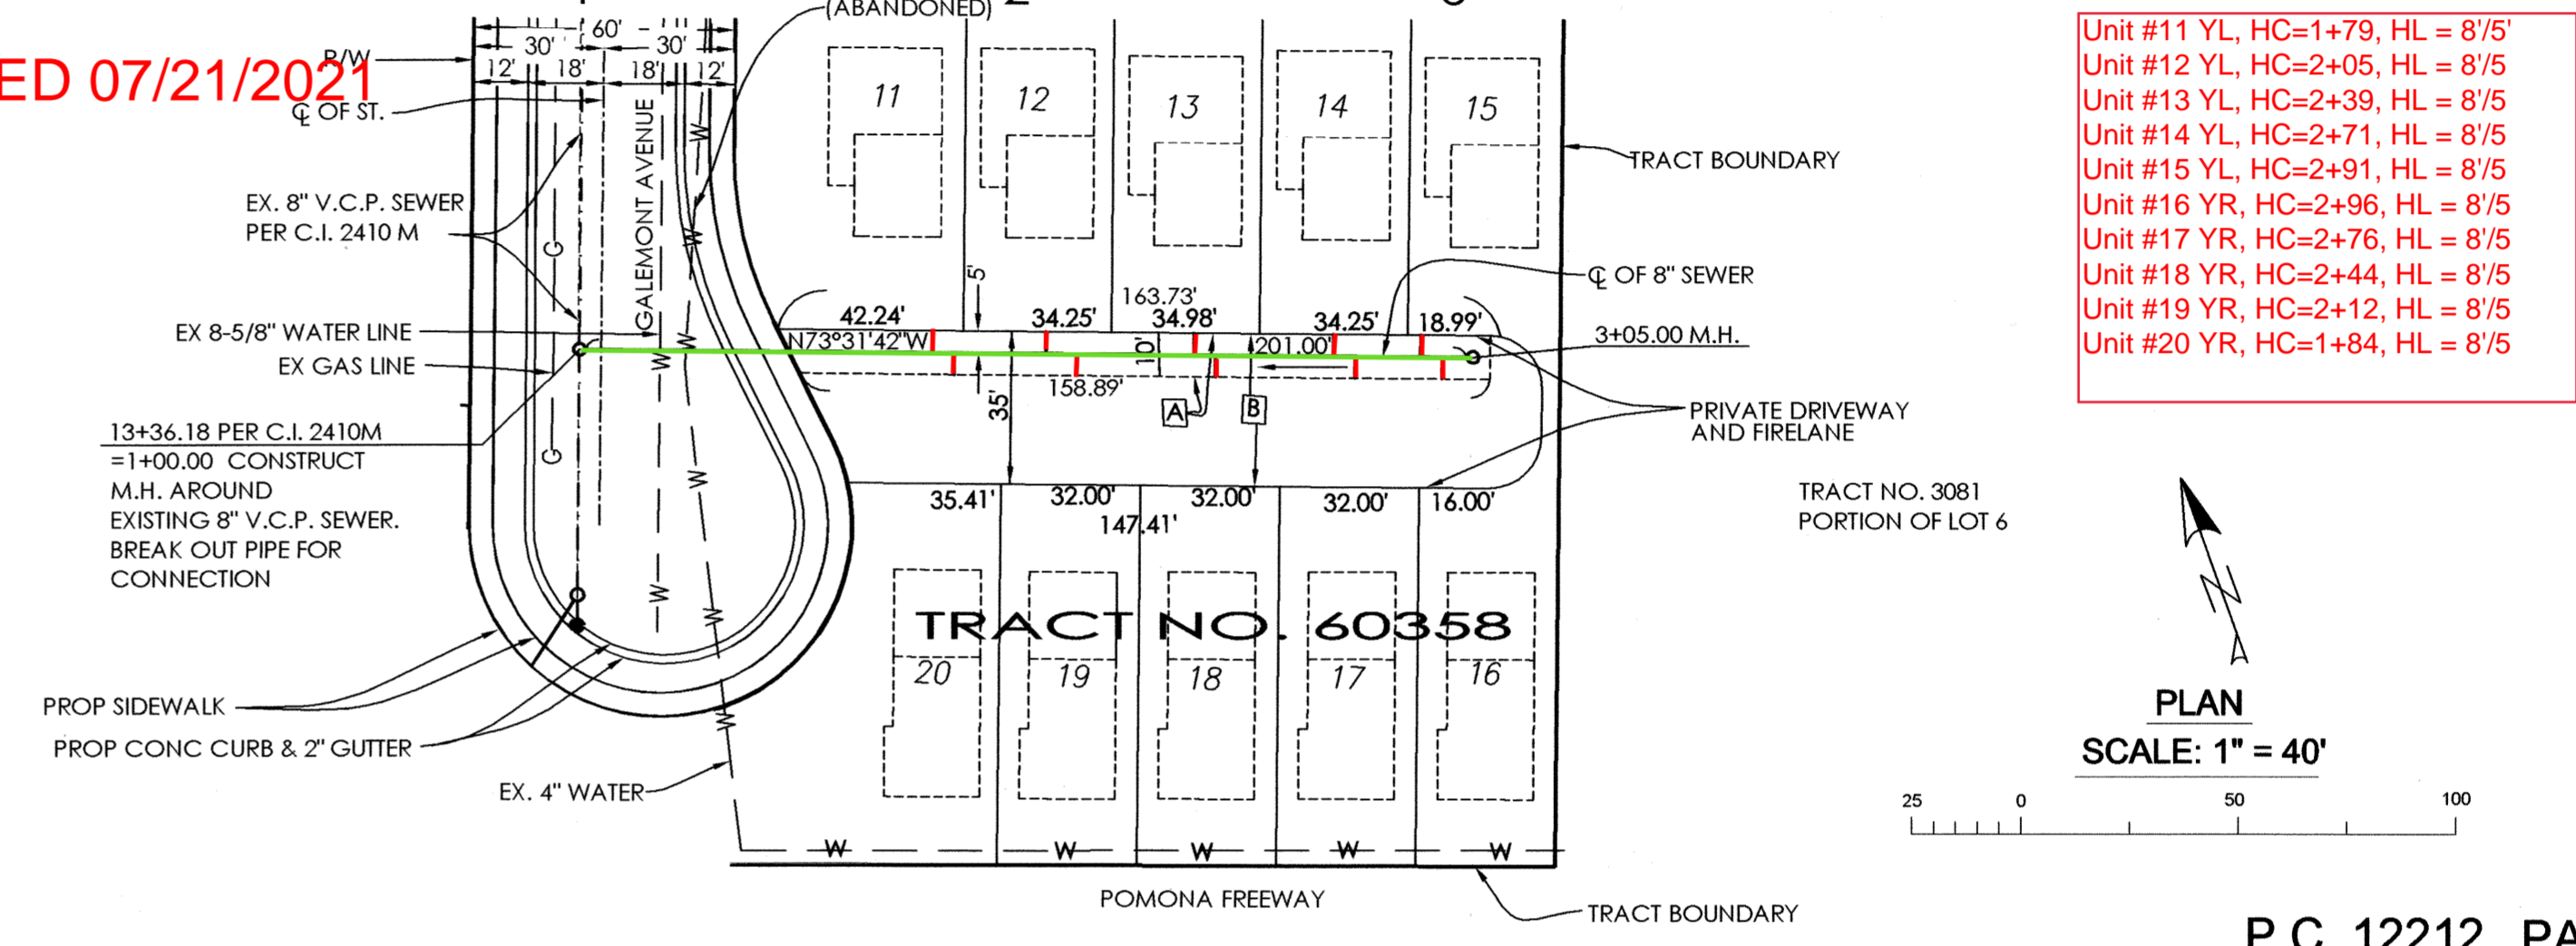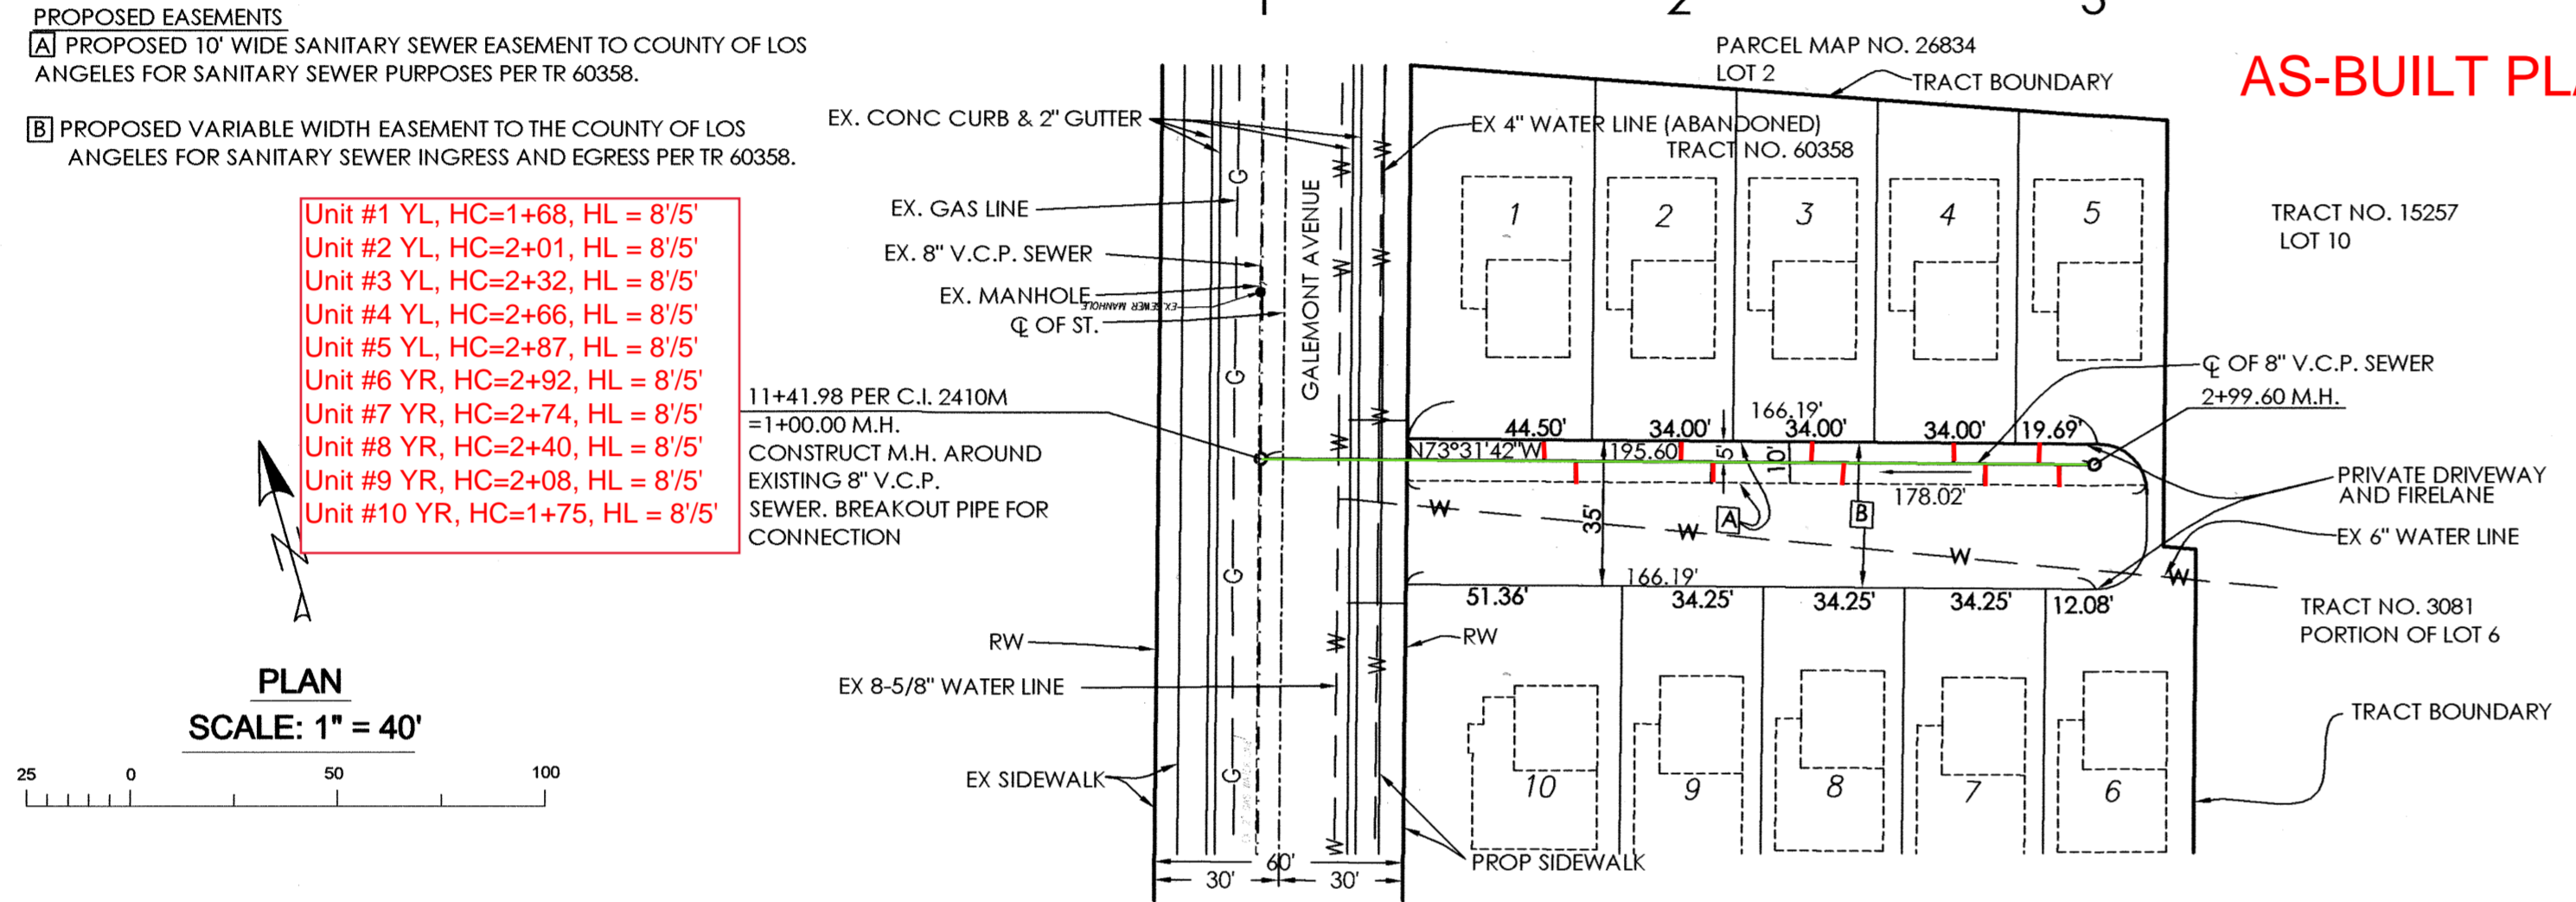

NO LA COUNTY CHARGES FOR CONNECTION
 SEE COUNTY SANITATION DISTRICTS FOR SPECIAL CONNECTION CHARGES
 TEL. (662) 908-4288 EX. 2727
 SCALE: VERT. 1" = 4'
 HORIZ. 1" = 40'

REVIEWED BY LAND DEVELOPMENT DIVISION
 BY Pedro Gomez DATE 08/07/2019
 FINAL MAPS, SEWER AND LANDSCAPING SUBDIVISION PLAN CHECKING SECTION
 DWG 7-672 SHEET 2 OF 2 SHEETS
 DPW.LACOUNTY.GOV ts-ss-dl.dgn 10/2013

TRACT NO. 60358-BC NO. 15517-01 TRACT 15