

STORMWATER POLLUTION PLAN NOTES

1. Every effort should be made to eliminate the discharge of non-stormwater from the project site at all times.
2. Erosion control and other pollutants must be retained on-site and may not be transported from the site via sheet flow, rills, or any other means of erosion.
3. Discharges of earth and other construction related materials must be protected from being transported from the site by the forces of wind or water.
4. Stormwater runoff shall be captured in accordance with best management practices and shall be directed to a stormwater management facility.
5. Stormwater runoff shall be captured in accordance with best management practices and shall be directed to a stormwater management facility.
6. Stormwater runoff shall be captured in accordance with best management practices and shall be directed to a stormwater management facility.
7. Stormwater runoff shall be captured in accordance with best management practices and shall be directed to a stormwater management facility.

PRIVATE CONTRACT SEWER GENERAL NOTES

1. A sewer connection permit shall be obtained from the County of Los Angeles Department of Public Works, 200 South Fremont Avenue, 3rd Floor, Anaheim, CA 92805, at least 72 hours prior to construction work under this permit.
2. When work is within a utility easement, a sewer connection permit shall be obtained and a fee paid for construction inspection and record plans to the City of Los Angeles.
3. Prior to issuance of any permit, the contractor shall file a copy of the proposed sewer connection plan with the County of Los Angeles Department of Public Works, 200 South Fremont Avenue, 3rd Floor, Anaheim, CA 92805, for review and approval.
4. If work is done in a utility easement, a permit shall be obtained from the State of California Division of Highways, 120 South Spring Street, Los Angeles, California.
5. The contractor shall conduct the work in accordance with the "Application for Construction Permit" as a condition of any sewer connection permit.

NOTICE TO CONTRACTOR

- The developer shall be responsible for the construction of the sewer line and the connection to the County of Los Angeles Department of Public Works main sewer line.
- The contractor shall be responsible for the construction of the sewer line and the connection to the County of Los Angeles Department of Public Works main sewer line.
- The contractor shall be responsible for the construction of the sewer line and the connection to the County of Los Angeles Department of Public Works main sewer line.

INDEX MAP

SCALE: 1"=40'

TR 61105

NO.	REVISION	REVISED BY	APPROVED BY	DATE
1	REVISED PROFILE PER UPDATED CROSSINGS	JY	[Signature]	11/15/19

COUNTY SANITATION DISTRICT (CSD) NOTES:

1. No connection for the disposal of industrial wastes shall be made to sewers shown on these drawings until a permit for industrial waste discharge has been issued by the County Sanitation District.
2. At least three (3) working days prior to breaking into or connecting to County Sanitation District sewer or manhole and prior to final acceptance of the project, a County Sanitation District inspector shall be notified.
3. All work involving CSD sewer or manholes shall be in accordance with the latest edition of the Standard Specifications for Public Works Construction, and CSD's Special Amendments to the Standard Specifications for Public Works Construction and Standard Drawings for Construction. A copy of the Amendments and Standard Drawings may be obtained at the Public Works (Room 110) located at 200 South Fremont Avenue, Anaheim, CA 92805.

PROFILE ALIGNMENT AND GRADE OF PAGE 1

SANITARY SEWERS

TO BE CONSTRUCTED BY

TRACT NO. 61105-01 TO 16 PC NO. 12220A

10 SHEETS: 19 PAGES

COUNTY OF LOS ANGELES CALIFORNIA

EIMP2019000179

CSDM INDEX: N-1217, N-1218, N-1256, N-1257


APPROVED BY [Signature] DATE: 8/27/19

APPROVED BY [Signature] DATE: 8/27/19

APPROVED BY [Signature] DATE: 9/1/19

APPROVED BY [Signature] DATE: 8/23/2019

APPROVED BY [Signature] DATE: 8-22-19

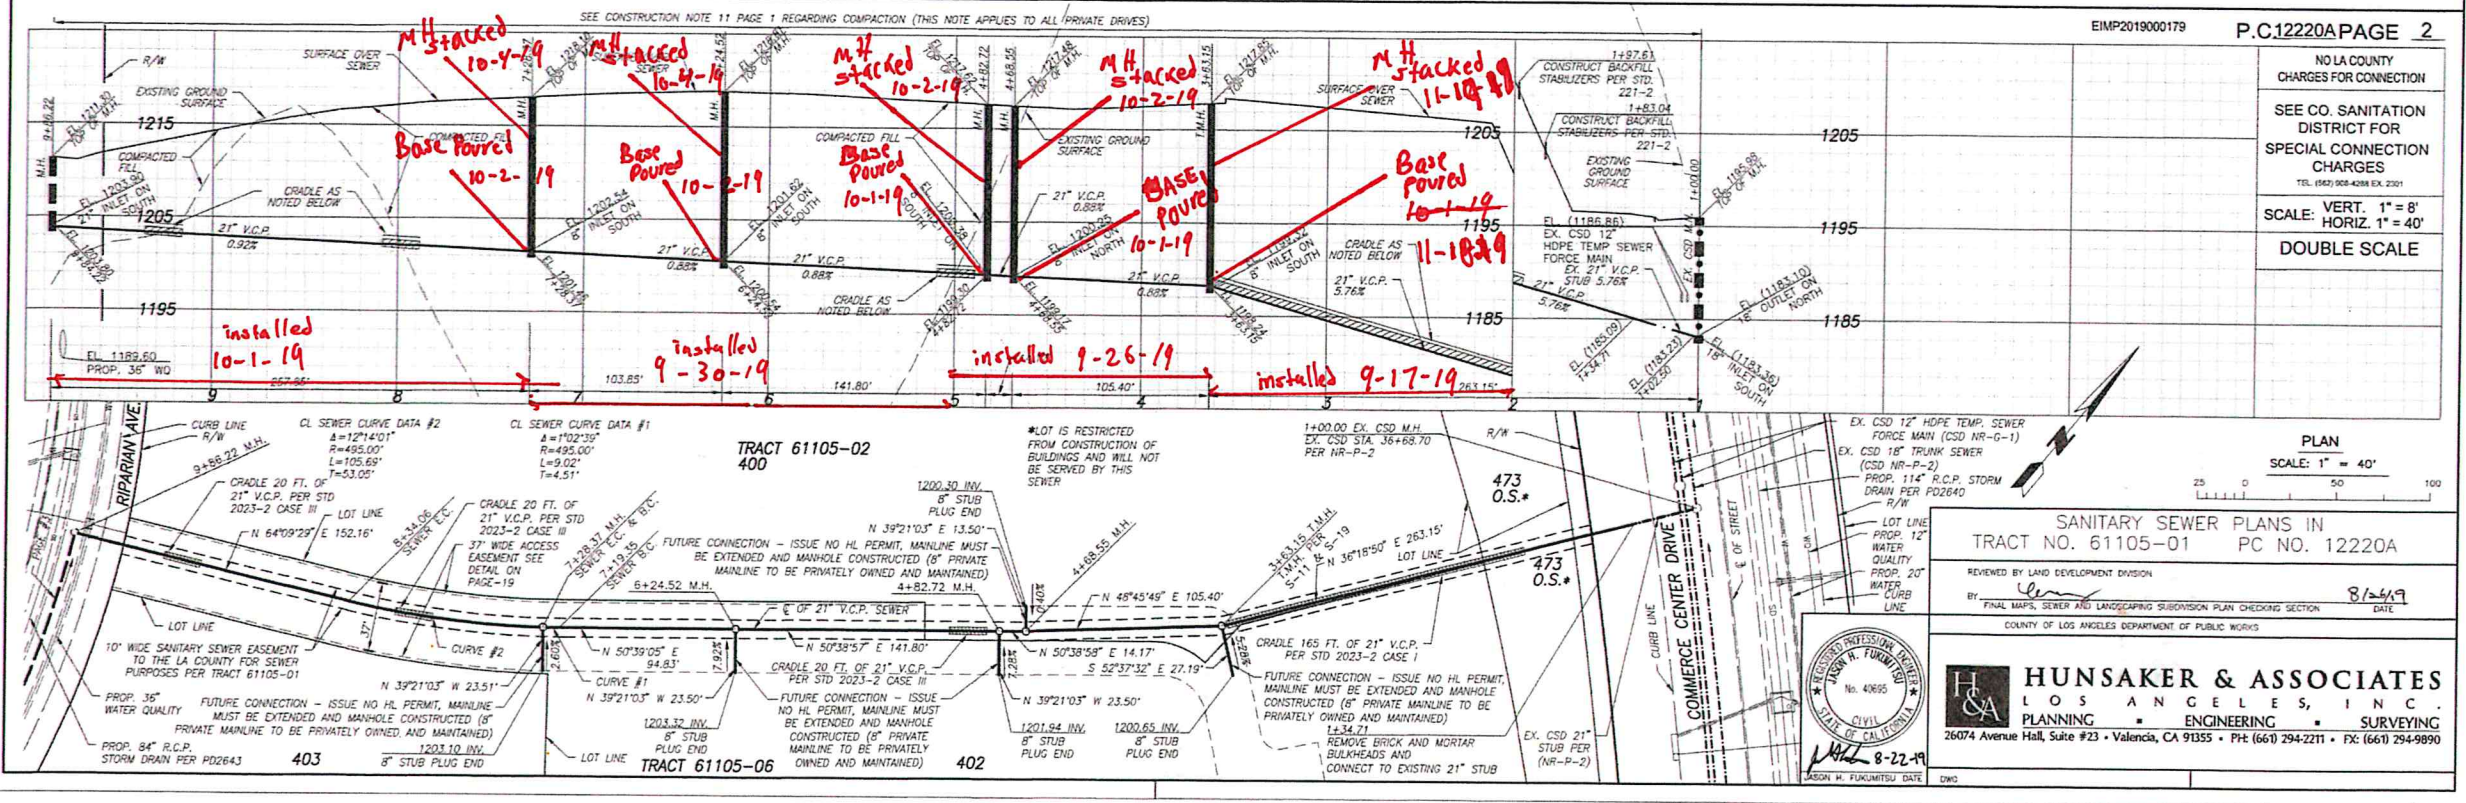

EIMP2019000179 P.C.12220A PAGE 2

NO LA COUNTY CHARGES FOR CONNECTION

SEE CO. SANITATION DISTRICT FOR SPECIAL CONNECTION CHARGES

SCALE: VERT. 1"=8'
HORIZ. 1"=40'

DOUBLE SCALE

PLAN SCALE: 1"=40'

SANITARY SEWER PLANS IN TRACT NO. 61105-01 PC NO. 12220A

REVIEWED BY LAND DEVELOPMENT DIVISION

BY [Signature] DATE: 8/24/19

COUNTY OF LOS ANGELES DEPARTMENT OF PUBLIC WORKS



HUNSAKER & ASSOCIATES

LOS ANGELES, INC.

PLANNING • ENGINEERING • SURVEYING



26074 Avenue Hill, Suite #23 • Valencia, CA 91355 • PH: (661) 294-2211 • FX: (661) 294-9890

DATE: 8-22-19

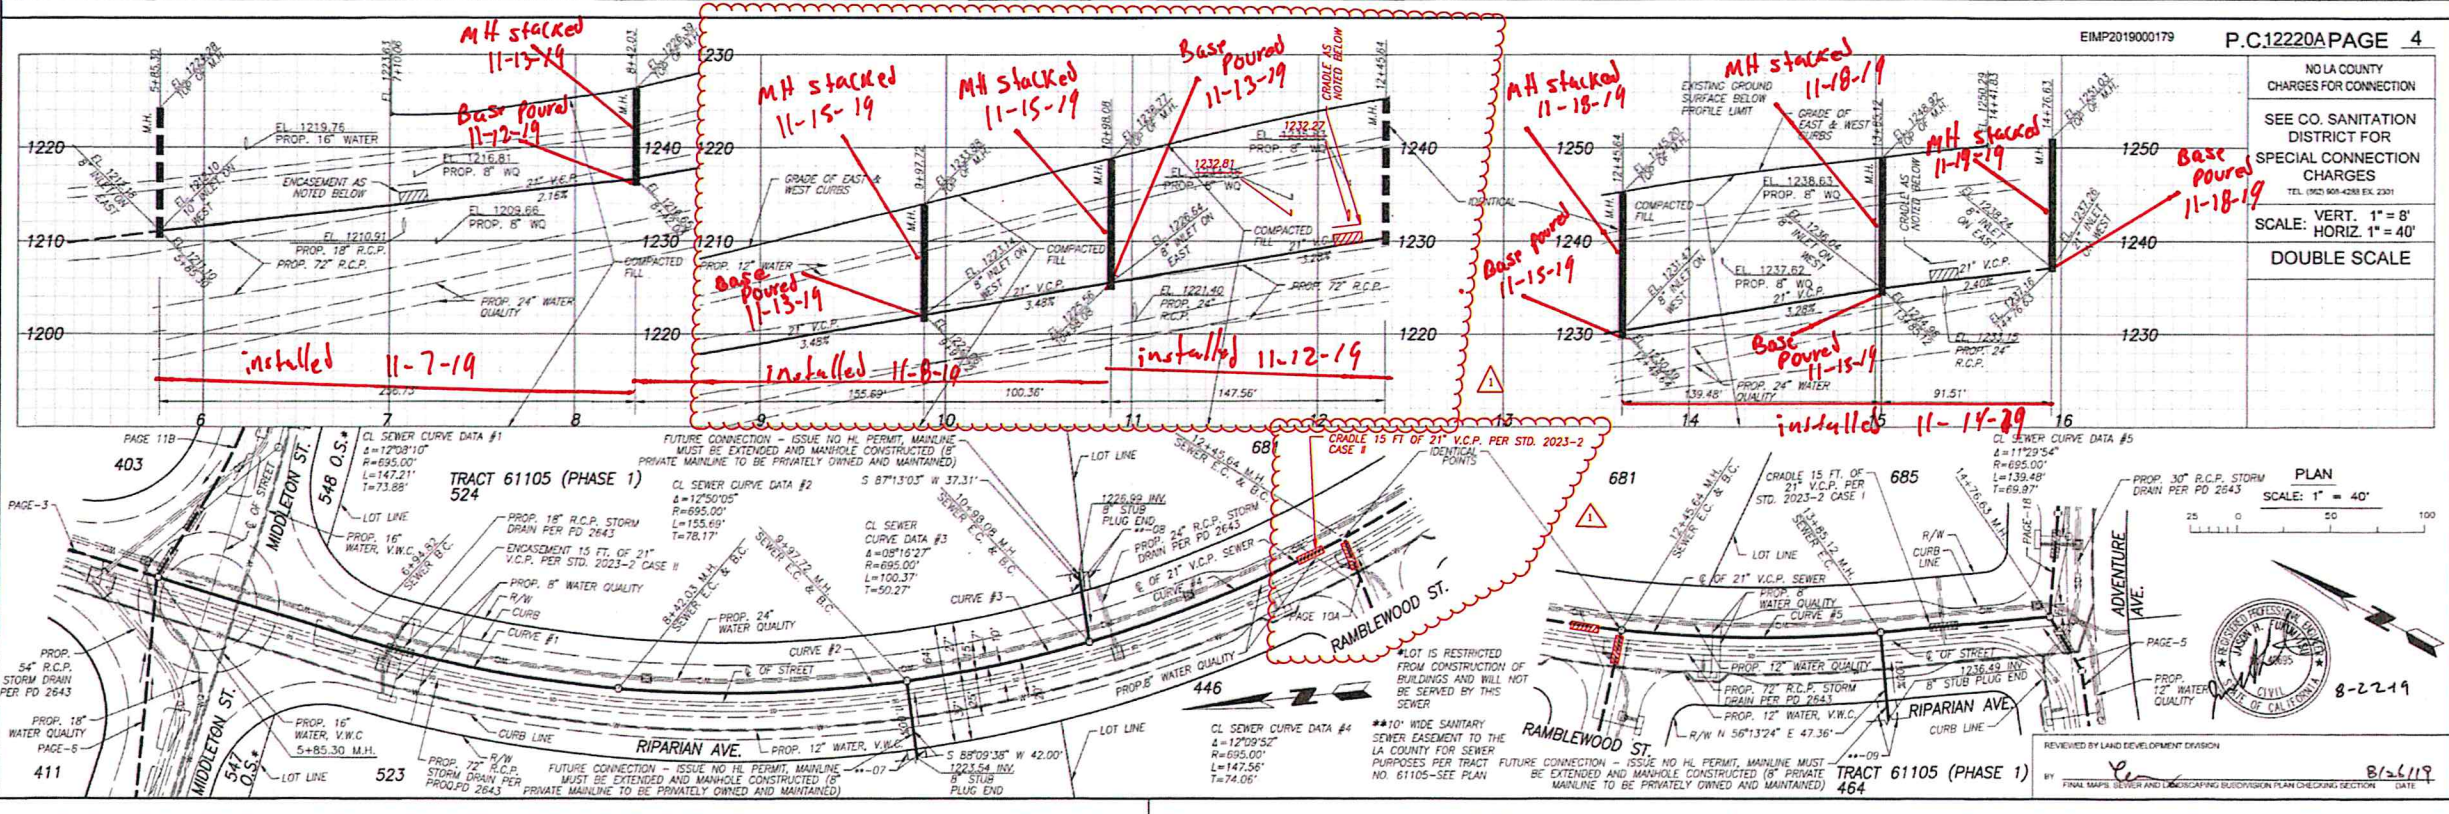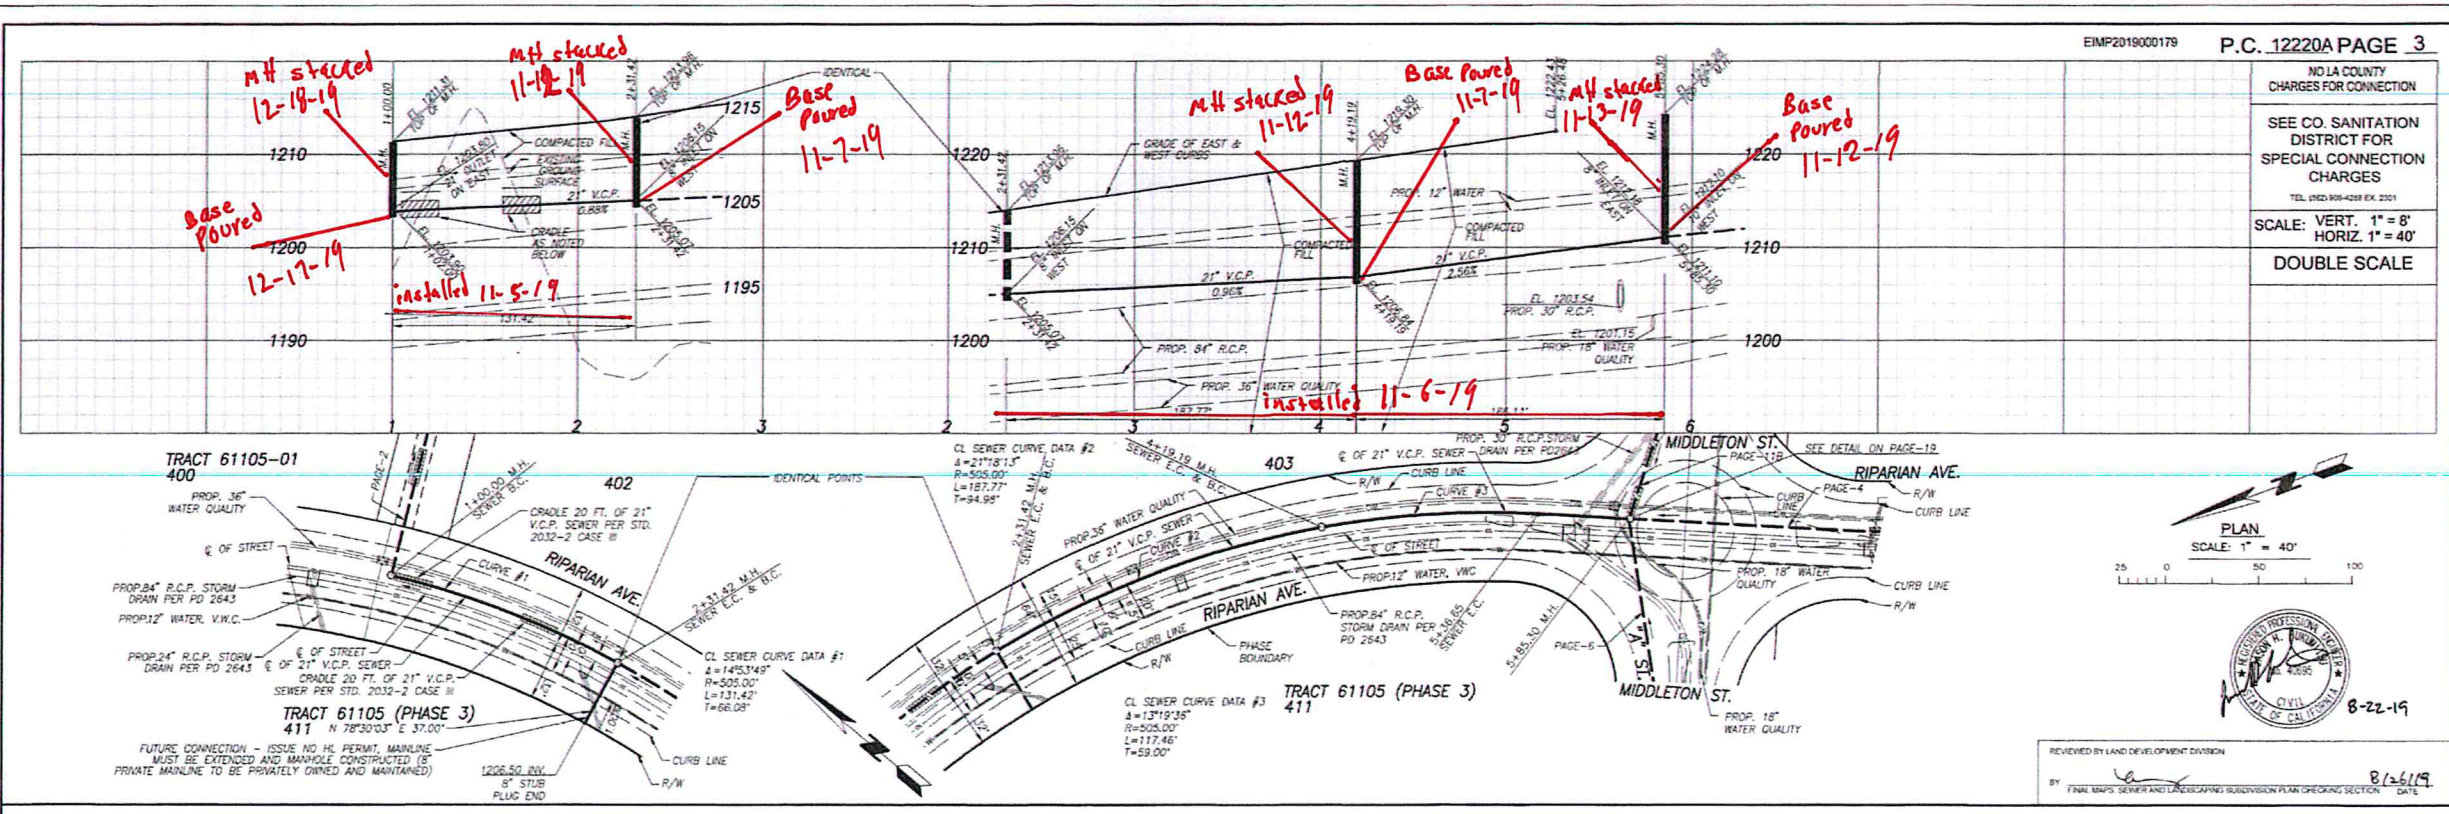


18VCL110 61102 BC 1333000


0:\Work\Bentley\B1105-01\Drawings\B1105-01\11-01\11-01-01.dwg PLOT SS 11/22/2019 4:18:11 PM CC: DO: DE: Eddy Printed On: Aug 21, 2019 9:26am by jolly

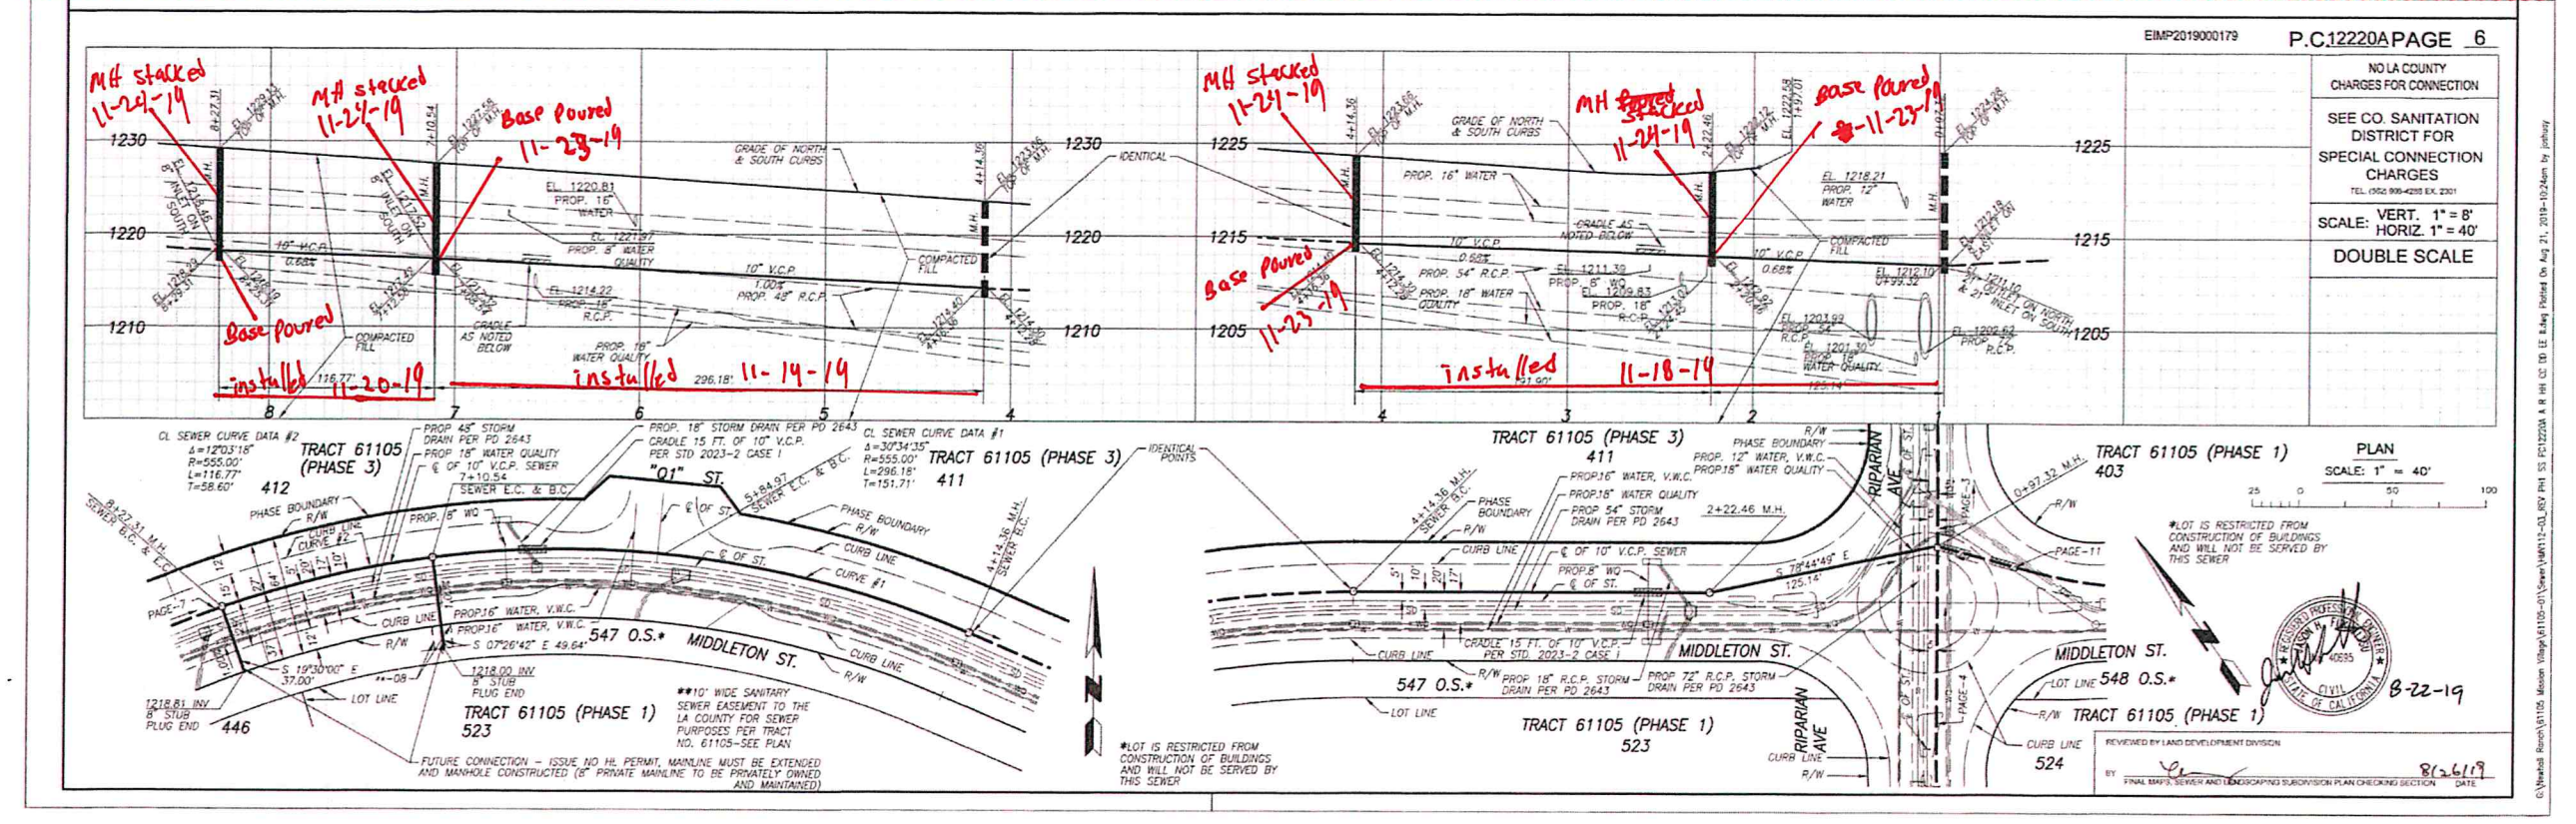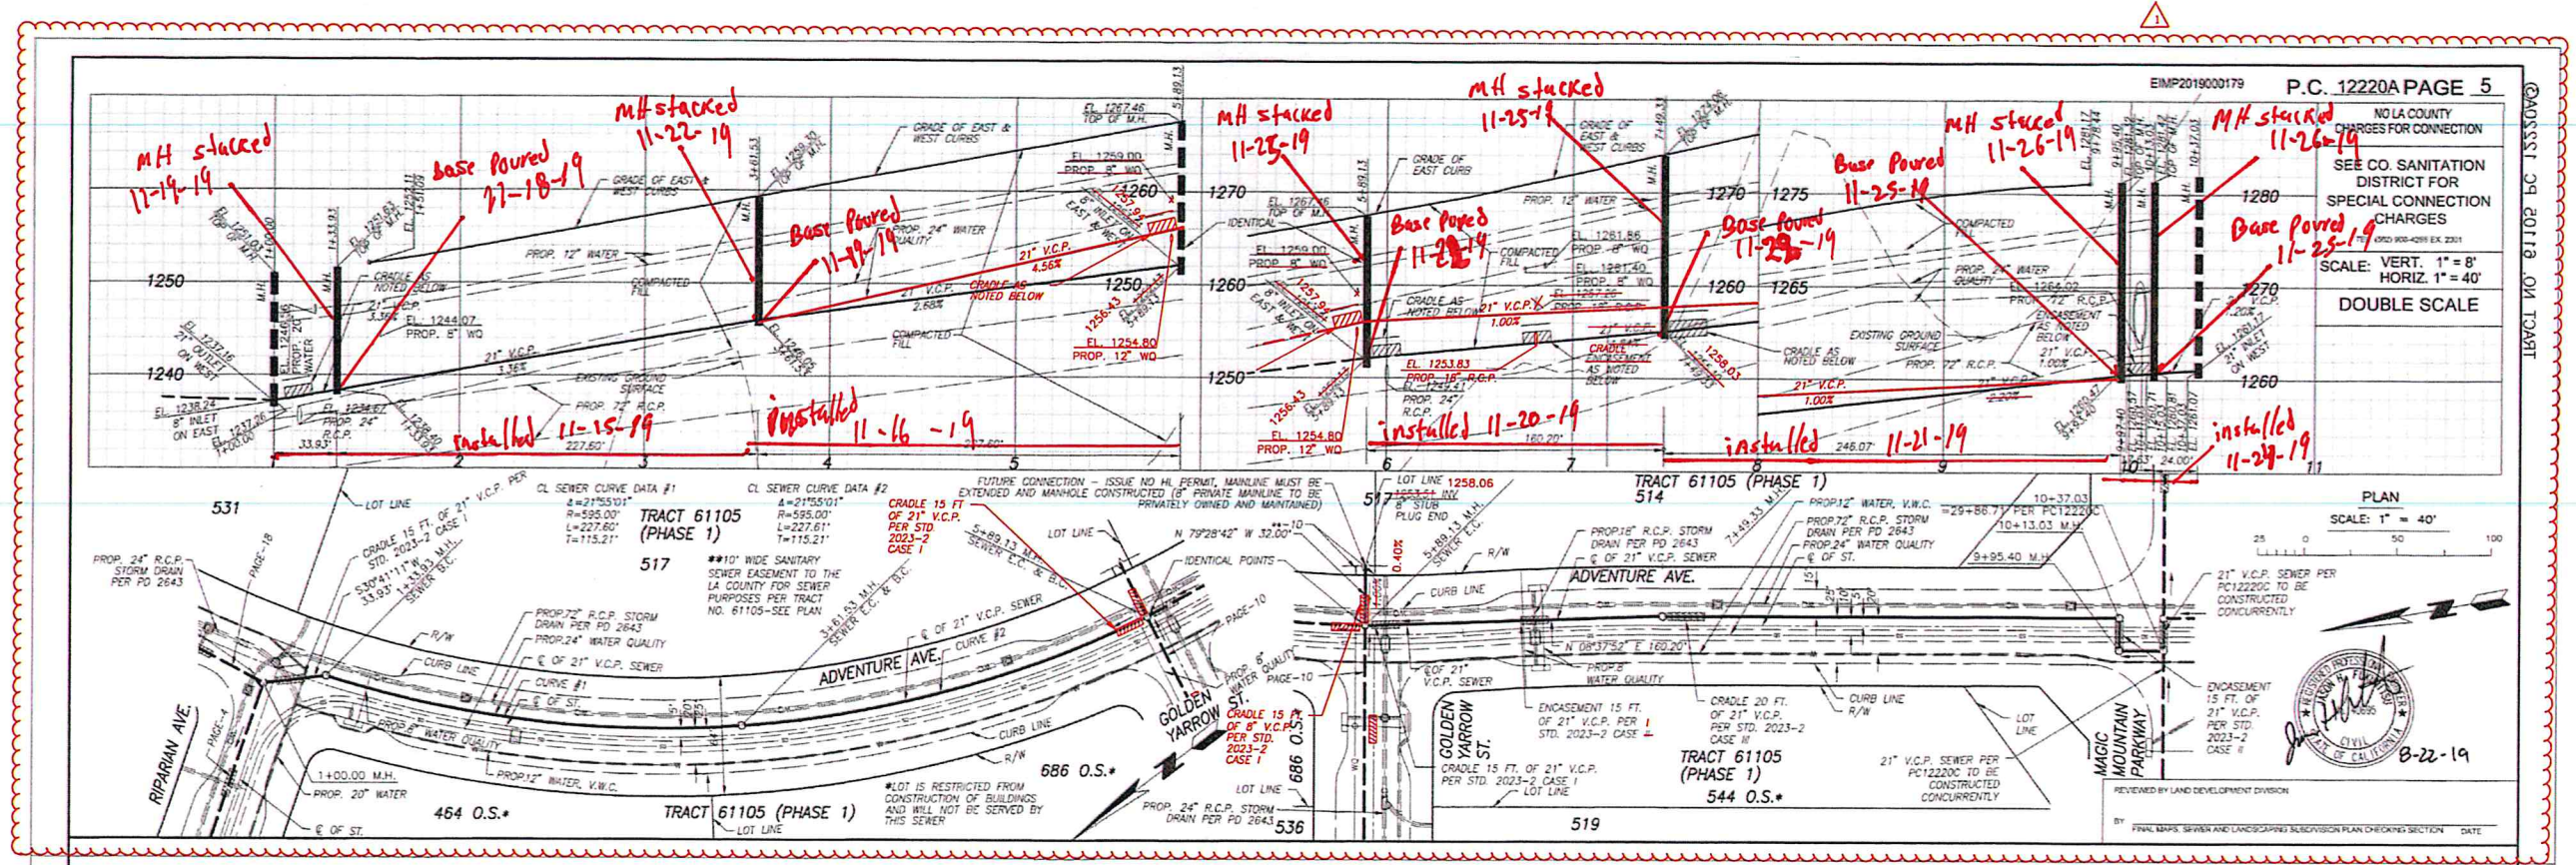

CROSS SECTION ON TRACT
 EIMP2019000179
 P.C. 12220A PAGE 5
 P.C. 12220A PAGE 6
 8-22-19
 8-26-19
 8-26-19

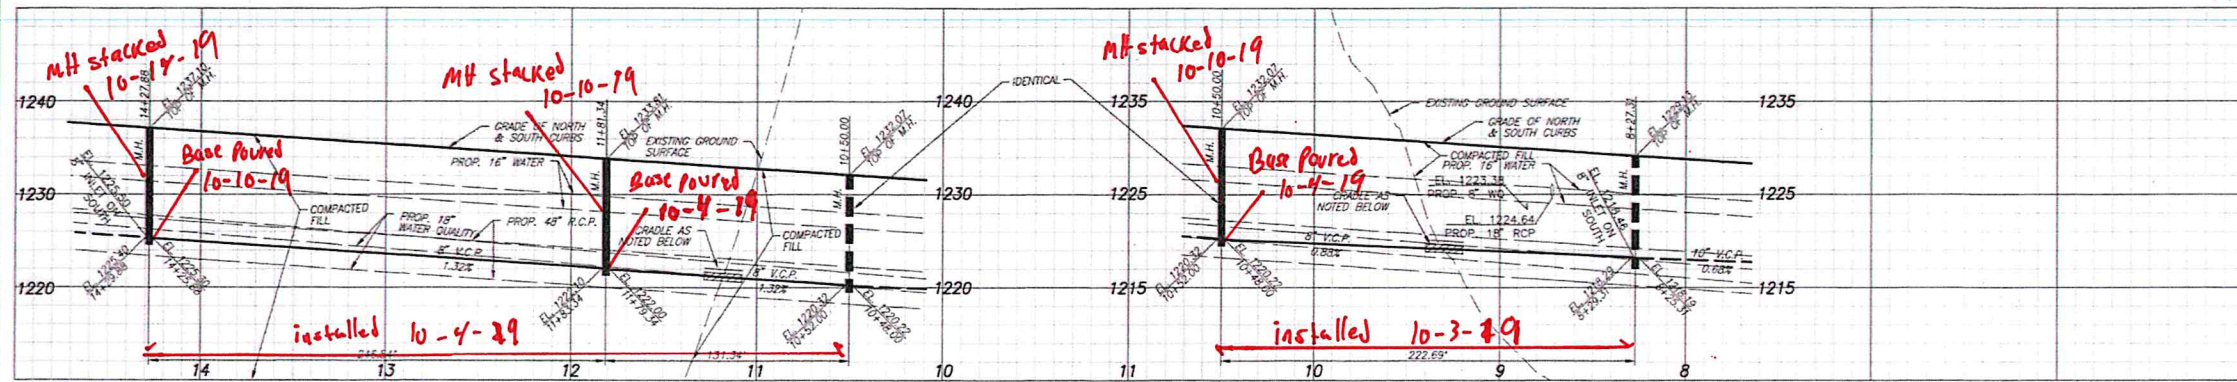


NO LA COUNTY CHARGES FOR CONNECTION
 SEE CO. SANITATION DISTRICT FOR SPECIAL CONNECTION CHARGES
 TEL: (952) 458-4288 EX. 2301
 SCALE: VERT. 1" = 8'
 HORIZ. 1" = 40'
 DOUBLE SCALE

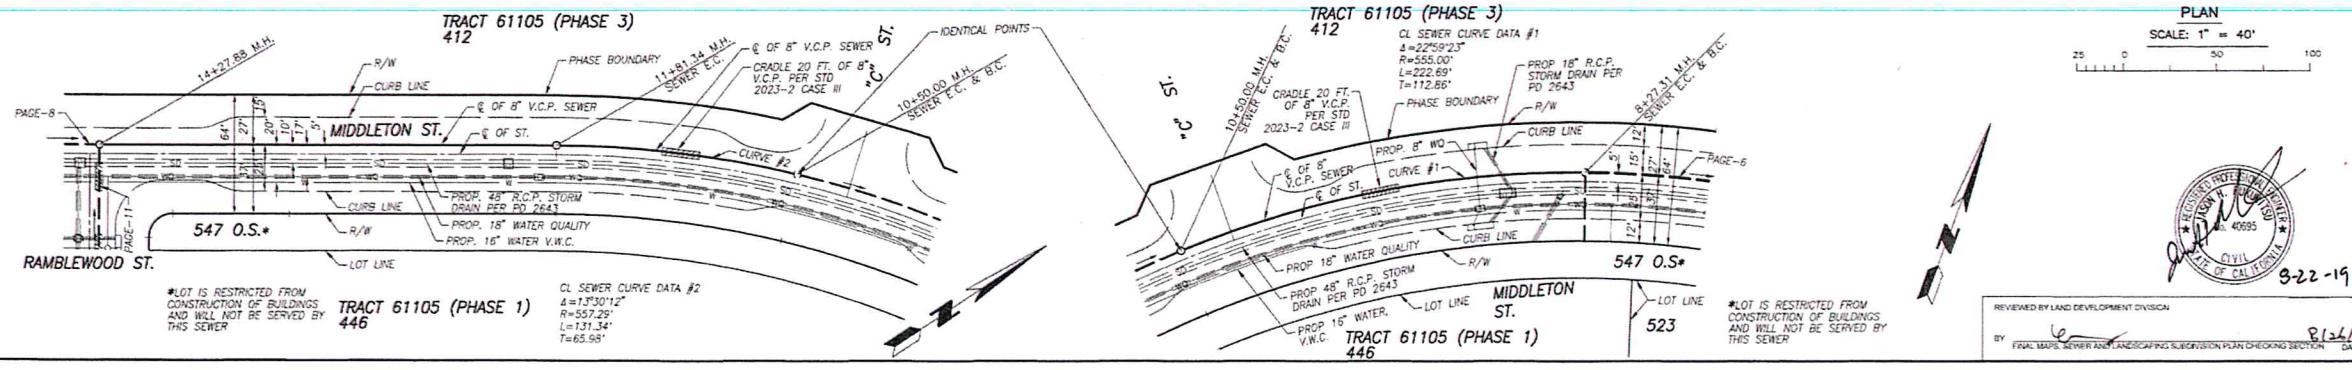


PLAN SCALE: 1" = 40'

REVIEWED BY LAND DEVELOPMENT DIVISION
 BY: [Signature] DATE: 8/22/19
 FINAL MAPS, SEWER AND LANDSCAPING SUPERVISION PLAN CHECKING SECTION

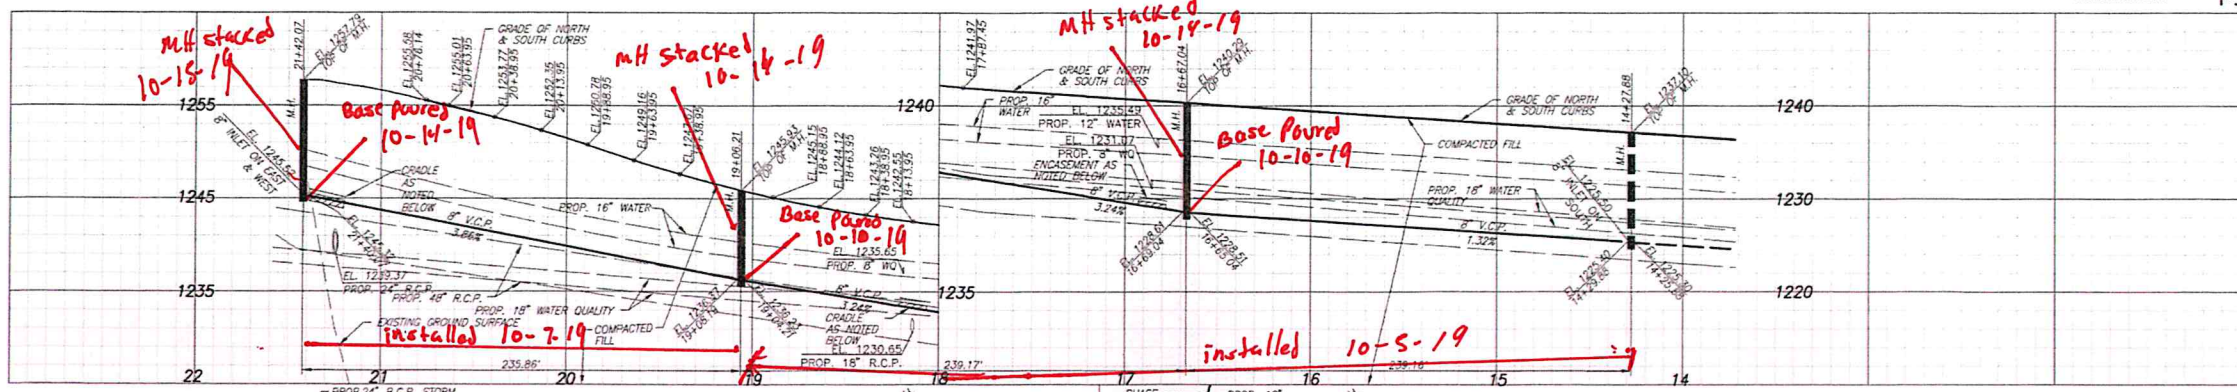


NO LA COUNTY CHARGES FOR CONNECTION
 SEE CO. SANITATION DISTRICT FOR SPECIAL CONNECTION CHARGES
 TEL: (952) 458-4288 EX. 2301
 SCALE: VERT. 1" = 8'
 HORIZ. 1" = 40'
 DOUBLE SCALE

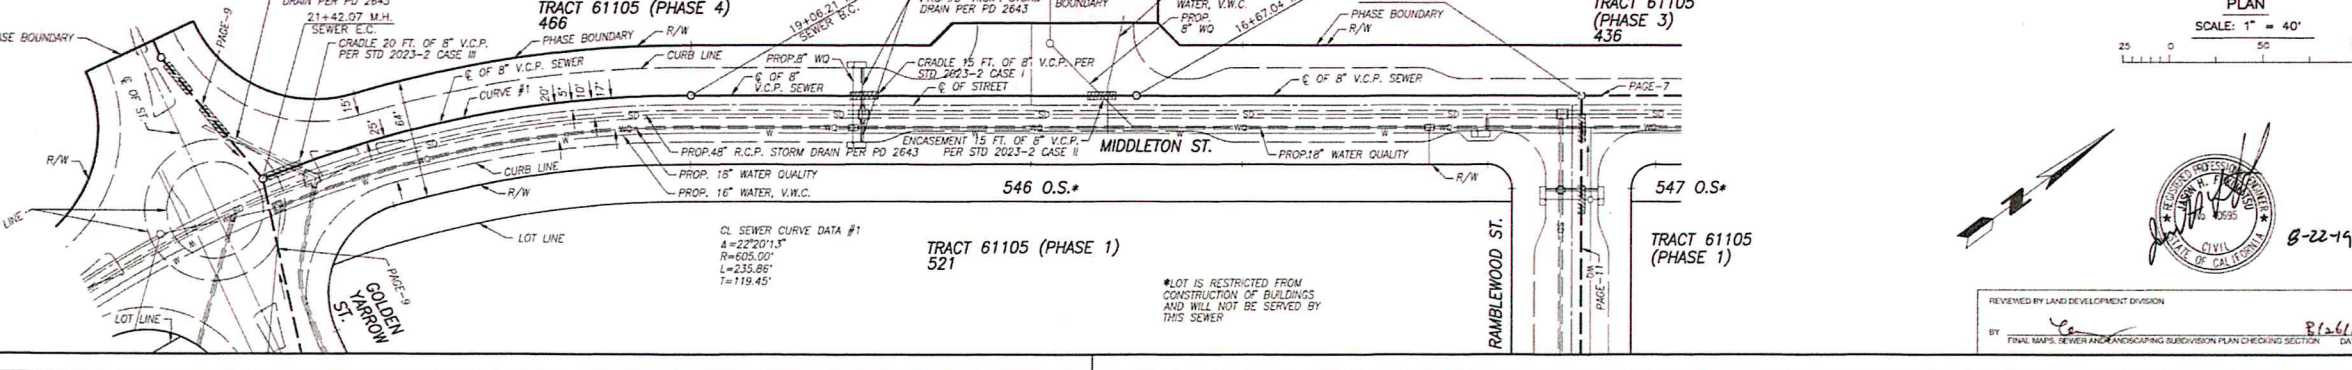


PLAN SCALE: 1" = 40'

REVIEWED BY LAND DEVELOPMENT DIVISION
 BY: [Signature] DATE: 8-22-19
 FINAL MAPS, SEWER AND LANDSCAPING SUPERVISION PLAN CHECKING SECTION


08/22/2019 11:53am by jphilly
 18VCI MO-ELTOR BC 1555062

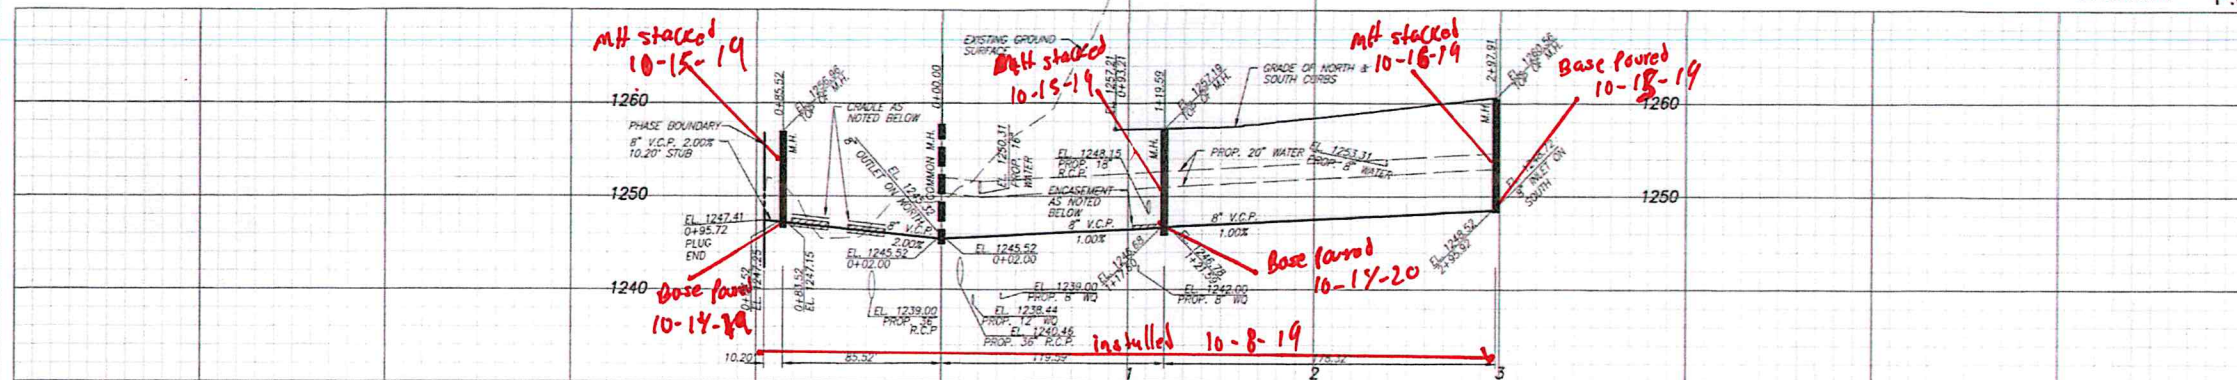


NO LA COUNTY CHARGES FOR CONNECTION
 SEE CO. SANITATION DISTRICT FOR SPECIAL CONNECTION CHARGES
 TEL. (924) 958-4281 EX. 2301
 SCALE: VERT. 1" = 8'
 HORIZ. 1" = 40'
 DOUBLE SCALE

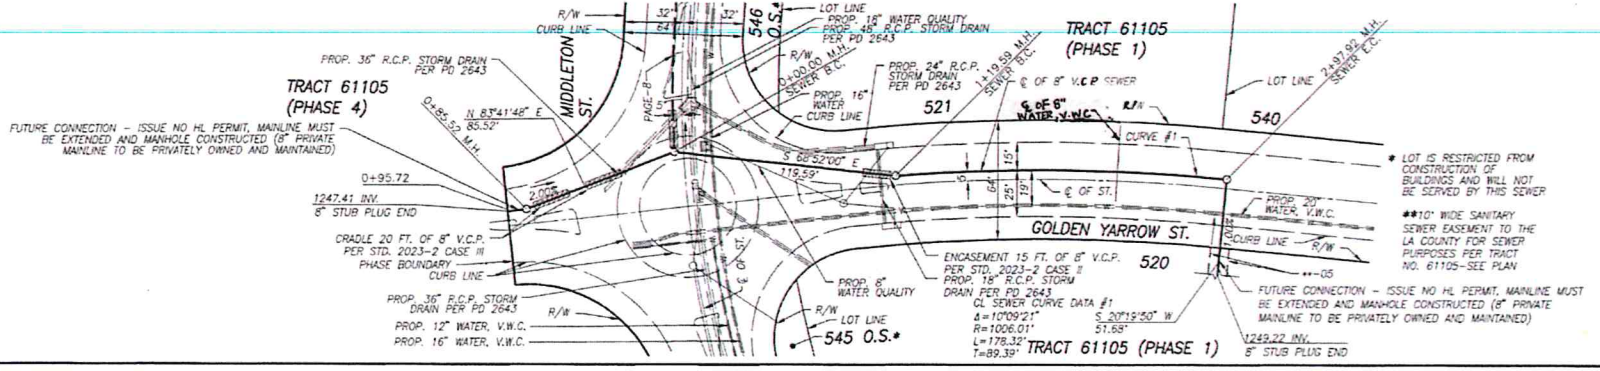

PLAN
 SCALE: 1" = 40'
 25 0 50 100
 CIVIL ENGINEER
 8-22-19
 REVIEWED BY LAND DEVELOPMENT DIVISION
 FINAL MAPS, SEWER AND LANDSCAPING SUBMISSION PLAN CHECKING SECTION
 DATE 8/26/19

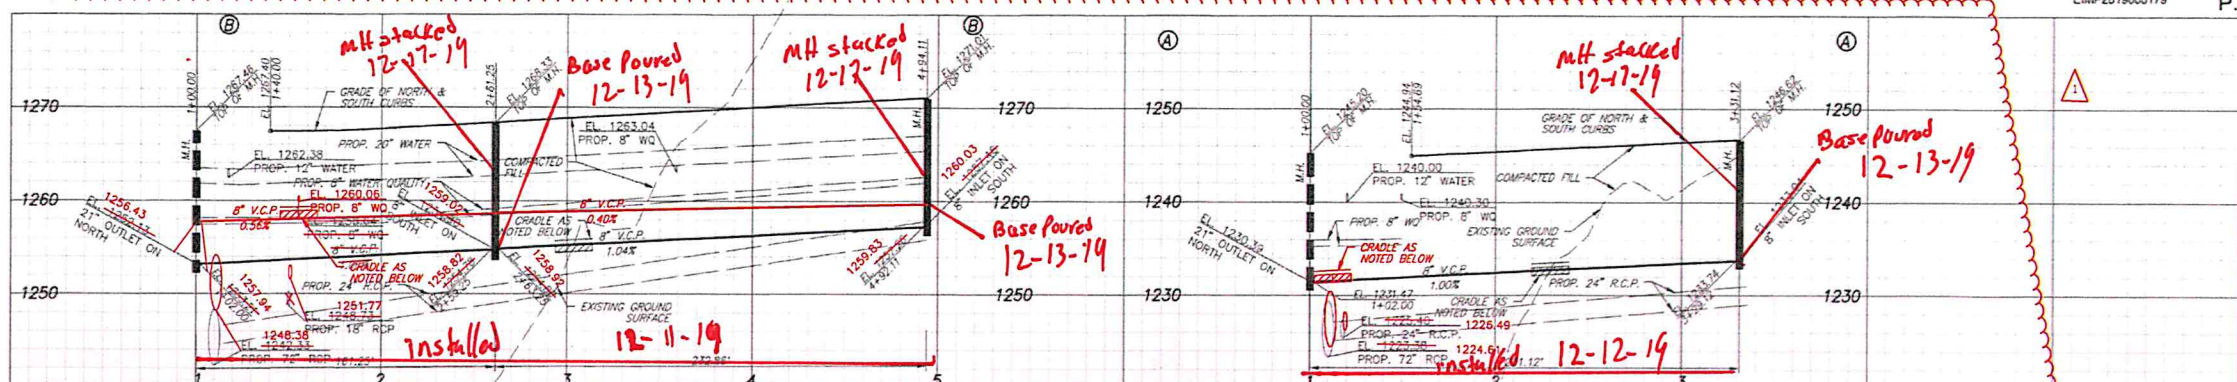


NO LA COUNTY CHARGES FOR CONNECTION
 SEE CO. SANITATION DISTRICT FOR SPECIAL CONNECTION CHARGES
 TEL. (924) 958-4281 EX. 2301
 SCALE: VERT. 1" = 8'
 HORIZ. 1" = 40'
 DOUBLE SCALE

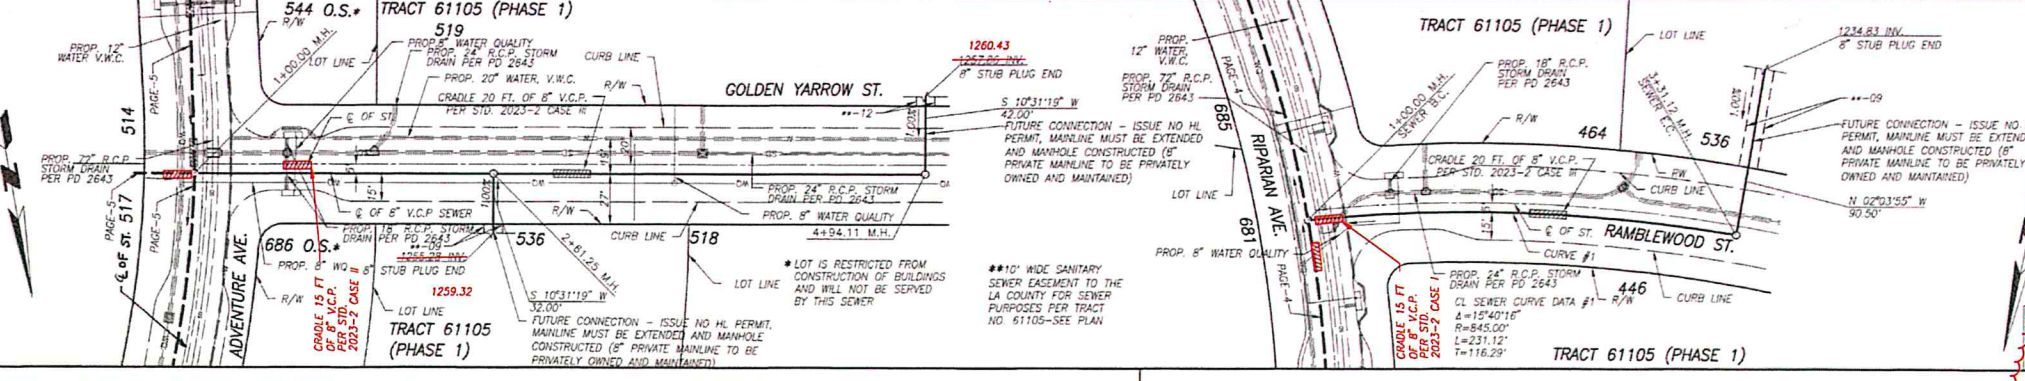

PLAN
 SCALE: 1" = 40'
 25 0 50 100
 CIVIL ENGINEER
 8-22-19
 REVIEWED BY LAND DEVELOPMENT DIVISION
 FINAL MAPS, SEWER AND LANDSCAPING SUBMISSION PLAN CHECKING SECTION
 DATE 8/26/19

© 2019 by J. J. & S. S. Engineering, Inc. All rights reserved. No part of this document may be reproduced without written permission from J. J. & S. S. Engineering, Inc.

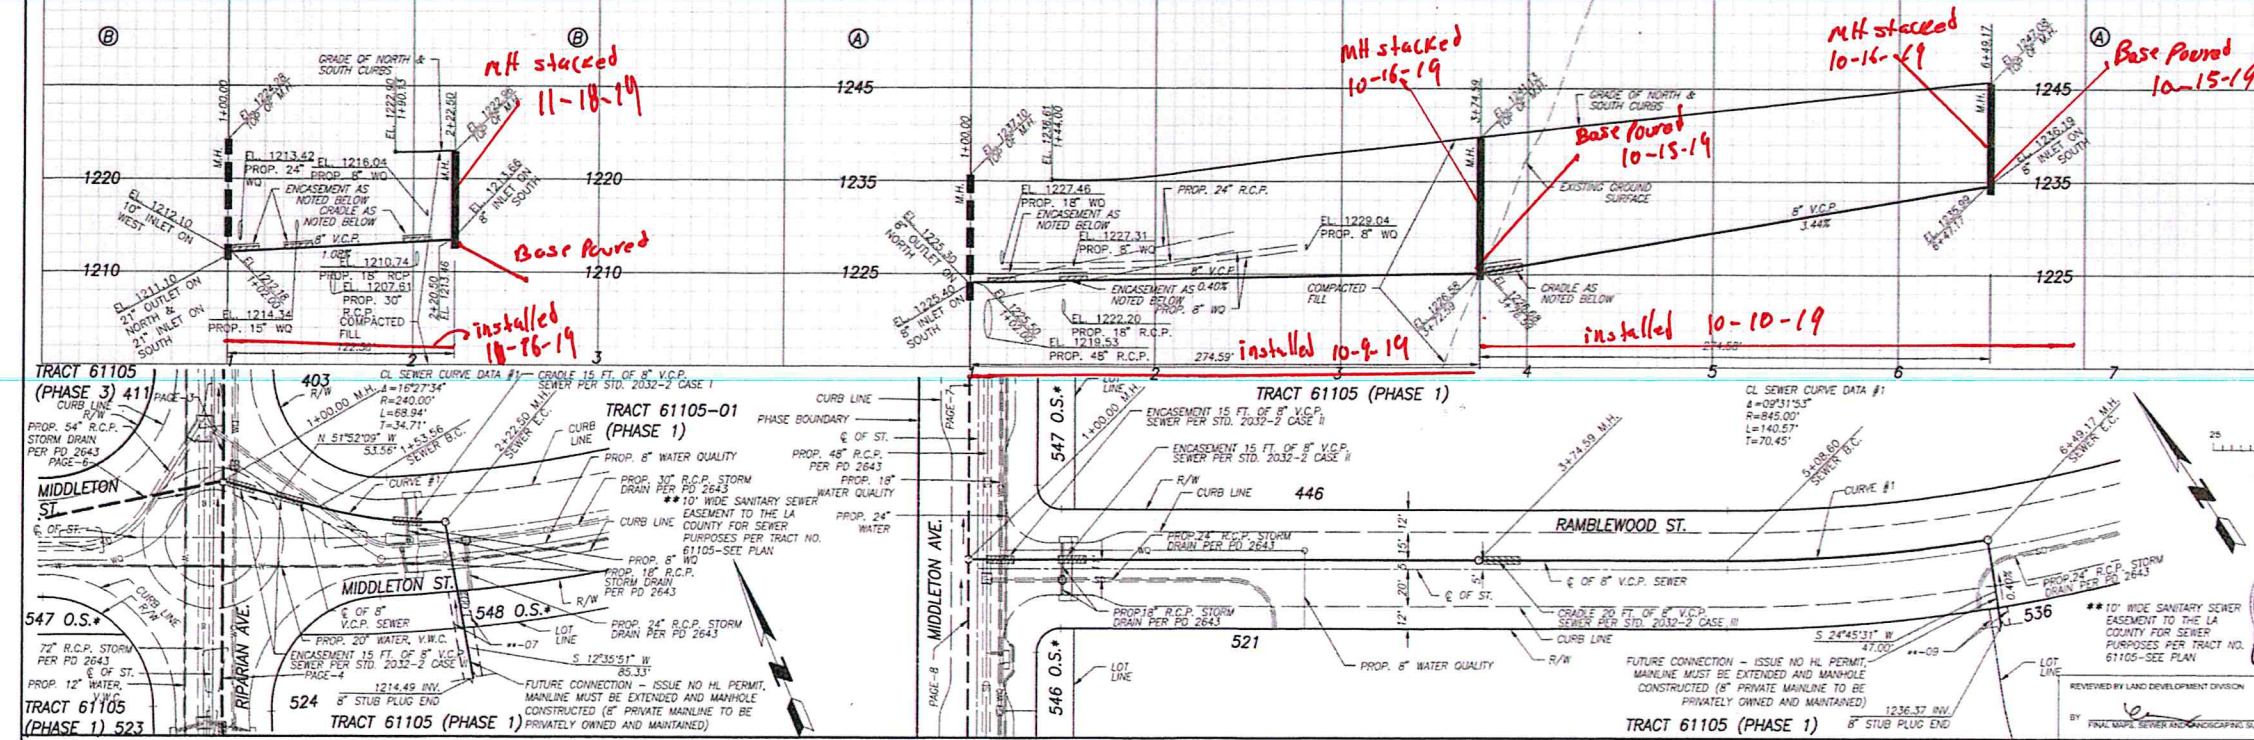


NO LA COUNTY CHARGES FOR CONNECTION
 SEE CO. SANITATION DISTRICT FOR SPECIAL CONNECTION CHARGES
 TEL. (952) 958-4218 EX. 2201
 SCALE: VERT. 1" = 8'
 HORIZ. 1" = 40'
 DOUBLE SCALE

PLAN SCALE: 1" = 40'

*LOT IS RESTRICTED FROM CONSTRUCTION OF BUILDINGS AND WILL NOT BE SERVED BY THIS SEWER

REVIEWED BY LAND DEVELOPMENT DIVISION
 BY: [Signature] DATE: 8/26/19

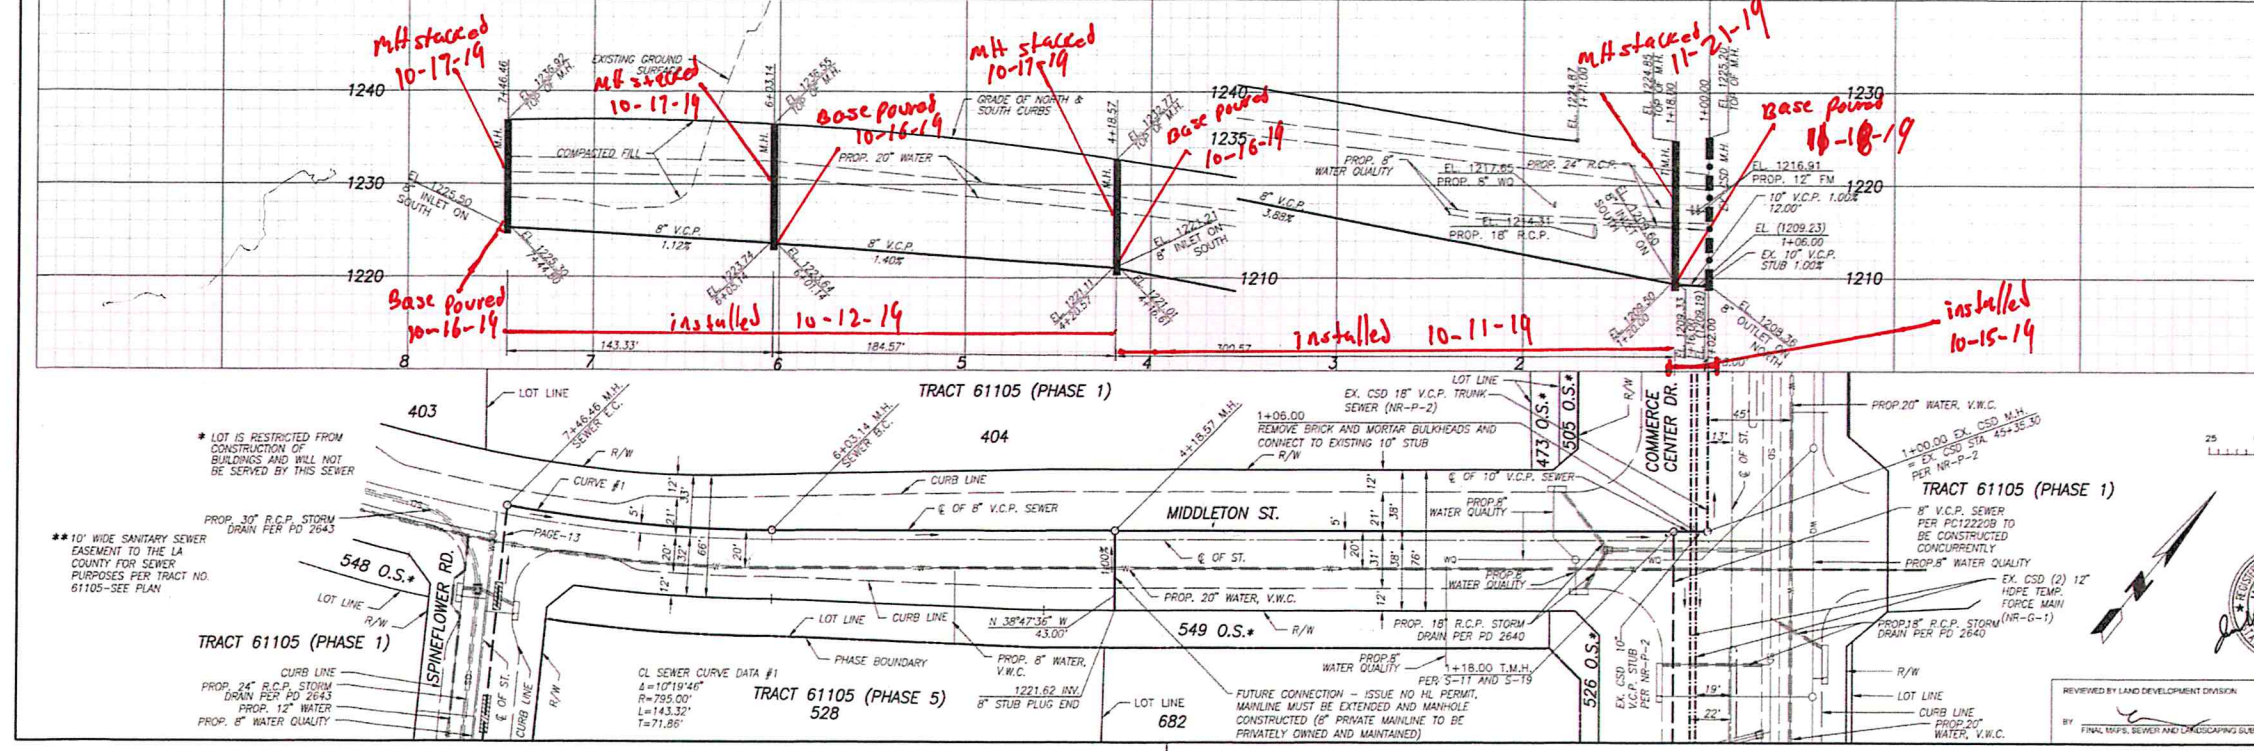


NO LA COUNTY CHARGES FOR CONNECTION
 SEE CO. SANITATION DISTRICT FOR SPECIAL CONNECTION CHARGES
 TEL. (952) 958-4218 EX. 2201
 SCALE: VERT. 1" = 8'
 HORIZ. 1" = 40'
 DOUBLE SCALE

PLAN SCALE: 1" = 40'


*LOT IS RESTRICTED FROM CONSTRUCTION OF BUILDINGS AND WILL NOT BE SERVED BY THIS SEWER

REVIEWED BY LAND DEVELOPMENT DIVISION
 BY: [Signature] DATE: 8/26/19

12/22/2019 10:11:00 AM
 C:\Users\Reed\Documents\61105-01\Sanitary\61105-01_Sanitary\61105-01_Sanitary.dwg
 PLOT: 12220A.PAGE 11
 PLOT: 12220A.PAGE 12
 PLOT: 12220A.PAGE 13
 PLOT: 12220A.PAGE 100

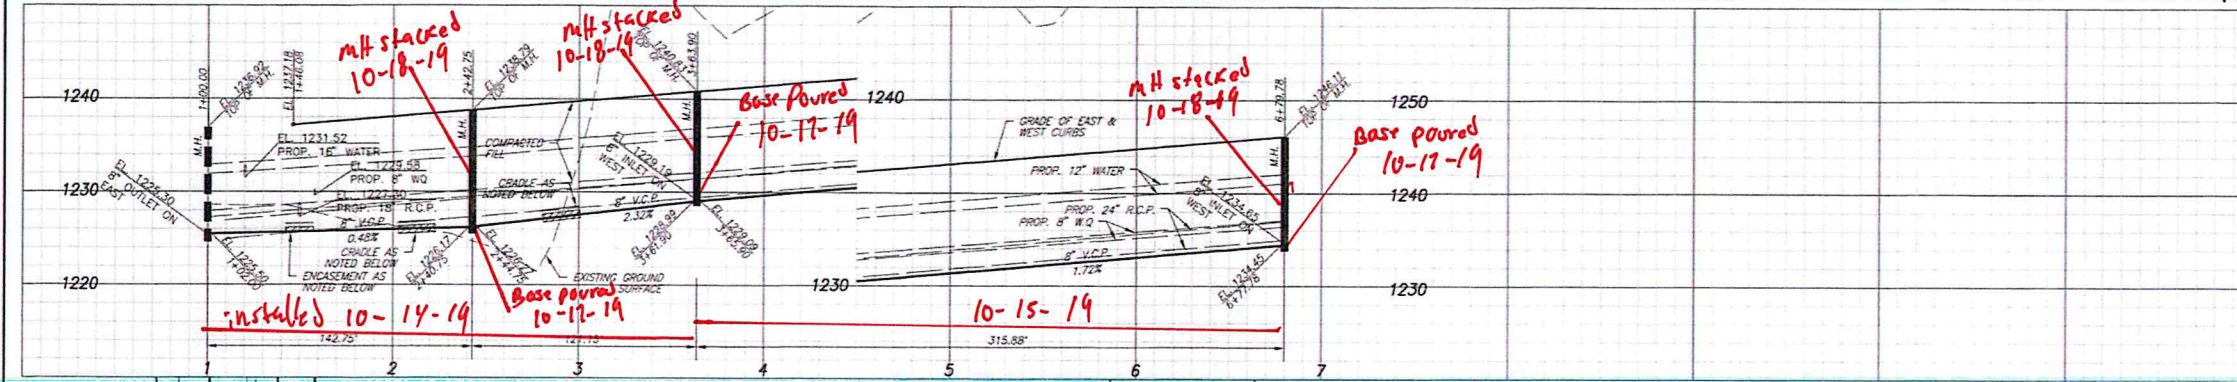


NO LA COUNTY CHARGES FOR CONNECTION
 SEE CO. SANITATION DISTRICT FOR SPECIAL CONNECTION CHARGES
 TEL: (562) 959-4388 EX. 2301
 SCALE: VERT. 1" = 8'
 HORIZ. 1" = 40'
 DOUBLE SCALE

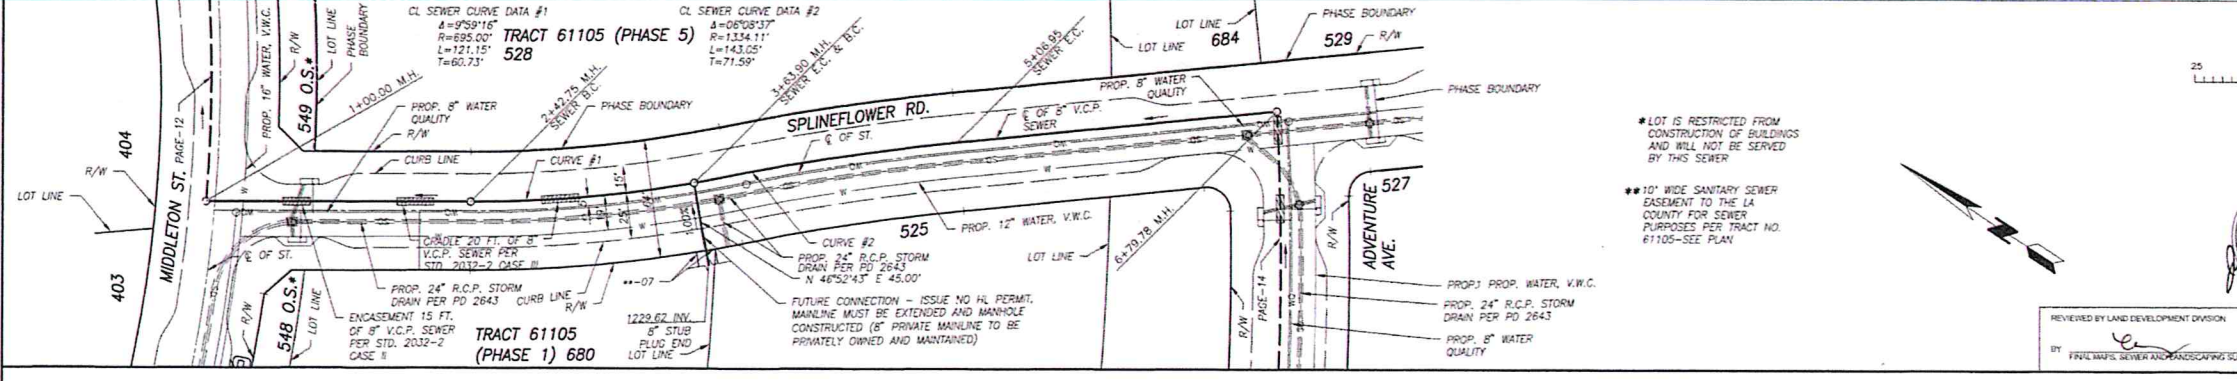


NO LA COUNTY CHARGES FOR CONNECTION
 SEE CO. SANITATION DISTRICT FOR SPECIAL CONNECTION CHARGES
 TEL: (562) 959-4388 EX. 2301
 SCALE: VERT. 1" = 8'
 HORIZ. 1" = 40'
 DOUBLE SCALE

REVIEWED BY LAND DEVELOPMENT DIVISION
 BY: [Signature] DATE: 8/26/19

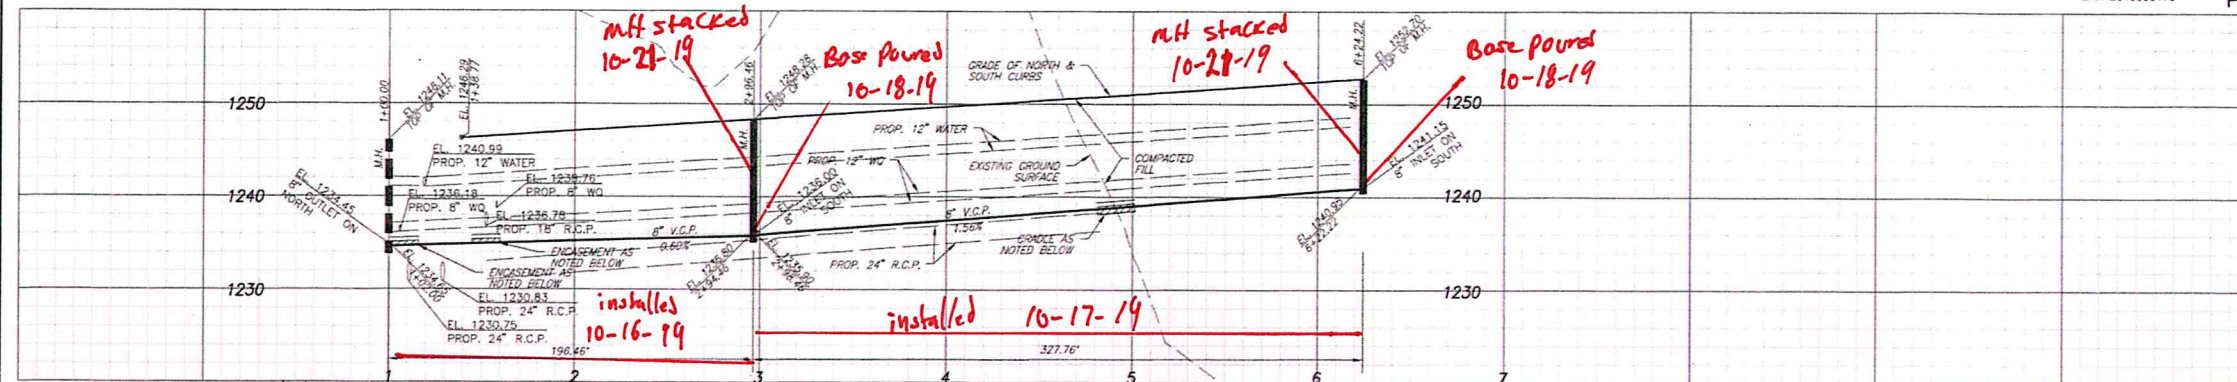


NO LA COUNTY CHARGES FOR CONNECTION
 SEE CO. SANITATION DISTRICT FOR SPECIAL CONNECTION CHARGES
 TEL: (562) 959-4388 EX. 2301
 SCALE: VERT. 1" = 8'
 HORIZ. 1" = 40'
 DOUBLE SCALE

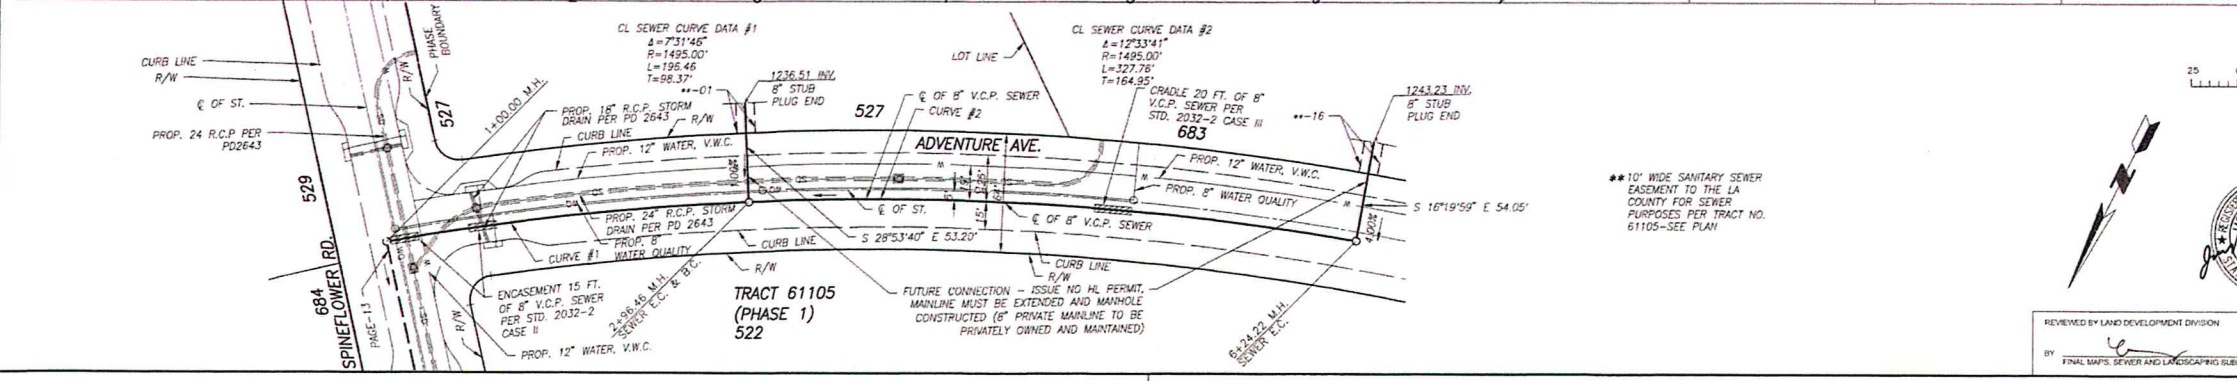


NO LA COUNTY CHARGES FOR CONNECTION
 SEE CO. SANITATION DISTRICT FOR SPECIAL CONNECTION CHARGES
 TEL: (562) 959-4388 EX. 2301
 SCALE: VERT. 1" = 8'
 HORIZ. 1" = 40'
 DOUBLE SCALE

REVIEWED BY LAND DEVELOPMENT DIVISION
 BY: [Signature] DATE: 8/26/19


CROSS SECTION 10119 ON TRACT
 © Veritas Beach/61105 Mission Village/61105-01/Sewer/61105-07_Plan_P13 P14 P15 P16 P100
 2019-11-16, 11:50 AM by jphayes

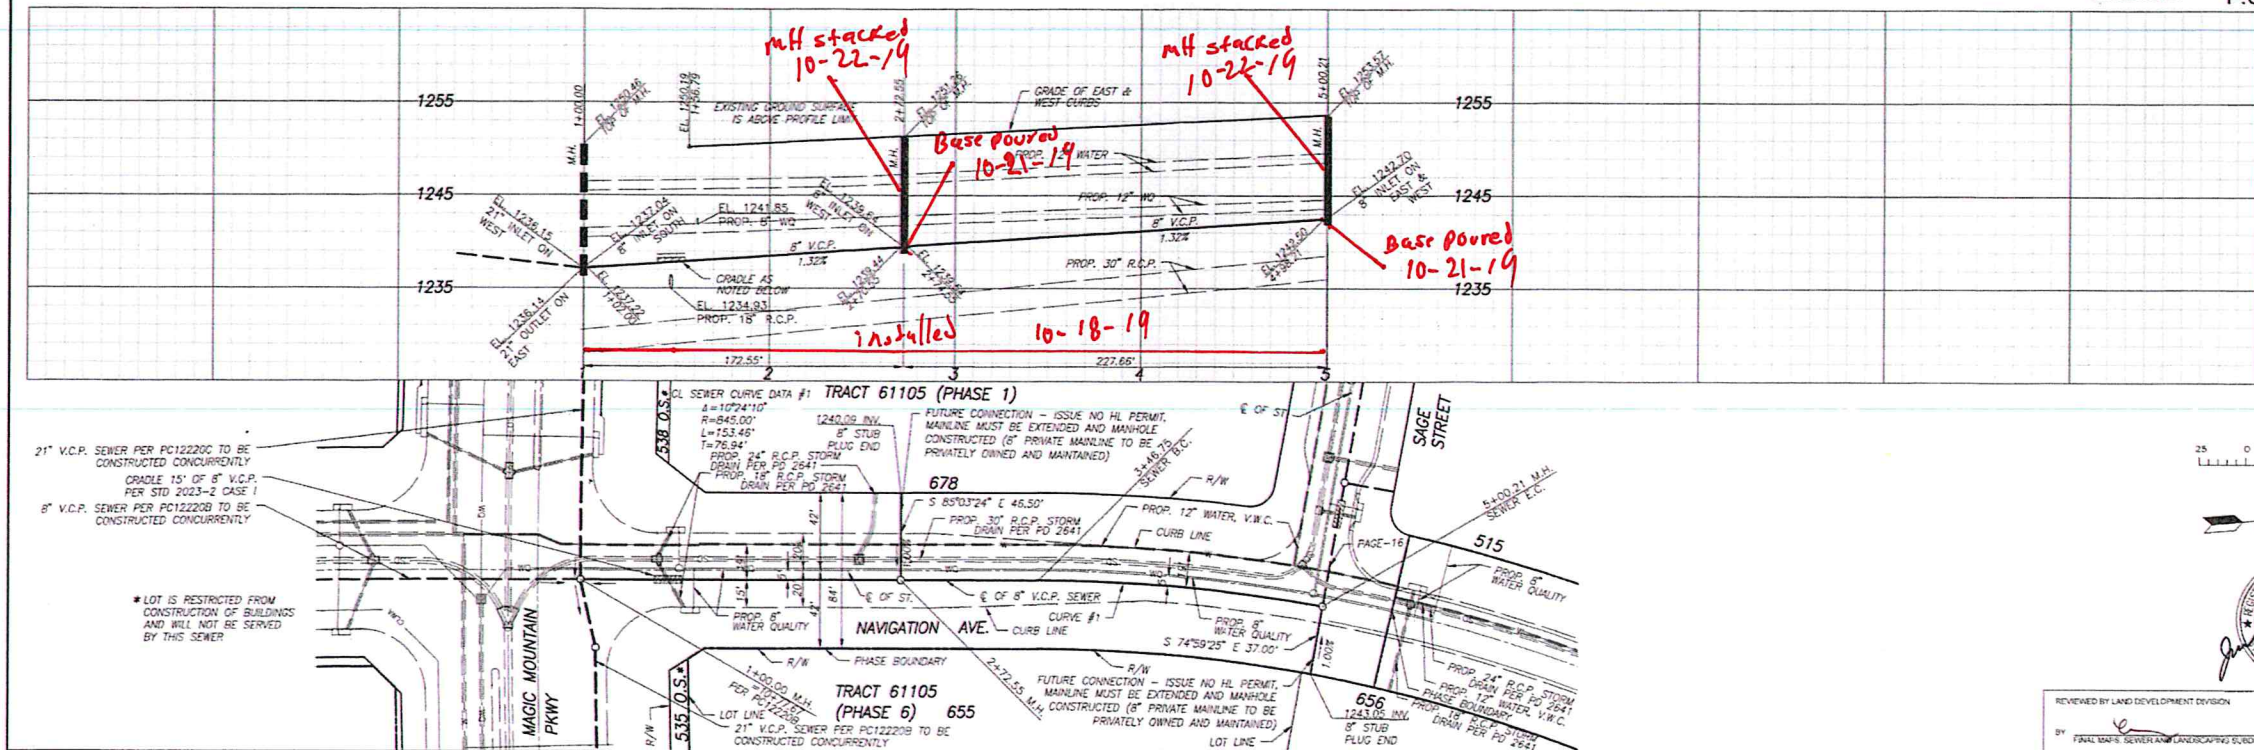


NO LA COUNTY CHARGES FOR CONNECTION
 SEE CO. SANITATION DISTRICT FOR SPECIAL CONNECTION CHARGES
 TEL. (924) 908-4208 EX. 2301
 SCALE: VERT. 1" = 8'
 HORIZ. 1" = 40'
 DOUBLE SCALE

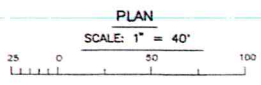

REVIEWED BY LAND DEVELOPMENT DIVISION
 BY: [Signature] DATE: 8/26/19

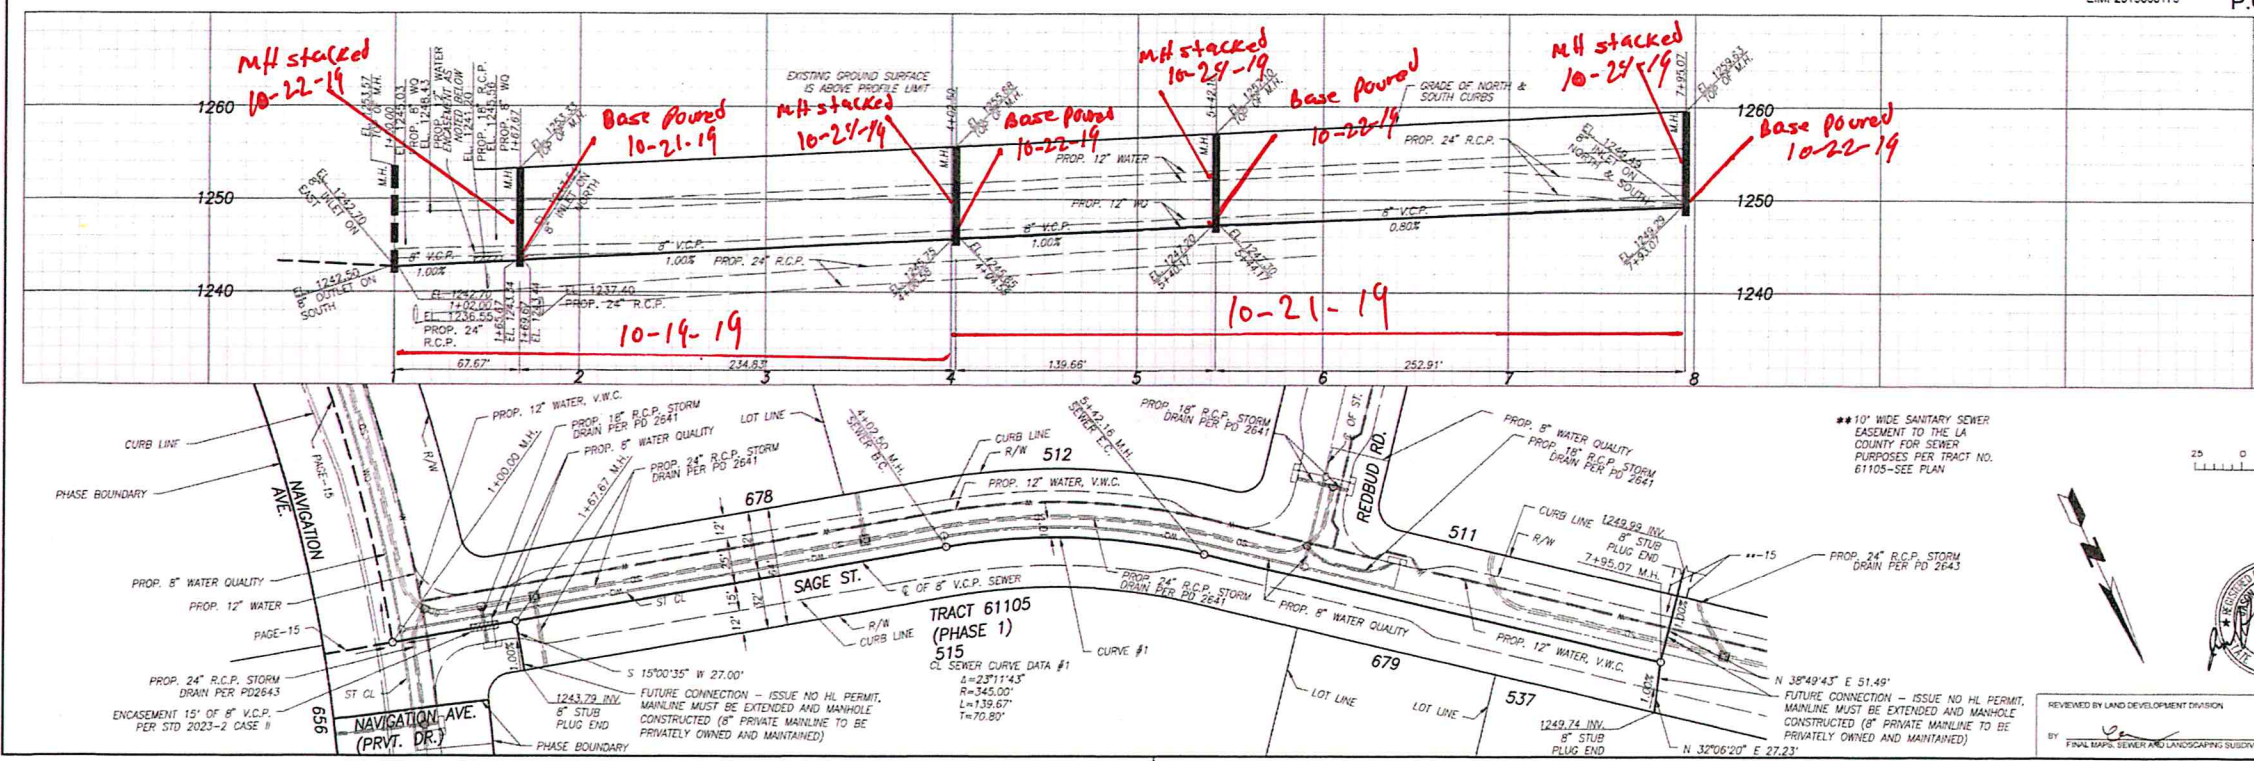


NO LA COUNTY CHARGES FOR CONNECTION
 SEE CO. SANITATION DISTRICT FOR SPECIAL CONNECTION CHARGES
 TEL. (924) 908-4208 EX. 2301
 SCALE: VERT. 1" = 8'
 HORIZ. 1" = 40'
 DOUBLE SCALE

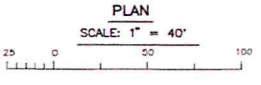

REVIEWED BY LAND DEVELOPMENT DIVISION
 BY: [Signature] DATE: 8/26/19

LIBVCI NO 01102 EC 1335000

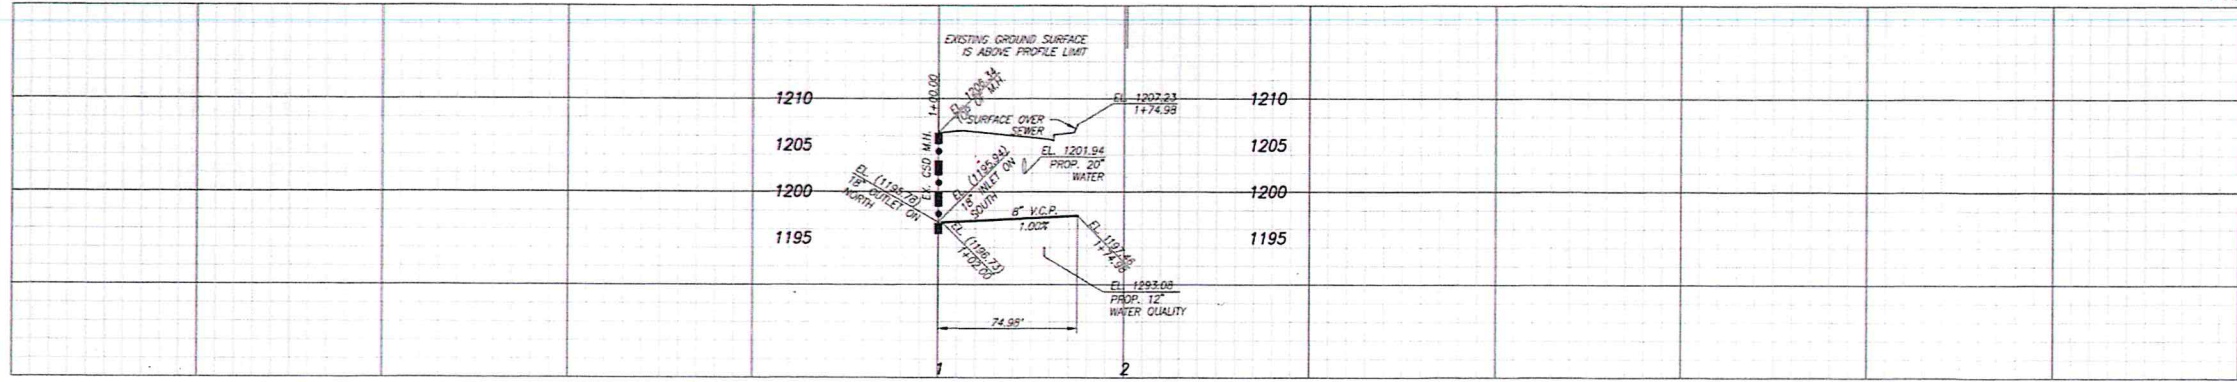


NO LA COUNTY CHARGES FOR CONNECTION

SEE CO. SANITATION DISTRICT FOR SPECIAL CONNECTION CHARGES

TEL. (562) 908-4288 EX. 2301

SCALE: VERT. 1" = 8'
HORIZ. 1" = 40'

DOUBLE SCALE

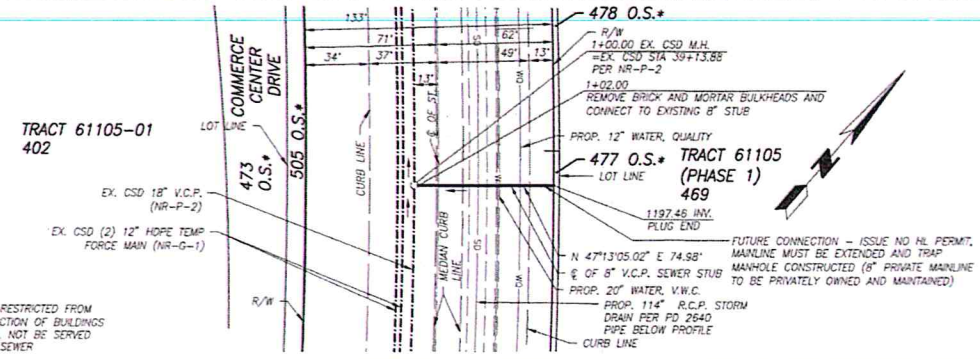

PLAN SCALE: 1" = 40'




REVIEWED BY LAND DEVELOPMENT DIVISION

BY: [Signature] DATE: 8/26/19

FINAL MAPS, SEWER AND LANDSCAPING SUBDIVISION PLAN CHECKING SECTION

*LOT IS RESTRICTED FROM CONSTRUCTION OF BUILDINGS AND WILL NOT BE SERVED BY THIS SEWER

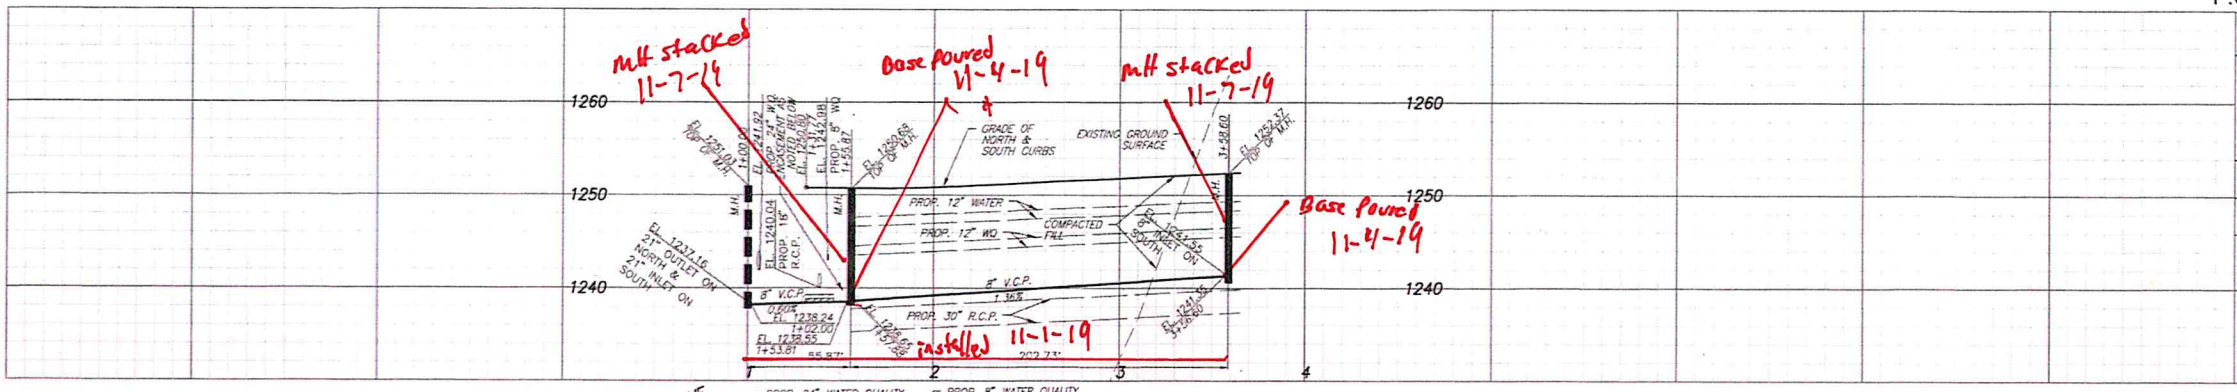


NO LA COUNTY CHARGES FOR CONNECTION

SEE CO. SANITATION DISTRICT FOR SPECIAL CONNECTION CHARGES

TEL. (562) 908-4288 EX. 2301

SCALE: VERT. 1" = 8'
HORIZ. 1" = 40'

DOUBLE SCALE

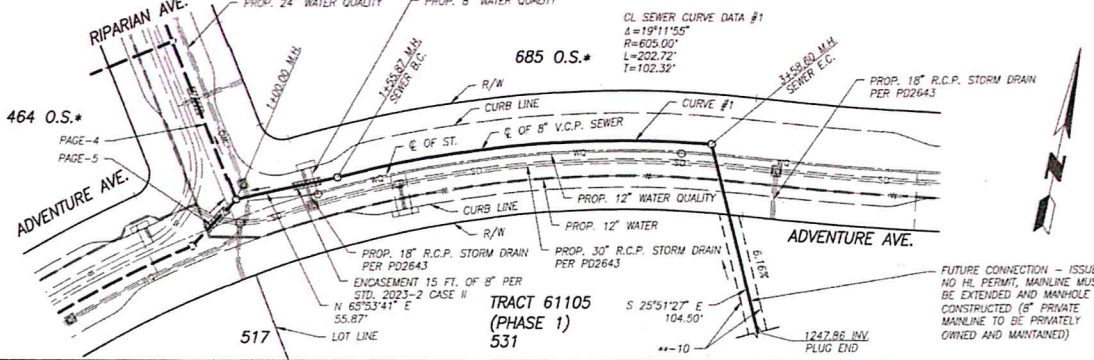

PLAN SCALE: 1" = 40'




REVIEWED BY LAND DEVELOPMENT DIVISION

BY: [Signature] DATE: 8/26/19

FINAL MAPS, SEWER AND LANDSCAPING SUBDIVISION PLAN CHECKING SECTION

*LOT IS RESTRICTED FROM CONSTRUCTION OF BUILDINGS AND WILL NOT BE SERVED BY THIS SEWER


© Vertical Research (11/10), Wilson, Whipple (11/10-01) (Seam) (11/11-09), JEV (PH) SS (12/22/20) A R (H) CD CD EE 8:44p Printed On Aug 21, 2019 - 11:56am by dwp

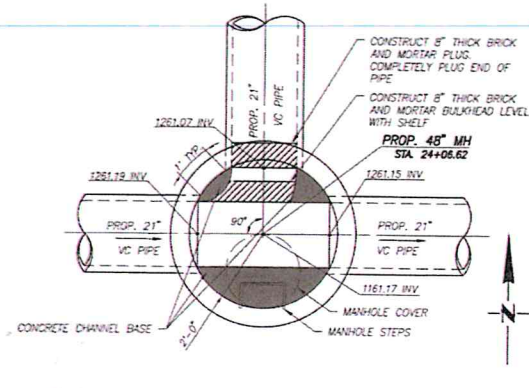


INTERIM CONDITION
(SEWAGE FLOWS INTO EAST PIPE)

MODIFIED MH BASE AT STA. 24+06.62 PER PC 12220C AND PAGE 5 PER PC 12220A

SCALE: 1/2" = 1'-0"

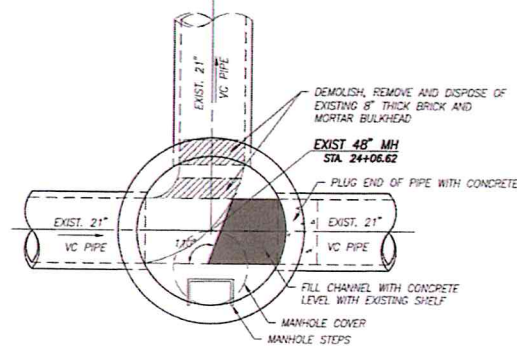


ULTIMATE CONDITION
(SEWAGE FLOWS INTO NORTH PIPE)

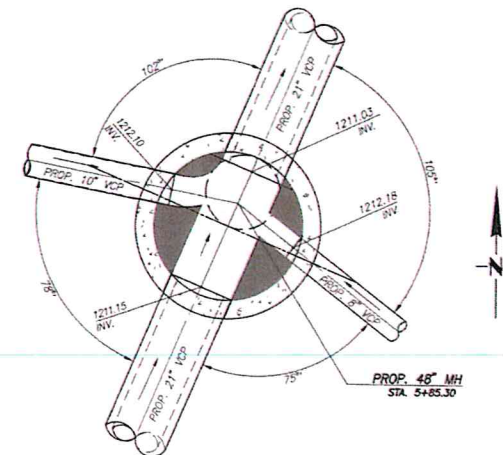


STA. 5+85.30 ON "RIPARIAN AVE" AND "MIDDLETON ST" STREET PER PAGE 3

SCALE: 1/2" = 1'-0"

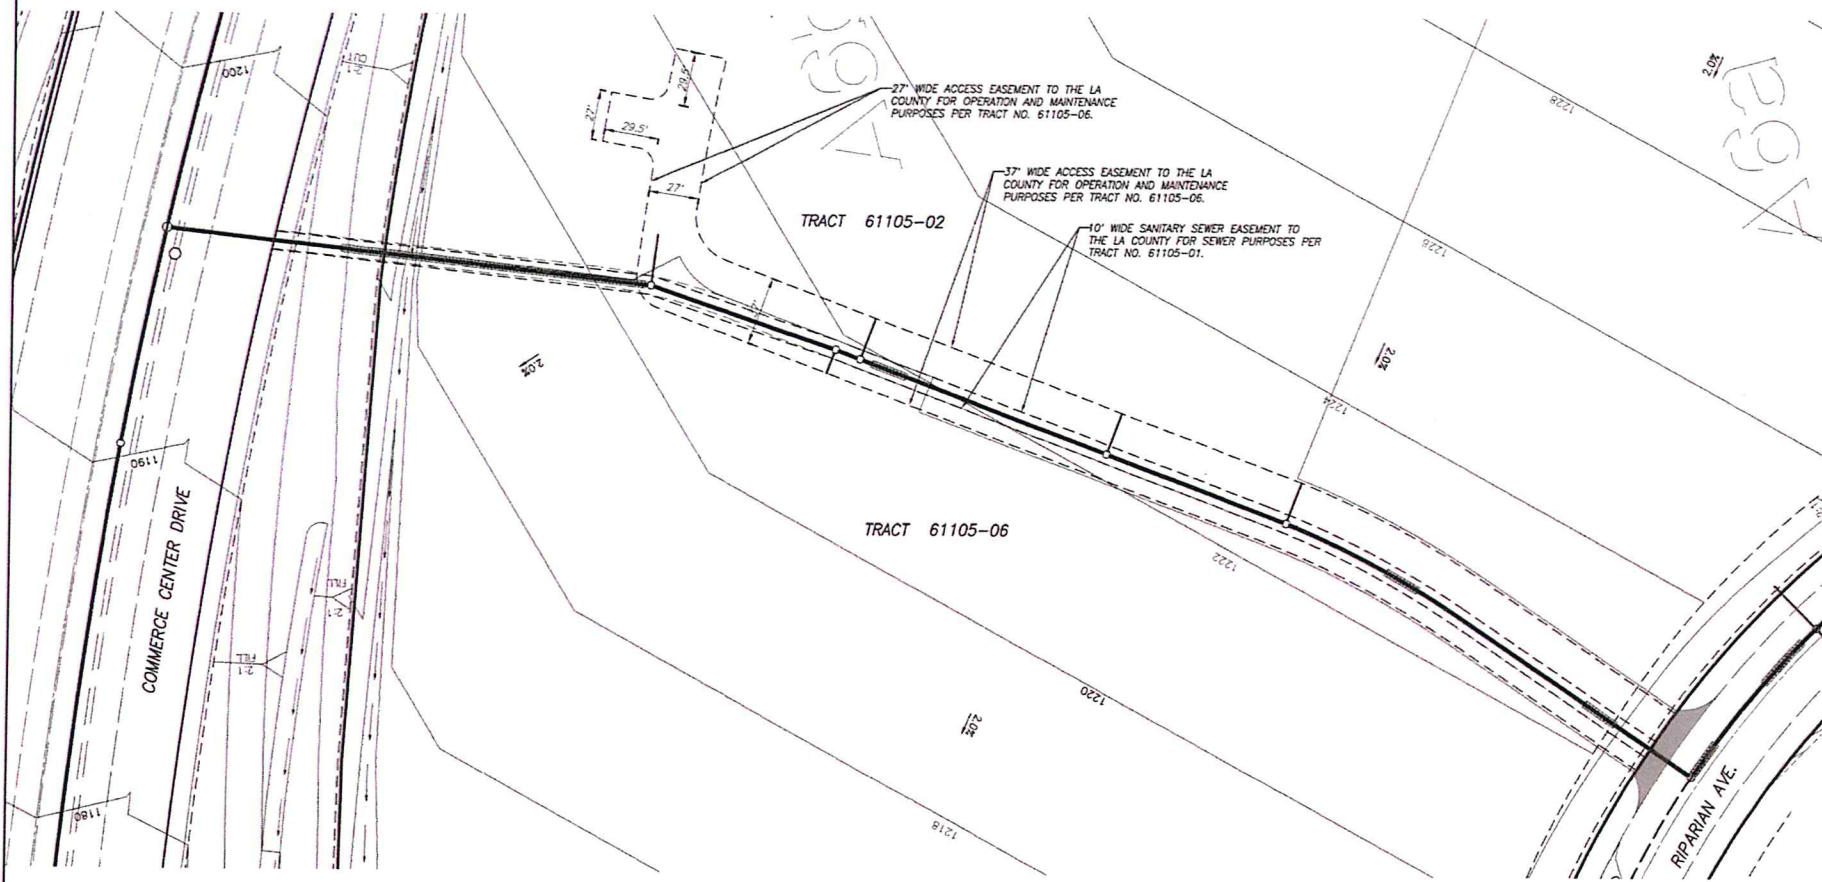

ACCESS ROAD AND EASEMENT
SCALE: 1" = 40'

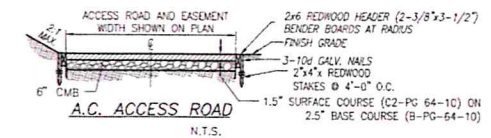

GEOTECHNICAL NOTES:
1. ALL RECOMMENDED MITIGATION MEASURES, PER THE GEOTECHNICAL ENGINEER.

NOTE: PROVIDE REPLACEMENT PLANS TO SMD FOR REVIEW AND APPROVAL AT THE TIME OF THIS TEMPORARY ACCESS ROAD REPLACEMENT

Professional Engineer Seal for **James H. Williams**, License No. 10095, State of California. The seal is dated **5-22-19**.

REVIEWED BY LAND DEVELOPMENT DIVISION
BY: [Signature] DATE: 8/26/19
FINAL MAPS, SEWER AND LANDSCAPING SUBDIVISION PLAN CHECKING SECTION

18VCL1 MO' 81102 BC 13330V0@