


NO LA COUNTY CHARGES FOR CONNECTION

SEE COUNTY SANITATION DISTRICTS FOR SPECIAL CONNECTION CHARGES

(562) 908-4288, EX. 2727

SCALE: VERT. 1" = 8'
HORIZ. 1" = 40'

DOUBLE SCALE

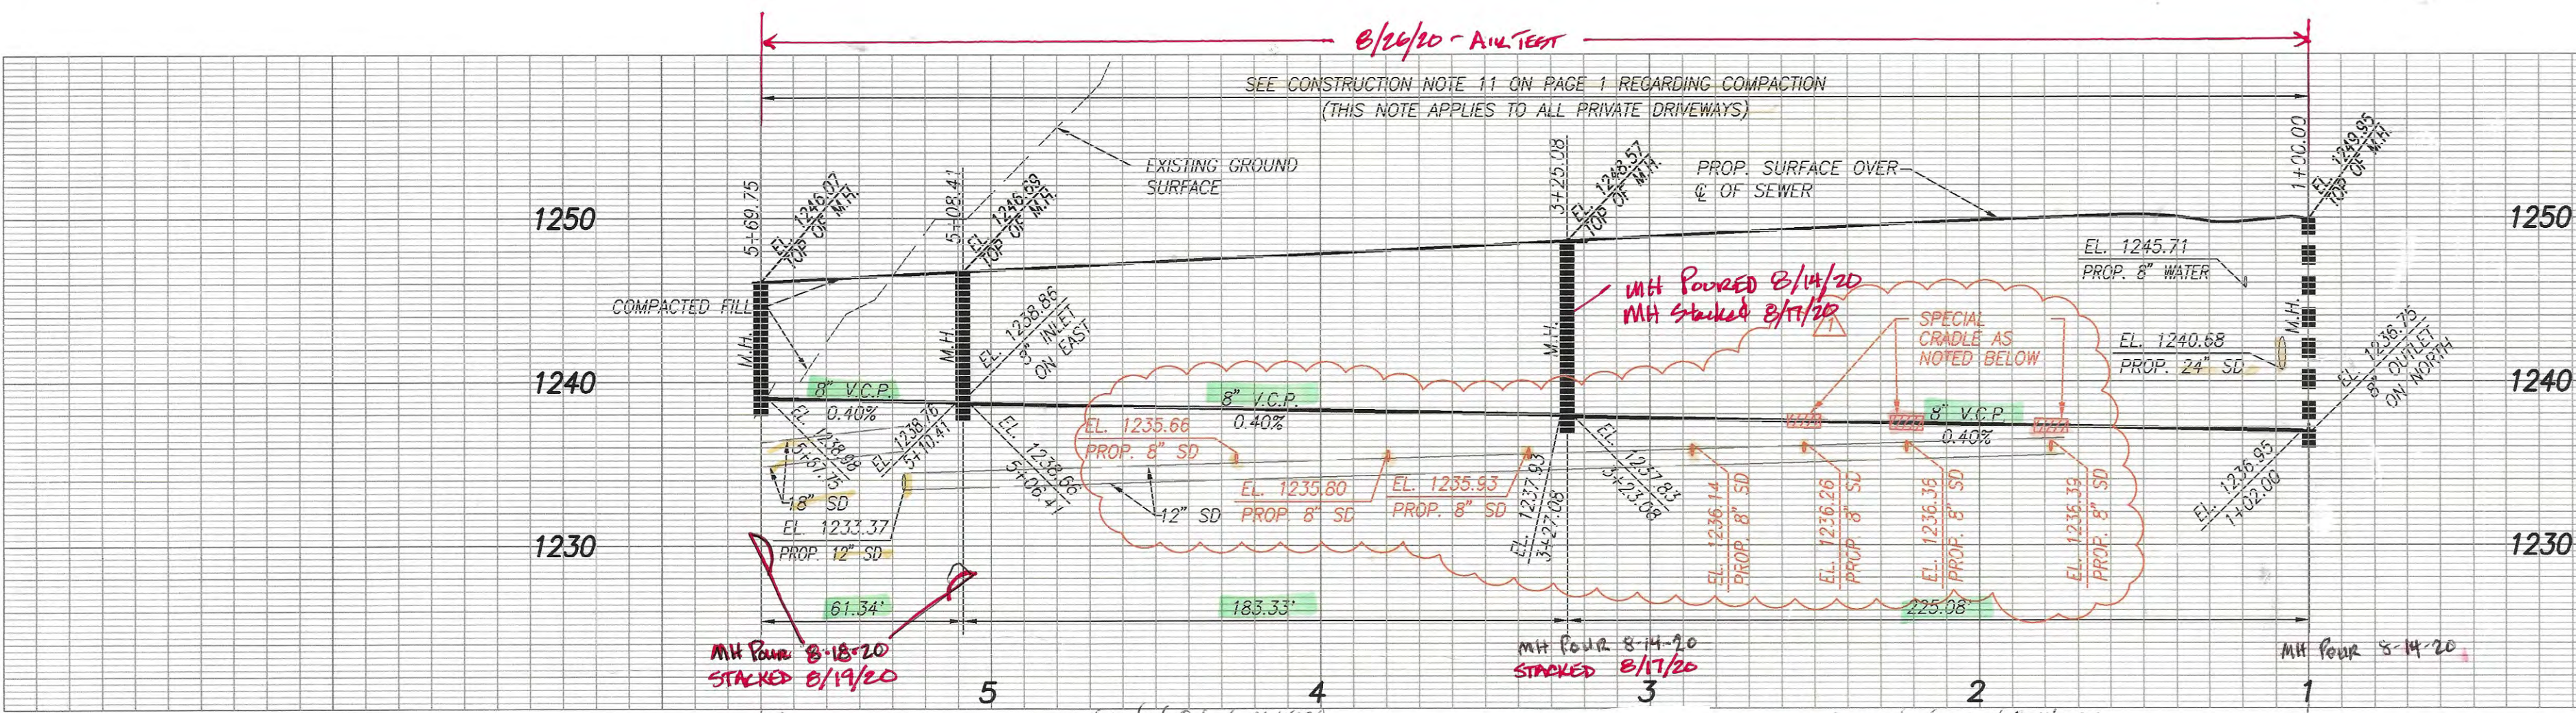

SANITARY SEWER DATA TABLE			
BEARING/Delta	RADIUS	LENGTH	TANGENT
N 55°42'26" W	—	61.35'	—
N 55°42'26" W	—	183.32'	—
N 55°42'26" W	—	114.49'	—
22°37'51"	280.00'	110.60'	56.03'
N 34°17'34" E	—	39.00'	—

AS-BUILTS
OCT 20 2020
Sam Hill & Sons, Inc.

NOTE:
** BACKWATER VALVES SHALL BE REQUIRED FOR ALL UNITS.



REVIEWED BY LAND DEVELOPMENT DIVISION
BY Pedro Romero 10/23/2019
FINAL MAPS, SEWER AND LANDSCAPING SUBDIVISION PLAN CHECKING SECTION DATE


NO LA COUNTY CHARGES FOR CONNECTION

SEE COUNTY SANITATION DISTRICTS FOR SPECIAL CONNECTION CHARGES

(562) 908-4288, EX. 2727

SCALE: VERT. 1" = 8'
HORIZ. 1" = 40'

DOUBLE SCALE

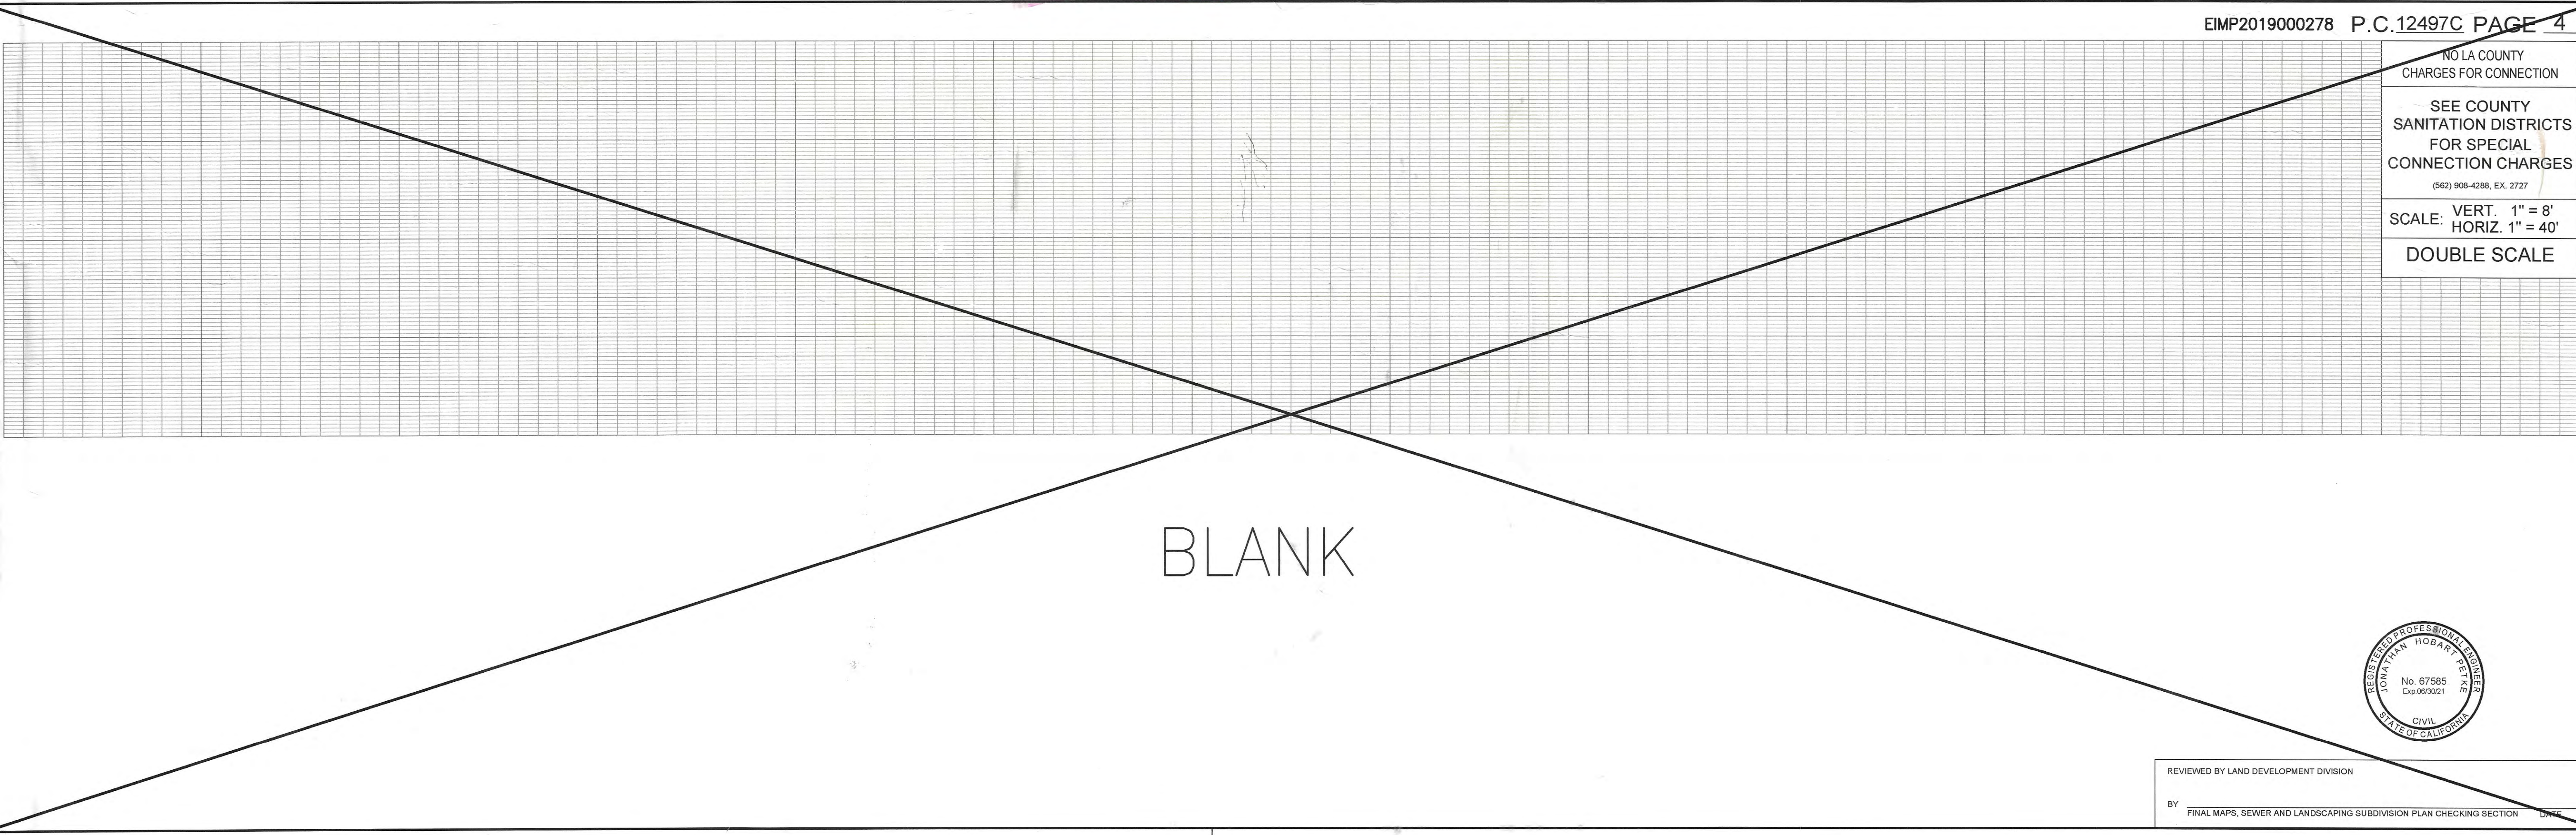

REVIEWED BY LAND DEVELOPMENT DIVISION
BY _____
FINAL MAPS, SEWER AND LANDSCAPING SUBDIVISION PLAN CHECKING SECTION DATE