


NO LA COUNTY CHARGES FOR CONNECTION

SEE COUNTY SANITATION DISTRICTS FOR SPECIAL CONNECTION CHARGES

(562) 908-4288, EX. 2727

SCALE: VERT. 1" = 8'
HORIZ. 1" = 40'



DOUBLE SCALE

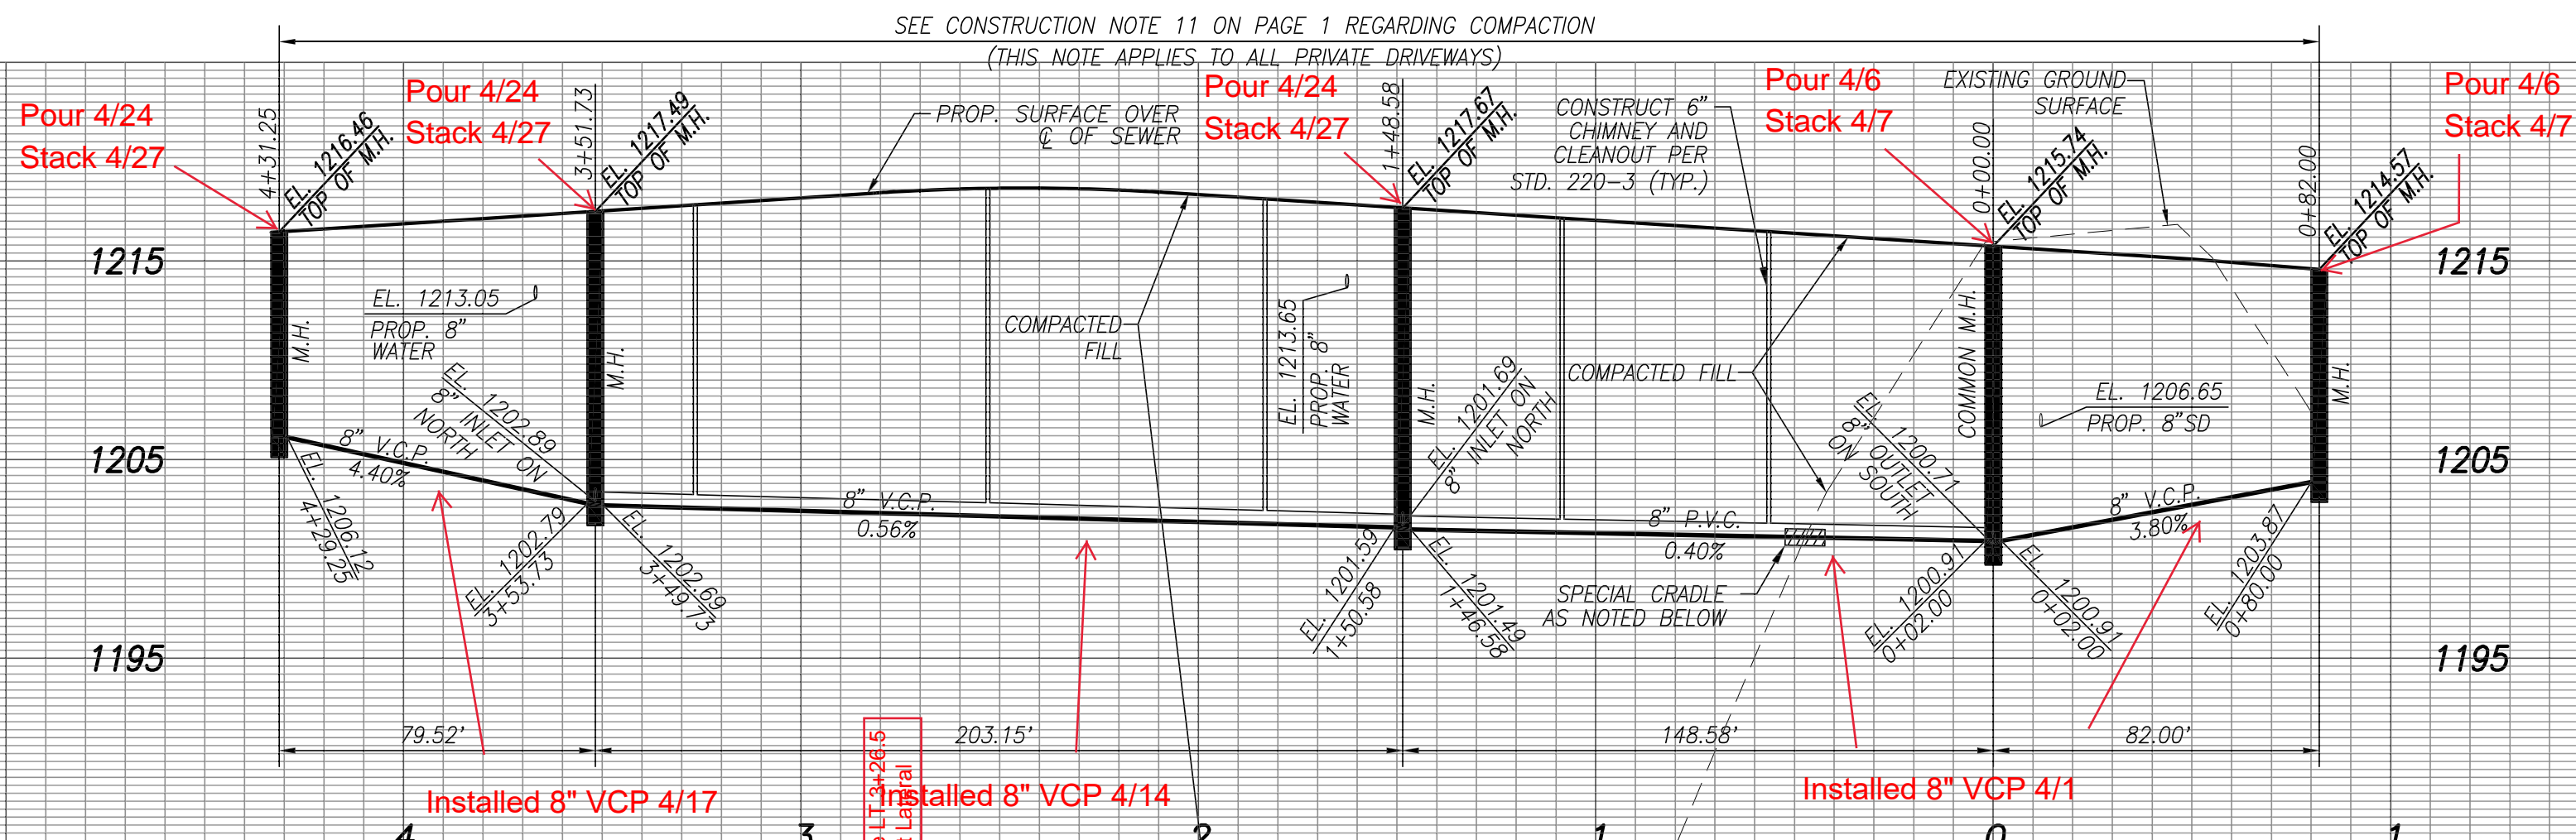

NOTE:
** BACKWATER VALVES SHALL BE REQUIRED FOR ALL UNITS.

SANITARY SEWER DATA TABLE

	BEARING/DELTA	RADIUS	LENGTH	TANGENT
(A)	N 50°38'57" E	-	82.00'	-
(B)	N 50°38'57" E	-	148.58'	-
(C)	N 50°38'57" E	-	58.28'	-
(D)	11°03'30"	507.50'	97.95'	49.13'
(E)	N 61°42'27" E	-	46.92'	-
(F)	N 61°42'27" E	-	79.52'	-

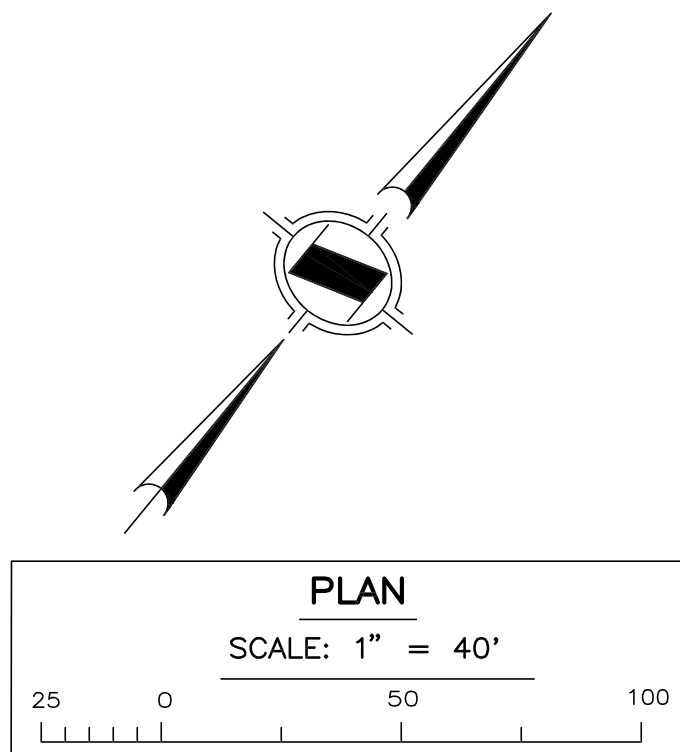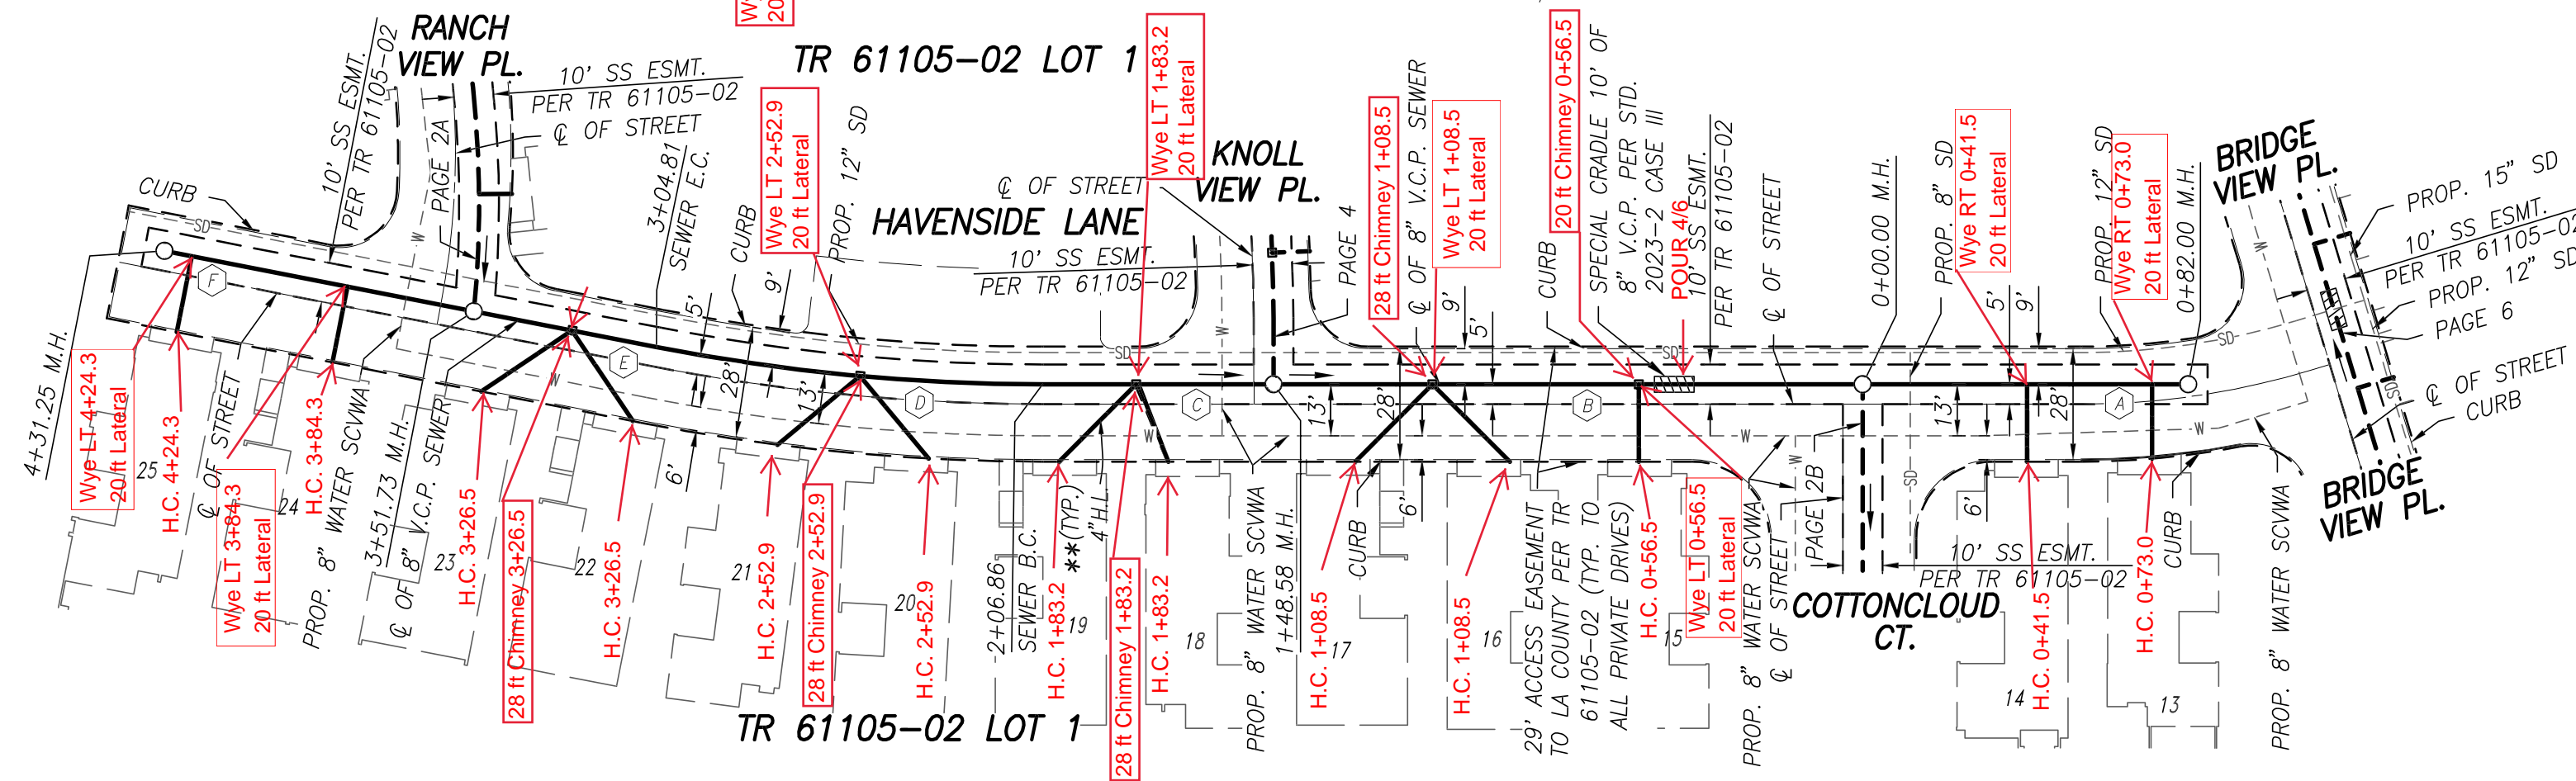

REVIEWED BY LAND DEVELOPMENT DIVISION

BY *Pedro Romero* 02/11/2020

FINAL MAPS, SEWER AND LANDSCAPING SUBDIVISION PLAN CHECKING SECTION DATE


NO LA COUNTY CHARGES FOR CONNECTION

SEE COUNTY SANITATION DISTRICTS FOR SPECIAL CONNECTION CHARGES

(562) 908-4288, EX. 2727

SCALE: VERT. 1" = 8'
HORIZ. 1" = 40'

DOUBLE SCALE

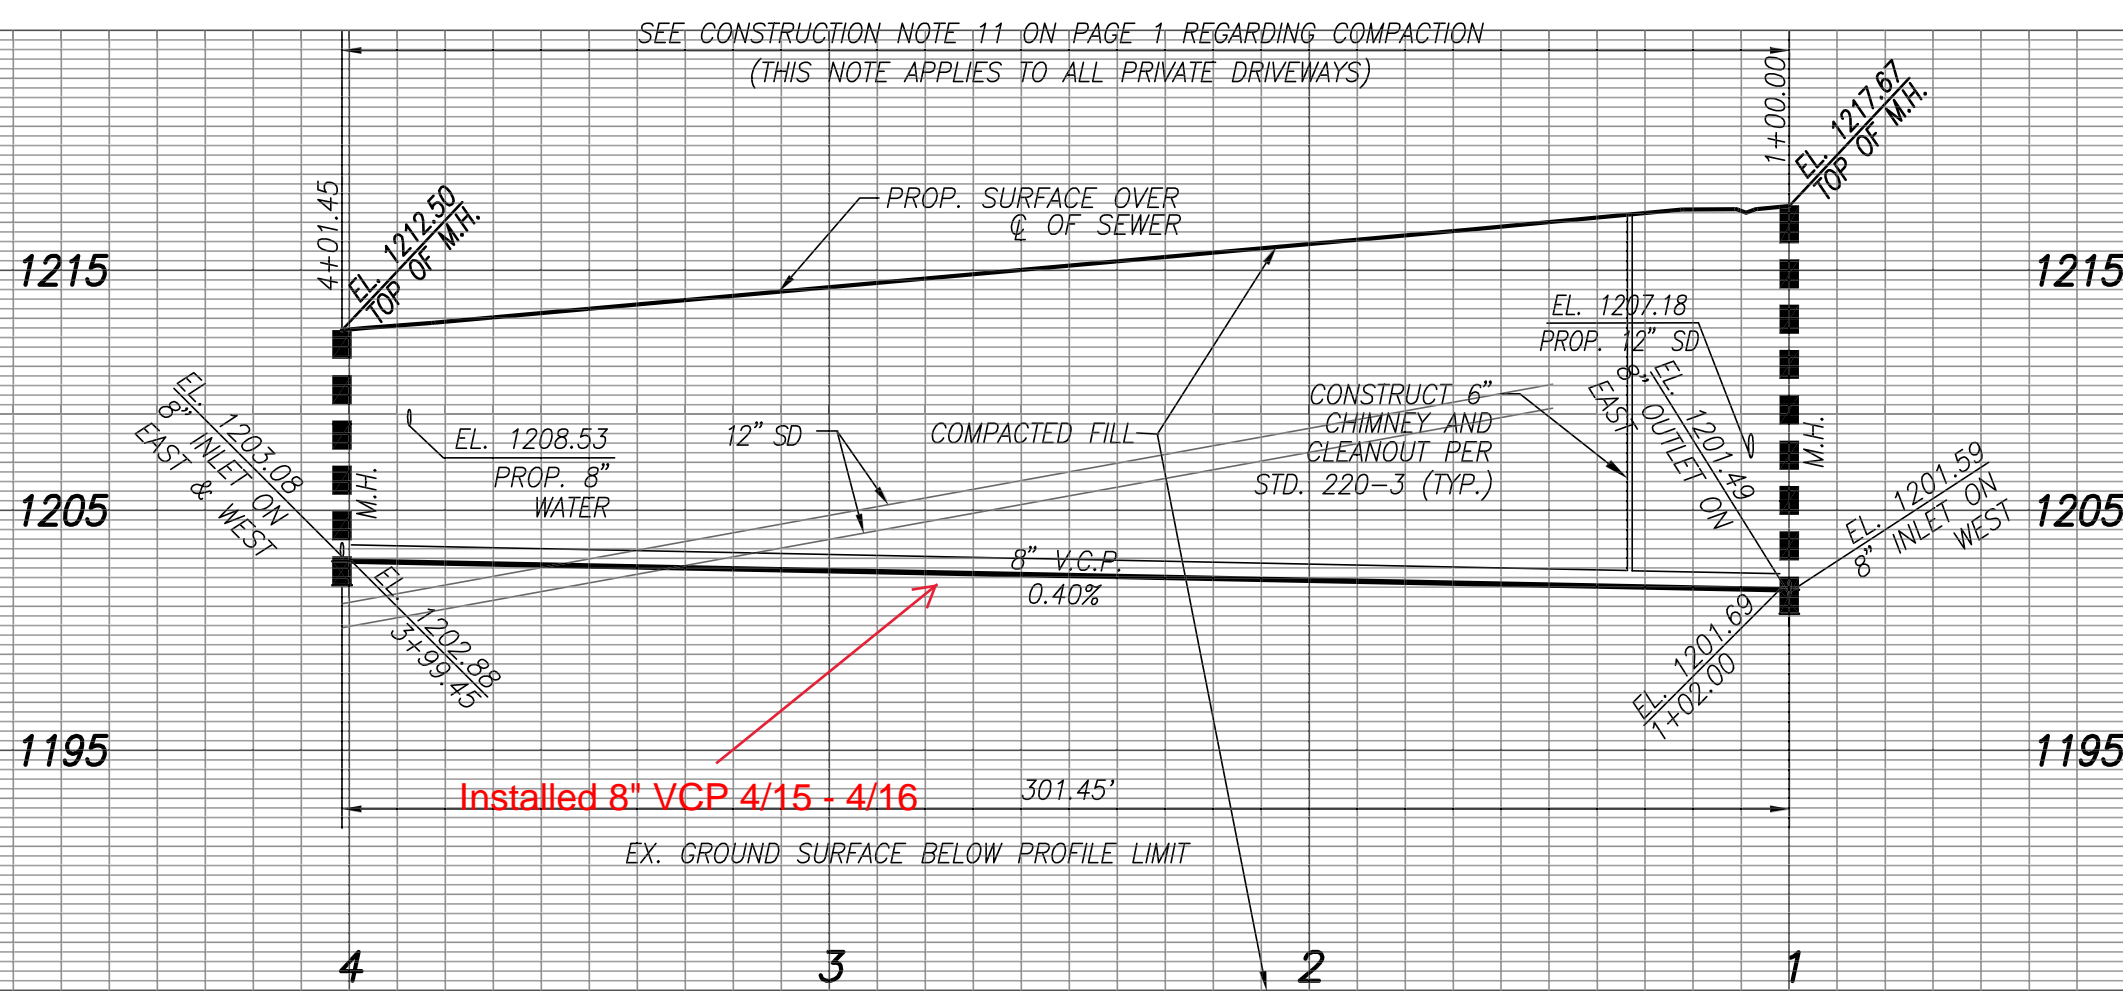

NOTE:
** BACKWATER VALVES SHALL BE REQUIRED FOR ALL UNITS.



AS - BUILT

DATE: *[Signature]*

BOUDREAU PIPELINE CORPORATION

SANITARY SEWER DATA TABLE

	BEARING/DELTA	RADIUS	LENGTH	TANGENT
(G)	N 39°21'03" W	-	16.63'	-
(H)	05°41'07"	505.00'	50.11'	25.07'
(I)	N 45°23'26" W	-	234.71'	-

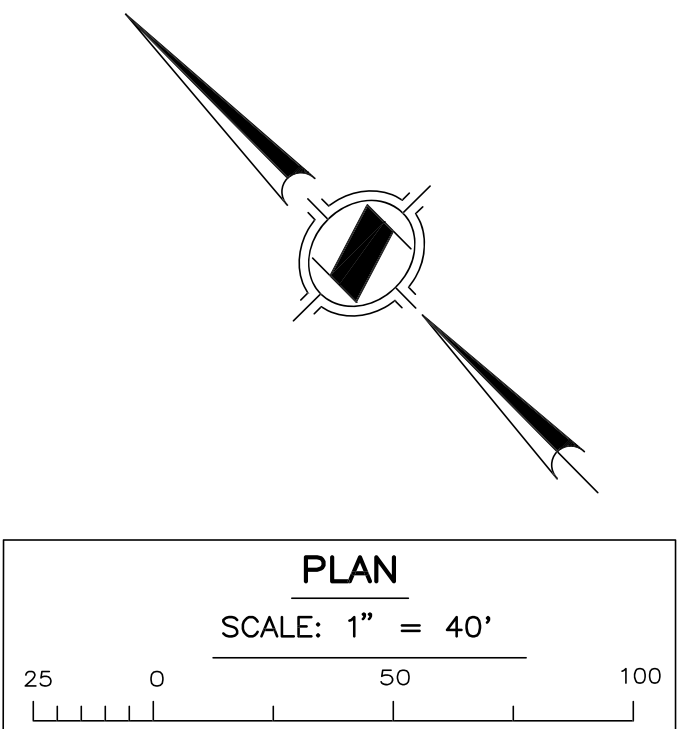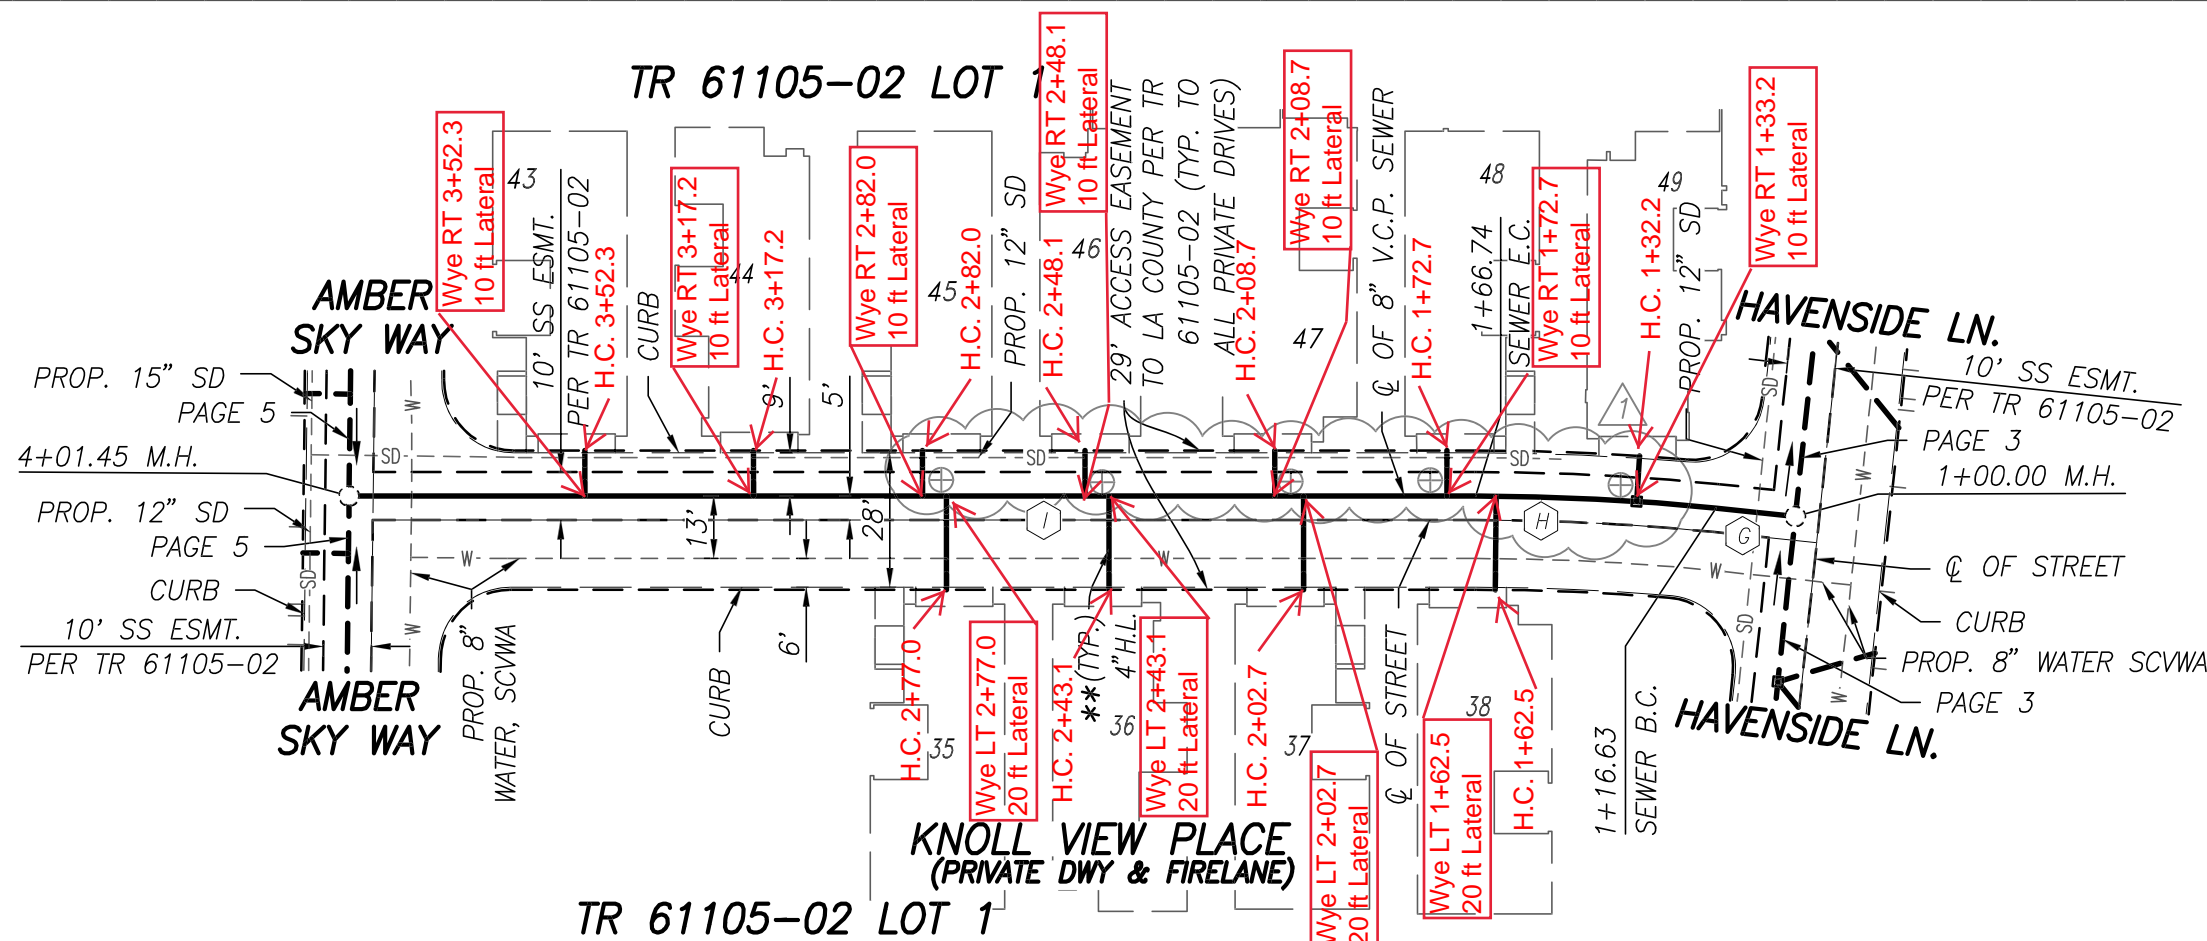

NOTE:
⊕ HOUSE LATERALS INVERTS TO BE CONSTRUCTED PER SEWER LATERAL TABLE ON PAGE 2



REVIEWED BY LAND DEVELOPMENT DIVISION

BY *Pedro Romero* 02/11/2020

FINAL MAPS, SEWER AND LANDSCAPING SUBDIVISION PLAN CHECKING SECTION DATE

