

Builder Area F5b Sewer Lateral Table				
Unit	Lateral Type	TC to Inv	SS Lat Crossing	
1	A	8.4	Under SD	
2	A	8.5	Under SD	
28	A	9.4	Under SD	
29	A	9.8	Under SD	
30	A	9.7	Under SD	
31	A	9.4	Under SD	
32	A	9.4	Under SD	
33	A	9.3	Under SD	
34	A	8.5	Under SD	
35	A	8.5	Under SD	
36	A	8.4	Under SD	
58	A	8.2	Under SD	
59	A	8.2	Under SD	


NO LA COUNTY CHARGES FOR CONNECTION

SEE COUNTY SANITATION DISTRICTS FOR SPECIAL CONNECTION CHARGES

(562) 908-4288, EX. 2727

SCALE: VERT. 1" = 8'  
HORIZ. 1" = 40'

DOUBLE SCALE

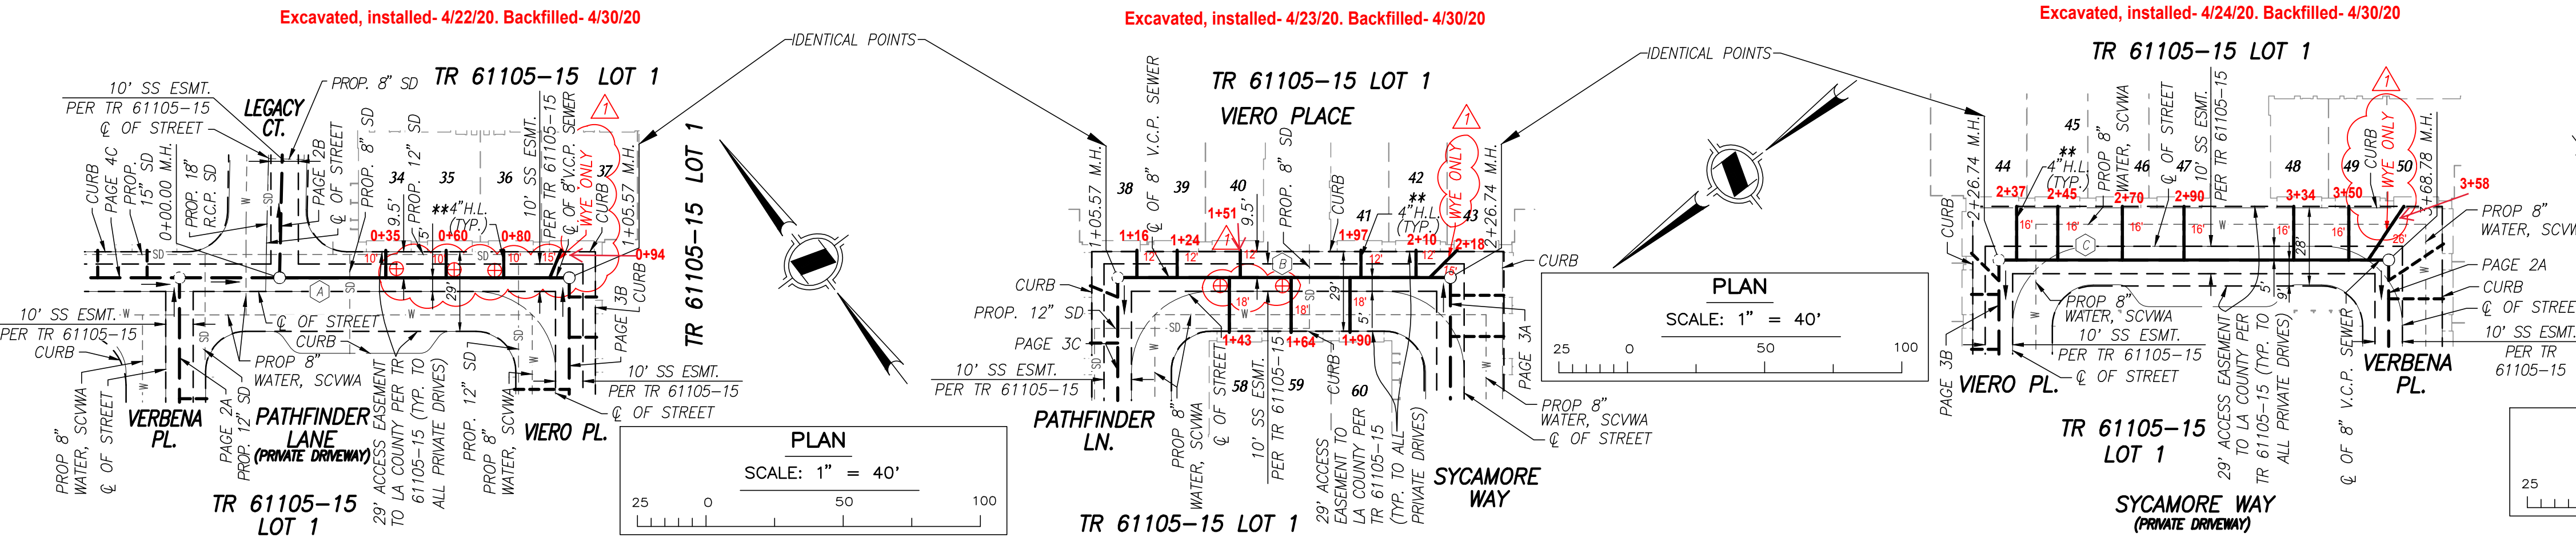

NOTE:  
HOUSE LATERALS INVERTS TO BE CONSTRUCTED PER SEWER LATERAL TABLE HEREON

NOTE:  
\*\* BACKWATER VALVES SHALL BE REQUIRED FOR ALL UNITS.


SANITARY SEWER DATA TABLE	
BEARING/DELTA	LENGTH
N 52°25'08" W	105.57'
N 37°34'52" E	121.17'
N 52°25'08" W	142.04'



REVIEWED BY LAND DEVELOPMENT DIVISION

BY *Pedro Romero* 02/11/2020

FINAL MAPS, SEWER AND LANDSCAPING SUBDIVISION PLAN CHECKING SECTION DATE

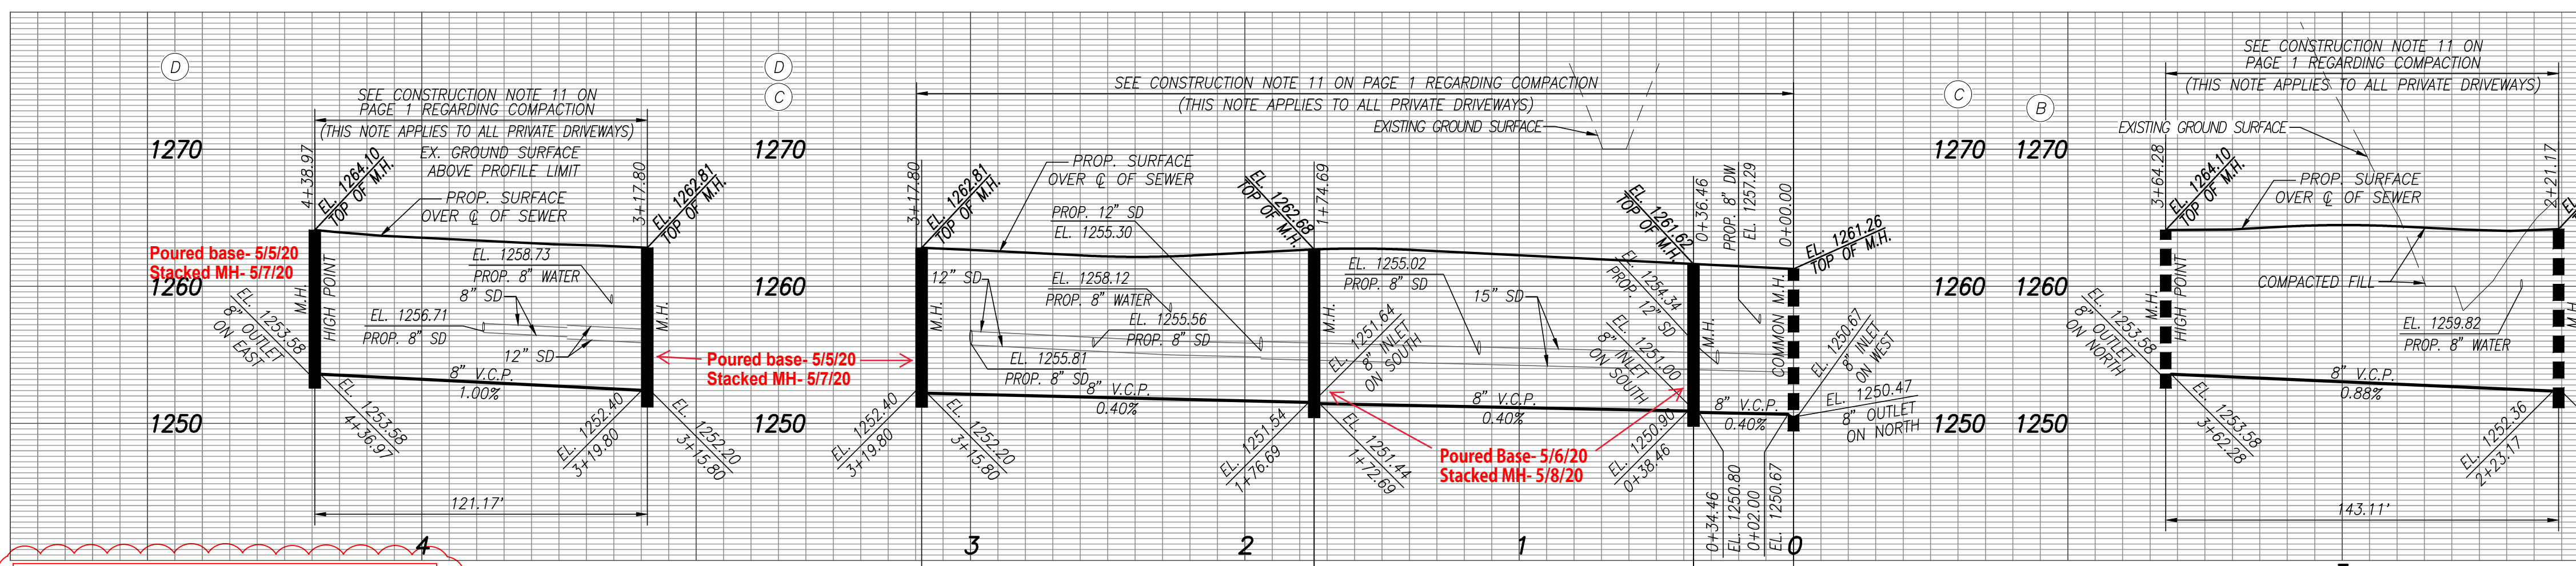

NOTE:  
HOUSE LATERALS INVERTS TO BE CONSTRUCTED PER SEWER LATERAL TABLE ON PAGE 3

NO LA COUNTY CHARGES FOR CONNECTION


SEE COUNTY SANITATION DISTRICTS FOR SPECIAL CONNECTION CHARGES

(562) 908-4288, EX. 2727

SCALE: VERT. 1" = 8'  
HORIZ. 1" = 40'

DOUBLE SCALE

SANITARY SEWER DATA TABLE	
BEARING/DELTA	LENGTH
N 37°34'52" E	121.17'
N 52°25'08" W	143.12'
N 52°25'08" W	138.23'
N 52°25'08" W	36.46'

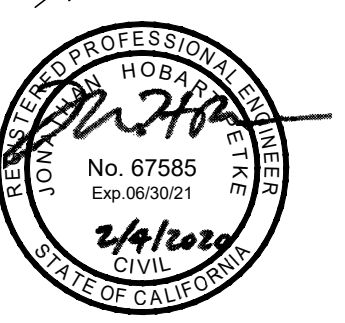

REVIEWED BY LAND DEVELOPMENT DIVISION

BY *Pedro Romero* 02/11/2020

FINAL MAPS, SEWER AND LANDSCAPING SUBDIVISION PLAN CHECKING SECTION DATE