
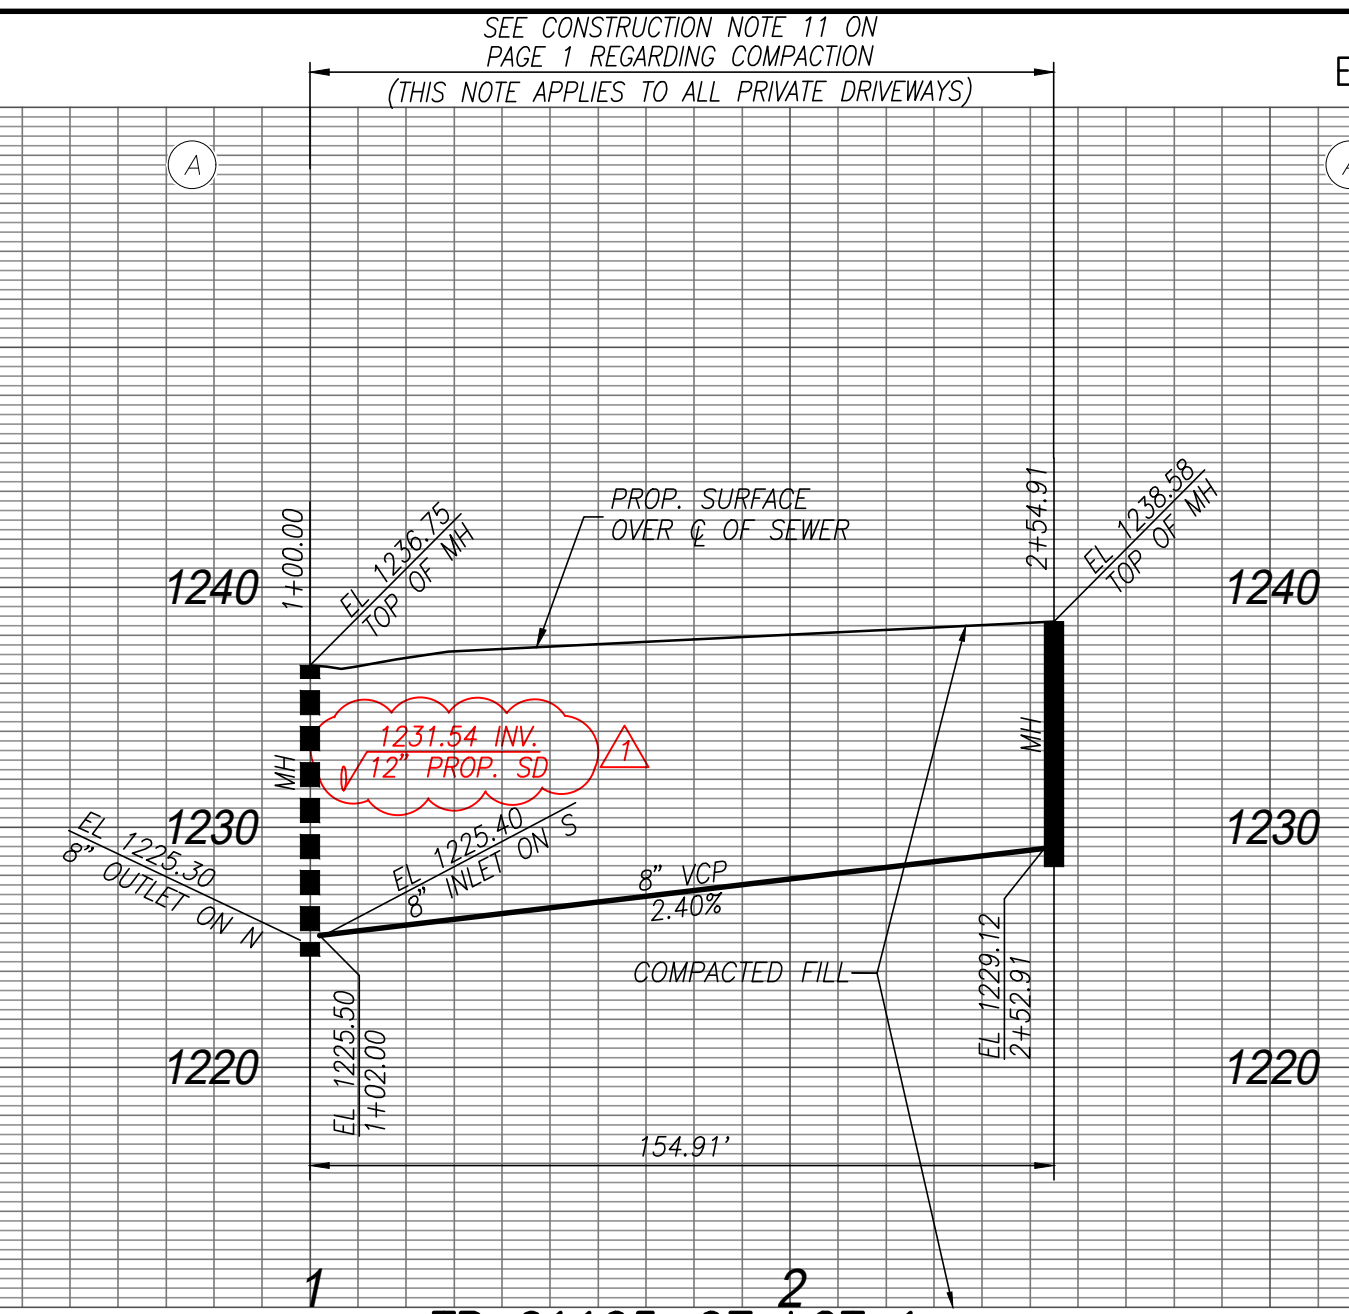





NO LA COUNTY CHARGES FOR CONNECTION
SEE COUNTY SANITATION DISTRICTS FOR SPECIAL CONNECTION CHARGES
TEL. (562) 908-4288, EX. 2727
SCALE: VERT. 1" = 8'
HORIZ. 1" = 40'
DOUBLE SCALE

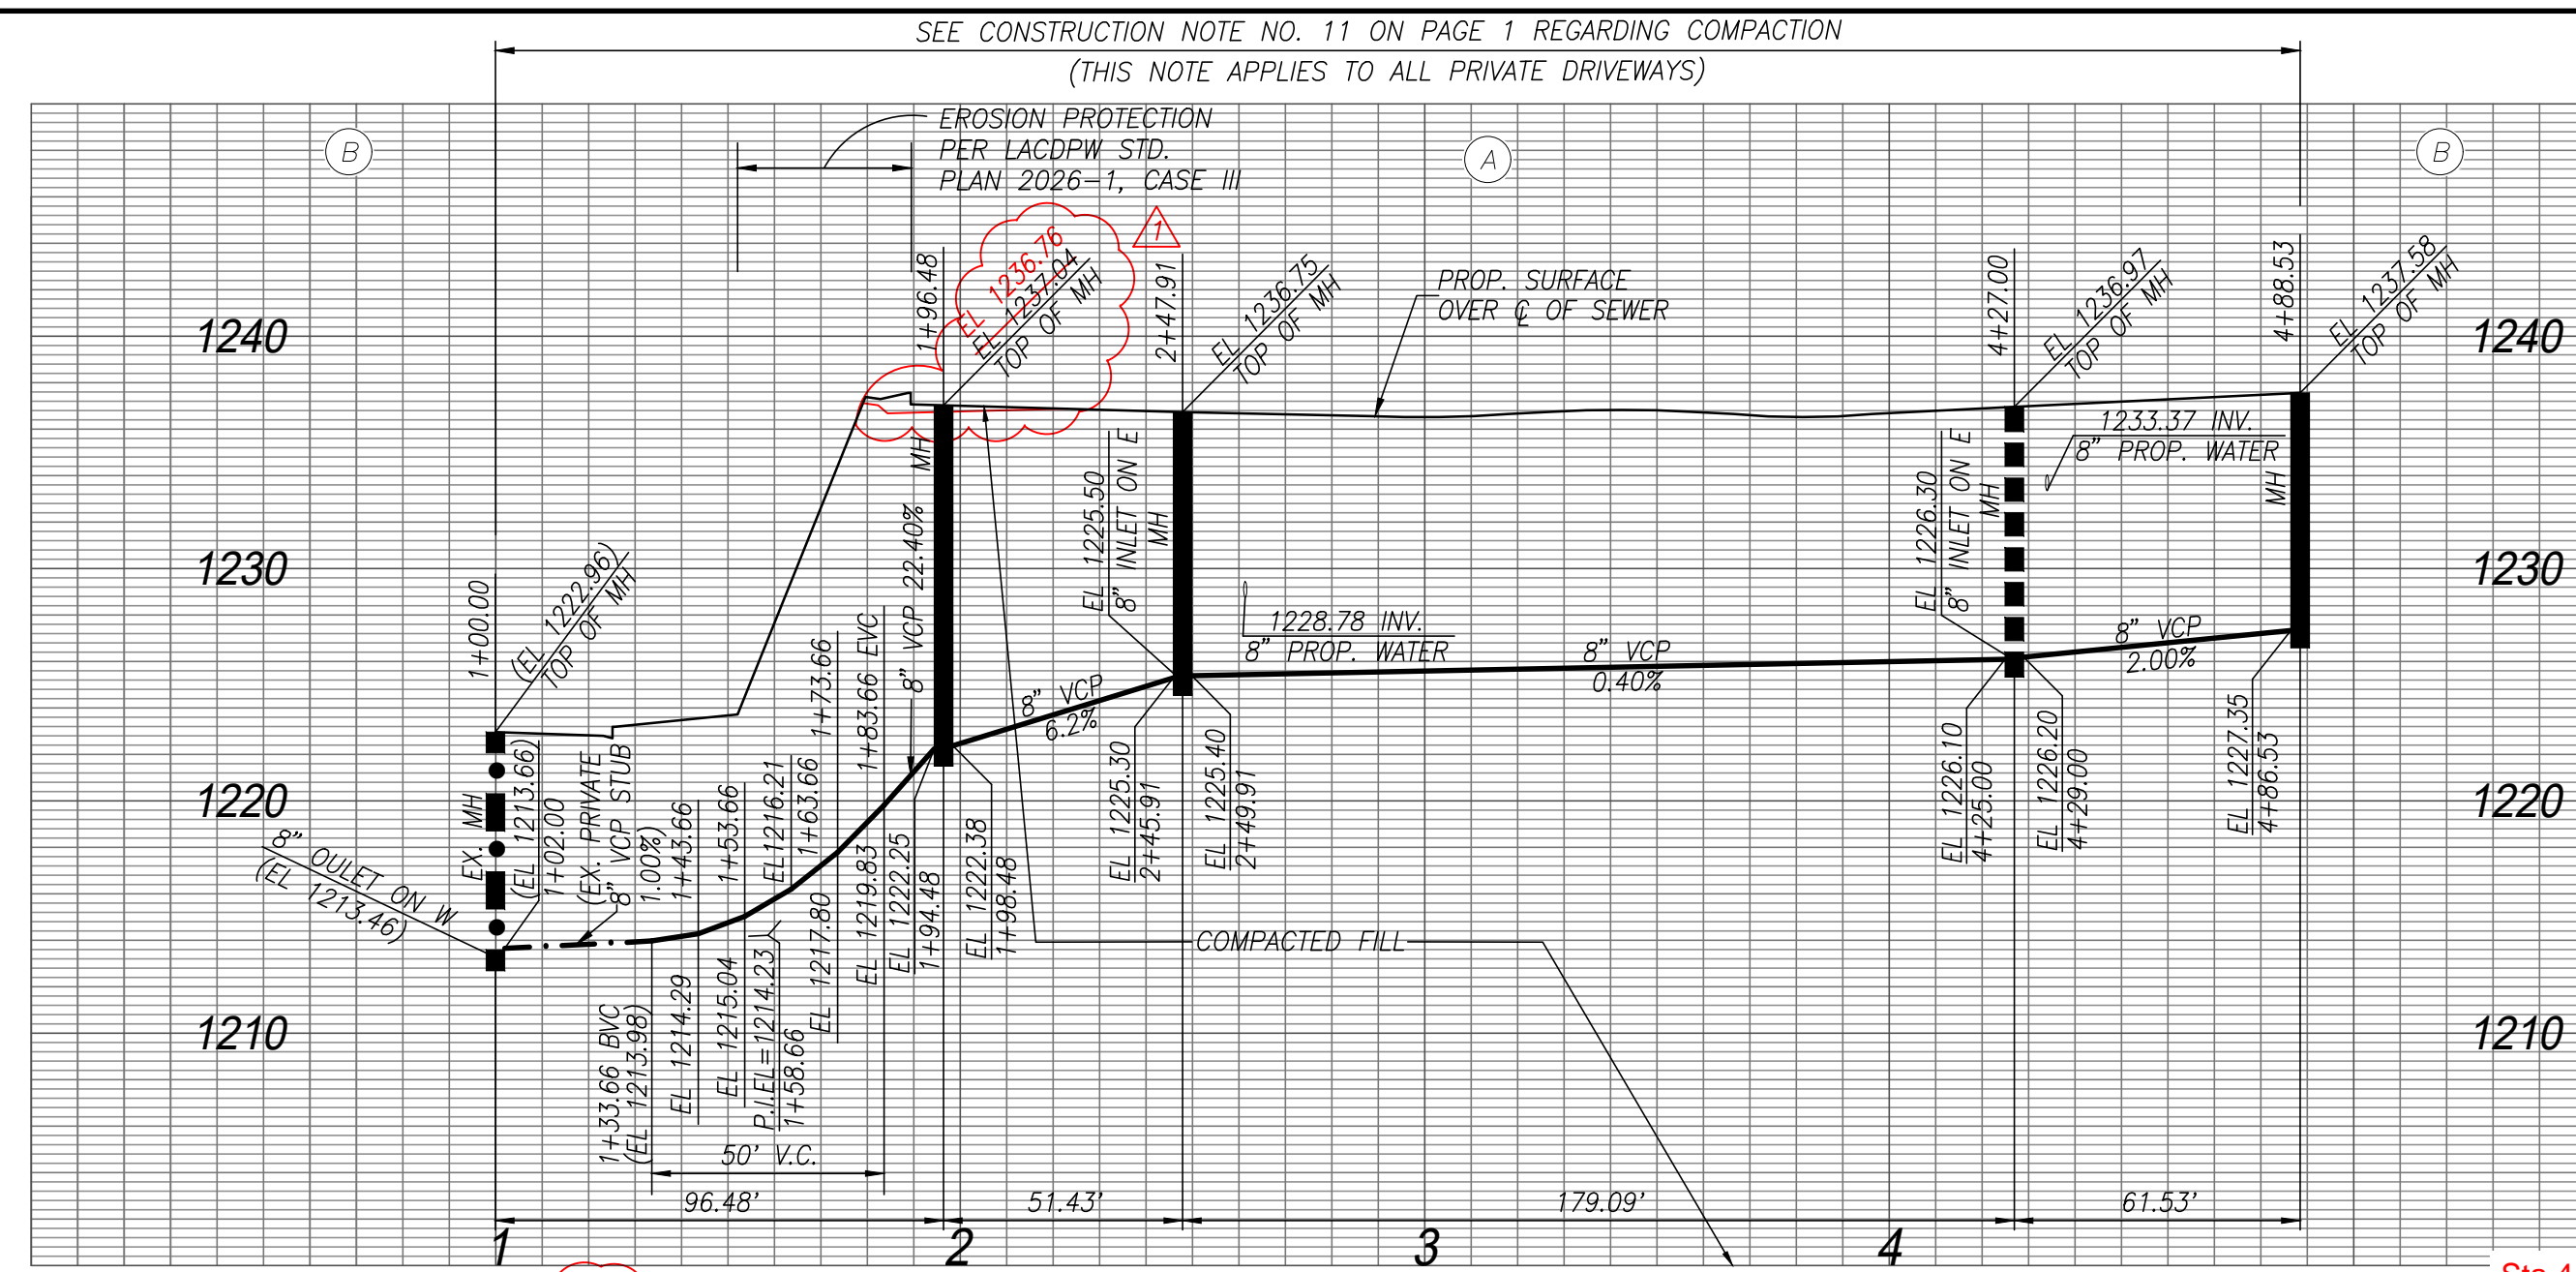



AS-BUILT AS OF 3/20/2020

SANITARY SEWER DATA TABLE

BEARING/Delta	RADIUS	LENGTH	TANGENT
(A) N 02°17'17" W	-	61.53'	-
(B) 14°11'33" W	552.00'	136.73'	68.72'
(C) N 12°35'50" E	-	42.36'	-
(D) N 12°35'50" E	-	51.43'	-
(E) N 12°35'51" E	-	62.83'	-
(F) N 79°29'40" W	-	154.91'	-

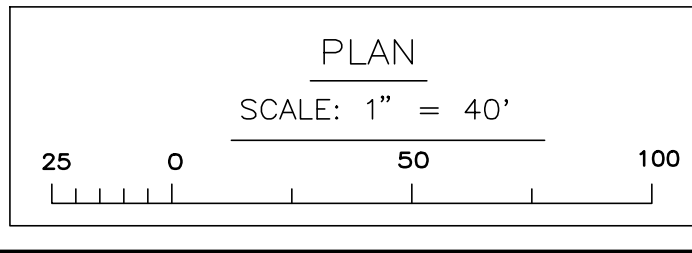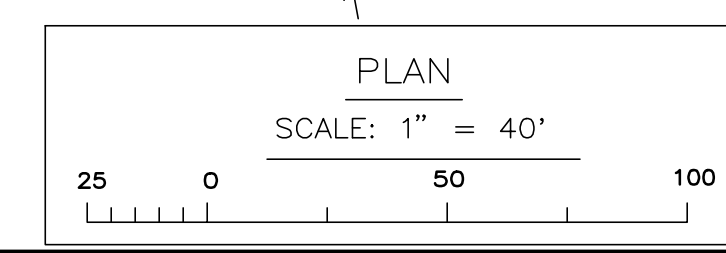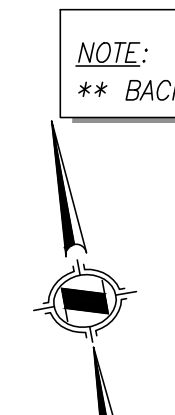


NOTE: ** ACCEPTANCE OF THIS 8" LINE FOR COUNTY MAINTENANCE IS CONTINGENT UPON MEETING ALL CONSTRUCTION AND INSPECTION REQUIREMENTS FOR THE FUTURE UPSTREAM SYSTEM.

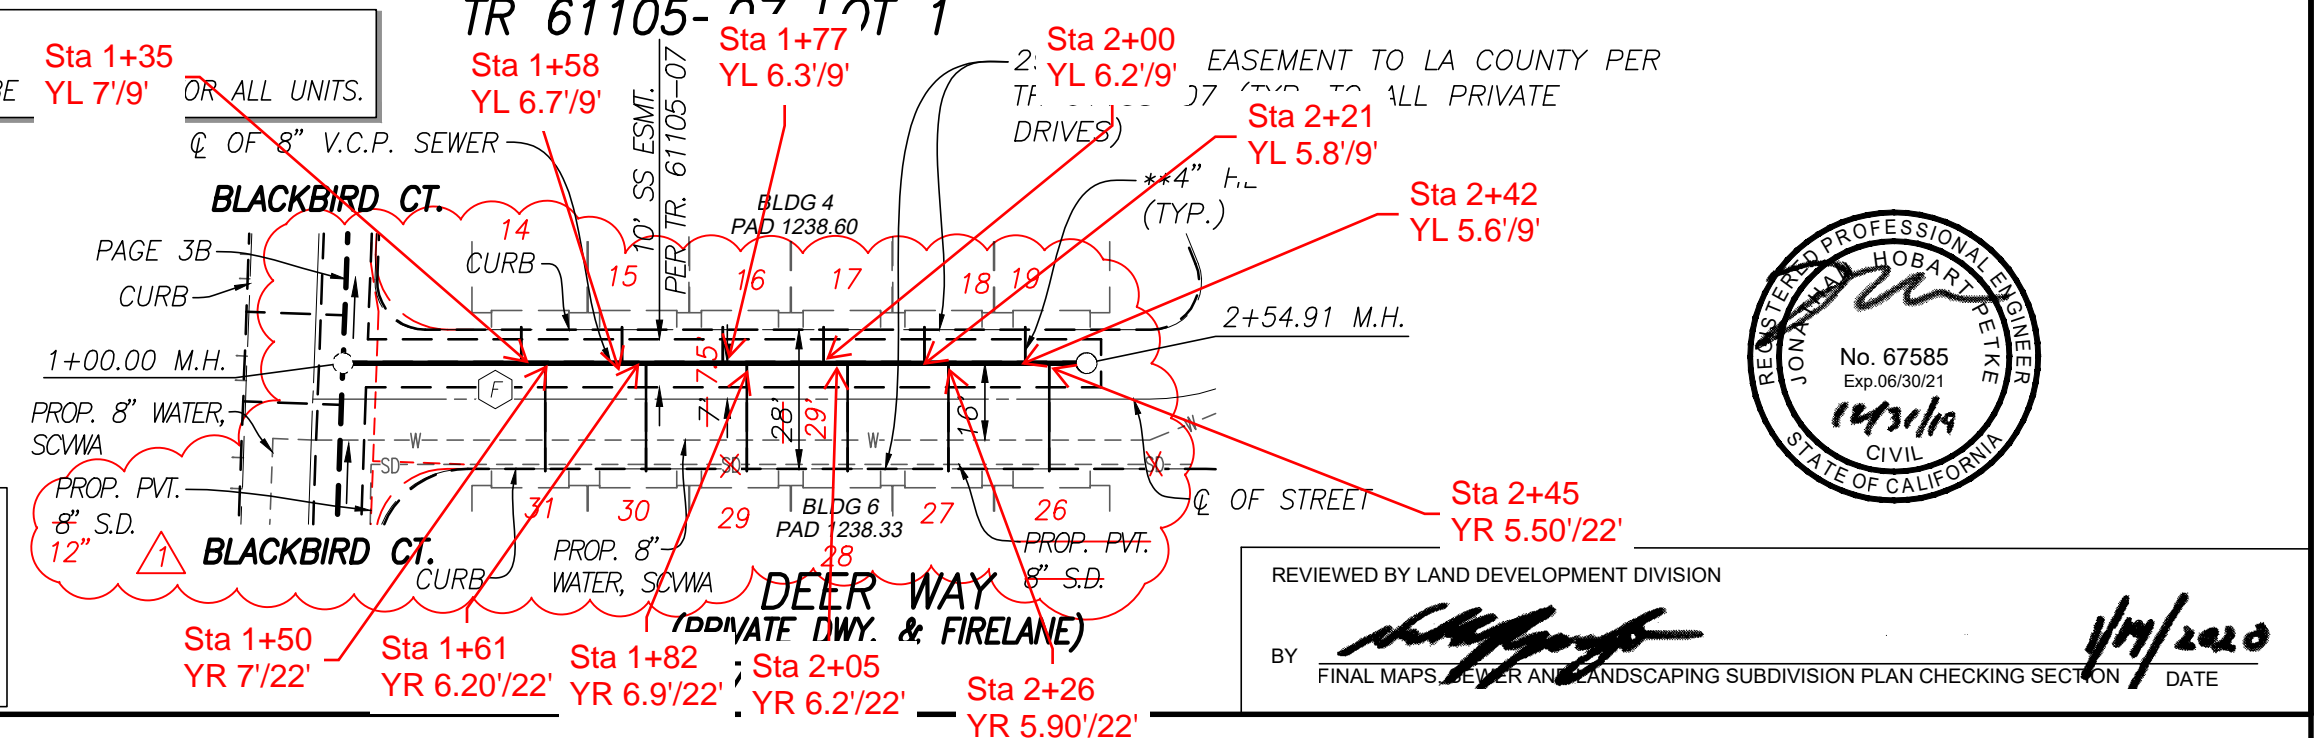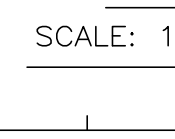

REVIEWED BY LAND DEVELOPMENT DIVISION
DATE: 1/17/2020

NO LA COUNTY CHARGES FOR CONNECTION
SEE COUNTY SANITATION DISTRICTS FOR SPECIAL CONNECTION CHARGES
TEL. (562) 908-4288, EX. 2727
SCALE: VERT. 1" = 8'
HORIZ. 1" = 40'
DOUBLE SCALE

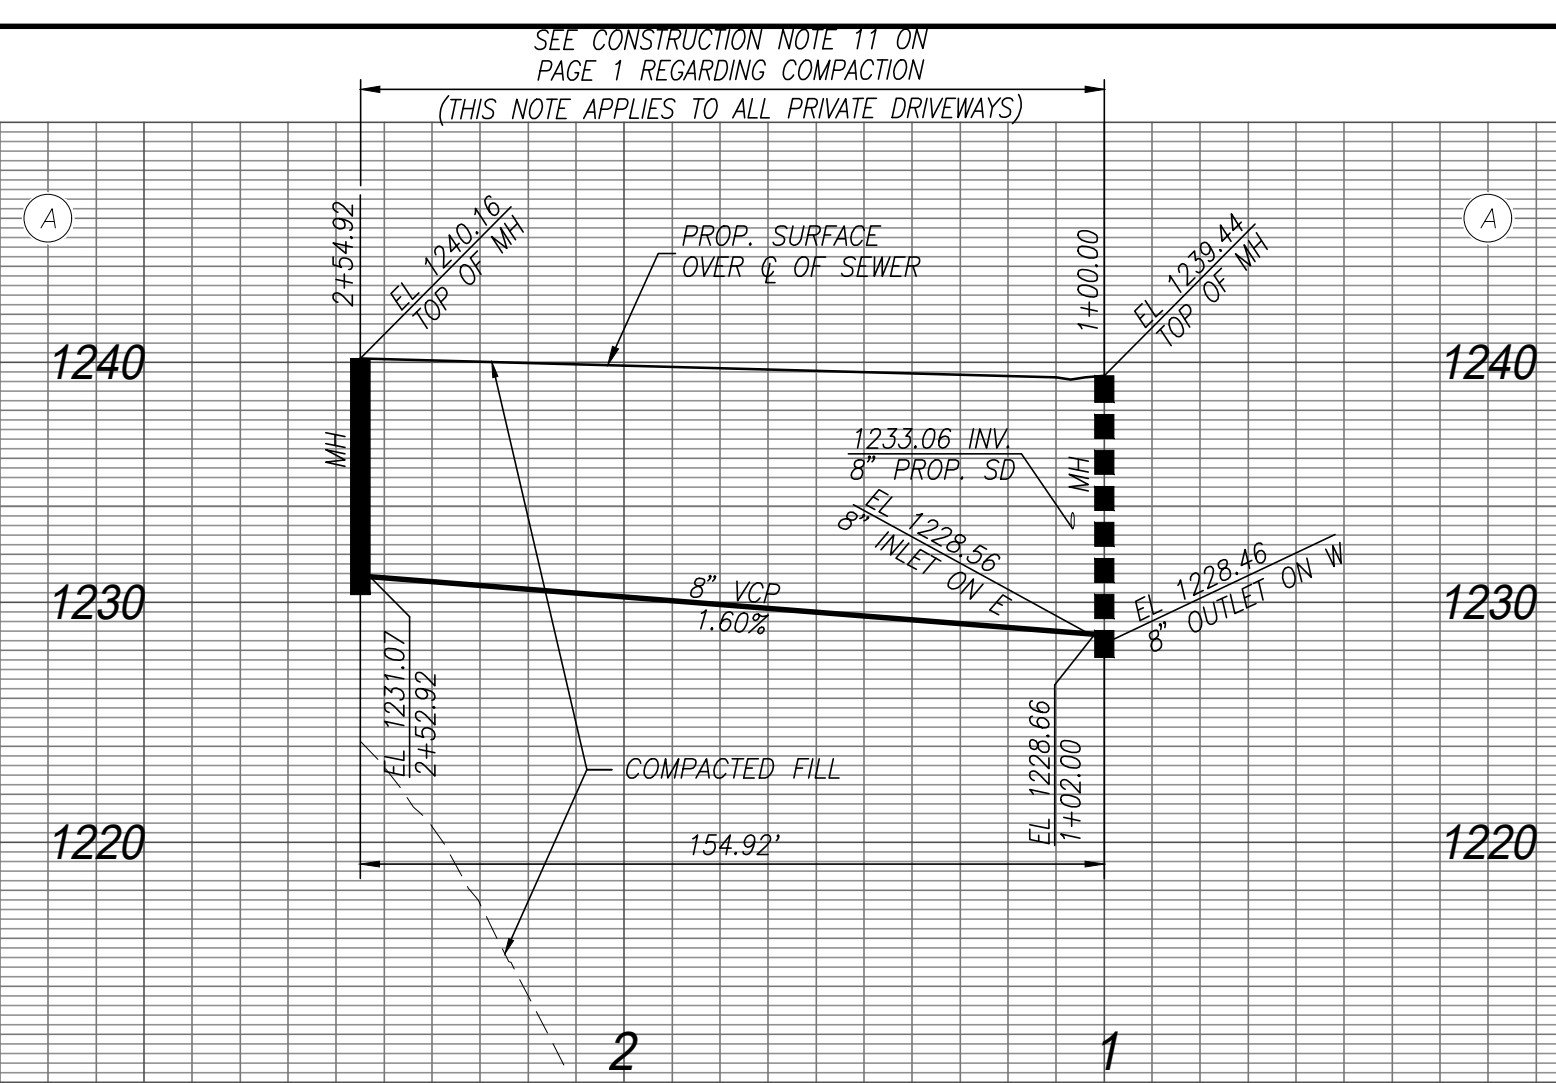


AS-BUILT AS OF 3/20/2020




NOTE: ** BACKWATER VALVES SHALL BE REQUIRED FOR ALL UNITS.

SANITARY SEWER DATA TABLE



BEARING/Delta	LENGTH
(A) N 16°53'46" W	130.33'
(B) N 11°22'10" W	154.92'

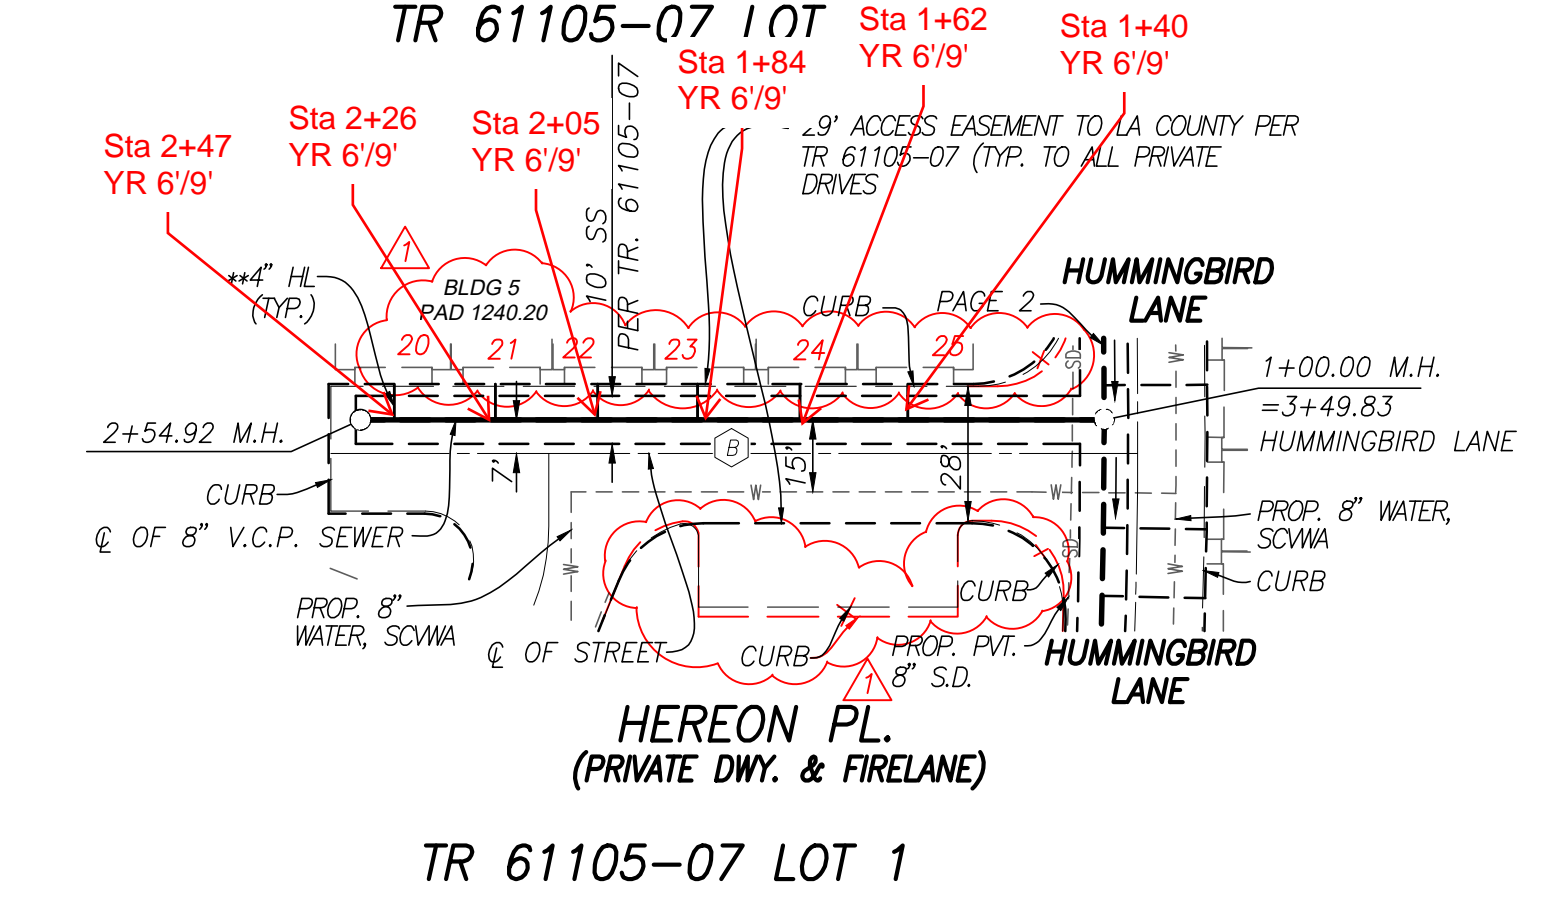


REVIEWED BY LAND DEVELOPMENT DIVISION
DATE: 1/17/2020

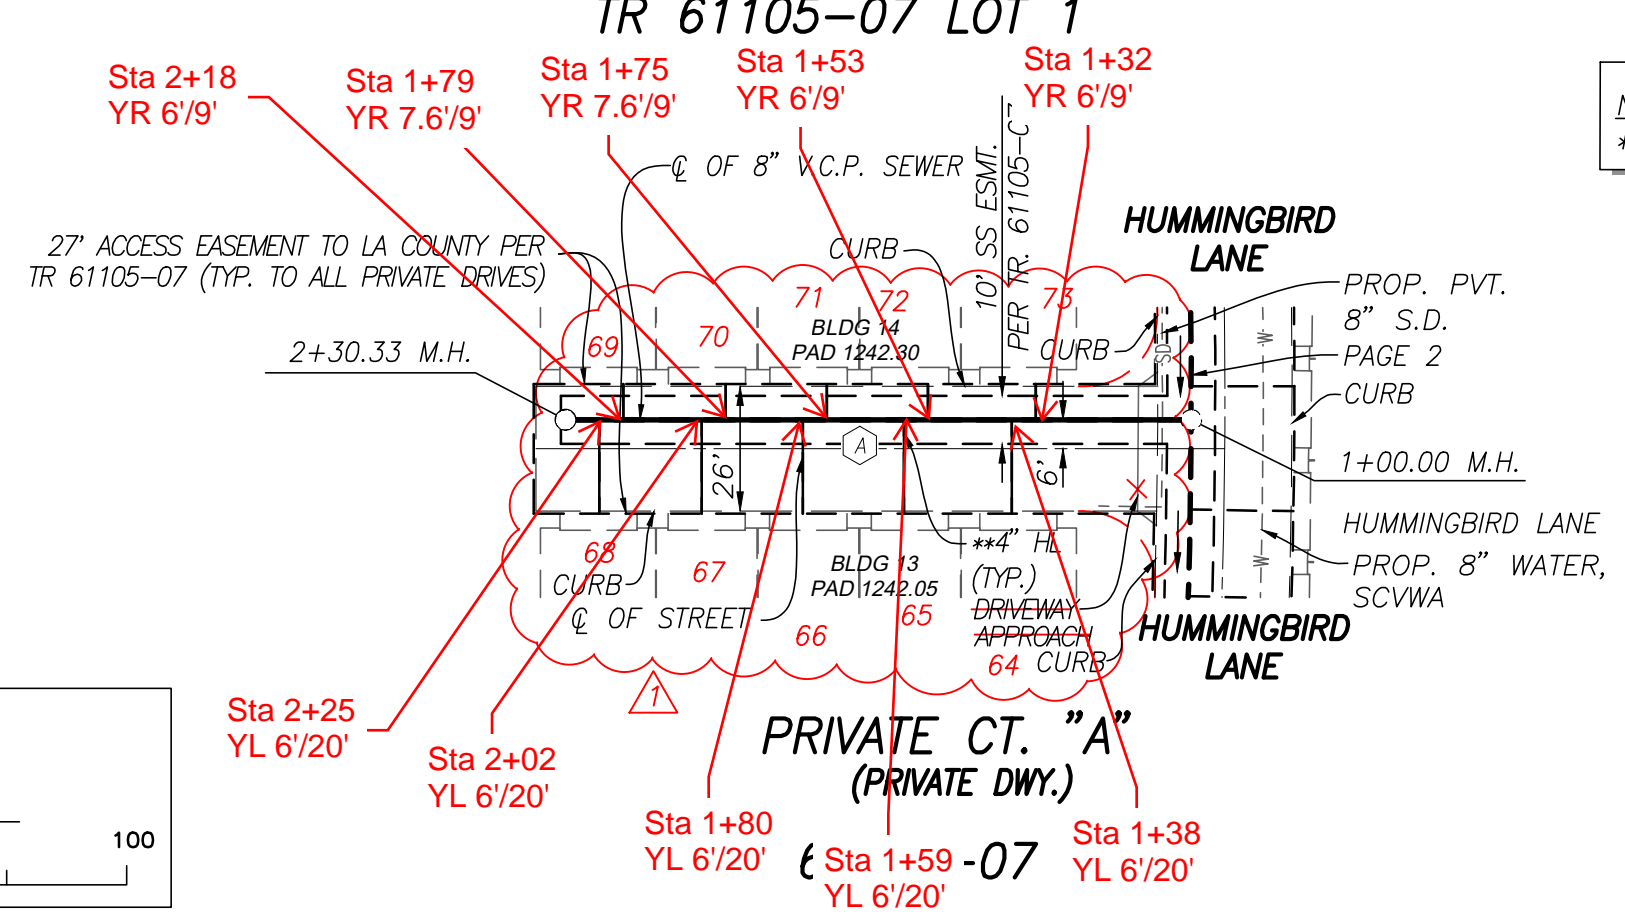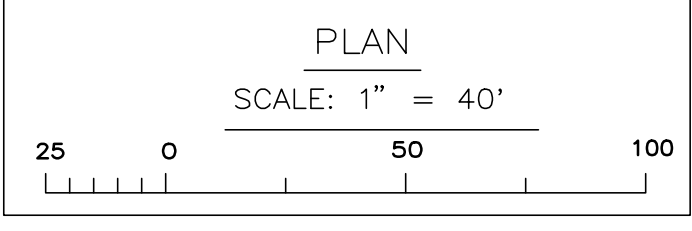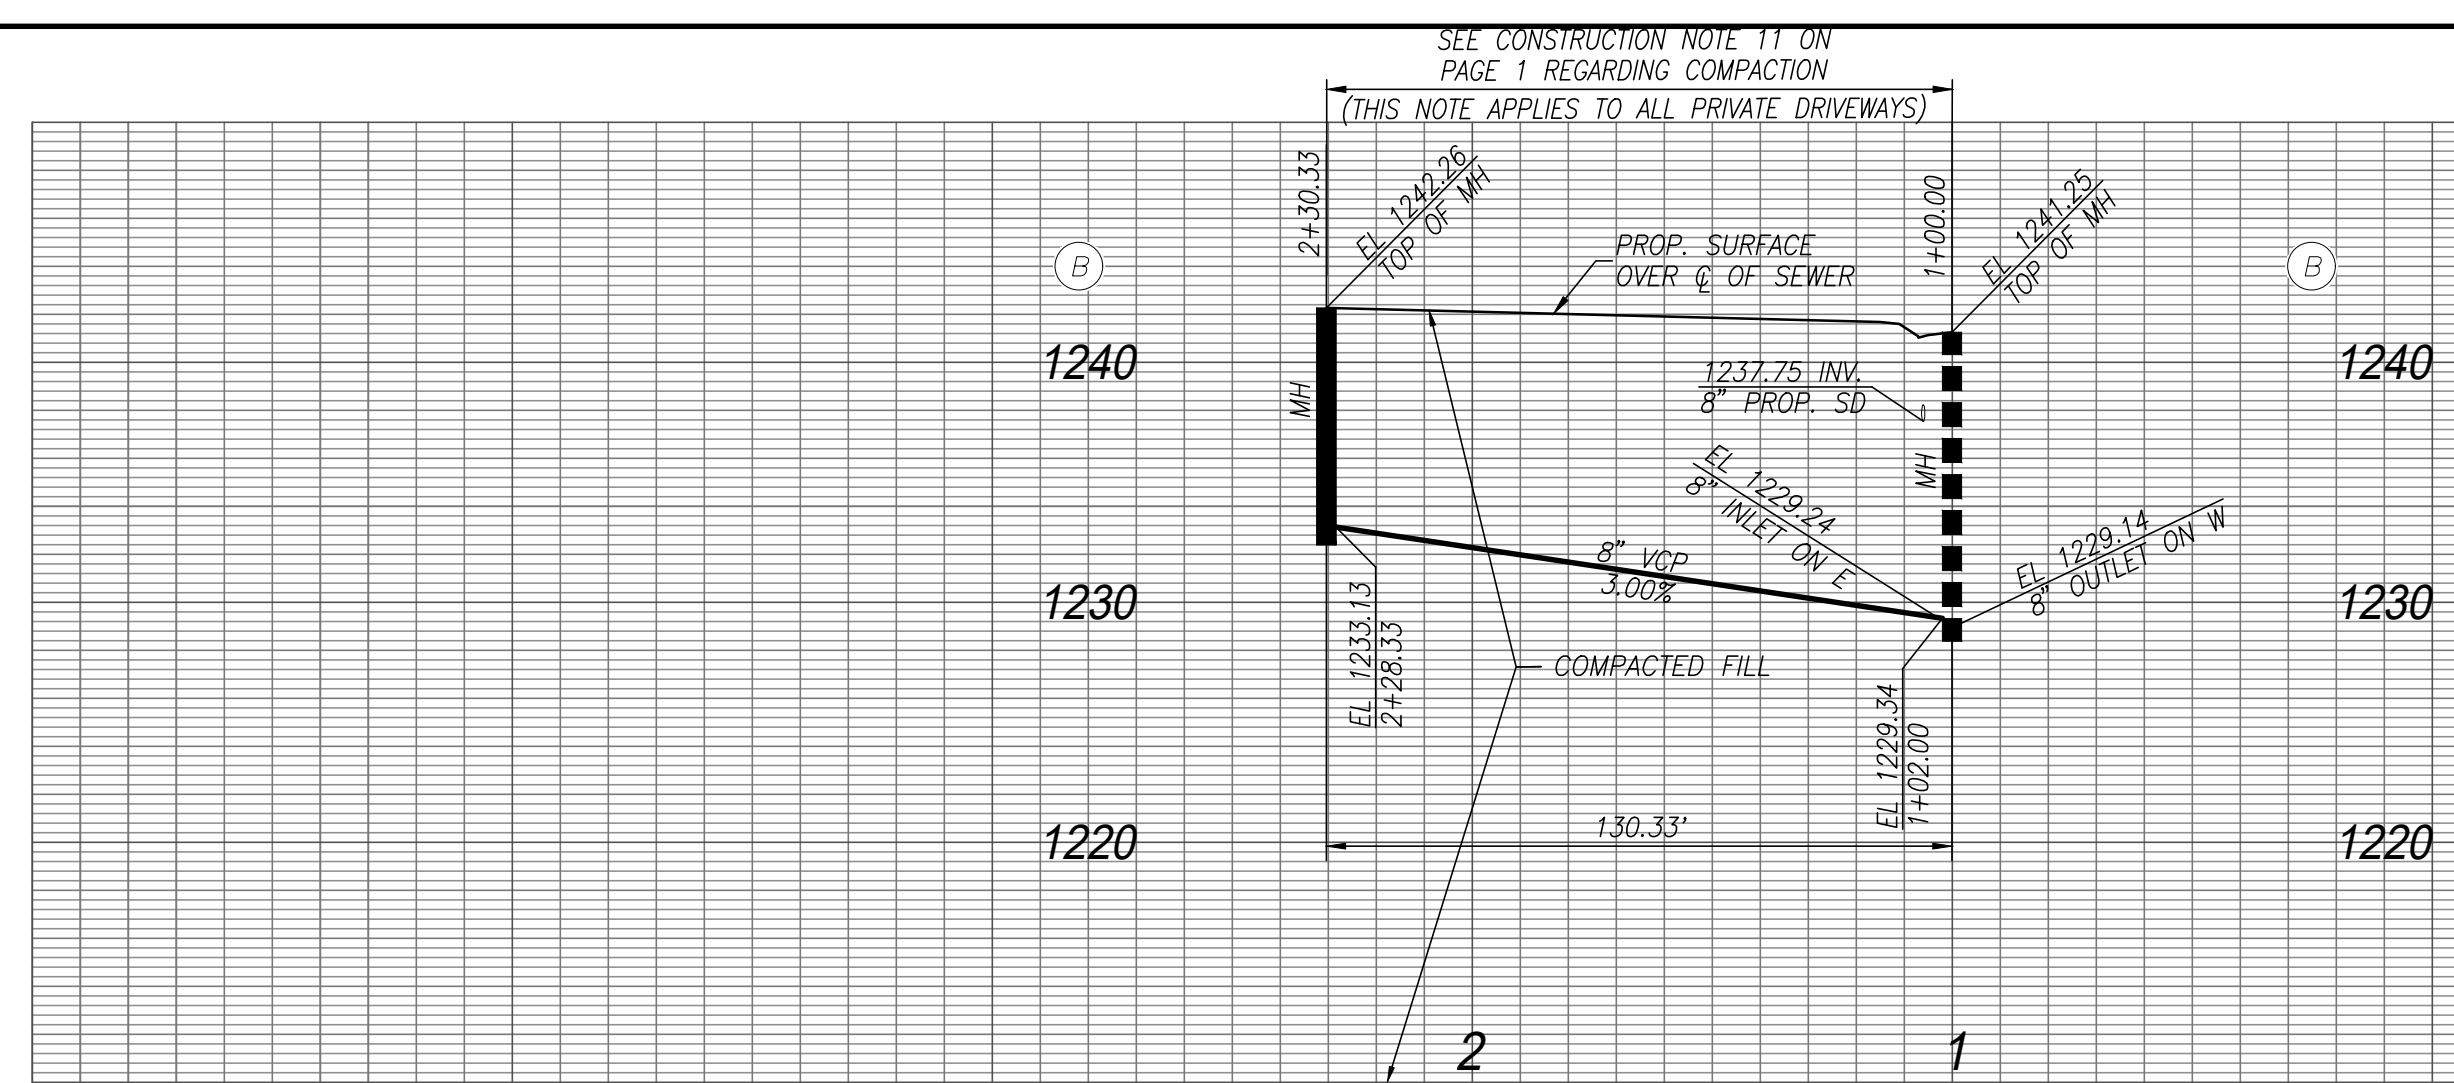

NO LA COUNTY CHARGES FOR CONNECTION
 SEE COUNTY SANITATION DISTRICTS FOR SPECIAL CONNECTION CHARGES
 TEL. (562) 908-4288, EX. 2727
 SCALE: VERT. 1" = 8'
 HORIZ. 1" = 40'
 DOUBLE SCALE

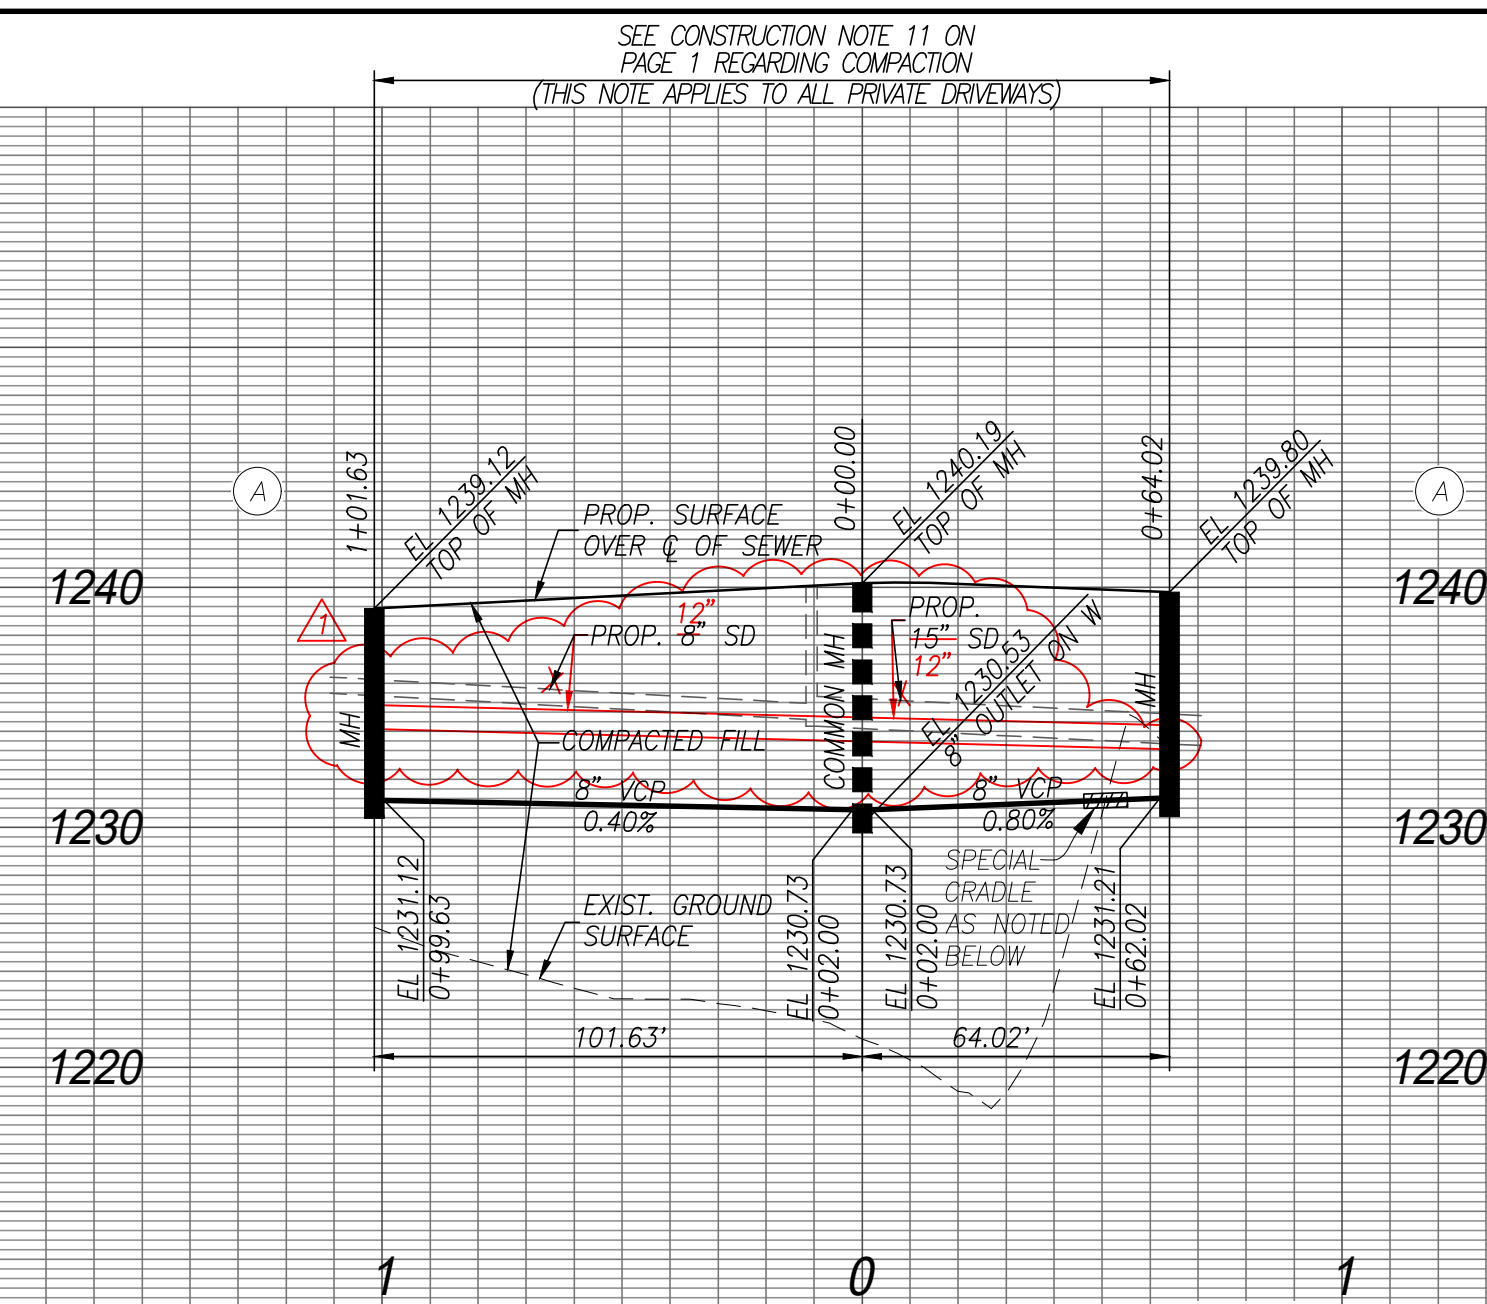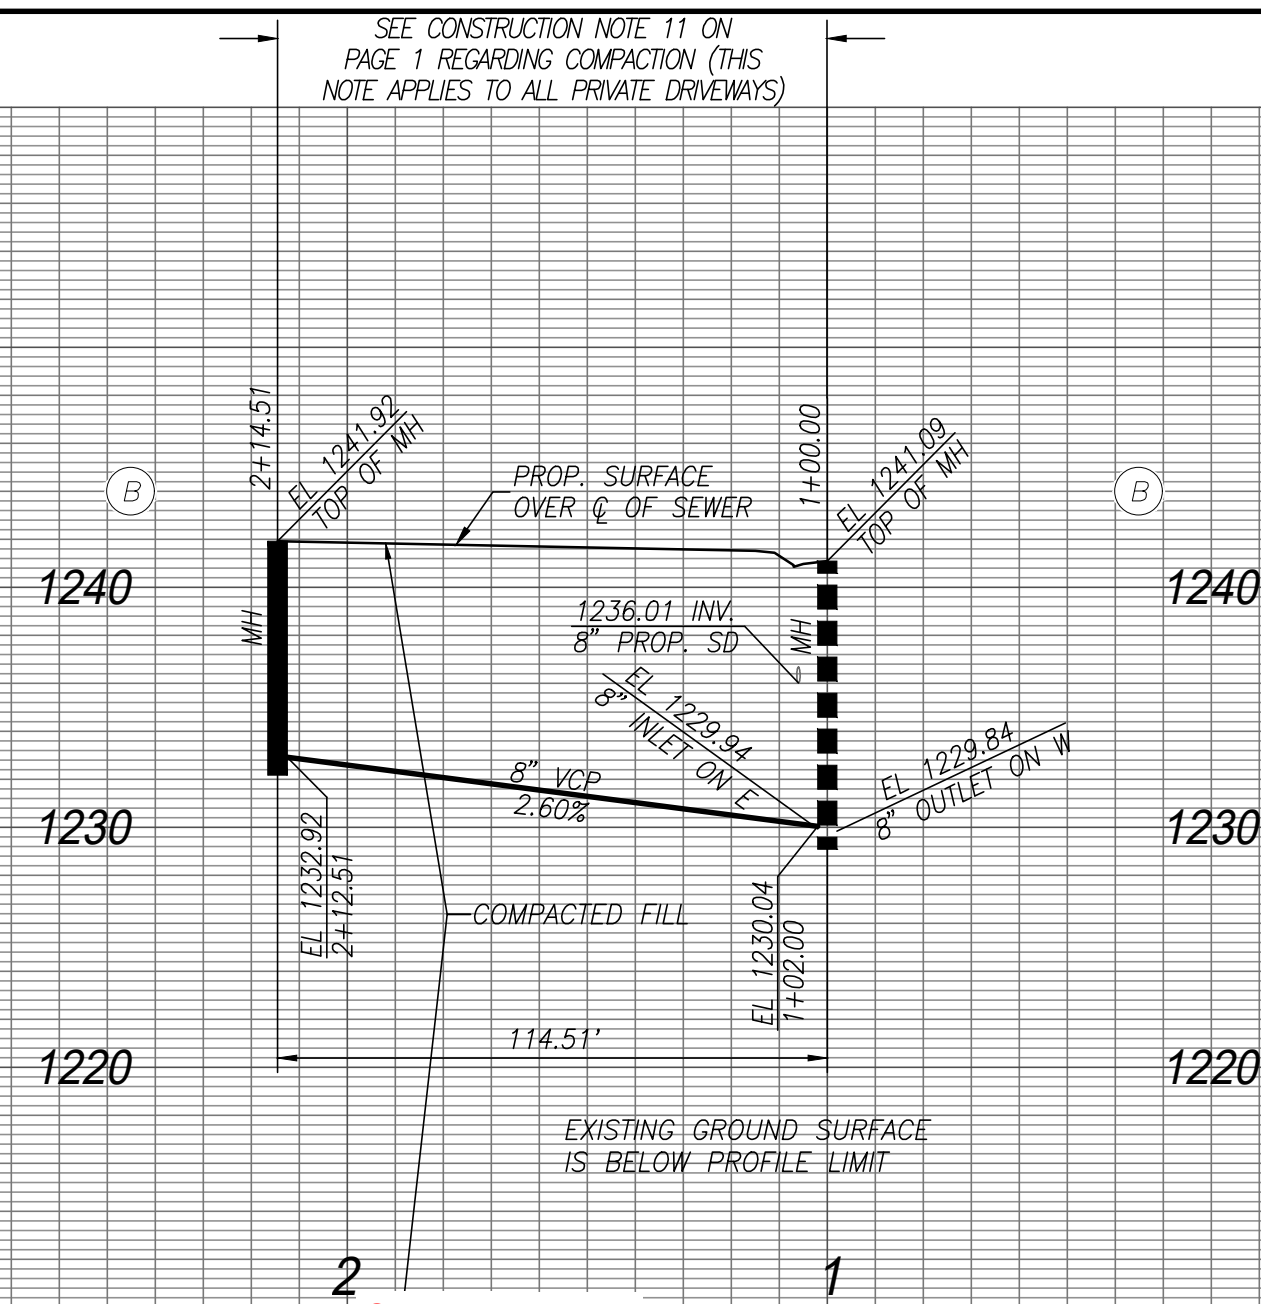


AS-BUILT AS OF 3/20/2020

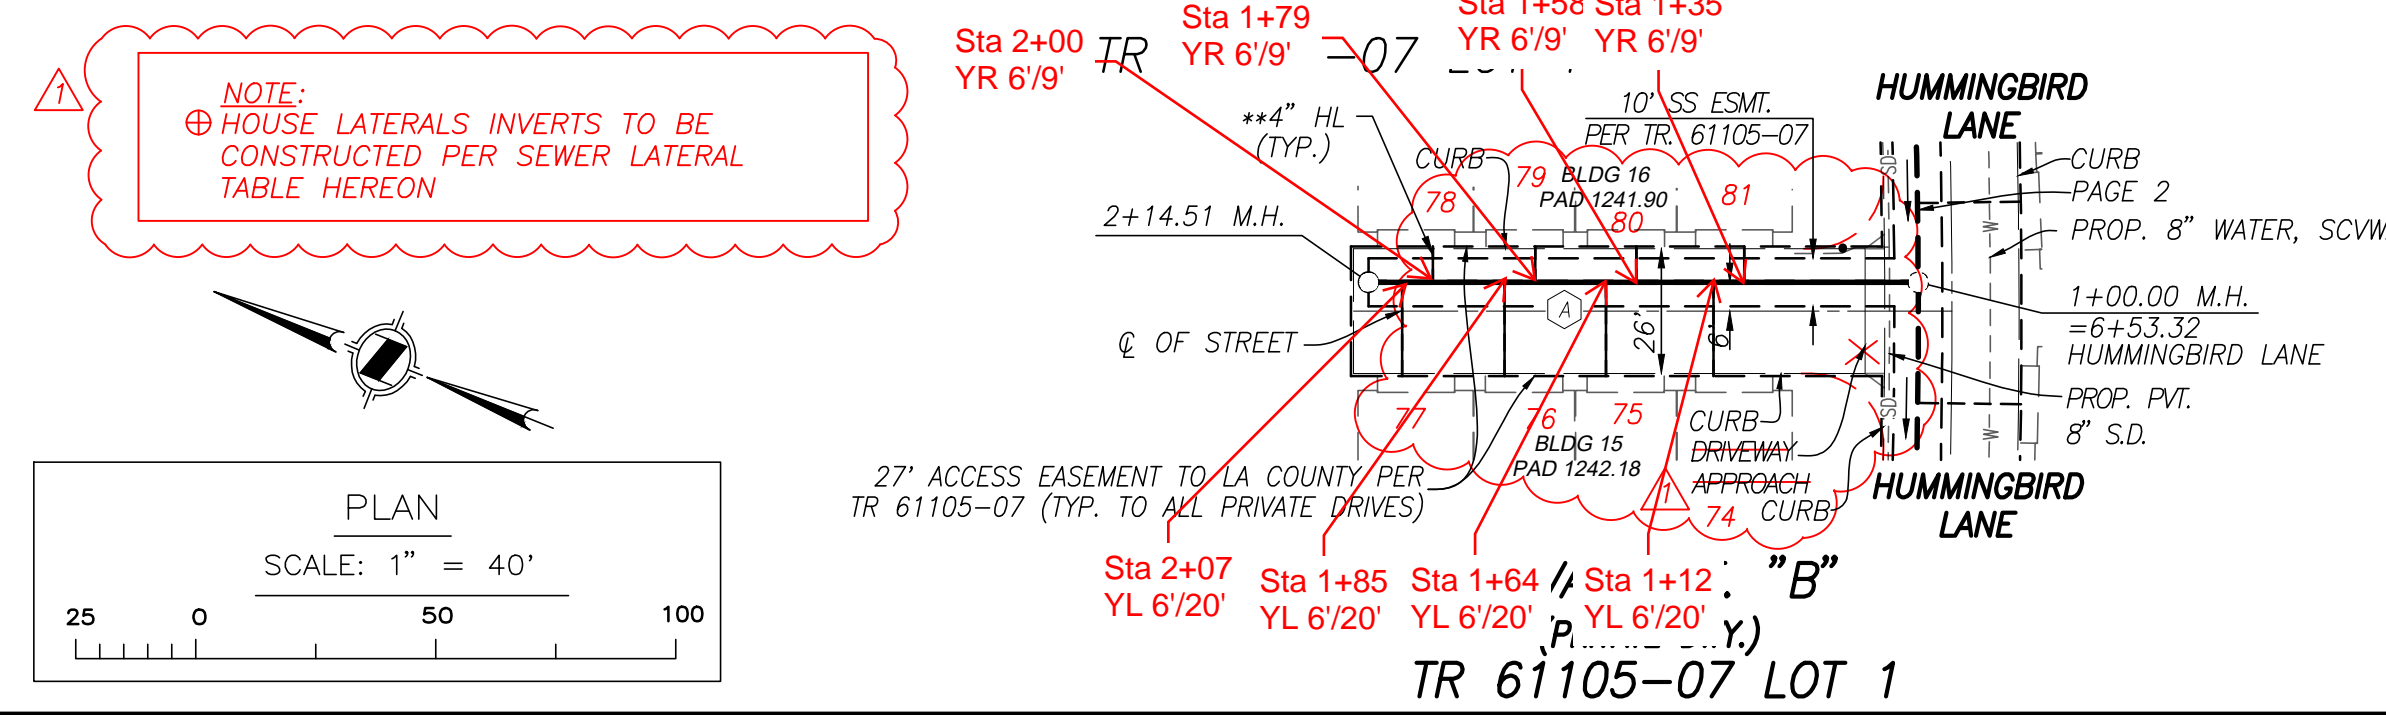

NOTE:
 ** BACKWATER VALVES SHALL BE REQUIRED FOR ALL UNITS.

SANITARY SEWER DATA TABLE

BEARING/Delta	LENGTH
N 21°55'13" W	114.51'
N 29°59'33" W	101.63'
N 29°59'33" W	64.02'

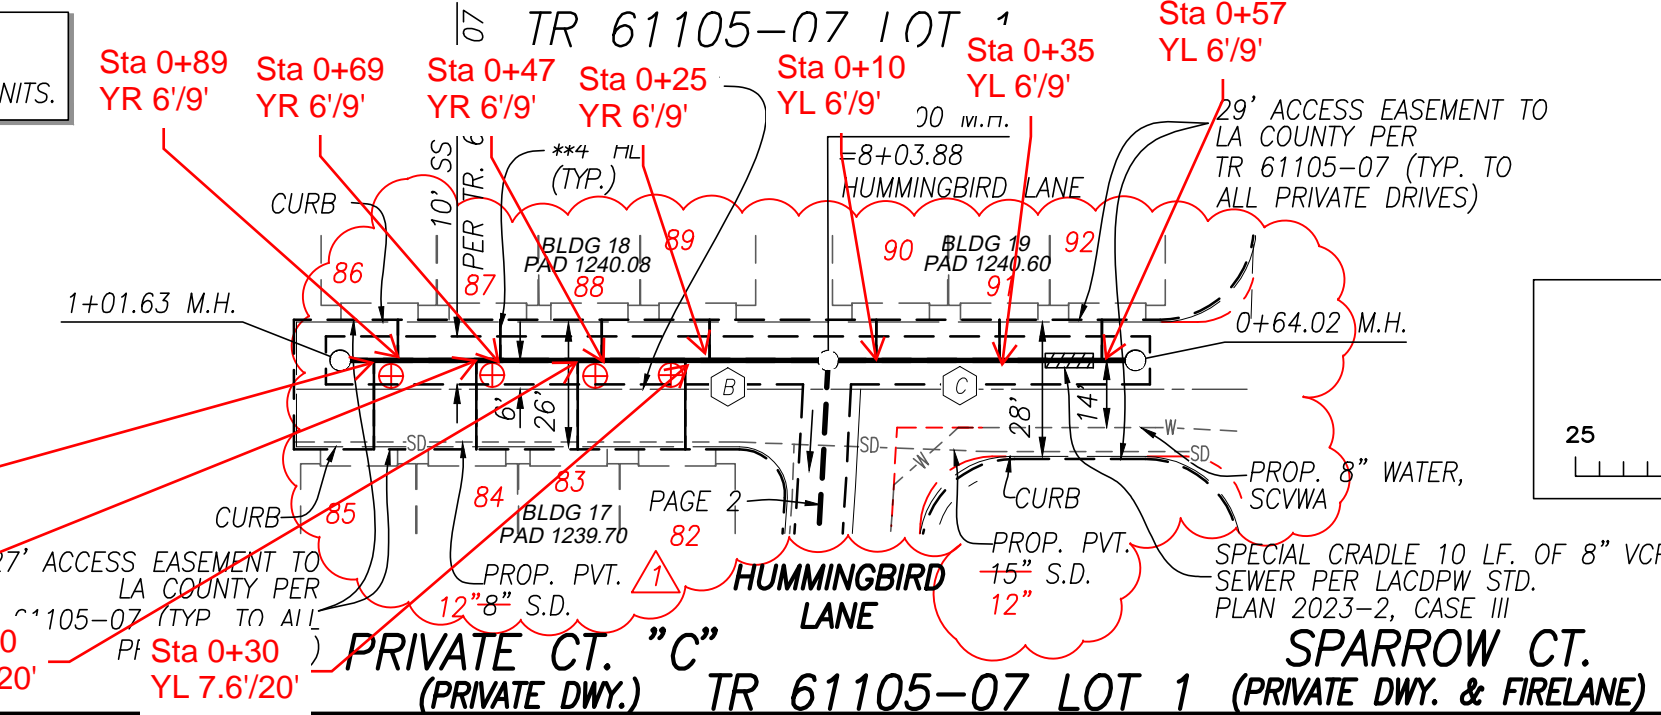

PLAN
 SCALE: 1" = 40'

REVIEWED BY LAND DEVELOPMENT DIVISION
 BY: [Signature] DATE: 1/17/2020
 FINAL MAPS, SEWER AND LANDSCAPING SUBDIVISION PLAN CHECKING SECTION

NO LA COUNTY CHARGES FOR CONNECTION
 SEE COUNTY SANITATION DISTRICTS FOR SPECIAL CONNECTION CHARGES
 (562) 908-4288, EX. 2727
 SCALE: VERT. 1" = 8'
 HORIZ. 1" = 40'
 DOUBLE SCALE

BLANK

REVIEWED BY LAND DEVELOPMENT DIVISION
 BY: [Signature] DATE: [Blank]
 FINAL MAPS, SEWER AND LANDSCAPING SUBDIVISION PLAN CHECKING SECTION



C:\Newhall_Ranch\61105_Mission_Village\61105-Builder\11\Sewer\HW448-03_P12_SS_PC12497P.dwg Plotted On: May 05, 2020 - 7:46am by Dorji