


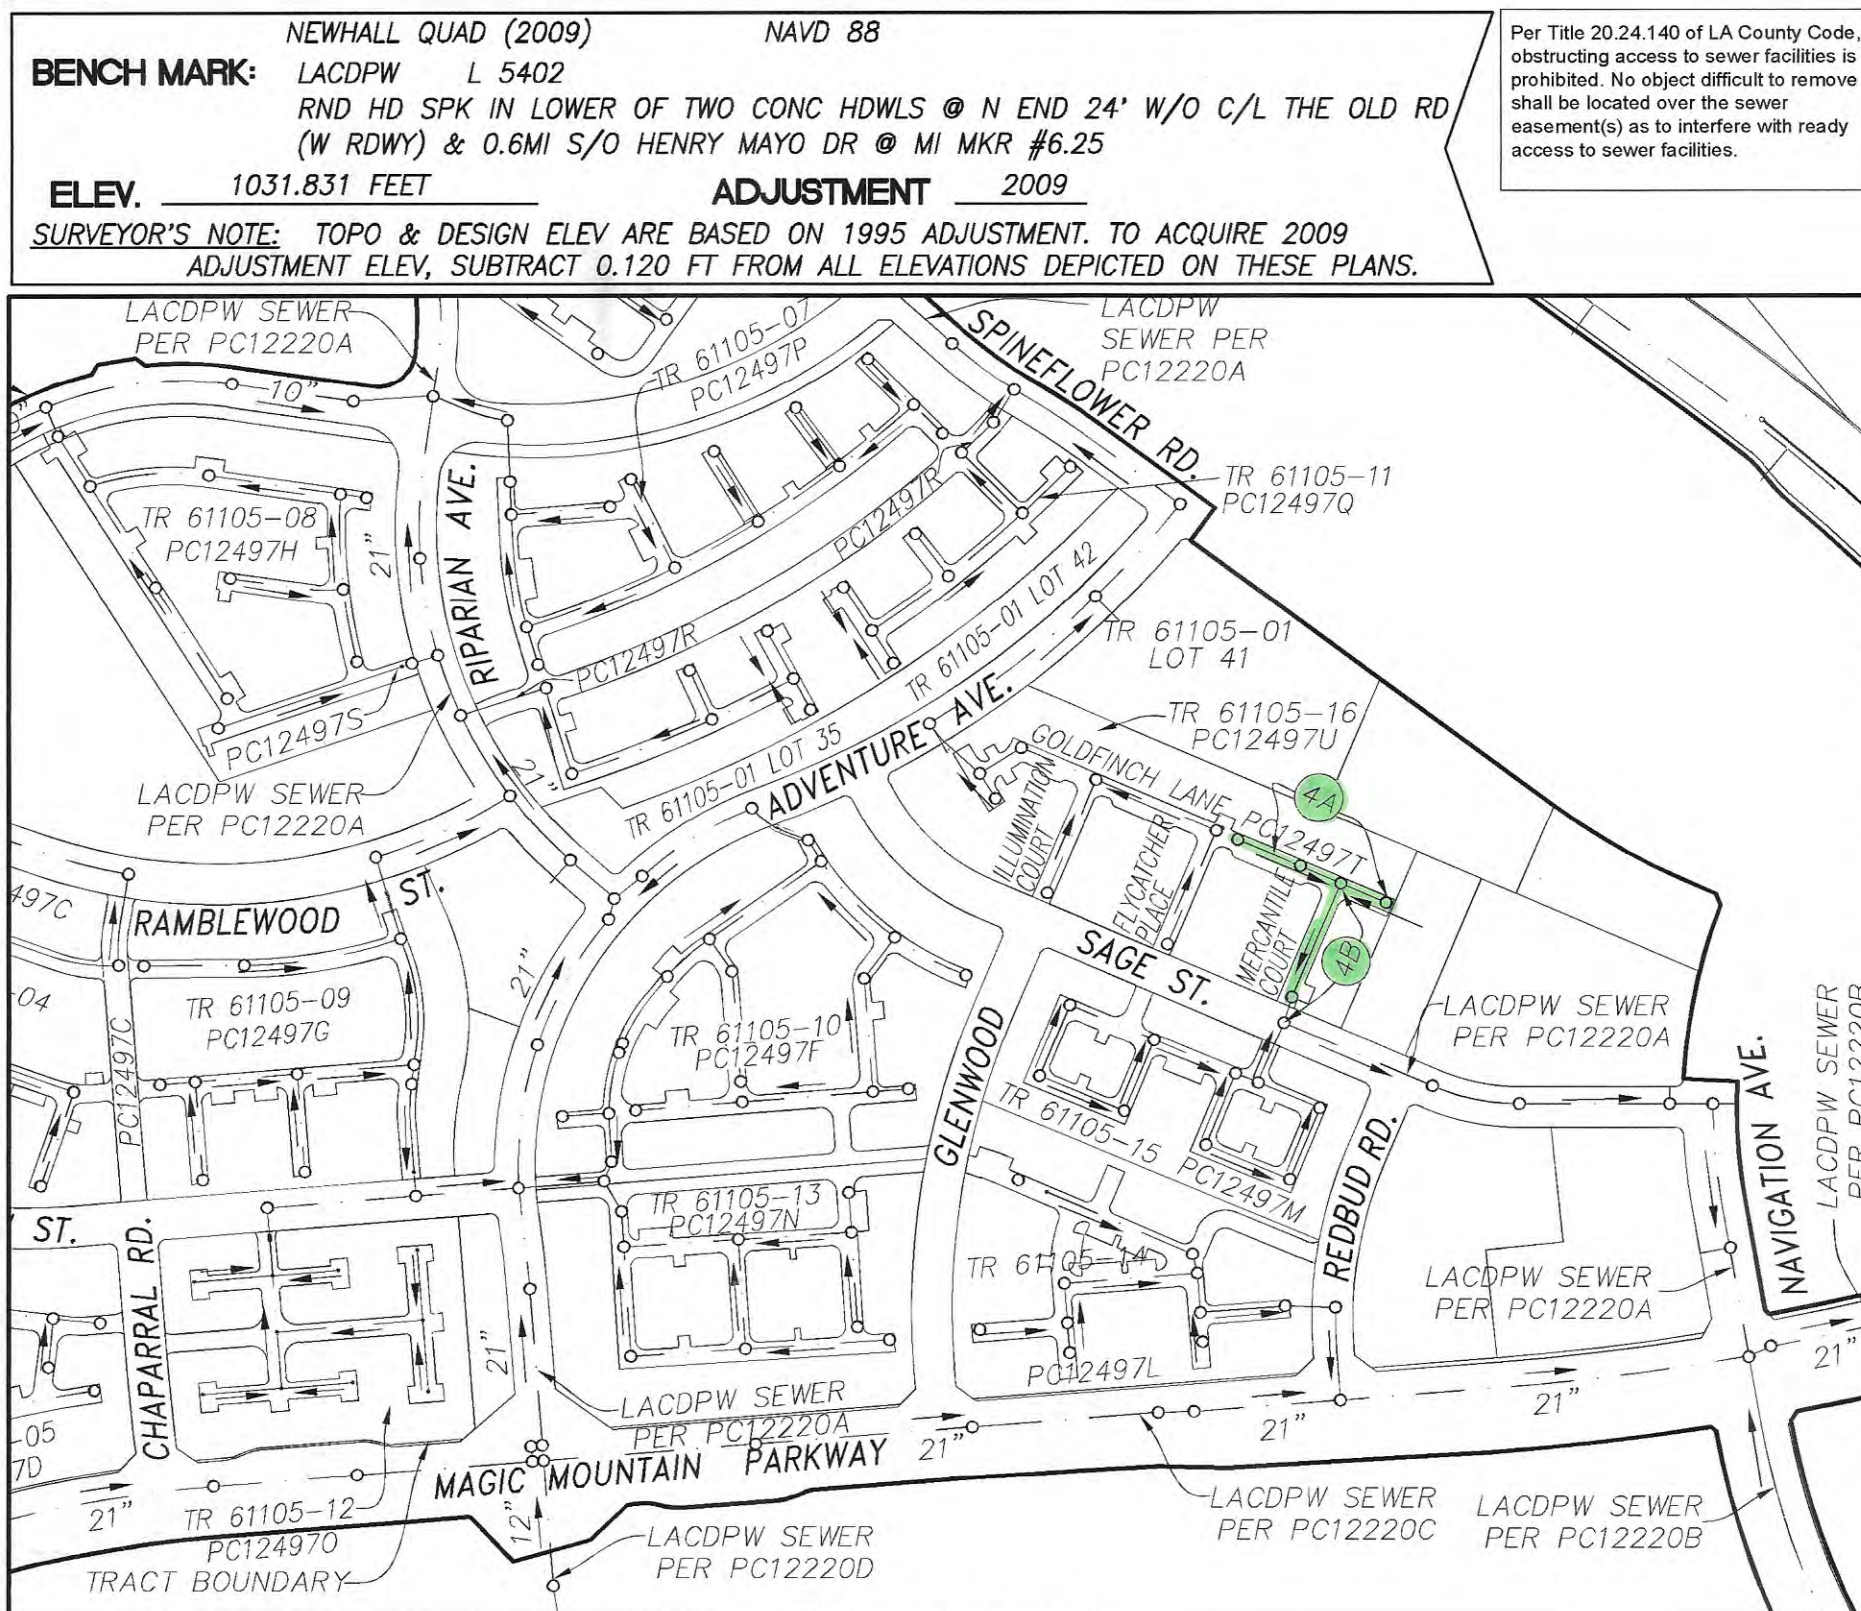

BUILDING AND SAFETY DISTRICT OFFICE: SANTA CLARITA

NOTES: NUMBER IN CIRCLE INDICATES PAGE NUMBER

ALL MAINLINE SANITARY SEWERS ARE WITHIN THE SANITARY SEWER EASEMENT

INDEX MAP

SCALE: 1"=300'

CSDM INDEX: N-1217

P.C. NO. 12497T TRACT NO. 61105-01 & 61105-16

THOMAS GUIDE PAGE: 4548 H3, J3

NO.	REVISION	REVISED BY	APPROVED BY	DATE
1	SHIFTED SEWER ON GOLDFINCH LANE DUE TO THE SITE PLAN CHANGES CAUSING THE CURB AND CENTERLINE TO SHIFT	JP (Jonathan H. Petke)		

BASIS OF BEARING

THE BEARINGS SHOWN HEREON ARE BASED ON THE BEARING 55°58'46"W OF THE SOUTHEASTLY LINE OF PARCEL MAP NO. 2400-01 FILED IN BOOK 283 PAGES 34 THROUGH 67, INCLUSIVE, OF PARCEL MAPS, RECORDS OF LOS ANGELES COUNTY.

- A. NOTES:
- Every effort should be made to eliminate the discharge of non-stormwater from the project site at all times.
 - Eroded sediments and other pollutants must be retained on-site and may not be transported from the site via sheet flow, swales, area drains, natural drainage courses or wind.
 - Stockpiles of earth and other construction related materials must be protected from being transported from the site by the forces of wind or water.
 - Fuels, oils, solvents, and other toxic materials must be stored in accordance with their listing and are not to contaminate the soil and surface waters. All approved storage containers are to be protected from the weather. Spills must be cleaned up immediately and disposed of in a proper manner. Spills may not be washed into the drainage system.
 - Excess or waste concrete may not be washed into the public way or any other drainage system. Provisions shall be made to retain concrete wastes on-site until they can be disposed of as solid waste.
 - Trash and construction related solid wastes must be deposited into a covered receptacle to prevent contamination of rainwater and dispersal by wind.
 - Sediments and other materials may not be tracked from the site by vehicle traffic. The construction entrance roadways must be stabilized so as to inhibit sediments from being deposited into the public way. Accidental depositions must be swept up immediately and may not be washed down by rain or other means.
 - Any slopes with disturbed soils or denuded of vegetation must be stabilized so as to inhibit erosion by wind and water.
 - The following BMPs as outlined in, but not limited to, the latest edition of the California BMP Handbook (Construction) or Caltrans Stormwater Quality Handbooks (Construction Site BMP Manual), may apply during the construction of this project (additional measures may be required if deemed appropriate by the Project Engineer or the Building Official).
- B. STANDARD PLANS:
- The following latest revised standard plans on file in the office of the following department shall apply in the construction of this project.
- LOS ANGELES COUNTY DEPARTMENT OF PUBLIC WORKS
- Legend for sanitary sewer plans and profiles and district maps. 2021-1
- 2000-0
- 2002-1
- 2003-2
- 2004-1
- 2004-2
- 2014-1
- 2015-1
- STANDARD PLANS FOR PUBLIC WORKS CONSTRUCTION (SPPWC)
- 200-3
- 201-2
- 202-2
- 203-2
- 1000-2

- PRIVATE CONTRACT SEWER GENERAL NOTES
- A sewer construction permit shall be obtained and a fee paid for construction inspection and record plans to the County of Los Angeles Department of Public Works at the Permit Counter, 800 South Fremont Avenue, 8th Floor, Alhambra, at least 72 hours prior to starting work under this permit. Copies of all other required permits, such as road excavation, Caltrans, etc., must be filed with the permit application.
 - When work is within a permit city, a sewer construction permit shall be obtained and a fee paid for construction inspection and record plans to the City.
 - The contractor must contact the Director of Public Works of that City to determine the location to pay the inspection fees.
 - Prior to issuance of any permit, the contractor shall file a permit for excavations and trenches from the State of California Division of Industrial Safety, and a Certificate of Worker's Compensation Insurance with the Department of Public Works named as the Certificate Holder or both as applicable. The County of Los Angeles Department of Public Works shall be notified 30 days prior to cancellation of the insurance policy.
 - If work is done in a State Highway, a permit must be obtained from the State of California Division of Highways, 120 South Spring Street, Los Angeles, California.
 - The contractor shall contact the district office listed on the "Application for Construction Permit" to arrange for an acceptable construction start date.
 - Approval of this plan by the County of Los Angeles Department of Public Works does not constitute a representation as to accuracy of the location of or the existence or nonexistence of any underground utility pipe or structure within the limits of this project. This note applied to all pages.
 - All work shall be in accordance with the latest approved edition of the "Standard Specification for Public Works Construction" including supplements (if there is any), the latest "Additions and Amendments to the Standard Specifications for Public Works Construction," and the latest "Special Provisions for the Construction for Sanitary Sewer" and shall be prosecuted only in the presence of the County of Los Angeles Department of Public Works.
 - The contractor's attention is directed to Section 7-10.4.2 of the "Standard Specifications for Public Works Construction" in regard to safety orders and shall conform to the "Minimum Public Safety Requirement" as shown on County of Los Angeles Department of Public Works Standard Plan No. 6008-1.
 - Elevations are in feet above U.S.C. and G.S. sea level datum of 1988.
 - No revisions shall be made in these plans without the approval of the County of Los Angeles Department of Public Works.
 - No representative of the County of Los Angeles Department of Public Works will survey or layout any portion of the work.
 - Grades to which this improvement is to be constructed are shown on plans and profiles. Grade point for top of curbs, centerline of streets, or centerline of alleys, is shown by circles on profiles at all points between said design points. The grade shall be established so as to conform to a straight line drawn between said design points.
 - The private engineer shall furnish the County of Los Angeles Department of Public Works with grade sheets and stationing for all house laterals and "Y" and "T" branches and shall provide stakes for them at their proper locations with stationing plainly marked. All house laterals shall be constructed in a straight alignment at right angles from the main sewer except as shown on the plans. House laterals from chimneys shall not have an angle of less than 45 degrees with the M.L. sewer. Any change in alignment shall be requested in writing by the private engineer.
 - The private engineer shall furnish the house lateral depth at the property line below the top of curb elevation for each house lateral on the grade sheet.
 - An approved backwater valve is required when the pad is lower in elevation than the top of the next upstream manhole.
 - Contact Environmental Programs Division for an Industrial Waste Discharge Permit at (626) 458-3517.
 - When work is encroaching into Flood Control District easement and/or crossing its facilities, a Flood Control permit shall be obtained from the Los Angeles County Flood Control District at https://epic.lacounty.gov at least 4 weeks prior to your desired start-up date. If you need additional information, you may contact Land Development Division - Permits Section Public Counter at 626-458-4921.
- CONSTRUCTION NOTES
- Provide survey stakes on the property line or property lines produced at right angles to the sewer line at the centerline of each manhole.
 - Verified day pipe joints shall be type "D" or "G" per "Standard Specifications for Public Works Construction" Section 208-2.
 - If a power pole is within three feet of the sewer, the sewer shall be encased, per LACDPW Standard Plan 2023-2, Case II, two feet on each side from the point of interference.
 - All joints between cast-iron pipe and vitrified clay pipe shall be made with a rubber sleeve joint, type "D" (with bushing if necessary), per "Standard Specifications for Public Works Construction" Section 208-2.
 - House laterals to be constructed with inverts at the property line 6 feet below curb grade except as noted.
 - Wye or tee branches may be used for connections to the mainline sewers except as noted.
 - If during the course of construction it is determined that there is less than four feet of cover over the top of a mainline or house lateral V.C.P. sewer, which is not indicated on the plans, the pipes shall be encased per LACDPW Standard Plan 5-3 (SPPWC 203-2), or precast concrete sewer manholes per LACDPW Standard Plan 5-36 (SPPWC 203-3), or reinforced precast manhole per LACDPW Standard Plan 2003-2, except as noted.
 - Resurface all trenches within paved areas to meet Department of Public Work or California State Highway requirements in accordance with the standards.
 - Full compliance with Section 306-12.2 of the "Standard Specifications for Public Works Construction" will be required for backfill in street. Certification of backfill, compaction, and sand equivalents by a qualified Civil Engineer shall be provided by the permittee prior to the issuance of a Certificate of Partial Acceptance.
 - All backfill and fills outside of the street right of way shall be compacted to 90 percent of the maximum density as determined by ASTM Soil Compaction Test D 1557-78, Method "D", unless otherwise specified. This shall be certified by a qualified Civil Engineer. This certification shall be submitted to the Land Development Division, Permit Section of the County of Los Angeles Department of Public Works prior to the acceptance of the work by the County.
 - Manhole tops in unimproved rights of way to be six inches above finished grade.
 - Sewers to be tested for leakage per Section 306-7.8 of the "Standard Specification for Public Works Construction" and "Special Provisions for the Construction of Sanitary Sewer" if applicable.
 - Manhole tops in improved rights of way to be level with finished grade.
 - All wyes and/or house laterals are to be located at least 5 feet apart, and when possible, not closer than 5 feet to any manhole.
 - All pipe materials shall be vitrified clay pipe or ductile iron pipe or other approved materials by the County of Los Angeles Department of Public Works.
 - All Ductile iron pipes shall be lined with Protecto 401 Ceramic Epoxy lining.
 - Cured in place pipe liner shall be used for all extra vitrified clay pipe if lining is required.
 - All Chimneys shall have terminal cleanout structure per SPPWC std. plan 204-2 and with traffic rated frame and cover.

PROFILE, ALIGNMENT, AND GRADE OF

PAGE 1

SANITARY SEWERS

TO BE CONSTRUCTED IN


TRACT NO. 61105-01 & 61105-16 PC NO. 12497T

NO LA COUNTY CHARGES FOR CONNECTION

SEE COUNTY SANITATION DISTRICTS FOR SPECIAL CONNECTION CHARGES
(562) 908-4288, EX. 2727

SCALE: VERT. 1" = 8'
HORIZ. 1" = 40'

DOUBLE SCALE

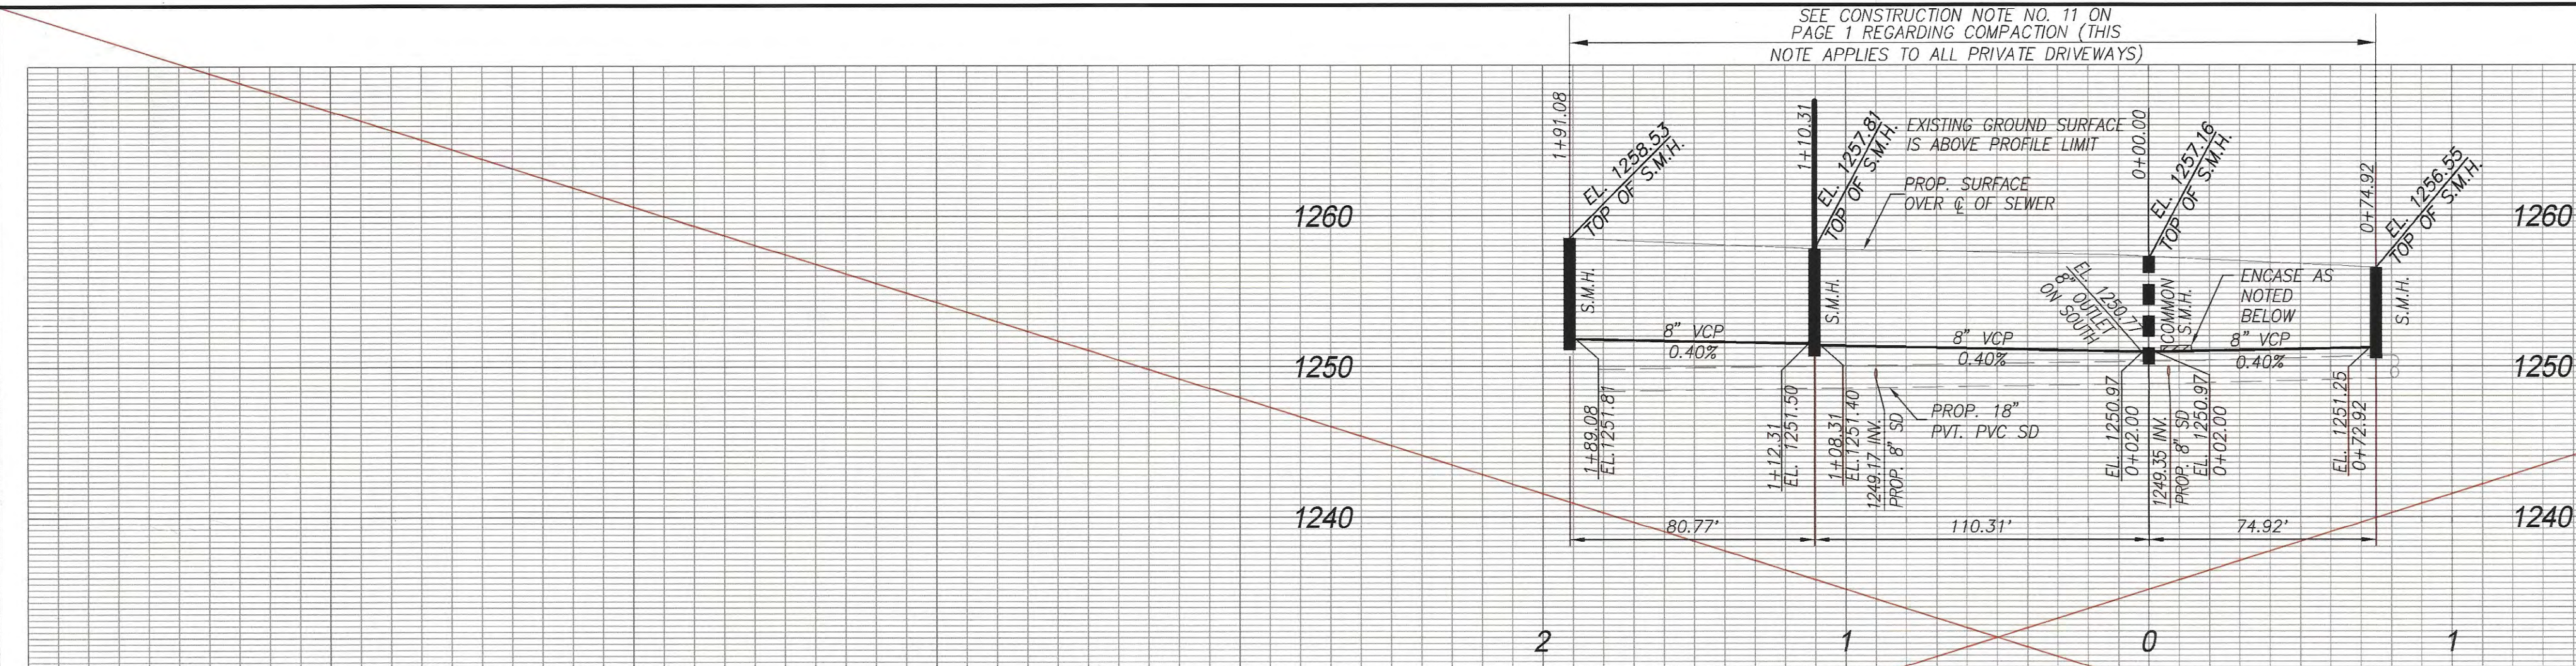

SANITARY SEWER DATA TABLE

BEARING/DELTA	LENGTH
N 51°49'32" W	80.77'
N 51°49'32" W	110.31'
N 51°49'32" W	74.92'

NOTE:
** BACKWATER VALVES SHALL BE REQUIRED FOR ALL UNITS.

HOUSE LATERALS TO BE CONSTRUCTED WITH 1/4" RISE PER FOOT TO EASEMENT. WYES TO BE LAID HORIZONTAL.



REVIEWED BY LAND DEVELOPMENT DIVISION


BY: FINAL MAPS, SEWER AND LANDSCAPING SUBDIVISION PLAN CHECKING SECTION DATE:

NO LA COUNTY CHARGES FOR CONNECTION

SEE COUNTY SANITATION DISTRICTS FOR SPECIAL CONNECTION CHARGES
(562) 908-4288, EX. 2727

SCALE: VERT. 1" = 8'
HORIZ. 1" = 40'

DOUBLE SCALE

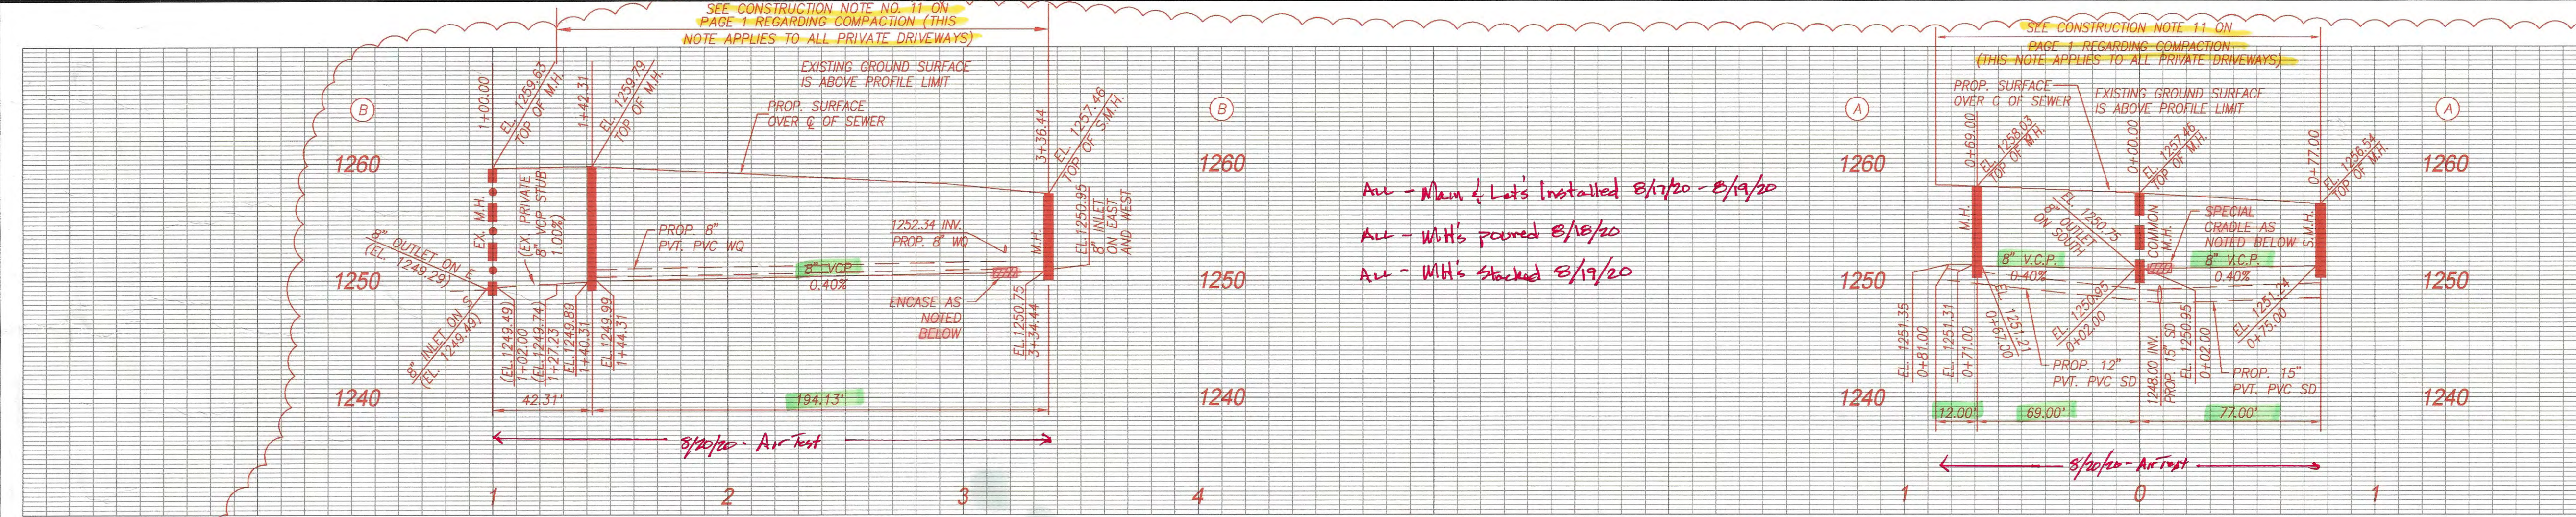

ALL - Main & Lateral Installed 8/1/20 - 8/19/20

ALL - M.H.'s poured 8/18/20

ALL - M.H.'s stacked 8/19/20

AS-BUILTS
OCT 20 2020
Sam Hill & Sons, Inc.



REVIEWED BY LAND DEVELOPMENT DIVISION

BY: FINAL MAPS, SEWER AND LANDSCAPING SUBDIVISION PLAN CHECKING SECTION DATE:

SANITARY SEWER DATA TABLE

BEARING/DELTA	LENGTH
N 51°49'32" W	17.50'
N 51°49'32" W	69.00'
N 51°49'32" W	77.18'
N 38°10'28" E	194.13'

NOTE:
* ACCEPTANCE OF THIS 8" LINE FOR COUNTY MAINTENANCE IS CONTINGENT UPON MEETING ALL CONSTRUCTION AND INSPECTION REQUIREMENTS FOR THE FUTURE UPSTREAM SYSTEM.

** BACKWATER VALVES SHALL BE REQUIRED FOR ALL UNITS.

FUTURE CONNECTION - ISSUE NO HL PERMIT. MAINLINE MUST BE EXTENDED AND MANHOLE CONSTRUCTED

NOTE:
HOUSE LATERALS TO BE CONSTRUCTED WITH 1/4" RISE PER FOOT TO EASEMENT. WYES TO BE HORIZONTAL.

NOTE:
*** S.M.H. TO BE CONSTRUCTED PER STD. PLAN 2002-1 AND 2014-1.