
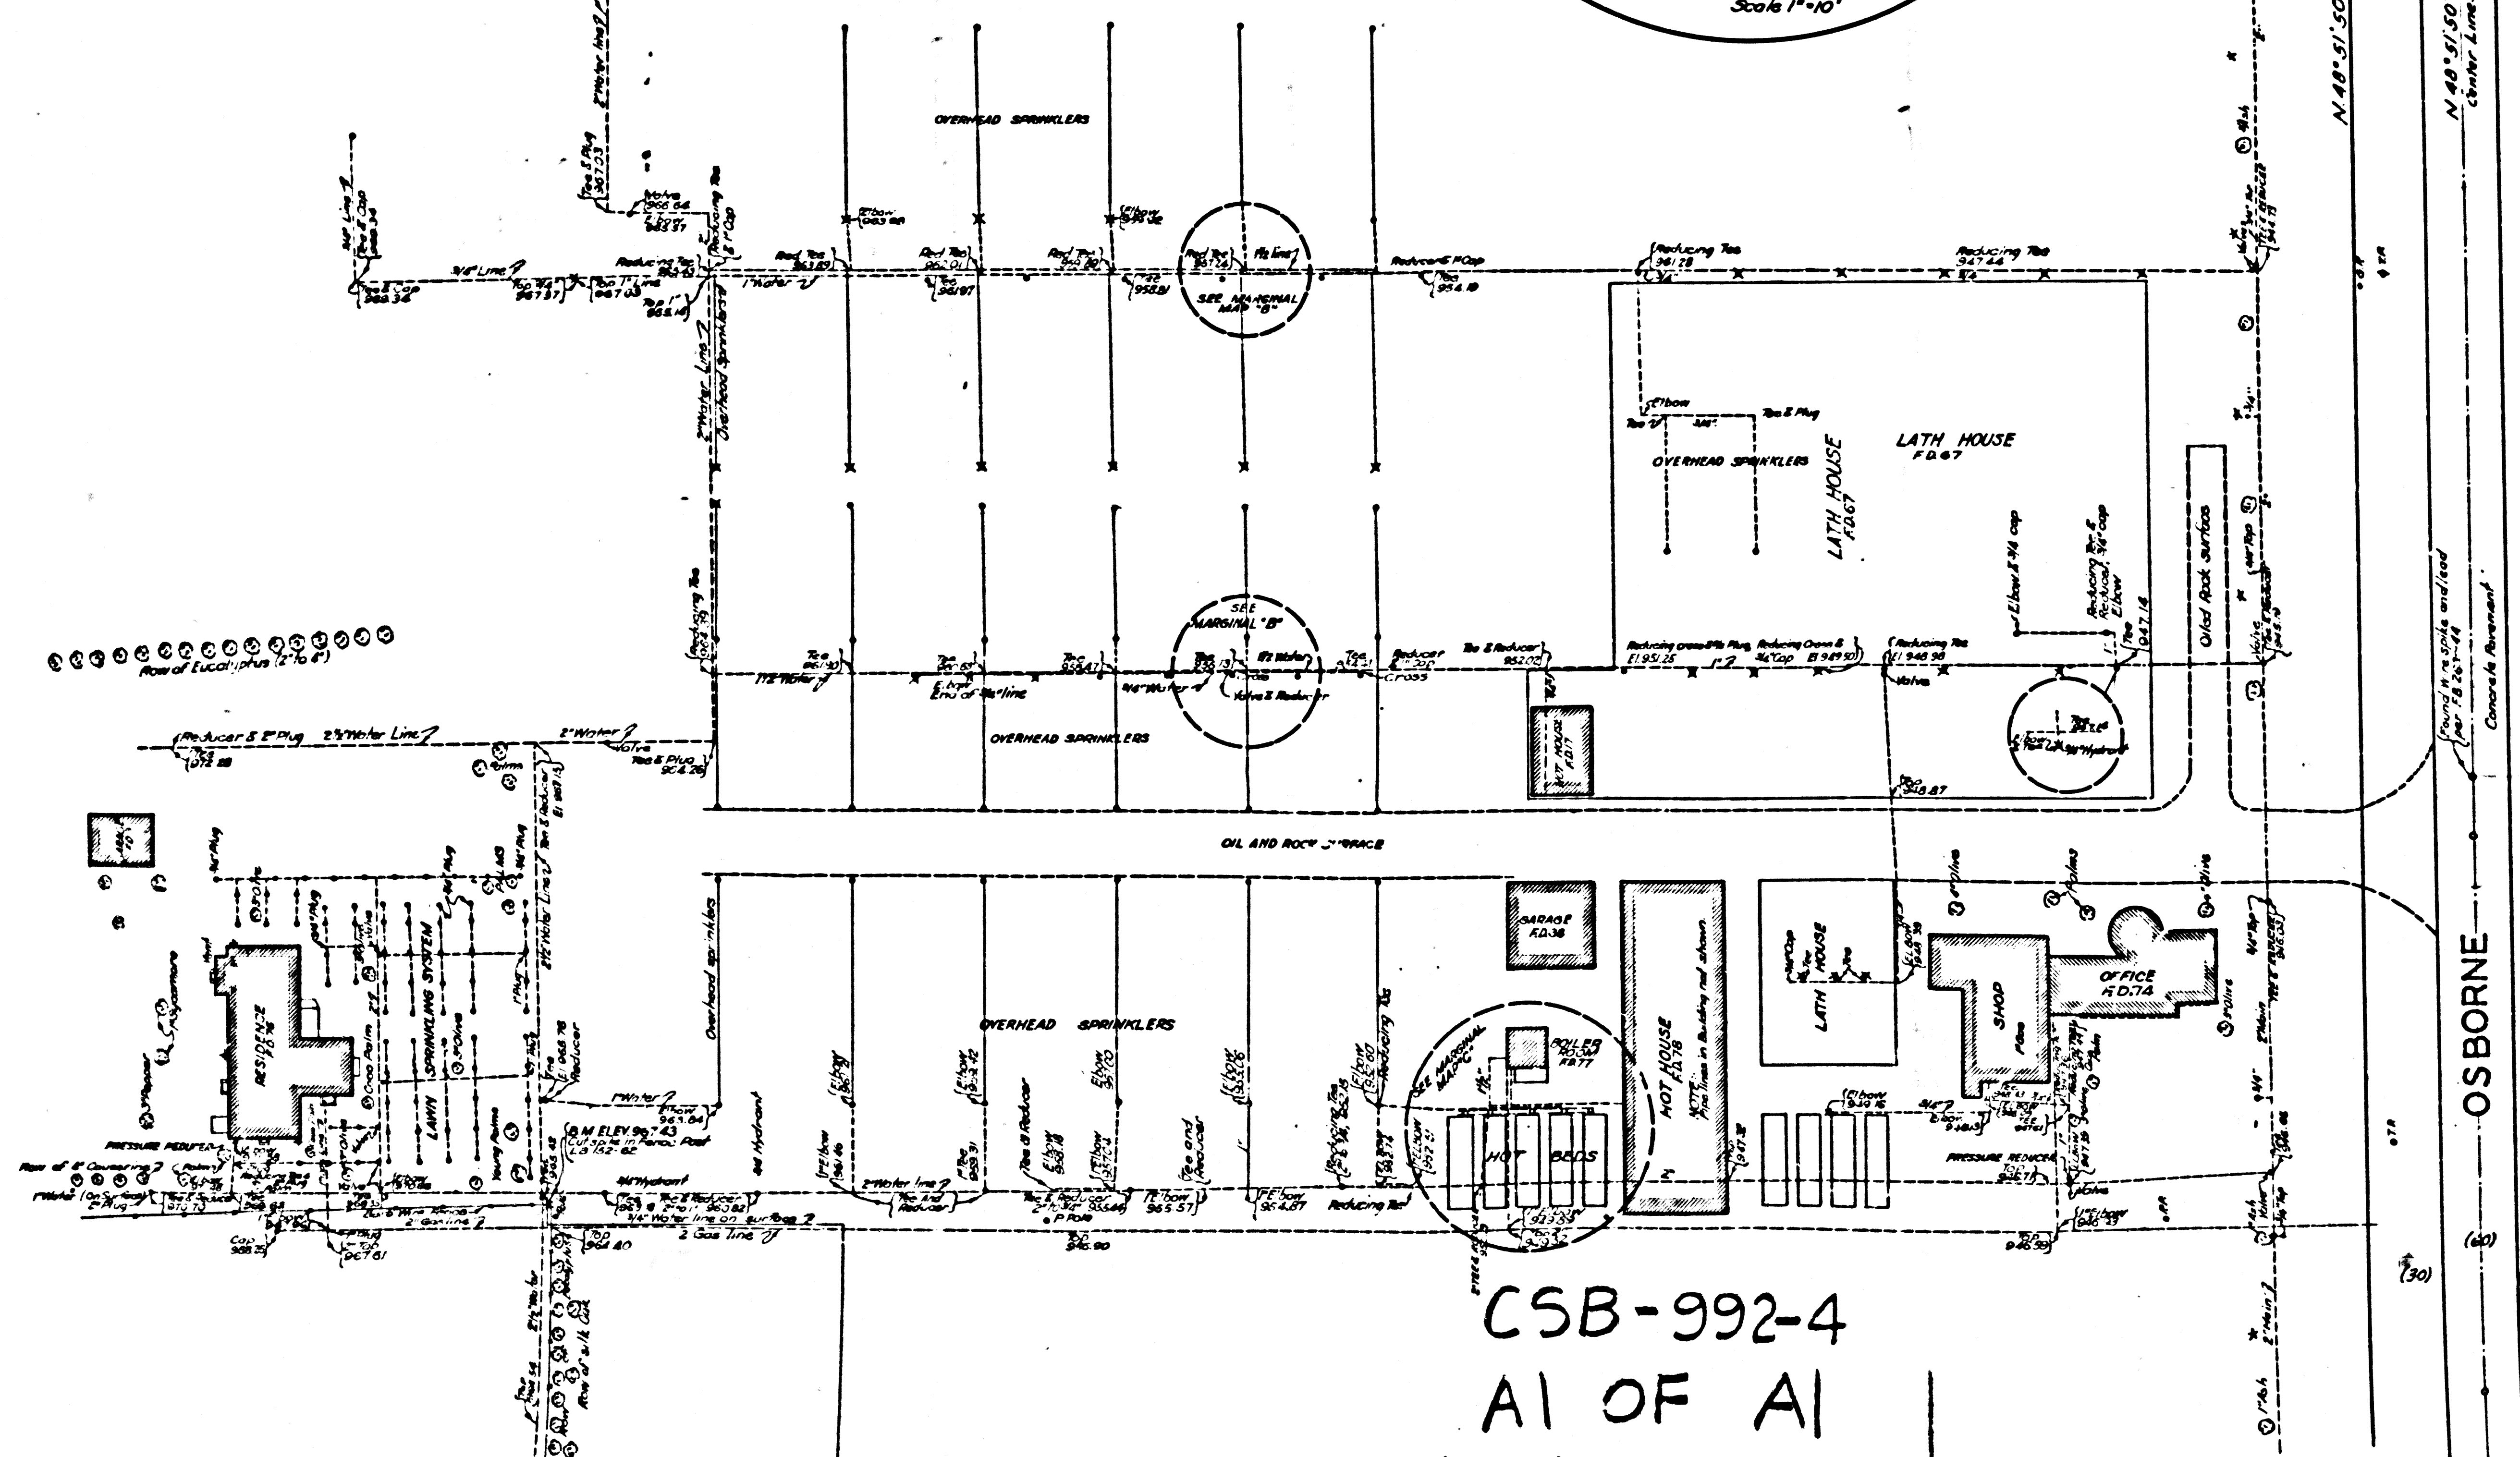
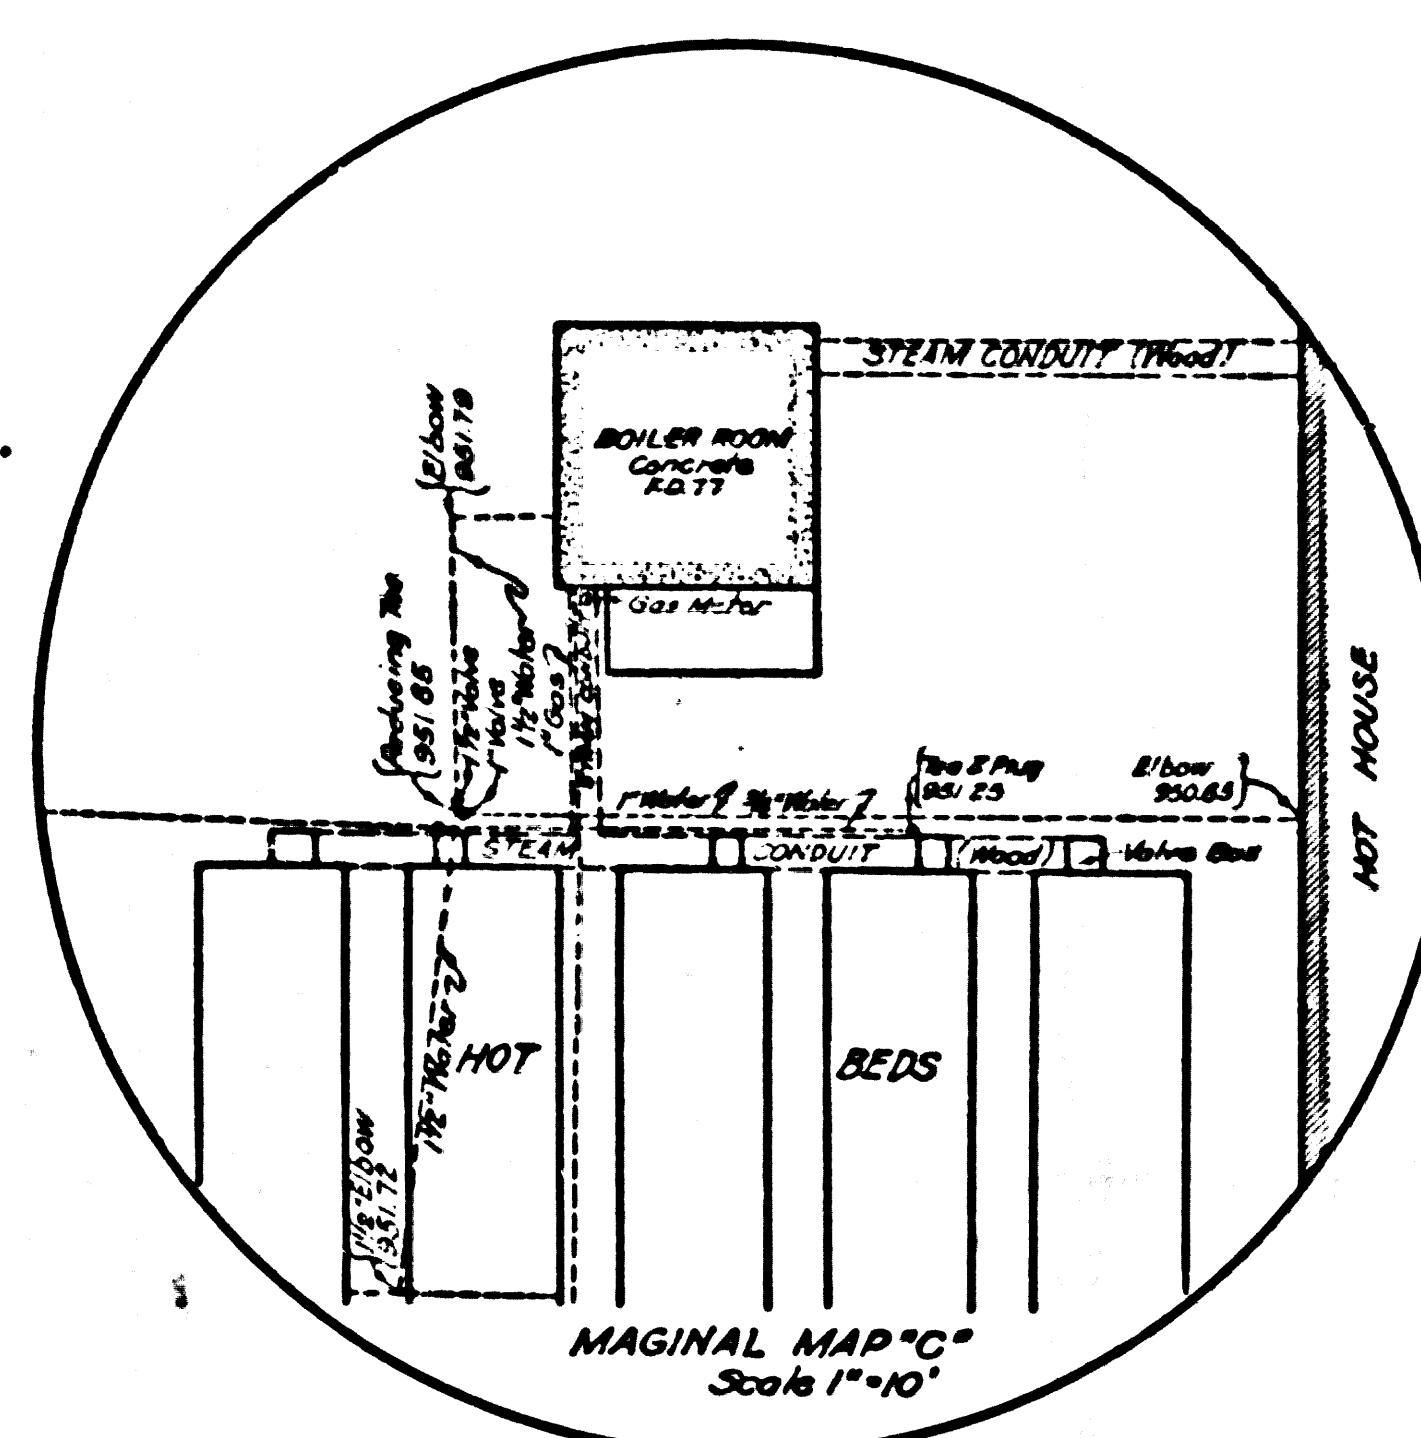
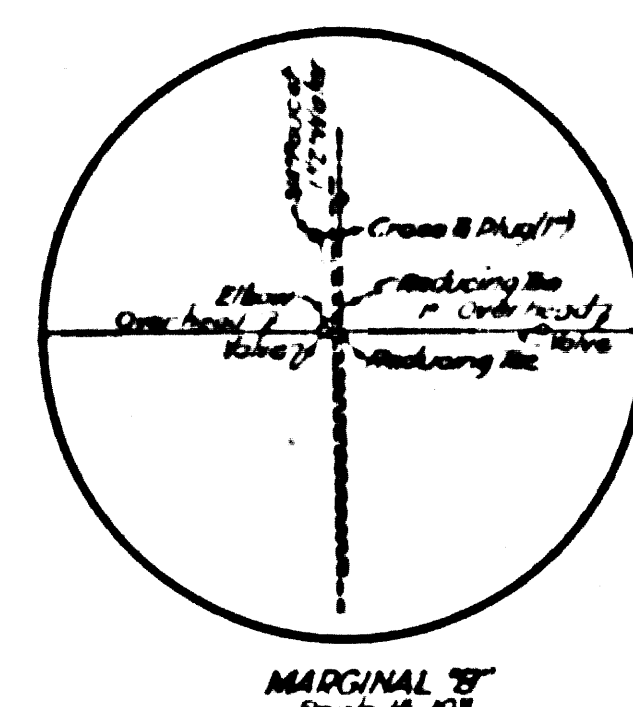


SUPERSEDED

BY

C.S. B-1809-4.

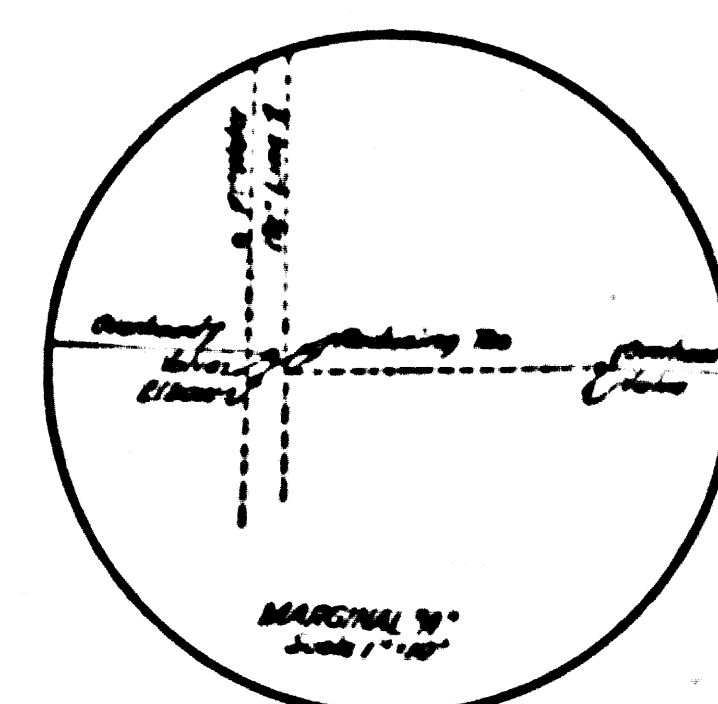

ROGER JESSUP PARK TOPOGRAPHIC MAP OF **PACOIMA PARK** BEING A PORTION OF PETER HAACK'S RANCH - M.B.13-101

COUNTY SURVEYORS MAP N^o B-992
SHEET N^o 4 OF 4 SHEETS
SCALE - AS SHOWN

JOB NUMBER 7154

J.E. ROCKHOLD - COUNTY SURVEYOR
SURVEYED - JANUARY 1934

BEARINGS ARE BASED ON THE BEARING OF
OSBORNE AVENUE PER C.S. 7625



PLANE TABLE SURVEY
FIELD WORK BY T.M. WALSH
OFFICE WORK BY W.J. LUCAS
CHECKED BY A.H. DREW

FOR PROPERTY LINE SURVEY SEE C.S.B. 775

SCALE IN FEET
INDEX 53

ROGER JESSUP PARK WAS FORMERLY KNOWN AS PACOIMA PARK
NAME CHANGE AUTHORIZED BY THE BOARD OF SUPERVISORS IN
THEIR ORDER OF AUGUST 9, 1938.

SHEET No 3 OF 4 SHEETS
COUNTY SURVEYORS MAP No B-805

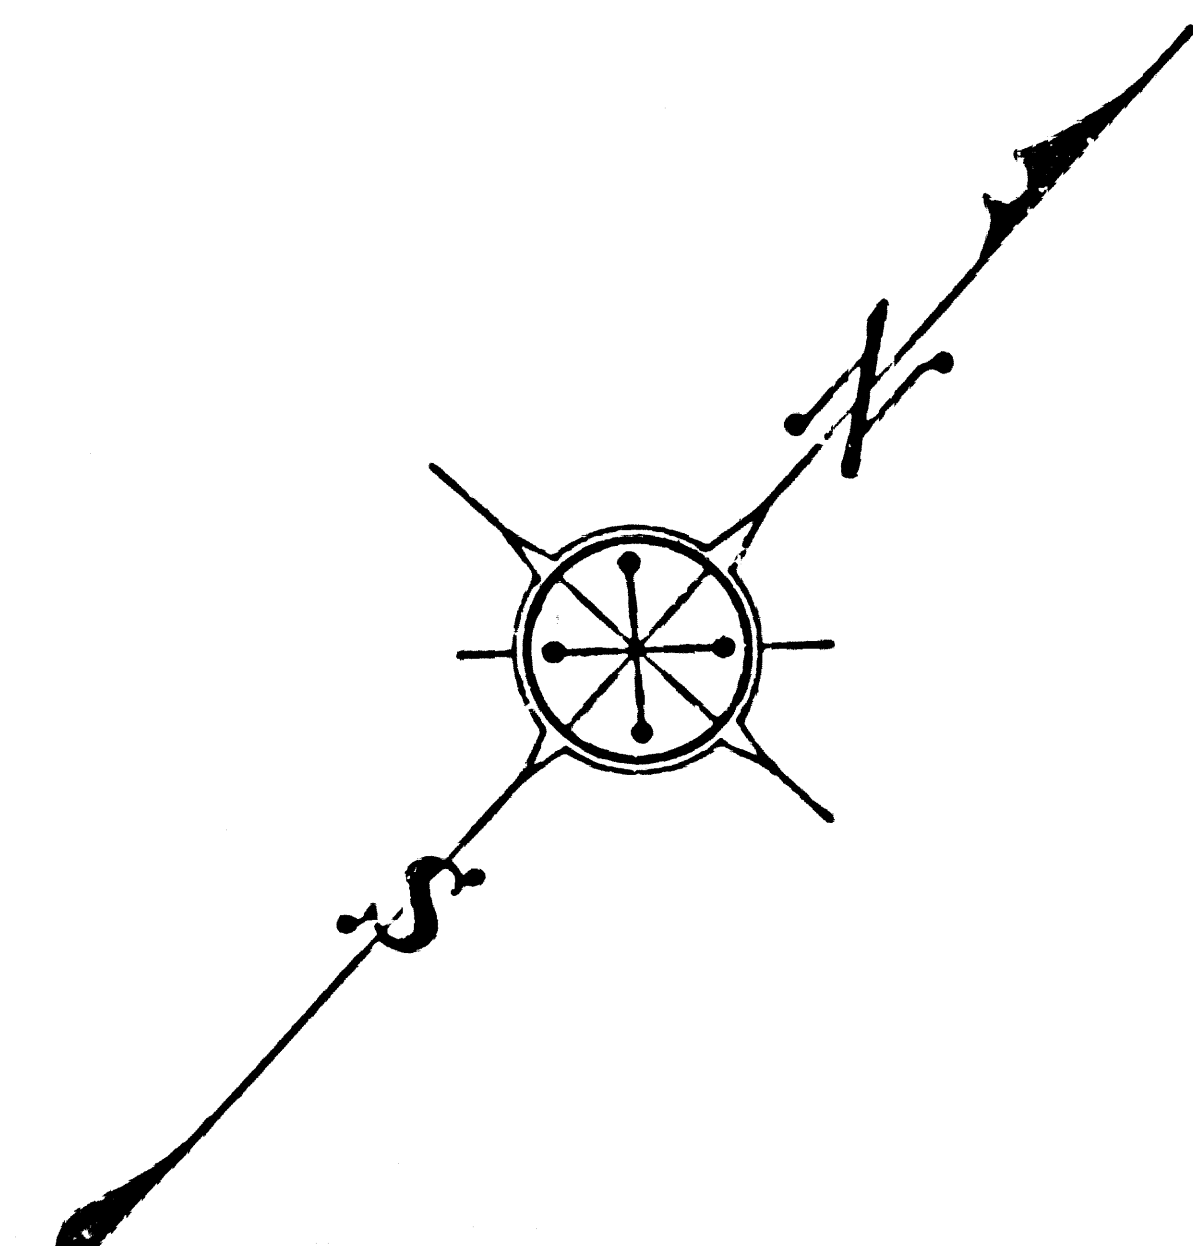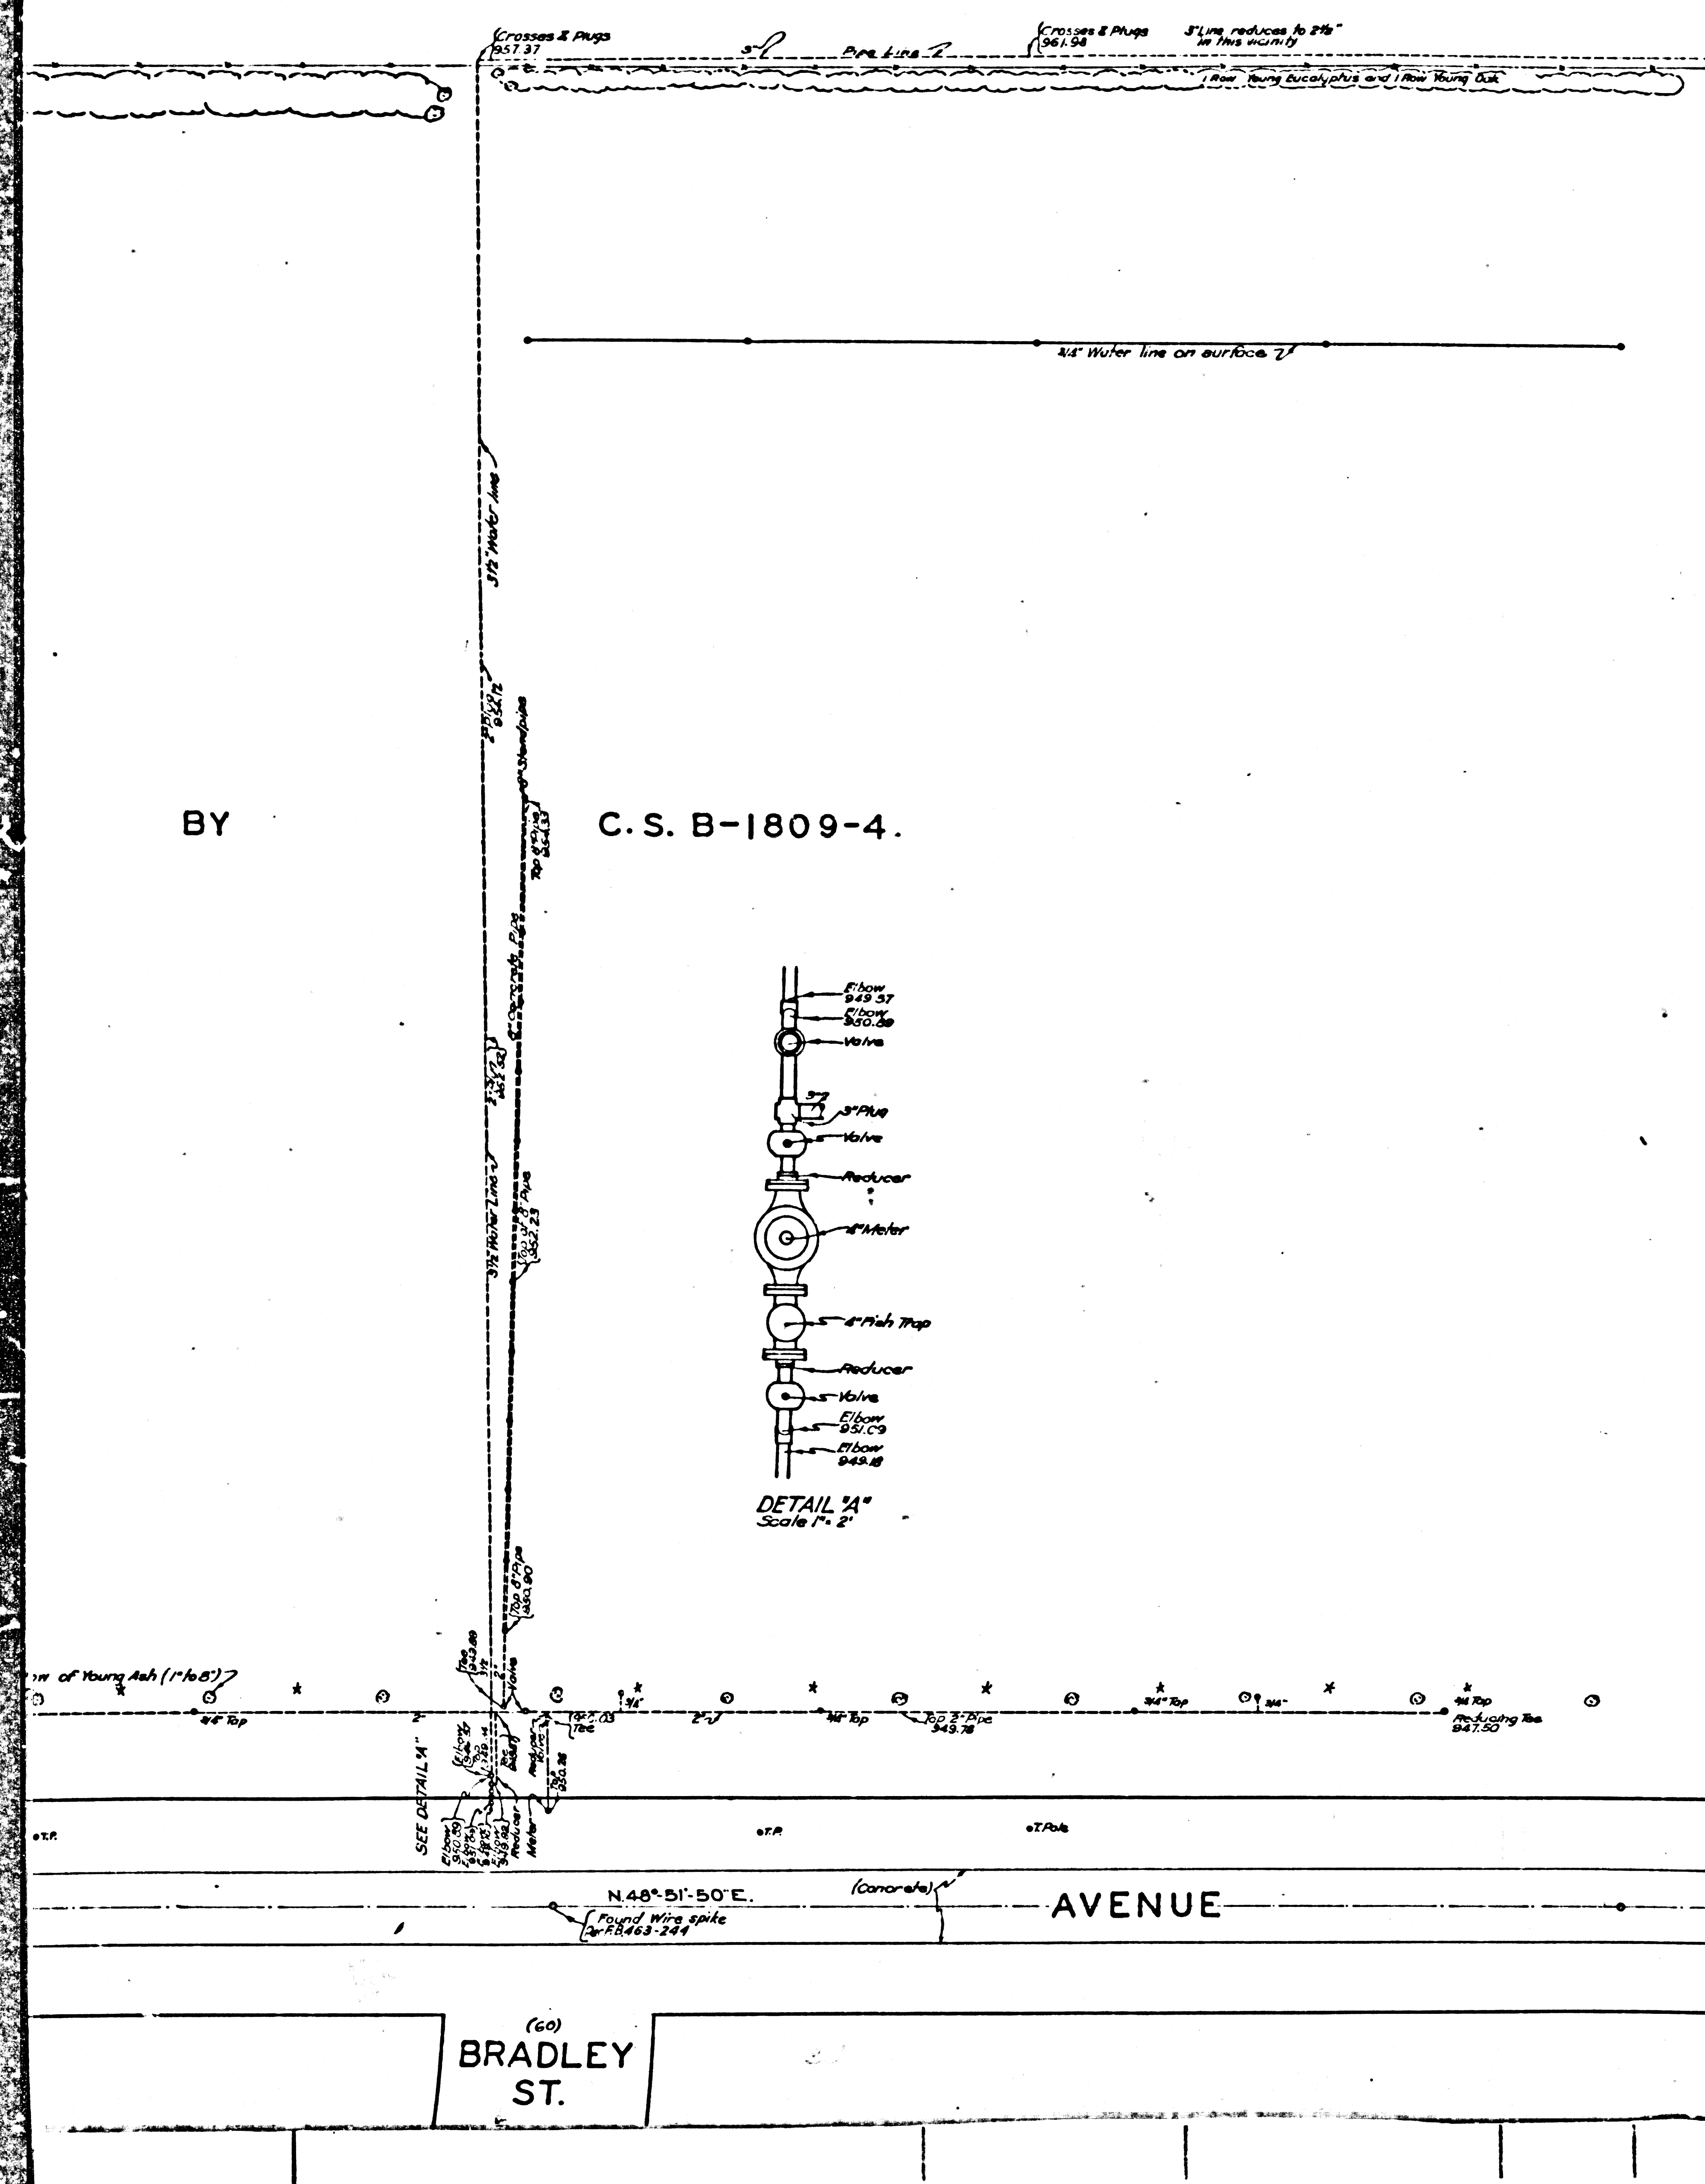

ROGER JESSUP PARK
TOPOGRAPHIC MAP OF
~~PACOIMA PARK~~
BEING A PORTION OF
PETER HAACK'S RANCH - M.B. 13 101

JOB NUMBER 7154


J.E.ROCKHOLD - COUNTY SURVEYOR
SURVEYED JANUARY 1934

BEARINGS ARE BASED ON THE BEARINGS OF
OSBORNE AVENUE PER C.S. 7625

PLANE TABLE SURVEY

FIELD WORK BY	T.M.WALSH
OFFICE WORK BY	W.J.LUCAS
CHECKED BY	A.H.DREW

FOR PROPERTY LINE SURVEY SEE C.S.E. 775

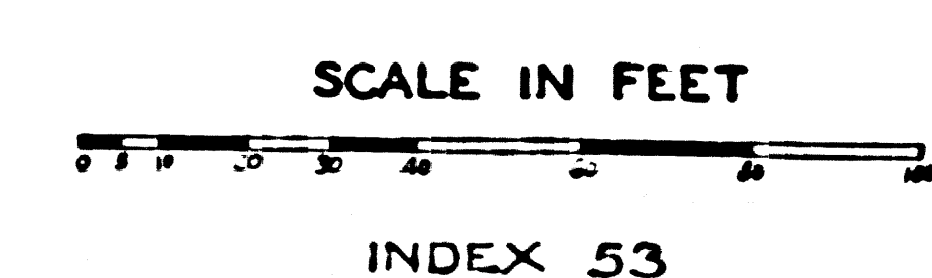

ROGER JESSUP PARK WAS FORMERLY KNOWN AS PACOIMA PARK
NAME CHANGE AUTHORIZED BY BOARD OF SUPERVISORS IN
THEIR ORDER OF AUGUST 9 1938


SHEET No 3 OF 4 SHEETS
COUNTY SURVEYORS MAP No B-885

-OSBORNE

SUPERSEDED

BY

C. S. B-1809-4.

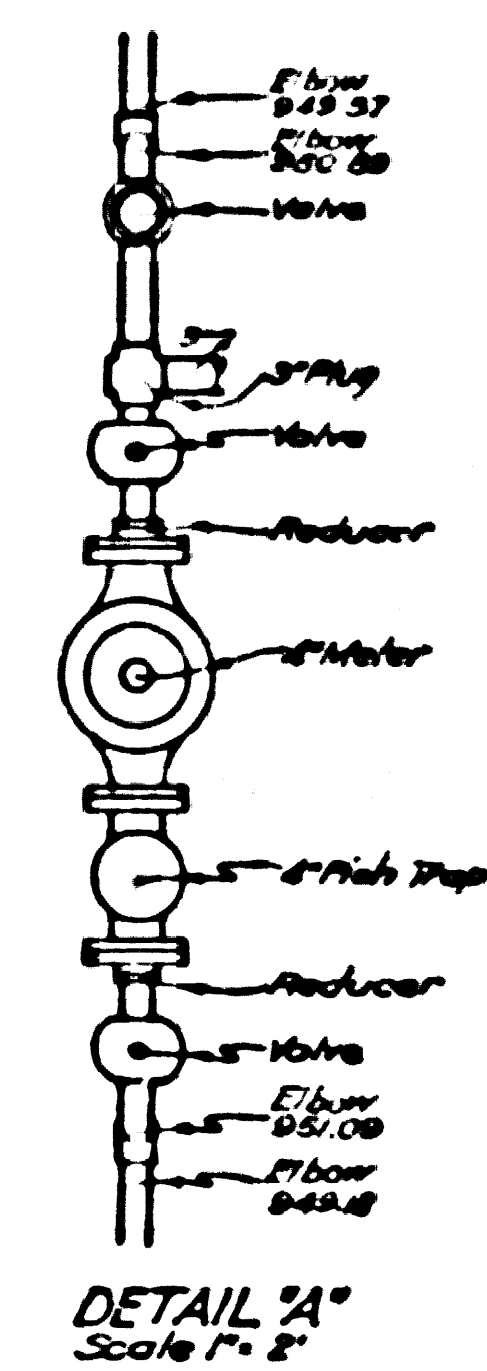

DETAIL 'A'
Scale 1" = 2'

(60)
BRADLEY
ST.

~~AVENUE~~