



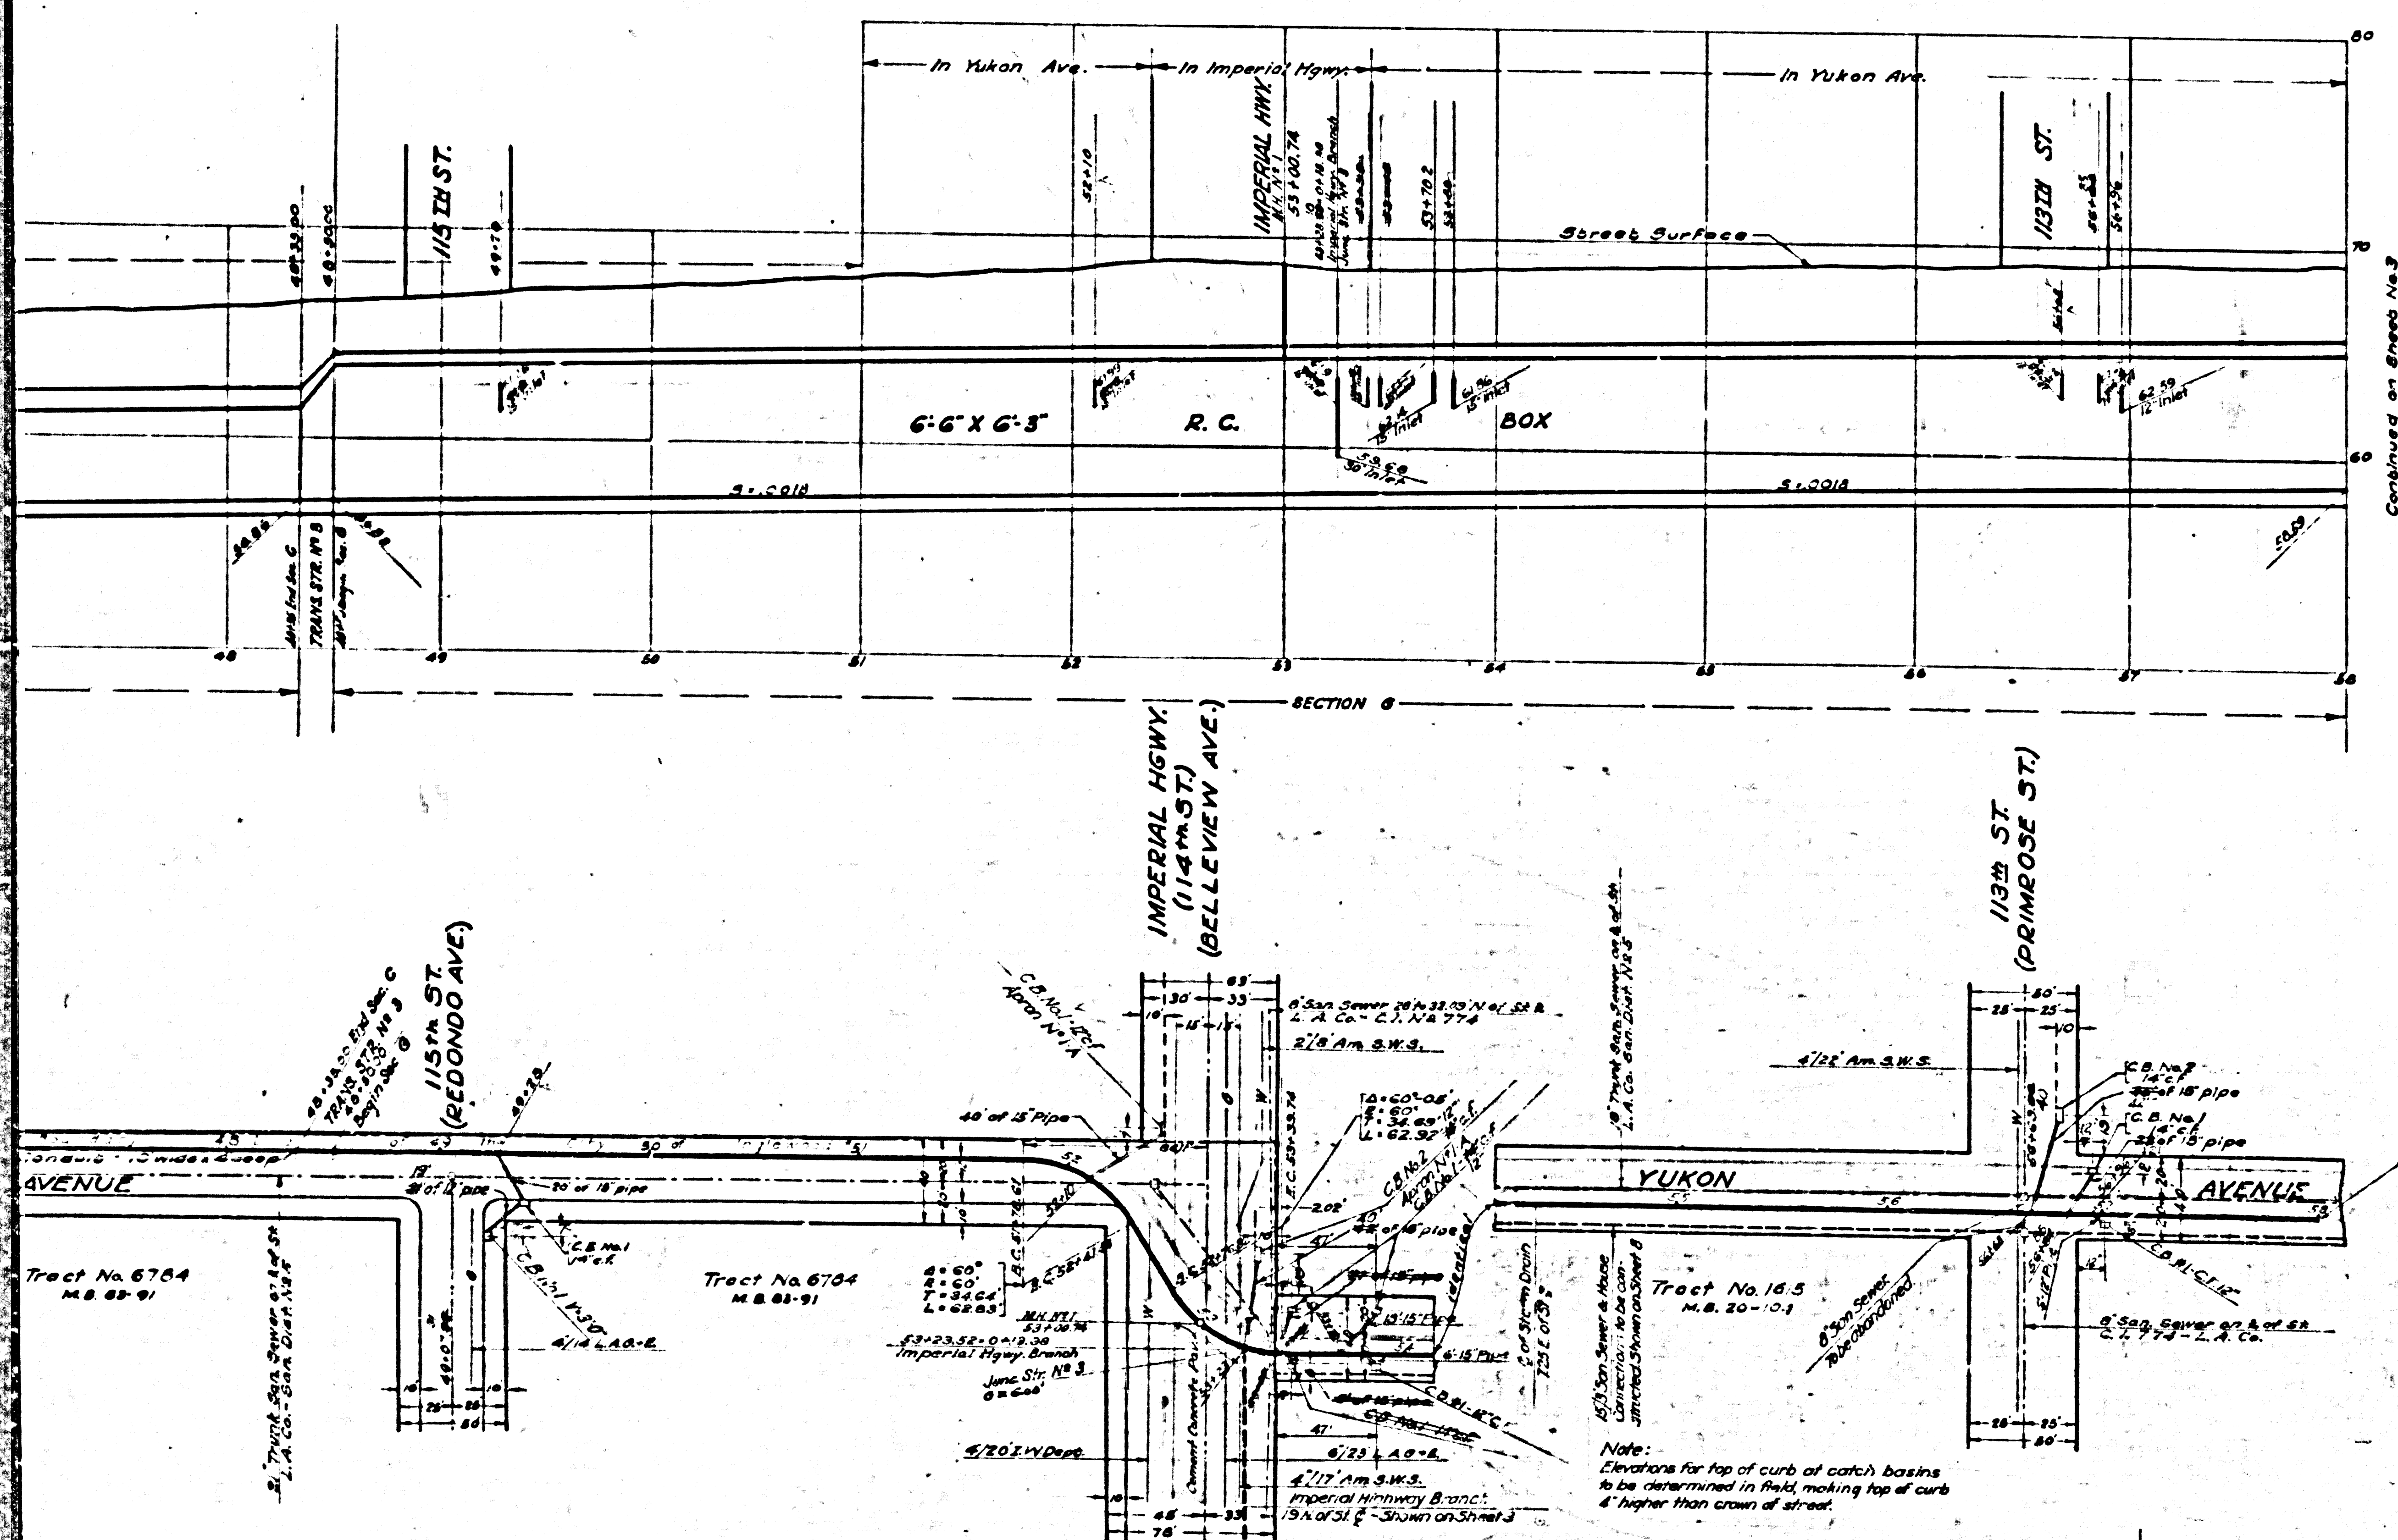

LINE

CSB-1164-2
A1 OF A4

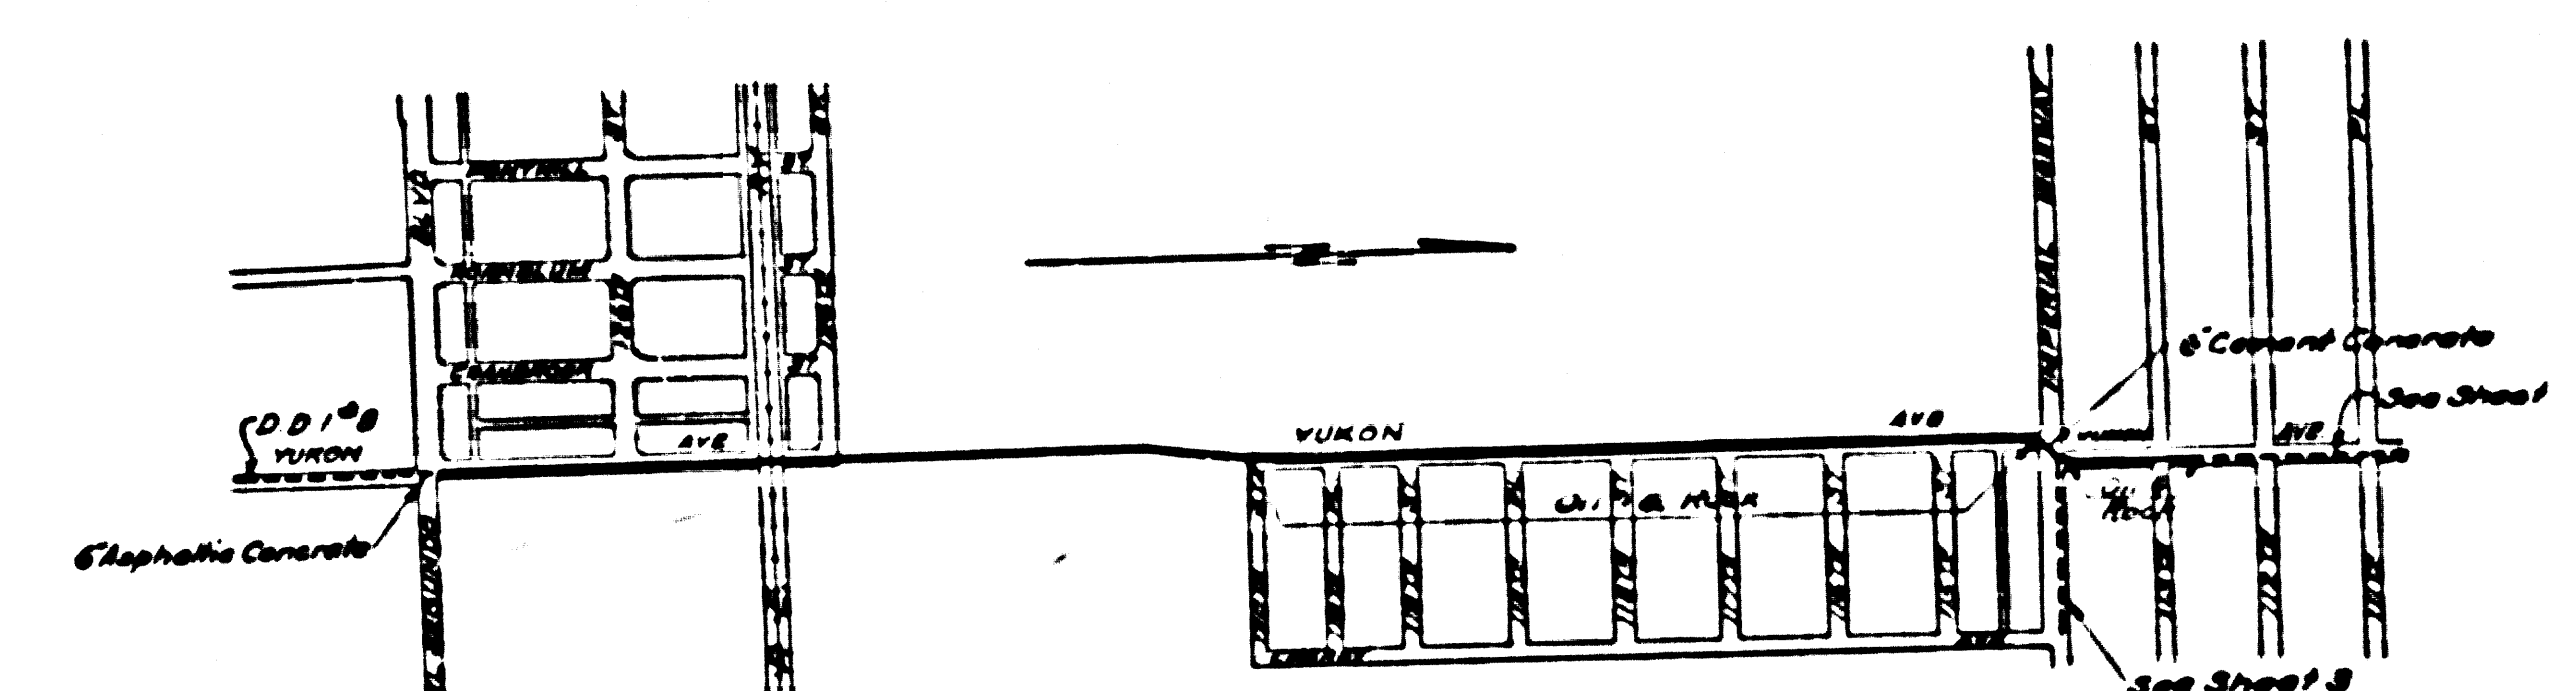

KEY MAP
SHOWING DRAINS AND RESURFACING

NOTES:

Elevations are in feet above U.S.G.S. or mean Sea Level Datum.

Stations of inlets and junctions refer to the intersections of the center lines of the inlets with the center line of the main drain.

Elevations of all inlets, except catch basin inlets into box sections refer to the flow line of the inlets produced on their gradients to the vertical plane thru the center line of the main drain. Elevations of catch basin inlets into box sections refer to the intersection of the flow lines of these inlets with the inside wall of the box section.

For details of all standard structures see Standard Plans.

All pipe not otherwise specified shall be plain cement pipe.

All stubs to be one length of pipe with ends sealed with 2" red wood planking, unless otherwise specified.

Catch basins shall be built with a curb face of 10' or more which shall include a minimum depression at opening of 4" below gutter grade, unless otherwise specified.

Sanitary sewers crossing over or with a clearance of 150 feet or less under Storm Drain, shall be constructed or reconstructed as shown on Standard D-36.

All reinforced concrete structures shall be Class A-1 Concrete.

Weep holes 3/4" in diameter shall be placed in each sidewall and spaced not more than five feet each way.

LENNOX DRAINAGE SYSTEM

OF THE COUNTY OF LOS ANGELES, CALIFORNIA
PLAN AND PROFILE OF

YUKON AVENUE LINE
STA. 0+1.27 TO STA. 58+00

SHEET 2 OF 10 SHEETS

SCALE: 1" = 40'

NOVEMBER 1935


ALFRED JONES COUNTY SURVEYOR
RECOMMENDED: *[Signature]* APPROVED: *[Signature]*

Corrected as constructed by A.W. Lynn, A-7-42
Checked by L.O. Lapham, B-11-42


REFERENCE	DESIGNED	J.H. Hartley	MAY 1935
P.B. 228	TRACED	Fred Hefner	MAY 1935
L.B. 289	TRACED	H.C. Glenn	MAY 1935
Divided	6.757	CHECKED	J.H. Rice
	7.038		

②

Trim to this Line

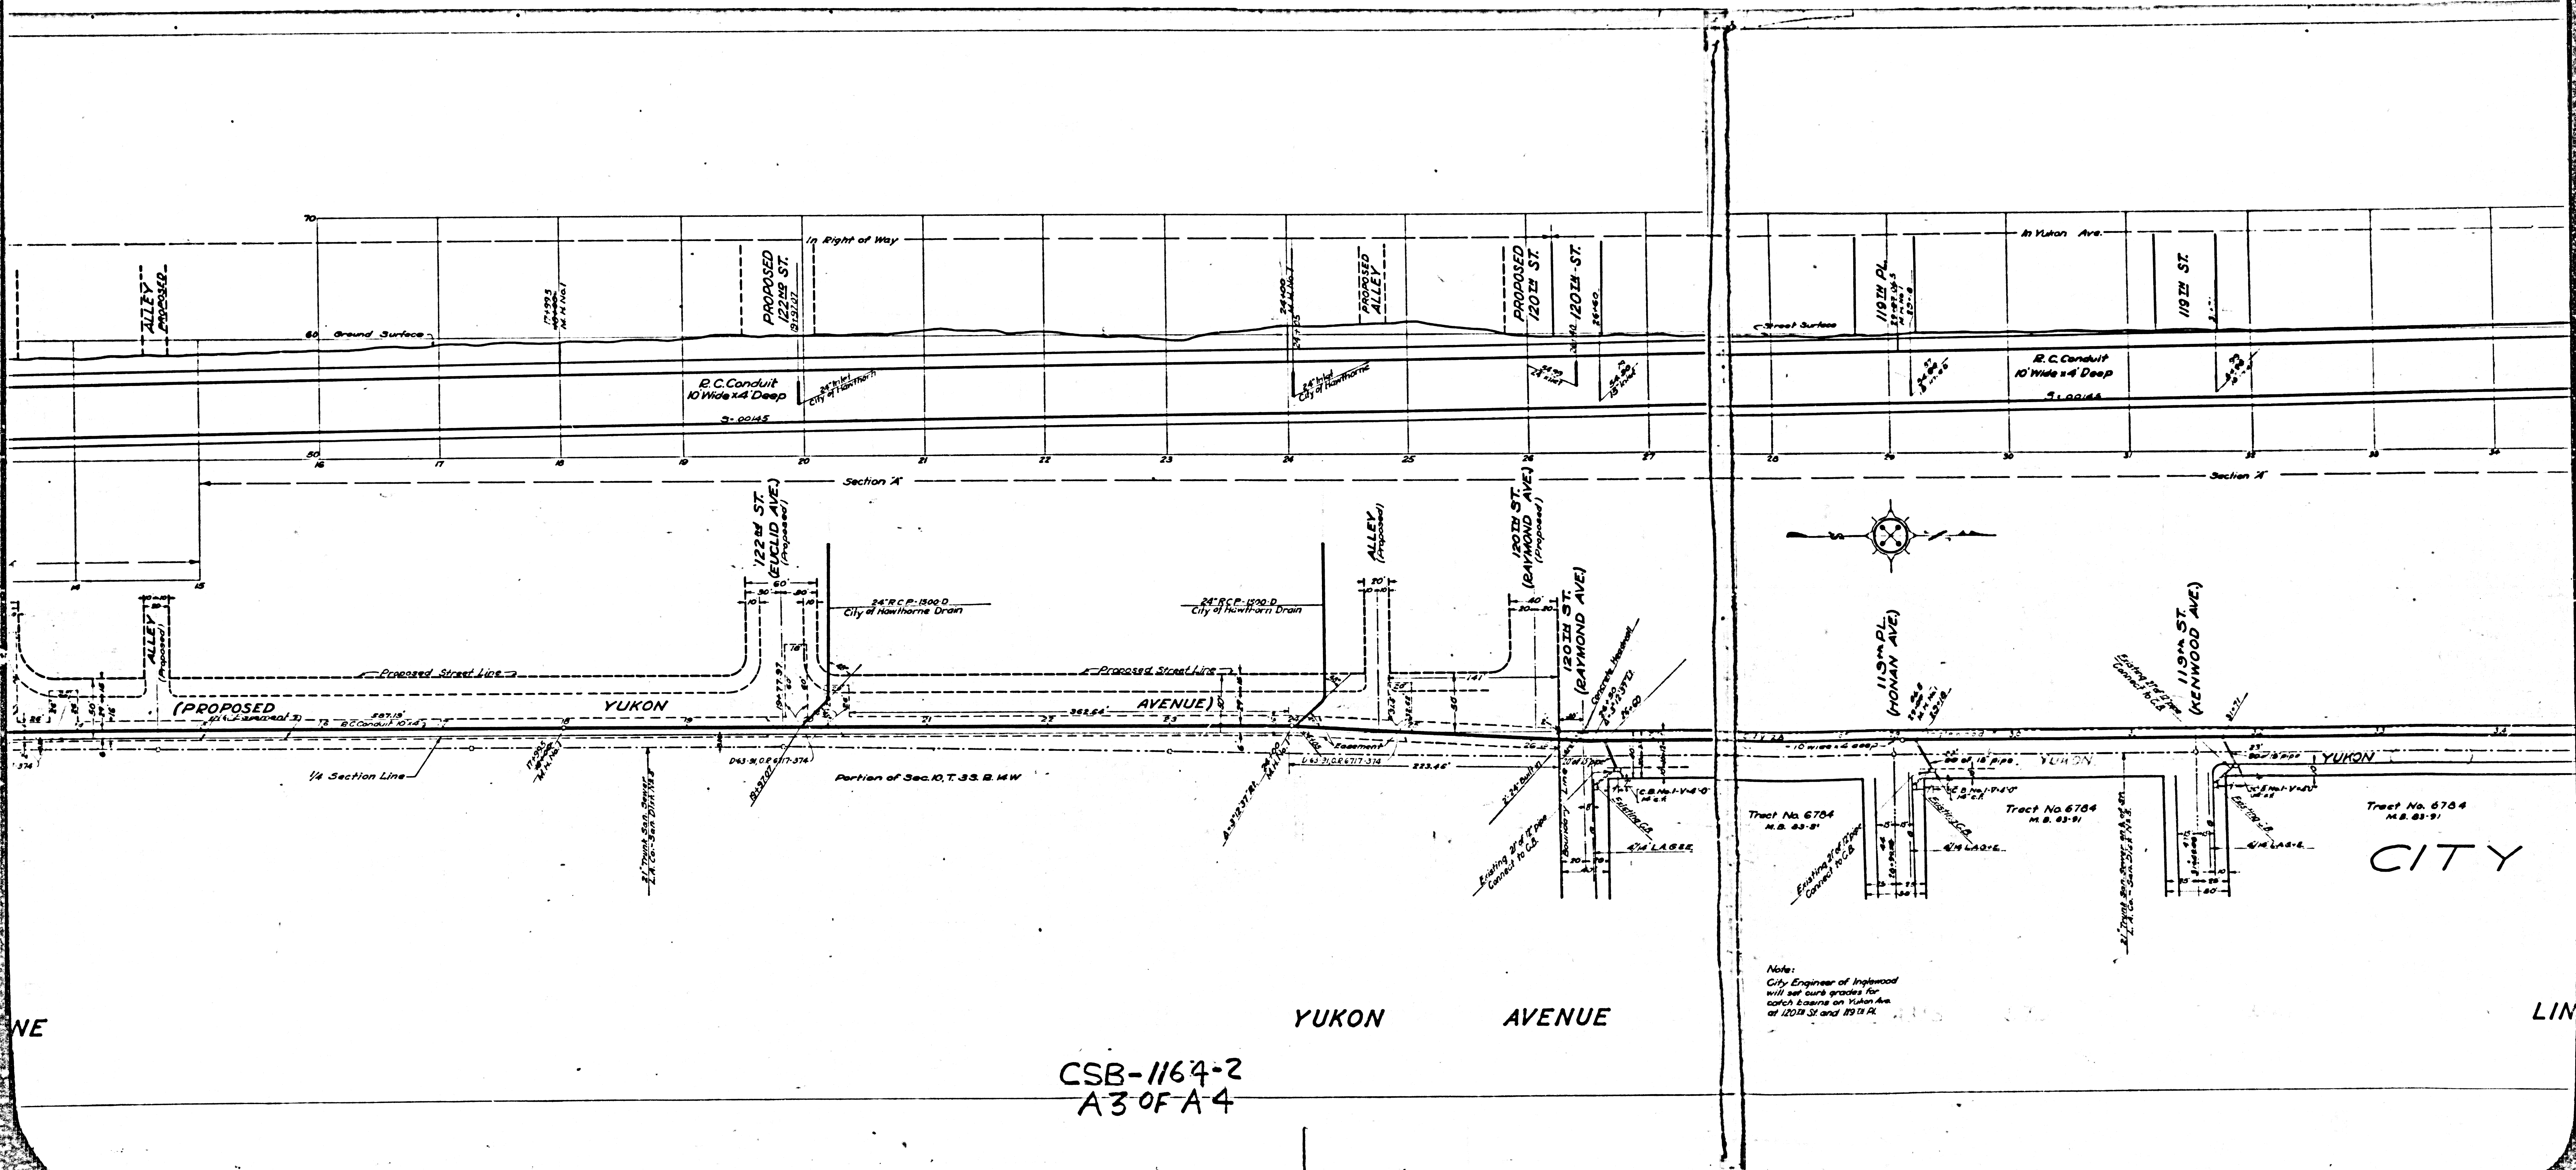


CSB-1164-2
A3 OF A4

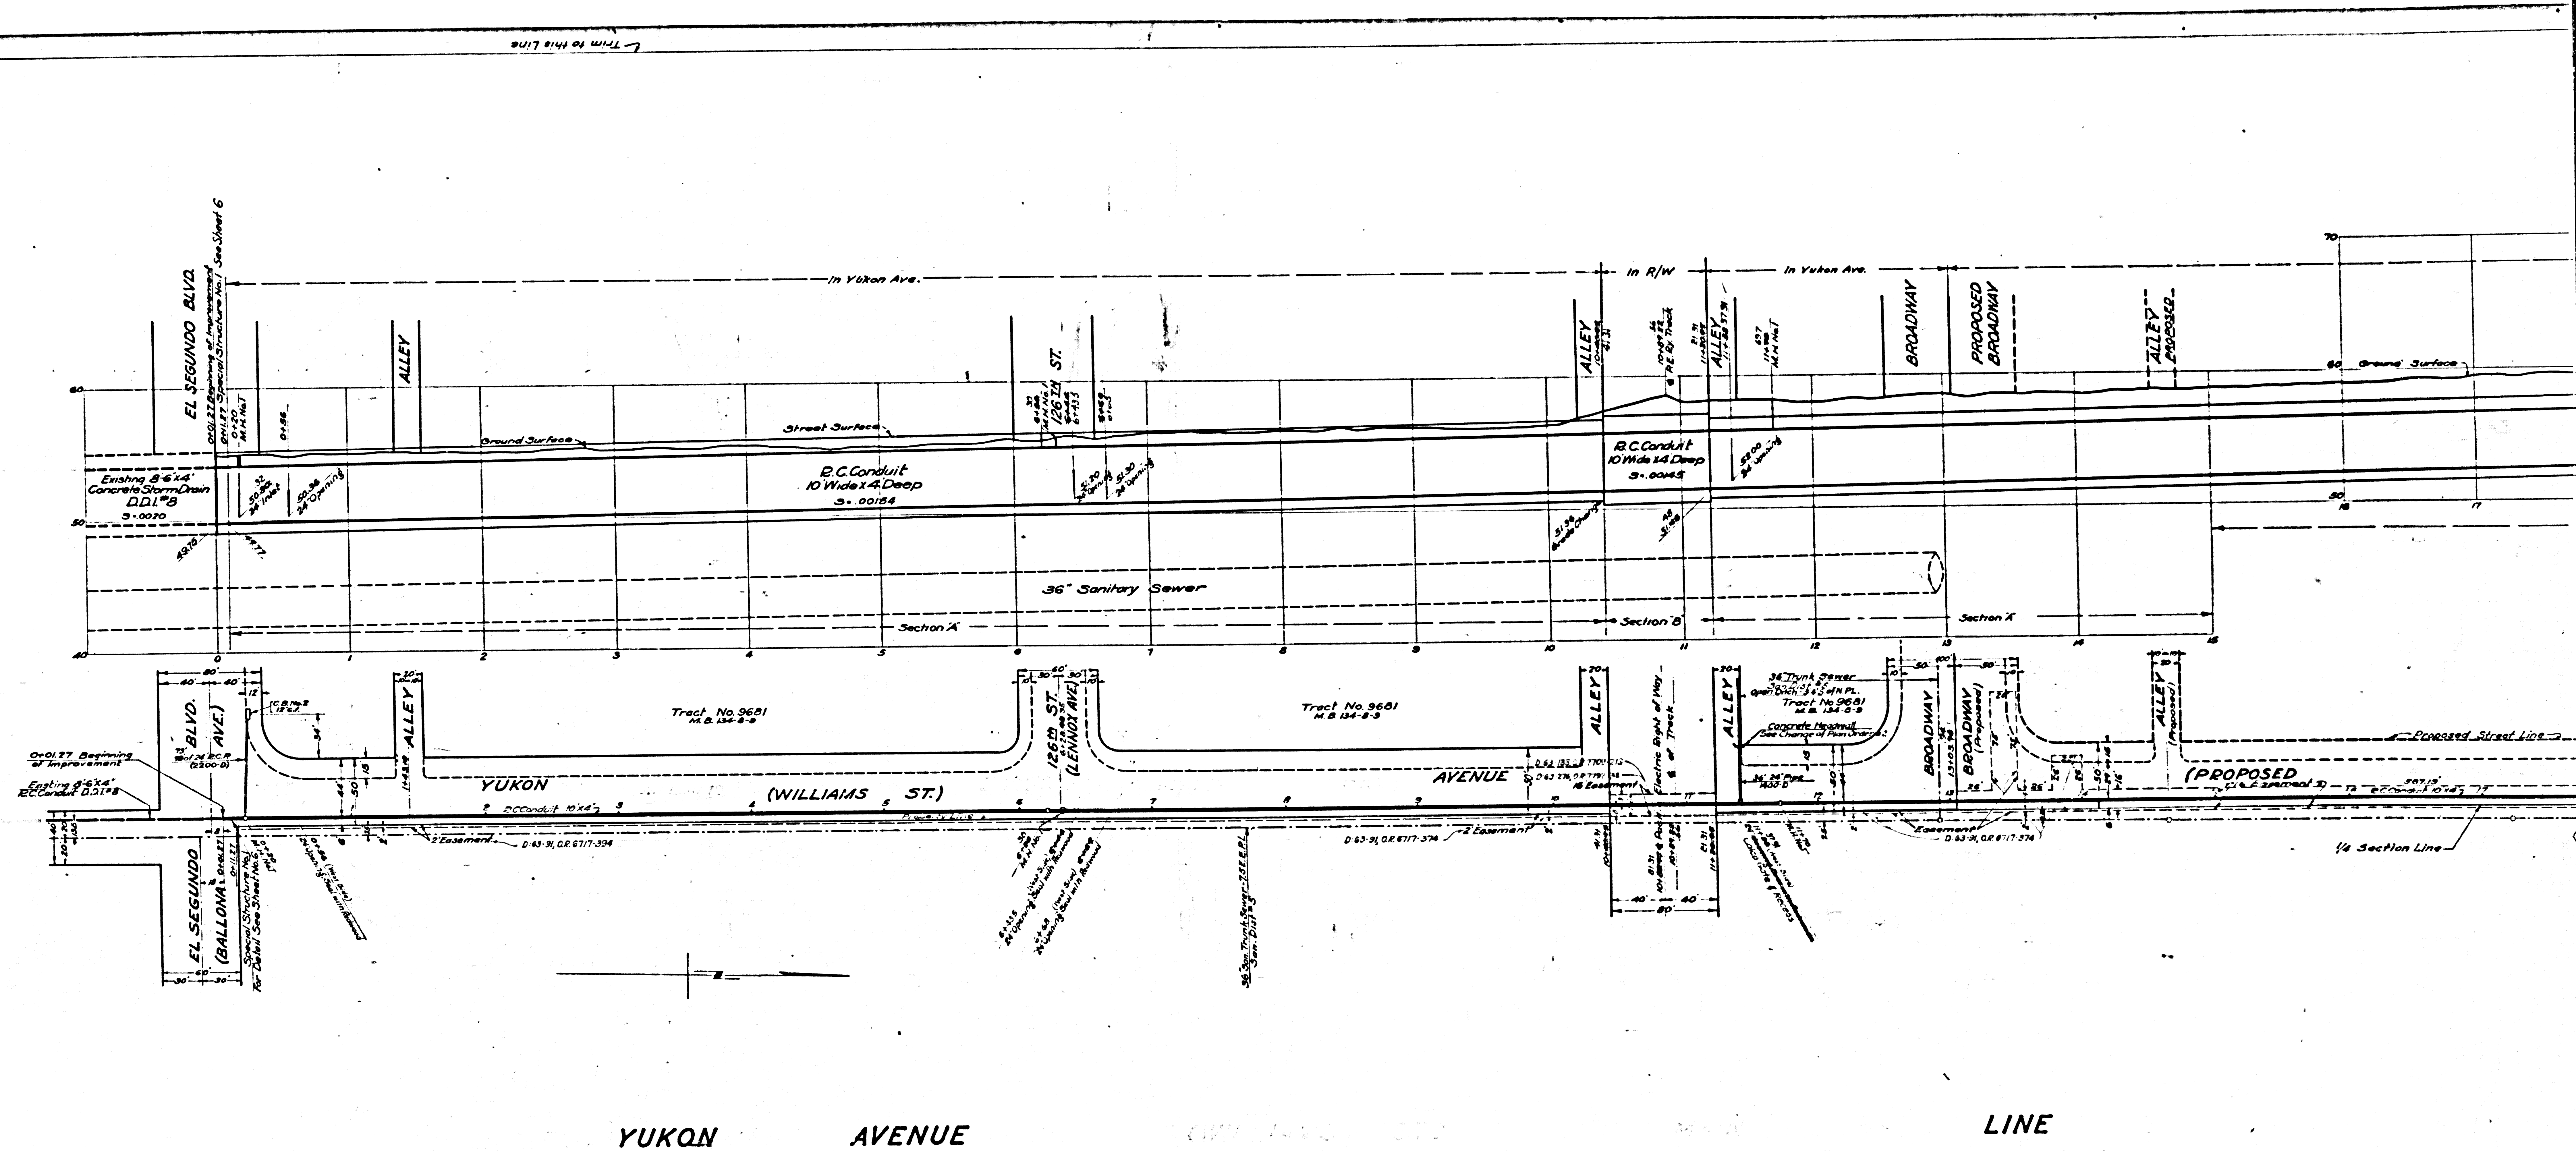

YUKON AVENUE

LINE

CSB-1164-2
A 4 OF A 4

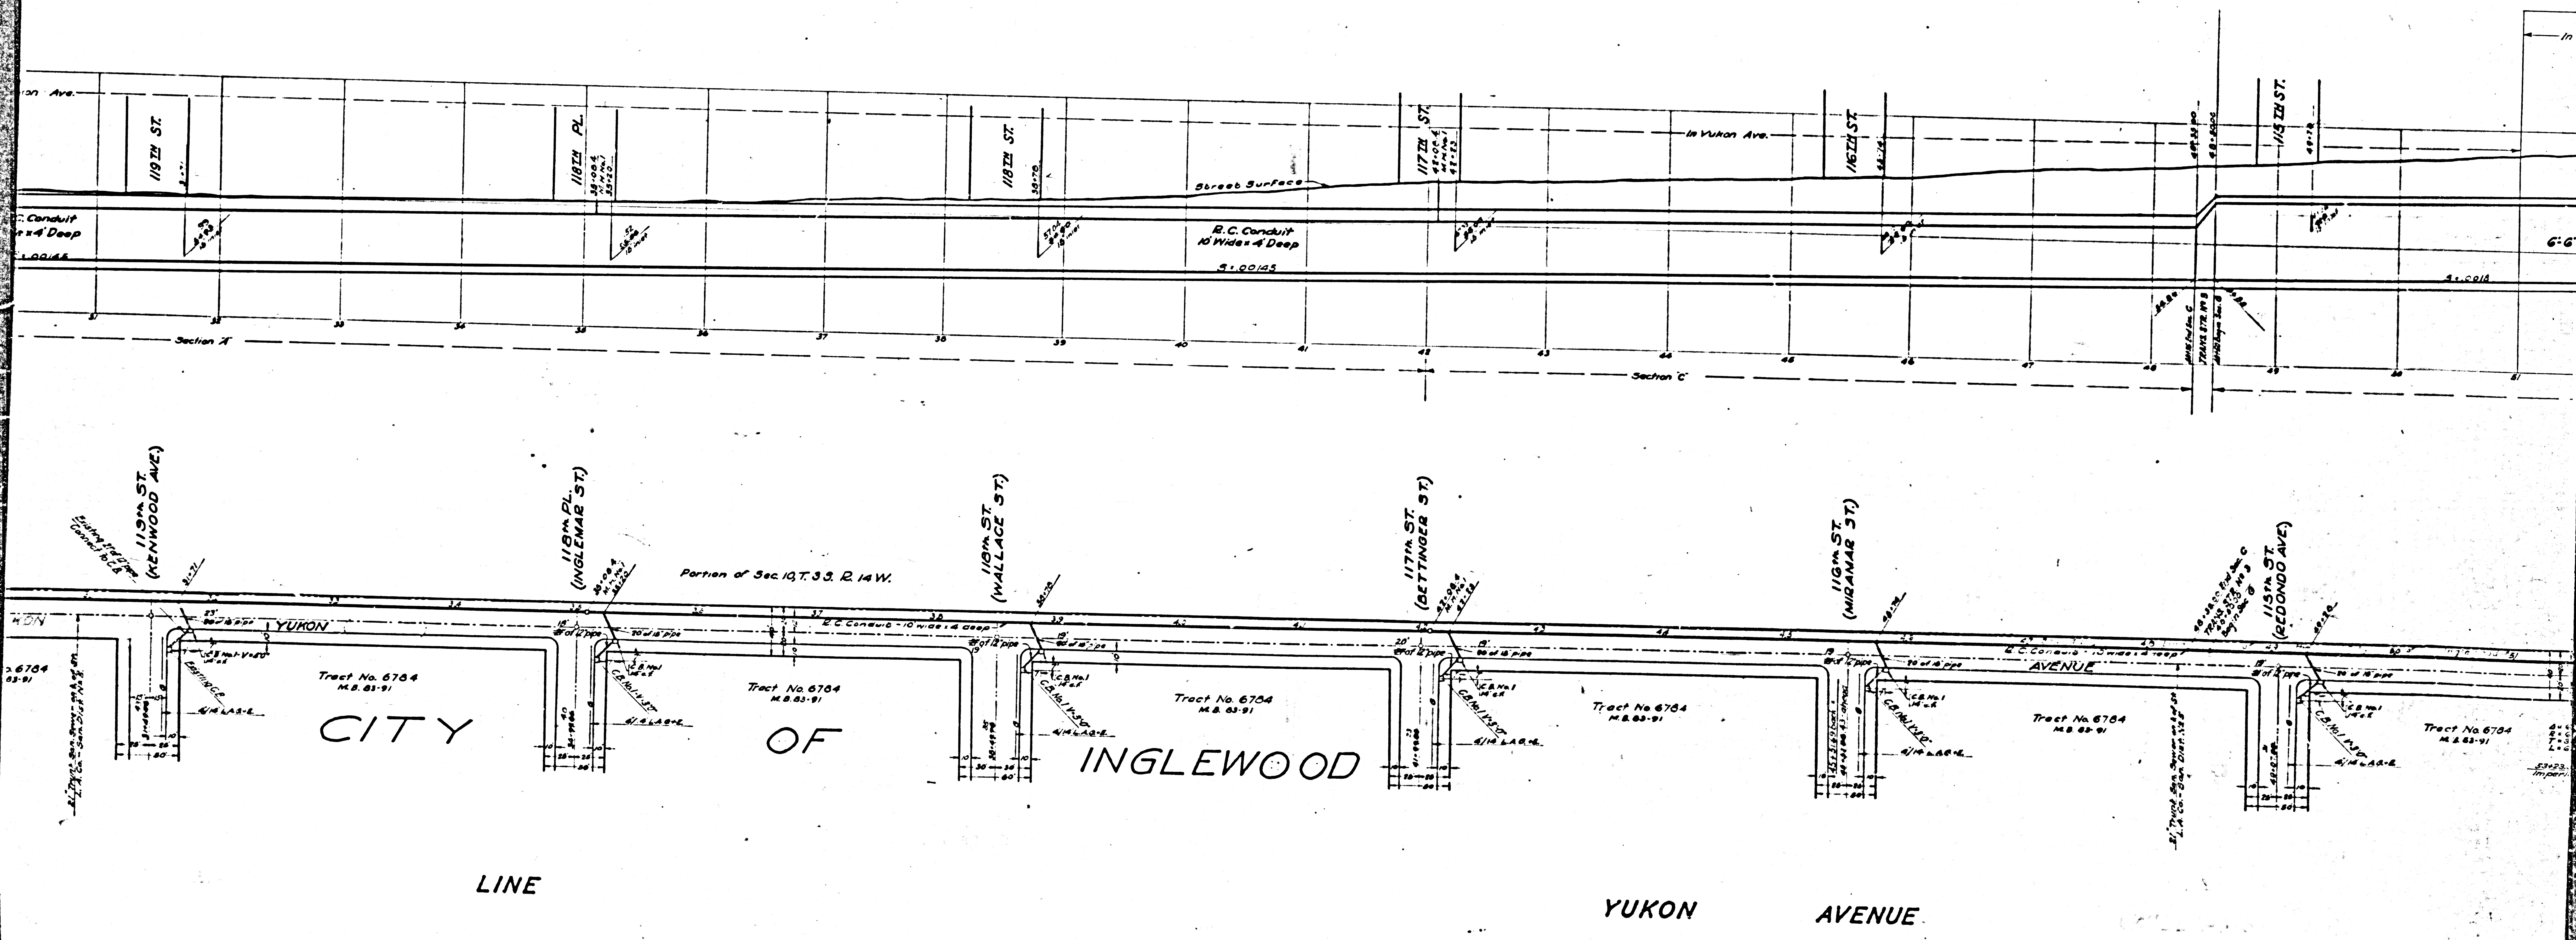

CSB-1164-2
A2 OF A4