

GLEN AVENUE DRAINAGE SYSTEM



PROFILE, ALIGNMENT AND GRADE OF
SANITARY SEWERS
TO BE CONSTRUCTED IN
ORIS STREET AND
SANITARY SEWER RIGHT OF WAY
AT
MONA BOULEVARD
GREENLEAF DRIVE AT
WILLOWBROOK AVENUE

SCALE: HORIZ. 1" = 40'
VERT. 1" = 4'
DEC 1935
SHEET 25 OF 26 SHEETS
COUNTY OF LOS ANGELES, CALIFORNIA
ALFRED JONES COUNTY SURVEYOR
RECOMMENDED *E. Blum* CHIEF DEPUTY
APPROVED *Alfred Jones* COUNTY SURVEYOR
APPROVED *A. W. Ware* CHIEF ENGINEER OF COUNTY SANITATION DISTRICT NO. 1

FOR LEGEND
SEE PLAN NO. 9-9-34
NOTE:
GRADES TO WHICH THIS IMPROVEMENT IS TO BE CONSTRUCTED ARE SHOWN ON PLANS AND PROFILES.
GRADE POINTS FOR TOP OF CURB, CENTER LINE OF STREET OR CENTER LINE OF ALLEY ARE SHOWN BY
CIRCLES ON PROFILES. AT ALL POINTS BETWEEN DESIGNATED POINTS THE GRADE SHALL BE ESTABLISHED
SO AS TO CONFORM TO A STRAIGHT LINE DRAWN BETWEEN SAID DESIGNATED POINTS.
ELEVATIONS ARE IN FEET ABOVE U. S. G. S. DATUM '18 NEAR SEA LEVEL.
UNIT PRICES IF IN ADDITIONAL WORK WHICH MAY BE REQUIRED BUT WHICH CANNOT BE ASCERTAINED
IN ADVANCE SHALL BE SUBMITTED BY THE PROPRIETOR.
THIS DRAWING AND THE DATA HEREON ARE HEREBY MADE A PART OF THE SPECIFICATIONS.

REFERENCES			
W.S.	DESIGNED	KFELLE	JUNE 1935
A. B.	TRACED	SPARLING	JULY 1935
L. B. 819	CHECKED	KUENZEL	DEC. 1935

- NOTES:
1. USE CEMENT MORTAR FOR ALL PIPE JOINTS.
 2. USE COUNTY SANITATION DISTRICT STANDARD MANHOLE FRAME AND COVER S-A-4.
 3. USE STANDARD STRENGTH PIPE EXCEPT AS NOTED.
 4. RESURFACE TRENCH WITHIN PAVED AREA WITH PREMIX ROCK AND OIL.
 5. RECONNECT EXISTING HOUSE SERVICES.

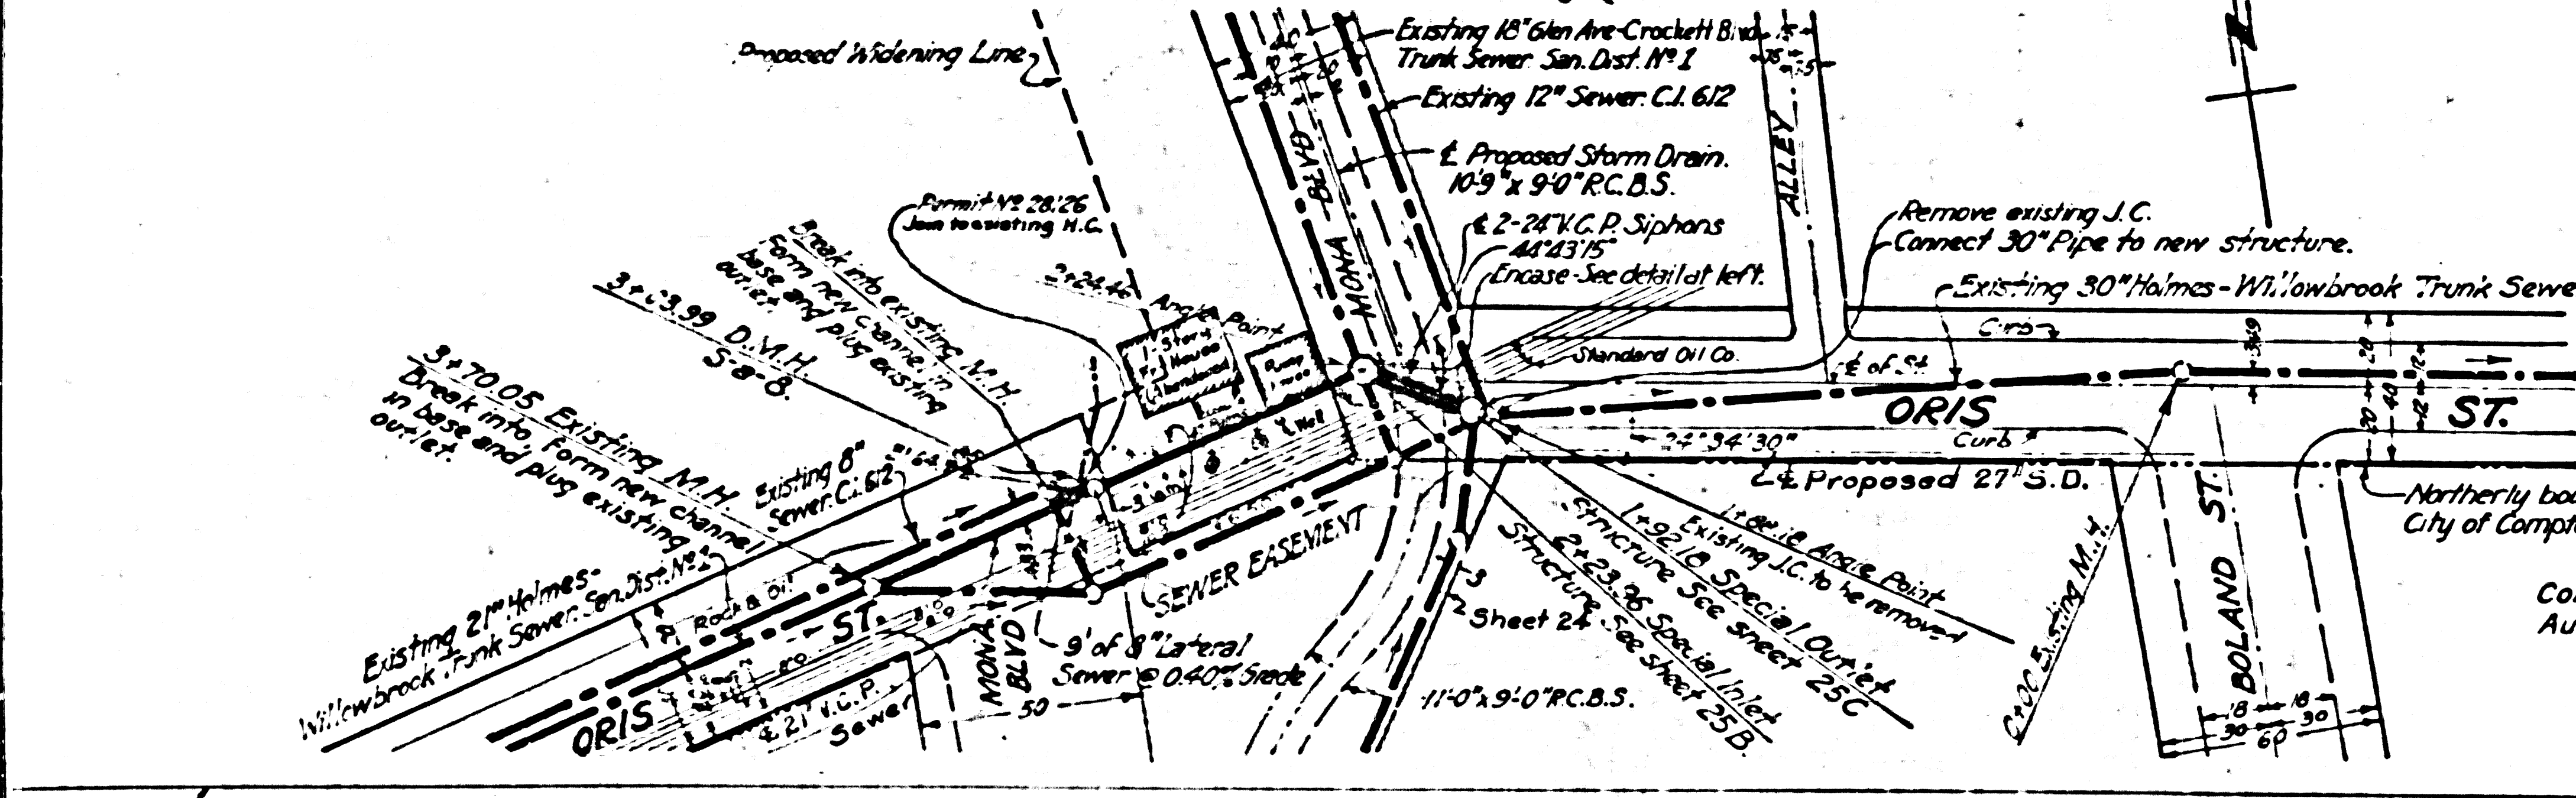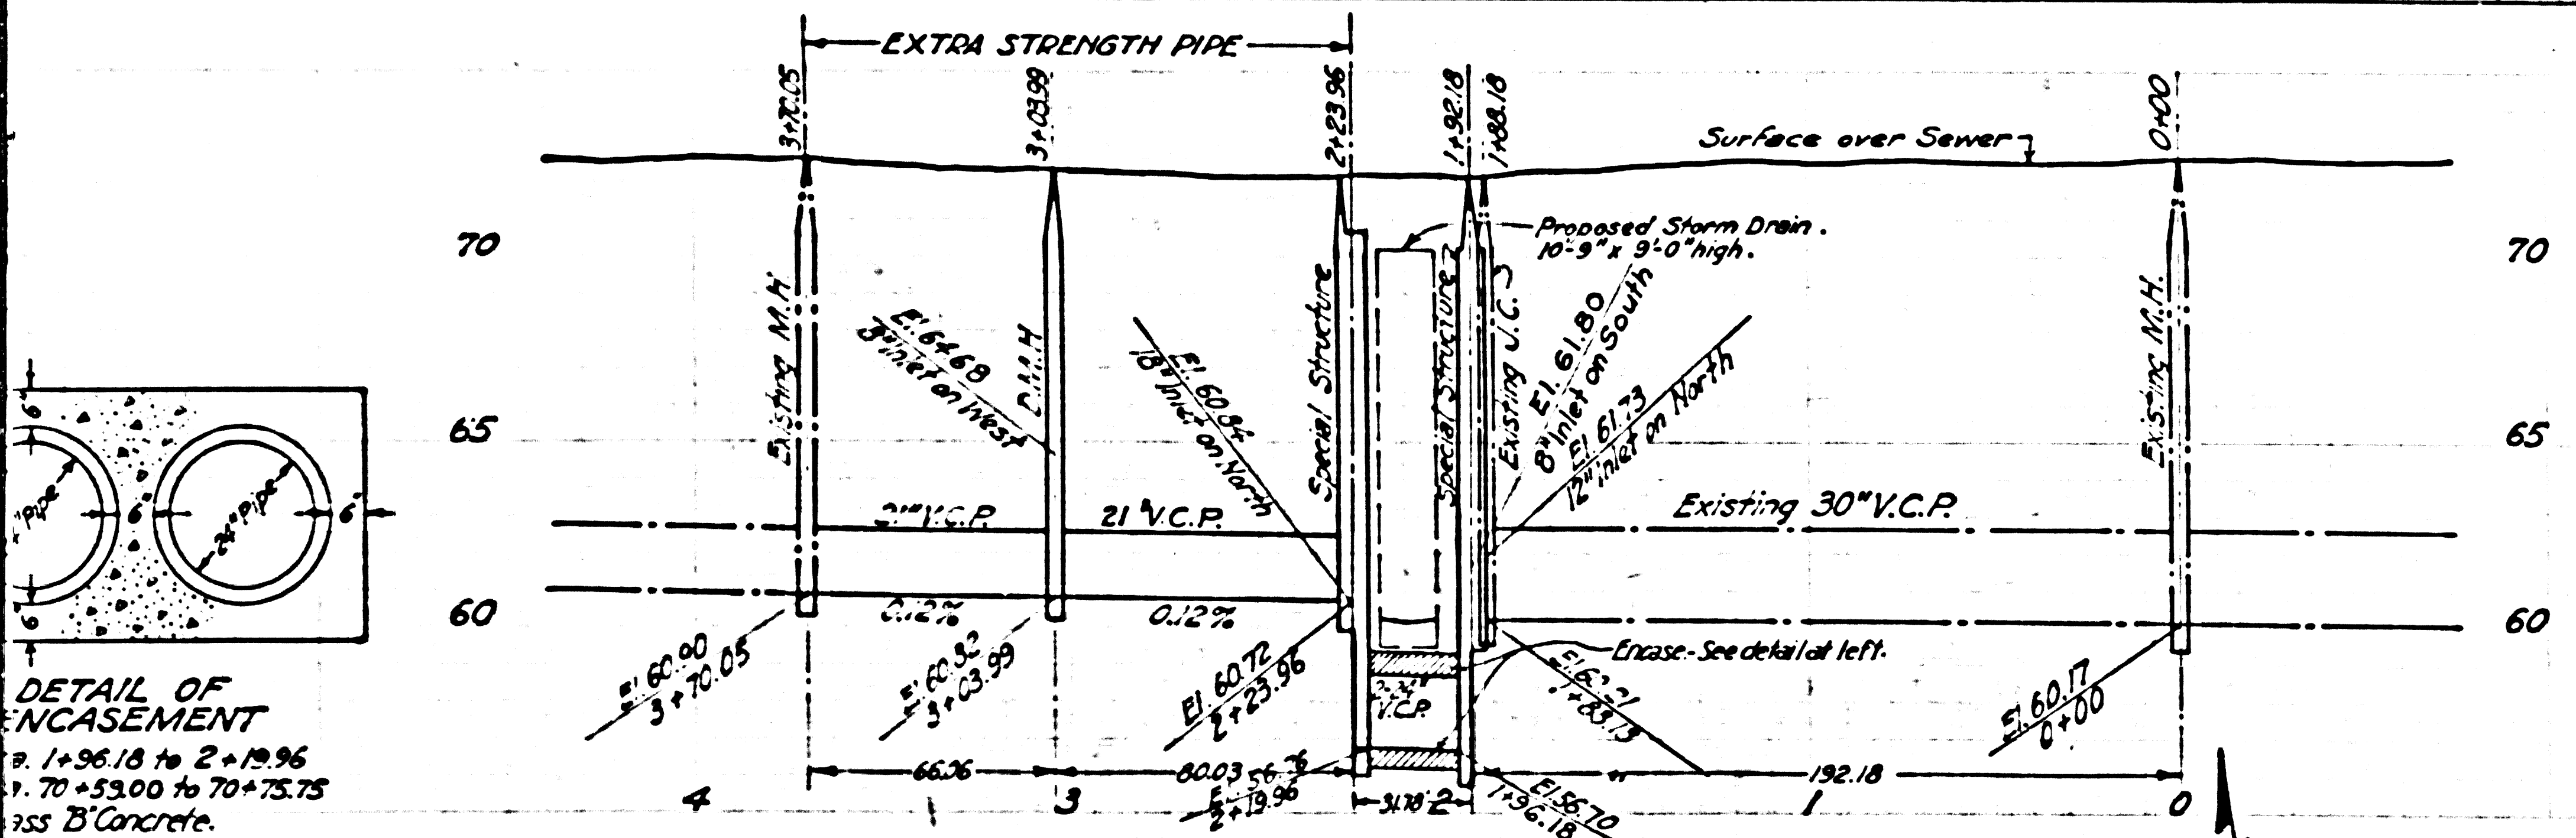


CSB-1171-25
A10FA3

Corrected as Constructed
August 1941 A.T. Kincaid

Checked - Kuenzel - Oct.



**SECTION SHOWING TRUNK SEWER ENCASEMENT
ALIGNED WITH BOTTOM OF STORM DRAIN MANHOLE**
SCALE 1"=10'

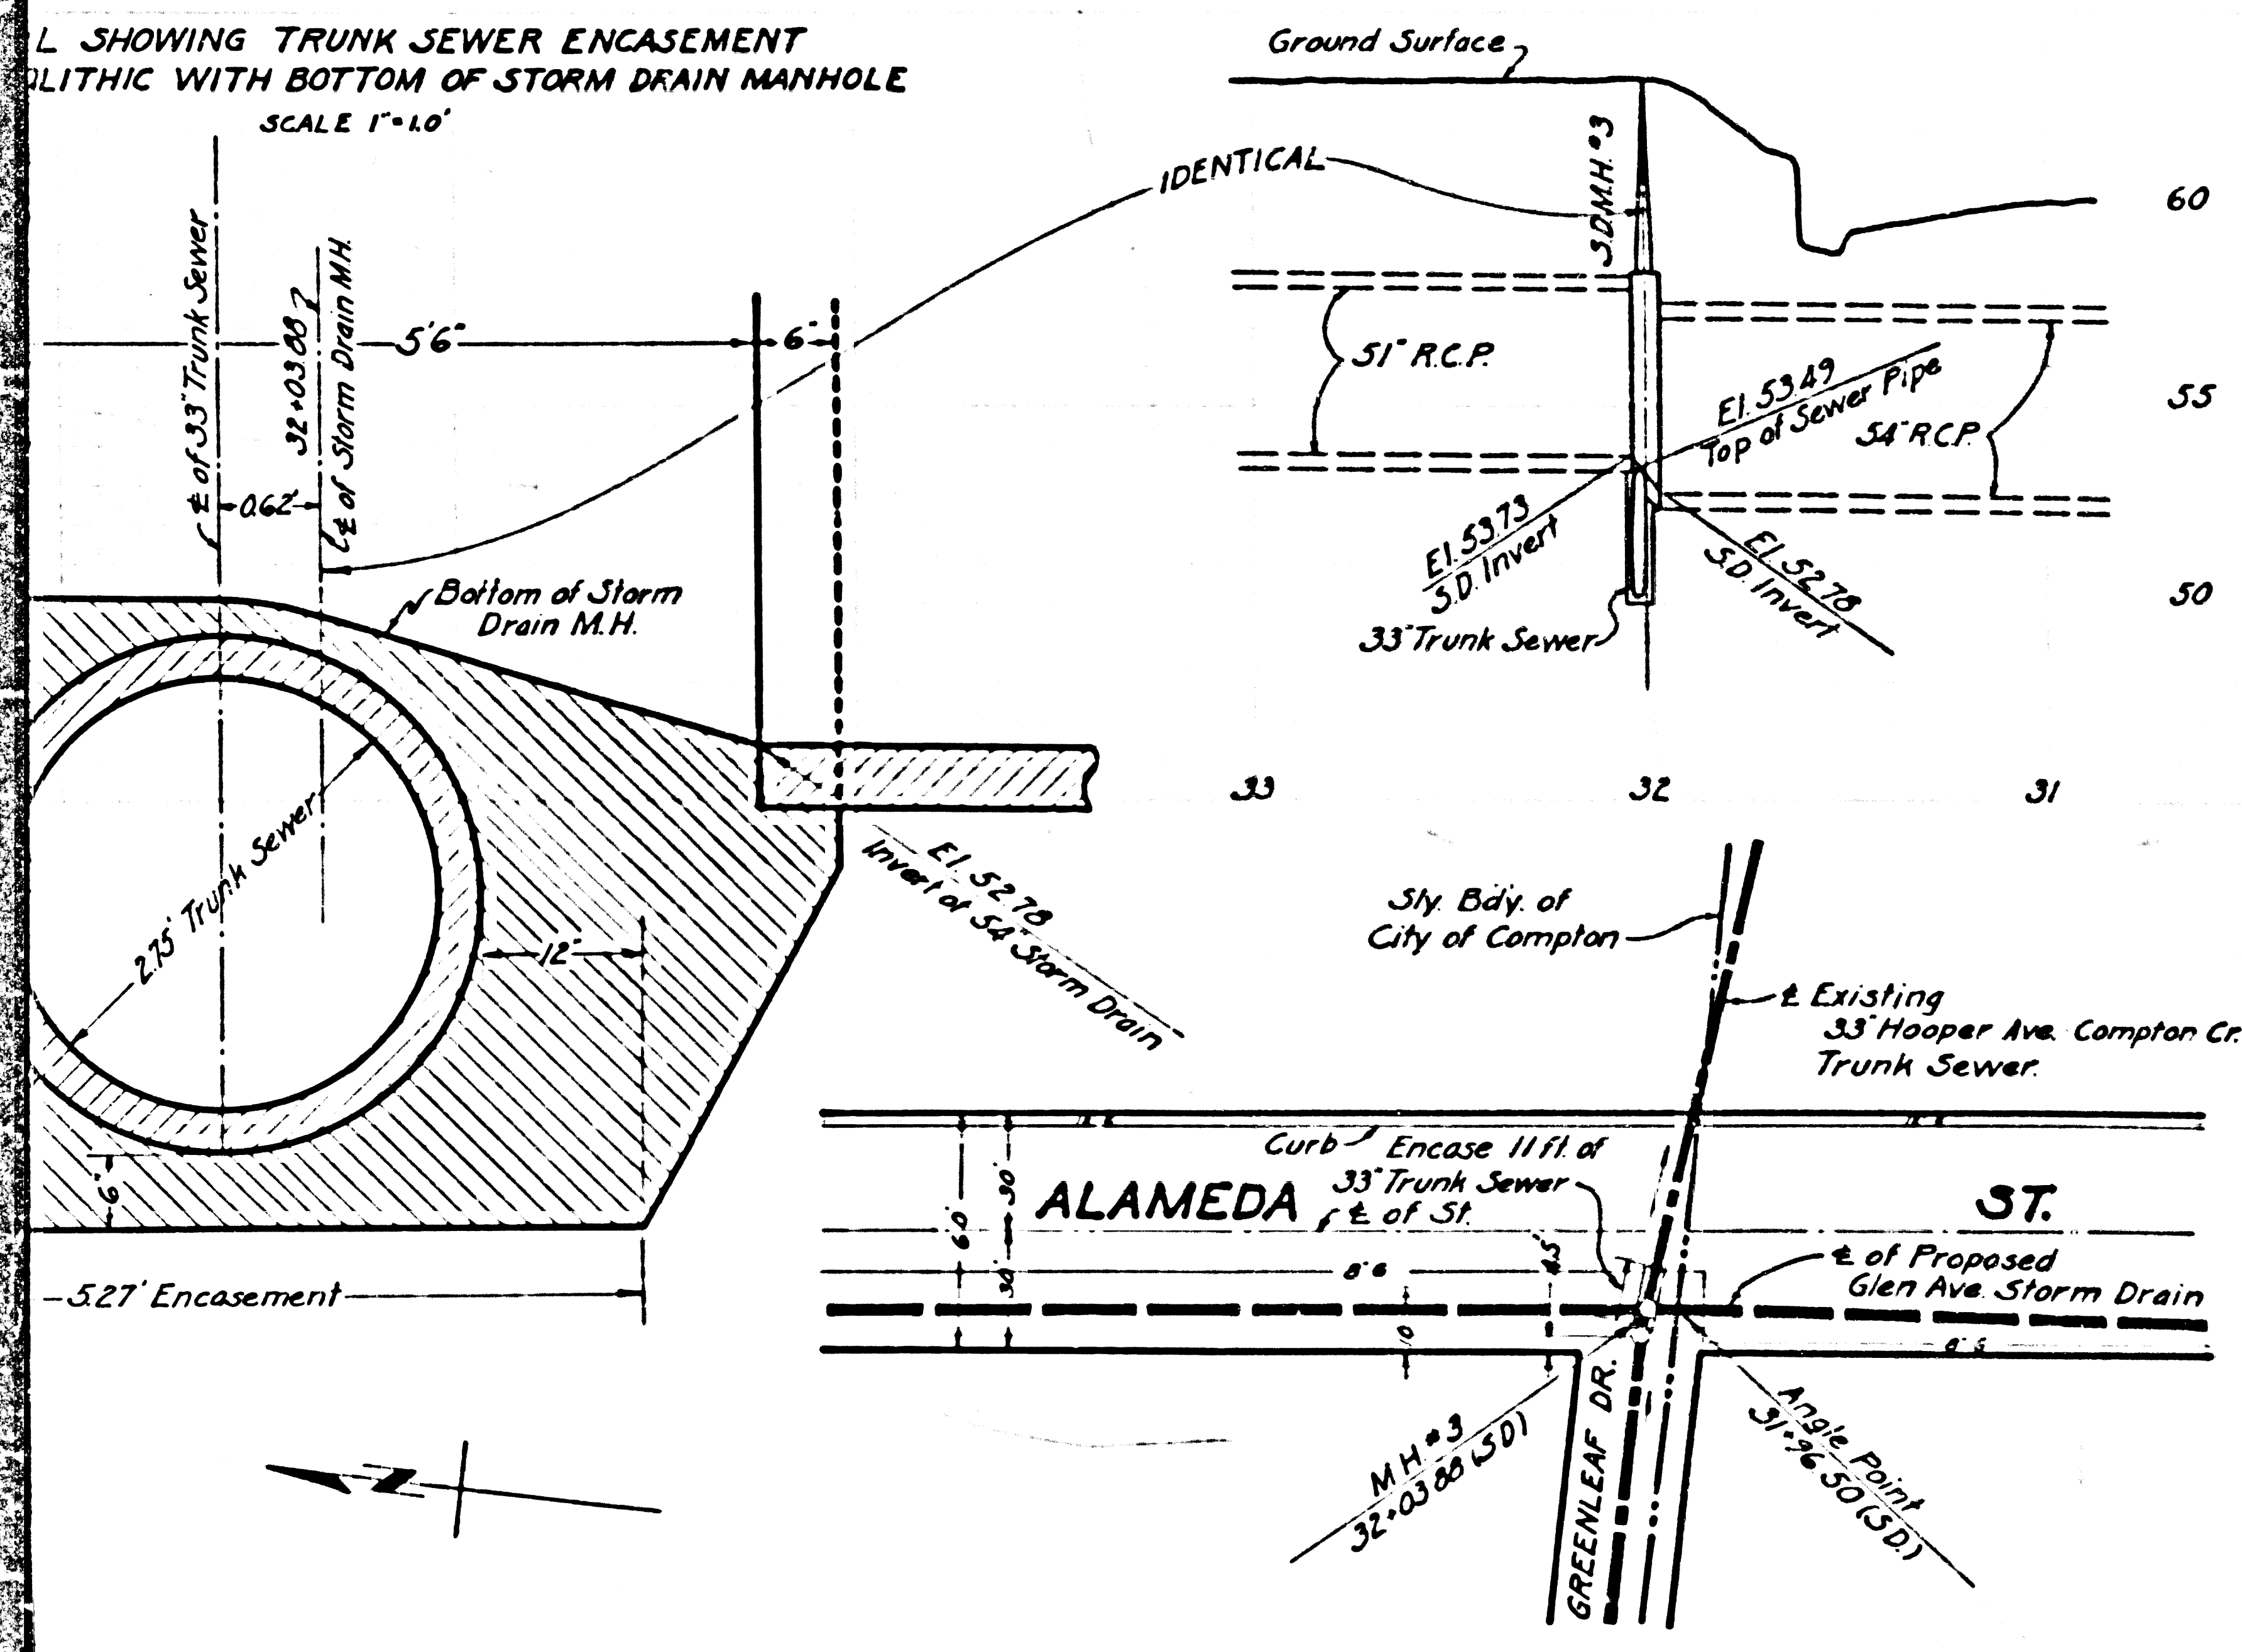



Kuenzel 1-15-36 L.E. 019-P 120-121

CSB-1171-25
A 2 OF A 3

Trim Prints to this Line 7

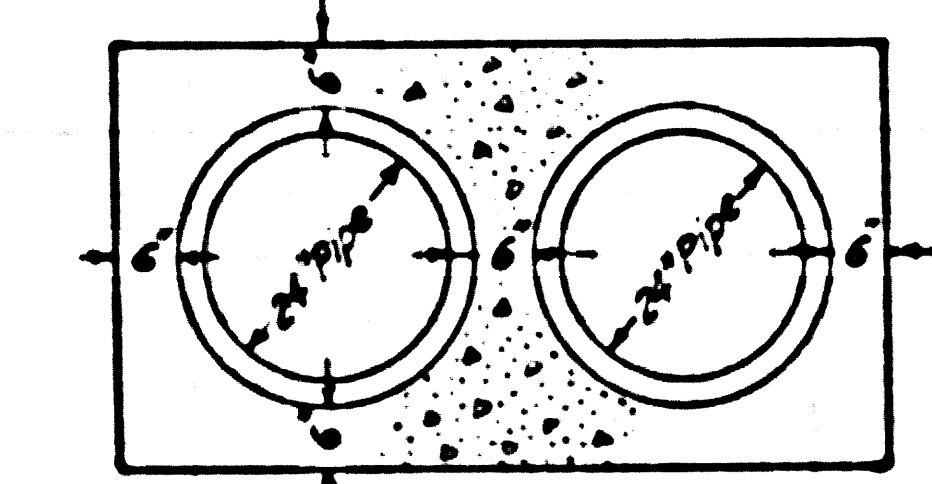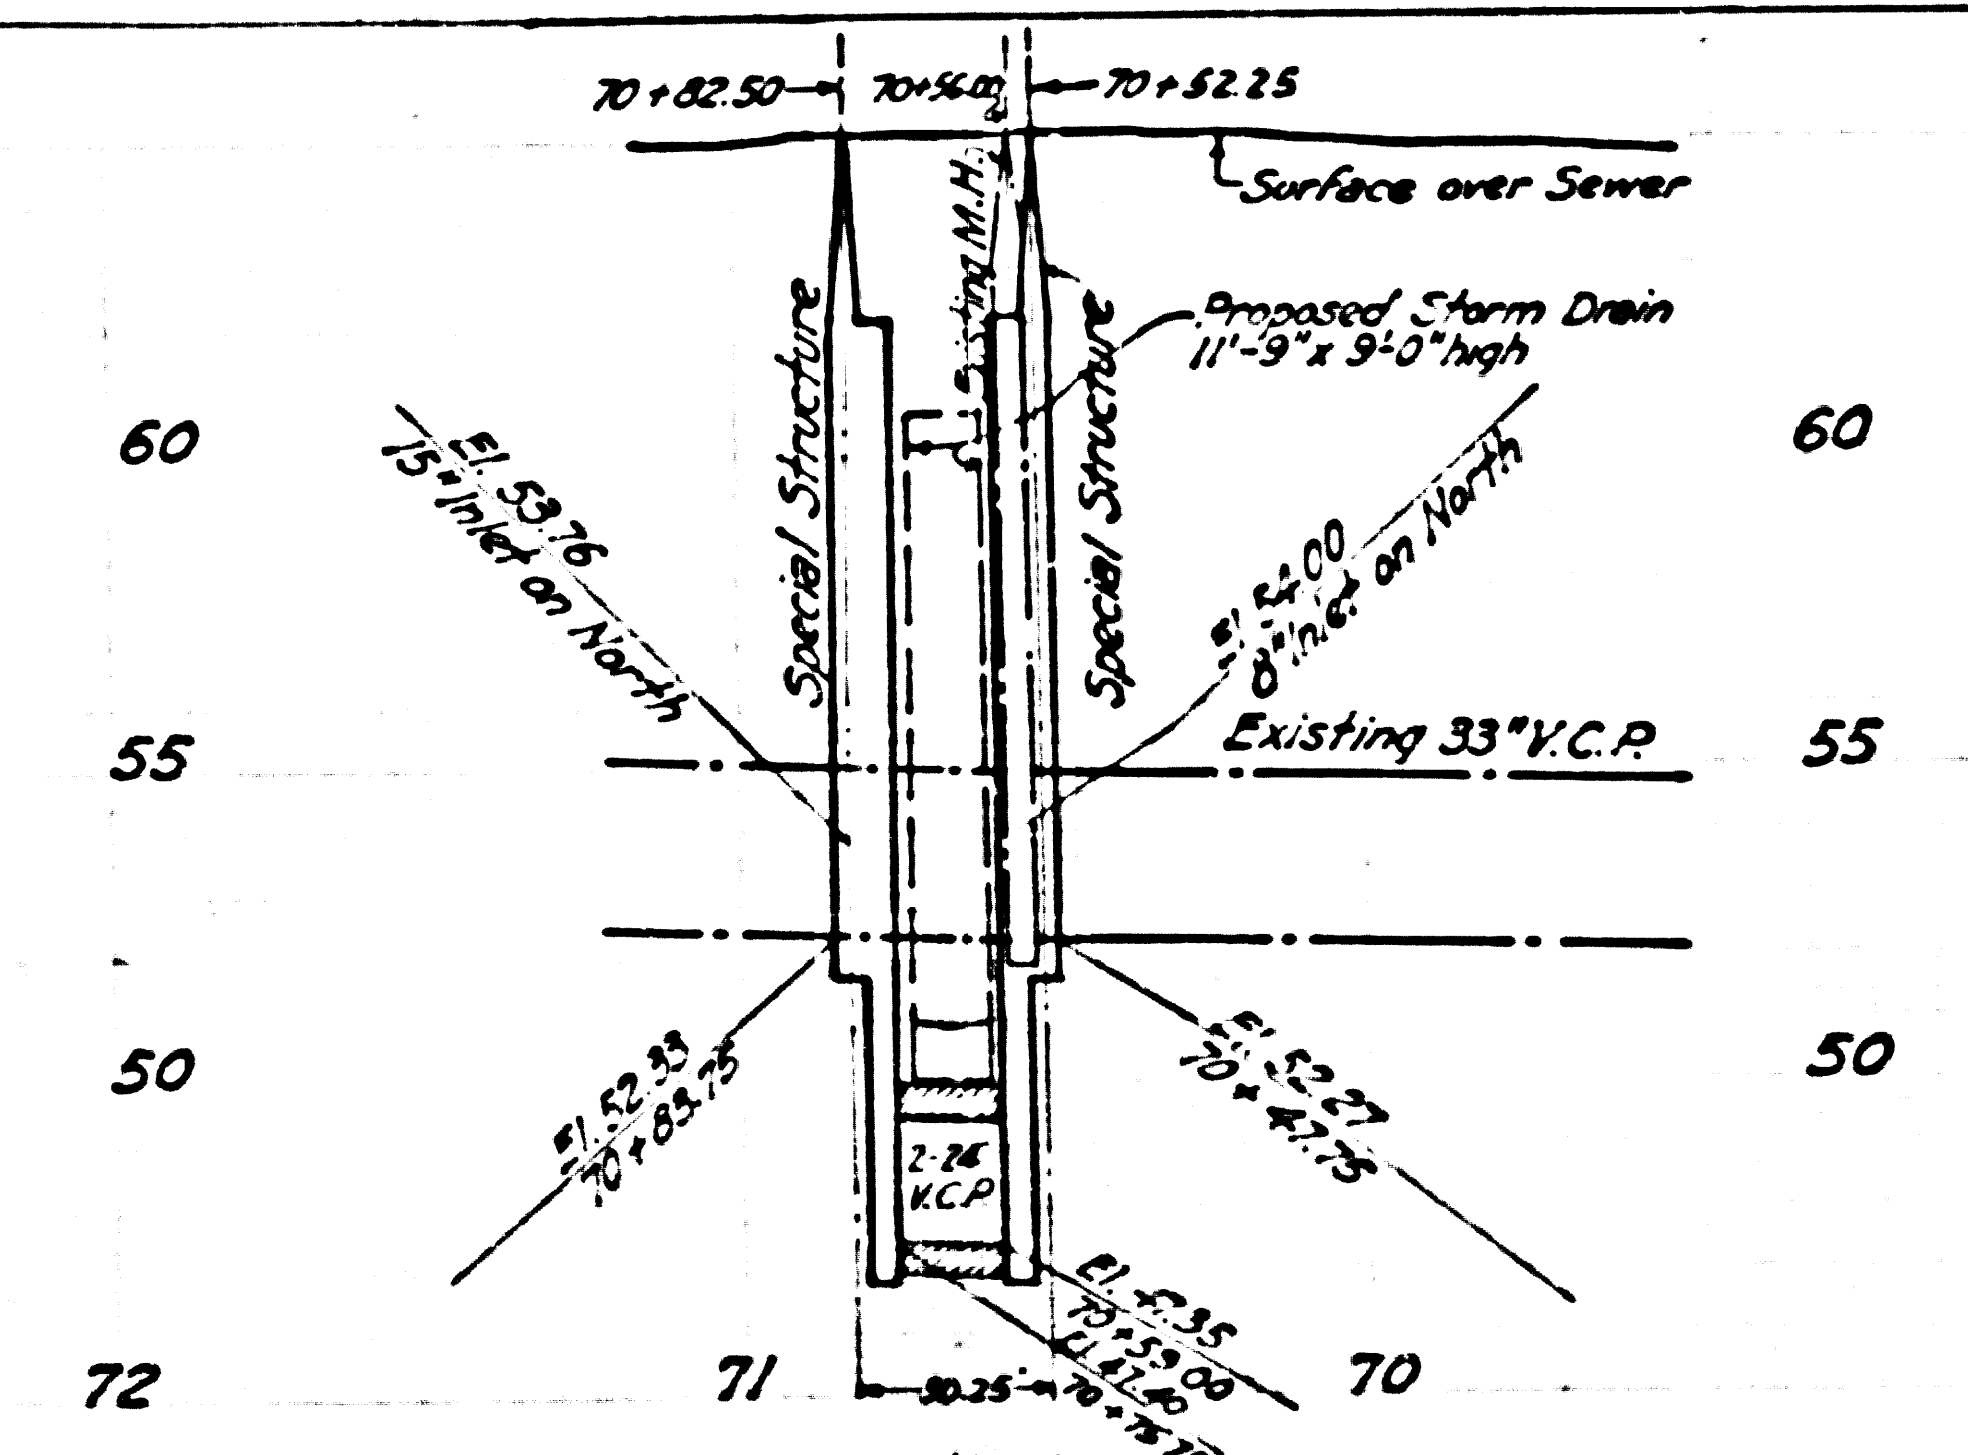

DETAIL OF ENCASEMENT
S.W. 1+36.18 to 2+19.96
S.W. 70+53.00 to 70+75.75
Class B Concrete.

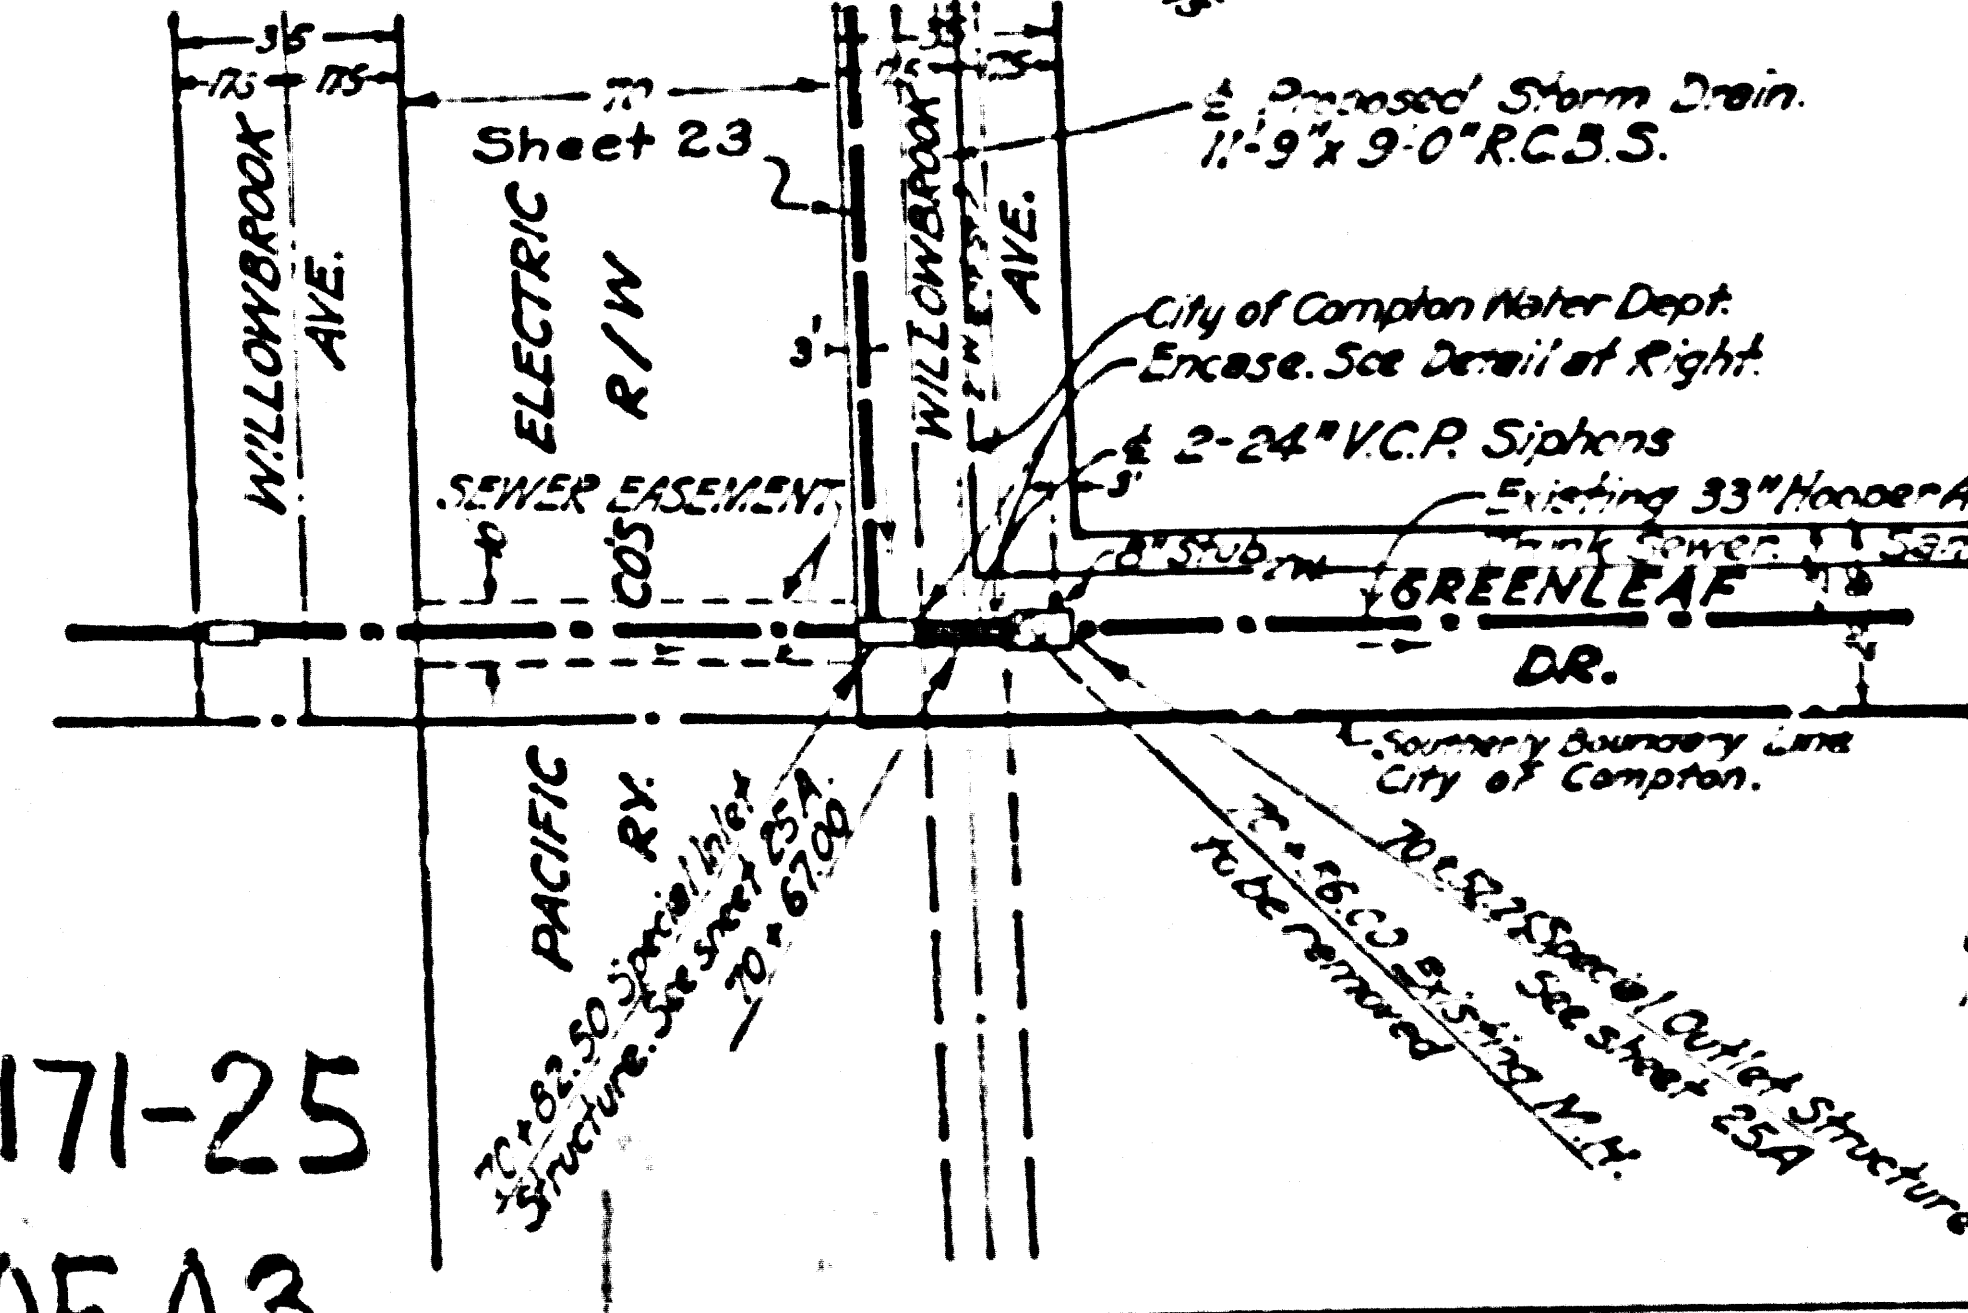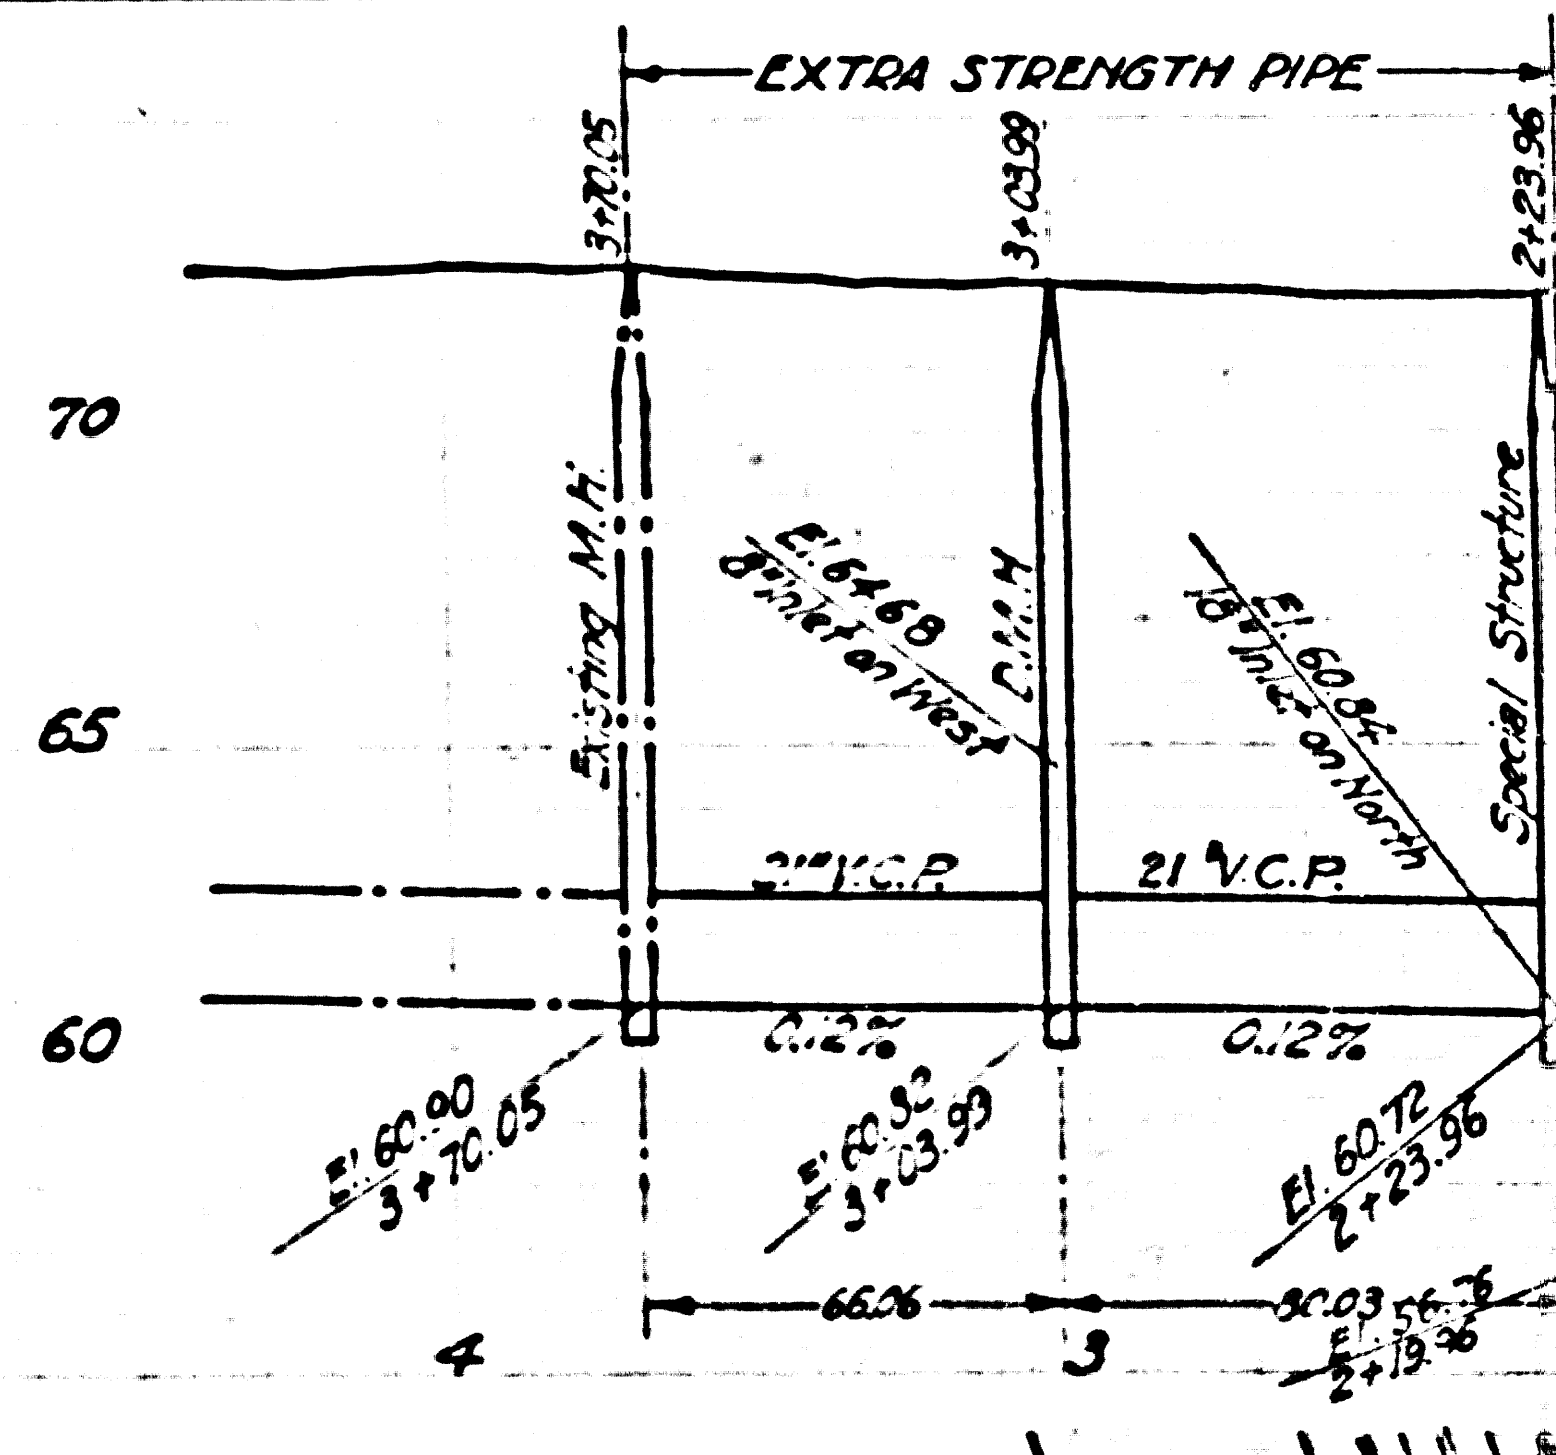

L.E. 019-105-116

Trim Prints to this Line

L.E. 019-52-25