
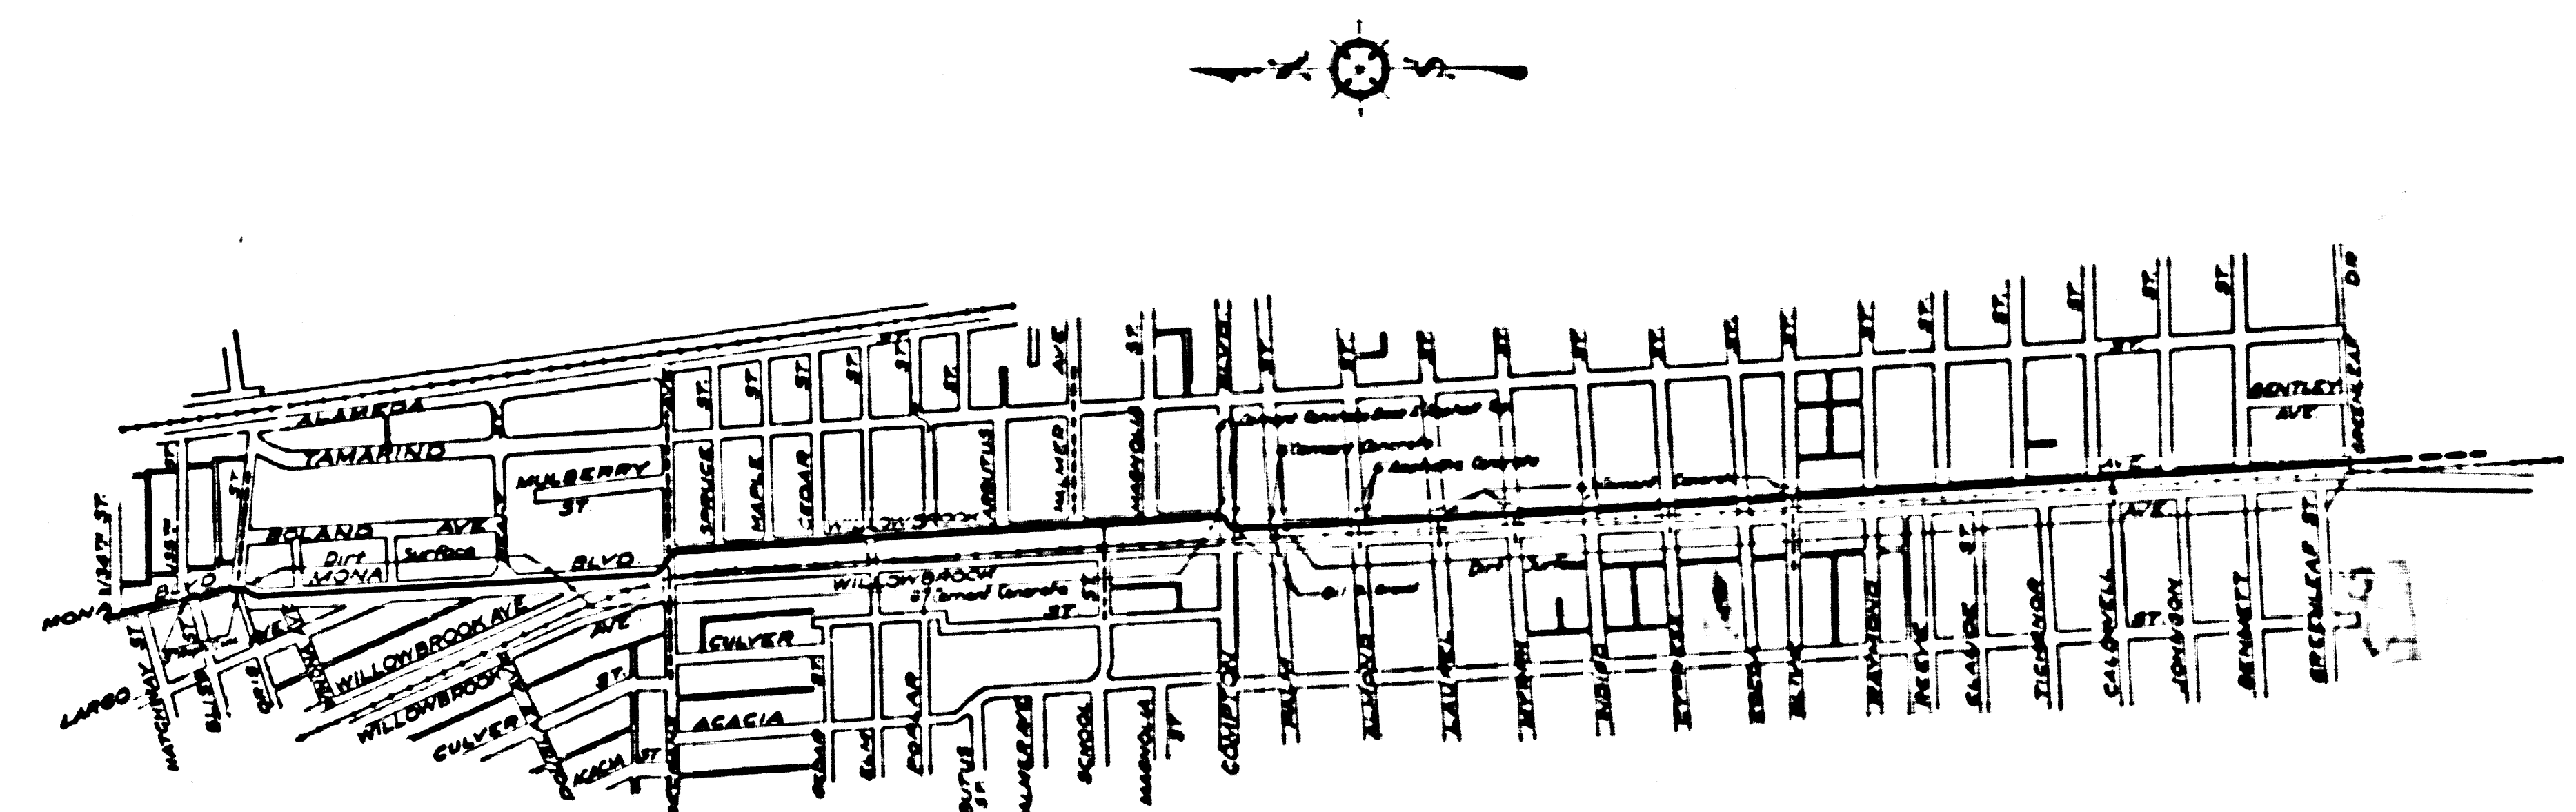


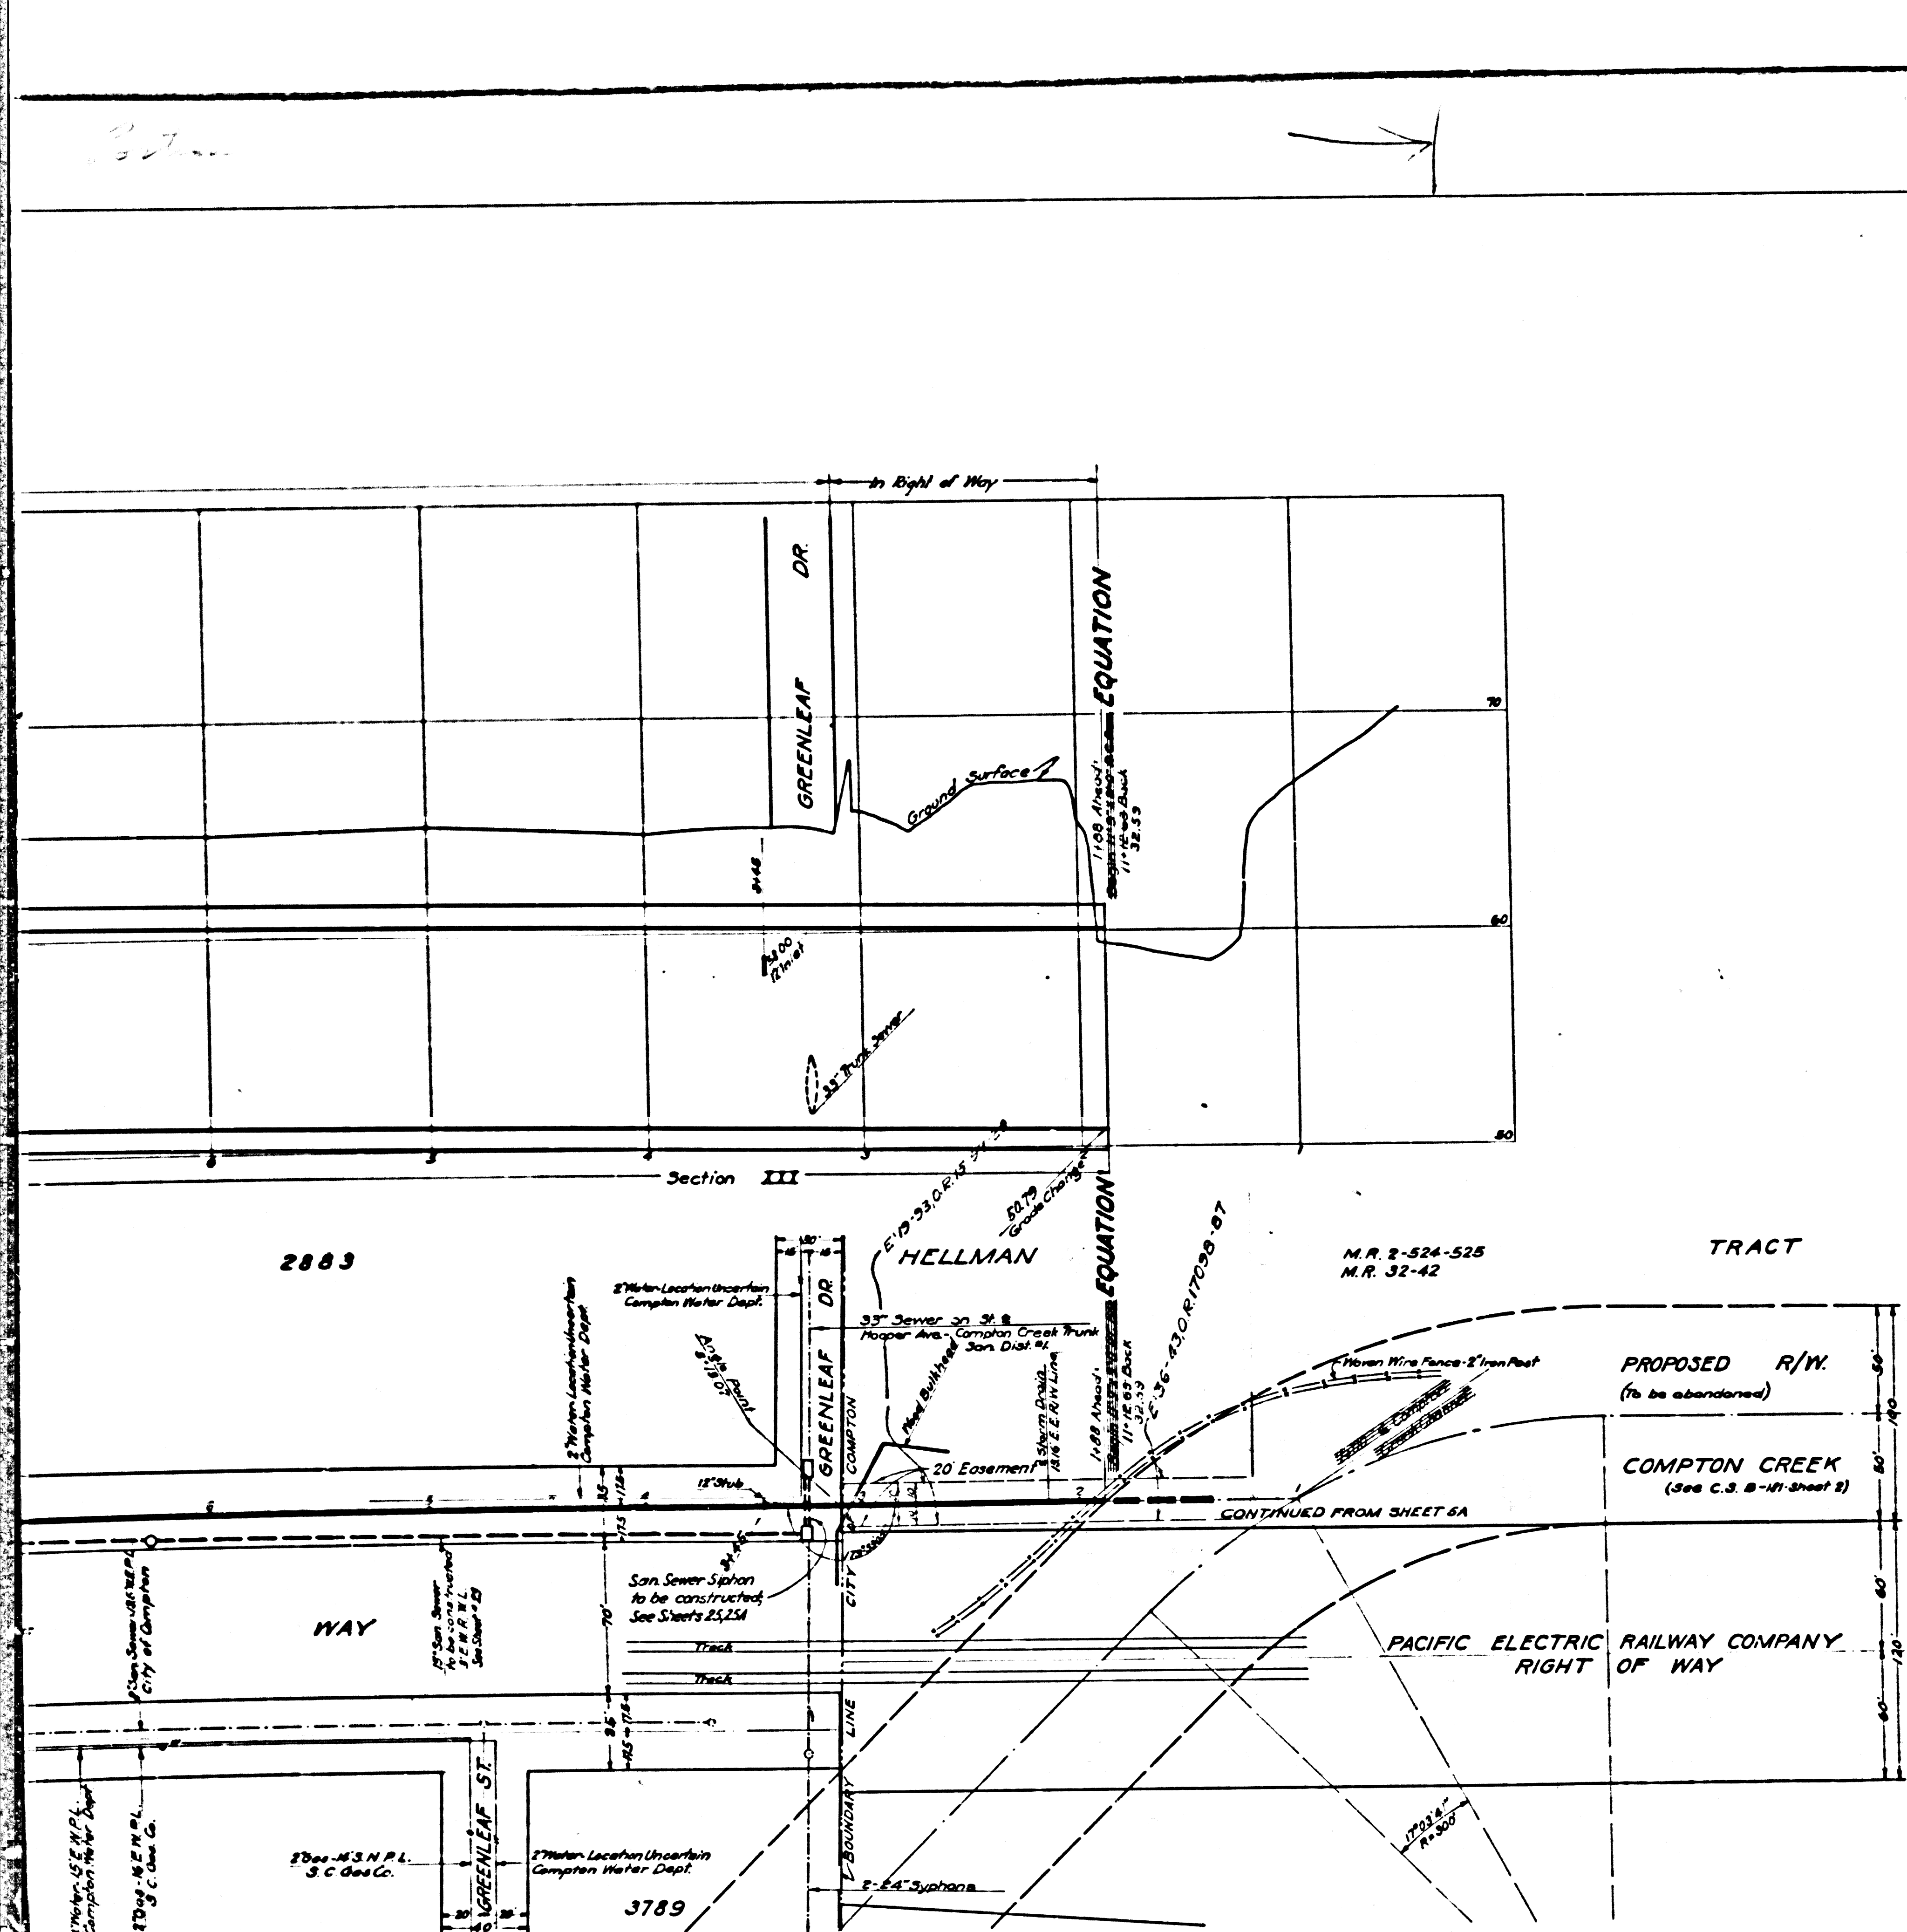

KEY MAP
SHOWING DRAINAGE AND RESURFACING

NOTES:

- Elevations are in feet above U.S.G.S. or mean Sea Level Datum.
- Stations of inlets and junctions refer to the intersections of the center lines of the inlets with the center line of the main drain.
- Elevations of all inlets except catch basin inlets into box sections refer to the flow lines of the inlets produced on their gradients to the vertical plane thru the center line of the main drain. Elevations of catch basin inlets into box sections refer to the intersections of the flow lines of these inlets with the inside wall of the box section.
- For details of all standard structures see Standard Plans.
- All pipe not otherwise specified shall be plain cement pipe.
- All stubs to be one length of pipe with ends sealed with Z'wood planking, unless otherwise specified.
- Catch basins shall be built with a curb face of 1/2' or more which shall include a minimum depression at opening of 4" below gutter grade, unless otherwise specified.
- Sanitary sewers crossing storm drains, shown in profile with less than 1/2' feet clearance, are to be encased as per S-6 for a length equal to the width of conduit trench. In addition if less than 1/2' ft. clearance sewers must be of cast iron pipe and encased as noted above.
- Corrected as Constructed
- August 1941
A.T. Hunscho

GLEN AVENUE
DRAINAGE SYSTEM
OF THE COUNTY OF LOS ANGELES, CALIFORNIA
PLAN AND PROFILE OF
GLEN AVE. TRUNK
STA. 107+00 TO STA. 1+00

SHEET 5 OF 26 SHEETS

DESIGNED BY ALFRED JONES COUNTY SURVEYOR
APPROVED BY [Signature]
DATE 11-1-35

REFERENCE	DESIGNED	DATE
P.B. 495	L. Langacre	MAR 1932
L.B. 678	PI Hunscho	MAY 1933
	CHECKED E.E. Mitchell	NOV 1933

CSB-1171-5
A10FA8

Position

In Willowbrook Ave.

WRIGHT'S

ADDITION

TO
M.R. 7-55


THE

TOWN

OF
COMPTON

TOWN

N2
M.B. 16-13

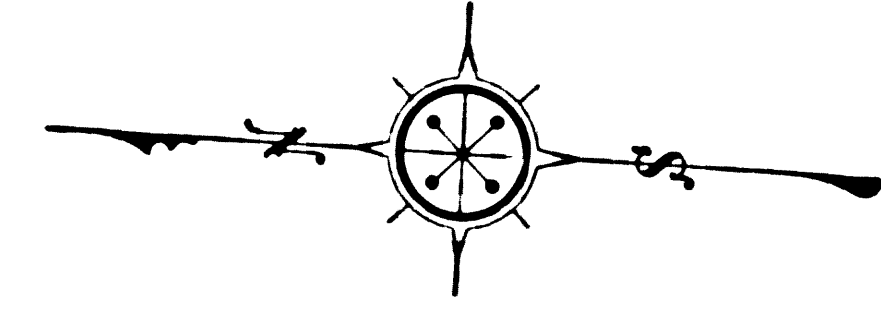


AVENUE


CSB-1171-5
A50FA8

P57

← this

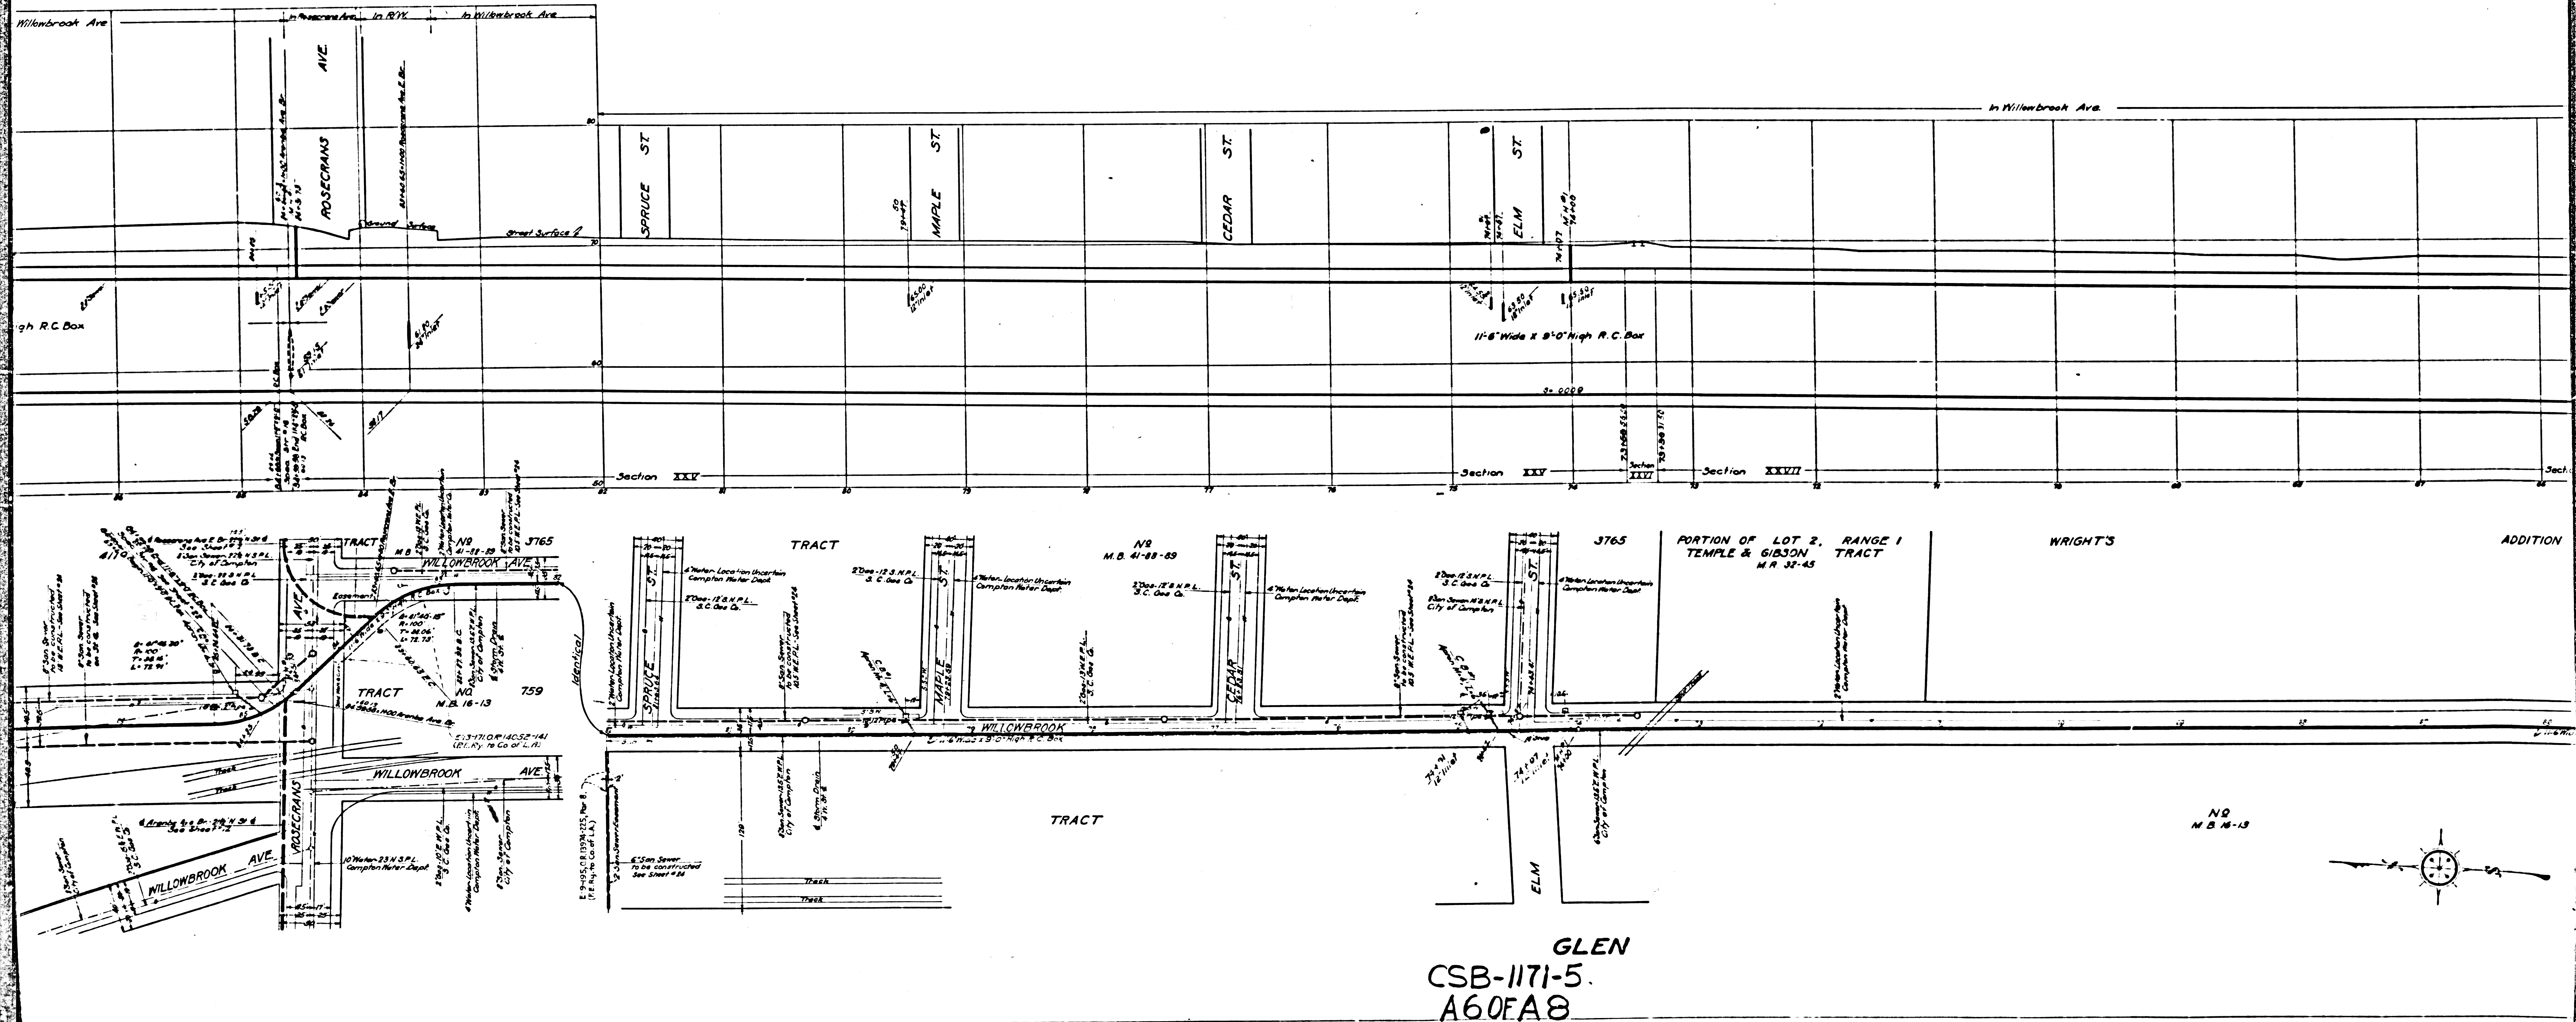


INDEX
Lines Shown on this Sheet
Reading from Left to Right
PLAN AND PROFILE
GLEN AVE. TRUNK

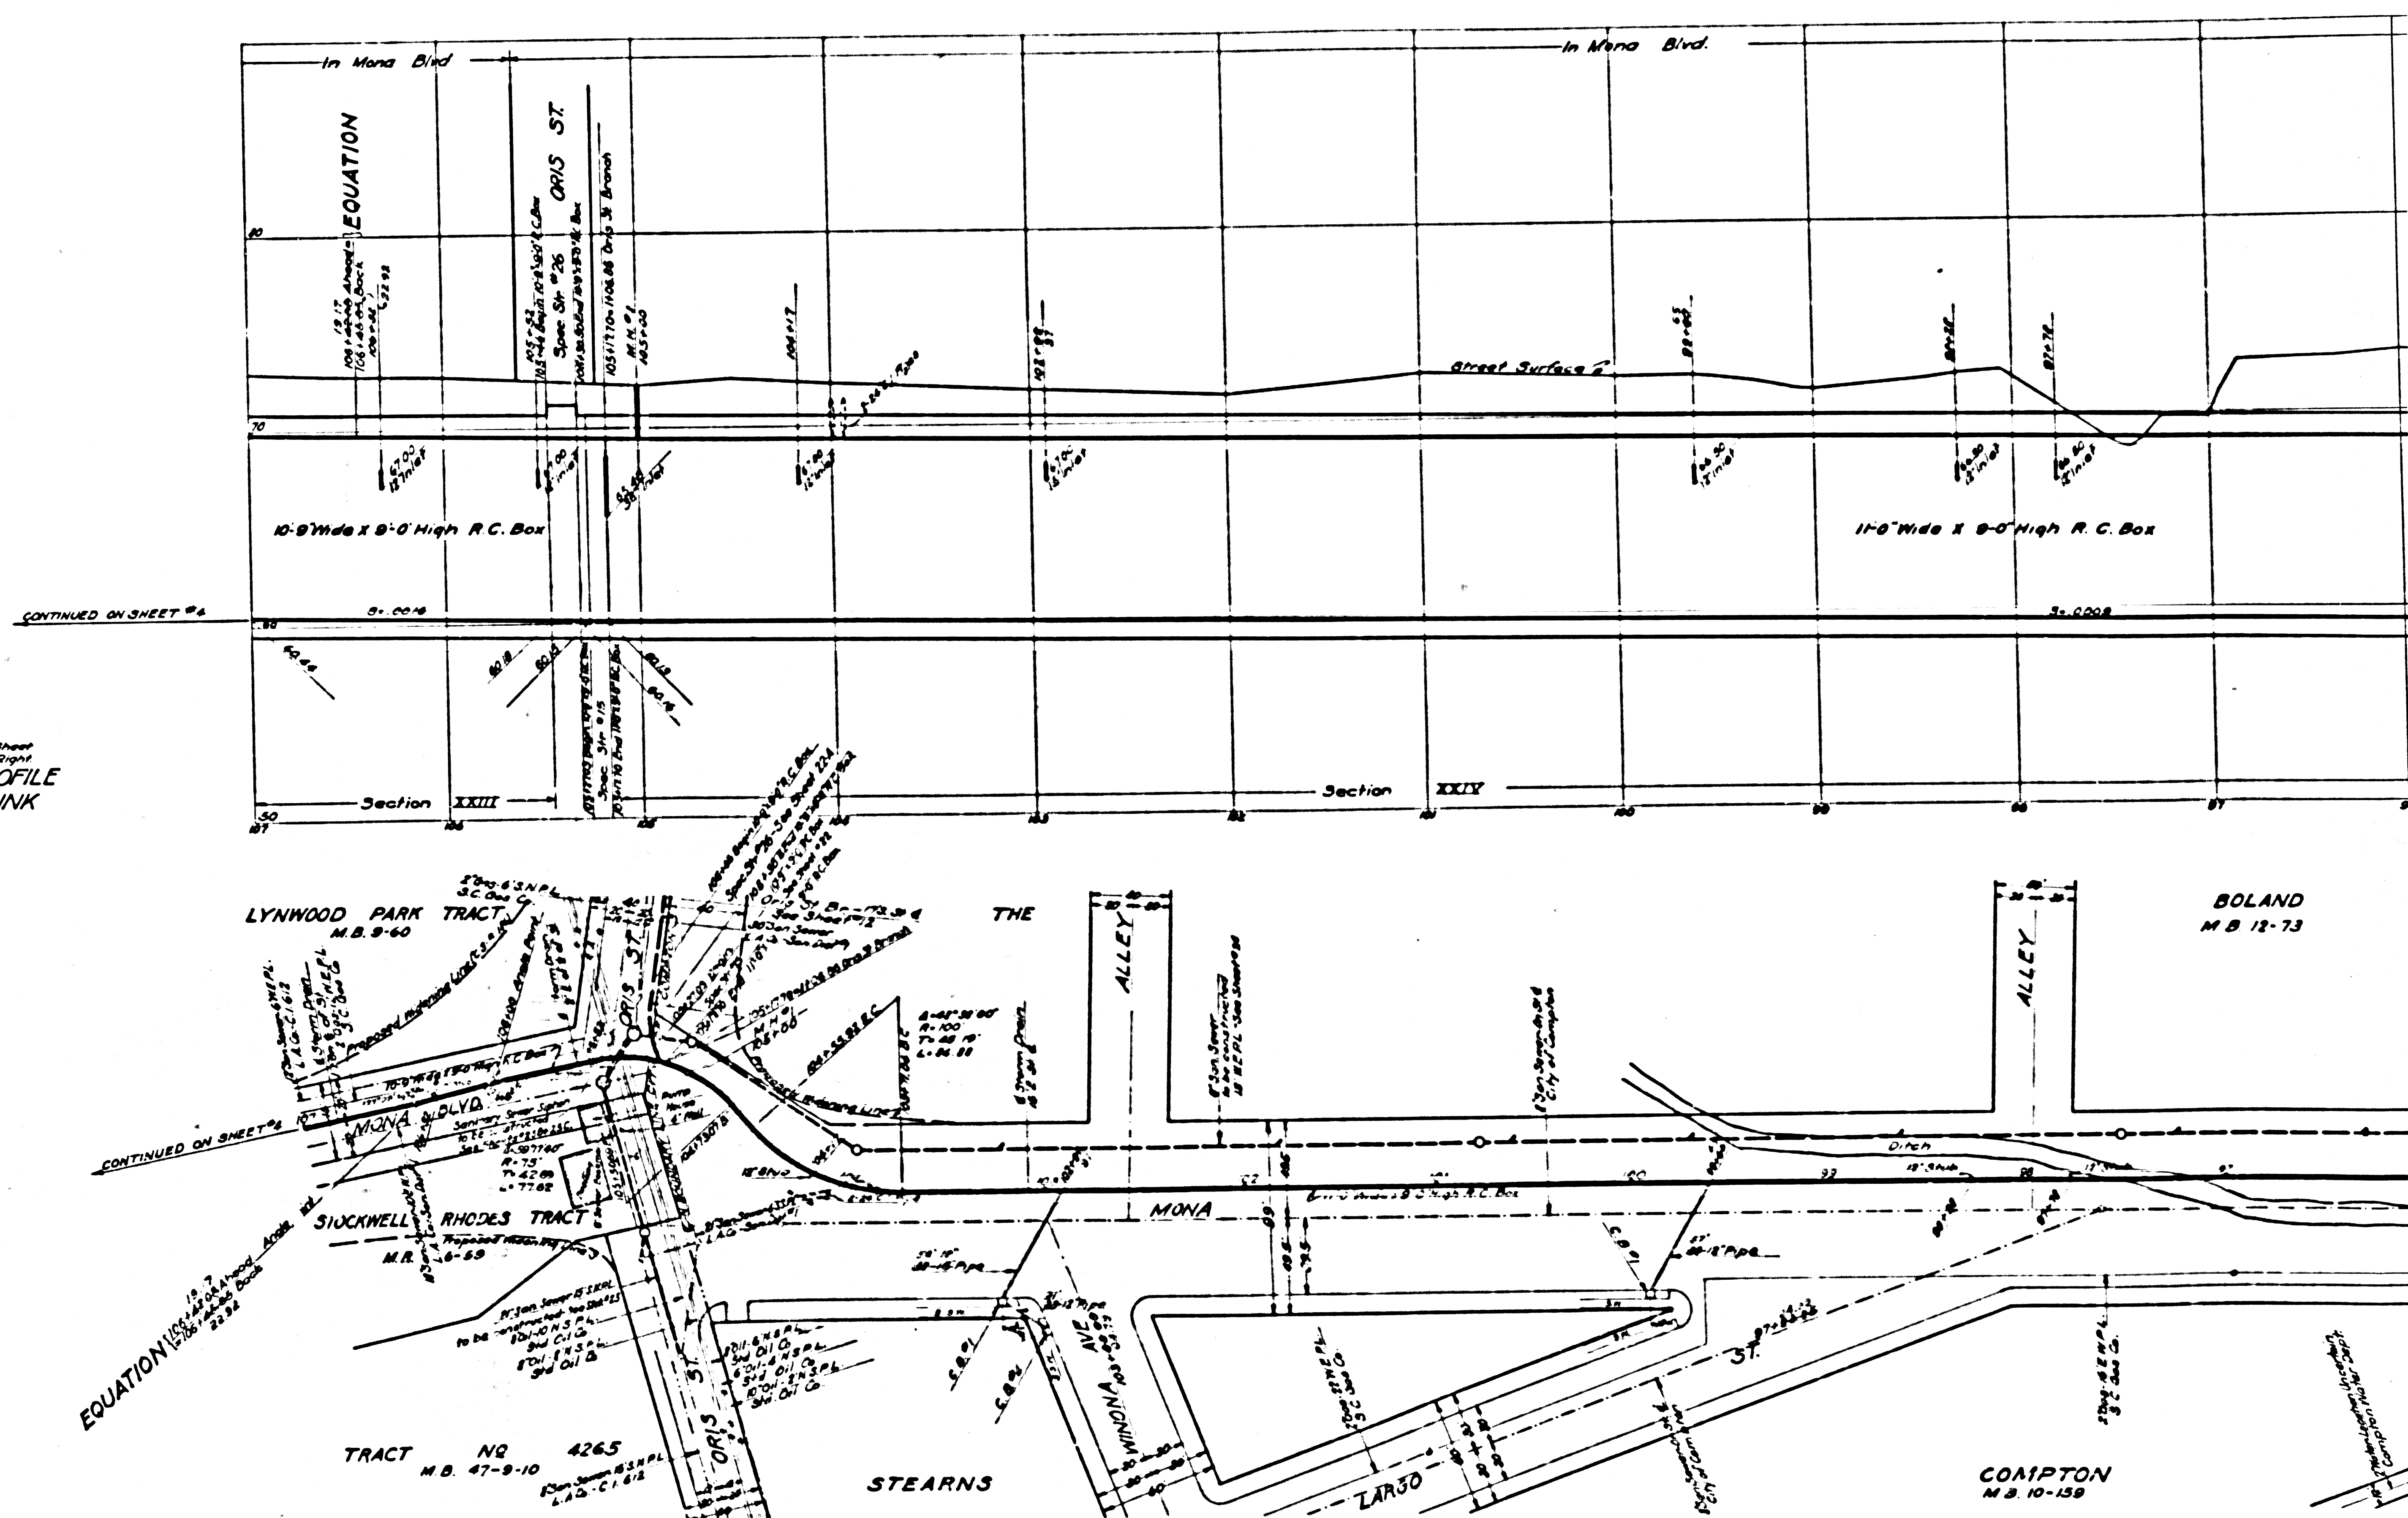


CS B-1171-5
A8 OF A8

SHEET NO. 2 OF 2 SHEETS

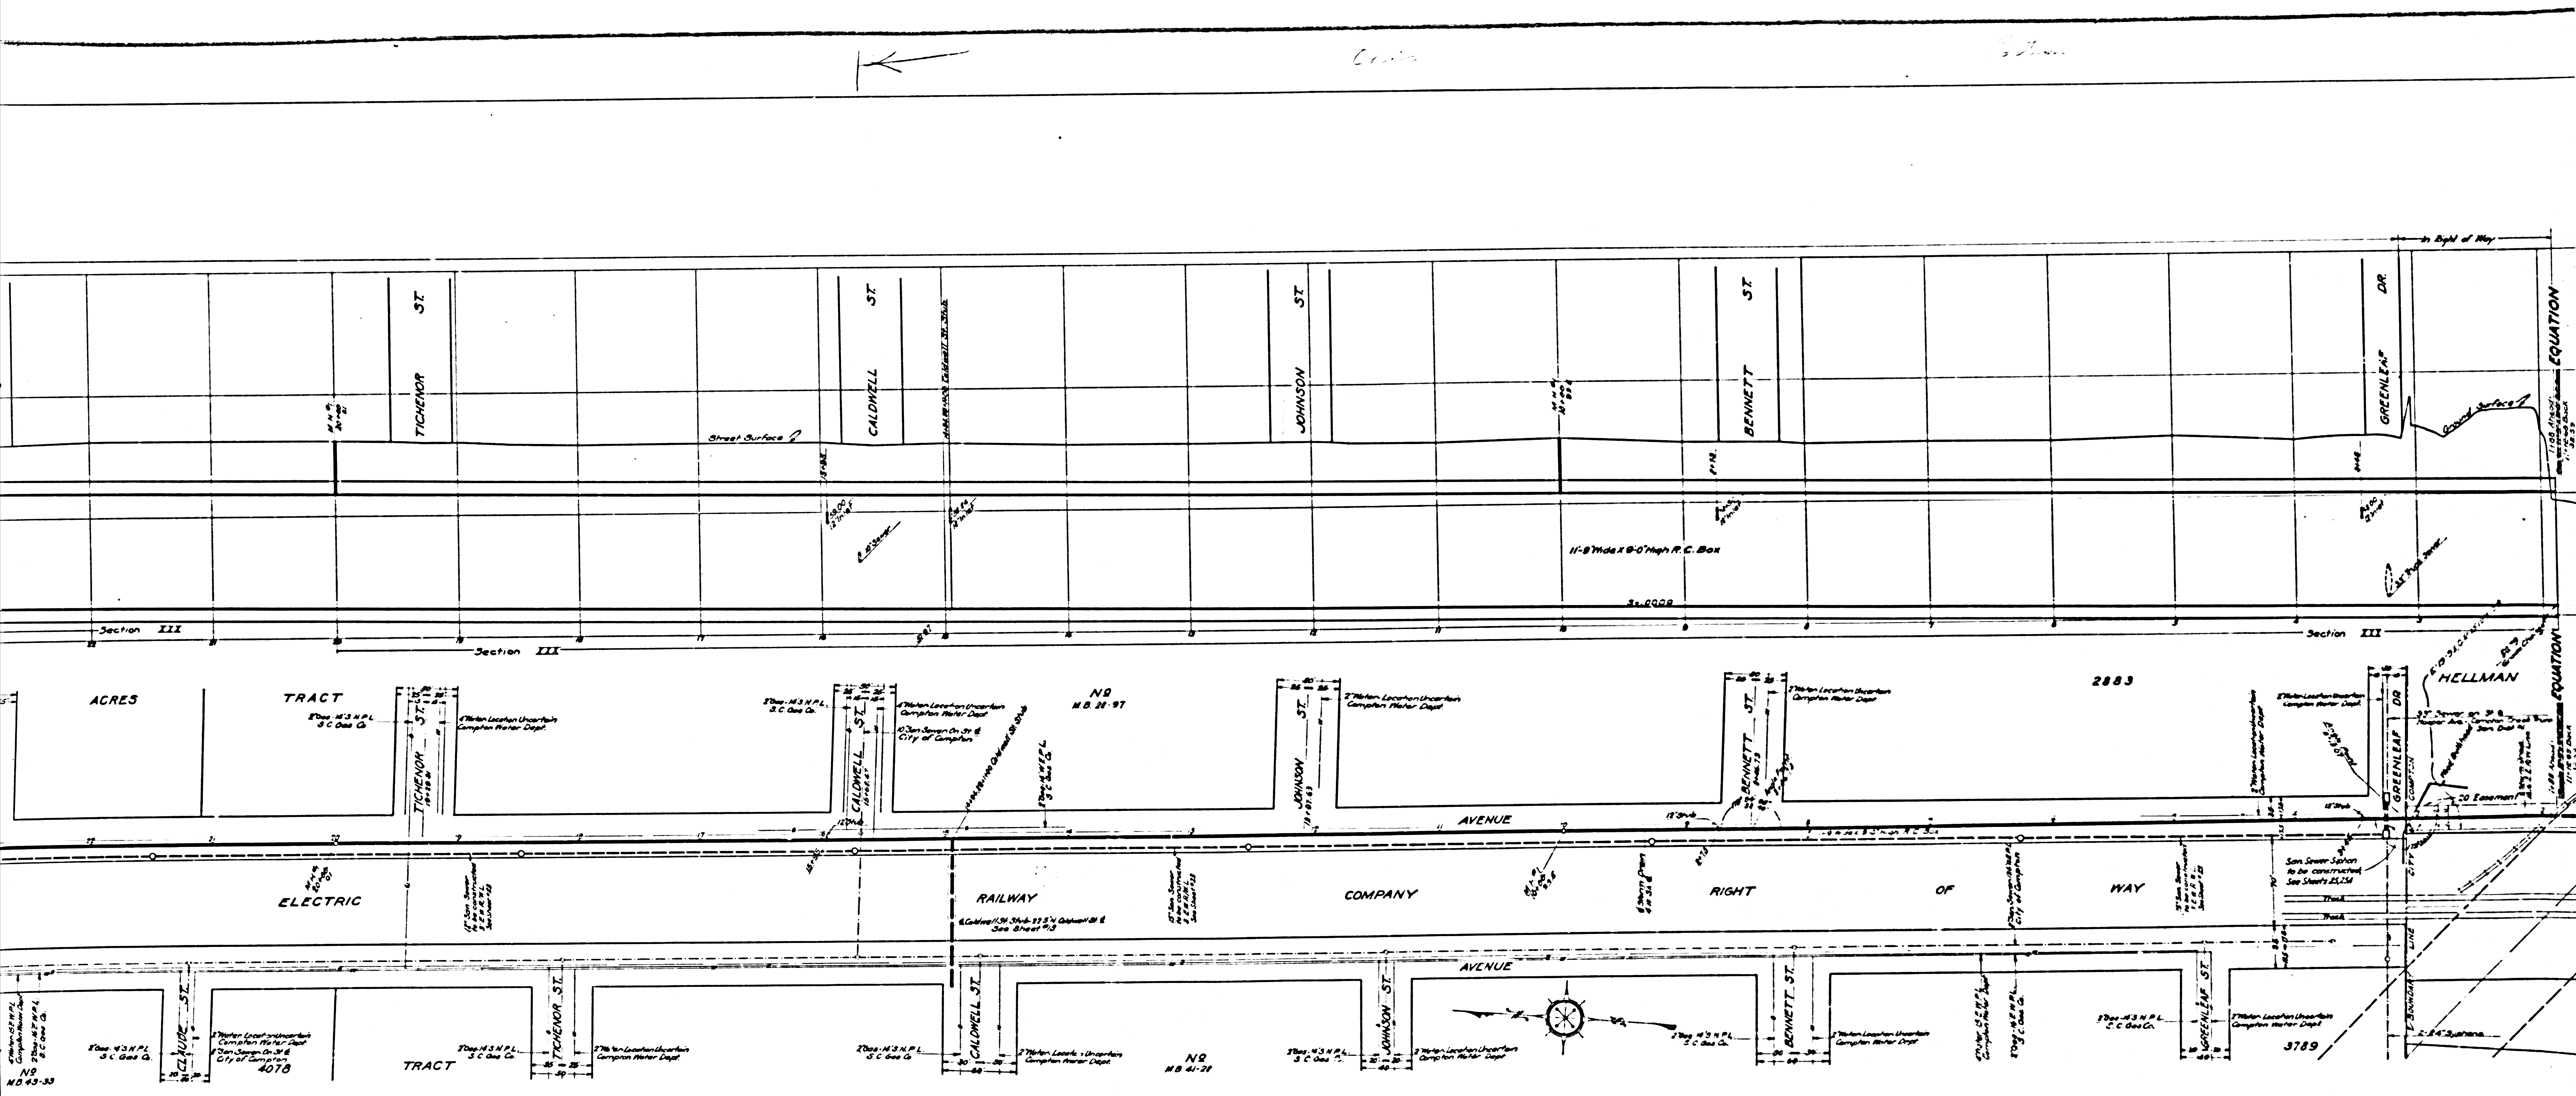



CSB-1171-5
A20FA8

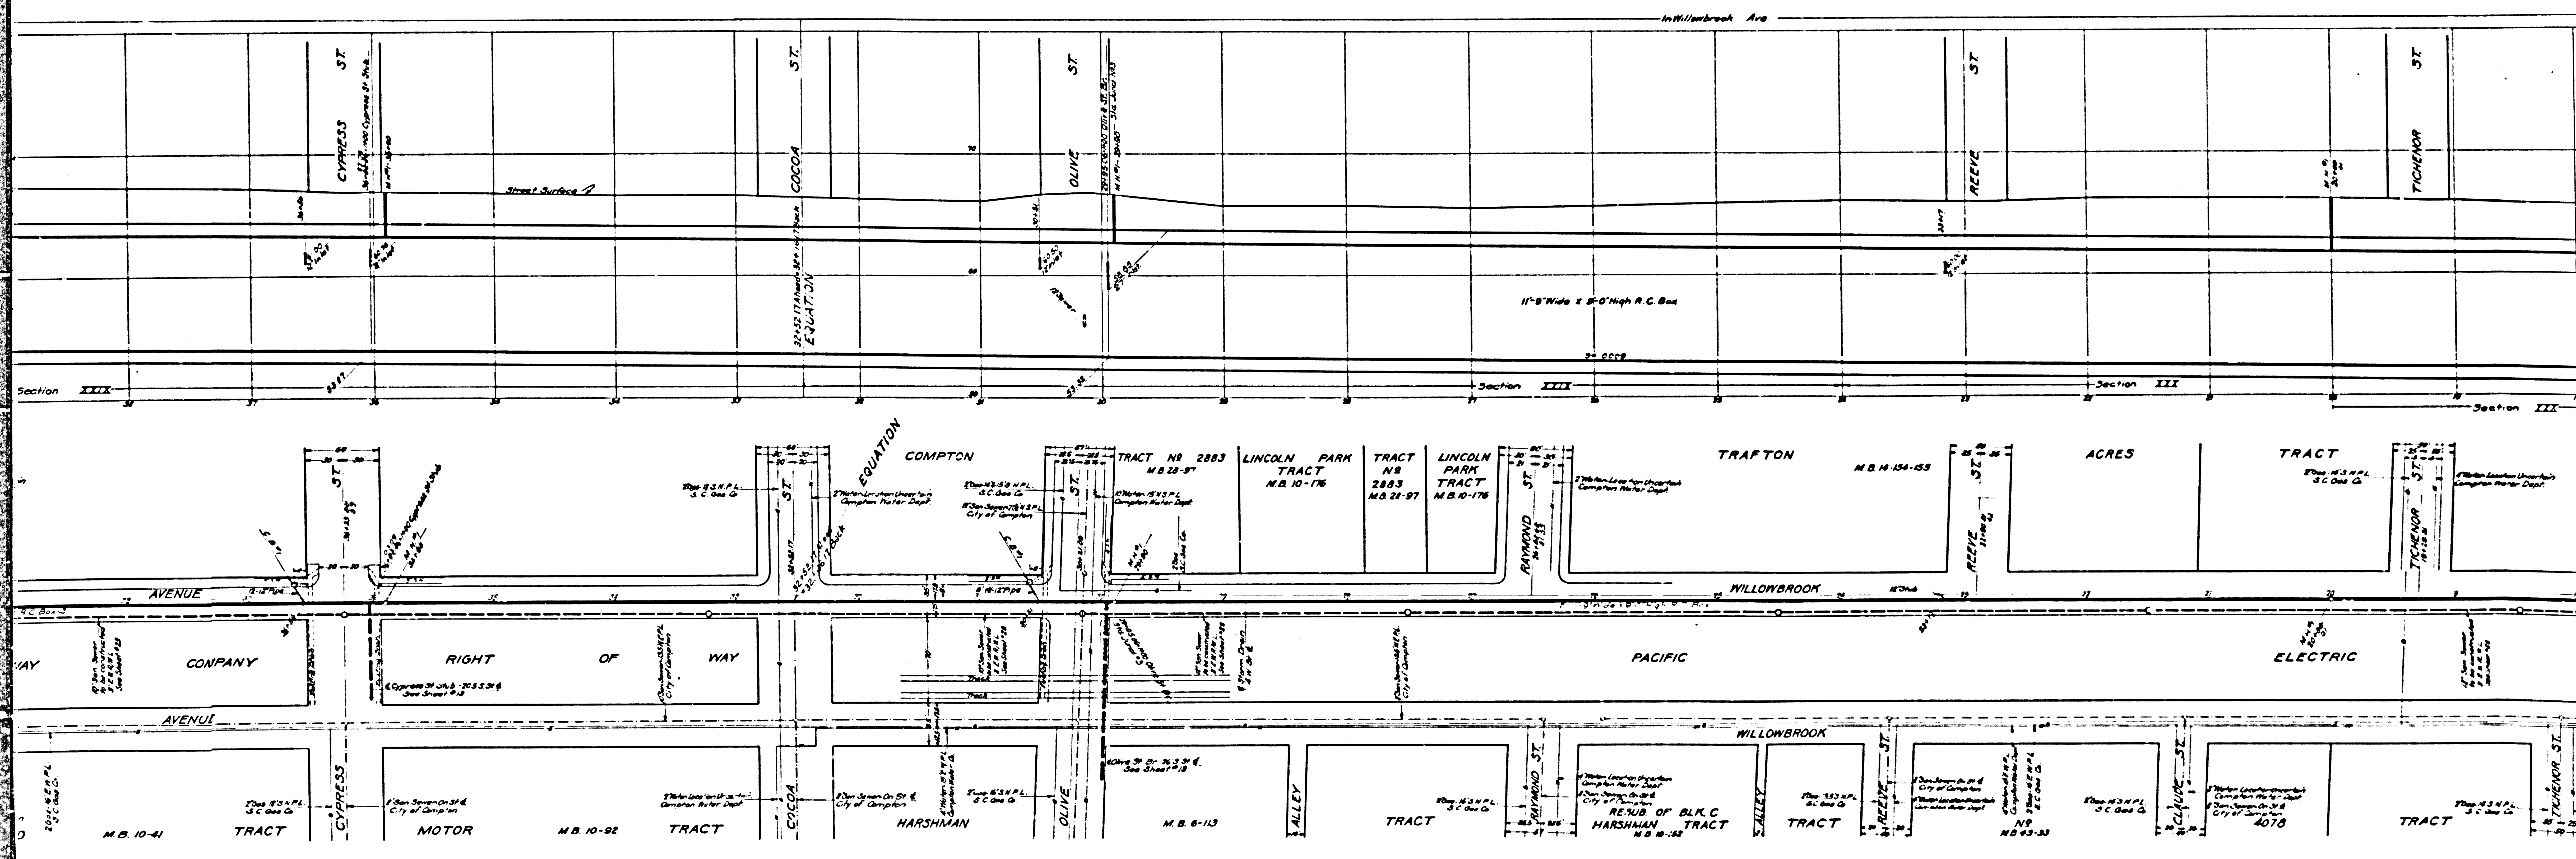

CSB-1171-5
A30FA8

Potion

In Willowbrook Ave

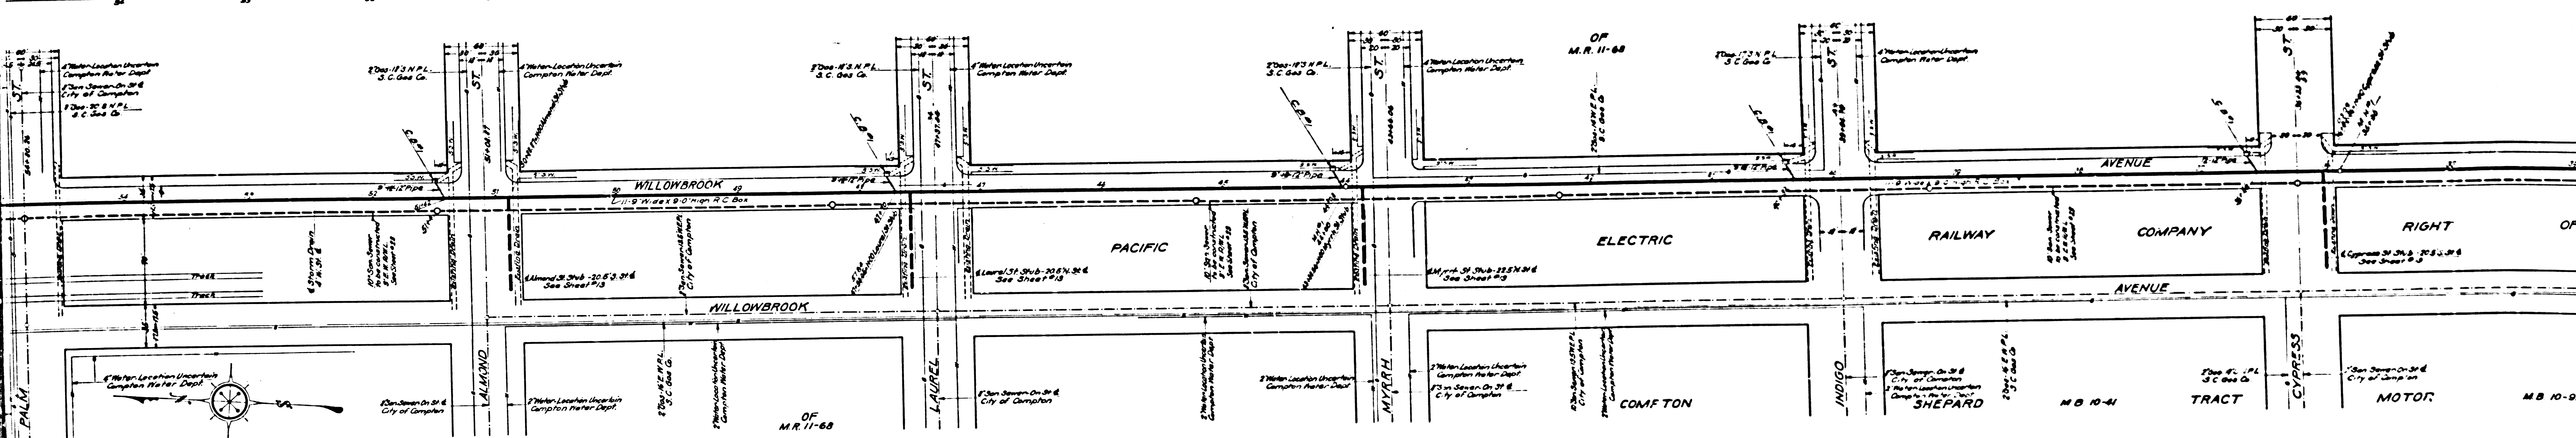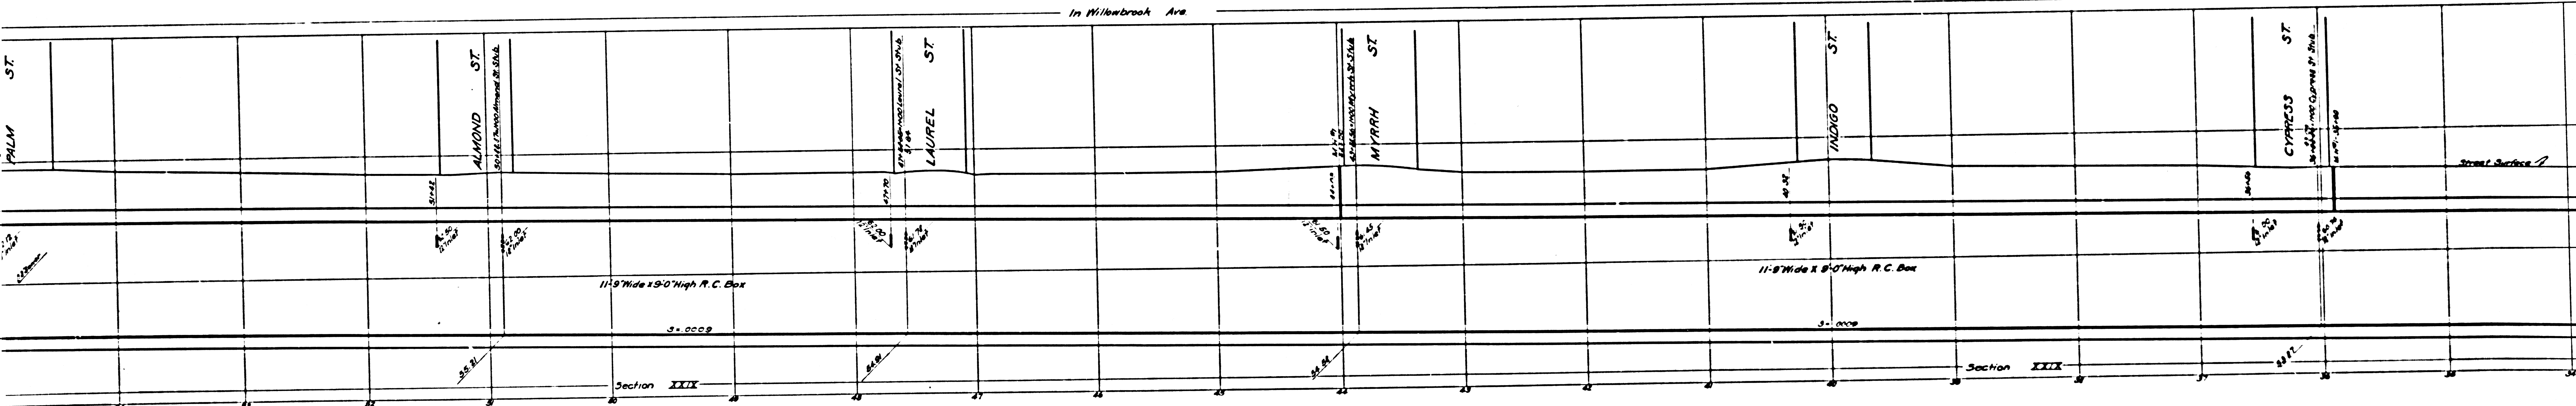

TRUNK

CSB-1171-5
A40FA8